


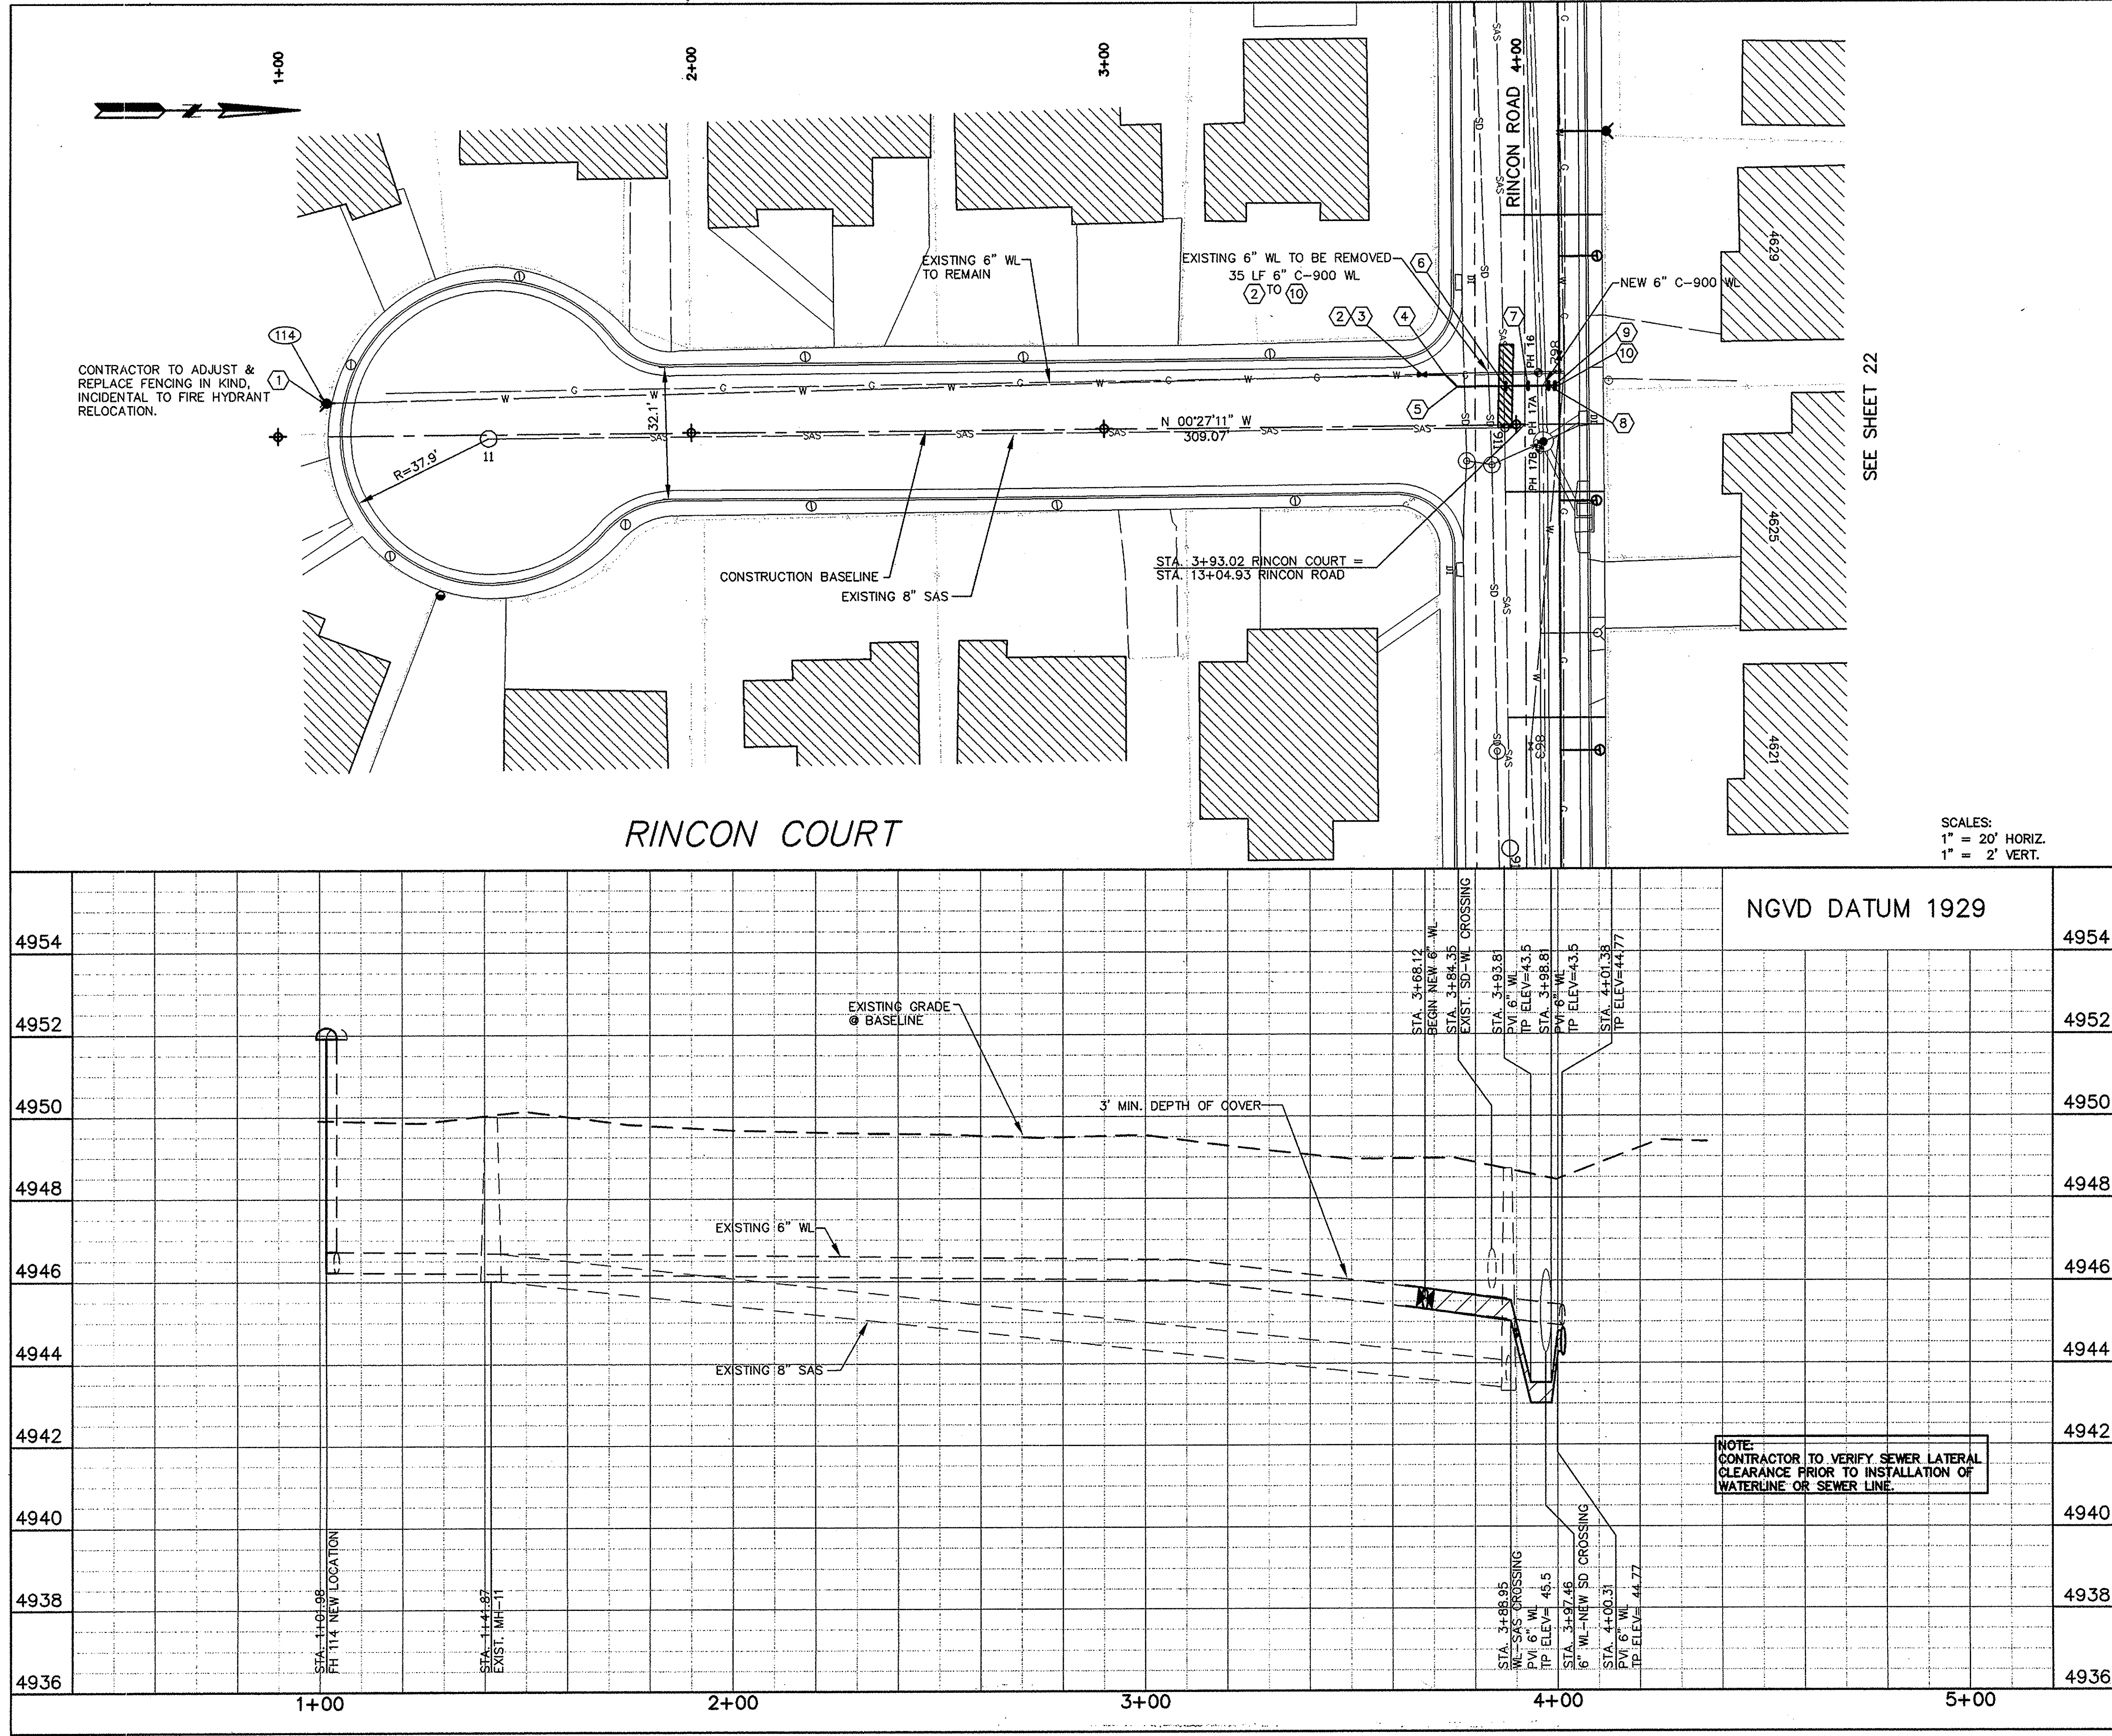

NOTES

- ALL FITTINGS SHALL BE RESTRAINED UNLESS NOTED OTHERWISE. SEE SHEET 30 FOR RESTRAINED JOINT TABLES.
- SEE SEWER AND WATER NOTES, SHEET 30.
- ALL SANITARY MANHOLES TO BE 4' DIAMETER, TYPE "C", UNLESS NOTED OTHERWISE. SEE MH DATA LISTINGS, THIS SHEET.
- ALL SEWER SERVICE CONNECTIONS TO BE 4". EXTEND SERVICE LINES TO PROPERTY LINE AND CONNECT TO EXISTING SERVICE.
- ALL WATER METERS ARE 3/4" UNLESS NOTED OTHERWISE.

WATERLINE KEYED NOTES

- STA. 1+03.75, 8.07' LT. EXIST. FIRE HYDRANT 114, REPLACE & RELOCATE PER COA STD. DWG. 2340 & 4 LF OF 6" WL.
- STA. 3+68.12, 12.35' LT. 6" TRANSITION COUPLING & NON-PRESSURE CONNECTION
- STA. 3+68.12, 12.35' LT. 6" GATE VALVE & VALVE BOX PER COA STD. DWG. 2326 & 2328
- STA. 3+73.65, 12.38' LT. PI 6" WL, 45' BEND
- STA. 3+76.70, 9.33' LT. PI 6" WL, 45' BEND
- STA. 3+88.39, 9.35' LT. PVI 6" WL, 22.5' BEND
- STA. 3+93.81, 9.36' LT. PVI 6" WL, 22.5' BEND
- STA. 3+98.81, 9.37' LT. PVI 6" WL, 45' BEND
- STA. 4+00.31, 9.34' LT. PVI 6" WL, 45' BEND
- STA. 4+01.38, 9.37' LT. SEE SHEET 22

AS BUILT INFORMATION

CONTRACTOR	New Mexico Underground
DATE	9/06
DATE	5/07
DATE	5/07
DATE	7/07

ENGINEER'S SEAL

REGISTERED PROFESSIONAL ENGINEER
STATE OF NEW MEXICO
LARKIN GROUP, INC.
10/06

RECORD DRAWING

JUNE 2007

LARKIN GROUP, INC.

CONSULTING ENGINEERS AND SURVEYORS
8500 MENAUL BLVD. NE A-440
ALBUQUERQUE, NEW MEXICO 87112
(505) 275-7500 FAX (505) 275-0748

CITY OF ALBUQUERQUE

DEPARTMENT OF MUNICIPAL DEVELOPMENT
STORM DRAINAGE DESIGN DIVISION

TITLE: CENTRAL - ATRISCO DRAINAGE IMPROVEMENTS PHASE II

WATER & SANITARY SEWER RINCON CT.

DESIGNED BY: XX	CHECKED BY: XX
DRAWN BY: XX	

DESIGN REVIEW COMMITTEE	CITY ENGINEER
JUN 08 2006	JUN 08 2006

Project No.	Zone Map No.	Sheet
674903	J-12-Z	25 OF 32