


SEE SHEET 26



MATCH LINE STA. 5+50

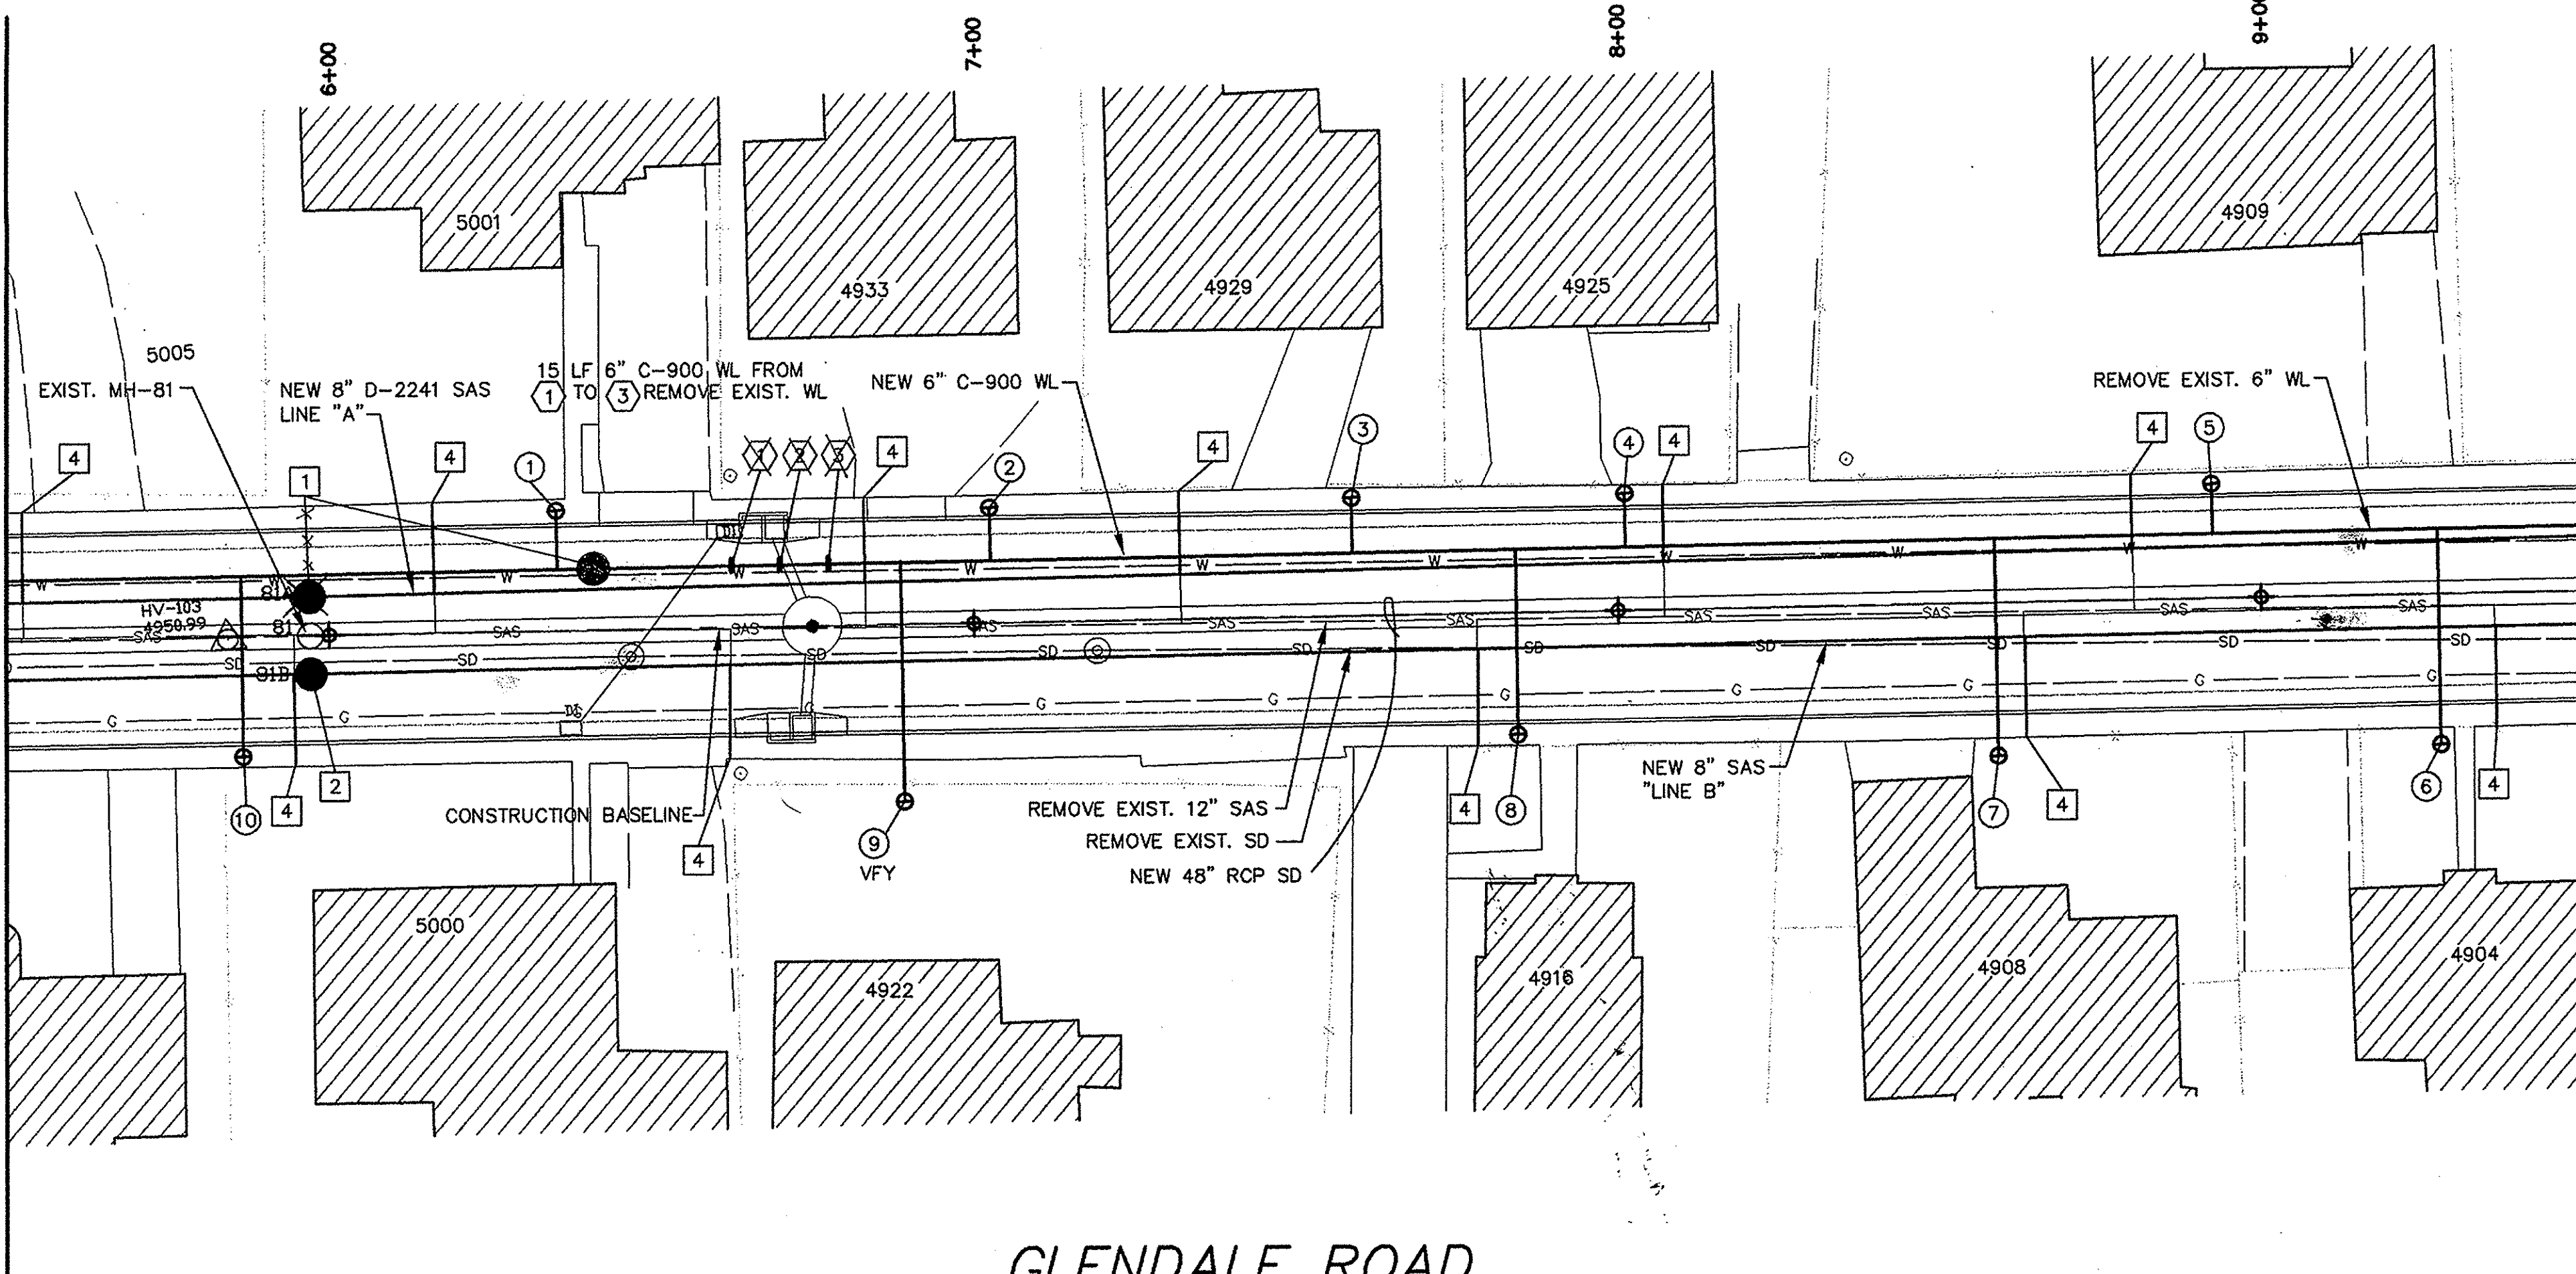

MATCH LINE STA. 9+50

SEE SHEET 28

GLENDAL ROAD

SCALES:
1" = 20' HORIZ.
1" = 2' VERT.

NOTES

1. ALL FITTINGS SHALL BE RESTRAINED UNLESS NOTED OTHERWISE. SEE SHEET 30 FOR RESTRAINED JOINT TABLES.
2. SEE SEWER AND WATER NOTES, SHEET 30.
3. ALL SANITARY MANHOLES TO BE 4' DIAMETER, TYPE "C", UNLESS NOTED OTHERWISE. SEE MH DATA LISTINGS, THIS SHEET.
4. ALL SEWER SERVICE CONNECTIONS TO BE 4". EXTEND SERVICE LINES TO PROPERTY LINE AND CONNECT TO EXISTING SERVICE.
5. ALL WATER METERS ARE 3/4" UNLESS NOTED OTHERWISE.

EXIST. WATER METER KEYED NOTES

- ① STA. 6+35.43, 18.74' LT.
- ② STA. 7+02.68, 17.96' LT.
- ③ STA. 7+58.90, 18.43 LT.
- ④ STA. 8+01.30, 18.25' LT.
- ⑤ STA. 8+92.57, 17.84' LT.
- ⑥ STA. 9+27.52, 23.38' RT., RELOCATE
- ⑦ STA. 8+58.76, 23.77 RT., RELOCATE
- ⑧ STA. 7+84.74, 18.96' RT., RELOCATE
- ⑨ STA. 6+88.83, 27.51' RT., RELOCATE
- ⑩ STA. 8+01.30, 18.25' LT.

SAS KEYED NOTES

- ① STA. 6+40.22, 6.07' LT.
NEW 4' TYPE "C" MANHOLE
MH-81A, STD. DWG. 2101
- ② STA. 5+97.14, 5.63' RT.
NEW 4' TYPE "C" MANHOLE
MH-81B, STD. DWG. 2101
- ③ STA. 5+97.14, REMOVE
EXISTING 4' MH-81
- ④ 4" SEWER SERVICE CONNECTION TO
PROPERTY LINE, CONTRACTOR
LOCATE AND CONNECT TO EXISTING
SERVICE.

WATER LINE KEYED NOTES

- ① STA. 6+62.50, 9.61' LT.
PVA-6" WL 11.25' BEND.
- ② STA. 6+70.00, 9.62' LT. Deleted
PVA-6" WL 22.5' BEND.
- ③ STA. 6+77.50, 9.63' LT.
PVA-6" WL 11.25' BEND.

MH-81
RIM = 4950.59
E. INV. = 4943.11
W. INV. = 4943.09

MH-81A
RIM = 4950.46
E. INV. = 4942.90
W. INV. = 4942.94

MH-81B
RIM = 4950.70
E. INV. = 4942.97
W. INV. = 4943.01

CONTRACTOR TO
VERIFY MANHOLE
ELEVATIONS PRIOR
TO CONSTRUCTING
SEWER LINE
BETWEEN MANHOLES.



CITY OF ALBUQUERQUE
DEPARTMENT OF MUNICIPAL DEVELOPMENT
STORM DRAINAGE DESIGN DIVISION

TITLE: **CENTRAL - ATRISCO DRAINAGE
IMPROVEMENTS PHASE II**
WATER & SANITARY SEWER GLENDAL ROAD STA 5+50 TO 9+50


DESIGNED BY: XX
DRAWN BY: XX
CHECKED BY: XX

NO. DATE REMARKS BY
1 2 3 4


APPROVE JUN 08 2006
DESIGN REVIEW COMMITTEE

APPROVE JUN 08 2006
CITY ENGINEER

Project No. 674903 Zone Map No. K-11-Z Sheet 27 OF 32

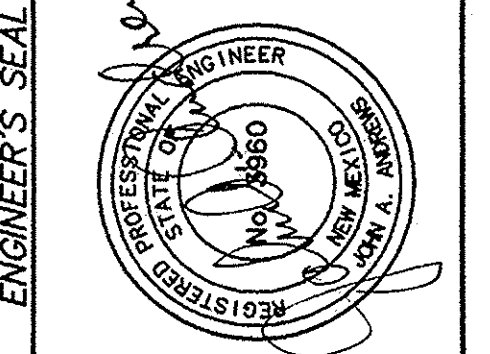

MATCH LINE STA. 5+50

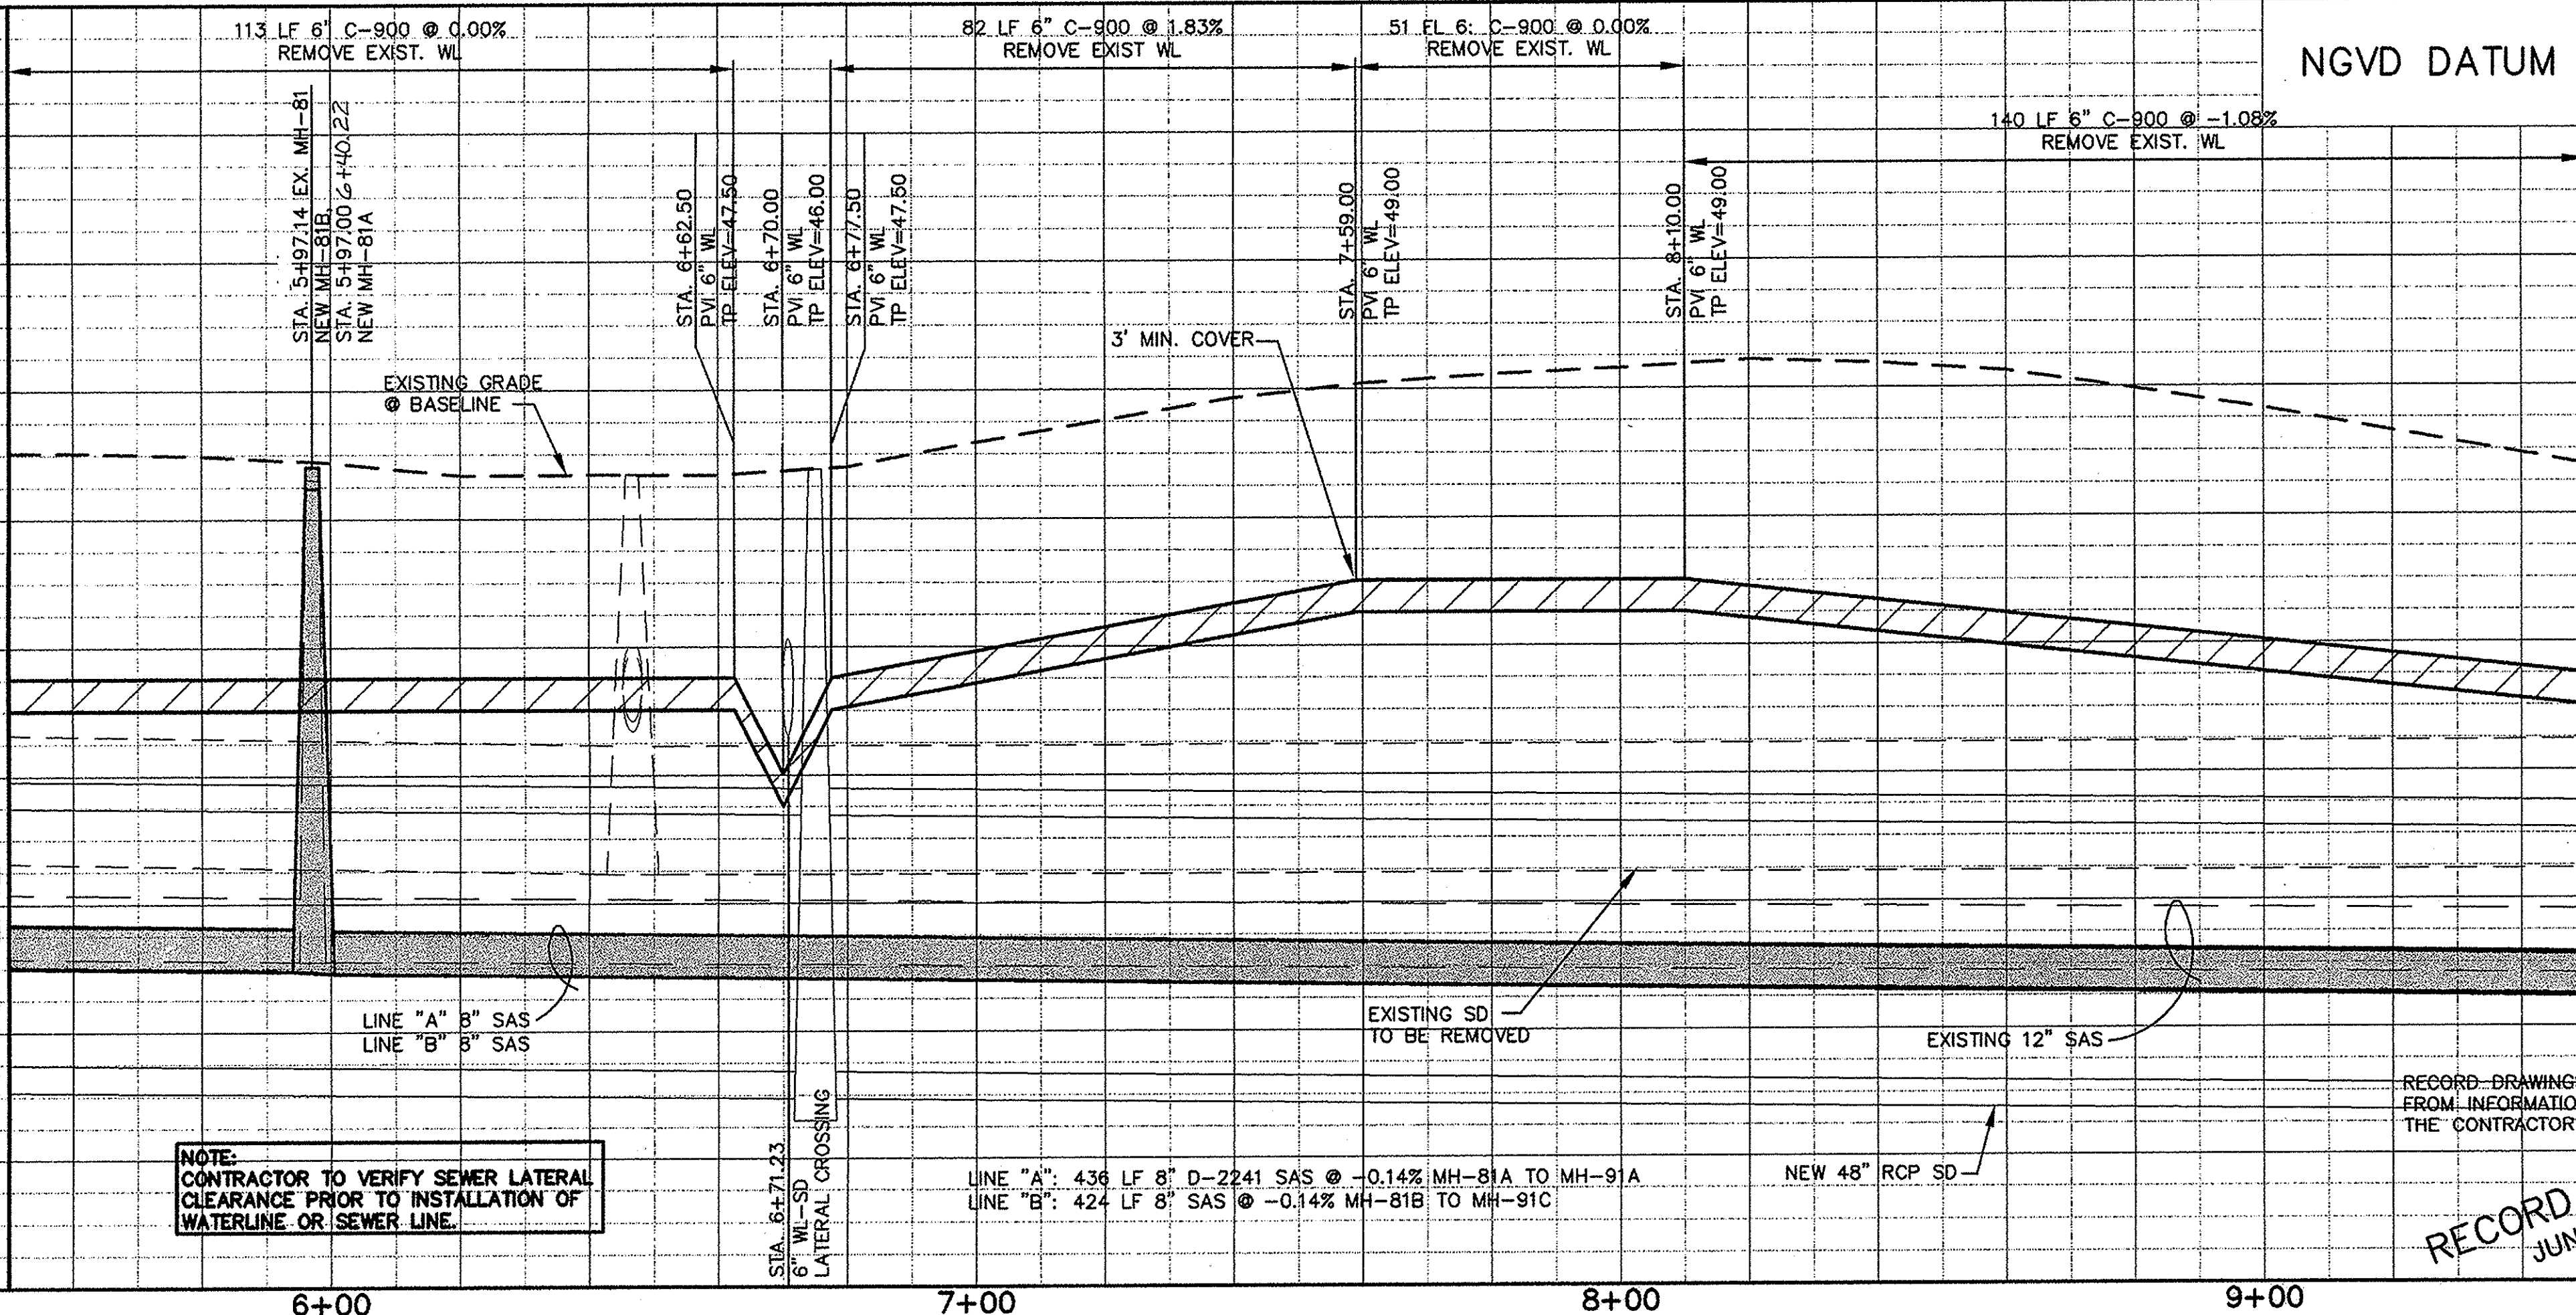

MATCH LINE STA. 9+50

NOTE:
CONTRACTOR TO VERIFY SEWER LATERAL
CLEARANCE PRIOR TO INSTALLATION OF
WATERLINE OR SEWER LINE.

LINE "A": 436 LF 8" D-2241 SAS @ -0.14% MH-81A TO MH-91A
LINE "B": 424 LF 8" SAS @ -0.14% MH-81B TO MH-91C

NEW 48" RCP SD

RECORD DRAWING
JUNE 2007