


SEE SHEET 27

STA. 9+50

MATCH LINE

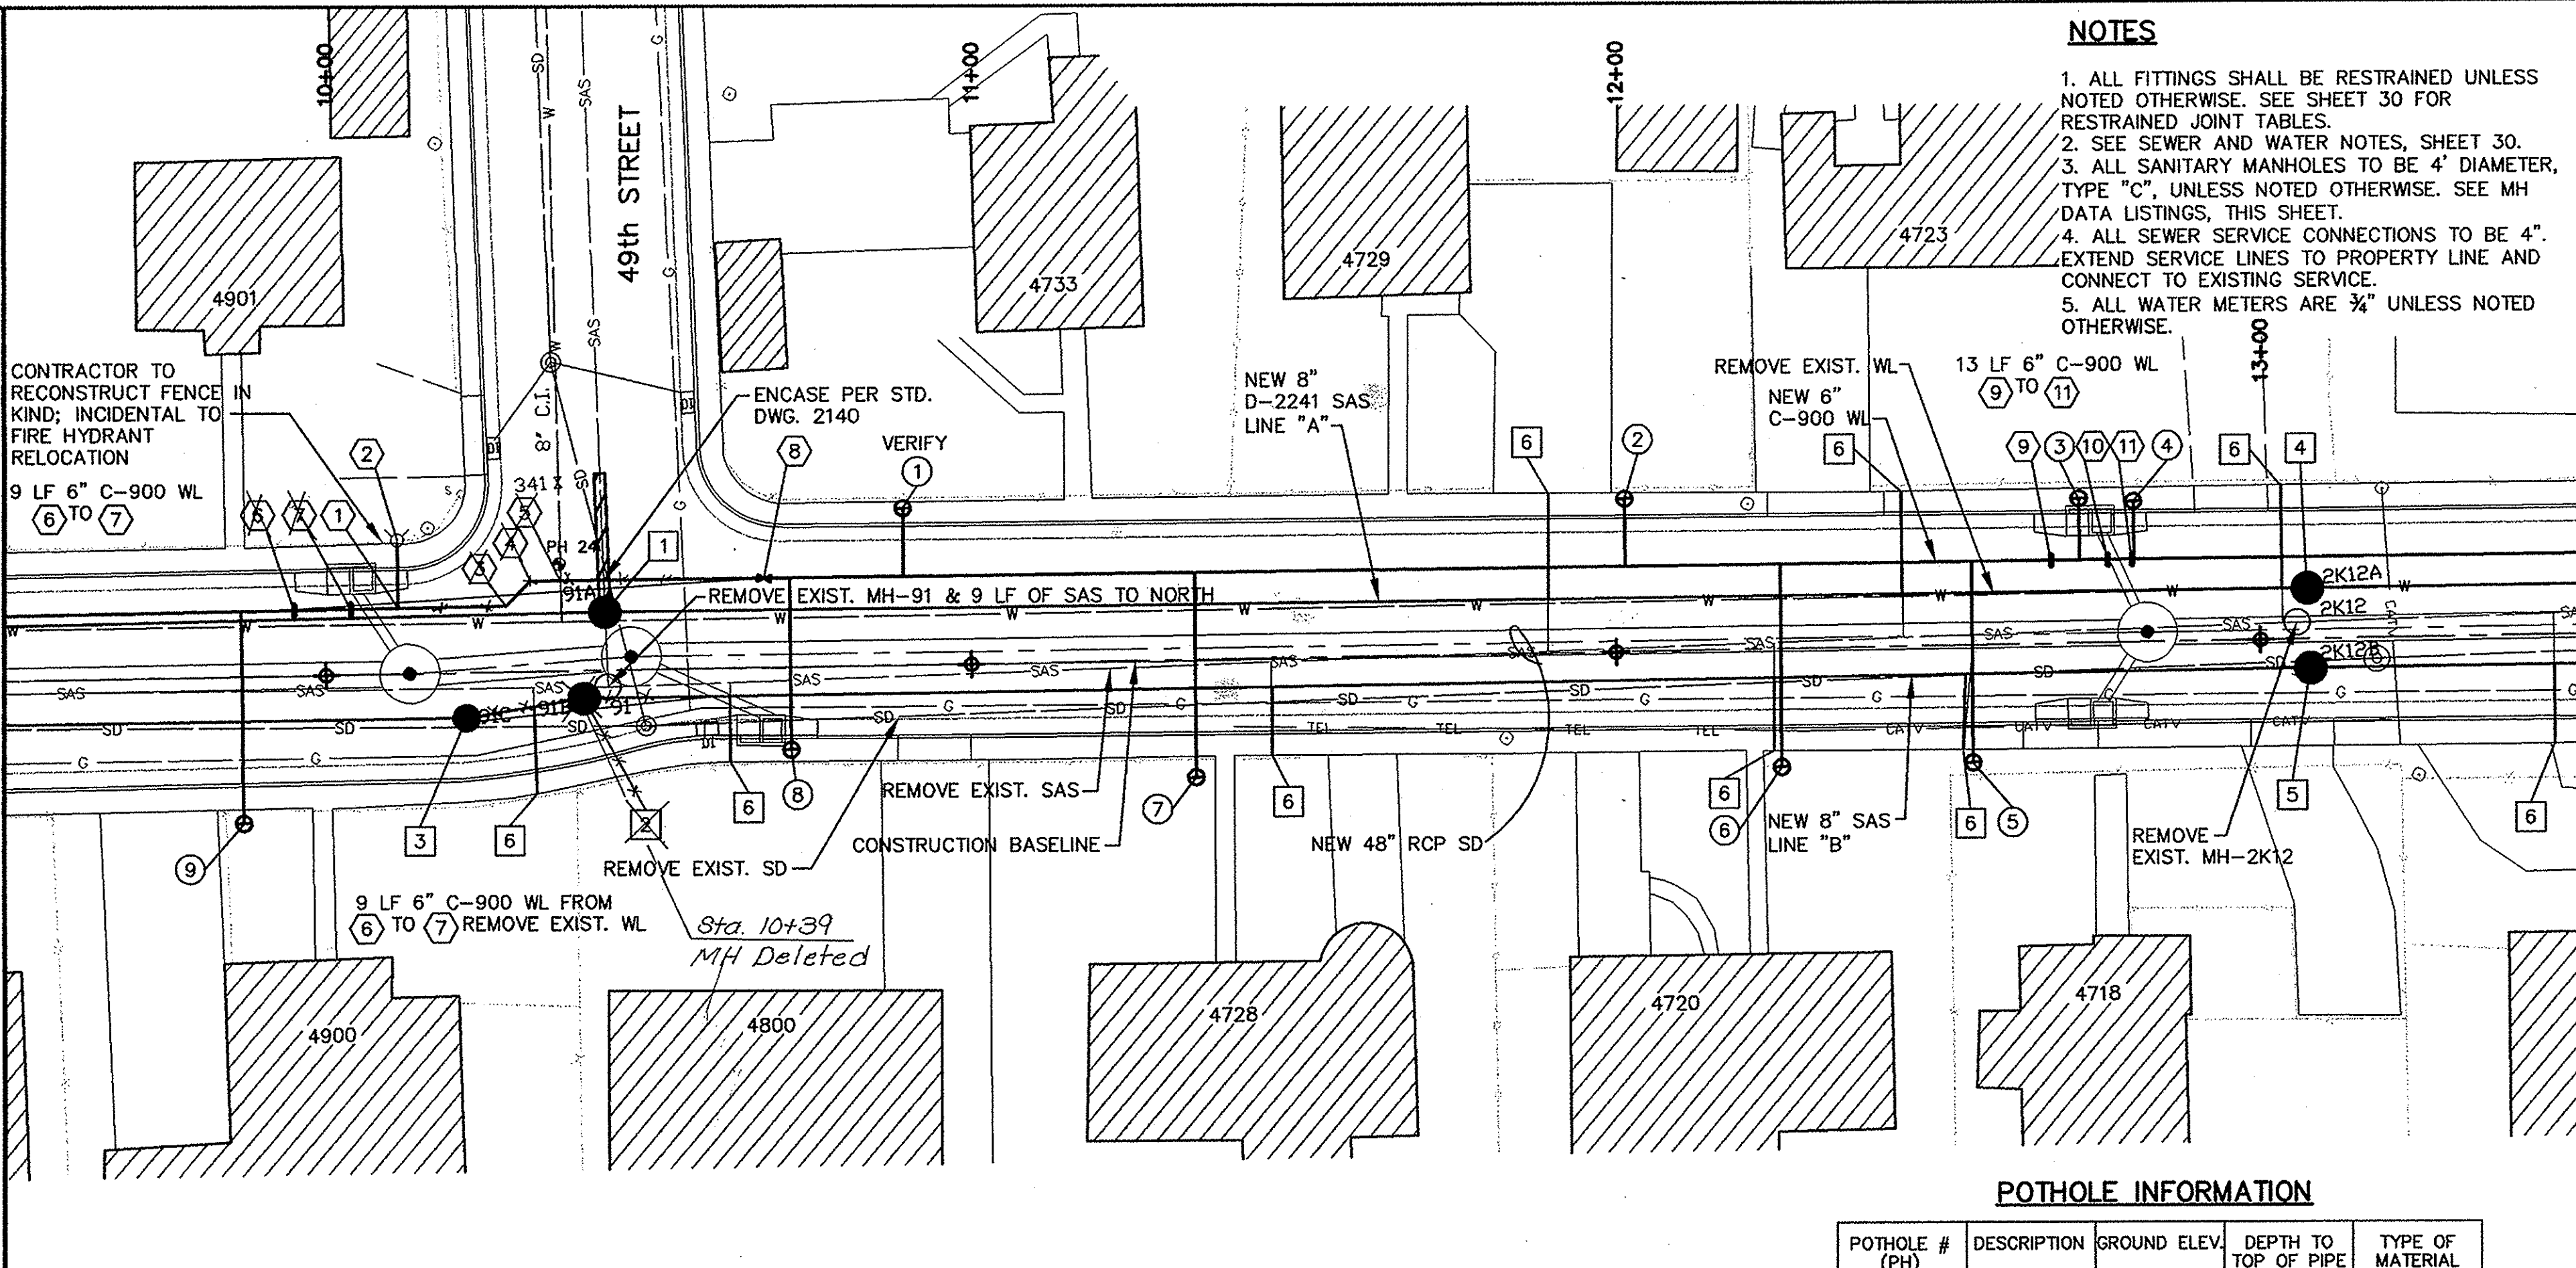

NOTES

1. ALL FITTINGS SHALL BE RESTRAINED UNLESS NOTED OTHERWISE. SEE SHEET 30 FOR RESTRAINED JOINT TABLES.
2. SEE SEWER AND WATER NOTES, SHEET 30.
3. ALL SANITARY MANHOLES TO BE 4' DIAMETER, TYPE "C", UNLESS NOTED OTHERWISE. SEE MH DATA LISTINGS, THIS SHEET.
4. ALL SEWER SERVICE CONNECTIONS TO BE 4". EXTEND SERVICE LINES TO PROPERTY LINE AND CONNECT TO EXISTING SERVICE.
5. ALL WATER METERS ARE 3/4" UNLESS NOTED OTHERWISE.

STA. 13+50

MATCH LINE

SEE SHEET 29

POTHOLE INFORMATION


| POTHOLE # | DESCRIPTION | GROUND ELEV. | DEPTH TO TOP OF PIPE | TYPE OF MATERIAL |
|-----------|-------------|--------------|----------------------|------------------|
| 24        | 8" WATER    | 49.20        | 45"                  | METALLIC         |

SCALES:  
1" = 20' HORIZ.  
1" = 2' VERT.

GLENDAL ROAD

STA. 9+50

MATCH LINE

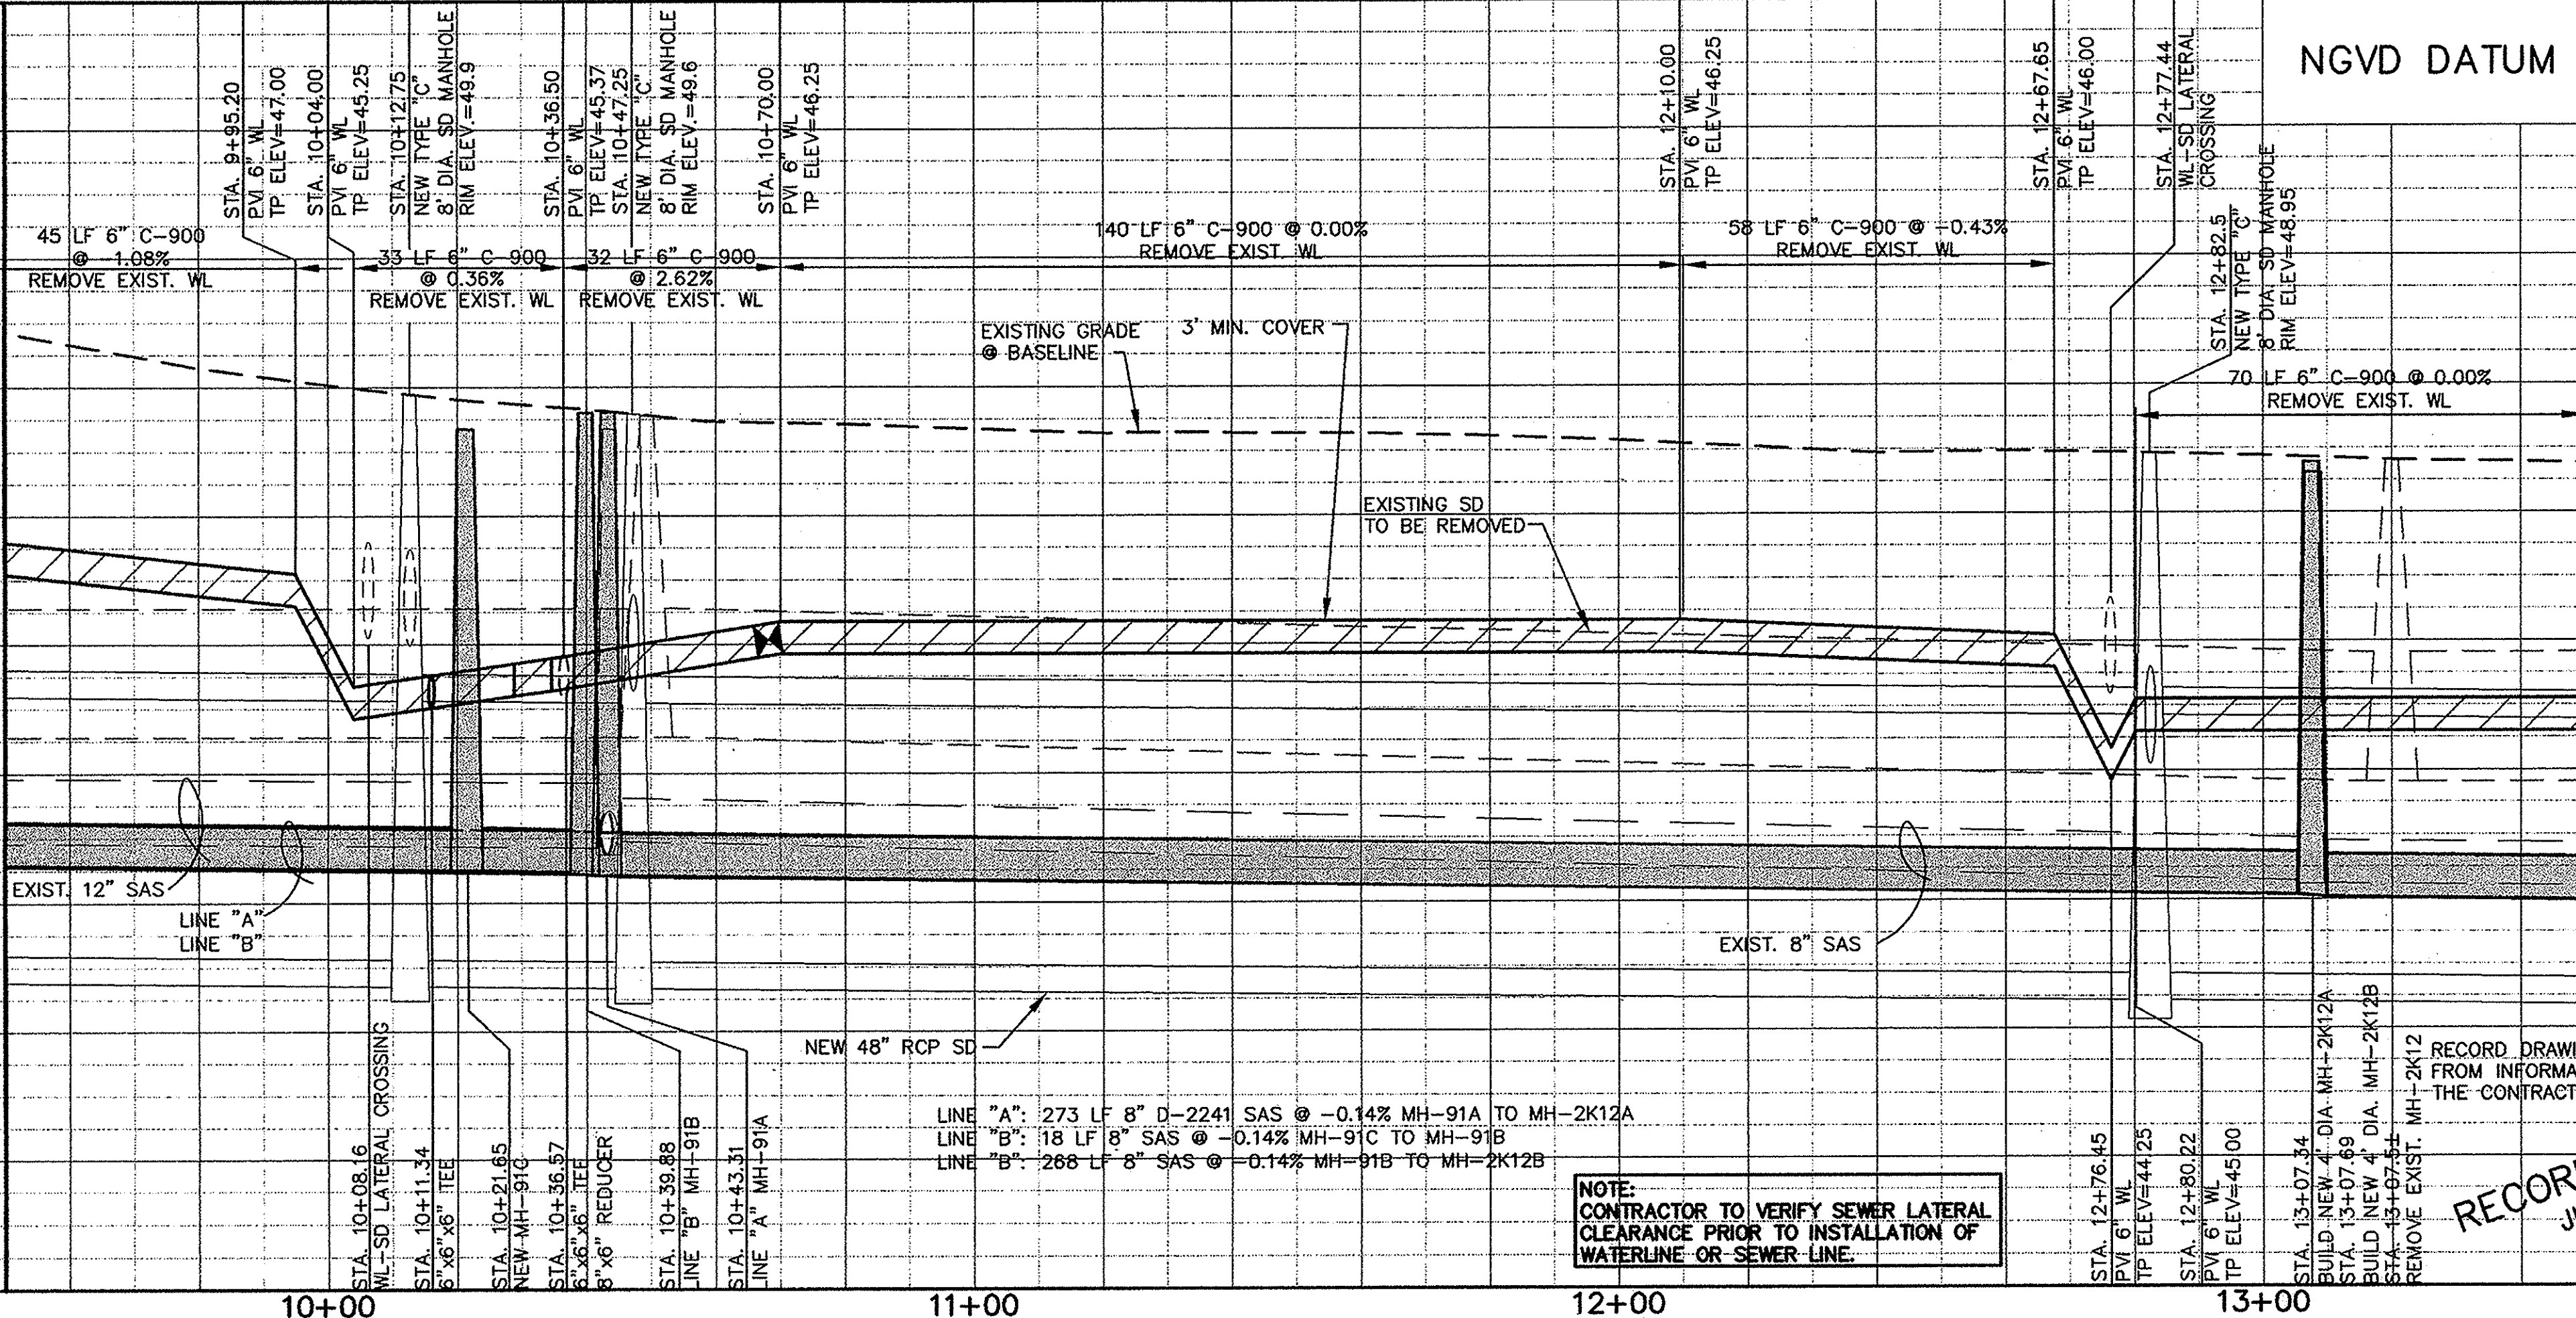

NGVD DATUM 1929

STA. 13+50

MATCH LINE

EXIST. WATER METER KEYED NOTES

- 1 STA. 10+89.71, 24.44' LT., RELOCATE
- 2 STA. 12+01.65, 23.80' LT.
- 3 STA. 12+72.10, 22.46' LT.
- 4 STA. 12+80.54, 21.86' LT.
- 5 STA. 12+55.07, 18.16' RT., RELOCATE
- 6 STA. 12+25.37, 18.27' RT.
- 7 STA. 11+34.51, 18.16' RT., RELOCATE
- 8 STA. 10+71.82, 12.74' RT.
- 9 STA. 9+87.04, 22.61' RT., RELOCATE

SAS KEYED NOTES

- 1 STA. 10+43.34, 9.08' LT. NEW 4" DIA. MH-91A
- 2 STA. 10+39.88, 4.31' RT. NEW 4" DIA. MH-91B
- 3 STA. 10+21.65, 7.90' RT. NEW 4" DIA. MH-91C
- 4 STA. 13+07.34, 7.81' LT. NEW 4" DIA. MH-2K12A
- 5 STA. 13+07.69, 4.55' RT. NEW 4" DIA. MH-2K12B
- 6 4" SEWER SERVICE CONNECTION TO PROPERTY LINE, CONTRACTOR LOCATE AND CONNECT TO EXISTING SERVICE.

WATER LINE KEYED NOTES

- 1 STA. 10+11.34, 10.21' LT. 6"x6"x6" TEE, 22.5' BEND & 9.5 LF 6" C-900 WL
- 2 STA. 10+11.32, 20.81' LT. REPLACE FIRE HYDRANT TO BEHIND SIDEWALK PER COA STD. DWG. 2340.
- 3 STA. 10+28.06, 10.24' LT. 6" WL 45' BEND
- 4 STA. 10+31.86, 14.05' LT. 6" WL 45' BEND
- 5 STA. 10+36.57, 14.03' LT. 6"x6"x6" TEE W/THRUST BLOCK PER COA STD. DWG 2320, 6"x8" REDUCER, TRANSITION COUPLING & NON-PRESSURE CONNECTION
- 6 STA. 9+95.20, 10.19' LT. 6" WL 11.25' BEND
- 7 STA. 10+04.00, 10.20' LT. 6" WL 11.25' BEND
- 8 STA. 10+68.00, 13.87' LT. 6" GATE VALVE & VALVE BOX PER COA STD. DWG. 2326 & 2328
- 9 STA. 12+67.65, 12.85' LT. PVI 6" WL 11.25' BEND
- 10 STA. 12+76.45, 12.86' LT. PVI 6" WL 45' BEND
- 11 STA. 12+80.22, 12.79' LT. PVI 6" WL 11.25' BEND

MH-91 RIM = 4949.25  
N. INV. = 4942.65  
E. INV. = 4942.85  
W. INV. = 4942.75

MH-2K12 RIM = 4948.69  
N. INV. = 4942.14  
E. INV. = 4942.85  
W. INV. = 4942.19

MH-91A RIM = 4949.52  
N. INV. = 4942.65  
E. INV. = 4942.26  
W. INV. = 4942.30

MH-2K12A RIM = 4948.68  
N. INV. = 4944.88  
E. INV. = 4944.92  
W. INV. = 4944.37

MH-91B RIM = 4949.24  
N. INV. = 4942.29  
E. INV. = 4942.33  
W. INV. = 4942.33

MH-2K12B RIM = 4948.52  
N. INV. = 4944.89  
E. INV. = 4944.93  
W. INV. = 4944.02

MH-91C RIM = 4949.25  
N. INV. = 4942.33  
E. INV. = 4942.33  
W. INV. = 4942.33

CONTRACTOR TO VERIFY MANHOLE ELEVATIONS PRIOR TO CONSTRUCTING SEWER LINE BETWEEN MANHOLES.



CITY OF ALBUQUERQUE  
DEPARTMENT OF MUNICIPAL DEVELOPMENT  
STORM DRAINAGE DESIGN DIVISION

TITLE: CENTRAL - ATRISCO DRAINAGE IMPROVEMENTS PHASE II  
WATER & SANITARY SEWER GLENDAL ROAD STA 9+50 TO 13+50

|                 |                  |                 |                  |
|-----------------|------------------|-----------------|------------------|
| DESIGNED BY: XX | DATE: 06/08/2006 | REVIEWED BY: XX | DATE: 06/08/2006 |
| DRAWN BY: XX    | DATE: 06/08/2006 | CHECKED BY: XX  | DATE: 06/08/2006 |

Project No. 674903 Zone Map No. K-11-Z Sheet 28 OF 32