


CONSTRUCTION PLANS FOR CENTRAL-ATRISCO DRAINAGE IMPROVEMENTS PHASE III

C.O.A. PROJECT NO. 6749.04

INDEX OF SHEETS

DESCRIPTION	SHEET NO.
TITLE SHEET, VICINITY MAP & INDEX	1
GENERAL NOTES	2
STORM DRAIN PLAN & PROFILE SHEETS	
GLENDALE ROAD, STA. 10+00 TO STA. 13+50	3
GLENDALE ROAD, STA. 13+50 TO STA. 16+24.98 (CL 53rd St.)	4
51st STREET, STA. 20+25.96 (CL GLENDALE RD.) TO STA. 23+50	5
51st STREET, STA. 23+50 TO STA. 26+50 (CL RINCON RD.)	6
53rd STREET, STA. 30+16.96 (CL GLENDALE RD.) TO STA. 33+00	7
GLENDALE ROAD AND ARENAL CANAL CROSSING	
REMOVAL PLAN AND PLAN & PROFILE	8
STRUCTURE PLAN & PROFILE	9
BOX CULVERT HEADWALL DETAILS	10
MISCELLANEOUS DETAILS & TYPICAL STREET SECTION	11
WATER SHUT OFF PLAN	12
NMDOT BOX CULVERT	
STRUCTURAL SECTIONS & REBAR	13
DIMENSIONS & REBAR SCHEDULE	14

CITY OF ALBUQUERQUE NEW MEXICO

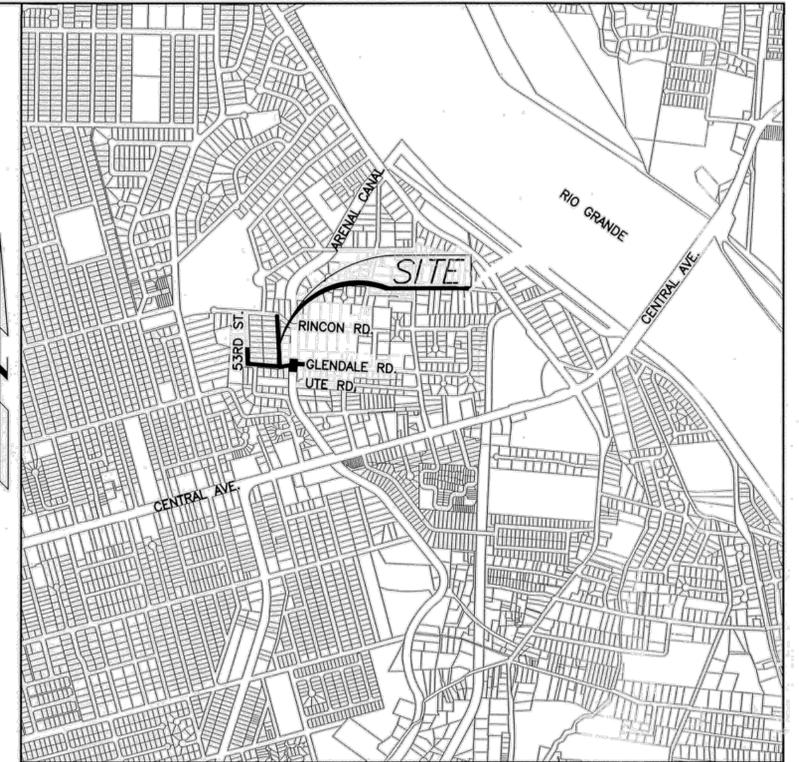

LOCATION MAP

ZONE ATLAS MAP K-11 & J-11
SCALE: 1"=1000'±

UTILITY CONTACTS

**PUBLIC SERVICE COMPANY
OF NEW MEXICO (PNM)-ELECTRIC**
ANDREA CONTRERAS
505-241-3666
Andrea.Contreras@pnm.com

QWEST COMMUNICATIONS
dba CENTURY LINK-TELEPHONE
ABDUL A. BHUIYAN
505-245-6996
Abdul.Bhuiyan2@CenturyLink.com

COMCAST-CABLE
MIKE MORTUS
505-271-3644
mike_mortus@cable.comcast.com

NEW MEXICO GAS COMPANY
ROB SMITH
505-697-3169
Robert.Smith@nmgco.com

JAMES ARAGON
James.Aragon@CenturyLink.com

RITA JARAMILLO
505-245-8352
Rita.Jaramillo@CenturyLink.com

NEW MEXICO ONE CALL, INC.
IN ALBUQUERQUE: 260-1990
STATEWIDE: 800-321-2537

ABCWUA
JOHN P. GABALDON, P.E.
505-289-3086
jgabaldon@abcwua.org

JOHN MELENDEZ
505-245-6124
John.Melendrez@CenturyLink.com

I, JOHN A. ANDREWS, P.E., CERTIFY THAT THIS ELECTRONIC VERSION IS IDENTICAL TO THE ORIGINAL REPRODUCIBLE RECORD DRAWING.

RECORD DRAWINGS WERE PREPARED FROM INFORMATION PROVIDED BY THE CONTRACTOR

APPROVAL OF RECORD DRAWINGS

THIS SET OF DRAWINGS IS ACCEPTED FOR RECORD PURPOSES BY:

BY: City of Albuquerque

DATE

BY: ABCWUA

DATE

RECORD DRAWING
APRIL 2017

LARKIN GROUP NM, INC.
CONSULTING ENGINEERS AND SURVEYORS
8500 MENAUL BLVD. NE SUITE A-440
ALBUQUERQUE, NEW MEXICO 87112
(505) 275-7500 FAX (505) 275-0748
www.larkinm.com ENGINEER'S FILE #2002-0021-18

BID SET NUMBER

REV.	SHEETS	CITY ENGINEER	DATE	USER DEPARTMENT	DATE	USER DEPARTMENT	DATE
ENGINEER'S STAMP & SIGNATURE		APPROVALS	ENGINEER	DATE	*****		
		DRC Chairman	<i>John A. Andrews</i>	8-18-15	APPROVED FOR CONSTRUCTION		
		Transportation	<i>John A. Andrews</i>	6-11-15			
		Water/Wastewater	<i>John A. Andrews</i>	6-11-15			
		Hydrology	<i>John A. Andrews</i>	6-11-15			
		Constr. Coord.	<i>John A. Andrews</i>	6-11-15			
					 City Engineer Date 8/26/15		
		City Project No.		Sheet	of		
			6749.04	1	14		

8-18-15 JA