


144 40TH STREET SOUTHWEST TRAFFIC IMPROVEMENTS FOR CITY OF ALBUQUERQUE TRANSPORTATION DEPARTMENT

PROJECT:
ATRISCO LOFTS APARTMENTS
CITY OF ALBUQUERQUE,
BERNALILLO COUNTY,
NEW MEXICO

144 40TH ST. S.W.




For more current information and details visit: www.cabq.gov/gis

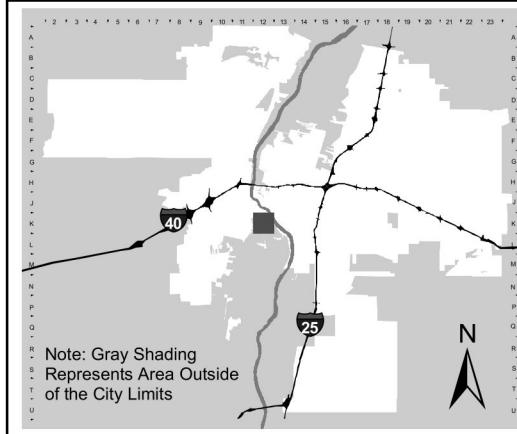

Address Map Page:


K-12-Z

Map Amended through:
3/17/2017

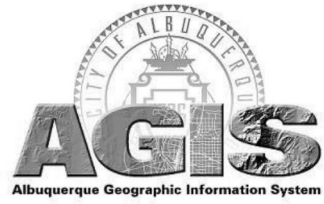


These addresses are for informational purposes only and are not intended for address verification.

K-12-Z VICINITY MAP - NTS

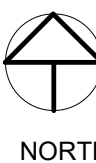


SHEET KEYNOTES CIVIL105

1. CLEAR SITE TRIANGLE
2. SAWCUT, REMOVE EXISTING GUTTER AND INSTALL STANDARD CURB & GUTTER PER COA STD DWG 2015A
3. EXISTING CURB & GUTTER - ADD 6" SIDEWALK AT BACK OF CURB PER COA STD # 2430 - REPAIR 90 FEET +/- EXISTING CURB AND GUTTER PER COA STD 2415A AS NECESSARY
4. CONSTRUCT STANDARD CURB & GUTTER
5. NO EXISTING CURB, GUTTER OR SIDEWALK NORTH OF PROPERTY LINE - STOP NEW WORK AT PROPERTY LINE
6. TAPER CONCRETE CURB DOWN AT ACCESS SIDEWALK
7. 4' WIDE ADA ACCESSIBLE ROUTE AT DRIVEPAD 2% MAX SIDE SLOPE

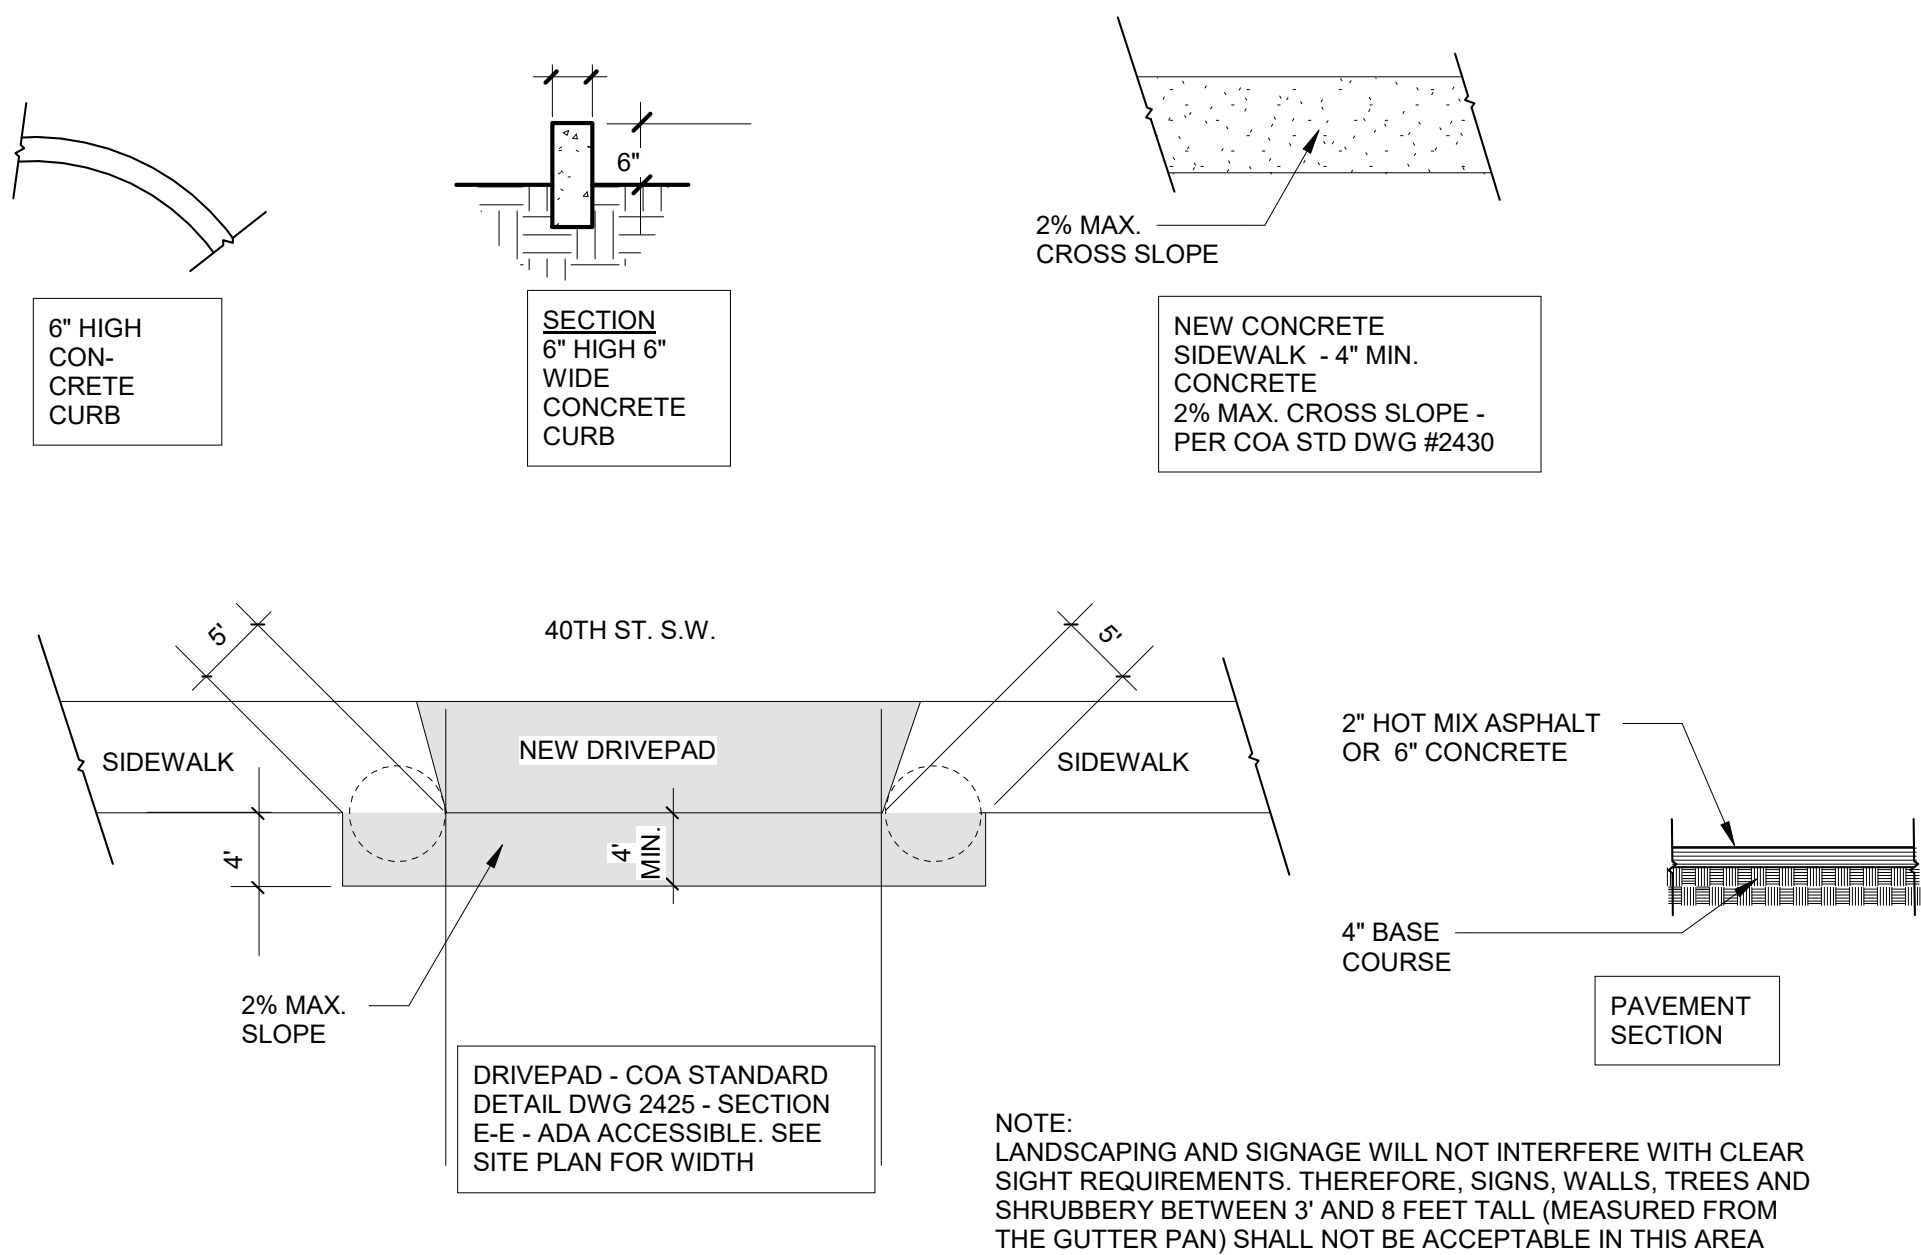


40TH STREET SW FRONTAGE IMPROVEMENTS LEGEND

- NOTES:
1. ALL BROKEN OR CRACKED SIDEWALK, CURB AND GUTTER MUST BE REPLACED AS PER COA STD DWG #2415A & #2430.
 2. SEE 40TH ST. S.W. FRONTAGE IMPROVEMENTS LEGEND THIS SHEET FOR COA STD DRIVEPAD, CURBS, SIDEWALKS AND PAVEMENT SECTION DETAILS
 3. ALL WHEELCHAIR RAMPS LOCATED WITHIN THE PUBLIC RIGHT OF WAY MUST HAVE TRUNCATED DOME WARNING STRIPS
 4. CITY WORK ORDER NOT REQUIRED - DRIVEPAD ACCESSIBLE SIDEWALK WILL BE BUILT UNDER BUILDING PERMIT
 5. ALL IMPROVEMENTS, IF ANY, LOCATED IN THE RIGHT OF WAY MUST BE INCLUDED IN A CITY WORK ORDER, IF APPLICABLE.

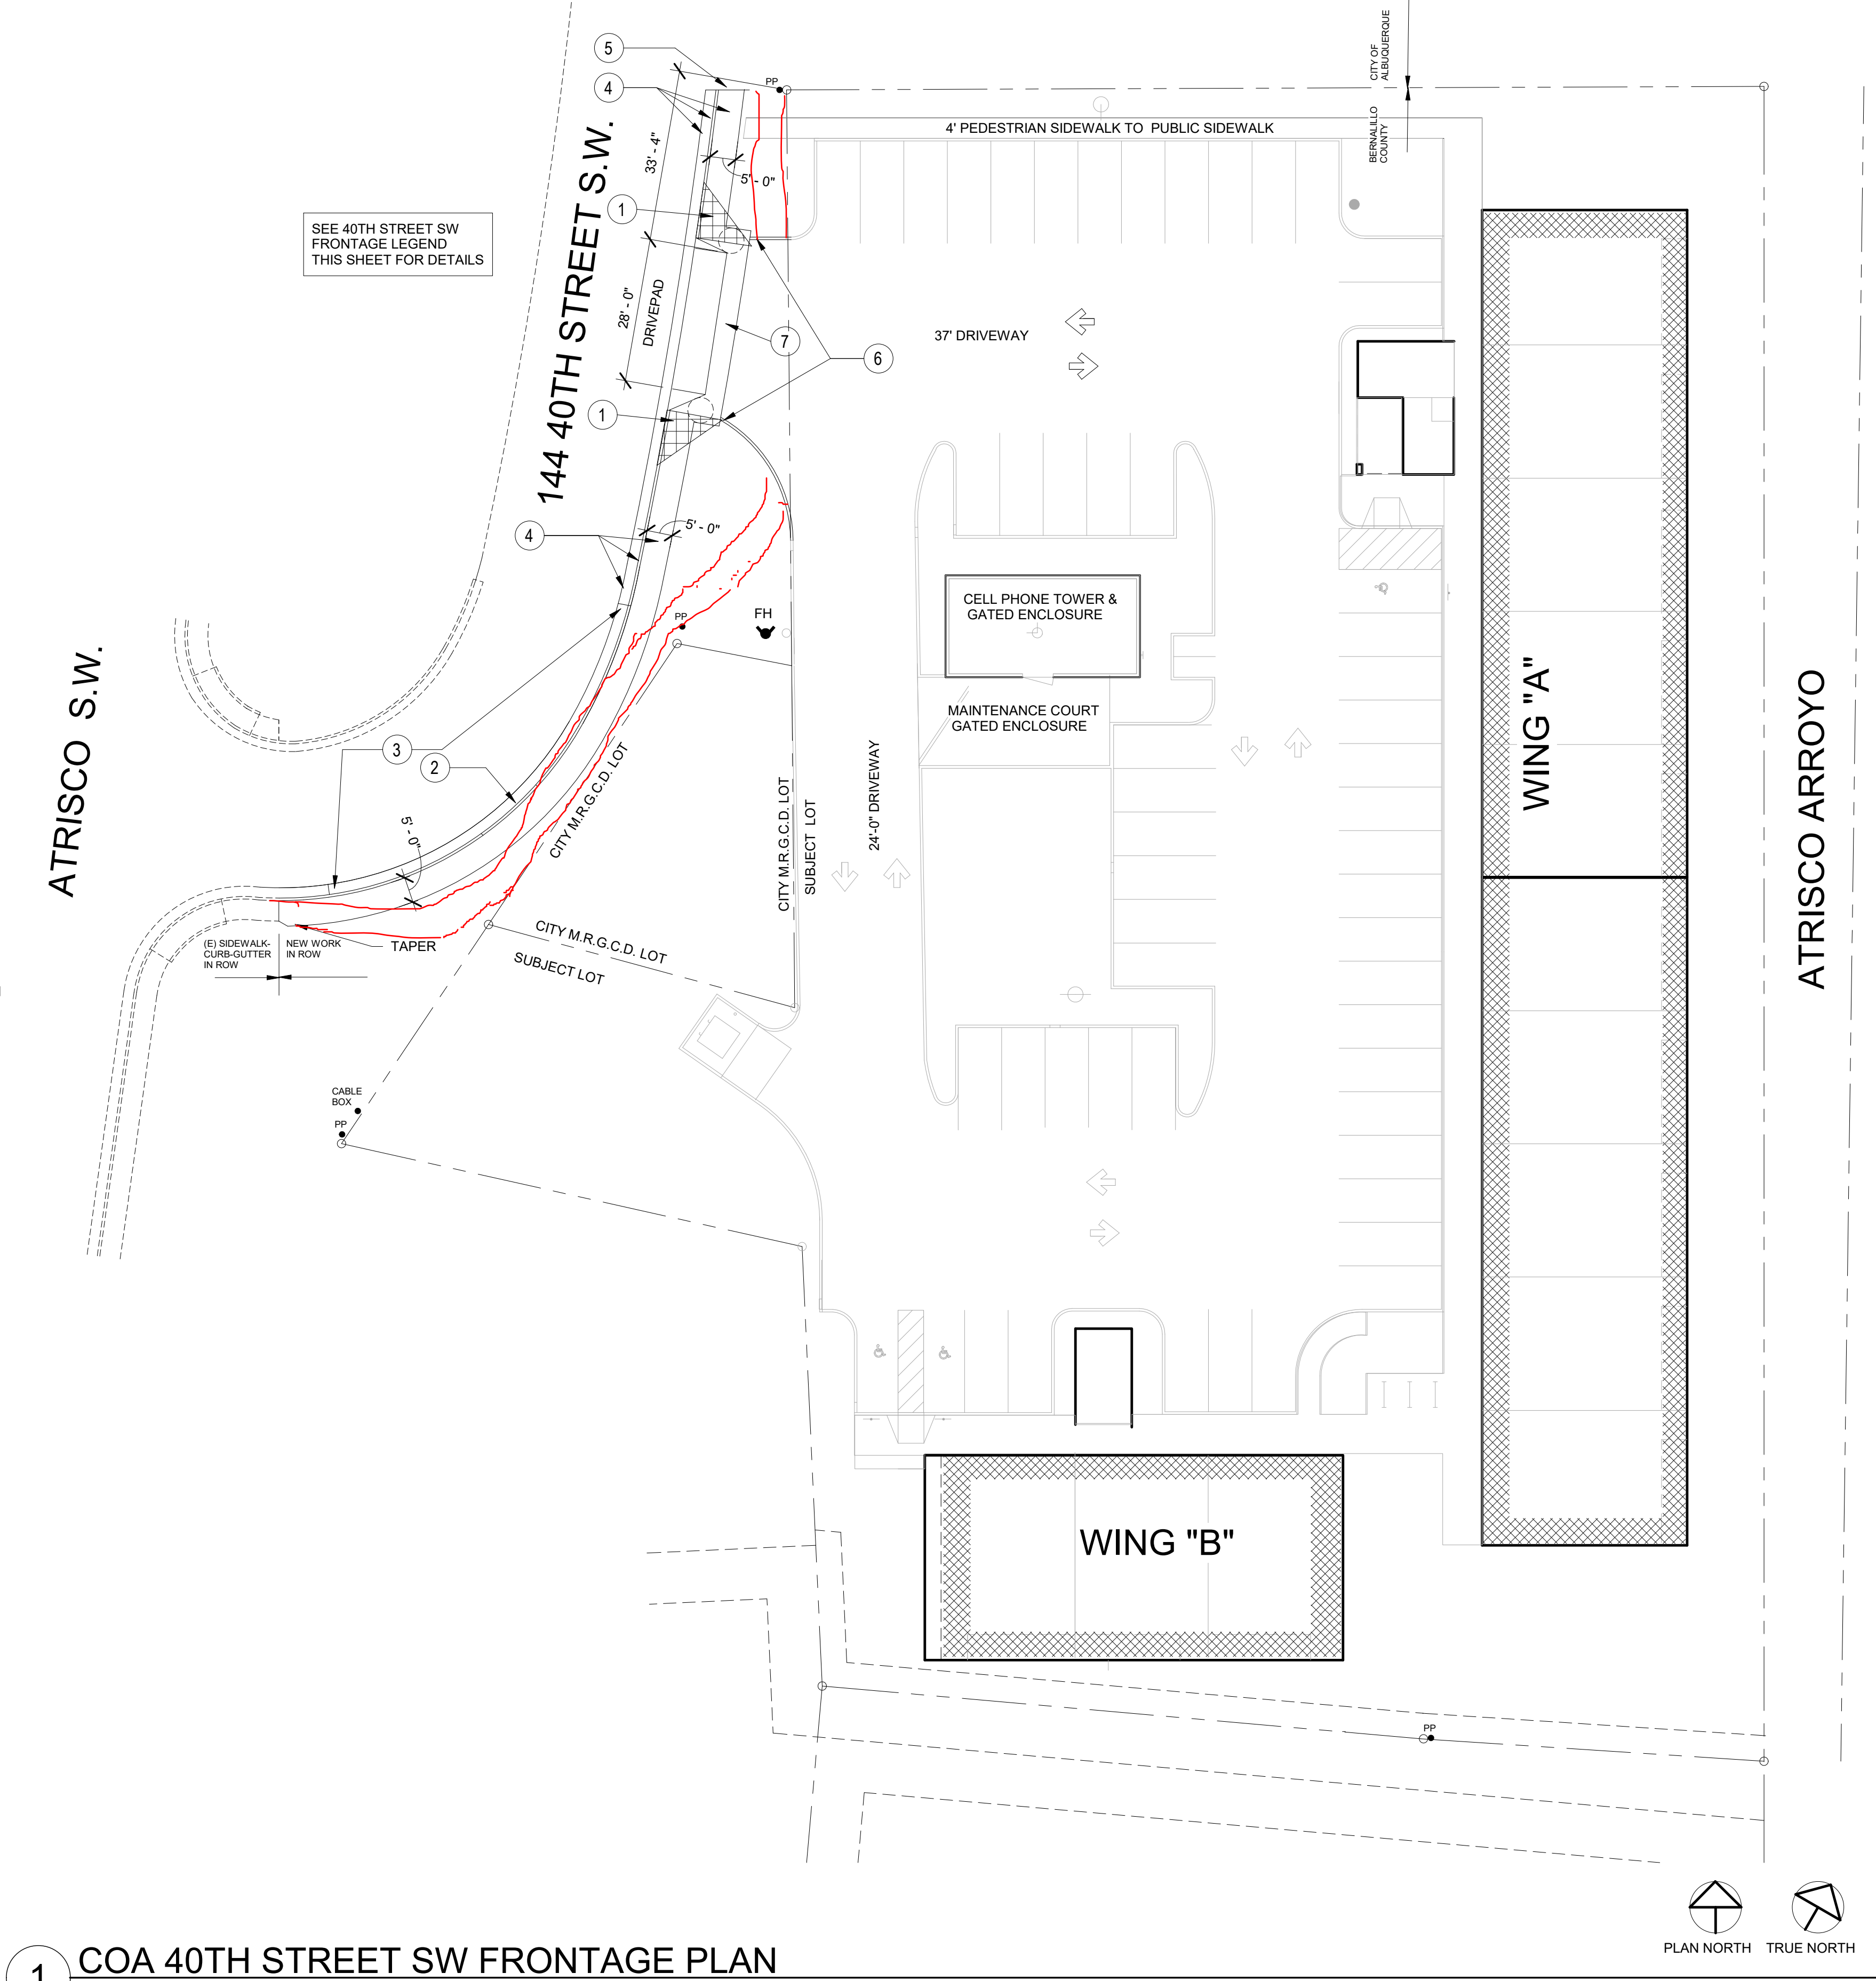

1 COA 40TH STREET SW FRONTAGE PLAN
Scale: 1" = 20'-0"

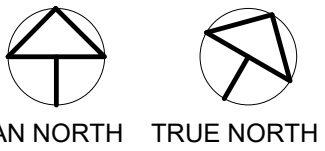

Cinelli /
ARCHITECTS
2418 Manuel Torres Lane N.W.
Albuquerque, New Mexico 87107
(505) 243-8211

PROJECT TITLE:
ATRISCO LOFTS APARTMENTS
144 40TH ST. S.W.
ALBUQUERQUE, N.M.

DRAWING TITLE:
**40TH STREET FRONTAGE
IMPROVEMENTS PLAN**

DATE: JAN 2024 PROJECT NO.: BIA26
DRAWING NO.:



CIVIL105