

# CITY OF ALBUQUERQUE



June 21, 2016

David Soule, PE  
Rio Grande Engineering  
1606 Central SE Suite 201  
Albuquerque, NM 87106

**Re: Coal Townhomes**  
**714 Coal Ave. SW**  
**6 Requested for Permanent C. O. - Accepted**  
**Engineers Stamp Date 5/27/15 (K13D073)**  
**Certification dated: 5-27-16**

Dear Mr. Soule,

Based on the Certification received 5/27/2016, the site is acceptable for release of Certificate of Occupancy by Hydrology.

PO Box 1293

If you have any questions, you can contact me at 924-3986 or Totten Elliott at 924-3982.

Albuquerque

Sincerely,

New Mexico 87103

Rita Harmon, P.E.  
Senior Engineer, Planning Dept.  
Development Review Services

www.cabq.gov

TE/RQH  
C: email

Cordova, Camille C.; Miranda, Rachel; Sandoval, Darlene M.; Blocker,  
Lois



# City of Albuquerque

Planning Department

Development & Building Services Division

## DRAINAGE AND TRANSPORTATION INFORMATION SHEET

(REV 02/2013)

Project Title: \_\_\_\_\_ Building Permit #: \_\_\_\_\_ City Drainage #: \_\_\_\_\_

DRB#: \_\_\_\_\_ EPC#: \_\_\_\_\_ Work Order#: \_\_\_\_\_

Legal Description: \_\_\_\_\_

City Address: \_\_\_\_\_

**Engineering Firm:** \_\_\_\_\_ Contact: \_\_\_\_\_

Address: \_\_\_\_\_

Phone#: \_\_\_\_\_ Fax#: \_\_\_\_\_ E-mail: \_\_\_\_\_

**Owner:** \_\_\_\_\_ Contact: \_\_\_\_\_

Address: \_\_\_\_\_

Phone#: \_\_\_\_\_ Fax#: \_\_\_\_\_ E-mail: \_\_\_\_\_

**Architect:** \_\_\_\_\_ Contact: \_\_\_\_\_

Address: \_\_\_\_\_

Phone#: \_\_\_\_\_ Fax#: \_\_\_\_\_ E-mail: \_\_\_\_\_

**Surveyor:** \_\_\_\_\_ Contact: \_\_\_\_\_

Address: \_\_\_\_\_

Phone#: \_\_\_\_\_ Fax#: \_\_\_\_\_ E-mail: \_\_\_\_\_

**Contractor:** \_\_\_\_\_ Contact: \_\_\_\_\_

Address: \_\_\_\_\_

Phone#: \_\_\_\_\_ Fax#: \_\_\_\_\_ E-mail: \_\_\_\_\_

### TYPE OF SUBMITTAL:

- DRAINAGE REPORT
- DRAINAGE PLAN 1st SUBMITTAL
- DRAINAGE PLAN RESUBMITTAL
- CONCEPTUAL G & D PLAN
- GRADING PLAN
- EROSION & SEDIMENT CONTROL PLAN (ESC)
- ENGINEER'S CERT (HYDROLOGY)
- CLOMR/LOMR
- TRAFFIC CIRCULATION LAYOUT (TCL)
- ENGINEER'S CERT (TCL)
- ENGINEER'S CERT (DRB SITE PLAN)
- ENGINEER'S CERT (ESC)
- SO-19
- OTHER (SPECIFY)

### CHECK TYPE OF APPROVAL/ACCEPTANCE SOUGHT:

- SIA/FINANCIAL GUARANTEE RELEASE
- PRELIMINARY PLAT APPROVAL
- S. DEV. PLAN FOR SUB'D APPROVAL
- S. DEV. FOR BLDG. PERMIT APPROVAL
- SECTOR PLAN APPROVAL
- FINAL PLAT APPROVAL
- CERTIFICATE OF OCCUPANCY (PERM)
- CERTIFICATE OF OCCUPANCY (TCL TEMP)
- FOUNDATION PERMIT APPROVAL
- BUILDING PERMIT APPROVAL
- GRADING PERMIT APPROVAL
- PAVING PERMIT APPROVAL
- WORK ORDER APPROVAL
- GRADING CERTIFICATION
- SO-19 APPROVAL
- ESC PERMIT APPROVAL
- ESC CERT. ACCEPTANCE
- OTHER (SPECIFY)

WAS A PRE-DESIGN CONFERENCE ATTENDED: \_\_\_\_\_ Yes \_\_\_\_\_ No \_\_\_\_\_ Copy Provided

DATE SUBMITTED: \_\_\_\_\_ By: \_\_\_\_\_

Requests for approvals of Site Development Plans and/or Subdivision Plats shall be accompanied by a drainage submittal. The particular nature, location, and scope to the proposed development defines the degree of drainage detail. One or more of the following levels of submittal may be required based on the following:

1. **Conceptual Grading and Drainage Plan:** Required for approval of Site Development Plans greater than five (5) acres and Sector Plans
2. **Drainage Plans:** Required for building permits, grading permits, paving permits and site plans less than five (5) acres
3. **Drainage Report:** Required for subdivision containing more than ten (10) lots or constituting five (5) acres or more
4. **Erosion and Sediment Control Plan:** Required for any new development and redevelopment site with 1-acre or more of land disturbing area, including project less than 1-acre that are part of a larger common plan of development

**Weighted E Method**  
LOT 8-A RAYNOLDS ADDITION

Basin	Area (sf)	Area (acres)	Treatment A %	Treatment B %	Treatment C %	Treatment D %	100-Year, 6-hr. Weighted E (ac-ft)	Volume (ac-ft)	Flow cfs
EXISTING	4970	0.114	0%	100.0%	0.114	0.0%	0.000	0.782	0.26
PROPOSED	4970	0.114	0%	33.0%	0.038	15.0%	0.01711	5.2%	0.009
IMPERVIOUS TO TRENCH	1740	0.040	0%	0.0%	0.000	0.0%	0	100%	0.040
DISCHARGE LESS HARVEST ALLOWABLE DISCHARGE	3230	0.074	0%	51.2%	0.038	23.1%	0.01711	26%	0.019
<b>Equation:</b>									
Weighted E = Ea* <i>A</i> a + Eb* <i>A</i> b + Ec* <i>A</i> c + Ed* <i>A</i> d / (Total Area)									
Volume = Weighted E * Total Area							FIRST FLUSH VOLUME=	73 CF	
							VOLUME	315 CF	
Flow = Qa * <i>A</i> a + Qb * <i>A</i> b + Qc * <i>A</i> c + Qd * <i>A</i> d									
Where for 100-year, 6-hour storm (zone 2)							VOLUME GENERATED FROM IMPERVIOUS CONTRIBUTING TO TRENCH	307.4 CF	
Ea= 0.53	Qa= 1.57								
Eb= 0.78	Qb= 2.28								
Ec= 1.13	Qc= 3.14								
Ed= 2.12	Qd= 4.7								

**BIOSWALE-HARVEST VOLUM**  
AREA OF PORE (DIA)  
AREA OF GRANULAR FILL  
LENGTH-115'

1.77  
3.25F 30% VOIDS 0.97CF/FT  
315.1 CUBIC FEET

NARRATIVE  
THIS IS A REDEVELOPMENT OF AN INFILL LOT. THIS LOT WAS FULLY DEVELOPED IN THE PAST. WE ARE PROPOSING A BIOSWALE/HARVEST TRENCH TO RETAIN THE FLOW G... FROM THE ROOF AND IMPERVIOUS AREA AROUND HOUSE. THE REMAINING SITE WILL FREE DISCHARGE AT 23CF/S WHICH IS LESS THAN THE .31 CFS ALLOWED (2.75CFS PER...

Plastic barrels filled with cobbles below canals

4" Schedule 40 PVC pipe from buried plastic barrels, filled with cobbles, to infiltrators

10 nds ads high capacity arc 34"wx60"x16h" leaching chamber, each with 101 gallon storage capacity buried 46" 135 CF PROVIDED

3"x12" swale for runoff

13 nds ads high capacity arc 34"wx60"x16h" leaching chamber, each with 101 gallon storage capacity buried 46" 175.5 CF PROVIDED

3"x12" swale for runoff

EXISTING CMU WALL


3"x12" swale for runoff

BUILD 95 LF BIO-SWALE

WATER HARVEST GALLERY  
SEE DETAIL THIS SHEET

30" WIDE X 2' DEEP TRENCH FILLED WITH CRUSHED ANGULAR rock 3/4-2" average size, install 18" hdpe perforated pipe. trench lined with filter fabric all sides



BIO SWALE/  
WATER HARVEST GALLERY

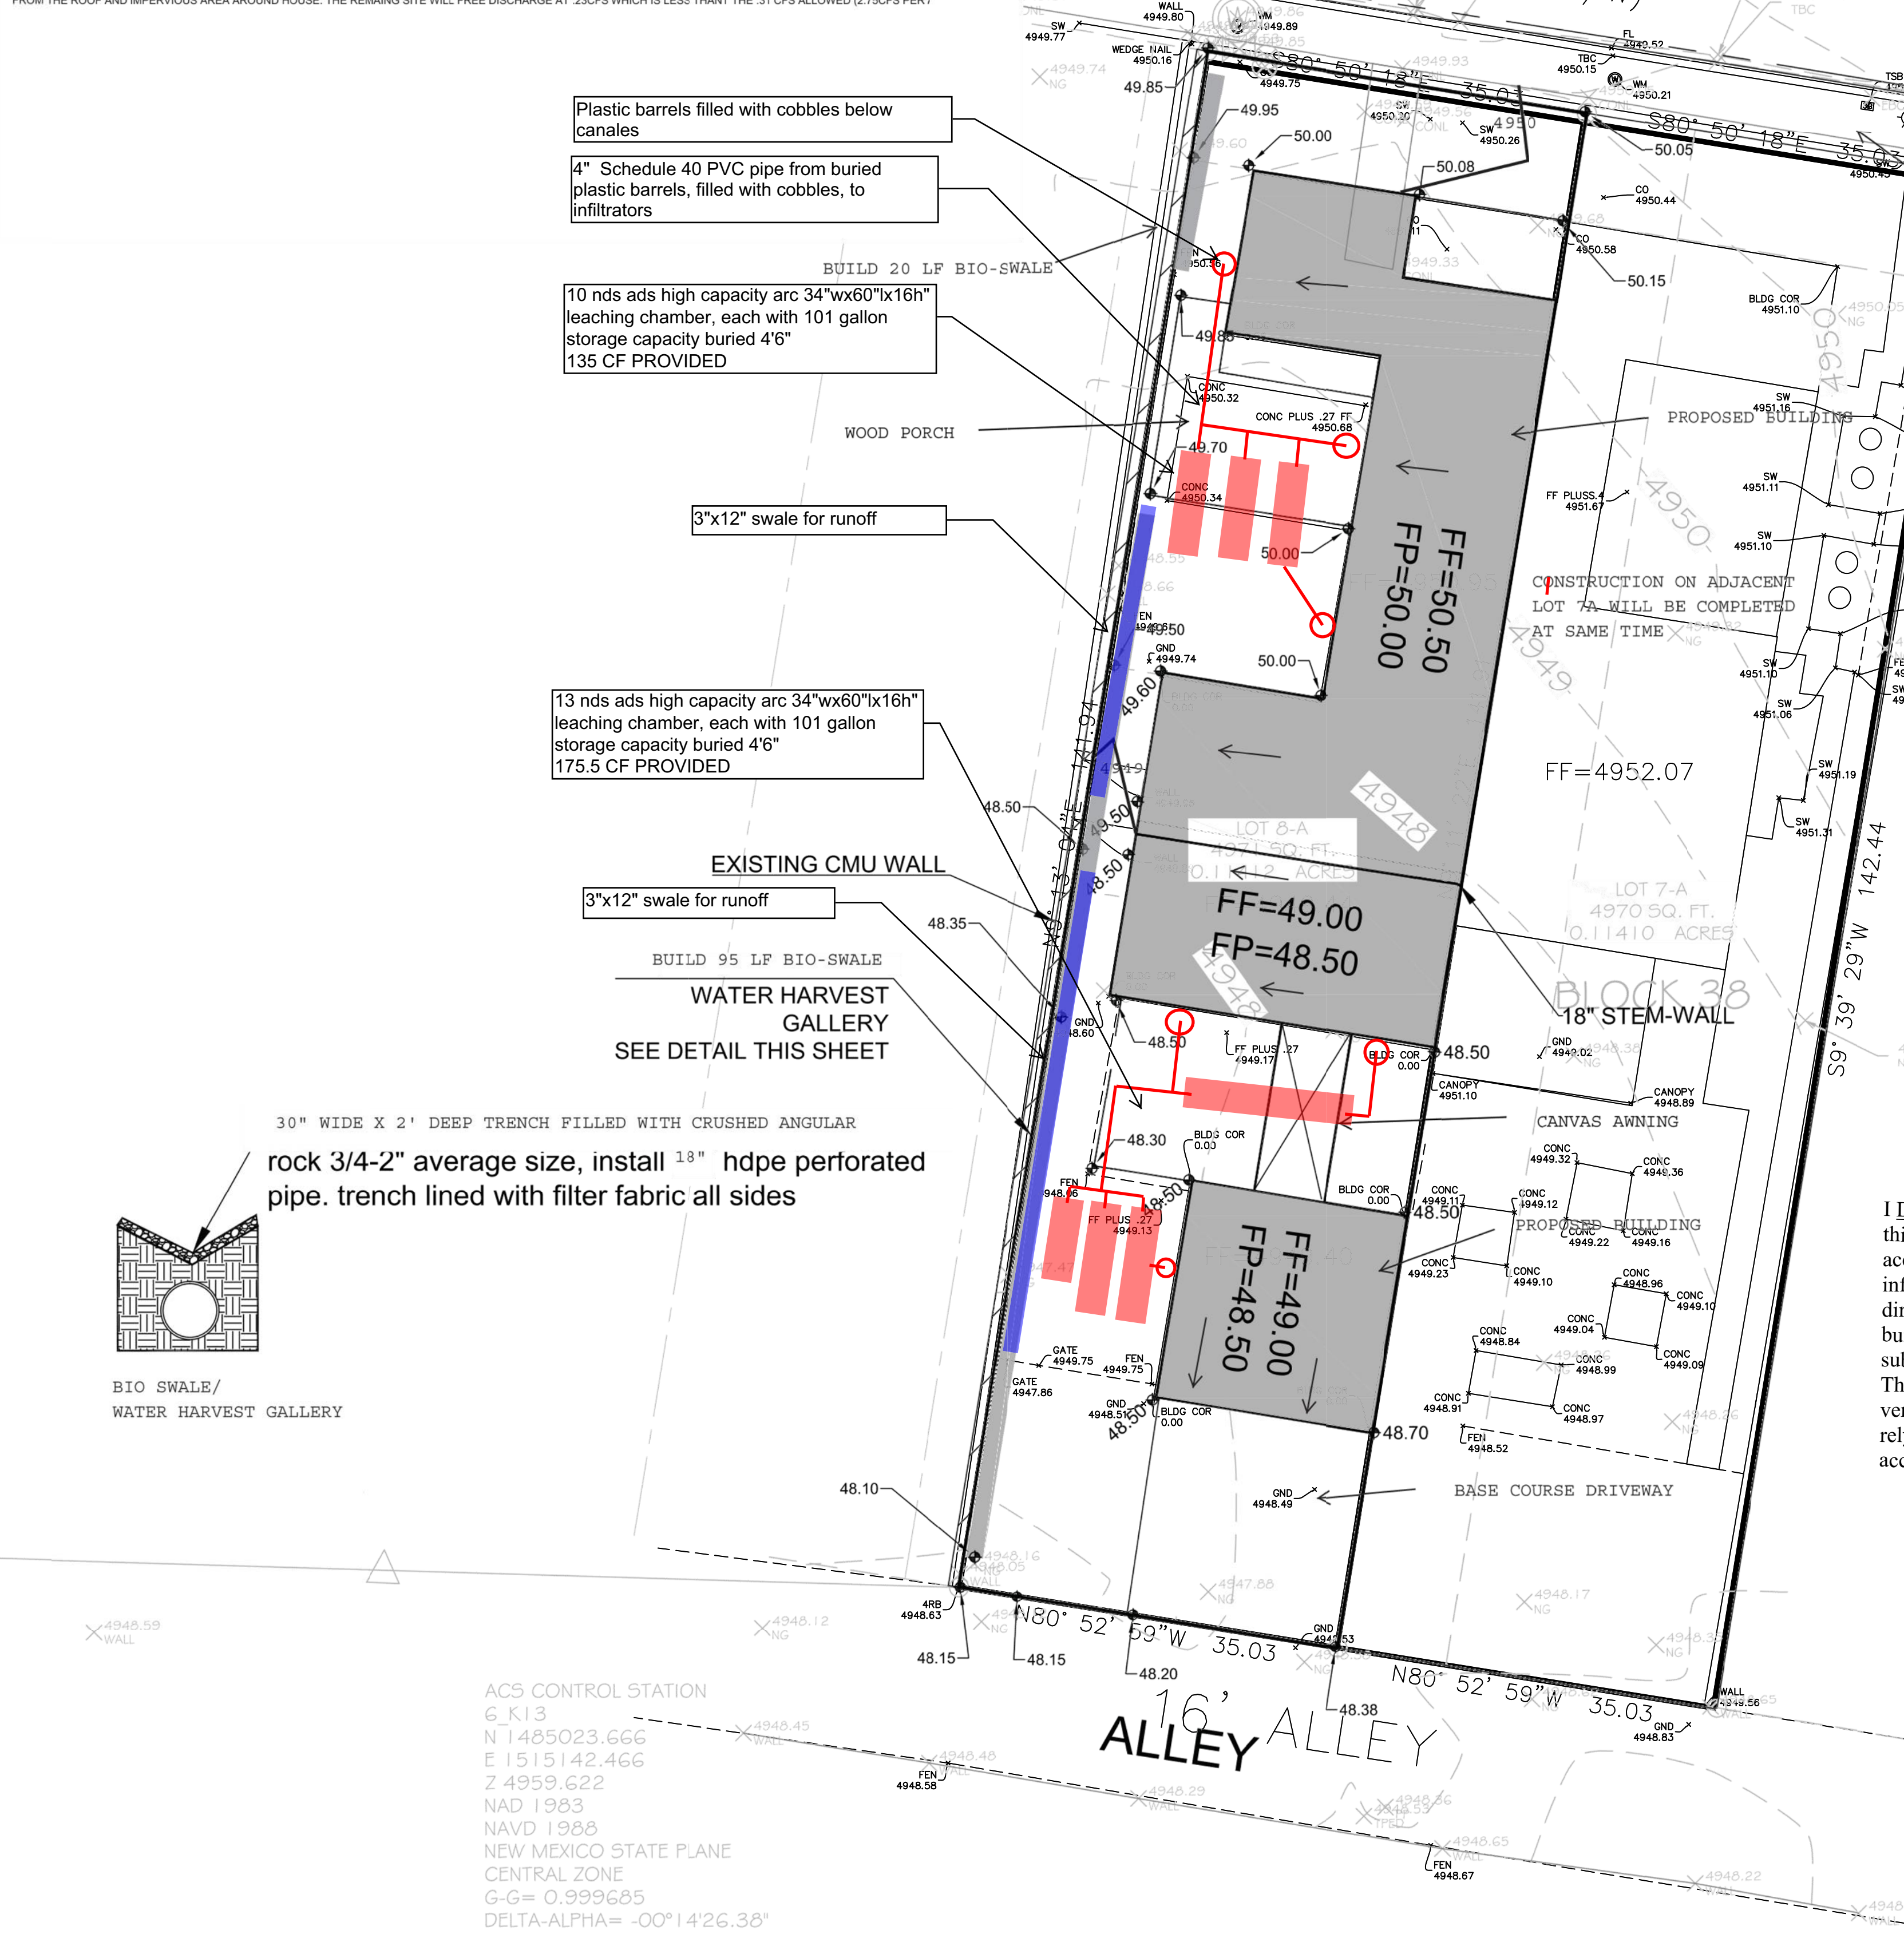

Point Table




Point #	Elevation	Northing	Easting	Description
103	4948.63	1484917.53	1518700.29	4RB
156	4950.50	1485048.46	1518798.80	WM
164	4949.89	1485060.82	1518725.88	WM

I David Soule, NMPE 14522, of the firm Rio Grande Engineering, hereby certify that this project has been graded and will drain in substantial compliance with and in accordance with the design intend of the approved plan dated 5/27/15. The record information edited on the original design document has performed by me or under my direct supervision and is true and correct to the best of my knowledge and belief. The as-built survey was provided DAVID ACOSTA NMPS 21082. The certification is submitted in support of a request for PERMANENT CERTIFICATE OF OCCUPANCY. The record information presented heron is not necessarily complete and intended only to verify substantial compliance of the grading and drainage aspects of this project. Those relying on this record document are advised to obtain independent verification of its accuracy before using it for any other purpose.

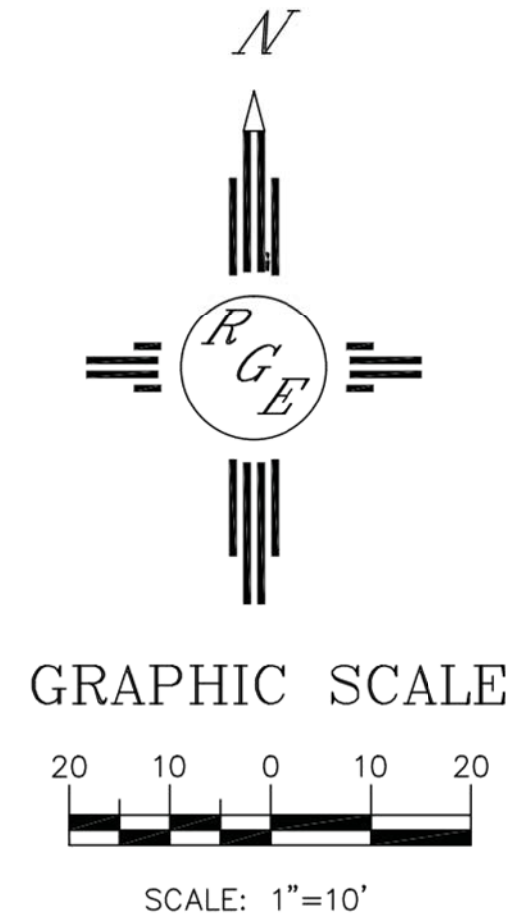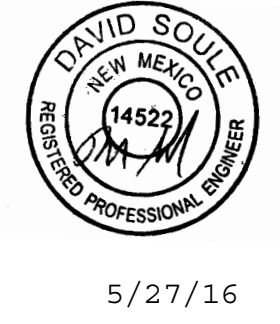


**EROSION CONTROL NOTES:**

- CONTRACTOR IS RESPONSIBLE FOR OBTAINING A TOPSOIL DISTURBANCE PERMIT PRIOR TO BEGINNING WORK.
- CONTRACTOR IS RESPONSIBLE FOR MAINTAINING RUN-OFF ON SITE DURING CONSTRUCTION.
- CONTRACTOR IS RESPONSIBLE FOR CLEANING ALL SEDIMENT THAT GETS INTO EXISTING RIGHT-OF-WAY.
- REPAIR OF DAMAGED FACILITIES AND CLEANUP OF SEDIMENT ACCUMULATIONS ON ADJACENT PROPERTIES AND IN PUBLIC FACILITIES IS THE RESPONSIBILITY OF THE CONTRACTOR.
- ALL EXPOSED EARTH SURFACES MUST BE PROTECTED FROM WIND AND WATER EROSION PRIOR TO FINAL (CITY) ACCEPTANCE OF ANY PROJECT.

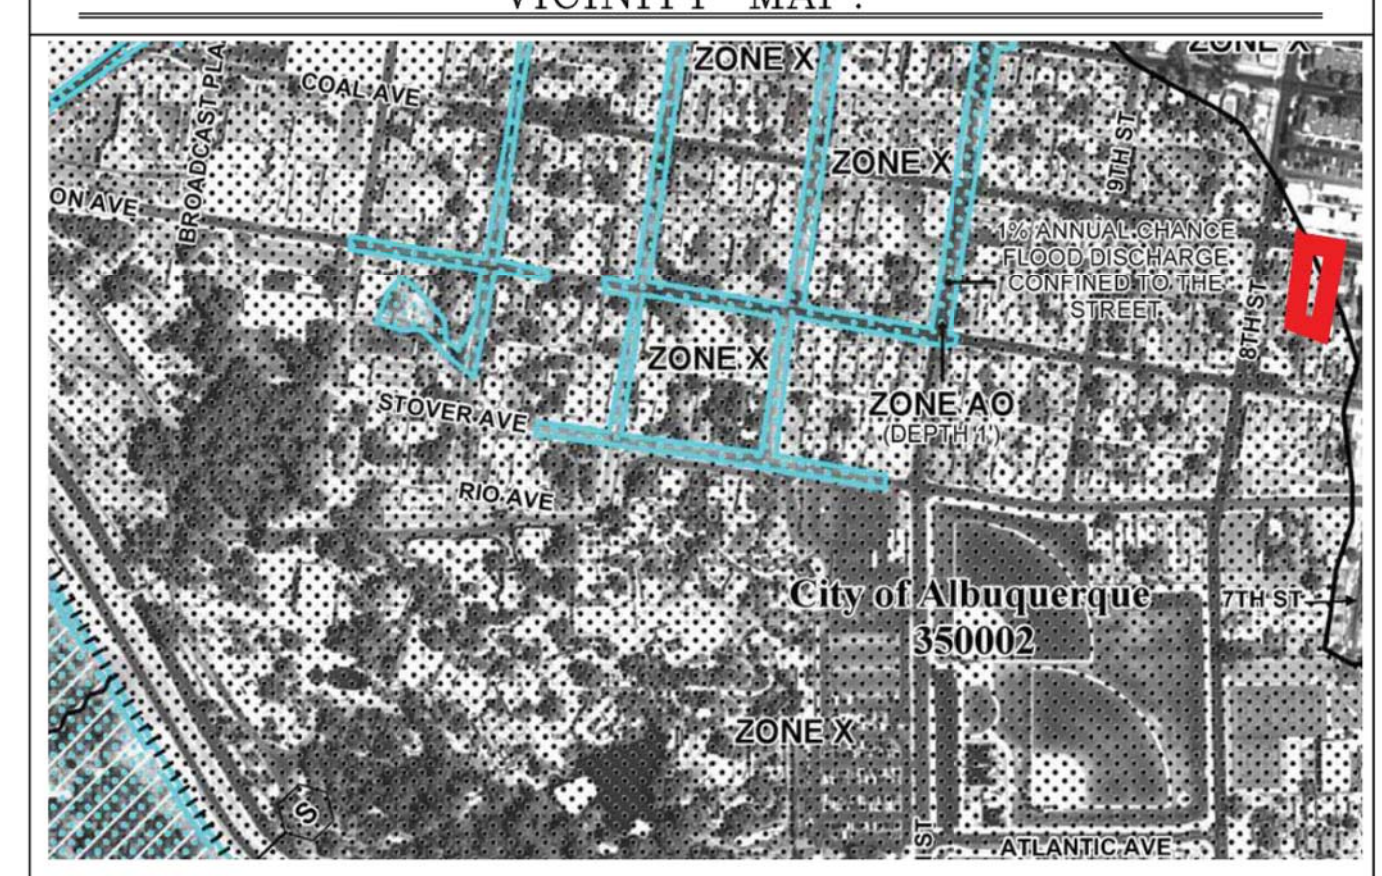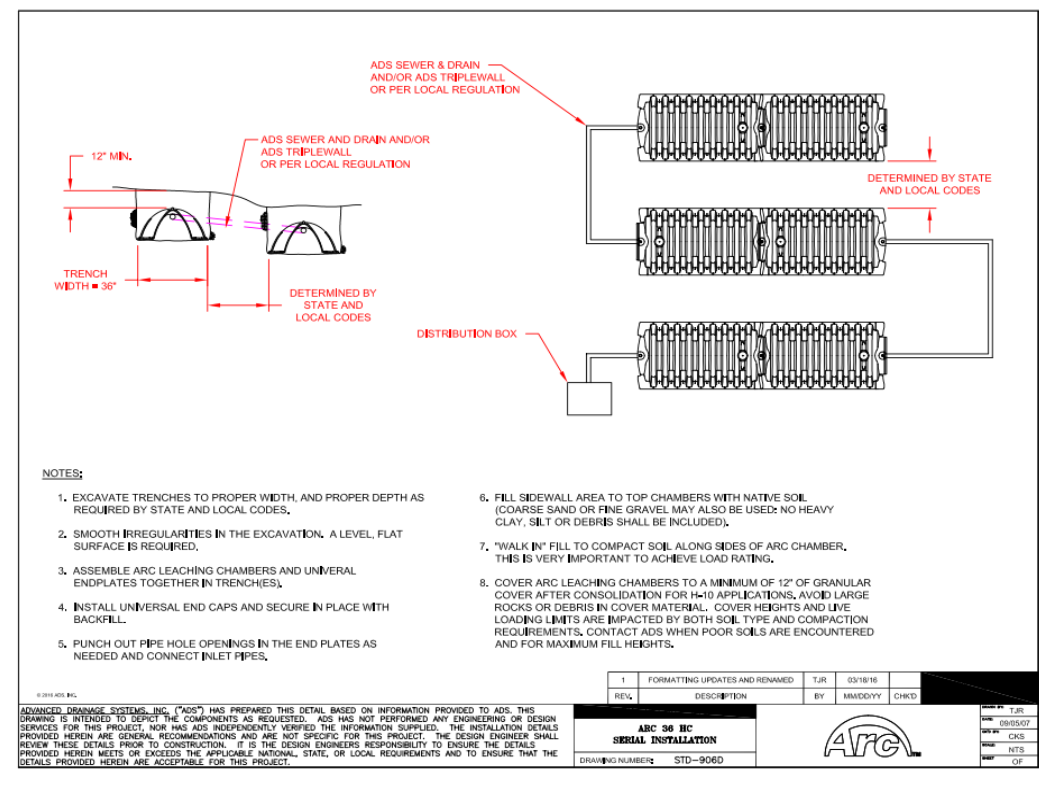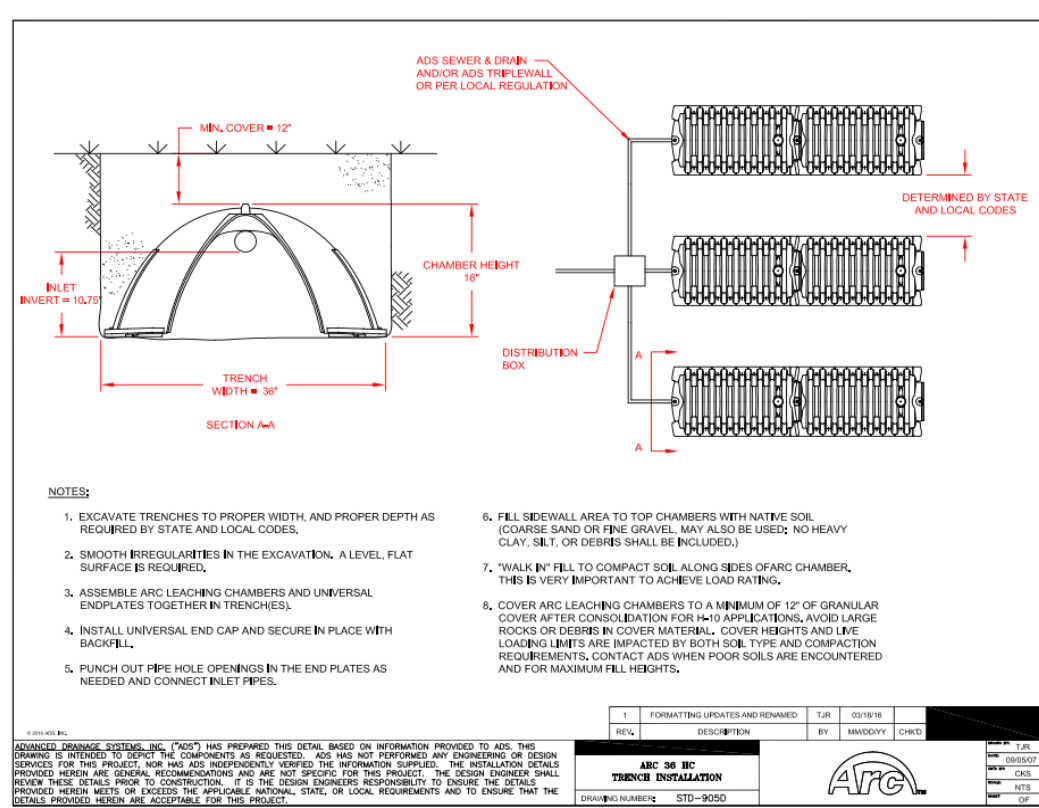

**LEGAL DESCRIPTION:**  
LOT 8-A RAYNOLDS ADDITION

- NOTES:**
- ALL SPOT ELEVATIONS REPRESENT FLOWLINE ELEVATION UNLESS OTHERWISE NOTED.
  - TOPOGRAPHY AND SURVEY DATA SHOWN ON THIS PLAN WAS OBTAINED BY CONSTRUCTION SURVEY TECHNOLOGIES, DAVID P ACOSTA PLS 21082 MAY 2015

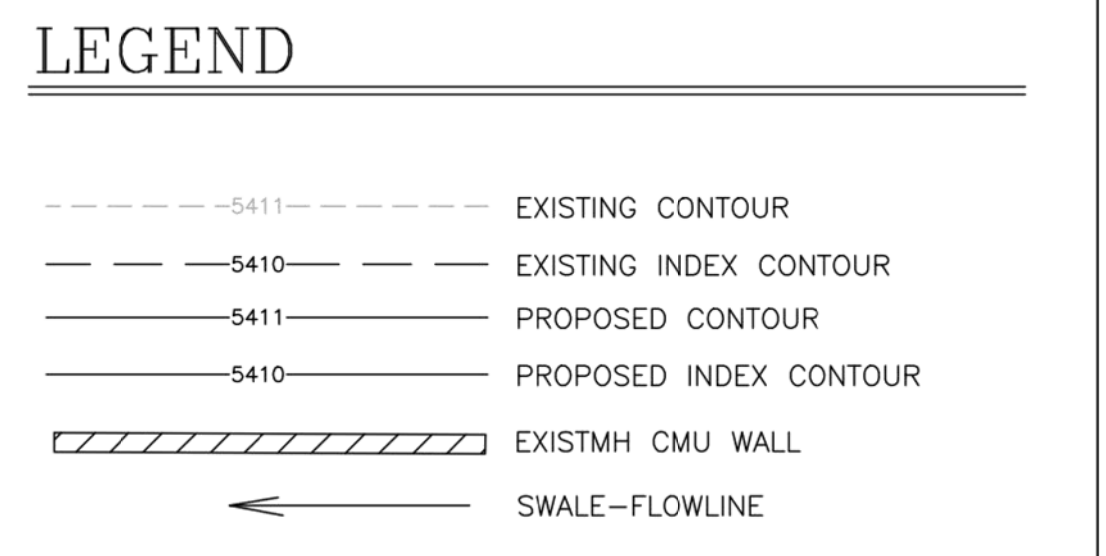

ENGINEER'S SEAL DAVID SOULE NEW MEXICO REGISTERED PROFESSIONAL ENGINEER 14522	LOT 8-A RAYNOLD ADDITION GRADING AND DRAINAGE PLAN <i>Rio Grande Engineering</i> 1606 CENTRAL AVENUE SE SUITE 201 ALBUQUERQUE, NM 87106 (505) 872-0999	DRAWN BY JDG DATE 05-20-2015 SHEET # 1 OF 1 JOB #
---	--	--