CITY OF ALBUQUERQUE



June 18, 2020

Byron Marroquin, RA Chris Pardo Design Elemental Architecture 161 S Civic Drive, Ste 8 Palm Springs, CA 92262

Re: Arrive Hotel

717 Central Ave. NW Traffic Circulation Layout

Architect's Stamp 06-18-2020 (K14-D022)

Dear Mr. Marroquin,

The TCL submittal received 06-17-2020 is approved for Building Permit with. A copy of the stamped and signed plan will be needed for each of the building permit plans. Please keep the original to be used for certification of the site for final C.O. for Transportation.

When the site construction is completed and an inspection for Certificate of Occupancy (C.O.) is requested, use the original City stamped approved TCL for certification. Redline any minor changes and adjustments that were made in the field. A NM registered architect or engineer must stamp, sign, and date the certification TCL along with indicating that the development was built in "substantial compliance" with the TCL. Submit this certification, the TCL, and a completed <u>Drainage and Transportation Information Sheet</u> to front counter personnel for log in and evaluation by Transportation.

Once verification of certification is completed and approved, notification will be made to Building Safety to issue Final C.O. To confirm that a final C.O. has been issued, call Building Safety at 924-3690.

Sincerely,

PO Box 1293

Albuquerque

NM 87103


www.cabq.gov


Nilo Salgado-Fernandez, P.E. Senior Engineer, Planning Dept.


Development Review Services

C: CO Clerk, File

7

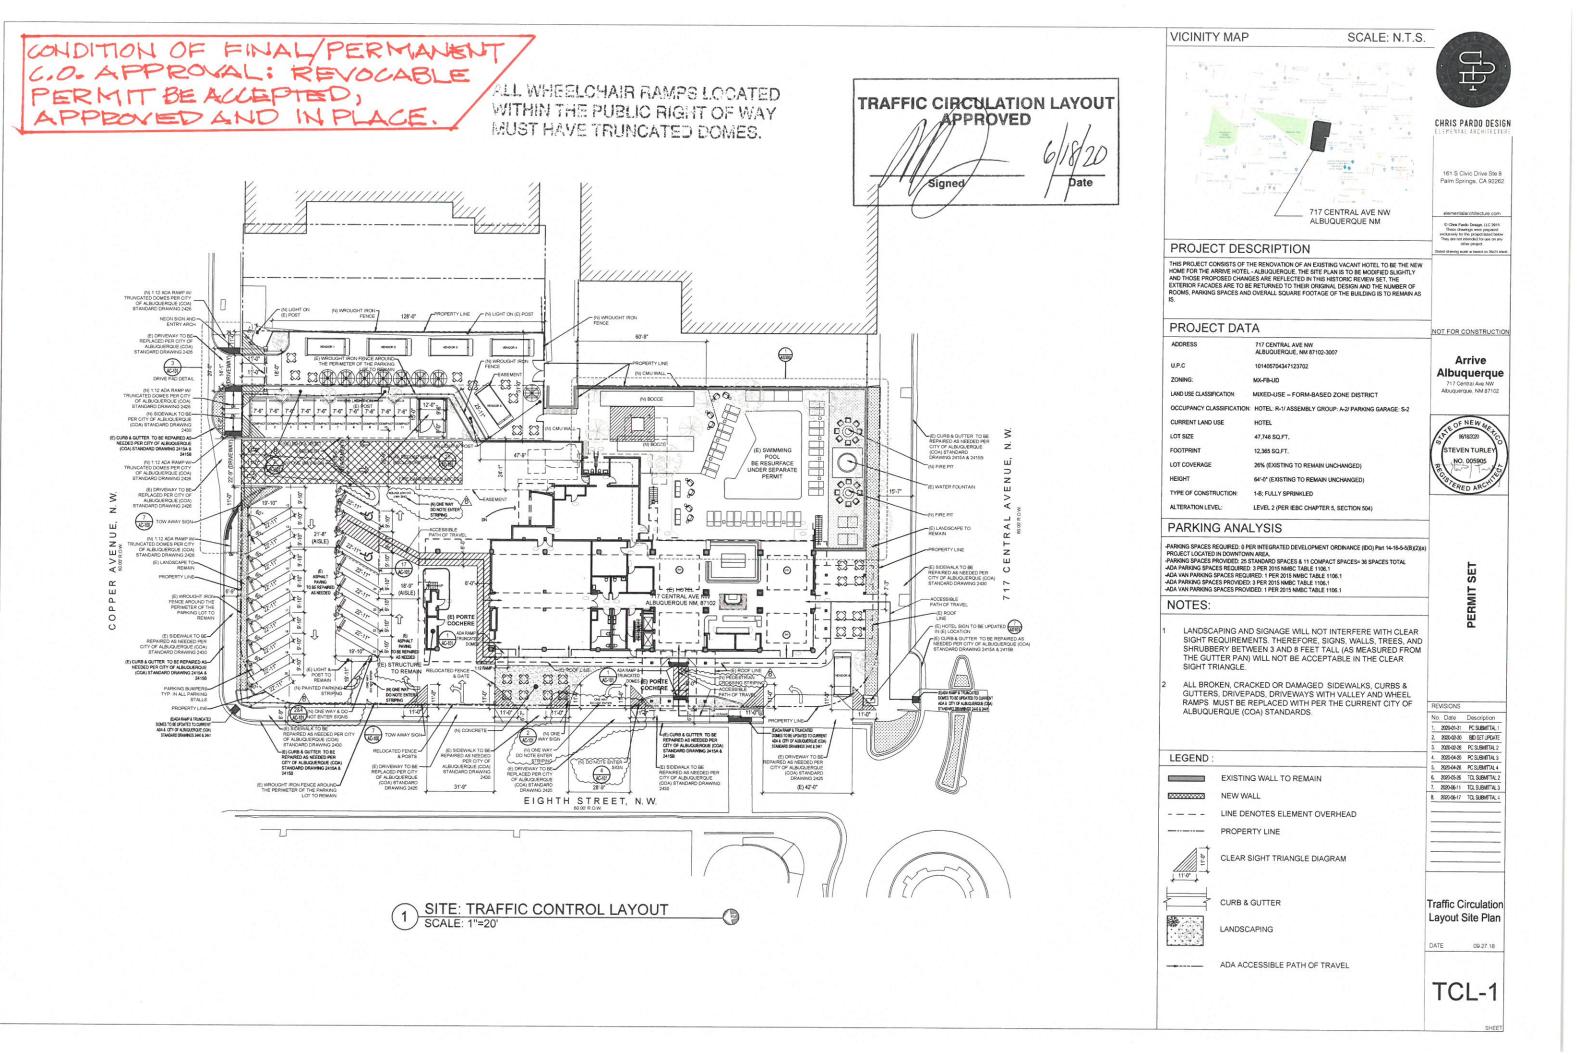

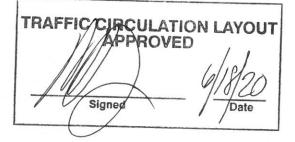

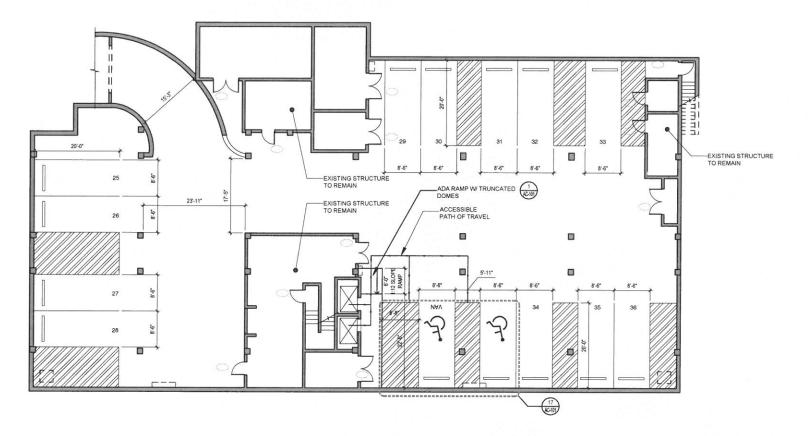

BASEMENT: TRAFFIC CONTROL LAYOUT SCALE: 1"=10"

PARKING ANALYSIS

-PARKING SPACES REQUIRED: 0 PER INTEGRATED DEVELOPMENT ORDINANCE (IDO) Part 14-16-5-5(B)(2)(a) PROJECT LOCATED IN DOWNTOWN AREA.
-PARKING SPACES PROVIDED: 25 STANDARD SPACES & 11 COMPACT SPACES= 36 SPACES TOTAL
-ADA PARKING SPACES REQUIRED: 9 PER 2015 NMBC TABLE 1106.1
-ADA VAN PARKING SPACES REQUIRED: 1 PER 2015 NMBC TABLE 1106.1
-ADA PARKING SPACES PROVIDED: 3 PER 2015 NMBC TABLE 1106.1
-ADA VAN PARKING SPACES PROVIDED: 1 PER 2015 NMBC TABLE 1106.1



NOTES:

LANDSCAPING AND SIGNAGE WILL NOT INTERFERE WITH CLEAR SIGHT REQUIREMENTS. THEREFORE, SIGNS, WALLS, TREES, AND SHRUBBERY BETWEEN 3 AND 8 FEET TALL (AS MEASURED FROM THE GUTTER PAN) WILL NOT BE ACCEPTABLE IN THE CLEAR SIGHT TRIANGLE. SIGHT TRIANGLE.

ALL BROKEN, CRACKED OR DAMAGED SIDEWALKS, CURBS & GUTTERS, DRIVEPADS, DRIVEWAYS WITH VALLEY AND WHEEL RAMPS MUST BE REPLACED WITH PER THE CURRENT CITY OF ALBUQUERQUE (COA) STANDARDS.

161 S Civic Drive Ste 8 Palm Springs, CA 92262

CHRIS PARDO DESIGN

LEGEND :

EXISTING WALL TO REMAIN

- - - LINE DENOTES ELEMENT OVERHEAD

— CONCRETE SIDEWALK

NOT FOR CONSTRUCTION

Arrive **Albuquerque**



SET

REVISIONS

No. Date Description 1. 2020-01-31 PC SUBMITTAL 1 2. 2020-02-20 BID SET UPDATE 3. 2020-02-28 PC SUBMITTAL 2

4. 2020-04-20 PC SUBMITTAL 3 5. 2020-04-28 PC SUBMITTAL 4


6. 2020-05-26 TOL SUBMITTAL 2 7. 2020-06-11 TCL SUBMITTAL 3


8. 2020-06-17 TOL SUBMITTAL 4

Traffic Circulation Layout Basement

09.27.18

TCL-2

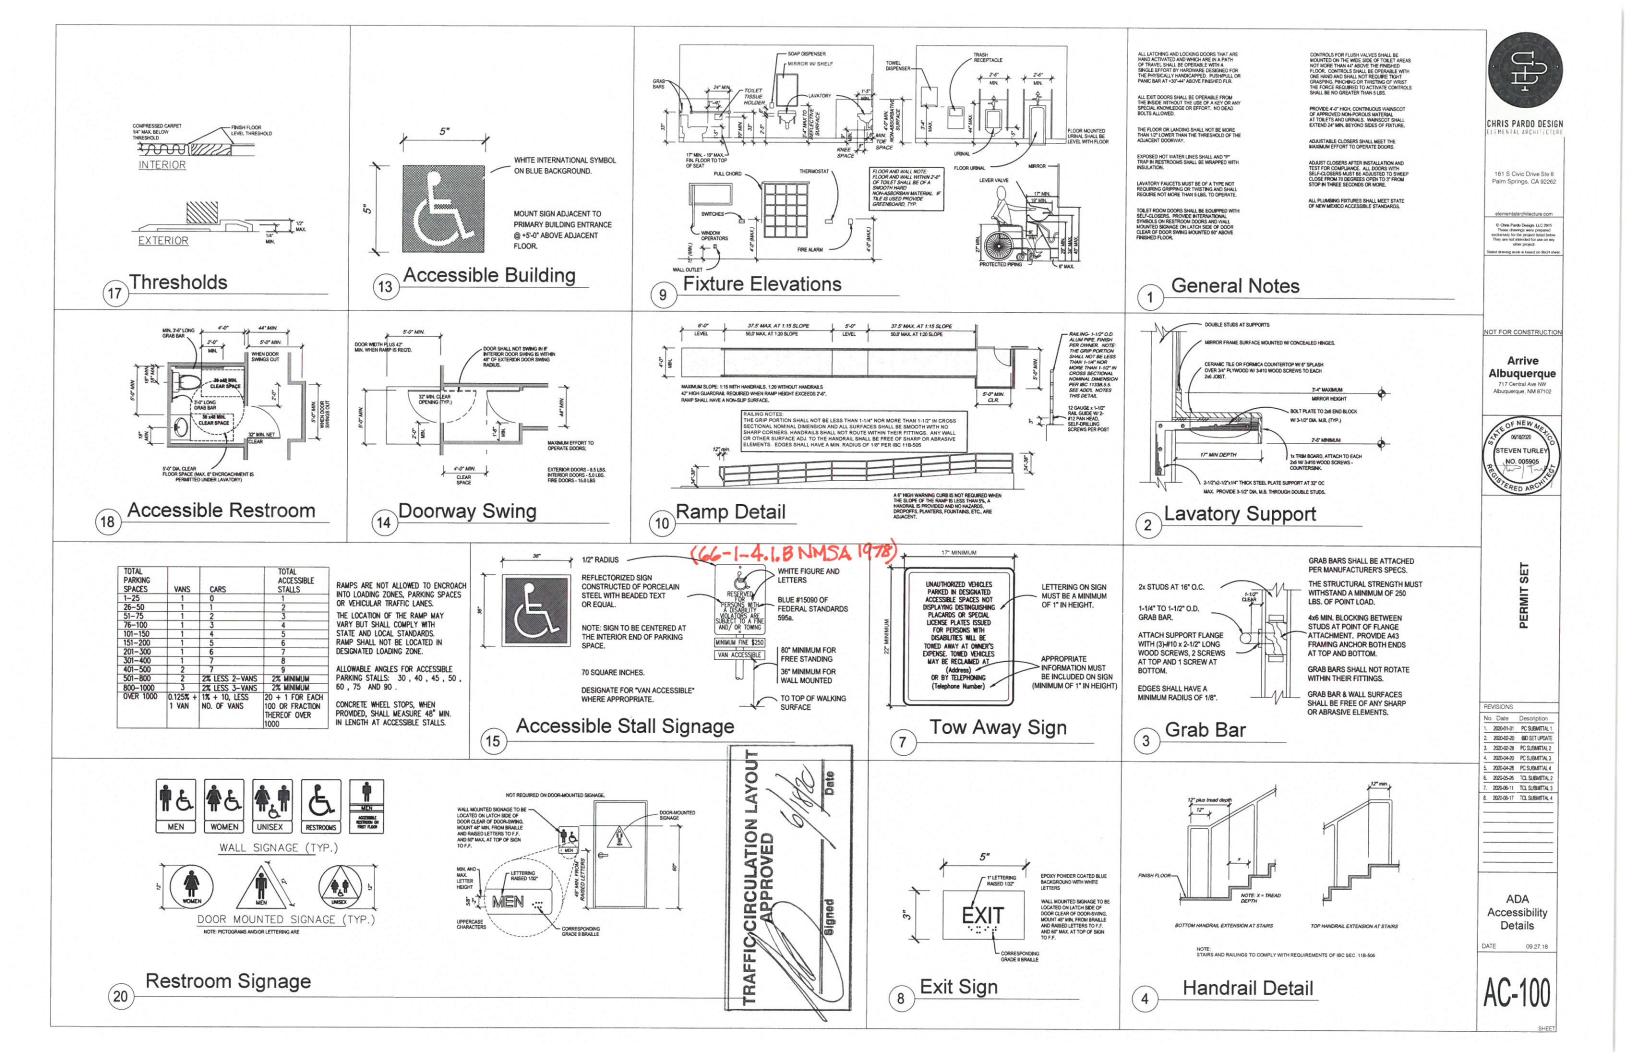

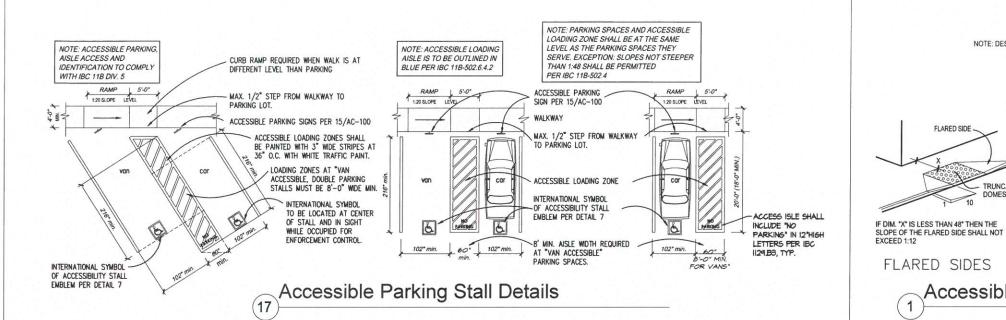

NOTE: DESIGN STORM DRAIN SYSTEM TO SHED WATER AWAY FROM CURB

FLARED SIDE

TRUNCATED

Accessible Ramps

> DOMES



CHRIS PARDO DESIGN

161 S Civic Drive Ste 8 Palm Springs, CA 92262

elementalarchitecture.com

NOT FOR CONSTRUCTION

Arrive Albuquerque

717 Central Ave NW Albuquerque, NM 87102

THE LANDING AT THE TOP OF THE CURB SHALL BE LEVEL AND 48" MIN. IN DEPTH FOR THE ENTIRE WIDTH OF HE CURB RAMP. SECTION 118-406.5.3.

FLARE SIDES 1:10 MAX. SLOPE

THE SLOPE OF THE FANNED OR FLARED SIDES OF CURB RAMPS SHALL NOT EXCEED 1:10, PER SECTION 118-406.2.2.

CURB RAMPS ARE TO BE 48" WIDE MIN. WITH A MIN. SLOPE OF 1:12 (8.33%), PER SECTION 118-406.5.2.

RAMP MUST NOT PROJECT INTO

BUILT-UP CURB RAMP

DETACTABLE WARNINGS, 36* DEEP AND EXTENDING THE FULL WIDTH OF THE CURB RAMP, ARE TO BE INSTALLED FOR ALL CURB RAMPS (RECARDLESS OF SLOVE), FOR SECTION 118-76 ONLY APPROVED DISAAC DETECTABLE WARNING PRODUCTS AND DIRECTIONAL SURFACES SHALL BE INSTALLED SECTION 118-765.

VEHICULAR TRAFFIC LANE

PLANTING OR OTHER NONWALKING SURFACE

- TRUNCATED DOMES

RETURNED CURB

TRUNCATED DOMES

STEVEN TURLE



PLEASE SEE MUTCD GUIDE FOR ADDITIONAL INFORMATION

ONE WAY SIGN DETAIL

DETACTABLE WARNINGS, 36" DEEP AND EXTENDING THE FULL WIDTH OF THE CURB RAMP, ARE TO BE INSTALLED FOR ALL CURB RAMPS (REGARDLESS OF SLOPE), PER SECTION 118-705. ONLY APPROVED DEAAGO DETECTABLE WARNING PRODUCTS AND DIRECTIONAL SURPACES SHALL BE INSTALLES SECTION 118-705. (N) SIDEWALK TO BE THE LANDING AT THE TOP OF THE CURB SHALL BE LEVEL AND

AS" MIN. IN DEPTH FOR THE ENTIRE WIDTH OF HE CURB RAMF

SECTION 118-406.5.3. (E) DRIVEWAY TO BE REPLACED PER CITY OF ALBUQUERQUE (COA) STANDARD DRAWING 2426 THE SLOPE OF THE FANNED OR FLARED SIDES OF CURB RA SHALL NOT EXCEED 1:10, PER SECTION 11B-406.2.2. (N) 1:12 ADA RAMP W TRUNCATED DOMES PER C OF ALBUQUERQUE (COA) STANDARD DRAWING 2426 (N) 1:12 ADA RAMP W/TRUNCATED_ DOMES PER CITY OF ALBUQUERQUE (COA) STANDARD DRAWING 2426 COPPER AVE. NW

DRIVE PAD DETAIL

ALL WHEELCHAIR RAMPS LOCATED WITHIN THE PUBLIC RIGHT OF WAY MUST HAVE TRUNCATED DOMES.



COLORS: SYMBOL - RED (RETROREFLECTIVE)
LEGEND & BACKGROUND - WHITE (RETROREFLECTIVE)

PLEASE SEE MUTCD GUIDE FOR ADDITIONAL INFORMATION

DO NOT ENTER SIGN DETAIL

No. Date Description . 2020-01-31 PC SUBMITTAL 1

2020-02-20 BID SET UPDAT 2020-02-28 PC SUBMITTAL 2 2020-04-20 PC SUBMITTAL : 2020-04-28 PC SUBMITTAL 4

2020-05-26 TCL SUBMITTAL 2 2020-06-11 TCL SUBMITTAL 3 2020-06-17 TOL SUBMITTAL 4

ADA Accessibility Details