

October 22, 1996

Martin J. Chávez, Mayor

Adam Wright Red Mountain Engineers 4600-C Montgomery Blvd. NE Albuquerque, NM 87109

RE: ENGINEER CERTIFICATION FOR PHASE I & PHASING PLAN FOR FAITH TEMPLE (K14-D58) CERTIFICATION STATEMENT DATED 10/16/96.

Dear Mr. Wright:

Based on the information provided on your October 16, 1996 submittal, Engineer Certification for Phase I is acceptable.

Phase II paving will need to be revised to indicate asphalt paving within the public alley area. Please keep in mind that any work done within public Right-of-Way needs to be coordinated through D.R.C. In this instance, the alley improvements are not that lengthy, therefore may be handled through Hydrology. Prior to Phase II construction, please provide an updated submittal for review and approval.

If I can be of further assistance, please feel free to contact me at 768-2667.

Sincerely,

Bernie J. Montoya, CE Engineering Associate

BJM/dl

c: Andrew Garcia

File



DRAINAGE INFORMATION SHEET

PROJECT TITLE: FATTH TEMPLE	ZONE ATLAS/DRNG. FILE #: _KI4-D58
DRB #: EPC #:	WORK ORDER #:
LEGAL DESCRIPTION: Lots 1,7 AND & B.	LOCK 16 OF EASTERN ADDITION
	4 56
	GINEERS CONTACT: ADAM WILLGITT
ADDRESS: 4600-C MONTEOMERY HE	STE 101 PHONE: (505) 889-3004
OWNER:	CONTACT:
ADDRESS:	PHONE:
ARCHITECT:	CONTACT:
ADDRESS:	PHONE:
SURVEYOR:	CONTACT:
ADDRESS:	PHONE:
CONTRACTOR:	CONTACT:
ADDRESS:	PHONE:
TYPE OF SUBMITTAL: CHECK TYPE OF APPROVAL SOUGHT:	
DRAINAGE REPORT	SKETCH PLAT APPROVAL
DRAINAGE PLAN	PRELIMINARY PLAT APPROVAL
CONCEPTUAL GRADING & DRAINAGE PLAN	S. DEV. PLAN FOR SUB'D. APPROVAL
GRADING PLAN	S. DEV. PLAN FOR BLDG. PERMIT APPROVAL
EROSION CONTROL PLAN	SECTOR PLAN APPROVAL
ENGINEER'S CERTIFICATION	FINAL PLAT APPROVAL
OTHER	FOUNDATION PERMIT APPROVAL
	∠ BUILDING PERMIT APPROVAL
PRE-DESIGN MEETING:	CERTIFICATE OF OCCUPANCY APPROVAL
YES	$\underline{\hspace{0.1cm} \hspace{0.1cm} \hspace{0.1cm}$
NO	PAVING PERMIT APPROVAL
GOPY PROVIDED	S.A.D. DRAINAGE REPORT
	DRAINAGE REQUIREMENTS
	SUBDIVISION CERTIFICATION
	OTHER (SPECIFY)
DATE SUBMITTED: 24 VAN 96	JAN 2 4 1996
DATE SUBMITTED: 24 VAN 96 BY: ADAM WRIGHT	



City of Albuquerque

P.O. BOX 1293 ALBUQUERQUE, NEW MEXICO 87103

January 30, 1996

Adam Wright
Red Mountain Engineer's Inc.
4600-C Montgomery NE
Suite 101
Albuquerque, NM 87109

RE: FAITH TEMPLE (K14-D58) GRADING AND DRAINAGE PLAN FOR BUILDING PERMIT AND GRADING PERMIT APPROVAL. ENGINEER'S STAMP DATED 1-23-96.

Dear Mr. Wright:

Based on the information provided on your January 24, 1996 submittal, the above referenced project is approved for Building and Grading Permits.

Prior to Certificate of Occupancy approval, an Engineer's Certification will be required.


If I can be of further assistance, please feel free to contact me at 768-3622.


Sincerely

Lisa Ann Manwill

Engineering Assoc./Hyd.

c: Andrew Garcia
 File

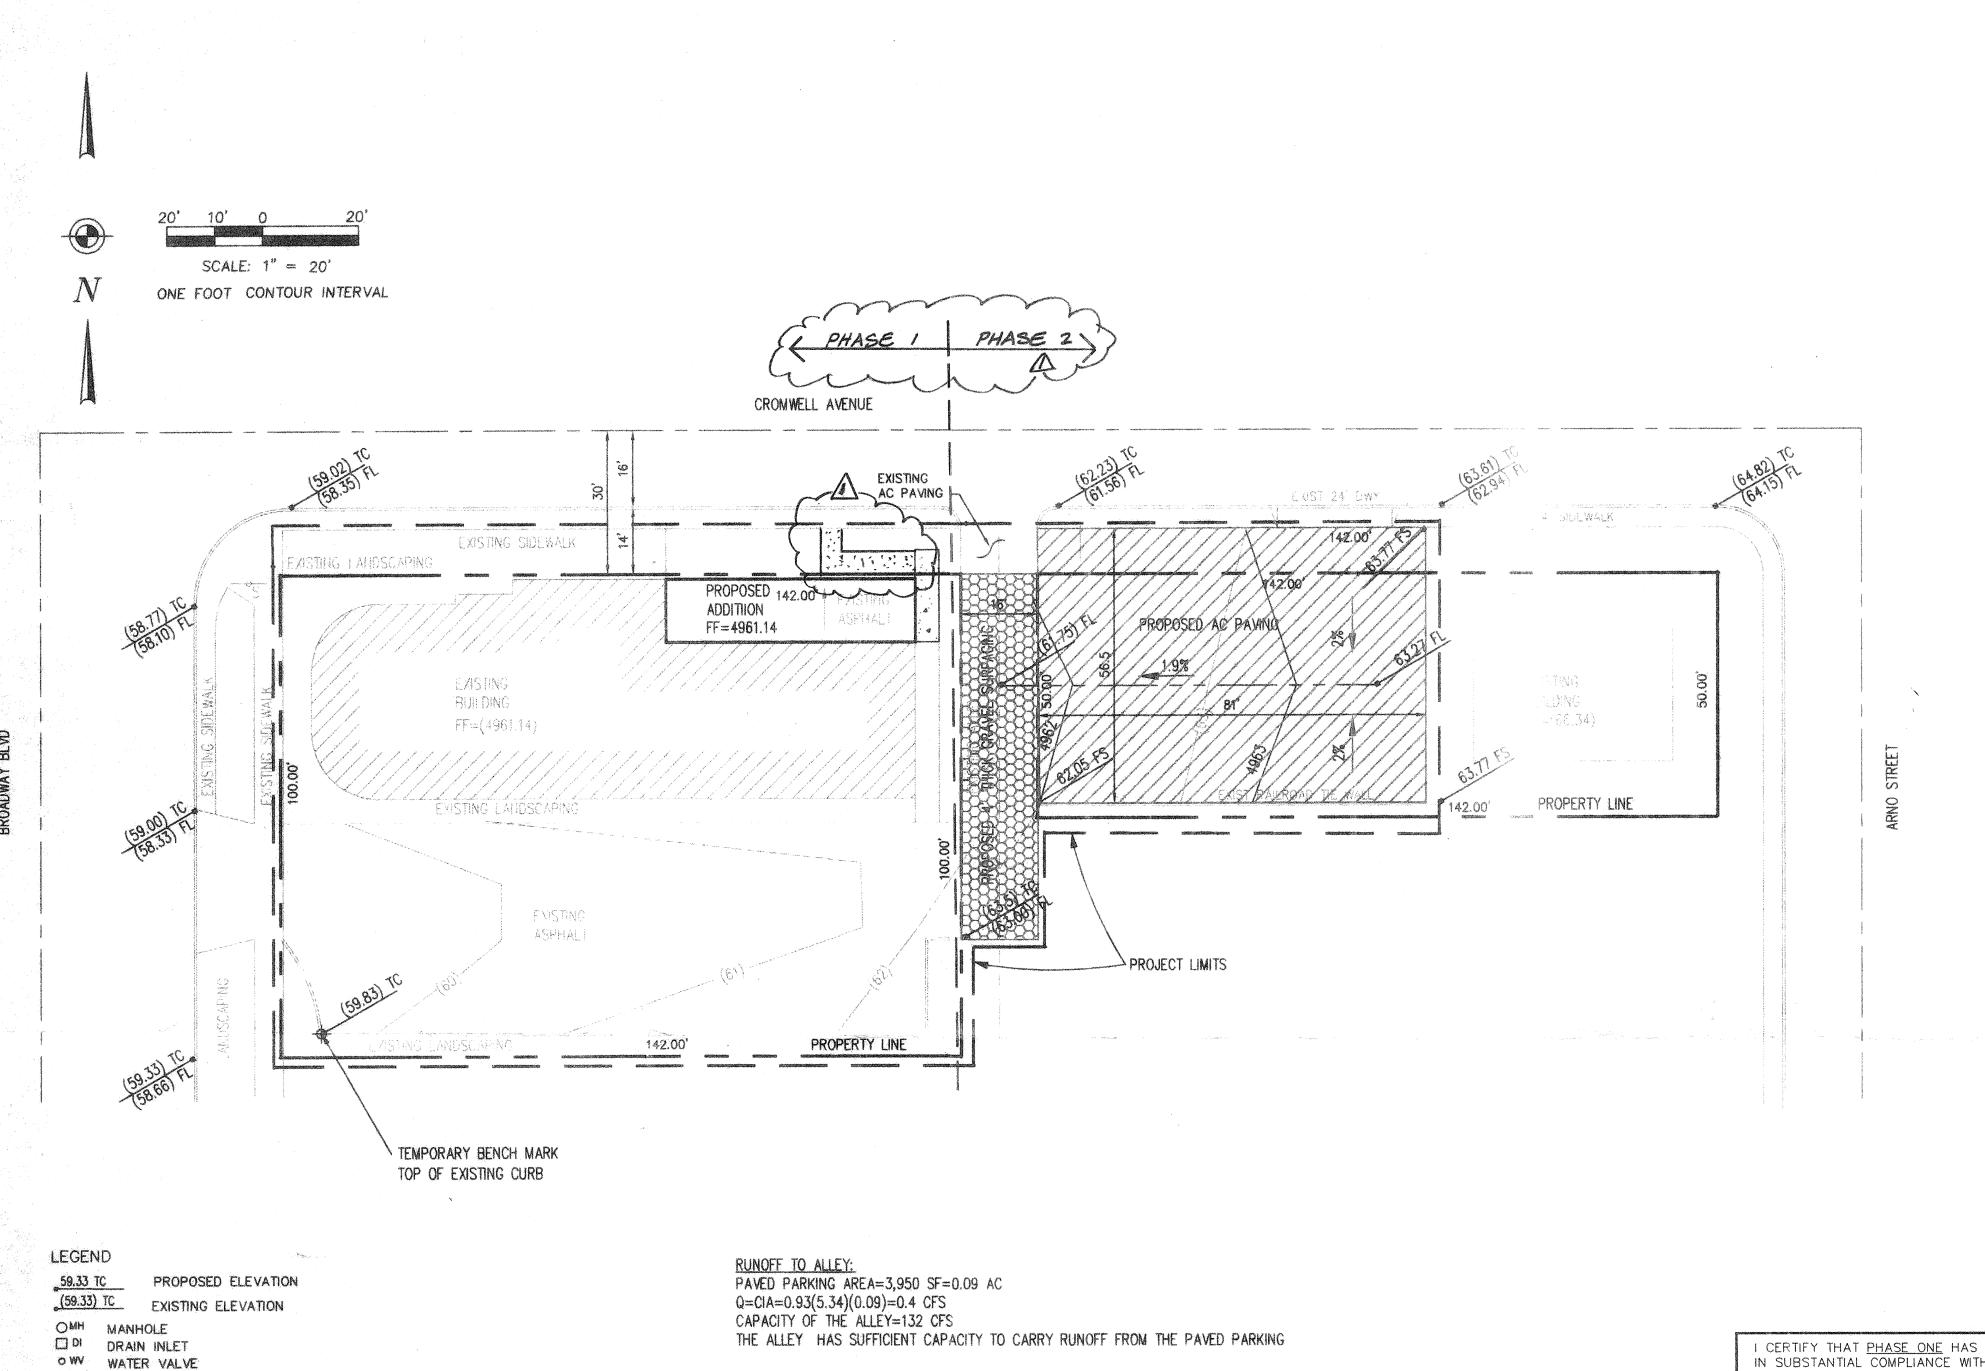

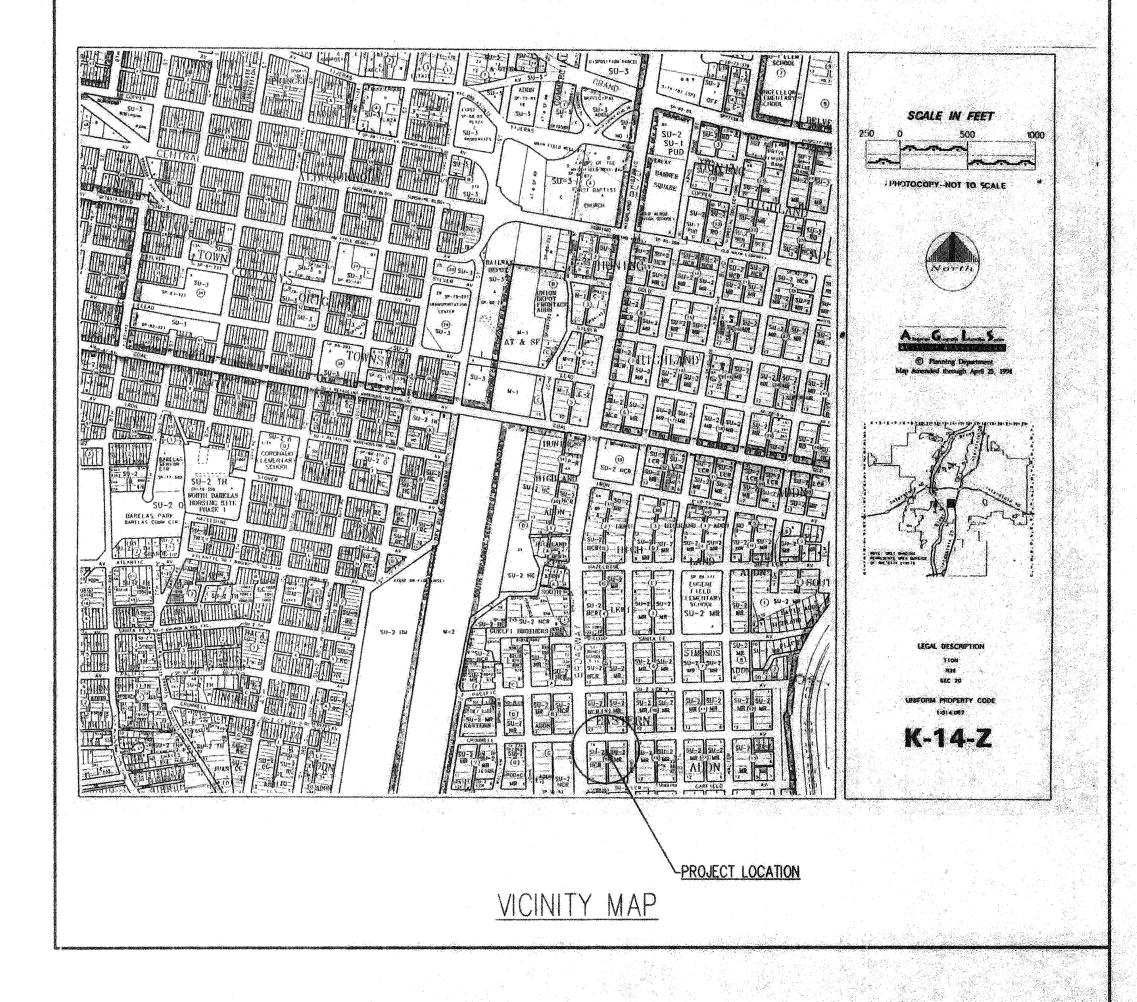

RUNOFF CALCULATIONS

THE EXISTING SITE INCLUDES A CHURCH BUILDING, AN ASPHALT PARKING AREA IMPROVEMENTS INCLUDE A ROOM ADDITION TO THE CHURCH, A CONCRET SIDEWALK AND A PAVED PARKING AREA.

ALL RUN OFF GENERATED ON SITE IS DISCHARGED INTO THE BROADWAY BOULEVARD AND CROMWELL STREET RIGHTS-OF-WAY AND FLOWS IN THE GUTTERS OF THOSE STREETS TO THE CATCH BASIN AT THEIR INTERSECTION. THE RUNOFF THEN FLOWS NORTH IN BROADWAY TO SANTA FE AVENUE THEN WEST IN SANTA FE TO THE SOUTH BROADWAY DETENTION BASIN.

THIS SITE DOES NOT CONTRIBUTE TO A DESIGNATED 100 YEAR FLOOD PLAIN AND WILL HAVE NO SIGNIFICANT IMPACT ON DOWNSTREAM CONDITIONS.


2 LEGAL DESCRIPTION

A TRACT OF LAND LOCATED WITHIN THE CORPORATE LIMITS OF CITY OF ALBUQUERQUE, COMPRISING ALL OF LOTS 7 AND 8 IN BLOCK 16 OF THE EASTERN ADDITION AS SHOWN ON THE PLAT FILED IN THE OFFICE OF THE COUNTY CLERK OF BERNALILLO COUNTY, NEW MEXICO ON MAY 21, 1932 IN BOOK C1, FOLIOI 171, AND BEING MORE PARTICULARLY DESCRIBED AS FOLLOWS:

BEGINNING AT THE NORTHWEST CORNER WHICH IS COMMON WITH THE NORTHWEST CORNER OF LOT 7, THENCE, EAST ALONG THE SOUTH RIGHT-OF-WAY OF CROMWELL AVENUE A DISTANCE OF 142.00 FEET; THENCE, SOUTH A DISTANCE OF 100.00 FEET, THENCE, WEST A DISTANCE OF 142.00 FEET; THENCE NORTH ALONG THE EAST RIGHT-OF-WAY OF BROADWAY BOULEVARD A DISTANCE OF 100.00 FEET TO THE POINT OF BEGINNING AND CONTAINING 0.3260 ACRES MORE OR LESS; AND

LOT NUMBERED ONE (1) IN BLOCK NUMBERED SIXTEEN (16) OF THE EASTERN ADDITION TO THE COTU OF ALBUQUERQUE, NEW MEXICO, AS THE SAME IS SHOWN AND DESIGNATED ON THE MAP OF SAID ADDITION, FILED IN THE OFFICE OF THE PROBATE CLERK AND EX-OFFICIAO RECORDER OF BERNALILLO COUNTY, NEW MEXICO, ON MAY 31ST, 1882.

> ARCHITECTS . PLANNERS . INTERIOR DESIGNERS 115 AMHERST DRIVE SE., ALBUQUERQUE, NEW MEXICO 87106 FAX (505) 268-6665 TELE. (505) 255-8668

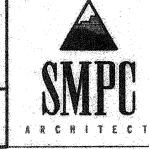

FAITH TEMPLE, 1004 BROADWAY SE, ALBUQUERQUE, NM

"AS BUILT" (12993) U 007 | 6

PHASE 1

HYDROLOGY

GRADING & DRAINAGE PLAN PROJECT #: 95XXX ASBORT 10/16/96 DWN BY: AW CHK BY: DATE: 18 OCT 95

RANGARARA RANGARA 3" ASPHALT CONCRETE TACK COAT 12" SUBGRADE SOIL: R-VALUE>50, -1 95% COMPACTION 8" SUBGRADE PREPARATION ---COMPACT TO 90% MAX. DENSITY

FOR ADDITIONAL CONSTRUCTION NOTES

ELEVATION

FT/METERS

4965.015

1513.340

ELEVATION

REV 1992

(MSLD 1929)

<u>DESCRIPTION</u>

CURB RETURN

POWER POLE W/LIGHT

-OH- OVERHEAD POWER LINE

-SAS- SANITARY SEWER LINE

-SD- STORM DRAIN LINE

-R/W- RIGHT-OF-WAY LINE -0- CHAIN LINK FENCE

EDGE OF BUILDING

LOCATION

OF THE INTERSECTION

O PP POWER POLE

-W- WATER LINE

____ ROCK CURB

O-O FIRE HYDRANT

BENCH MARK

BM NO.

-- G-- GAS LINE

9999.9 SPOT ELEVATION ON NATURAL GROUND

9999.99 SPOT ELEVATION AT TOP BACK OF C & G OR TOP OF ASPHALT

LOCATED AT THE INTERSECTION OF A SQUARE CHISELED

SE IN THE SOUTHWEST QUADRANT CURB AT THE SSW

BROADWAY BLVD AND PACIFIC AVE ON TOP OF CONCRETE

SEE CITY OF ALBUQUERQUE DWG 2405

AC PAVEMENT SECTION NO SCALE

4" THICK GRAVEL SURFACING 95% COMPACTION 8" SUBGRADE PREPARATION -COMPACT TO 95% MAX. DENSITY GRAVEL SURFACING SECTION

NO SCALE

DATE ADAM R. WRIGHT, NM PE 12993 **RUNOFF CALCULATIONS - 40 ACRE AND SMALLER BASINS** REFERENCE: CITY OF ALBUQUERQUE, DEVELOPMENT PROCESS MANUAL (DPM) VOL. 2 DESIGN CRITEREIA, SECTION 22.2, HYDROLOGY, JANUARY 1993 ZONE ATLAS PAGE: K-14-Z PRECIPITATION ZONE: P(60) - 100-YEAR: 2.00 PRE DEVELOPMENT CONDITIONS: A (UNDISTURBED) B (LANDSCAPED) C (GOMPACTED SOIL) D (IMPERVIOUS) 0.93 11,654 0.27 0.25 18,074 0.41 0.33 WEIGHTED C: C=SUM(CxA)/SUM(A)= 0.80 0.1667 TIME OF CONCENTRATION (HR), Tc= RAINFALL INTENSITY (INCHES/HOUR), I= PEAK DISCHARGE (CFS), Q(100)=CIA= POST DEVELOPMENT CONDITIONS:
 C
 A (SF)
 A (AC)
 CxA

 0.31
 0
 0.00
 0.00

 0.45
 2,460
 0.06
 0.03

 0.62
 0
 0.00
 0.00

 0.93
 15,614
 0.36
 0.33

 18,074
 0.41
 0.36
 LAND TREATMENT A (UNDISTURBED) B (LANDSCAPED) C (COMPACTED SOIL) D (IMPERVIOUS)
TOTAL WEIGHTED C: C=SUM(CxA)/SUM(A)= 0.86 TIME OF CONCENTRATION (HR), Tc= 0.1667

I CERTIFY THAT PHASE ONE HAS BEEN COMPLETED IN SUBSTANTIAL COMPLIANCE WITH THE APPROVED MEX DRAINAGE REPORT AND THE APPROVED GRADING AND DRAINAGE PLAN. MAUnight

RAINFALL INTENSITY (INCHÈS/HOUR), I= PEAK DISCHARGE (CFS), Q(100)=CIA=