

# CITY OF ALBUQUERQUE

Planning Department  
Brennon Williams, Interim Director



Mayor Timothy M. Keller

August 7, 2019

Don Briggs, P.E.  
Don Briggs Engineering, LLC  
5324 Oakledge Ct. NW  
Albuquerque, NM 87120

**RE: 913 Silver Ave. SW**  
**Grading and Drainage Plan**  
**Engineer's Stamp Date: 07/25/19**  
**Hydrology File: K14D118A**

Dear Mr. Briggs:

PO Box 1293

Based upon the information provided in your resubmittal received 08/02/2019, the Grading & Drainage Plan is approved for Building Permit and Grading Permit.

Albuquerque

Please attach a copy of this approved plan in the construction sets for Building Permit processing along with a copy of this letter. Prior to approval in support of Permanent Release of Occupancy by Hydrology, Engineer Certification per the DPM checklist will be required.

NM 87103

Prior to the backfill of the retention pond, please provide photos and an Engineer Certification for the underground retention pond. This can be submitted to Hydrology as a letter submittal either before or at the time of submittal for Permanent Release of Occupancy.

www.cabq.gov

Also as a reminder, please provide a Drainage Covenant for the proposed retention pond per Chapter 17 of the DPM prior to Permanent Release of Occupancy. Please submit this on the 4th floor of Plaza de Sol. A \$25 fee will be required.

If you have any questions, please contact me at 924-3995 or [rbrissette@cabq.gov](mailto:rbrissette@cabq.gov).

Sincerely,

Renée C. Brissette, P.E. CFM  
Senior Engineer, Hydrology  
Planning Department



# City of Albuquerque

Planning Department

Development & Building Services Division

## DRAINAGE AND TRANSPORTATION INFORMATION SHEET (REV 11/2018)

**Project Title:** \_\_\_\_\_ **Building Permit #:** \_\_\_\_\_ **Hydrology File #:** \_\_\_\_\_

**DRB#:** \_\_\_\_\_ **EPC#:** \_\_\_\_\_ **Work Order#:** \_\_\_\_\_

**Legal Description:** \_\_\_\_\_

**City Address:** \_\_\_\_\_

**Applicant:** \_\_\_\_\_ **Contact:** \_\_\_\_\_

**Address:** \_\_\_\_\_

**Phone#:** \_\_\_\_\_ **Fax#:** \_\_\_\_\_ **E-mail:** \_\_\_\_\_

**Owner:** \_\_\_\_\_ **Contact:** \_\_\_\_\_

**Address:** \_\_\_\_\_

**Phone#:** \_\_\_\_\_ **Fax#:** \_\_\_\_\_ **E-mail:** \_\_\_\_\_

**TYPE OF SUBMITTAL:** \_\_\_\_\_ PLAT (\_\_\_\_# OF LOTS) \_\_\_\_\_ RESIDENCE \_\_\_\_\_ DRB SITE \_\_\_\_\_ ADMIN SITE

**IS THIS A RESUBMITTAL?:** \_\_\_\_\_ Yes \_\_\_\_\_ No

**DEPARTMENT:** \_\_\_\_\_ TRAFFIC/ TRANSPORTATION \_\_\_\_\_ HYDROLOGY/ DRAINAGE

Check all that Apply:

### TYPE OF SUBMITTAL:

- \_\_\_\_\_ ENGINEER/ARCHITECT CERTIFICATION
- \_\_\_\_\_ PAD CERTIFICATION
- \_\_\_\_\_ CONCEPTUAL G & D PLAN
- \_\_\_\_\_ GRADING PLAN
- \_\_\_\_\_ DRAINAGE MASTER PLAN
- \_\_\_\_\_ DRAINAGE REPORT
- \_\_\_\_\_ FLOODPLAIN DEVELOPMENT PERMIT APPLIC
- \_\_\_\_\_ ELEVATION CERTIFICATE
- \_\_\_\_\_ CLOMR/LOMR
- \_\_\_\_\_ TRAFFIC CIRCULATION LAYOUT (TCL)
- \_\_\_\_\_ TRAFFIC IMPACT STUDY (TIS)
- \_\_\_\_\_ OTHER (SPECIFY) \_\_\_\_\_
- \_\_\_\_\_ PRE-DESIGN MEETING?

### TYPE OF APPROVAL/ACCEPTANCE SOUGHT:

- \_\_\_\_\_ BUILDING PERMIT APPROVAL
- \_\_\_\_\_ CERTIFICATE OF OCCUPANCY
- \_\_\_\_\_ PRELIMINARY PLAT APPROVAL
- \_\_\_\_\_ SITE PLAN FOR SUB'D APPROVAL
- \_\_\_\_\_ SITE PLAN FOR BLDG. PERMIT APPROVAL
- \_\_\_\_\_ FINAL PLAT APPROVAL
- \_\_\_\_\_ SIA/ RELEASE OF FINANCIAL GUARANTEE
- \_\_\_\_\_ FOUNDATION PERMIT APPROVAL
- \_\_\_\_\_ GRADING PERMIT APPROVAL
- \_\_\_\_\_ SO-19 APPROVAL
- \_\_\_\_\_ PAVING PERMIT APPROVAL
- \_\_\_\_\_ GRADING/ PAD CERTIFICATION
- \_\_\_\_\_ WORK ORDER APPROVAL
- \_\_\_\_\_ CLOMR/LOMR
- \_\_\_\_\_ FLOODPLAIN DEVELOPMENT PERMIT
- \_\_\_\_\_ OTHER (SPECIFY) \_\_\_\_\_

**DATE SUBMITTED:** \_\_\_\_\_ **By:** \_\_\_\_\_

COA STAFF:

ELECTRONIC SUBMITTAL RECEIVED: \_\_\_\_\_

FEE PAID: \_\_\_\_\_



July 30, 2019

Renée C. Brissette, P.E. CFM  
Senior Engineer, Hydrology  
Planning Department  
City of Albuquerque  
600 2<sup>nd</sup> St. NW  
Albuquerque, NM 87103

Re: Hydrology File #K14D118A, 913 Silver Ave. SW

Dear Ms. Brissette,

I have attached a revised grading & drainage plan that addresses your comments of July 19, 2019. The comments have been addressed as follows:

1. Even though the project benchmark is shown, please provide the City monument where this datum was taken. *The tie is presented on the plan.*
2. Per the DPM Chapter 22 Section 7 - Grading Plan Checklist, please use 1" = 20' for the scale. *The scale has been revised to 1"=20'.*
3. Per the DPM Chapter 22 Section 7 - Grading Plan Checklist, please provide a graphic scale. *A graphic scale has been provided.*
4. Please show all existing structures, fences, sidewalk, and pavement on the lot, adjacent lots, Silver R.O.W., and alley. These items are important to tie proposed grading into and are any going to remain. See aerial. *These items have been added and labeled on the plan.*
5. Please label both the alley as a "16' Public Alley" and Silver Ave SW R.O.W. *Labels have been provided.*
6. Please provide a legend showing all hatch patterns. I cannot tell what is being proposed. *Legend is provided.*
7. Please provide all dimensions needed to build the proposed retention pond especially the dimension off the property line. Also please label the retention pond. *The dimensions are now shown on the plan and labels have been provided.*
8. Please provide all dimensions needed to build the proposed French drain along the eastern property line especially the dimension off the property line. *An area drain pipe system is proposed in this area. It drains to the underground stormwater retention area.*
9. Please provide size of the drain pipe and proposed inlet rim elevations along with pipe inverts. *This information has been provided.*
10. Please provide the swale grades. *Spot elevations for concrete, swales and piping inverts have been provided.*
11. Since this site is in the Valley region, please follow Chapter 22 Section 5.G (Flat Grading Scheme). The following conditions must be applied to the site: *This plan proposes underground storage of the 100yr 6hr runoff volume. This was discussed with Mr. Doug Hughes prior to development of the plan.*
12. Please show how the overflow of 0.1 cfs is leaving the site from the retention pond. *The overflow location is shown on the plan.*
13. Please clarify the retention detail dimensions. Are these in inches or feet? Also please use aggregate instead of clean rounded cobble. *Dimensions have been provided. The clean rounded cobble is required to achieve the 30% porosity for the underground stormwater storage area.*
14. In the provided retention pond volume calculations, which dimensions are to be used in this project? There are five shown. *The developer has chosen the 15'x14'x4.5 configuration. This is shown on the plan.*
15. The site section does not provide any relevant information and can be removed. *The section now shows piping inverts and slopes for the proposed swale and area drain system as requested in 9 above.*

Comments 16, 17 and 18 are noted. Thank you for these reminders.

Please call if you have any questions or comments on this matter.






Sincerely

Don Briggs PE CFM



GRADING KEY

- fence
- lotline
- block wall
- easements
- proposed retention pond
- concrete pads
- proposed curb extension

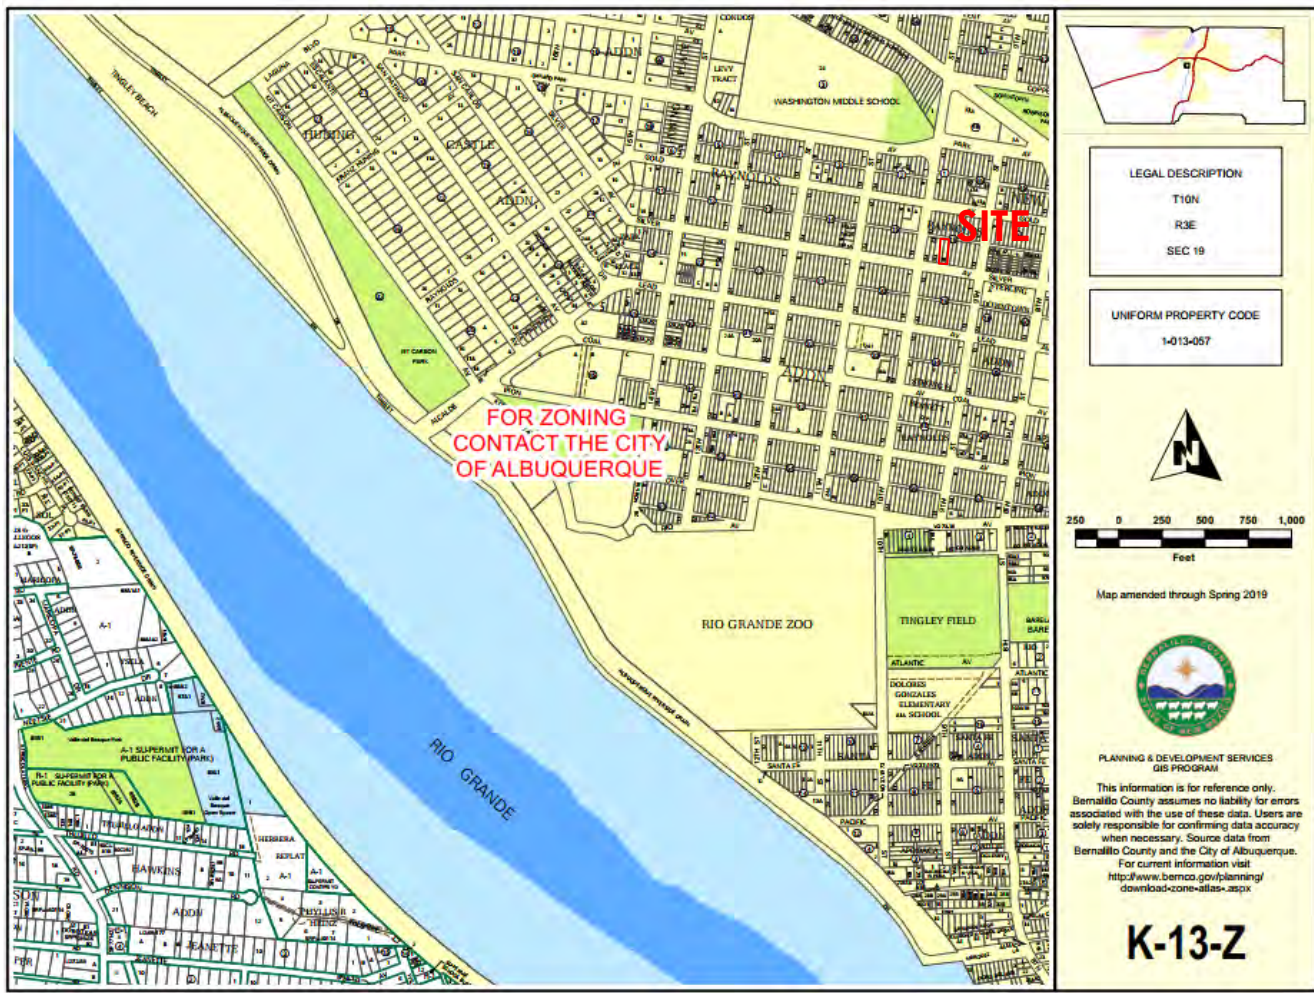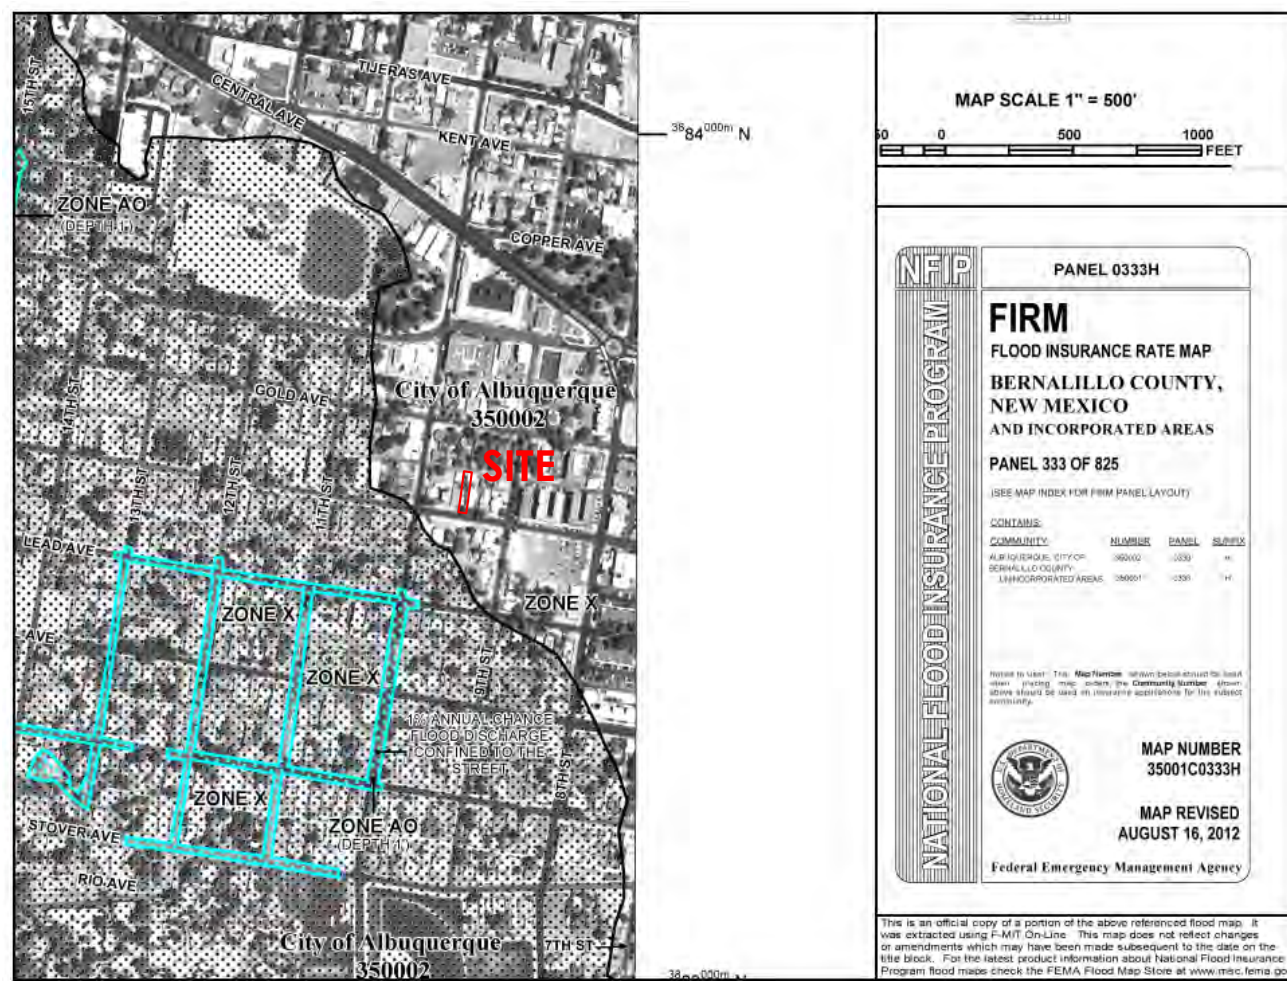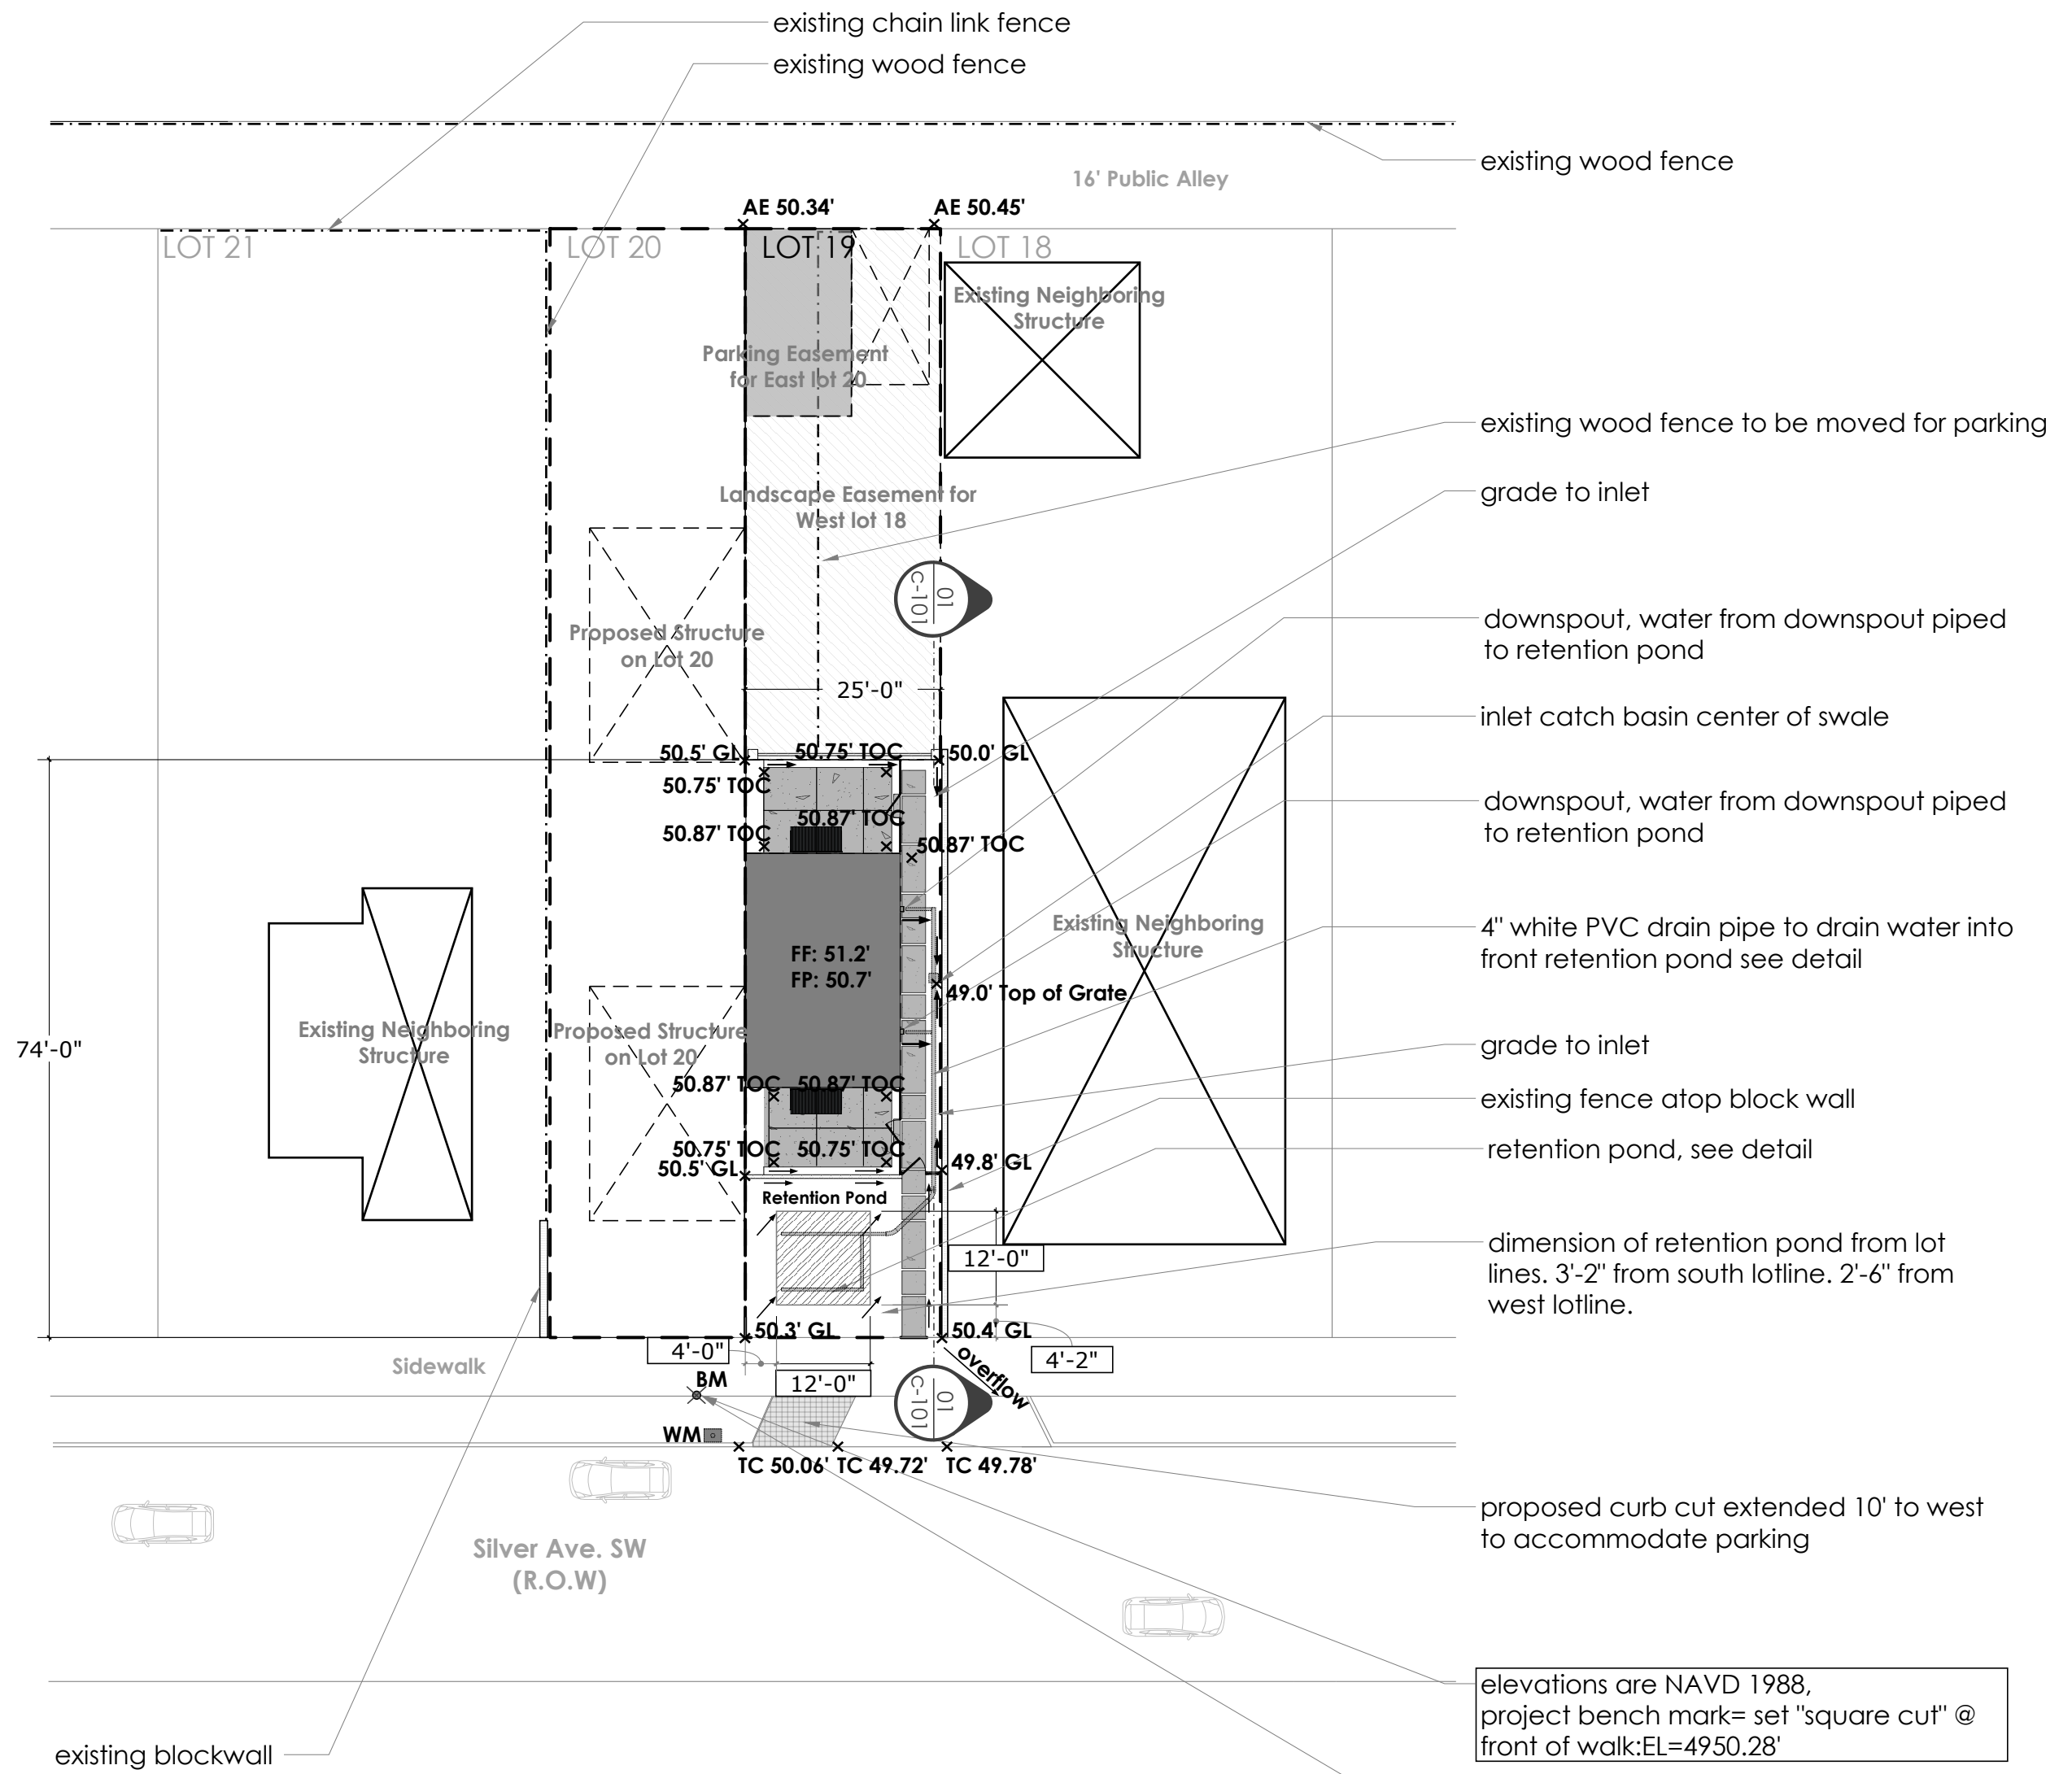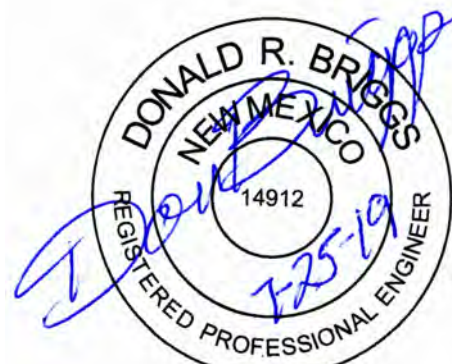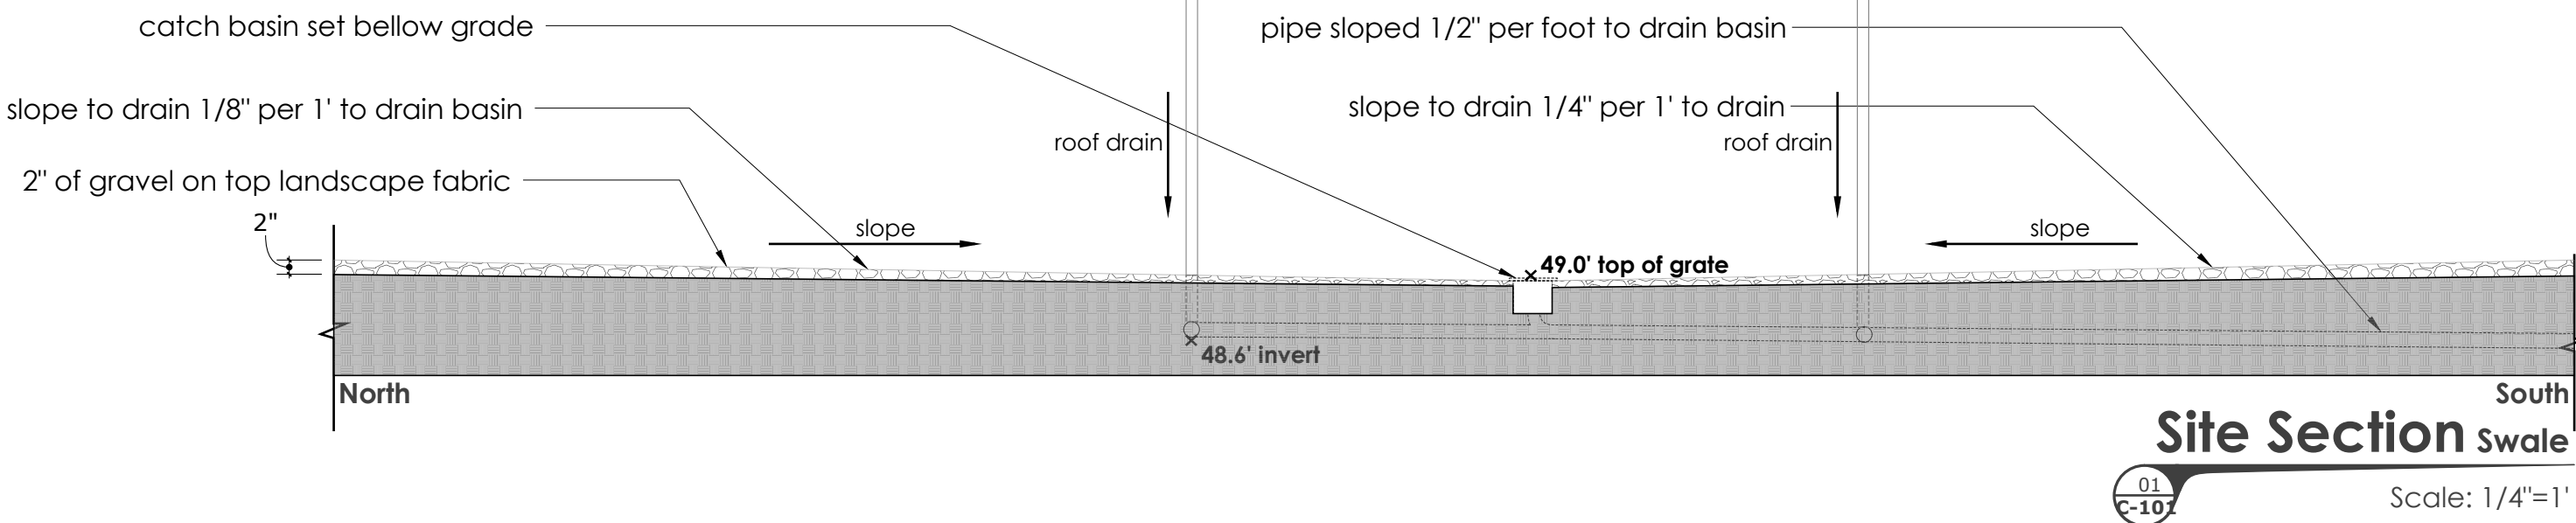

DRAINAGE NARRATIVE

This grading & drainage plan was prepared to support a building permit application for a new residence located at 913 Silver Ave. SW (Lot 19, Block 16, Reynolds Addn.). A pre-development meeting with City Hydrology staff indicates that full retention of the 100yr. 6hr. runoff volume is required for this property due to the lack of capacity of the storm drain system in Silver Ave. The site is a 0.07 acre parcel located in Precipitation Zone 2 and Floodzone X (Unshaded). It is generally flat at an elevation of around 4950' MSL. The property has existing structures that have been granted an easement for the benefit of the adjacent land owner to the east. This plan will only address the new construction. Existing structures will drain as they have historically. The site is not impacted by cross lot runoff from adjacent properties.



This plan was prepared using the hydrology methodology presented in Chapter 22.2 of the City of Albuquerque's Development Process Manual (abbreviated method). Due to the limited space, underground storage in a porous French Drain system is proposed for containment of the 100yr. 6hr. runoff volume. Stormwater runoff will be directed to the French Drain system via area drains. Inlets to the area drain pipes will include grates and sumps to capture sediment and trash. Hydrology and French Drain volume calculations are presented in the included table. Multiple dimensions for the French Drain are presented to give the builder some alternatives in construction.

GENERAL NOTES

Contractor is responsible for utility spots and controlling sediment deposition and erosion during construction.

A concrete washout bin must be provided as per City of Albuquerque MS4 Permit requirements.

All disturbed area due to construction must be reseeded or landscaped following construction.

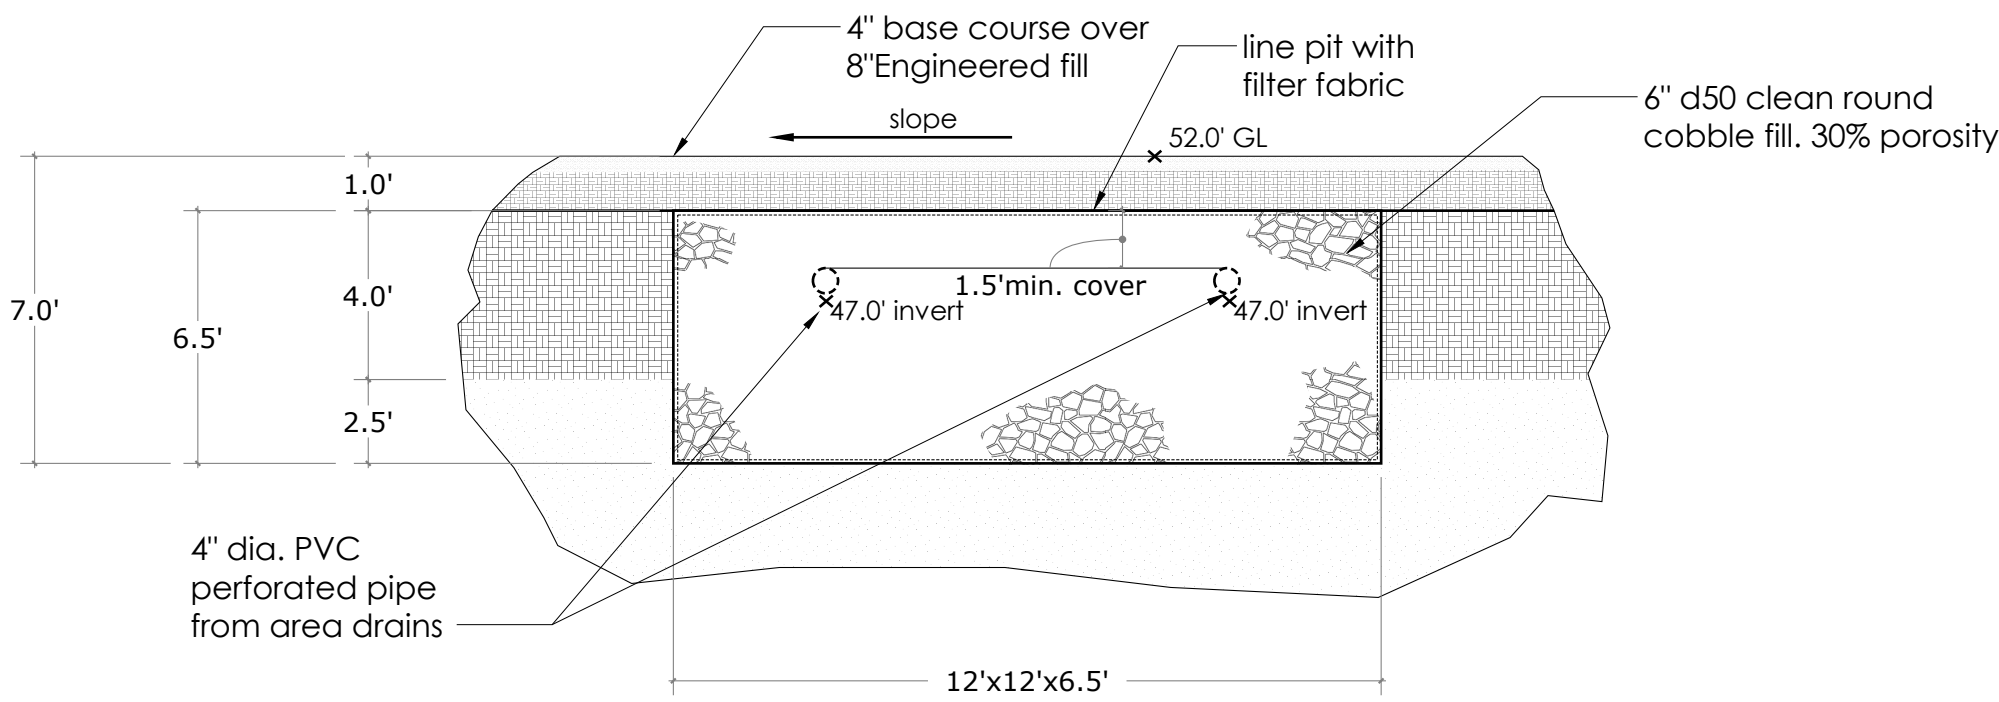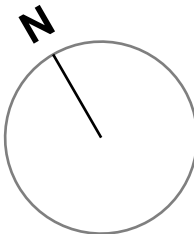

Retention Detail

Hydrology Calculations						
913 Silver SW						
Precipitation Zone 2						
100 yr 6 hr Storm						
Basin Area =		0.042544	ac.	1853.2	sq ft	Determined by DB
Land Treatment	Percent	Area (ac.)	Excess Precipitation (in.)	Unit Peak Discharge (cfs/ac.)	Runoff Volume (ac. Ft.)	Peak Discharge (cfs)
A	0.00%	0.00	0.53	1.56	0.00	0.00
B	8.13%	0.00	0.78	2.28	0.00	0.00
C	18.60%	0.00	1.13	3.14	0.00	0.02
D	73.26%	0.03	2.12	4.70	0.00	0.14
TOTAL	100.00%	0.04	1.82		0.00	0.17
Required 100yr 6hr Storage Volume =				282	cu ft	
Required French Drain Volume @ 30% Porosity =				940	cu ft	
Drain Volume Dimensions			W	L	D	
			15.0	14.0	4.47	
			12.0	12.0	6.53	

505-246-4843  
donbriggsengineering@gmail.com  
5524 Callejita Ct. NW, Albuquerque, NM 87120

DON BRIGGS  
Engineering LLC

DUPLEX

915 Silver Avenue SW, Lot 19, Albuquerque, NM,  
87102

Revisions Grading and Drainage C-101		Remarks	
NO.	Date		

Grading and Drainage

C-101