

REGINA HALL DRAINAGE PLAN

K15/D18

12-1-83

PROJECT LOCATION

34.75 - DESIGN ELEVATION
AS BUILT ELEVATIONS
SURVEYED BY BOYLE
ENGINEERING CORP.
12/1/83


VICINITY MAP
ZONE ATLAS NO. K-15-2

BENCH MARK LOCATION:
ALL ELEVATIONS SHOWN HEREON ARE REFERENCED TO NMSHC
MONUMENT "1-25-26", A BRASS CAP 6 FEET WEST OF THE
NORTHWEST CORNER OF THE BRIDGE FOR SOUTH-BOUND LANE
OF I-25 AT GRAND AVENUE OVERPASS. ELEV. = 5068.8'


LEGEND

DRAINAGE SUBAREAS

A
B
C
D

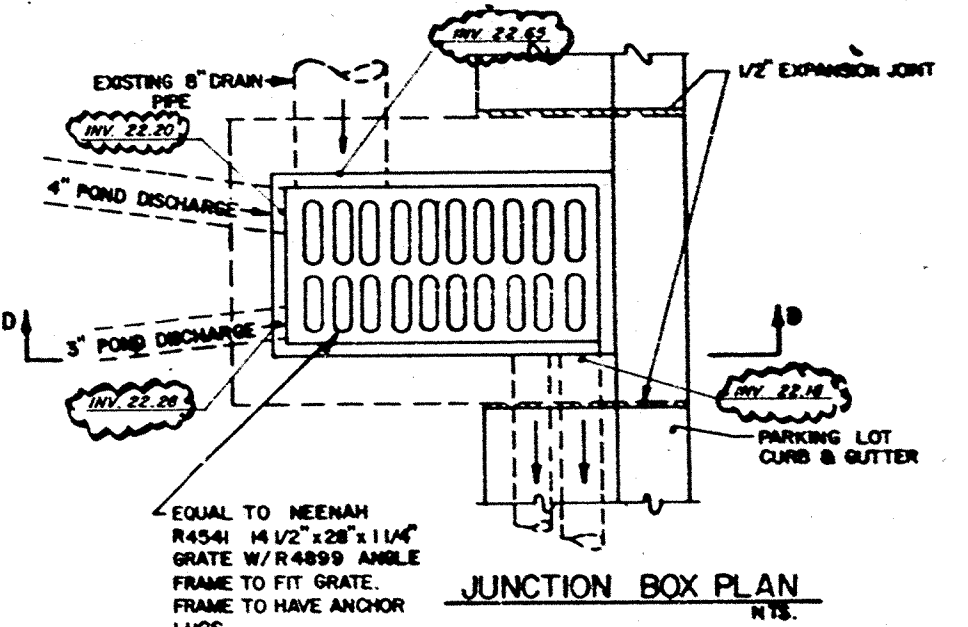

SECTION E-E

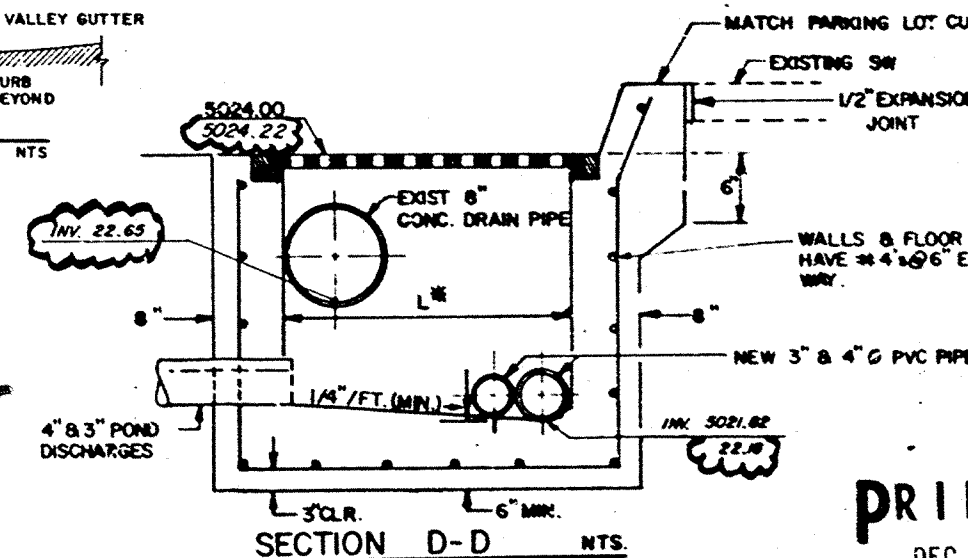

PRINTED
DEC 2 1983
BOYLE
ENGINEERING CORPORATION

K15/D18

REGINA HALL DRAINAGE PLAN

STEVENSON, MALLORY, PEARL & CAMPBELL, P.A.
ARCHITECTS
100 NORTH FIRST ST. ALEXANDRIA, VA 22304
12/30/83

CHECKED
P.D.L.

DESIGNED
J.D.M.

DATE

12/30/83

101

