

PROPOSED 12"

PRIVATE ACCESS

Z EXIST. CONC. SIDENACK 75116.0

MEN 34' CURB CUT

1.55 2.28 3.14 4.70 [0.00, 0.38] [0.08, 0.95] [0.60, 1.71] [1.86, 3.14] 1.87 2.60 3.45 5.02 [0.00, 0.58] [0.21, 1.19] [0.78, 2.00] [2.04, 3.39] 2.20 2.92 3.73 5.25 [0.05, 0.87] [0.38, 1.45] [1.00, 2.26] [2.17, 3.57]

Zone	Intensity	100-YR { 2-YR, 10-YR
. 1	4.70 [1.84, 3.14]	
2	5.05 [2.04, 3.41]	
3	5.38 [2.21, 3.65]	
4	5.61 [2.34, 3.83]	

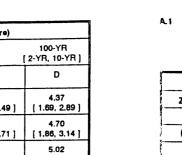


FIGURE	E A-1	1
Blo Granda San Matteo	Eubenk Range 4 1/2 or 5 E Range 4 1/2 or 5 E	Where watersh extends zone bo use the which cothelarg portion watersh

West of the Rio Grande

Bernalillo County's four precipitation zones are indicated in TABLE A-1 and on

Between San Mateo and Eubank, North of Interstate 40; and

East of Eubank, North of Interstate 40; and East of the East boundary of Range 4 East, South of Interstate 40

TABLE A-1. PRECIPITATION ZONES

Between the Rio Grande and San Mateo

DPM SECTION 22.2 - HYDROLOGY

Treatment	Land Condition
A	Soll uncompacted by human activity with 0 to 10 percent slopes. Native grasses, weeds and shrubs in typical densities with minima disturbance to grading, groundcover and infiltration capacity. Croplands. Unlined arroycs.
В	Irrigated lawns, parks and golf courses with 0 to 10 percent slopes Native grasses, weeds and shrubs, and soil uncompacted by hum activity with slopes greater than 10 percent and less than 20 percent
С	Soil compacted by human activity. Minimal vegetation. Unpaved parking, roads, trails. Most vacant lots. Gravel or rock on plastic (desert landscaping). Irrigated lawns and parks with slopes great than 10 percent. Native grasses, weeds and shrubs, and soil uncompacted by human activity with slopes at 20 percent or great Native grass, weed and shrub areas with clay or clay loam soils a other soils of very low permeability as classified by SCS Hydrolog Soil Group D.
D	Impervious areas, pavement and roofs.

treatments, measure respective subareas. In lieu of specific measurement for treatment D, the areal percentages in TABLE A-5 may be employed.

K-15-Z

EROSION CONTROL MEASURES:

THE CONTRACTOR SHALL BE HELD RESPONSIBLE FOR MANAGEMENT OF STORM RUNOFF DURING CONSTRUCTION; HE SHALL ENSURE THAT THE FOLLOWING MEASURES ARE

- 1) ADJACENT PROPERTY SHALL BE PROTECTED AT ALL TIMES BY CONSTRUCTION OF BERMS, DIKES, SWALES, PONDS, AND OTHER TEMPORARY GRADING AS REQUIRED TO PREVENT STORM RUNOFF FROM LEAVING THE SUBJECT SITE AND ENTERING ADJACENT PROPERTIES
- 2) ADJACENT PUBLIC RIGHT-OF-WAYS SHALL BE PROTECTED AT ALL TIMES FROM STORM WATER RUNOFF FROM THE SUBJECT SITE. NO SEDIMENT BEARING WATER SHALL BE PERMITTED TO ENTER PUBLIC STREET RIGHT-OF-WAYS.
- 3) THE CONTRACTOR SHALL IMMEDIATELY AND THOROUGHLY REMOVE ANY AND ALL SEDIMENT FROM PUBLIC STREETS THAT HAS BEEN ERODED FROM THE SUBJECT SITE AND DEPOSITED THEREON.

CONSTRUCTION NOTES:

- 1) TWO (2) WORKING DAYS PRIOR TO ANY EXCAVATION, CONTRACTOR MUST CONTACT LINE LOCATING SERVICE AT 260-1990 FOR THE ACTUAL FIELD LOCATION OF THE EXISTING SURFACE OF SUB-SURFACE UTILITIES.
- 2) PRIOR TO CONSTRUCTION, THE CONTRACTOR SHALL EXCAVATE AND VERIFY THE HORIZONTAL AND VERTICAL LOCATION(S) OF ALL POTENTIAL OBSTRUCTIONS, SHOULD A CONFLICT EXIST, THE CONTRACTOR SHALL NOTIFY THE ENGINEER SO THAT THE CONFLICT CAN BE RESOLVED WITH A MINIMUM OF
- 3) ALL WORK ON THIS PROJECT SHALL BE PERFORMED IN ACCORDANCE WITH ALL APPLICABLE FEDERAL, STATE, AND LOCAL LAWS, RULES AND REGULATIONS CONCERNING CONSTRUCTION SAFETY AND HEALTH.
- 4) ALL CONSTRUCTION WITHIN PUBLIC STREET RIGHT-OF-WAY(S) SHALL BE PERFORMED IN ACCORDANCE WITH APPLICABLE CITY OF ALBUQUERQUE/BERNALILLO COUNTY STANDARDS AND PROCEDURES

LEGEND:

TOP OF CURB ELEVATION = 7C = G3.03CURB FLOWLINE ELEVATION = $\cancel{E} = G2.37$ EXISTING SPOT ELEVATION = • 632 EXISTING CONTOUR ELEVATION = _ - GA.O - _ - -PROPOSED SPOT ELEVATION = + C450 PROPOSED CONTOUR ELEVATION = - G4.0 - G4.0


PROPOSED OR EXISTING CONCRETE SURFACE = \(\frac{1}{2}\). EXISTING FENCE LINE =


C EXISTING C.M.U. BLOCK WILL


(D) - PROPOSED RETAINING WALL TO BE DESIGNED BY PROJECT ARCHITECT

GENERAL NOTES:

- 1) NO PERIMETER BOUNDARY CORNERS HAVE BEEN FIELD ESTABLISHED PER THIS SURVEY OF THE SUBJECT PROPERTY.
- 2) NO SEARCH HAS BEEN MADE FOR EASEMENTS OF RECORD OTHER THAN SHOWN HERON.

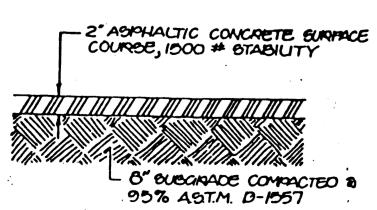

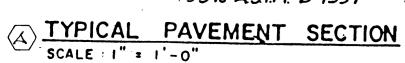

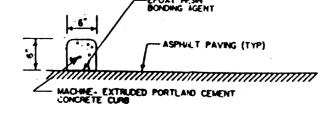

EXTRUDED CONCRETE CURB SECTION

MOTE: REMOVE REQUIRED CURB CUTS, SUDEWALKS, CURB & GUTTER, AND REPLACE WITH NEW PROPOSED CURS CUTT, SIDENALK, CURS & GUTTER PER C.O. A. STANDARDS.

> ARCHITECT TO PROVIDE A ROOF GUITTER DESIGN TO DISCHARGE FLOWS TO DRIVERAD(S)

TIJERAS

DRAINAGE COMMENTS:

AS SHOWN ON THE VICINITY MAP HEREON, THE SUBJECT SITE IS LOCATED ON THE SOUT SIDE OF DR. MARTIN LUTHER KING, JR. AVENUE N.E., AND, TWO (2) BLOCKS EAST OF INTERSTATE HIGHWAY NO. 25, IN THE CITY OF ALBUQUERQUE, BERNALILLO COUNTY, NE MEXICO, (CITY ZONE ATLAS MAP 'K-15-Z').

THE SUBJECT SITE IS PRESENTLY A VACANT INFILL PROPERTY; THE PROPOSED PLAN AS SHOWN HEREON, IS TO CONSTRUCT EIGHT (8) TOWNHOME UNITS ON SAID PROPERTY TOGETHER WITH ASSOCIATED IMPROVEMENTS THEREON.

THE SUBJECT SITE, 1.) DOES NOT LIE WITHIN A DESIGNATED FLOODPLAIN, NOR DOES IT HAVE DOWNSTREAM FLOODING CONDITIONS (RE: F.E.M.A. PANEL 334 OF 825), 2.) DOES ACCEPT VERY MINIMAL OFFSITE FLOWS THROUGH A 4" P.V.C. DRAINPIPE IN WALL THAT ALONG THE EAST PROPERTY LINE OF THIS PROPERTY (THESE OFFSITE FLOWS WILL CON-TINUE TO BE ACCEPTED AND PASSED THROUGH THE SUBJECT PROPERTY), 3.) DOES NOT CONTRIBUTE TO THE OFFSITE FLOWS OF ADJACENT PROPERTIES, 4.) DOES NOT LIE AD-JACENT TO A NATURAL OR ARTIFICIAL WATER COURSE, 5.) IS ALLOWED FREE DISCHARGI OF DEVELOPED FLOWS INTO THE ADJACENT STREET RIGHT-OF-WAYS, (THESE FLOWS DO NOT AND WILL NOT HAVE AN ADVERSE IMPACT TO DOWSTREAM PROPERTIES).

CALCULATIONS:

PER SECTION 22.2, HYDROLOGY OF THE DEVELOPMENT PROCESS MANUAL, VOLUME 2., DESIGN CRITERIA FOR THE CITY OF ALBUQUERQUE, BERNALILLO COUNTY, NEW MEXICO.

SITE AREA: 0.43 ACRE

PRECIPITATION ZONE : TWO (2)

PEAK INTENSITY: IN./HR. AT Tc = TWELVE (12) MINUTES, 100-YR. - 6 HR. = 5.05

LAND TREATMENT METHOD FOR THE CALCULATION OF "Qp", TABLES A-8 & A-9.

LAND TREATMENT FACTORS, TABLE A-4

EXISTING CONDITIONS

TREATMENT	AREA/ACRES		FACTOR		CFS
С	0.43	X	3.14	=	1.35
D	0.00	X	4.70	=	0.00

"Qp" = 1.35 CFS

PROPOSED DEVELOPED CONDITIONS

TREATMENT	AREA/ACRES		FACTOR	CFS
C	0.18	X	3.14 =	0.57
D	0.25	X	4.70 =	1.18


"QP" = 1.75 CFS INCREASE = 0.40 CFS


LEGAL DESCRIPTION:

PRESENTLY TRACT "A", BLOCK 28, BROWNEWELL & LAIL'S HIGHLAND ADDITION, ALBUQUERQUE, NEW MEXICO, (TO BE REPLATTED INTO 8 TOWNHOUSE LOTS).

BENCHMARK REFERENCE:

ACS STATION "4-K15" LOCATED AT THE INTERSECTION OF CENTRAL AVENUE AND OAK STREET N.E.; ELEVATION = 5045.07, (PROJECT T.B.M. AS SHOWN ON THE PLAN HEREON).

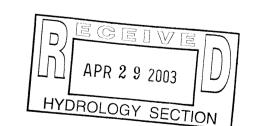


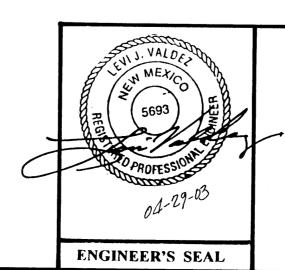


A PROPOSED GRADING & DRAINAGE PLAN

DMLK TOWNHOMES

(FIRST CHOICE CUSTOM BUILDERS) ALBUQUERQUE, NEW MEXICO APRIL, 2003

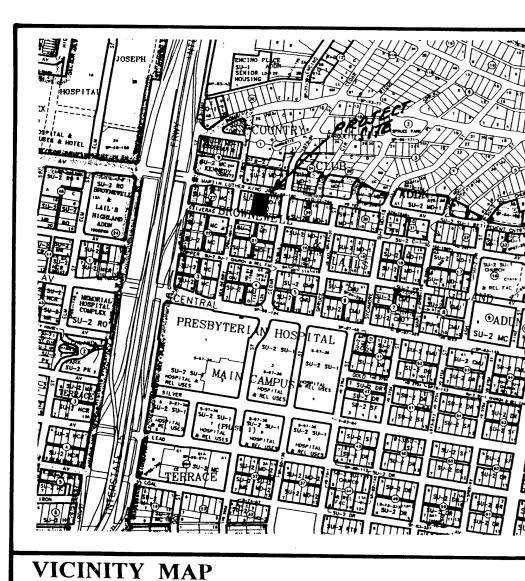

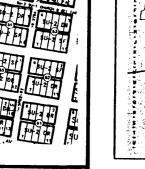

AREA MAP



EROSION CONTROL MEASURES:

THE CONTRACTOR SHALL BE HELD RESPONSIBLE FOR MANAGEMENT OF STORM RUNOFF DURING CONSTRUCTION; HE SHALL ENSURE THAT THE FOLLOWING MEASURES ARE

- 1) ADJACENT PROPERTY SHALL BE PROTECTED AT ALL TIMES BY CONSTRUCTION OF BERMS, DIKES, SWALES, PONDS, AND OTHER TEMPORARY GRADING AS REQUIRED TO PREVENT STORM RUNOFF FROM LEAVING THE SUBJECT SITE AND ENTERING ADJACENT PROPERTIES.
- 2) ADJACENT PUBLIC RIGHT-OF-WAYS SHALL BE PROTECTED AT ALL TIMES FROM STORM WATER RUNOFF FROM THE SUBJECT SITE. NO SEDIMENT BEARING WATER SHALL BE PERMITTED TO ENTER PUBLIC STREET RIGHT-OF-WAYS.
- 3) THE CONTRACTOR SHALL IMMEDIATELY AND THOROUGHLY REMOVE ANY AND ALL SEDIMENT FROM PUBLIC STREETS THAT HAS BEEN ERODED FROM THE SUBJECT SITE AND DEPOSITED THEREON.

CONSTRUCTION NOTES:

- 1) TWO (2) WORKING DAYS PRIOR TO ANY EXCAVATION, CONTRACTOR MUST CONTACT LINE LOCATING SERVICE AT 260-1990 FOR THE ACTUAL FIELD LOCATION OF THE EXISTING SURFACE OF SUB-SURFACE UTILITIES.
- 2) PRIOR TO CONSTRUCTION, THE CONTRACTOR SHALL EXCAVATE AND VERIFY THE HORIZONTAL AND VERTICAL LOCATION(S) OF ALL POTENTIAL OBSTRUCTIONS; SHOULD A CONFLICT EXIST, THE CONTRACTOR SHALL NOTIFY THE ENGINEER SO THAT THE CONFLICT CAN BE RESOLVED WITH A MINIMUM OF
- 3) ALL WORK ON THIS PROJECT SHALL BE PERFORMED IN ACCORDANCE WITH ALL APPLICABLE FEDERAL, STATE, AND LOCAL LAWS, RULES AND REGULATIONS CONCERNING CONSTRUCTION SAFETY AND HEALTH.
- 4) ALL CONSTRUCTION WITHIN PUBLIC STREET RIGHT-OF-WAY(S) SHALL BE PERFORMED IN ACCORDANCE WITH APPLICABLE CITY OF ALBUQUERQUE/BERNALILLO COUNTY STANDARDS AND PROCEDURES.

LEGEND:

TOP OF CURB ELEVATION = 7C = 63.03 CURB FLOWLINE ELEVATION = #= G2.37 EXISTING SPOT ELEVATION = • • • 632 PROPOSED SPOT ELEVATION = $+ \leftarrow C4^{60}$

PROPOSED CONTOUR ELEVATION = ← G4.0 ← PROPOSED OR EXISTING CONCRETE SURFACE = 7


EXISTING FENCE LINE = C EXISTING C.M.U. BLOCK WILL


D RETAINING WALL DESVISH BY PROJECT ARCHITECT


GENERAL NOTES:

1) NO PERIMETER BOUNDARY CORNERS HAVE BEEN FIELD ESTABLISHED PER THIS SURVEY OF THE SUBJECT PROPERTY.


2) NO SEARCH HAS BEEN MADE FOR EASEMENTS OF RECORD OTHER THAN SHOWN HERON.

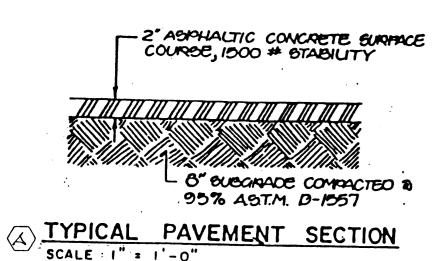

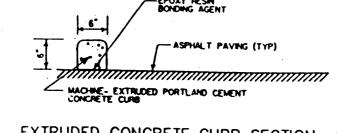

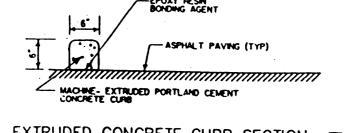

DR. MARTIN LUTHER KING AVE. N.E.

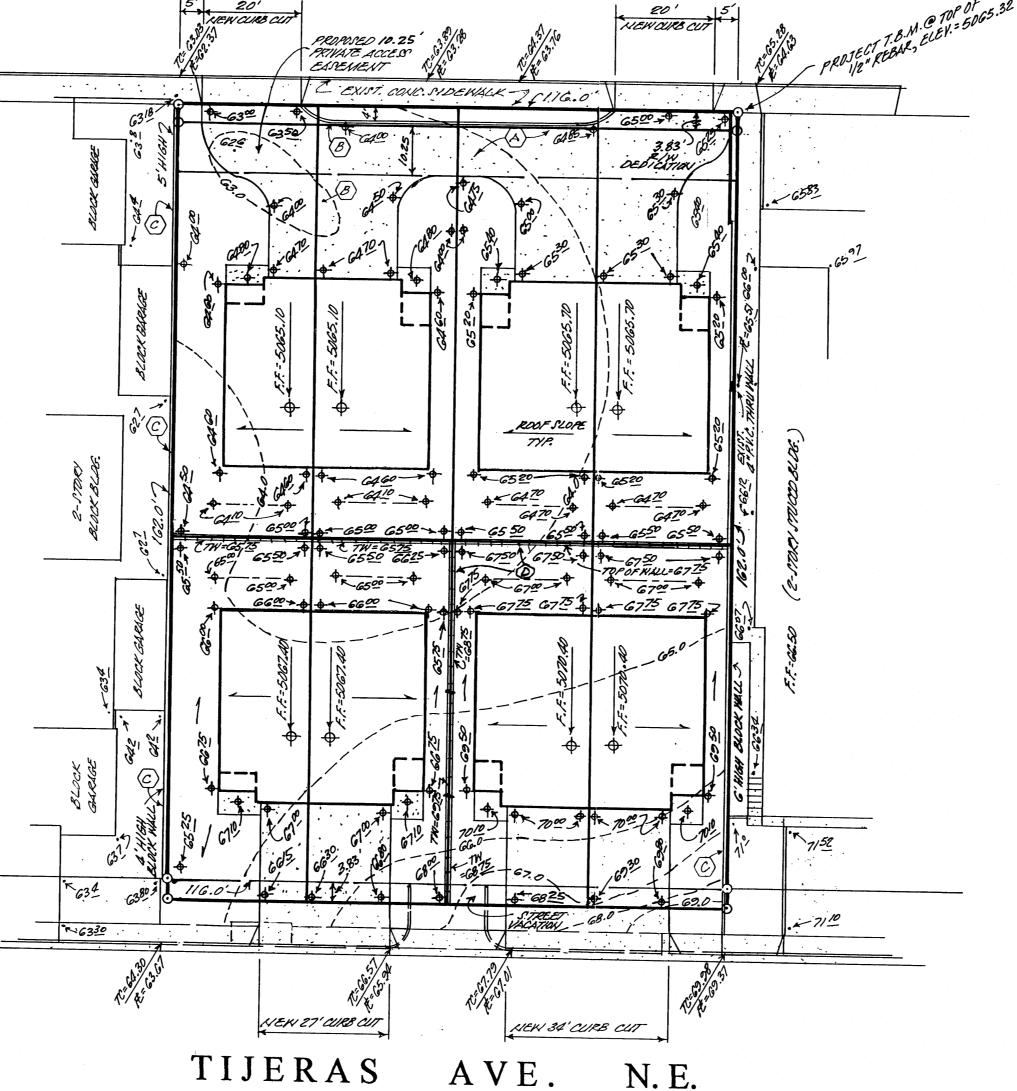

MOTE: REMOVE REQUIRED CURB CUTS, SIDEKILLES, CURB & GUTTER, AND REPLACE WITH NEW PROPOSED CURE CUTT, SIDENALK, CURB & GUTTER PER C.O. A. STANDARDS.

* * ARCHITECT TO PROVIDE & ROOF GUTTER DESIGN TO DISCHARGE FLOKS TO DRIVERAD(S)


TABLE A-9. PEAK DISCHARGE (cfs/acre) 1.29 2.03 2.87 4.37 [0.00, 0.24] [0.03, 0.76] [0.47, 1.49] [1.69, 2.89] 1.87 2.60 3.45 5.02 [0.00, 0.58] [0.21, 1.19] [0.78, 2.00] [2.04, 3.39]

TABLE A-10. P	PEAK INTENSITY (IN/HR at	t _c = 0.2 hour)
Zone	Intensity	100-YR [2-YR, 10-YR]
. 1	4.70 [1.84, 3.14]	-
2	5.05 [2.04, 3.41]	
3	5.38 { 2.21, 3.65 }	
4	5.61 [2.34, 3.83]	

A.1 PRECIPITATION ZONES

Bernalillo County's four precipitation zones are indicated in TABLE A-1 and on

TABLE A-1. PRECIPITATION ZONES					
Zone	Location				
1	West of the Rio Grande				
2	Between the Rio Grande and San Mateo				
3	Between San Mateo and Eubank, North of Interstate 40; and between San Mateo and the East boundary of Range 4 East, South of Interstate 40				
4	East of Eubank, North of Interstate 40; and East of the East boundary of Range 4 East, South of Interstate 40				

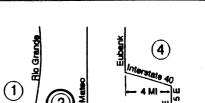

zone boundary, use the zone which contains

DPM SECTION 22.2 - HYDROLOGY

Treatment	Land Condition
A	Soil uncompacted by human activity with 0 to 10 percent slopes. Native grasses, weeds and shrubs in typical densities with minimal disturbance to grading, groundcover and infiltration capacity. Croplands. Unlined arroycs.
В	Irrigated lawns, parks and golf courses with 0 to 10 percent slopes Native grasses, weeds and shrubs, and soil uncompacted by huma activity with slopes greater than 10 percent and less than 20 perce
С	Soil compacted by human activity. Minimal vegetation. Unpaved parking, roads, trails. Most vacant lots. Gravel or rock on plastic (desert landscaping). Irrigated lawns and parks with slopes greate than 10 percent. Native grasses, weeds and shrubs, and soil uncompacted by human activity with slopes at 20 percent or greate Native grass, weed and shrub areas with clay or clay loam soils are other soils of very low permeability as classified by SCS Hydrologic Soil Group D.
D	Impervious areas, pavement and roofs.

DRAINAGE COMMENTS:

AS SHOWN ON THE VICINITY MAP HEREON, THE SUBJECT SITE IS LOCATED ON THE SOUT SIDE OF DR. MARTIN LUTHER KING, JR. AVENUE N.E. AND, TWO (2) BLOCKS EAST OF INTERSTATE HIGHWAY NO. 25, IN THE CITY OF ALBUQUERQUE, BERNALILLO COUNTY, NE. MEXICO, (CITY ZONE ATLAS MAP 'K-15-Z').

THE SUBJECT SITE IS PRESENTLY A VACANT INFILL PROPERTY; THE PROPOSED PLAN AS SHOWN HEREON, IS TO CONSTRUCT EIGHT (8) TOWNHOME UNITS ON SAID PROPERTY TOGETHER WITH ASSOCIATED IMPROVEMENTS THEREON.

THE SUBJECT SITE, 1.) DOES NOT LIE WITHIN A DESIGNATED FLOODPLAIN, NOR DOES IT HAVE DOWNSTREAM FLOODING CONDITIONS (RE: F.E.M.A. PANEL 334 OF 825), 2.) DOES ACCEPT VERY MINIMAL OFFSITE FLOWS THROUGH A 4" P.V.C. DRAINPIPE IN WALL THAT ALONG THE EAST PROPERTY LINE OF THIS PROPERTY (THESE OFFSITE FLOWS WILL CON-TINUE TO BE ACCEPTED AND PASSED THROUGH THE SUBJECT PROPERTY), 3.) DOES NOT CONTRIBUTE TO THE OFFSITE FLOWS OF ADJACENT PROPERTIES, 4.) DOES NOT LIE AD-JACENT TO A NATURAL OR ARTIFICIAL WATER COURSE, 5.) IS ALLOWED FREE DISCHARGI OF DEVELOPED FLOWS INTO THE ADJACENT STREET RIGHT-OF-WAYS, (THESE FLOWS DO NOT AND WILL NOT HAVE AN ADVERSE IMPACT TO DOWSTREAM PROPERTIES).

CALCULATIONS:

PER SECTION 22.2, HYDROLOGY OF THE DEVELOPMENT PROCESS MANUAL, VOLUME 2., DESIGN CRITERIA FOR THE CITY OF ALBUQUERQUE, BERNALILLO COUNTY, NEW MEXICO.

SITE AREA: 0.43 ACRE

PRECIPITATION ZONE: TWO (2)

PEAK INTENSITY: IN./HR. AT Tc = TWELVE (12) MINUTES, 100-YR. - 6 HR. = 5.05

LAND TREATMENT METHOD FOR THE CALCULATION OF "Qp", TABLES A-8 & A-9.

LAND TREATMENT FACTORS, TABLE A-4

EXISTING CONDITIONS

TREATMENT	AREA/ACRES		FACTOR		CFS
C	0.43	X	3.14	=	1.35
D	0.00	X	4.70	=	0.00

"Qp" = 1.35 CFS

PROPOSED DEVELOPED CONDITIONS

TREATMENT	AREA/ACRES		FACTOR	CI
C	0.18	X	3.14 =	0.
D	0.25	X	4 70 =	1 1

"QP" = 1.75 CFS


INCREASE = 0.40 CFS


LEGAL DESCRIPTION:

PRESENTLY TRACT "A", BLOCK 28, BROWNEWELL & LAIL'S HIGHLAND ADDITION, ALBUQUERQUE, NEW MEXICO, (TO BE REPLATTED INTO 8 TOWNHOUSE LOTS).

BENCHMARK REFERENCE:

ACS STATION "4-K15" LOCATED AT THE INTERSECTION OF CENTRAL AVENUE AND OAK STREET N.E.; ELEVATION = 5045.07, (PROJECT T.B.M. AS SHOWN ON THE PLAN HEREON).

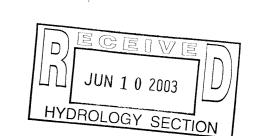

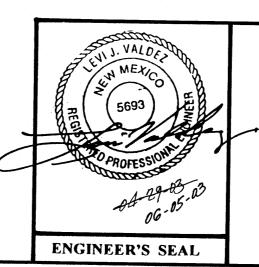

A PROPOSED GRADING & DRAINAGE PLAN **FOR**

DMLK TOWNHOMES

(FIRST CHOICE CUSTOM BUILDERS) ALBUQUERQUE, NEW MEXICO APRIL, 2003







EROSION CONTROL MEASURES:

THE CONTRACTOR SHALL BE HELD RESPONSIBLE FOR MANAGEMENT OF STORM RUNOFF DURING CONSTRUCTION; HE SHALL ENSURE THAT THE FOLLOWING MEASURES ARE

- 1) ADJACENT PROPERTY SHALL BE PROTECTED AT ALL TIMES BY CONSTRUCTION OF BERMS, DIKES, SWALES, PONDS, AND OTHER TEMPORARY GRADING AS REQUIRED TO PREVENT STORM RUNOFF FROM LEAVING THE SUBJECT SITE AND ENTERING ADJACENT PROPERTIES.
- 2) ADJACENT PUBLIC RIGHT-OF-WAYS SHALL BE PROTECTED AT ALL TIMES FROM STORM WATER RUNOFF FROM THE SUBJECT SITE. NO SEDIMENT BEARING WATER SHALL BE PERMITTED TO ENTER PUBLIC STREET RIGHT-OF-WAYS.
- 3) THE CONTRACTOR SHALL IMMEDIATELY AND THOROUGHLY REMOVE ANY AND ALL SEDIMENT FROM PUBLIC STREETS THAT HAS BEEN ERODED FROM THE SUBJECT SITE AND DEPOSITED THEREON.

CONSTRUCTION NOTES:

- 1) TWO (2) WORKING DAYS PRIOR TO ANY EXCAVATION, CONTRACTOR MUST CONTACT LINE LOCATING SERVICE AT 260-1990 FOR THE ACTUAL FIELD LOCATION OF THE EXISTING SURFACE OF SUB-SURFACE UTILITIES.
- 2) PRIOR TO CONSTRUCTION, THE CONTRACTOR SHALL EXCAVATE AND VERIFY THE HORIZONTAL AND VERTICAL LOCATION(S) OF ALL POTENTIAL OBSTRUCTIONS; SHOULD A CONFLICT EXIST, THE CONTRACTOR SHALL NOTIFY THE ENGINEER SO THAT THE CONFLICT CAN BE RESOLVED WITH A MINIMUM OF
- 3) ALL WORK ON THIS PROJECT SHALL BE PERFORMED IN ACCORDANCE WITH ALL APPLICABLE FEDERAL, STATE, AND LOCAL LAWS, RULES AND REGULATIONS
- 4) ALL CONSTRUCTION WITHIN PUBLIC STREET RIGHT-OF-WAY(S) SHALL BE PERFORMED IN ACCORDANCE WITH APPLICABLE CITY OF

LEGEND:

TOP OF CURB ELEVATION = 7C = G3.03 CURB FLOWLINE ELEVATION = 72 = 62.37 EXISTING SPOT ELEVATION = -- - - 632

PROPOSED SPOT ELEVATION = . + ~ C4 60


PROPOSED OR EXISTING CONCRETE SURFACE = 7 EXISTING FENCE LINE =

* RETAINING WALL DESIGN BY PROTECT ARCHITECT

GENERAL NOTES:


1) NO PERIMETER BOUNDARY CORNERS HAVE BEEN FIELD ESTABLISHED PER THIS SURVEY OF THE SUBJECT PROPERTY.

2) NO SEARCH HAS BEEN MADE FOR EASEMENTS OF RECORD OTHER THAN SHOWN HERON.

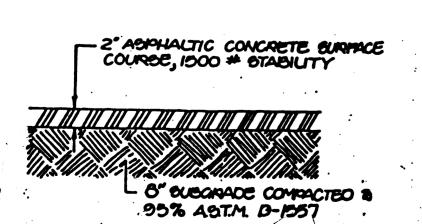

TYPICAL PAVEMENT SECTION

SCALE: 1" = 1'-0"

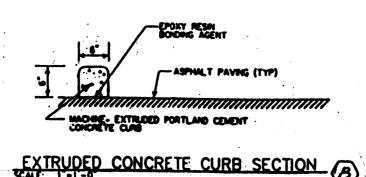

NEW 27' CURB CUT

TIJERAS

MOTE: REMOVE REQUIRED CURB CUTS, SUDEKILLES,

ARCHITECT TO PROVIDE A ROOF GUITTER

PER C.O. X. STXKULLON.

CURB & GUTTER, AND REPLACE WITH NEW PROPOSED CURS CUTT, SYDEWALK, CURS & GUTTER

DESIGN TO DISCHARGE FLOKS TO DRIVERADIS

DR. MARTIN LUTHER KING AVE. N.E.

- EXIST. COLE. SIDENAUX - 1116.0"

PRIVATE ACCES

AREA MAP

CONCERNING CONSTRUCTION SAFETY AND HEALTH. ALBUQUERQUE/BERNALILLO COUNTY STANDARDS AND PROCEDURES.

EXISTING CONTOUR ELEVATION = _ - G4.0 - _ - -

PROPOSED CONTOUR ELEVATION = - G4.0

C EXISTING C.M.U. BLOCK WALL


DRAINAGE CERTIFICATION:

MEN 34' CURB CUT

AVE. N.E.


I, LEVI J. VALDEZ, N.M.P.E. NO. 5693, HEREBY CERTIFY THAT THIS PROJECT HAS BEEN GRADED AND WILL DRAIN IN SUBSTANTIAL COMPLIANCE WITH AND IN ACCORDANCE WITH THE DESIGN INTENT OF THE APPROVED PLAN DATED TUNE 5, 2003. THE RECORD INFORMATION EDITED ONTO THE ORIGINAL DESIGN DOCUMENT HAS BEEN OBTAINED BY ME OR UNDER MY DIRECT SUPERVISION AND IS TRUE AND CORRECT TO THE BEST OF MY KNOW-LEDGE AND BELIEF. THIS CERTIFICATION IS SUBMITTED IN SUPPORT OF A RE-


QUEST FOR Release of Financial Guaranty The RECORD INFORMATION PRESENTED HEREON IS NOT NECESSARILY COMPLETE AND INTENDED ONLY TO VERIFY SUBSTANTIAL COMPLIANCE OF THE GRADING AND DRAINAGE ASPECTS OF THIS PROJECT. THOSE RELYING ON THIS RECORD DOCUMENT ARE ADVISED TO OBTAIN INDEPENDENT VERIFICATION OF ITS ACCURACY BEFORE USING IT FOR ANY OTHER PURPOSES.

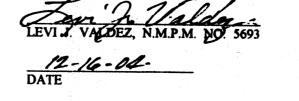

HOTE: "AS-BUILT" ELEVATIONS

SHOKKI THUS (6975)

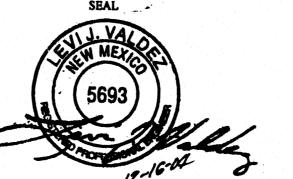

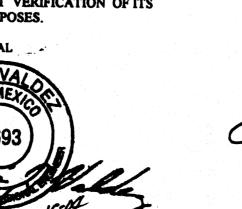

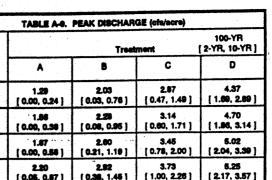


							
 TABLE	TABLE A-10. PEAK INTENSITY (IN/HR at te = 0.2 hour)						
Zone	into	100-Y malty [2-YR, 10-					
1		.70 3, 3.14]					
0		i.06 i, 3.41]					
3		.30 , 3.65 }					
4		.61 , 3.83 }					

2 Between the Pio Grande and San Mateo

	4	East of Eubani boundary of Re	k, North of Inters ange 4 East, So	state 40; and Ea uth of Interstate	st of the East 40
		FIGUR	E A-1		
material and the second of the	①	Ric Granda.	4 M	Parge 4 E 6 (4)	Where a watersh extends zone buse the which cothe large portion watersh

West of the Rio Grande

Bernalillo County's four precipitation zones are indicated in TABLE A-1 and on

TABLE A-1. PRECIPITATION ZONES

Between San Mateo and Eubank, North of Interstate 40; and

DPM SECTION 22.2 - HYDROLOG

TABLE A-4. LAND TREATMENTS				
Treatment	Land Condition			
۸	Soil uncompacted by human activity with 0 to 10 percent slopes. Native grasses, weeds and shrubs in typical densities with minimal disturbance to grading, groundcover and inflitration capacity. Croplands. Unlined arroycs.			
В	Irrigated lawns, parks and golf courses with 0 to 10 percent slopes. Native grasses, weeds and shrubs, and soil uncompacted by human activity with slopes greater than 10 percent and less than 20 percent.			
C	Soil compacted by human activity. Minimal vegetation. Unpaved parking, roads, trails. Most vacant lots. Gravel or rock on plastic (desert landscaping). Irrigated lawns and parks with slopes greater than 10 percent. Native grasses, weeds and shrubs, and soil uncompacted by human activity with slopes at 20 percent or greater. Native grass, weed and shrub areas with clay or clay loam soils and other soils of very low permeability as classified by SCS Hydrologic Soil Group D.			
D	Impervious areas, pavement and roofs.			

treatments, measure respective subareas. In lieu of specific measurement for atment D, the areal percentages in TABLE A-5 may be employed.

DRAINAGE COMMENTS:

AS SHOWN ON THE VICINITY MAP HEREON, THE SUBJECT SITE IS LOCATED ON THE SOUT SIDE OF DR. MARTIN LUTHER KING, JR. AVENUE N.E., AND, TWO (2) BLOCKS EAST OF INTERSTATE HIGHWAY NO. 25, IN THE CITY OF ALBUQUERQUE, BERNALILLO COUNTY, NE MEXICO, (CITY ZONE ATLAS MAP 'K-15-Z').

THE SUBJECT SITE IS PRESENTLY A VACANT INFILL PROPERTY; THE PROPOSED PLAN AS SHOWN HEREON, IS TO CONSTRUCT EIGHT (8) TOWNHOME UNITS ON SAID PROPERTY TOGETHER WITH ASSOCIATED IMPROVEMENTS THEREON.

THE SUBJECT SITE, 1.) DOES NOT LIE WITHIN A DESIGNATED FLOODPLAIN, NOR DOES IT , HAVE DOWNSTREAM FLOODING CONDITIONS (RE: F.E.M.A. PANEL 334 OF 825), 2.) DOES ACCEPT VERY MINIMAL OFFSITE FLOWS THROUGH A 4" P.V.C. DRAINPIPE IN WALL THAT ALONG THE EAST PROPERTY LINE OF THIS PROPERTY (THESE OFFSITE FLOWS WILL CON-TINUE TO BE ACCEPTED AND PASSED THROUGH THE SUBJECT PROPERTY), 3.) DOES NOT CONTRIBUTE TO THE OFFSITE FLOWS OF ADJACENT PROPERTIES, 4.) DOES NOT LIE AD-JACENT TO A NATURAL OR ARTIFICIAL WATER COURSE, 5.) IS ALLOWED FREE DISCHARGI OF DEVELOPED FLOWS INTO THE ADJACENT STREET RIGHT-OF-WAYS, (THESE FLOWS DO NOT AND WILL NOT HAVE AN ADVERSE IMPACT TO DOWSTREAM PROPERTIES).

CALCULATIONS:

PER SECTION 22.2, HYDROLOGY OF THE DEVELOPMENT PROCESS MANUAL, VOLUME 2., DESIGN CRITERIA FOR THE CITY OF ALBUQUERQUE, BERNALILLO COUNTY, NEW MEXICO.

SITE AREA: 0.43 ACRE

PRECIPITATION ZONE : TWO (2)

PEAK INTENSITY: IN./HR. AT Tc = TWELVE (12) MINUTES, 100-YR. - 6 HR. = 5.05

LAND TREATMENT METHOD FOR THE CALCULATION OF "Qp", TABLES A-8 & A-9.

LAND TREATMENT FACTORS, TABLE A-4

EXISTING CONDITIONS:

REATMENT	AREA/ACRES		FACTOR		CFS
C	0.43	x	3.14	=	1.3
D	0.00	x	4.70	=	0.0

"Qp" = 1.35 CFS

PROPOSED DEVELOPED CONDITIONS

FREATMENT	AREA/ACRES		FACTOR		CFS
C	0.18	X	3.14	=	0.57
D	0.25	x	4.70	=	1.18

"QP" = 1.75 CFS


INCREASE = 0.40 CFS


LEGAL DESCRIPTION:

PRESENTLY TRACT "A", BLOCK 28, BROWNEWELL & LAIL'S HIGHLAND ADDITION, ALBUQUERQUE, NEW MEXICO, (TO BE REPLATTED INTO 8 TOWNHOUSE LOTS).

BENCHMARK REFERENCE:

ACS STATION "4-K15" LOCATED AT THE INTERSECTION OF CENTRAL AVENUE AND OAK STREET N.E.; ELEVATION = 5045.07, (PROJECT T.B.M. AS SHOWN ON THE PLAN HEREON).

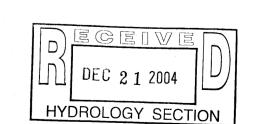

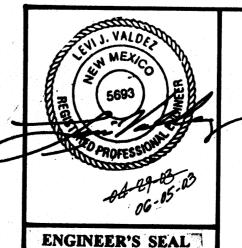

A PROPOSED GRADING & DRAINAGE PLAN **FOR** DMLK TOWNHOMES

(FIRST CHOICE CUSTOM BUILDERS) ALBUQUERQUE, NEW MEXICO APRIL, 2003