

LOCATION MAP  
NOT TO SCALE




NORTH

**ZONING COMPLIANCE**

UNIVERSITY NEIGHBORHOODS SECTOR DEVELOPMENT PLAN  
 ZONED DR (DIVERSE RESIDENTIAL)  
 FLOOR AREA RATIO PERMITTED: 0.5 (MAX.)  
 LOT AREA: 110' X 75' = 8250 SF (0.5) = 4125 SF MAX.  
 OFF-STREET PARKING:  
 1 SPACE FOR 600 SF: 4125/600 = 6.875 ~ 7 SPACES  
 OR 1.5 SPACES PER UNIT: 1.5 (5 UNITS) = 7.5 ~ 8 SPACES

*Per 6-28-05*

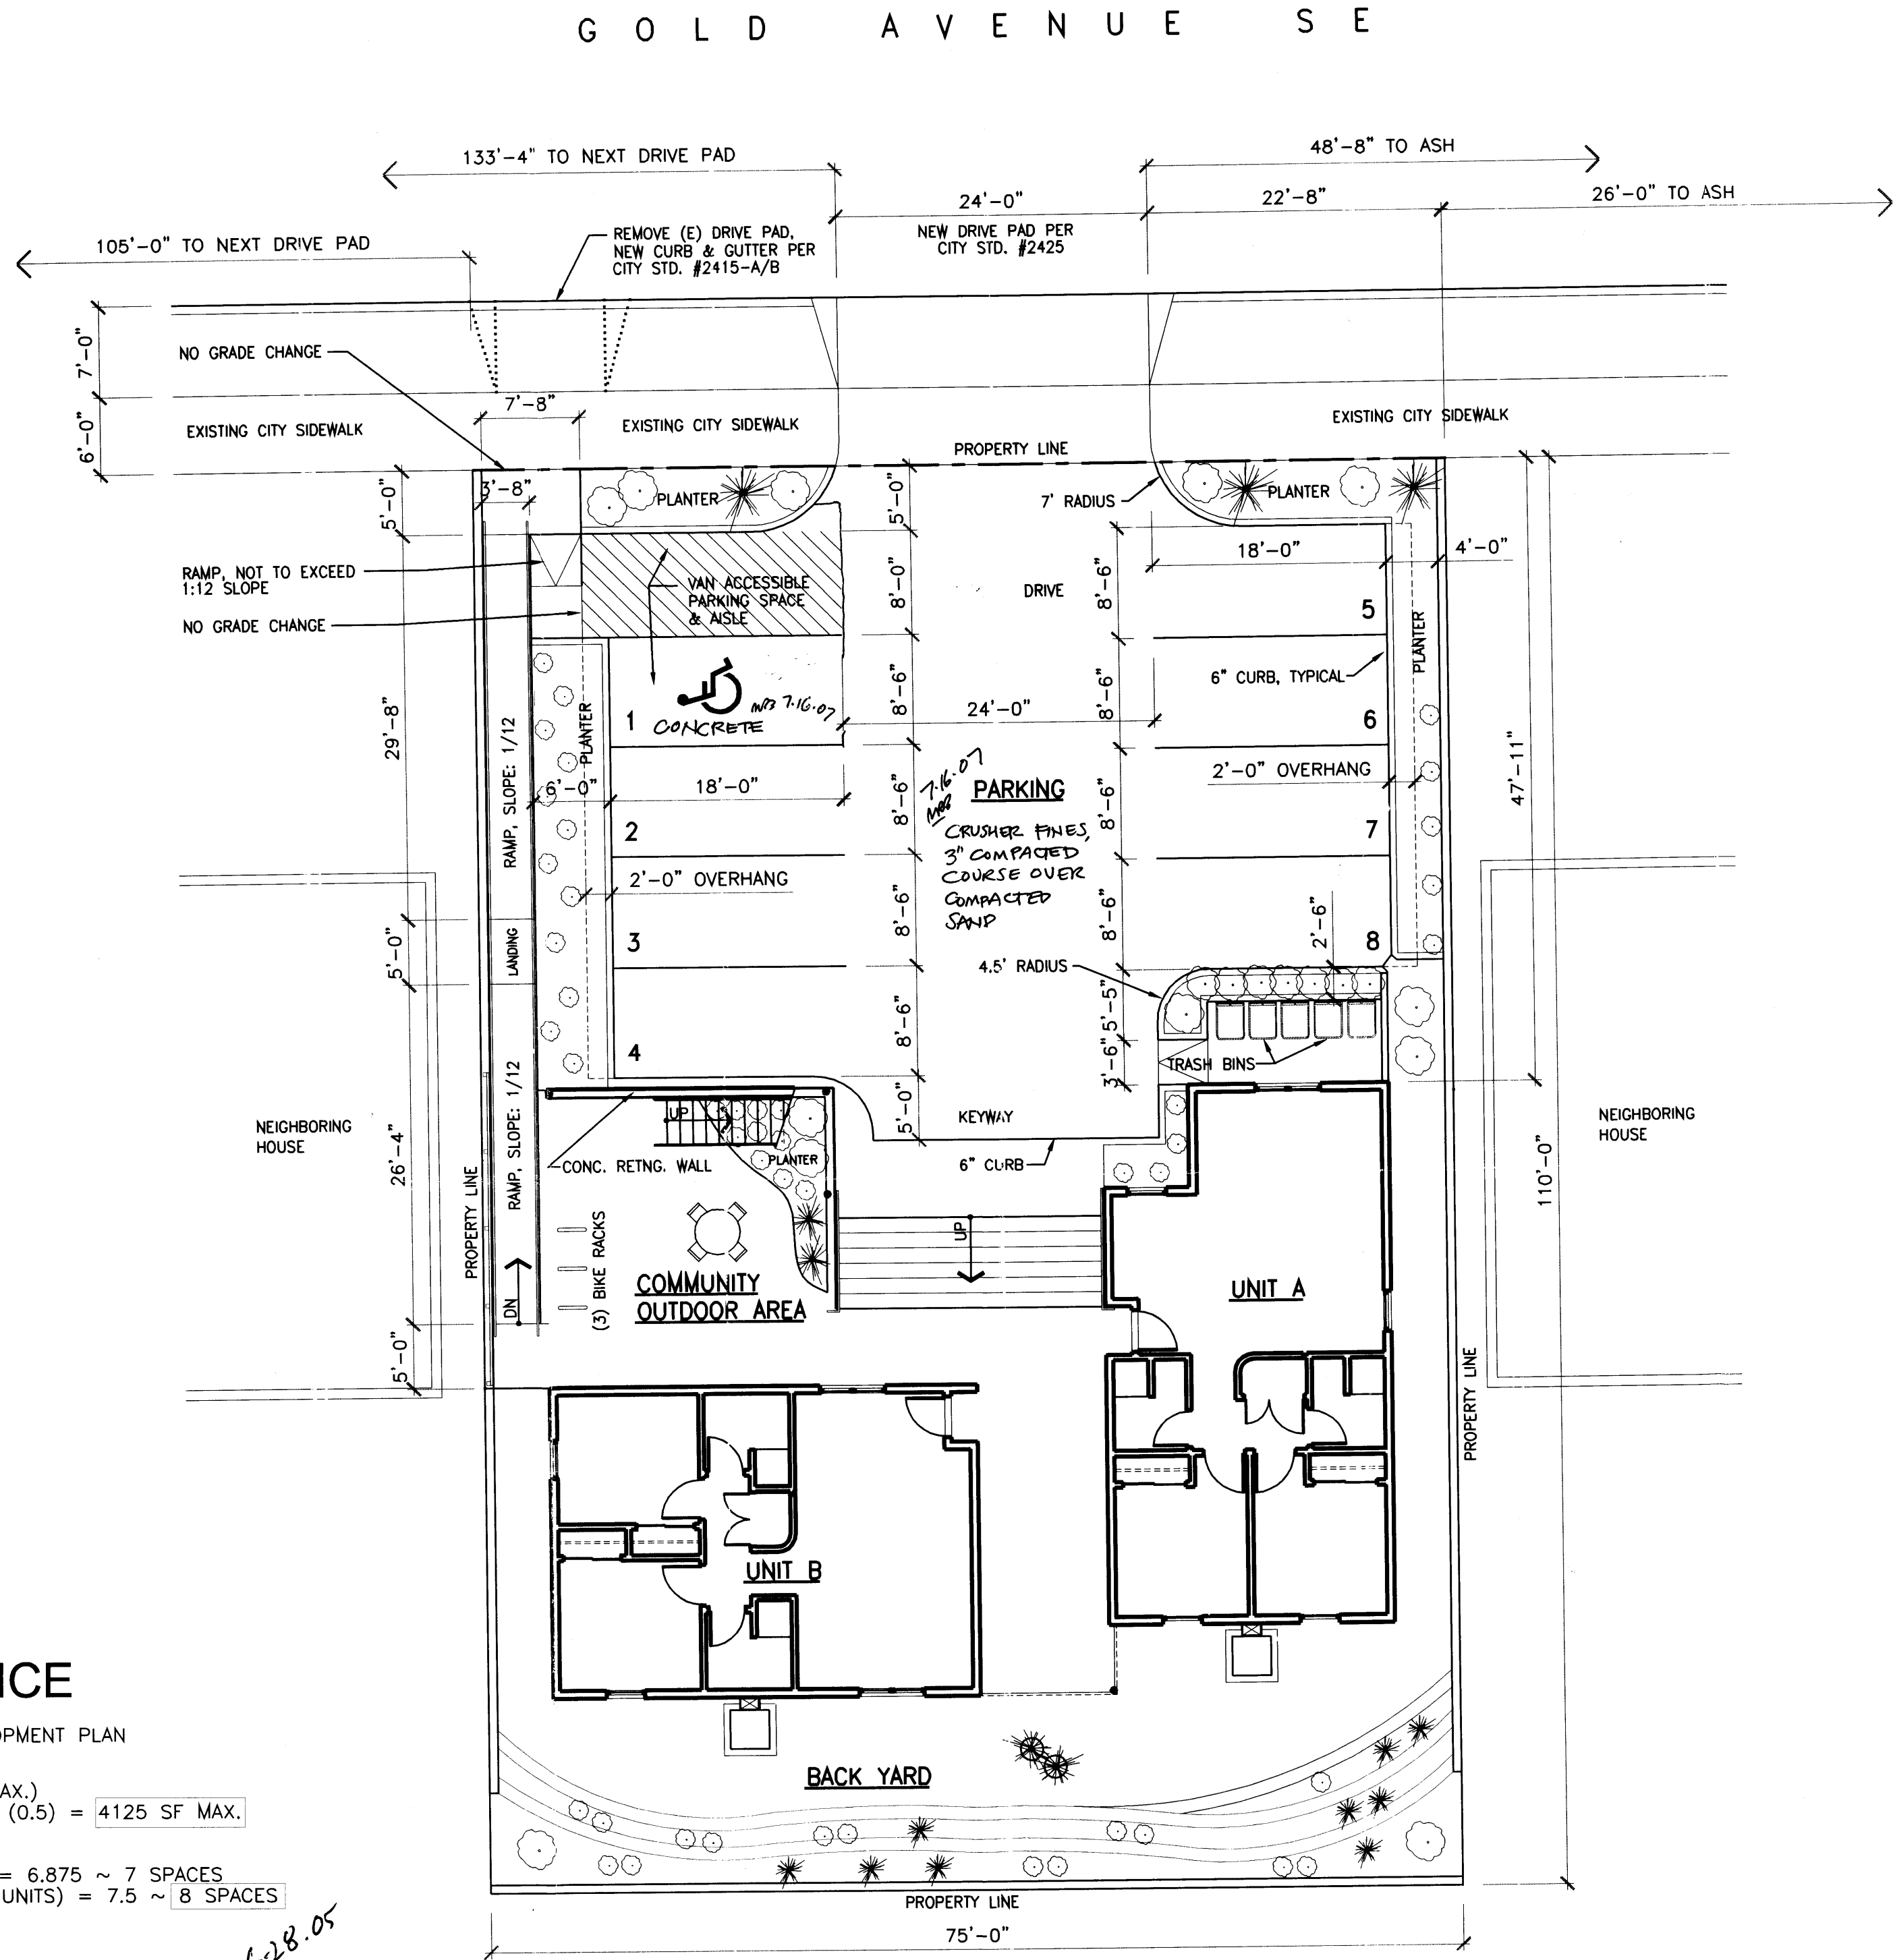

**TRAFFIC CIRCULATION LAYOUT**

SCALE: 1" = 10'



NORTH

CERTIFICATION:  
 THE DEVELOPMENT  
 OF THE T.C.L.  
 WAS BUILT IN  
 SUBSTANTIAL  
 COMPLETION.

BAKER  
 ARCHITECTURE + DESIGN  
 3110 SILVER AVENUE SE  
 ALBUQUERQUE NEW MEXICO 87106  
 T 505.254.4687  
 F 505.254.4687  
 E www.bakerad.com


GOLD APARTMENTS  
 1512 & 1514 GOLD AVENUE SE  
 ALBUQUERQUE, NEW MEXICO 87106



*Mark Baker 7.16.07*


TRAFFIC CIRCULATION LAYOUT  
 APPROVED  
 [Signature] 6/29/05  
 Signed Date

PROJECT NO. : 0501  
 DATE : 22 MAR 2005  
 DRAWN BY :  
 SCALE : AS NOTED

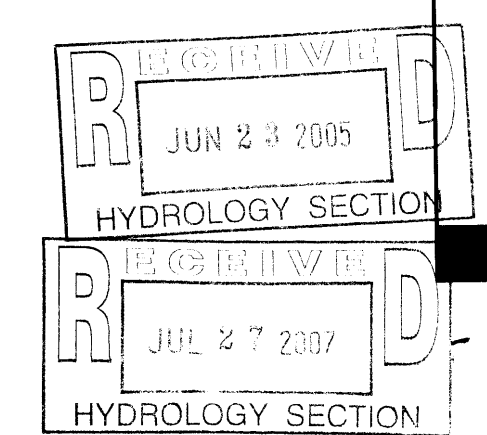


TCL



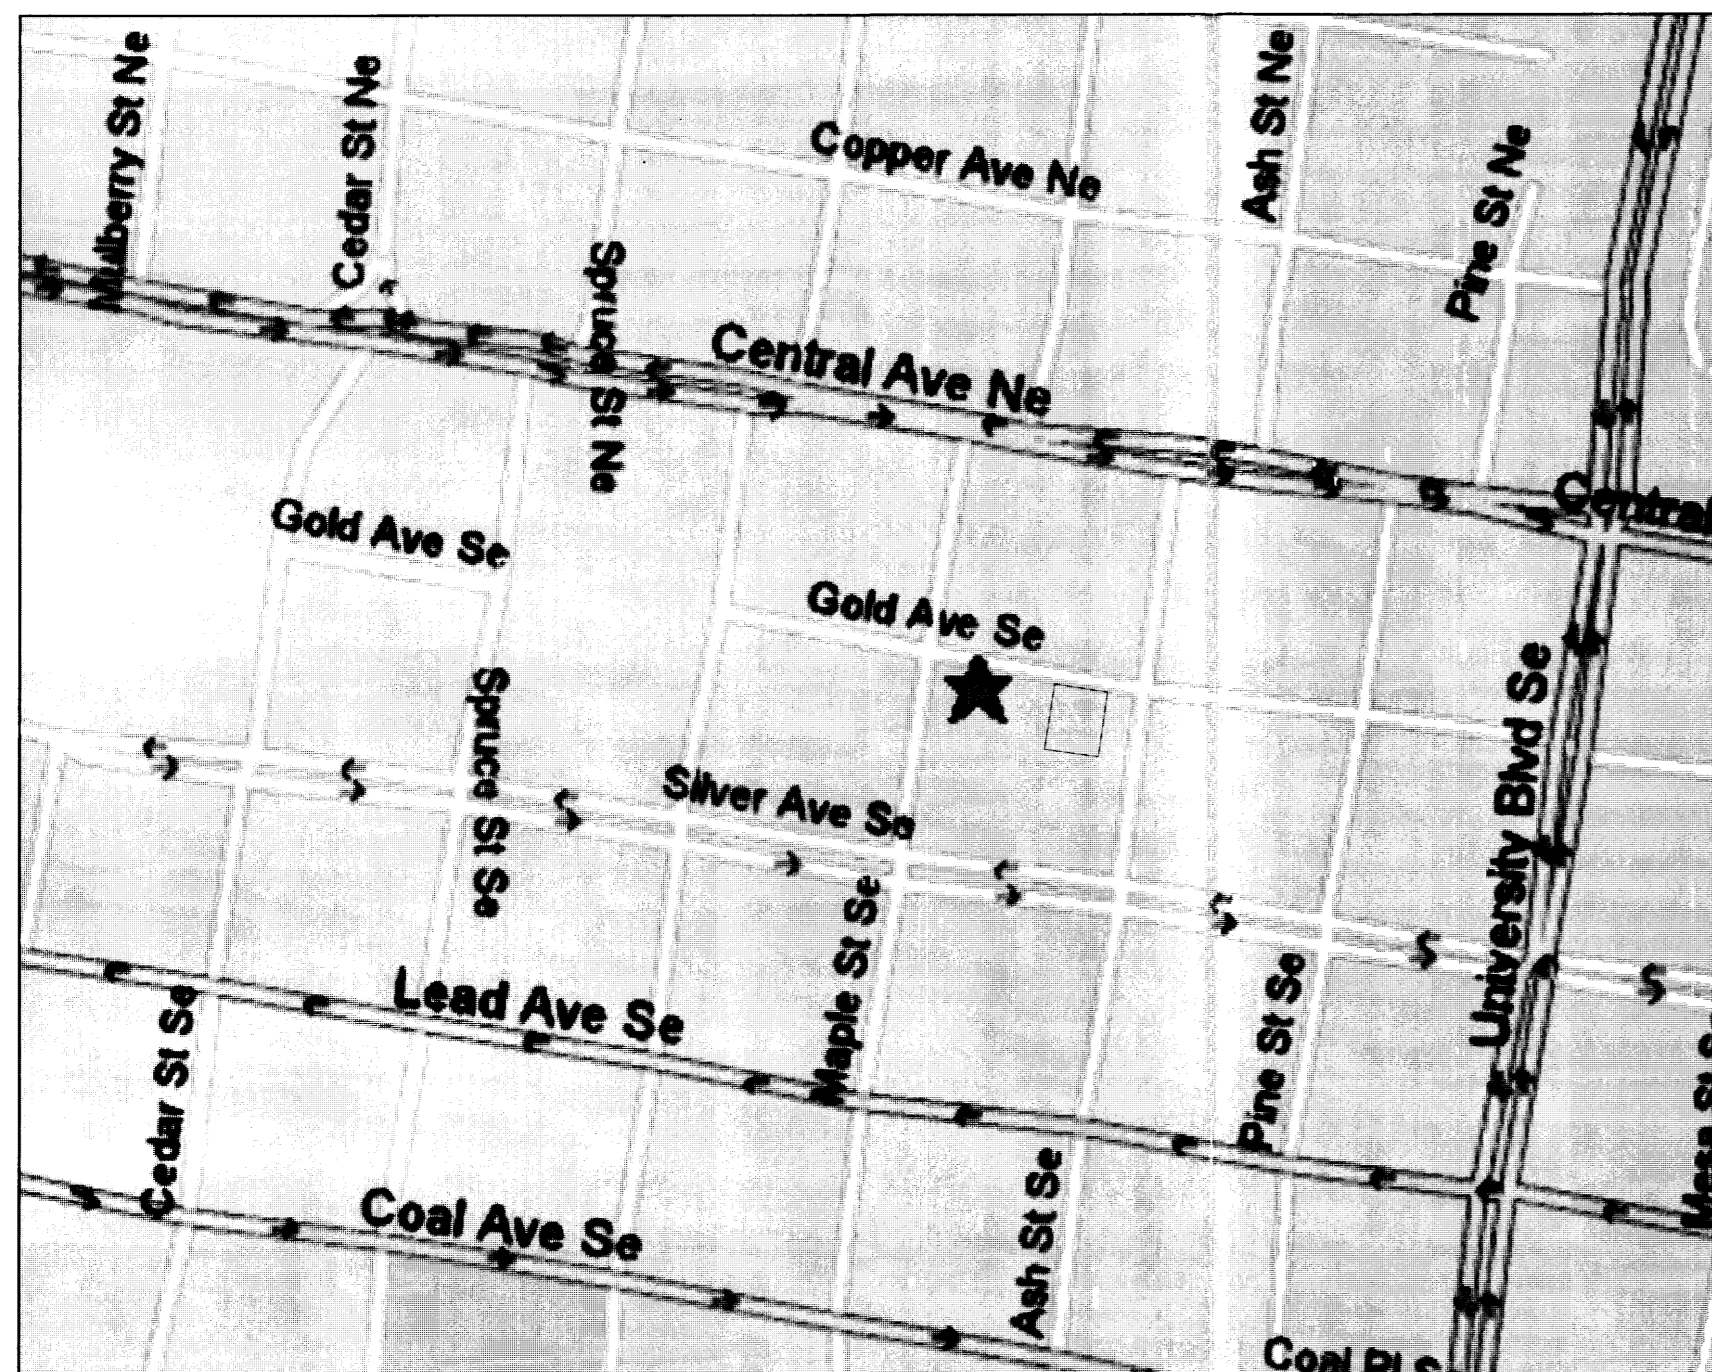

**LOCATION MAP**  
NOT TO SCALE

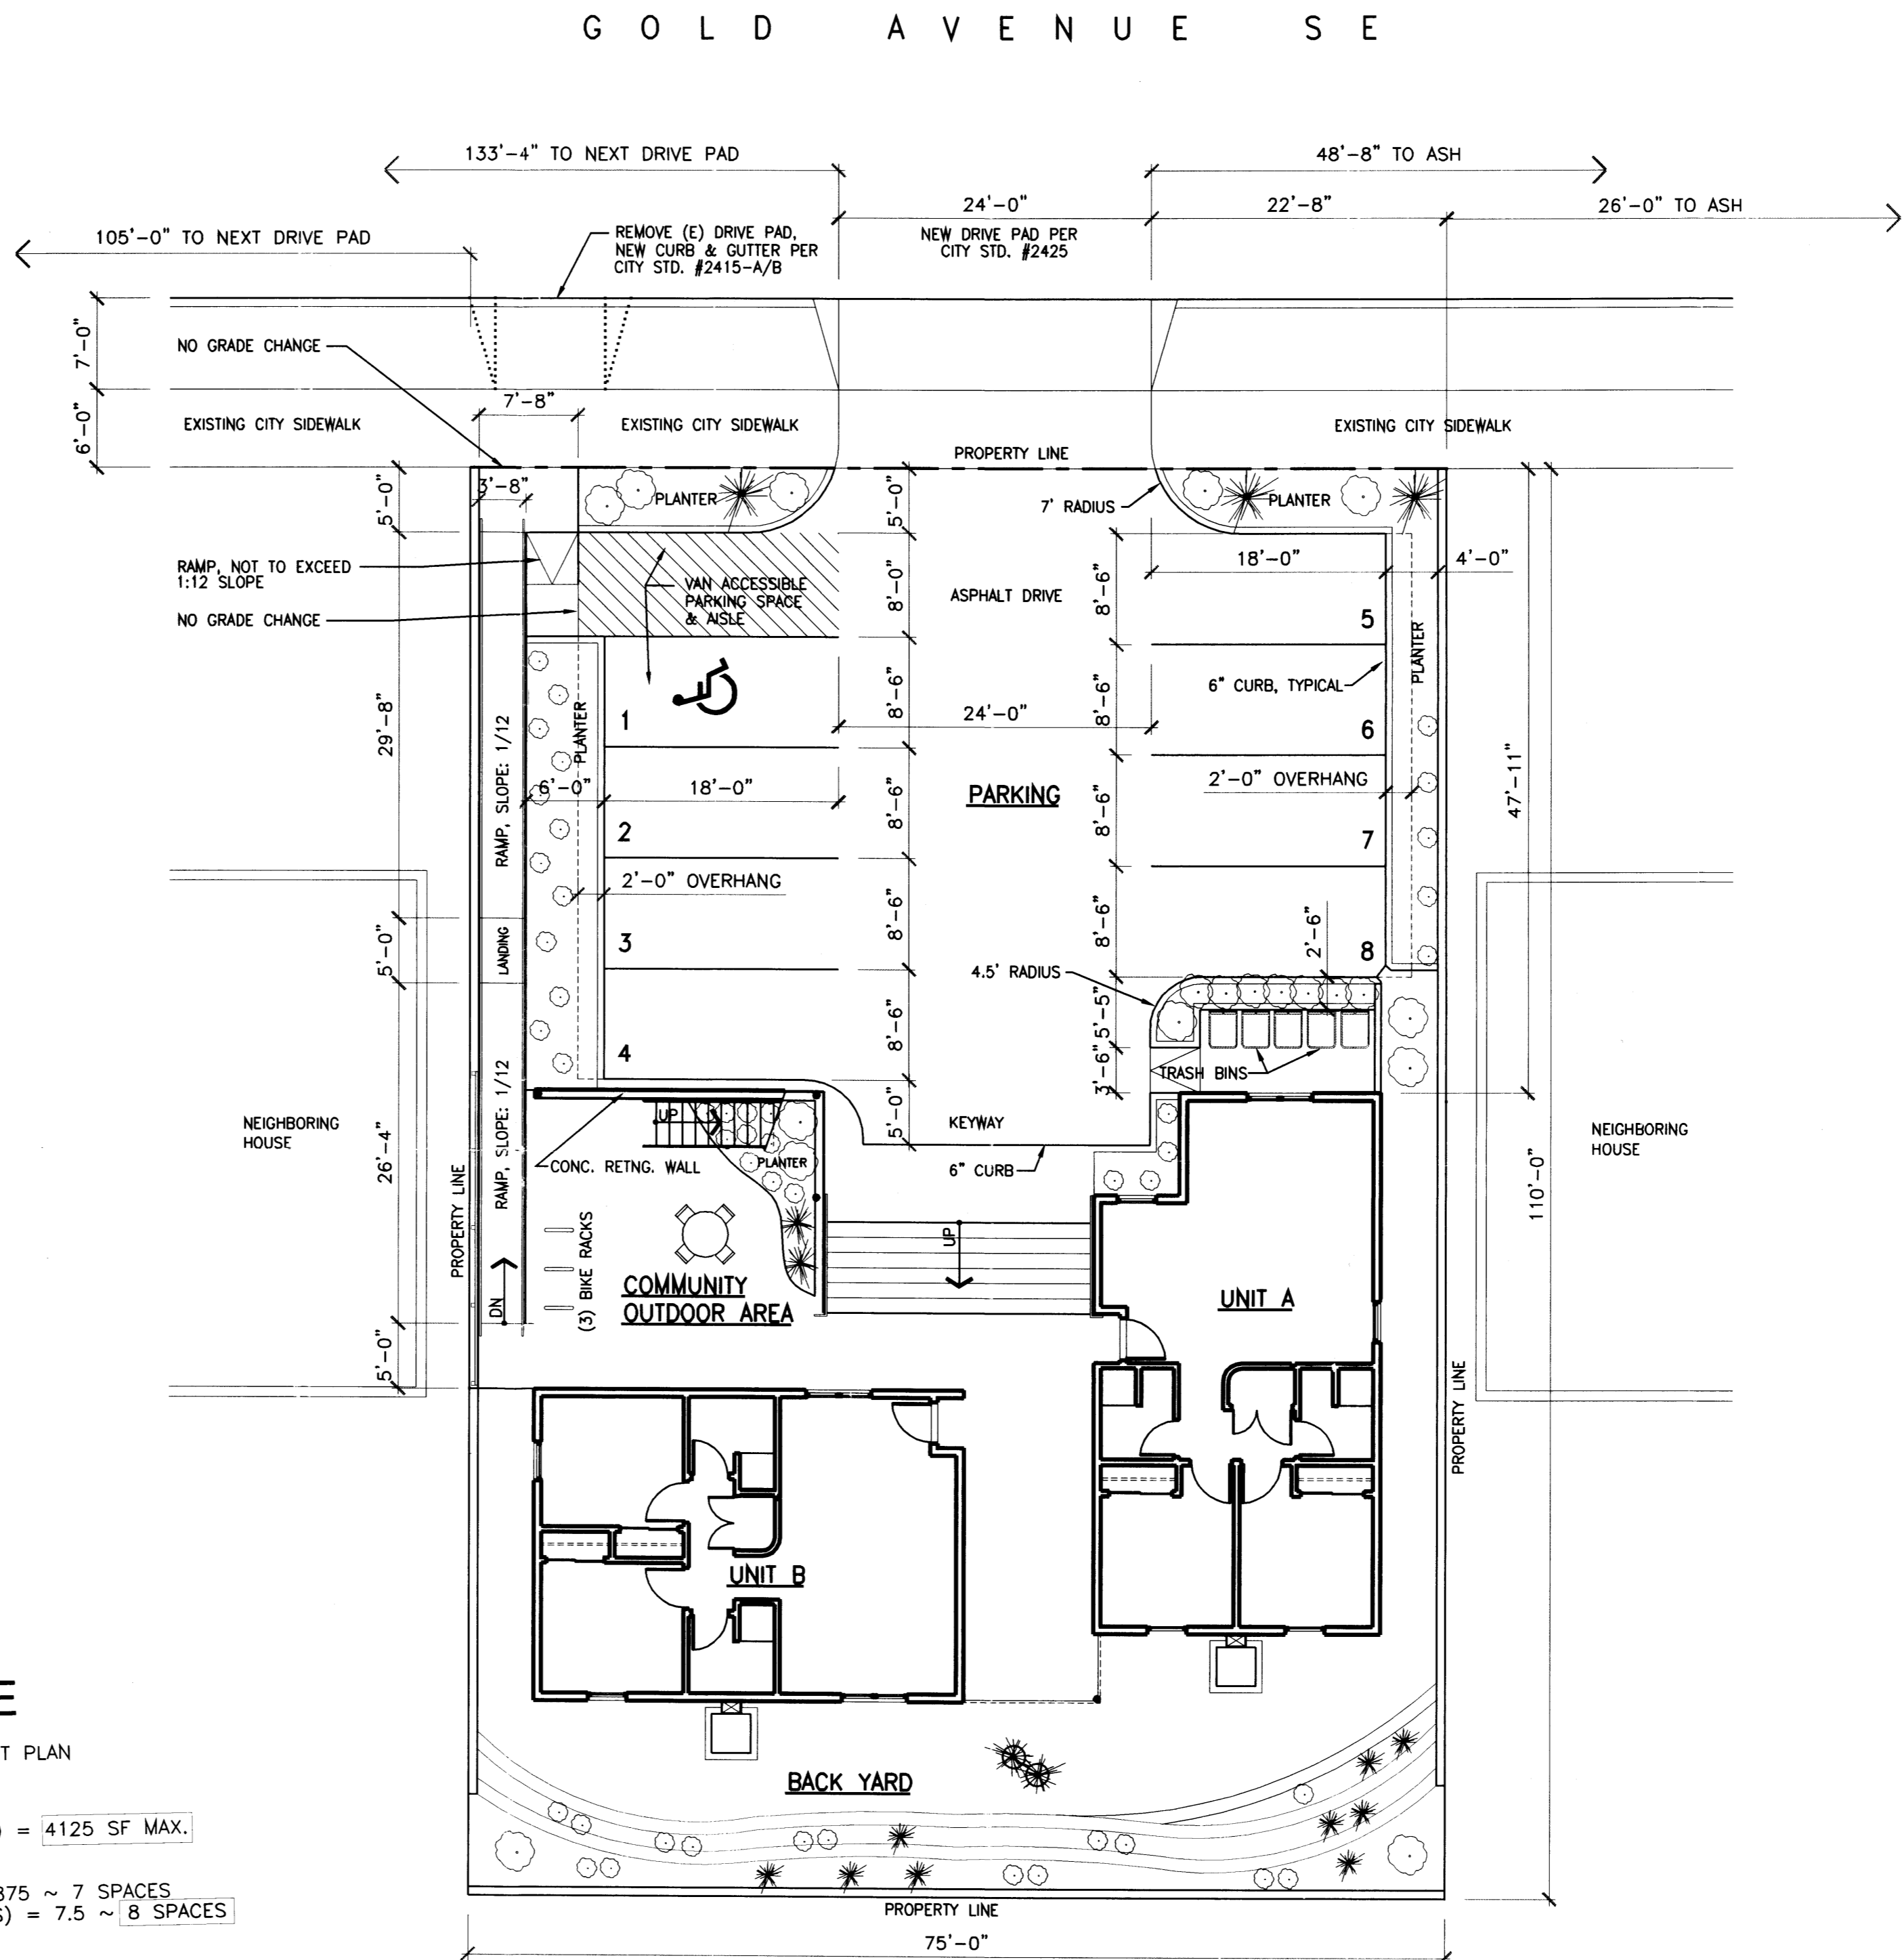

**ZONING COMPLIANCE**

UNIVERSITY NEIGHBORHOODS SECTOR DEVELOPMENT PLAN  
 ZONED DR (DIVERSE RESIDENTIAL)  
 FLOOR AREA RATIO PERMITTED: 0.5 (MAX.)  
 LOT AREA: 110' X 75' = 8250 SF (0.5) = 4125 SF MAX.  
 OFF-STREET PARKING:  
 1 SPACE FOR 600 SF: 4125/600 = 6.875 ~ 7 SPACES  
 OR 1.5 SPACES PER UNIT: 1.5 (5 UNITS) = 7.5 ~ 8 SPACES

*MKS  
6-23-05*

**TRAFFIC CIRCULATION LAYOUT**  
SCALE: 1" = 10'



**TRAFFIC CIRCULATION LAYOUT APPROVED**  
 [Signature] 6/23/05  
 Signed Date

**REGISTERED**  
 JUN 23 2005  
 HYDROLOGY SECTION

**BAKER**  
 ARCHITECTURE + DESIGN  
 3110 SILVER AVENUE SE  
 ALBUQUERQUE, NEW MEXICO 87106  
 T 505.254.4697  
 F 505.254.4697  
 www.bakerad.com

**GOLD APARTMENTS**  
**1512 & 1514 GOLD AVENUE SE**  
**ALBUQUERQUE, NEW MEXICO 87106**



PROJECT NO. : 0501  
 DATE : 22 MAR 2005  
 DRAWN BY :  
 SCALE : AS NOTED

**TCL**



**Location**  
 Lot 2-A, Block 51, Terrace Addition is located at 1512 Gold Street SE. See attached portion of Zone Atlas page number K-15 for exact location.

**Purpose**  
 The purpose of this drainage report is to present a grading and drainage solution for the proposed sites. The owners are proposing to add to the existing building and provide on-site parking. We are requesting rough grading approval as well as building permit approval.

**Existing Drainage Conditions**  
 There is an existing building on this site. The site drains from south to north to Gold Street and then west on Gold Street. Existing sites surrounding this project are developed. No offsite runoff enters this site. The site does not fall within a 100-year floodplain.

**Proposed Conditions and On-Site Drainage Management Plan**  
 This site will continue to drain to Gold Street. The proposed construction will only increase the runoff by 0.16 cfs (from 0.67 to 0.83). Therefore, there will be no impact on the street flow capacity nor the downstream storm system.

**Calculations**  
 City of Albuquerque, Development Process Manual, Section 22.2, Hydrology Section was used for runoff calculations.

**AHYMO INPUT FILE**

```

* ZONE 2
* 100-YEAR, 6-HR STORM (UNDER EXISTING CONDITIONS)
START TIME=0.0
RAINFALL TYPE=1 RAIN QUARTER=0.0 IN
RAIN ONE=2.01 IN RAIN SIX=2.35 IN
RAIN DAY=2.75 IN DT=0.03333 HR
COMPUTE NM HYD ID=1 HYD NO=101.0 AREA=0.000296 SQ MI
PER A=0.00 PER B=38.00 PER C=20.00 PER D=42.00
TP=0.1333 HR MASS RAINFALL=-1
* 10-YEAR, 6-HR STORM (UNDER EXISTING CONDITIONS)
START TIME=0.0
RAINFALL TYPE=1 RAIN QUARTER=0.0 IN
RAIN ONE=1.34 IN RAIN SIX=1.57 IN
RAIN DAY=1.83 IN DT=0.03333 HR
COMPUTE NM HYD ID=1 HYD NO=101.0 AREA=0.000296 SQ MI
PER A=0.00 PER B=38.00 PER C=20.00 PER D=42.00
TP=0.1333 HR MASS RAINFALL=-1
* 100-YEAR, 6-HR STORM (UNDER PROPOSED CONDITIONS)
START TIME=0.0
RAINFALL TYPE=1 RAIN QUARTER=0.0 IN
RAIN ONE=2.01 IN RAIN SIX=2.35 IN
RAIN DAY=2.75 IN DT=0.03333 HR
COMPUTE NM HYD ID=1 HYD NO=101.0 AREA=0.000296 SQ MI
PER A=0.00 PER B=10.00 PER C=10.00 PER D=80.00
TP=0.1333 HR MASS RAINFALL=-1
* 10-YEAR, 6-HR STORM (UNDER PROPOSED CONDITIONS)
START TIME=0.0
RAINFALL TYPE=1 RAIN QUARTER=0.0 IN
RAIN ONE=1.83 IN RAIN SIX=1.57 IN
RAIN DAY=2.75 IN DT=0.03333 HR
COMPUTE NM HYD ID=1 HYD NO=101.0 AREA=0.000296 SQ MI
PER A=0.00 PER B=10.00 PER C=10.00 PER D=80.00
TP=0.1333 HR MASS RAINFALL=-1
FINISH
  
```

**RUNOFF CALCULATION RESULTS**

BASIN	AREA (SF)	AREA (AC)	AREA (MF)
ON-SITE	8253.63	0.1895	0.000296

PROPOSED			
BASIN	Q-100	Q-10	
	CFS	CFS	
ON-SITE	0.67	0.38	

EXISTING			
BASIN	Q-100	Q-10	
	CFS	CFS	
ON-SITE	0.83	0.53	

**SUMMARY OUTPUT FILE**

VERSION: 1997.02d RUN DATE (MON/DAY/YR) = 03/28/2005  
 USER NO.: AHYMO-1-9702C0100R31-AH


COMMAND	HYDROGRAPH IDENTIFICATION	FROM ID	TO ID	AREA (SQ MI)	PEAK DISCHARGE (CFS)	RUNOFF VOLUME (AC-FT)	RUNOFF (INCHES)	TIME TO PEAK (HOURS)	CFS PER ACRE	PAGE = 1	NOTATION
START											
RAINFALL TYPE=1											TIME= .00
COMPUTE NM HYD	101.00	-	1	.00030	.67	.022	1.40161	1.500	3.557		RAIN= 2.350
START											PER IMP= 42.00
RAINFALL TYPE=1											TIME= .00
COMPUTE NM HYD	101.00	-	1	.00030	.38	.012	.76288	1.500	2.026		RAIN= 1.570
START											PER IMP= 42.00
RAINFALL TYPE=1											TIME= .00
COMPUTE NM HYD	101.00	-	1	.00030	.83	.030	1.87962	1.500	4.399		RAIN= 2.350
START											PER IMP= 80.00
RAINFALL TYPE=1											TIME= .00
COMPUTE NM HYD	101.00	-	1	.00030	.53	.018	1.14633	1.500	2.799		RAIN= 1.570
FINISH											PER IMP= 80.00

**DRAINAGE CERTIFICATION**


I, SHAHAB BIAZAR, NMPE 13479, OF THE FIRM ADVANCED ENGINEERING AND CONSULTING, LLC HEREBY CERTIFY THAT THIS PROJECT HAS BEEN GRADED AND WILL DRAIN IN SUBSTANTIAL COMPLIANCE WITH AND IN ACCORDANCE WITH THE DESIGN INTENT OF THE APPROVED PLAN DATED 03/28/05. THE RECORD INFORMATION EDITED ONTO THE ORIGINAL DESIGN DOCUMENT HAS BEEN OBTAINED BY ME OR UNDER MY DIRECT SUPERVISION AND IS TRUE AND CORRECT TO THE BEST OF MY KNOWLEDGE AND BELIEF. THIS CERTIFICATION IS SUBMITTED IN SUPPORT OF A REQUEST FOR CERTIFICATE OF OCCUPANCY, AS-BUILT INFORMATION PROVIDED BY ADVANCED ENGINEERING AND CONSULTING, LLC.

THE RECORD INFORMATION REPRESENTED HEREON IS NOT NECESSARILY COMPLETE AND INTENDED ONLY TO VERIFY SUBSTANTIAL COMPLIANCE OF THE GRADING AND DRAINAGE ASPECTS OF THIS PROJECT. THOSE RELYING ON THIS RECORD DOCUMENT ARE ADVISED TO OBTAIN INDEPENDENT VERIFICATION OF ITS ACCURACY BEFORE USING IT FOR ANY OTHER PURPOSE.


SHAHAB BIAZAR, NMPE 13479 DATE 3/30/07

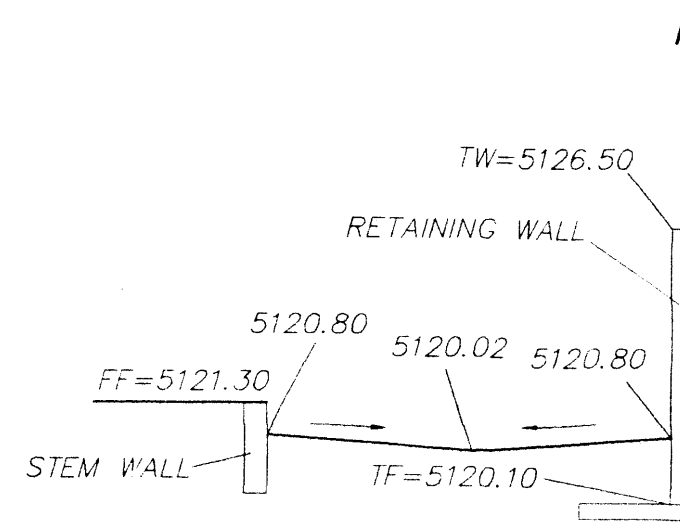

SECTION A-A NTS

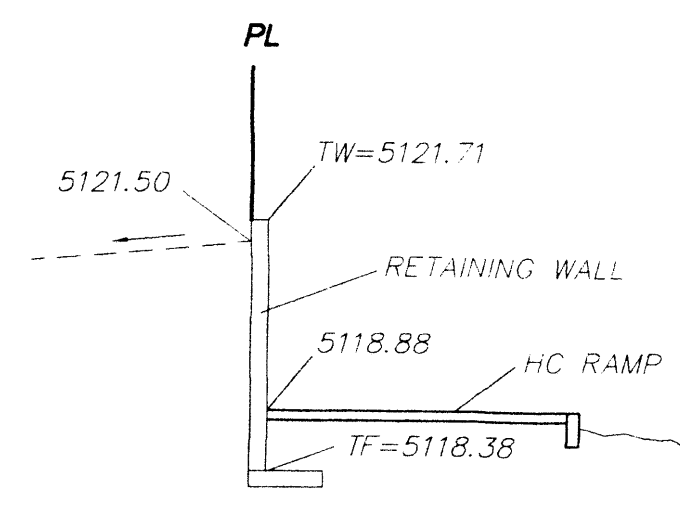


SECTION B-B NTS

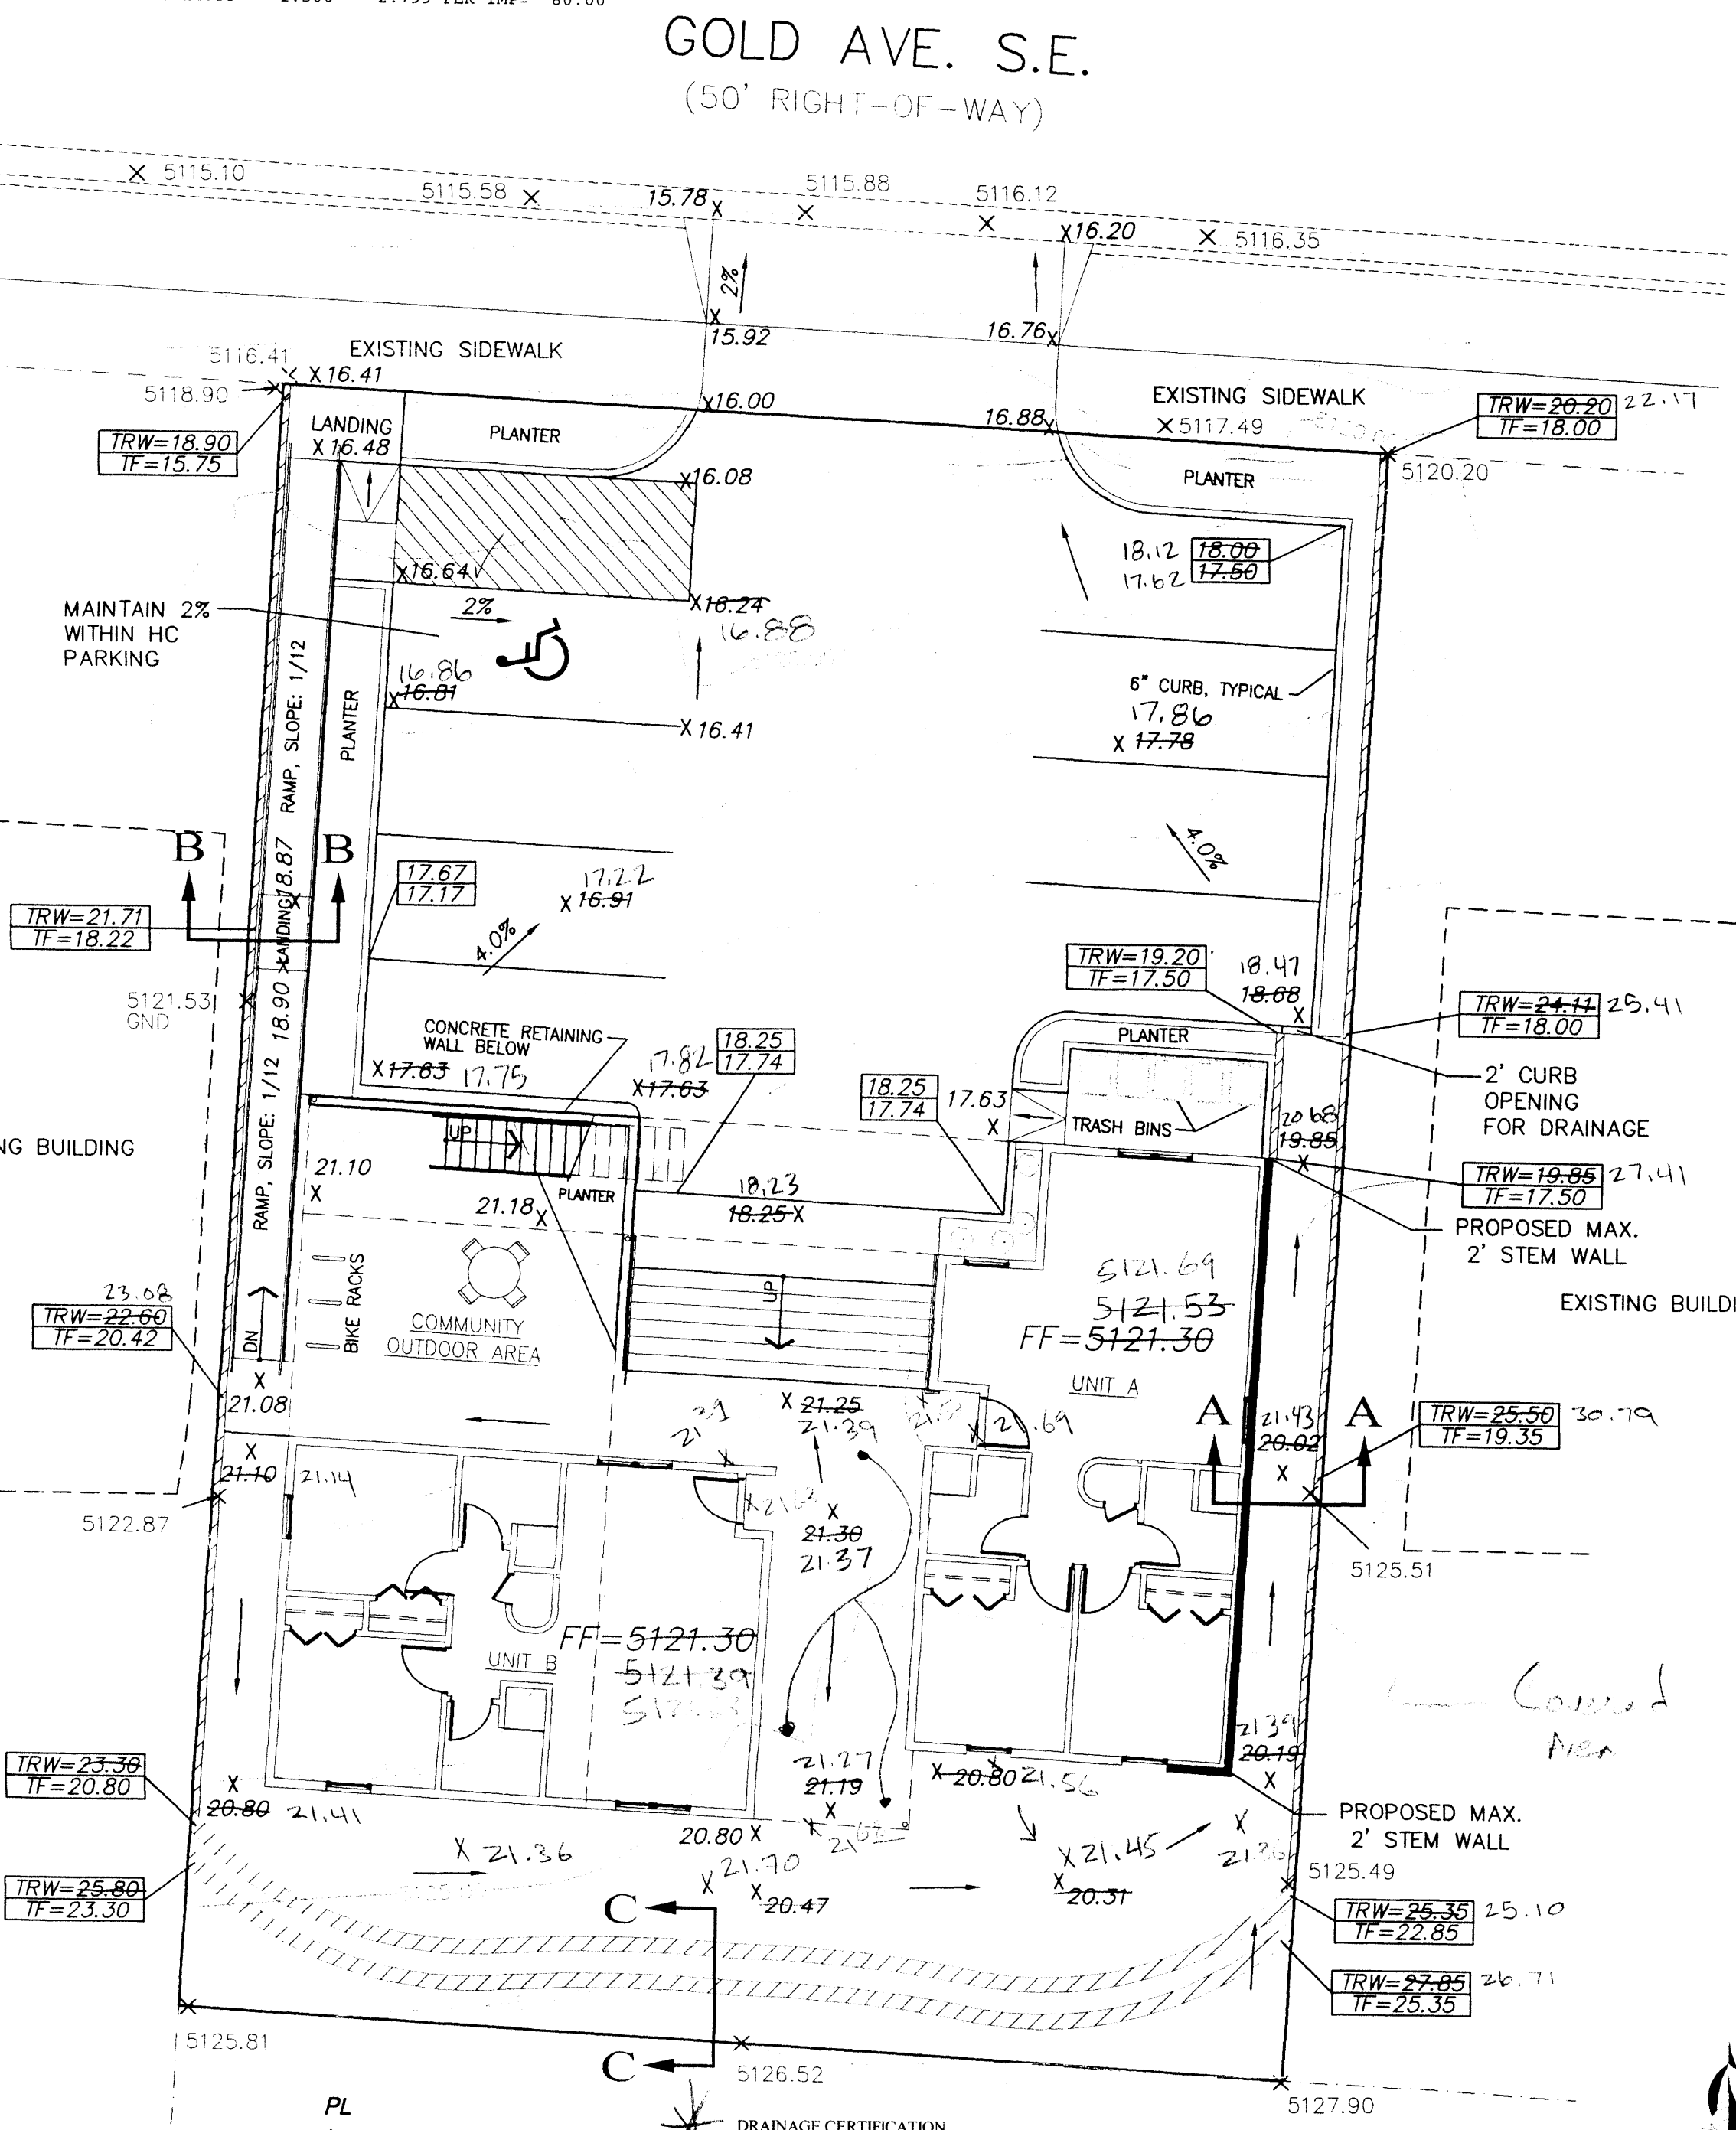


**DRAINAGE CERTIFICATION**  
 I, SHAHAB BIAZAR, NMPE 13479, OF THE FIRM ADVANCED ENGINEERING AND CONSULTING, LLC HEREBY CERTIFY THAT THIS PROJECT HAS BEEN GRADED AND WILL DRAIN IN SUBSTANTIAL COMPLIANCE WITH AND IN ACCORDANCE WITH THE DESIGN INTENT OF THE APPROVED PLAN DATED 03/28/05. THE RECORD INFORMATION EDITED ONTO THE ORIGINAL DESIGN DOCUMENT HAS BEEN OBTAINED BY ME OR UNDER MY DIRECT SUPERVISION AND IS TRUE AND CORRECT TO THE BEST OF MY KNOWLEDGE AND BELIEF. THIS CERTIFICATION IS SUBMITTED IN SUPPORT OF A REQUEST FOR CERTIFICATE OF OCCUPANCY. THE GRADES IN THE BACK WERE ERASED SO THE WATER WILL DRAIN TO THE FRONT. AS-BUILT INFORMATION PROVIDED BY ADVANCED ENGINEERING AND CONSULTING, LLC.

THE RECORD INFORMATION REPRESENTED HEREON IS NOT NECESSARILY COMPLETE AND INTENDED ONLY TO VERIFY SUBSTANTIAL COMPLIANCE OF THE GRADING AND DRAINAGE ASPECTS OF THIS PROJECT. THOSE RELYING ON THIS RECORD DOCUMENT ARE ADVISED TO OBTAIN INDEPENDENT VERIFICATION OF ITS ACCURACY BEFORE USING IT FOR ANY OTHER PURPOSE.

SHAHAB BIAZAR, NMPE 13479 DATE 3/30/07

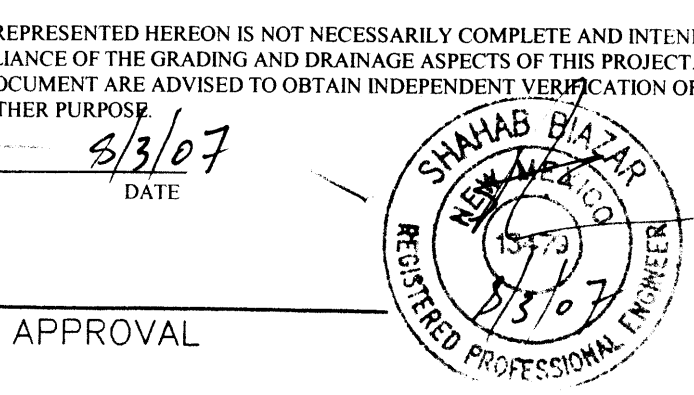


ROUGH GRADING APPROVAL

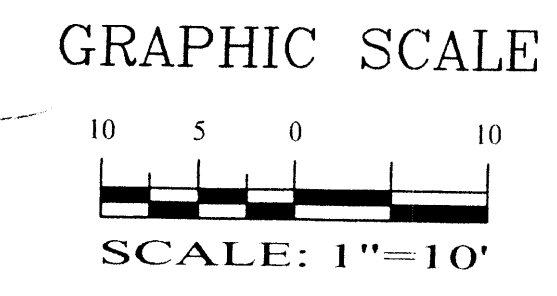

**LEGEND**

- EXISTING CURB & GUTTER
- PROPOSED CURB & GUTTER
- EXISTING CONTOUR (MAJOR)
- EXISTING CONTOUR (MINOR)
- BOUNDARY LINE
- PROPOSED GRADE
- PROPOSED SPOT ELEVATION
- EXISTING GRADE
- PROPOSED RETAINING WALL
- PROPOSED EXTENDED STEM WALL
- TOP OF RETAINING WALL
- TOP OF FOOTING

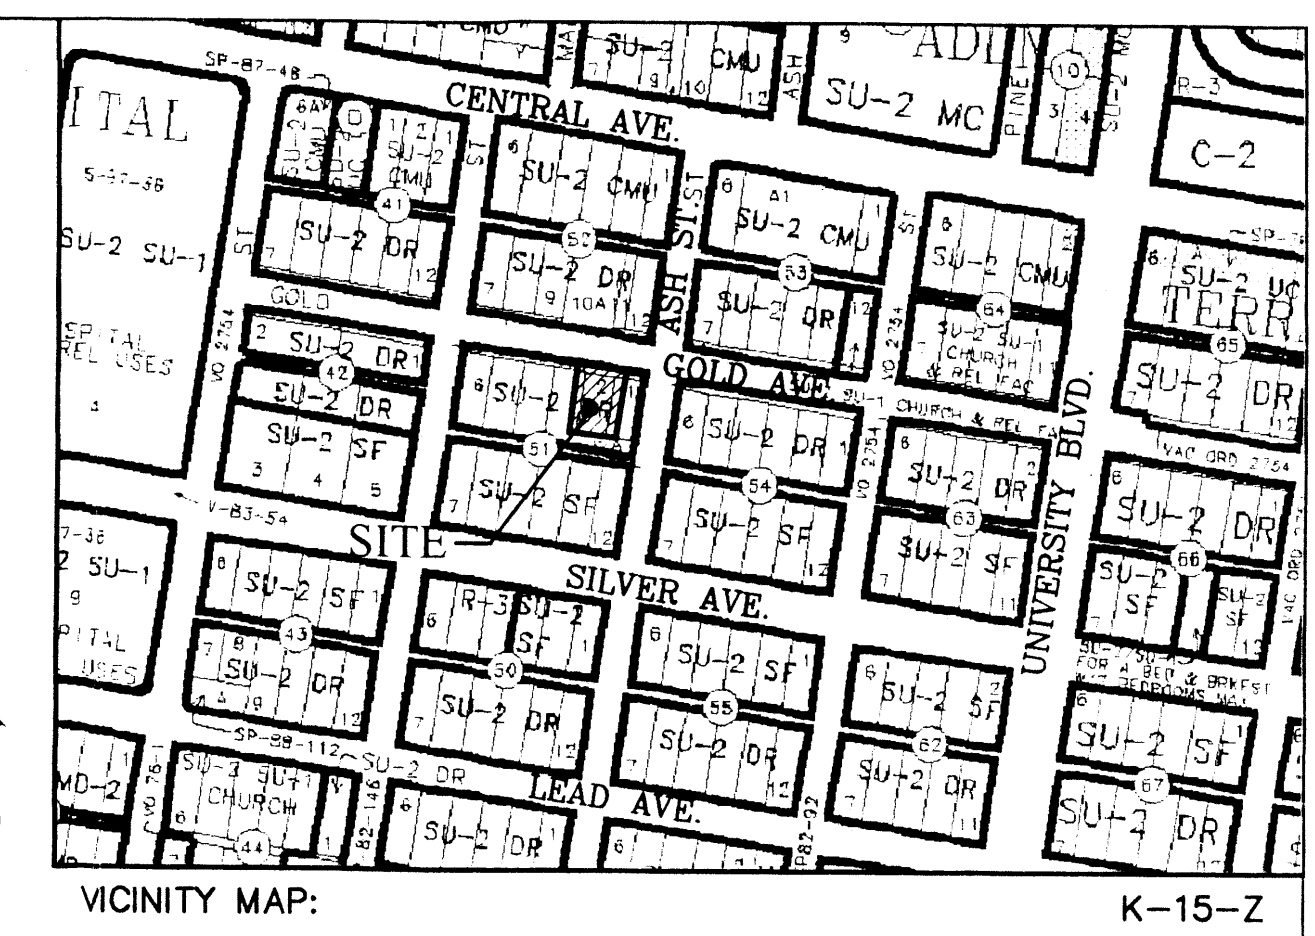


**LEGAL DESCRIPTION:**  
 LOT 2-A, BLOCK 51, TERRACE ADDITION  
 CONTAINING 8,253.63 SQUARE FEET (0.1895 ACRES)  
 MORE OR LESS.

- NOTICE TO CONTRACTORS**
1. AN EXCAVATION/CONSTRUCTION PERMIT WILL BE REQUIRED BEFORE BEGINNING ANY WORK WITHIN CITY RIGHT-OF-WAY.
  2. ALL WORK DETAILED ON THESE PLANS TO BE PERFORMED, EXCEPT AS OTHERWISE STATED OR PROVIDED HEREON, SHALL BE CONSTRUCTED IN ACCORDANCE WITH CITY OF ALBUQUERQUE INTERIM STANDARD SPECIFICATIONS FOR PUBLIC WORKS CONSTRUCTION, 1985.
  3. TWO WORKING DAYS PRIOR TO ANY EXCAVATION, CONTRACTOR MUST CONTACT LINE LOCATING SERVICE, 765-1234, FOR LOCATION OF EXISTING UTILITIES.
  4. PRIOR TO CONSTRUCTION, THE CONTRACTOR SHALL EXCAVATE AND VERIFY THE HORIZONTAL AND VERTICAL LOCATIONS OF ALL CONSTRUCTIONS. SHOULD A CONFLICT EXIST, THE CONTRACTOR SHALL NOTIFY THE ENGINEER SO THAT THE CONFLICT CAN BE RESOLVED WITH A MINIMUM AMOUNT OF DELAY.
  5. BACKFILL COMPACTION SHALL BE ACCORDING TO TRAFFIC/STREET USE.
  6. MAINTENANCE OF THESE FACILITIES SHALL BE THE RESPONSIBILITY OF THE OWNER OF THE PROPERTY SERVED.
  7. WORK ON ARTERIAL STREETS SHALL BE PERFORMED ON A 24-HOUR BASIS.

- EROSION CONTROL PLAN AND POLLUTION PREVENTION NOTES**
1. CONTRACTOR IS RESPONSIBLE FOR OBTAINING A TOPSOIL DISTURBANCE PERMIT PRIOR TO BEGINNING WORK.
  2. CONTRACTOR IS RESPONSIBLE FOR CLEANING ALL SEDIMENT OUT OF EXISTING RIGHT-OF-WAY.
  3. CONTRACTOR IS RESPONSIBLE FOR MAINTAINING ALL STORM RUNOFF ON SITE.
  4. REPAIR OF DAMAGED FACILITIES AND CLEAN-UP OF SEDIMENT ACCUMULATION ON ADJACENT PROPERTIES AND IN PUBLIC FACILITIES IS THE RESPONSIBILITY OF THE CONTRACTOR.
  5. ALL EXPOSED EARTH SURFACES MUST BE PROTECTED FROM WIND AND WATER EROSION PRIOR TO FINAL ACCEPTANCE OF ANY PROJECT.
  6. ALL THE DISTURBED AREAS MUST BE REVEGETATED.

- GENERAL NOTES:**
1. ADD ±200 TO SPOT ELEVATIONS TO SHOW TRUE ELEVATION.
  2. CONTOUR INTERVAL IS ONE (1) FOOT.
  3. ELEVATIONS ARE BASED ON CITY OF ALBUQUERQUE CONTROL STATION MON 2-K15 HAVING AN ELEVATION OF 5136.65 (NAVD88) FEET ABOVE SEA LEVEL.
  4. UTILITIES SHOWN HEREON ARE IN THEIR APPROXIMATE LOCATION BASED ONLY ON ABOVE GROUND EVIDENCE FOUND IN THE FIELD AND AS-BUILT INFORMATION PROVIDED BY THE CLIENT. UTILITIES SHOWN HEREON, WHETHER INDICATED AS ABANDONED OR NOT, SHALL BE VERIFIED BY OTHERS FOR EXACT LOCATION AND/OR DEPTH PRIOR TO EXCAVATION OR DESIGN CONSIDERATIONS.
  5. THIS IS NOT A BOUNDARY SURVEY, BEARINGS ARE ASSUMED, DISTANCES AND FOUND PROPERTY CORNERS ARE FOR INFORMATIONAL PURPOSES ONLY.
  6. SLOPES ARE AT 3:1 MAXIMUM.

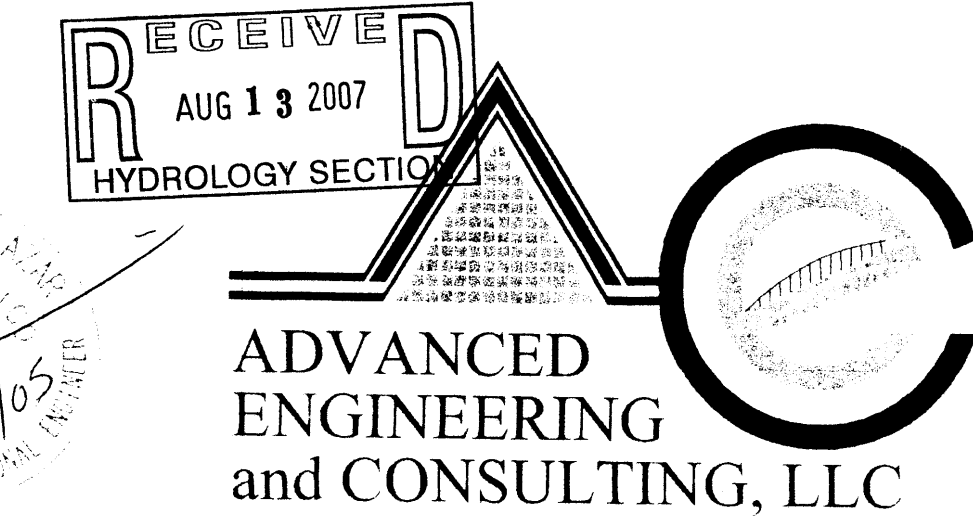

SHAHAB BIAZAR P.E. #13479 4416 ANAHEIM AVE., NE ALBUQUERQUE, NEW MEXICO 87113 (505)899-5570

**LOT 2-A, BLOCK 51, TERRACE ADDITION GRADING AND DRAINAGE PLAN**

DRAWING: 200507-GR.DWG	DRAWN BY: SHH	DATE: 03-08-2005	SHEET # 1 OF 1
------------------------	---------------	------------------	----------------

