DRAINAGE INFORMATION SHEET

PROJECT TITLE: Four-1 : Apartment Bldg. Zo	ONE ATLAS/DR FILE #: K-16 /D35
LEGAL DESCRIPTION: Lot 21, Block 18, Univ	versity Heights Addition
CITY ADDRESS: 207 Princeton Drive, S.E.	
ENGINEERING FIRM: Lovelady & Associat	es CONTACT: Frank Lovelady
ADDRESS: 7408 Morrow Ave. NE 8711	0 PHONE: 883-7973
OWNER: Don Keith & Associates	CONTACT: Don Keith
ADDRESS 7116 Edwina Ct. NE	PHONE: 884-4070
ARCHITECT:	CONTACT:
ADDRESS:	PHONE:
SURVEYOR: Lovelady & Associates	CONTACT: Frank Lovelady
ADDRESS: 7408 Morrow Ave. N.E. 87110	PHONE: 883-7973
CONTRACTOR: Don Keith & Associates	CONTACT: Don Keith
ADDRESS: 7116 Edwina Ct. NE	PHONE: 884-4070
PRE-DESIGN MEETING:	
X YES	DRB NO
MAY 1 6 1989	EPC NO
X COPY OF CONFERENCE RESERVION	PROJECT NO
SHEET PROVIDED	
TYPE OF SUBMITTAL:	CHECK TYPE OF APPROVAL SOUGHT:
DRAINAGE REPORT	SKETCH PLAT APPROVAL
X DRAINAGE PLAN	PRELIMINARY PLAT APPROVAL
CONCEPTUAL GRADING & DRAIN. PLAN	SITE DEVELOPMENT PLAN APPROVAL
GRADING PLAN	PINAL PLAT APPROVAL
BROSION CONTROL PLAN	X BUILDING PERMIT APPROVAL
ENGINEER'S CERTIFICATION	POUNDATION PERMIT APPROVAL
v Revised Plan - lowered	CERTIFICATE OF OCCUPANCY APPROVAL
Fin Flr. 6"	ROUGH GRADING PERMIT APPROVAL
DATE SUBMITTED: April 21, 1989	GRADING/PAVING PERMIT APPROVAL
BY:	OTHER (SPECIFY)
Frank D. Lovelady, P.E. Rev. 11/84 10	
de la compresenció de la compres	ningstroperson out out the property of the second

MEMORANDUM:

May 24, 1989



ENGINEERING GROUP

TO:

MC AN

Jacob Baca, Transportation System Division

FROM:

Fred J. Aguirre, Hydrologist; Engineering Group/PWD

SUBJECT:

PRIVATE DRAINAGE FACILITIES WITHIN PUBLIC RIGHTS-OF-WAY/EASEMENT

4-PLEX 207 PRINCETON DRIVE, SE (K-16/D35)

Transmitted herewith, is a copy of the approved drainage plan for the referenced project incorporating the S.O. #19 design.

In accordance with the new process, this plan is being submitted to you for permitting and inspection. Please provide this section with a signed-off copy per the signature block upon construction and acceptance by your office.

As you are aware, the signed-off S.O. #19 is required by this office for Certificate of Occupancy release; hence your expeditious processing of this plan would be greatly appreciated and would avoid any unnecessary delay in the release of the Certificate of Occupancy.

Thank you for your cooperation, and if you should have any questions and/or comments regarding the process, please feel free to call me at 768-2650.

FJA/bsj

Attachment



City of Albuquerque

P.O. BOX 1293 ALBUQUERQUE, NEW MEXICO 87103

CLARENCE V. LITHGOW CHIEF

CHIEF DEPUTY CAO
ADMINISTRATIVE OFFICER PUBLIC SERVICE

DAN WEAKS

FRED E. MONDRAGON

DEPUTY CAO
PUBLIC SERVICES DEVELOPMENT & ENTERPRISE SERVICES

May 24, 1989

Frank Lovelady, P.E. Lovelady & Associates 7408 Morrow, NE Albuquerque, New Mexico 87110

RE: REVISED DRAINAGE PLAN FOR FOUR PLEX APARTMENT BUILDING

207 PRINCETON AVENUE, SE (K-16/D35)

REVISION DATED MAY 12, 1989

Dear Mr. Lovelady:

Based on the information provided on your resubmittal of May 16, 1989, the revisions as indicated are acceptable for Building Permit.

Please attach a copy of this plan to the construction sets prior to sign-off by Hydrology.

Also, please be advised that a separate permit is required for construction within City right of way. A copy of this approval letter must be on hand when applying for the excavation permit.

If I can be of further assistance, please feel free to call me at 768-2650.

Cordially,

Bernie J. Montoya, C.E. Engineering Assistant

: Becky Sandoval

BJM/bsj (WP+1084)

CITY OF ALBUQUERQUE

DRAINAGE FACILITIES WITHIN CITY RIGHT-OF-WAY

NOTICE TO CONTRACTOR

- 1. AN EXCAVATION/CONSTRUCTION PERMIT WILL BE REQUIRED PEFORE BEGINNING ANY WORK WITHIN CITY RIGHT-OF-WAY. AN APPROVED COPY OF THESE PLANS MUST BE SUBMITTED AT THE TIME OF APPLICATION FOR THIS PERMIT.
- 2. ALL WORK DETAILED ON THESE PLANS TO BE PERFORMED, EXCEPT AS OTHERWISE STATED OR PROVIDED HEREON, SHALL BE CONSTRUCTED IN ACCORDANCE WITH STANDARD SPECIFICATIONS FOR PUBLIC WORKS CONSTRUCTION, 1986.
- 3. TWO (2) WORKING DAYS PRIOR TO ANY EXCAVATION, CONTRACTOR MUST CONTACT LINE LOCATING SERVICE, 765-1234, FOR LOCATION OF EXISTING UTILITIES.
- 4. PRIOR TO CONSTRUCTION, THE CONTRACTOR SHALL EXCAVATE AND VERIFY THE HORIZONTAL AND VERTICAL LOCATIONS OF ALL OBSTRUCTIONS. SHOULD A CONFLICT EXIST, THE CONTRACTOR SHALL NOTIFY THE ENGINEER SO THAT THE CONFLICT CAN BE RESOLVED WITH A MINIMUM AMOUNT OF DELAY.
- 5. BACKFILL COMPACTION SHALL BE ACCORDING TO RESIDENTIAL STREET USE.
- 6. MAINTENANCE OF THESE FACILITIES SHALL BE THE RESPONSIBILITY OF THE OWNER OF SAID PROPERTY SERVED.
- 7. THE ADDRESS OF THE PROPERTY SERVED IS 207 PRINCETON DR. S.E.

LOT 3

LOT 4

Contractors and Contractors and Contractors

LOT 5

-08 FOR

LEGEND:

APPROVALS: HYDROLOGY Desnie & Montyo	5/2489
INSPECTOR (NAME)	(DATE)
(NAME)	(DATE)

PRE-DESIGN CONFERENCE RECAP:

- 1. DRAINAGE PLAN PER D.P.M. GUIDELINES REQUIRED PRIOR TO BUILDING PERMIT RE-
- 2. FREE DISCHARGE TO PRINCETON IS ACCEPTABLE.
- 3. FREE DISCHARGE TO ALLEY IS ACCEPTABLE IF ALLEY IS PAVED AND HAS CAPACITY ALL THE WAY TO MAIN STREETS. PROVIDE VERIFICATION WITH DRAINAGE SUBMIT-
- 4. APPROVED ALLEY GRADES ARE REQUIRED TO COMPARE WITH SITE GRADES.
- 5. ALLEY FLOWS ARE FROM SOUTH TO NORTH.
- 6. IDENTIFY ANY OFF-SITE FLOWS ENTERING THE SITE.

RESPONSE TO PRE-DESIGN CONFERENCE FINDINGS:

EXISTING

FOUR-PLEX APARTMENT BUILDING

FIN.FLR. = 5178.50

LANDSCAPING

FIN. FLR. = 5179.25

FF= 79.07

UNIT 2

COVERED PORCH

78.40 1 NV 77.94 78.40

RESIDENCE

2.5

LOT

UNIT 3

COVERED PORCH

78.08 INV.

EXISTING

RIDGE

OVERFLOW 78.27 78.27 SIDEWALK

LOT

UNIT 4

COVERED PORCH/

DESCRIPTION

SPOT ELEVATION

PROPERTY LINE

SHEET FLOW

ROOF DRAINAGE

TC TOP CURB

FL FLOWLINE

EDGE NEW ASPHALT

TA TOP ASPHALT

CONTOUR-

- 1. THE D.P.M. GUIDELINES WERE USED IN PREPARATION OF THIS GRADING AND DRAIN-
- 2. THE SITE HAS BEEN GRADED TO DRAIN MOSTLY TO PRINCETON DRIVE TO MINIMIZE
- 3. THE AMOUNT OF FLOW DISCHARGING TO THE ALLEY WILL BE REDUCED AFTER DEVEL-OPMENT. THE ALLEY IS PRESENTLY PAVED.
- 4. APPROVED ALLEY GRADES ARE PER CITY PROJECT P-124-78. ONLY CENTERLINE GRADES ARE SHOWN ON THE PLAN AND PROFILE AND THERE IS NO TYPICAL SECTION.
- 5. FIELD ELEVATIONS CONFIRM THAT ALLEY FLOWS ARE FROM SOUTH TO NORTH.
- 6. THERE ARE NO OFF-SITE FLOWS ENTERING THE SITE. ALL LOTS DRAIN EITHER TO PRINCETON OR THE THE ALLEY. THERE IS NO SIGNIFICANT CROSS-LOT-LINE

RESIDENCE

UNIT

78.40 78.40 PVC 77.79 INV-

OVERFLOW 78.27

COVERED PORCH

77.87 INV.


2.5

SECTION A-A - SWALE DETAIL

1/2" = 1' - 0"

2 % 78.27 O.F. TC 78.33

FIN. FLR. = 5179.02

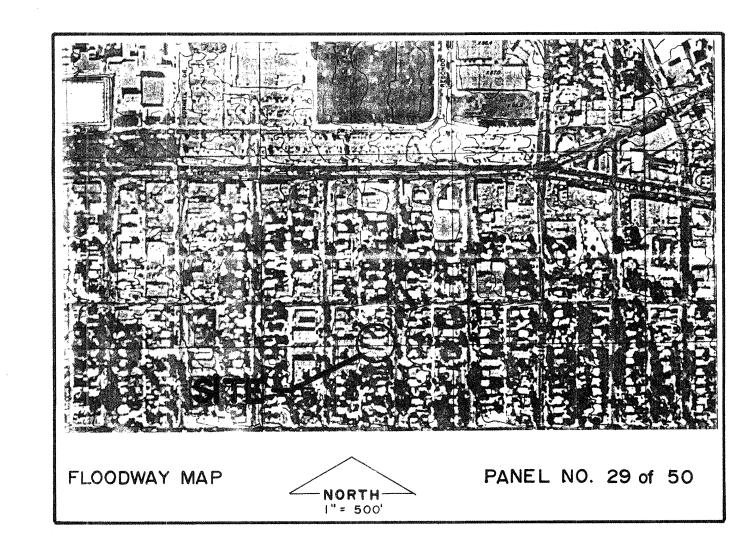


LEGAL DESCRIPTION:

LOT NUMBER 21 IN BLOCK NUMBER 18, UNIVERSITY HEIGHTS ADDITION.


ACS STATION \13-K16 LOCATED AT THE INTERSECTION OF LEAD AVE. AND GIRARD BLVD. THE STATION IS A 31 ALUMINUM TABLET SET IN A DRILL HOLE FLUSH WITH THE TOP OF CURB. STATION IS STAMPED "ACS, 13-K16, 1984". ELEVATION IS 5187.389 FEET.

TEMPORARY BENCH MARK (TBM):

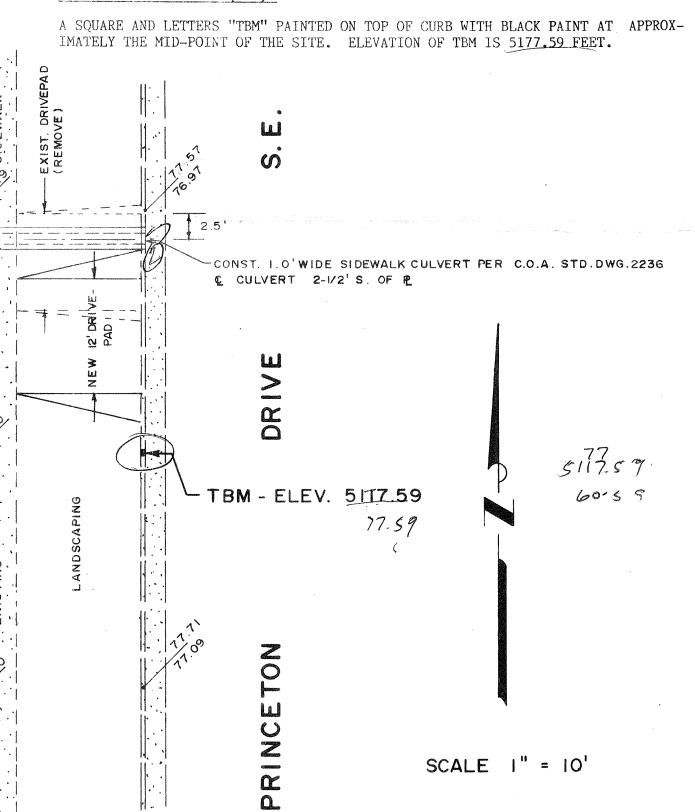

EROSION CONTROL PLAN:

DURING CONSTRUCTION OF THE BUILDING, ALL RUNOFF FROM THE SITE SHALL BE CON-TAINED BY THE USE OF A POND, BERM, OR OTHER SUITABLE CONTAINMENT FROM WHICH SEDIMENT-FREE WATER SHALL BE RELEASED AT A CONTROLLED RATE. ALL SEDIMENT SHALL BE SETTLED OR FILTERED OUT BEFORE RELEASING THE WATER TO THE PUBLIC RIGHT-OF-WAY.

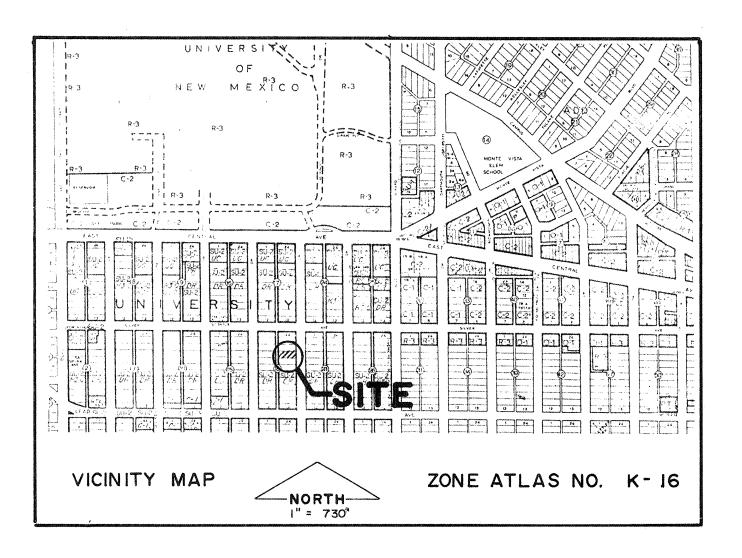

DRAINAGE CALCULATIONS

SOIL INFORMATION: (REFER TO SCS SOIL SURVEY OF BERNALILLO COUNTY.) SOIL IS WeB, WINK-EMBUDO COMPLEX, HYDROLOGIC SOIL GROUP "B".

RAINFALL, 100-YEAR, 6-HOUR: (REFER TO D.P.M., PLATE 22.2 D-1) $R_6 = 2.25$ INCHES.

TIME OF CONCENTRATION: (REFER TO D.P.M. SECTION 22.2, PAGE 3)

TEN (10) MINUTES, MINIMUM TIME OF CONCENTRATION. RAINFALL INTENSITY: (REFER TO PLATE 22.2 D-2)

 $I = R_6 \times 6.84 \times Tc^{-0.51} = 2.25 \times 6.84 \times (10)^{-0.51} = 4.76 \text{ INCHES PER HOUR.}$

CURVE NUMBERS: (REFER TO D.P.M. PLATE 22.2 C-2)

	CN	EXISTING AREA	NEW AR
EXISTING PERVIOUS	70	***	***
BUILDINGS AND PAVEMENT	98	9000	6185
LANDSCAPING	61	*****	365
UNPAVED GRAVEL	85	****	550
UNPAVED DIRT	82	7100	-
TOTAL AREAS		7100 SF = 0.163 AC	7100

WIEGHTED CURVE NUMBER (CN_U):

EXISTING $CN_U = 82$ DEVELOPED $CN_U = 95$

DIRECT RUNOFF: (REFER TO D.P.M. PLATE 22.2 C-4)

EXISTING $Q_D = 0.85$ DEVELOPED $Q_D = 1.75$

RUNOFF COEFFICIENTS: (REFER TO "NOTICE OF EMERGENCY RULE",

0.40 UNDEVELOPED 0.25 365 LAWNS AND LANDSCAPING 0.90 3325 ROOFS 0.95 2860 STREETS, DRIVES, WALKS

7100 TOTAL AREAS WEIGHTED "C" FACTORS: EXISTING "C" = 0.40 DEVELOPED "C" = 0.85

EXISTING CONDITIONS:

RUNOFF BY RATIONAL EQUATION, Q = CIA Q = 0.40 X 4.76 X 0.163 = 0.31 CFS

VOLUME BY SCS METHOD, $V = A(Q_D/12)$, WHERE A = AREA IN SQUARE FEET. V = 7100 (0.85/12) = 503 CF

DEVELOPED CONDITIONS:


 $Q = 0.85 \times 4.76 \times 0.163 = 0.66 \text{ CFS}$ V = 7100 (1.75/12) = 1035 CF

DRAINAGE TO ALLEY:


UNDEVELOPED - THE WESTERLY 75% OF THE SITE DRAINS TO THE ALLEY. $0.75 \times 0.31 = 0.23 \text{ CFS}$

DEVELOPED - THE WESTERLY 32' OF THE SITE WILL DRAIN TO THE ALLEY.

Q = 0.95 X 4.76 (1600/43560) = 0.17 CFS. THEREFORE, THE AMOUNT OF RUNOFF DISCHARGING TO THE ALLEY WILL BE REDUCED BY DEVELOPMENT.

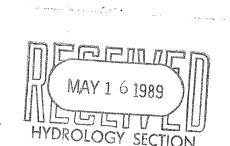

REVISED MAY 12, 1989

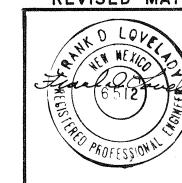

APRIL 21, 1989

GRADING AND DRAINAGE PLAN FOUR - PLEX APARTMENT BUILDING 207 PRINCETON DRIVE, S.E.

ALBUQUERQUE, NEW MEXICO