

## GRADING & DRAINAGE PLAN


THE MULTI-FAMILY/TOWNHOME PROJECT IS LOCATED IN THE UNIVERSITY HEIGHTS OF ALBUQUERQUE APPROXIMATELY 2.5 MILES EAST OF THE DOWNTOWN CORE OF ALBUQUERQUE, NM. THE GRADING & DRAINAGE SCHEME HEREON IS IN COMPLIANCE WITH THE BERN-ALILLO COUNTY FLOOD HAZARD ORDINANCE, NO.88-46, AND THE CITY STORM DRAINAGE ORDINANCE. THE PLAN IS REQUIRED IN ORDER TO FACILITATE THE OWNER'S REQUEST FOR BUILDING PERMIT. THE PLAN SHOWS:

- 1. EXISTING CONTOURS, AND SPOT ELEVATIONS AND EXISTING DRAINAGE PATTERNS AND EXISTING IMPROVEMENTS: INCLUDING EXISTING FLATWORK
- 2. PROPOSED IMPROVEMENTS: 2800 SF BUILDING STRUCTURE. NEW CONCRETE DRIVEPADS AND OUTDOOR PATIO AREAS, NEW GRADE ELEVATIONS, WALLS, FLATWORK AND LANDSCAPING.
- 3. CONTINUITY BETWEEN EXISTING AND PROPOSED ELEVATIONS 4. QUANTIFICATION AND ACCEPTANCE OF UPSTREAM OFF-SITE FLOWS WHICH CONTRIBUTE TO THE DEVELOPED FLOWS GEN-ERATED BY THE IMPROVEMENTS.

THE PURPOSE OF THE PLAN IS TO ESTABLISH CRITERIA FOR CON-TROLLING STORM RUNOFF AND EROSION, AND ESSENTIALLY ALLOWING HISTORIC FLOWS TO CONTINUE TO DRAIN THROUGH THE PROPERTY. PRESENTLY, THE SITE IS BOUNDED ON THE NORTH BY RESIDENTIAL USE TO THE EAST BY COMMERCIAL PUBLIC ALLEY. COAL AVENUE & VASSAR DRIVE ON THE SOUTH AND WEST ARE PAVED WITH CURB, GUTTER AND SIDEWALK, AND MAINTAINED BY THE CITY OF ALBUQUERQUE. THE SITE CURRENTLY DRAINS AT 1% FROM EAST TO WEST.

HISTORICAL SITE RUNOFF OUTFALL LOCATIONS WILL REMAIN UNCHANGED. SINCE BOTH STREETS ARE IMPROVED ONLY MINIMAL GRADING (DRIVEPAD RECONSTR~N) IS PROPOSED WITHIN THE CITY R.O.W. FREE DISCHARGE OF DEVELOPED FLOW IS ACCEPTABLE SINCE THE TOTAL INCREASE OF DEVELOPED FLOW IS MINIMAL, AND CAPACITY EXISTS DOWNSTREAM.

THE SITE IS NOT IMPACTED ADVERSELY BY ANY OFF-SITE DRAINAGE FLOWS.

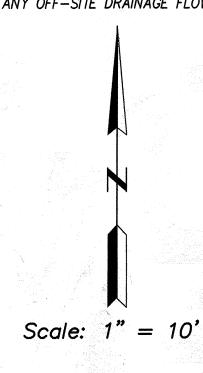

NOTICE TO CONTRACTORS

1. AN EXCAMATION/CONSTRUCTION PERMIT WILL BE REQUIRED BEFORE BEGINNING MITHIN CITY RIGHT-OF-WAY. 2. ALL WORK DETAILED ON THESE PLANS TO BE PERFORMED, EXCEPT AS OTHERWISE STATED OR PROVIDED HEREON, SHALL BE CONSTRUCTED IN ACCORDANCE WITH THE CITY OF ALBUQUERQUE ST'D. SPECIFICATIONS FOR PUBLIC WORKS CONSTRUCTION, 7TH EDITION, AND AMEN THE #1 TWO WORKING DAYS PRIOR TO ANY EXPANSION, CONTRACTOR MUST CONTACT.

HALL BE ACCORDING TO TRAFFIC/STREET USE.

OF THE PROPERTY BEING SERVED.

7. WORK ON APPERIAL STREETS SHALL BE PERFORMED ON A 24-HR. BASIS.

KEC=5184.69 TIC=5184139 FL=5183.69 🛪 LOT 11, BLOCK 27 UNIVERSITY HEIGHTS T#4 R/B W/CAP PS 11463 Built 5' P.C.C. SOWK. 5-Locations N.side BUILT BLK 6'-0" TALL KALL IRON GATE W/ CHAINLINK FENCE FENÇES ₩/CAP PS 11463 > ELECTRIC SLOPE  $O \perp$ **LOT 12** 0.1630 Ac. VACANT LAND 4-CAR FIN. FLR. ELEV. 5186.0 86 45 FIN. FLR. ELEV. COVERED PARKING-5185.08 D TOWNHOME XG=5184.84 STRUCTURE Ģ=5186.20 FIN. FLR. ELEV. WATER METER ROOF SLOPE 1832 5'-8" TALL STUCCO'D Depressed L.S. DI=5183.23 1 J.CMU TURNID? EXIST. DROP W/CAP PS 11463
TURN BOTT.

CMU BLK. TYP. INV. 85.3 RMP=5183.34 NEW PCC SDWK.-EXIST. WC NEW PCC SDWK.(5") RAMP (By COA) EXIST. CONCRETE WALK Depressed -7 ± (5.5 ) DC=518 .70 DRIVE CUT Gravel5184.13 L. S. CLOSE EXIST. DRIVE BUILT BY (By COA) Built NEW CURB LINE, Face STORM SEVER MANHOLE **∑**MH=5183.10 NEW C/G & SDWK PER C.I.P. INLET (ADJ. d) COA DWG 2415A, 2430 WER MANHOLE EXIST. ST'D CURB/GUTTER AVENUE

ONE-WAY EASTBOUND, 3- LANES)

# CALCULATIONS

### DESIGN CRITERIA

HYDROLOGIC METHODS PER SECTION 22.2, HYDROLOGY OF THE DEVELOPMENT PROCESS MANUAL (DPM) REVISED JANUARY 1993 FOR CITY OF ALBUQUERQUE ADOPTED BY THE COUNTY OF BERNALILLO DISCHARGE RATE: Q=QPEAK x AREA.."Peak Discharge Rates For Small Watersheds" VOLUMETRIC DISCHARGE: VOLUME = EWeighted x AREA

P100 = 2.35 Inches, Zone 2 Time of Concentration, TC = 10 Minutes DESIGN STORM: 100-YEAR/6-HOUR, 10-YEAR/6-HOUR [ ] = 10 YEAR VALUES

### EXISTING CONDITIONS

TOTAL AREA = 0.16 ACRES, WHERE EXCESS PRECIP. 'W' =1.13 In. [0.52] PEAK DISCHARGE, Q100 = 0.50 CFS [0.27], WHERE UNIT PEAK DISCHARGE 'W' = 3.1CFS/AC. [1.7] THEREFORE: VOLUME 100 = 656 CF [302]

### DEVELOPED CONDITIONS

DETERMINE LAND TREATMENTS, PEAK DISCHARGE AND VOLUMETRIC DISCHARGE FOR STUDY AREA

RECOMMEND: ROUTE DEVELOPED RUNOFF THROUGH SOFT LANDSCAPING

	AREA LAND TREATM'T	Q Peak	E
UNDEVELOPED	Ac. A	1.56[0.38]	0.53[0.13]
LANDSCAPING	0.03 Ac.(16%) B	2.28[0.95]	0.78[0.28]
GRAVEL & COMPACTED SOIL	0.02 Ac.(15%) C	<i>3.14[1.71]</i>	1.1 <i>3[</i> 0.52]
ROOF - PAVEMENT	<u>0.11 Ac.(69%)</u> D	4.70[3.14]	2.12[1.34]
	0.16 Ac.		

THEREFORE: E<sub>Weighted</sub> = 1.76 In.[1.06] & Q100 = 0.65 CFSQ10 = 0.41 CFS

**VOLUME 100 = 1022 CF VOLUME 10 = 616 CF** 

DETERMINED.

I, Philip W.Clark, NMPE 1856 THE FIRM Clark Consulting Engineereby CERTIFY THAT THIS PROJECT HAS BEEN GRADED AND WILL DRAIN IN SUBSTANTIAL COMPLIANCE

BY ME OR UNDER MY DIRECT SUPERVISION [+AS SUPPLEMENTAL DATA TO THE ORIGINAL TOPOGRAPHIC SURVEY PREPARED BY // / S SUPPLEMENTAL DATA TO THE ORIGINAL TOPOGRAPHIC SURVEY PREPARED BY // / S SUPPLEMENTAL DATA TO THE ORIGINAL TOPOGRAPHIC SURVEY PREPARED BY // / S SUPPLEMENTAL DATA TO THE ORIGINAL TOPOGRAPHIC SURVEY PREPARED BY // / S SUPPLEMENTAL DATA TO THE ORIGINAL TOPOGRAPHIC SURVEY PREPARED BY // / S SUPPLEMENTAL DATA TO THE ORIGINAL TOPOGRAPHIC SURVEY PREPARED BY // S SUPPLEMENTAL DATA TO THE ORIGINAL DESIGN DOCUMENT THIS DEEN OBTAIN BY ME OR UNDER THE ORIGINAL DESIGN DOCUMENT THIS DEEN OBTAIN BY ME OR UNDER THE ORIGINAL DESIGN DOCUMENT THIS DEEN OBTAIN BY ME OR UNDER THE ORIGINAL TOPOGRAPHIC SURVEY PREPARED BY // S SUPPLEMENTAL DATA TO THE ORIGINAL TOPOGRAPHIC SURVEY PREPARED BY // S SUPPLEMENTAL DATA TO THE ORIGINAL TOPOGRAPHIC SURVEY PREPARED BY // S SUPPLEMENTAL DATA TO THE ORIGINAL TOPOGRAPHIC SURVEY PREPARED BY // S SUPPLEMENTAL DATA TO THE ORIGINAL TOPOGRAPHIC SURVEY PREPARED BY // S SUPPLEMENTAL DATA TO THE ORIGINAL TOPOGRAPHIC SURVEY PREPARED BY // S SUPPLEMENTAL DATA TO THE ORIGINAL TOPOGRAPHIC SURVEY PREPARED BY // S SUPPLEMENTAL DATA TO THE ORIGINAL TOPOGRAPHIC SURVEY PREPARED BY // S SUPPLEMENTAL DATA TO THE ORIGINAL TOPOGRAPHIC SURVEY PREPARED BY // S SUPPLEMENTAL DATA TO THE ORIGINAL TOPOGRAPHIC SURVEY PREPARED BY // S SUPPLEMENTAL DATA TO THE ORIGINAL TOPOGRAPHIC SURVEY PREPARED BY // S SUPPLEMENTAL DATA TO THE ORIGINAL TOPOGRAPHIC SURVEY PREPARED BY // S SUPPLEMENTAL DATA TO THE ORIGINAL TOPOGRAPHIC SURVEY PREPARED BY // S SUPPLEMENTAL DATA TO THE ORIGINAL TOPOGRAPHIC SURVEY PREPARED BY // S SUPPLEMENTAL DATA TO THE ORIGINAL TOPOGRAPHIC SURVEY PREPARED BY // S SUPPLEMENTAL TOPOGRAPHIC SURVEY PREPARED BY //

Permanent C.O.

WITH AND IN ACCORDANCE WITH THE DESIGN INTENT OF THE APPROVED PLAN DATED 5/13/10 THE RECORD INFORMATION EDITED ONTO THE ORIGINAL DESIGN DOCUMENT HAS BEEN OBTAINED

(DESCRIBE ANY EXCEPTIONS) Per S. B./C.C. mtg. - SDWK. culvert Deleted, increase Routing thru L.S. (2) LOCATIONS. (DESCRIBE ANY DEFICIENCIES)

THE RECORD INFORMATION PRESENTED HEREON IS NOT NECESSARILY COMPLETE AND INTENDED ONLY TO VERIFY SUBSTANTIAL COMPLIANCE OF THE GRADING AND DRAINAGE ASPECTS OF THIS

PROJECT. THOSE RELYING ON THIS RECORD DOCUMENT ARE ADVISED TO OBTAIN INDEPENDENT

, PHILIP W. CLARK, A PROFESSIONAL ENGINEER LICENSED IN ACCORDANCE WITH THE LAWS OF THE STATE OF NEW MEXICO, DO HEREBY CERTIFY THAT I HAVE VISITED THE SITE SHOWN HEREON, AND THAT THE CONTOURS SHOWN REPRESENT THE EXISTING GROUND CONDITIONS, AND DO FURTHER CERTIFY THAT NO EARTHWORK OF ANY KIND, NOR ANY DISTURBANCE OF THE EXISTING GROUND HAS OCCURRED ON THIS SITE SINCE THE CONTOURS WERE

VICINITY MAP

### NOTES

1. ALL WORK WITHIN THE RIGHT-OF-WAY SHALL BE CONSTRUCTED IN ACCORDANCE WITH THE CITY OF ALBUQUERQUE STANDARD SPECS. FOR PUBLIC WORKS CONSTRUCTION, 7TH EDITION W/ UPDATES.

2. AN EXCAVATION/CONSTRUCTION PERMIT IS REQUIRED BEFORE BEGINNING ANY WORK WITHIN CITY R.O.W. AN APPROVED COPY OF THIS PLAN MUST BE SUBMITTED AT THE TIME OF APPLICATION.

3. ALL WORK ON THIS PROJECT SHALL BE PERFORMED IN ACCORDANCE WITH APPLICABLE FEDERAL, STATE AND LOCAL LAWS, RULES, AND REGULATIONS CONCERNING CONSTRUCTION SAFETY AND HEALTH.

4. ALL LANDSCAPING AREA SHALL BE SOFT-LINED WITH NATIVE VEGETATION AND/OR GRAVEL. ASPHALT PARKING AREA SHALL DRAIN DIRECTLY TO NEW CURB CUT OR SDWK CULVERT

5. CONTRACTOR SHALL ENSURE THAT NO SITE SOILS/SEDIMENT OR SILT ENTER THE RIGHT-OF-WAYS DURING CONSTRUCTION.

6. REVEGETATE ALL AREAS DISTURBED DUE TO CONSTRUCTION PER CITY OF ALBUQ. SPEC. 1011, NATIVE SEED MIX.

7. MAXIMUM SITE GRADING WITHOUT EROSION PROTECTION: 3 HORIZONTAL TO 1 VERTICAL, 3:1. ALL DIMENSIONS TO FACE OF CURB, UNLESS NOTED OTHERWISE.

### LEGEND EXIST. SPOT ELEVATION AS-BUILT EXIST. CONTOUR NEW SPOT ELEVATION **4** 24.0 NEW CONTOUR NEW SWALE DRAINAGE DIRECTION, EXISTING NEW CONCRETE CURB (0.5' HEIGHT) NEW P.C.C., CONCRETE TOP OF CURB, EXISTING FLOWLINE

PROJECT DATA

### LEGAL DESCRIPTION

WATER BLOCK

LOT 12, BLOCK 27, UNIVERSITY HEIGHTS ALBUQUERQUE, BERNALILLO COUNTY, NEW MEXICO

### PROJECT BENCHMARK

EXISTING POWER POLE

FACE OF CURB/FACE OF CURB

TOP OF REBAR/CAP AT THE PROJECT SOUTHEAST CORNER MSL ELEVATION = 5186.05, AS TIED FROM COA 3-1/4" DIAMETER ALUM DISK SET IN TOP OF CURB, 20\_L16, MSL, NAVD 88, 5210.84, LOCATED 114' SOUTH OF THE INTERSECTION OF GIRARD AND BURTON AVENUE, SE.

### TOPOGRAPHIC DESIGN SURVEY

PROVIDED BY HARRIS SURVEYING, INC. UNDER THE DIRECTION OF TON'Y HARRIS, N.M.P.S. 11463, DATED APRIL 2010.

		A CONTRACTOR OF THE PARTY OF TH			Land and Carrier		
	<u>}_                                    </u>	lark	Consu	ılting	Engine	eers	
			19 Ryan ood, New	Road Mexico			
Tele: (505)	281-2444	4	and the second	~	Fax:	(505) 2	81-244
DATE	REVISI	ON	LOT 12, BL ALBUQUERQ	K. 27, UI UF. BERN	NIVERSITY I ALILLO COUI	HEIGHTS NTY. NE	W MEXI
3.26.14	As. B	st.	324 VAS				
3·26·14		Olive			TOWNHO	MEC	
		:	Grac	lina S	R Drain	מחפר	ı
			Grad			lagu	
				Pla	an		
DESIGNED B	Y: PWC	DRAWN	BY: CCE	JOB #: AL	BERT_THs	1 0	E 1
CHECKED BY	· PWC	DATE: 5	/4/10	FILE #:	G/D	1 0	r I