

# CITY OF ALBUQUERQUE

Planning Department  
Alan Varela, Director



Mayor Timothy M. Keller

January 9, 2023

Shawn Biazar  
SBS Construction and Engineering, LLC  
10209 Snowflake Ct. NW  
Albuquerque, NM 87114

**RE: 112 Princeton Dr. SE**  
**Permanent C.O. - Accepted**  
**Engineer's Certification Date: 12/21/22**  
**Engineer's Stamp Date: 02/02/22**  
**Hydrology File: K16D094**

Dear Mr. Biazar:

PO Box 1293  
Albuquerque  
NM 87103  
www.cabq.gov

Based on the Certification received 12/29/2022 and site visit on 01/06/2023, this letter serves as a "green tag" from Hydrology Section for a Permanent Certificate of Occupancy to be issued by the Building and Safety Division.

If you have any questions, please contact me at 924-3995 or [rbrissette@cabq.gov](mailto:rbrissette@cabq.gov).

Sincerely,

Renée C. Brissette, P.E. CFM  
Senior Engineer, Hydrology  
Planning Department



# City of Albuquerque

Planning Department  
Development & Building Services Division

## DRAINAGE AND TRANSPORTATION INFORMATION SHEET (REV 6/2018)

**Project Title:** 112 PRINCETON DR. SE GRADING PLAN Building Permit #: \_\_\_\_\_ Hydrology File #: K16D094  
DRB#: \_\_\_\_\_ EPC#: \_\_\_\_\_ Work Order#: \_\_\_\_\_  
Legal Description: LOT 6, BLOCK 24, UNIVERSITY HEIGHTS ADDITION  
City Address: 112 PRINCETON DR. SE

**Applicant:** SBS CONSTRUCTION AND ENGINEERING, LLC Contact: SHAWN BIAZAR  
Address: 7632 WILLIAM MOYERS AVE., NE, ALBUQUERQUE, NM 87122  
Phone#: (505) 804-5013 Fax#: (505) 897-4996 E-mail: AECLLC@AOL.COM

**Other Contact:** \_\_\_\_\_ Contact: \_\_\_\_\_  
Address: \_\_\_\_\_  
Phone#: \_\_\_\_\_ Fax#: \_\_\_\_\_ E-mail: \_\_\_\_\_

**TYPE OF DEVELOPMENT:** \_\_\_\_\_ PLAT (# of lots) \_\_\_\_\_ RESIDENCE \_\_\_\_\_ DRB SITE  ADMIN SITE

IS THIS A RESUBMITTAL? \_\_\_\_\_ Yes  No

**DEPARTMENT** \_\_\_\_\_ TRANSPORTATION  HYDROLOGY/DRAINAGE

Check all that Apply:

**TYPE OF SUBMITTAL:**

- ENGINEER/ARCHITECT CERTIFICATION
- PAD CERTIFICATION
- CONCEPTUAL G & D PLAN
- GRADING PLAN
- DRAINAGE REPORT
- DRAINAGE MASTER PLAN
- FLOODPLAIN DEVELOPMENT PERMIT APPLIC
- ELEVATION CERTIFICATE
- CLOMR/LOMR
- TRAFFIC CIRCULATION LAYOUT (TCL)
- TRAFFIC IMPACT STUDY (TIS)
- STREET LIGHT LAYOUT
- OTHER (SPECIFY) \_\_\_\_\_
- PRE-DESIGN MEETING?

**TYPE OF APPROVAL/ACCEPTANCE SOUGHT:**

- BUILDING PERMIT APPROVAL
- CERTIFICATE OF OCCUPANCY
- PRELIMINARY PLAT APPROVAL
- SITE PLAN FOR SUB'D APPROVAL
- SITE PLAN FOR BLDG. PERMIT APPROVAL
- FINAL PLAT APPROVAL
- SIA/ RELEASE OF FINANCIAL GUARANTEE
- FOUNDATION PERMIT APPROVAL
- GRADING PERMIT APPROVAL
- SO-19 APPROVAL
- PAVING PERMIT APPROVAL
- GRADING/ PAD CERTIFICATION
- WORK ORDER APPROVAL
- CLOMR/LOMR
- FLOODPLAIN DEVELOPMENT PERMIT
- OTHER (SPECIFY) \_\_\_\_\_

DATE SUBMITTED: 12-26-2022 By: SHAWN BIAZAR

COA STAFF: \_\_\_\_\_

ELECTRONIC SUBMITTAL RECEIVED: \_\_\_\_\_

FEE PAID: \_\_\_\_\_

**Location**

Lot 6, Block 24, University Heights Addition is located at 112 Princeton SE Albuquerque NM 87106. See attached portion of Vicinity Map K-16-Z for exact location.

**Purpose**

The purpose of this drainage report is to present a grading and drainage solution for the proposed buildings.

**Existing Drainage Conditions**

This lot is very flat and drains from north to south. No offsite runoff enters this site.

**Proposed Conditions and On-Site Drainage Management Plan**

The drainage patterns will remain the same. The additional runoff volume generated by this project garage will be retained on site. The total volume requirement under proposed conditions is 909.43 cf based on the 100-yr/10-day volume. Retention volume provided is 1007.67 cf. First Volume requirement is (0.42/12\*3,585.50) 125.49 cf

**VOLUME CALCULATIONS FOR 10 DAY STORM**

BASIN	AREA (SF)	AREA (AC)	AREA (MI <sup>2</sup> )
ON-SITE	7,171.00	0.16462	0.000257

$$E = \frac{EA(AA) + EB(AB) + EC(AC) + ED(AD)}{AA + AB + AC + AD}$$

$$V-360 = E(AA + AB + AC + AD)$$

EA = 0.62  
EB = 0.80  
EC = 1.03  
ED = 2.33

P-60 = 1.78  
P-360 = 2.29  
P-1440 = 2.59  
P-10 Day = 3.62

**EXISTING CONDITIONS      PROPOSED CONDITIONS**

AA = 0.00%      AA = 0.00%  
AB = 100.00%    AB = 10.00%  
AC = 0.00%      AC = 40.00%  
AD = 0.00%      AD = 50.00%

E = 0.80 IN      E = 1.66 IN  
V-360 = 478.07 CF    V-360 = 990.29 CF  
AD = 0.0 AC      AD = 0.08231 AC  
V-10 DAY = 478.07 CF    V-10 DAY = 1,387.59 CF

**V (REQUIRED) = 990.29 - 478.07 = 512.22 CF USING V-360**

**V (REQUIRED) = 1,387.50 - 478.07 = 909.43 CF USING V-10 DAY**

**FLOW CALCULATIONS**

A = 1.71 CFS/AC  
B = 2.36 CFS/AC  
C = 3.05 CFS/AC  
D = 7.34 CFS/AC

**TOTAL QP = QPA\*AA + QPB\*AB + QPC\*AC + QPD\*AD**

QP (HISTORICAL) = 0.45 CFS  
QP (PROPOSED) = 0.69 CFS


**PONDING VOLUME CALCULATION**

**PONDS A & B & C & D**  
BOTTOM AREA (@ 5179.75) = 50.57 SF  
TOP AREA (@ 5180.50) = 171.13 SF  
DEPTH = 0.75'  
POND VOLUME = (171.13 + 50.57) / 2 \* 0.75  
POND VOLUME = 83.13 CF  
PONDS TOTAL VOLUME = 83.13 \* 4 = 332.54 CF

**POND E**  
BOTTOM AREA (@ 5178.25) = 81.26  
TOP AREA (@ 5180.25) = 295.43  
DEPTH = 2.00'  
POND VOLUME = (296.43 + 81.26) / 2 \* 2  
POND VOLUME = 376.69 CF

TOTAL VOLUME (A+B+C+D+E+F) =  
VOL = 332.54 + 376.69 + 298.44 = 1,007.67 CF

**POND F**  
BOTTOM AREA (@ 5178.80) = 51.80  
TOP AREA (@ 5180.80) = 246.64  
DEPTH = 2.00'  
POND VOLUME = (248.64 + 51.80) / 2 \* 2.00'  
POND VOLUME = 298.44 CF

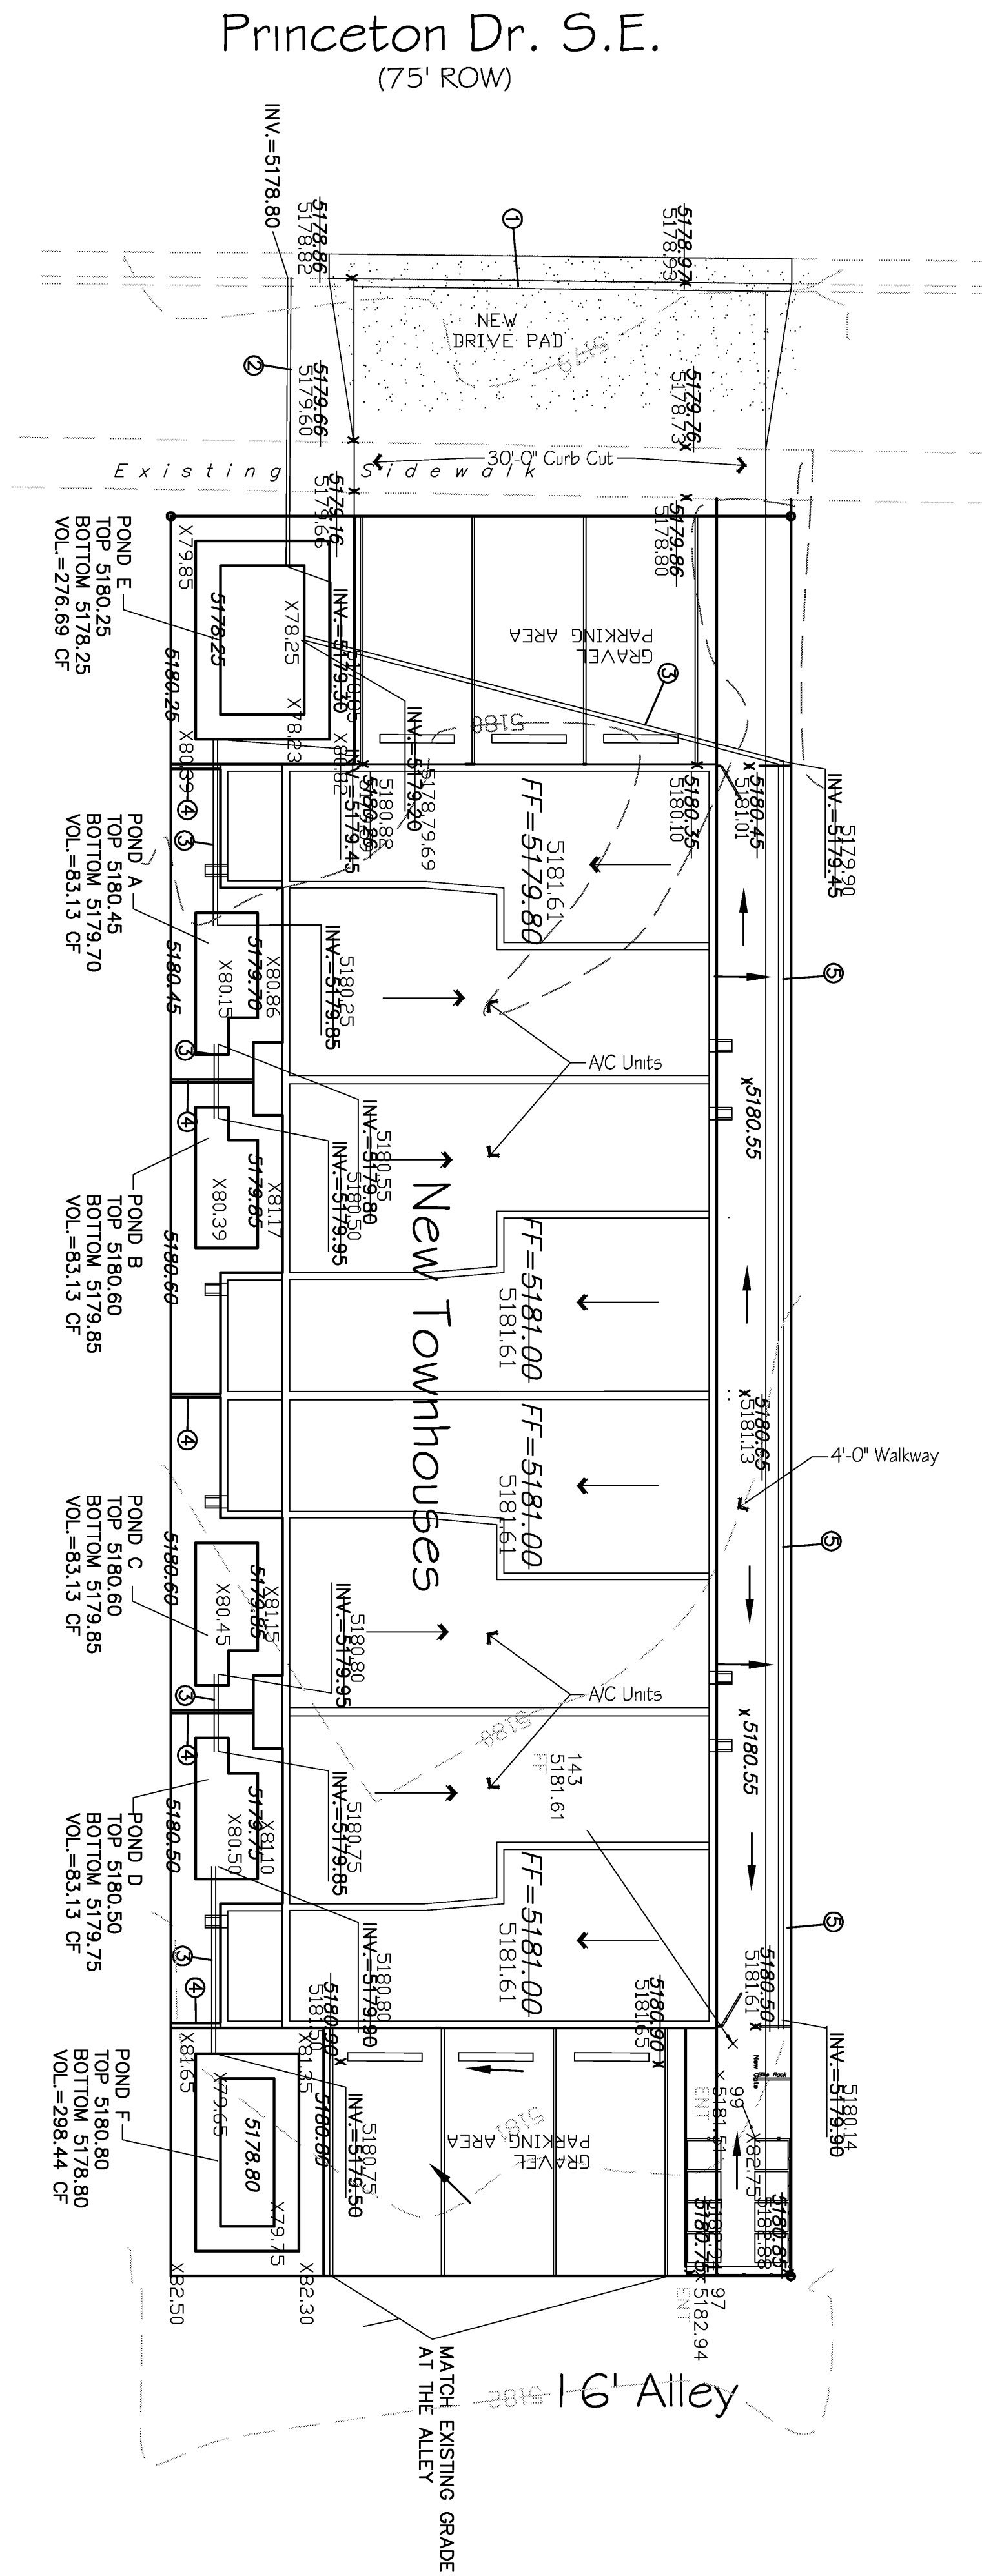

**NOTICE TO CONTRACTOR**  
PRIVATE DRAINAGE FACILITIES WITHIN CITY RIGHT-OF-WAY (SO-19')

- Build sidewalk culvert per COA STD DWG 2236. Work is permitted and inspected by DMD Construction Services Division.
- An excavation permit will be required before beginning any work within City Right Of Way.
- All work on this project shall be performed in accordance with applicable federal, state and local laws, rules and regulations concerning construction safety and health.
- Prior to any excavation, the contractor must contact New Mexico One Call, dial "811" [or (505) 260\_1990] for the location of existing utilities.
- Prior to construction, the contractor shall excavate and verify the locations of all obstructions. Should a conflict exist, the contractor shall notify the engineer so that the conflict can be resolved with a minimum amount of delay.
- Backfill compaction shall be 95%.
- Maintenance of the facility shall be the responsibility of the owner of the property being served.
- Work on arterial streets may be required on a 24-hour basis.
- For excavation and barricading inspections, contact DMD Construction Services Division.

APPROVALS	NAME	DATE
INSPECTOR		

**KEYED NOTES:**




- INSTALL NEW DRIVEPAD PER C.O.A. STD DWG 2425.
- INSTALL 4" STORM DRAIN PIPE, SCHEDULE 40. INSTALL CURB DRAIN PER C.O.A. STD DWG 2235.
- INSTALL 4" STORM DRAIN PIPE, SCHEDULE 40.
- DIVIDING WALL, PVC SLAT.
- 4" PERFERATED PIPE WITH LINER AND GRAVEL ON TOP

**DRAINAGE CERTIFICATION**

I, REZA AFAGHPOUR, NMPE11814 OF SBS CONSTRUCTION AND ENGINEERING, LLC, HEREBY CERTIFY THAT THIS PROJECT HAS BEEN GRADED AND WILL DRAIN IN SUBSTANTIAL COMPLIANCE WITH AND IN ACCORDANCE WITH THE DESIGN INTENT OF THE APPROVED PLAN DATED 02-02-2022. THE RECORD INFORMATION EDITED ONTO THE ORIGINAL DESIGN DOCUMENT HAS BEEN OBTAINED BY NMPS 9801 LEONARD MARTINEZ OF SBS CONSTRUCTION AND ENGINEERING. I FURTHER CERTIFY THAT I HAVE PERSONALLY VISITED THE PROJECT SITE ON AND HAVE DETERMINED BY VISUAL INSPECTION THAT THE SURVEY DATA PROVIDED IS REPRESENTATIVE OF ACTUAL SITE CONDITIONS AND IS TRUE AND CORRECT TO THE BEST OF MY KNOWLEDGE AND BELIEF. THIS CERTIFICATION IS SUBMITTED IN SUPPORT OF A REQUEST FOR FINAL CERTIFICATE OF OCCUPANCY.

THE RECORD INFORMATION PRESENTED HEREON IS NOT NECESSARILY COMPLETE AND INTENDED ONLY TO VERIFY SUBSTANTIAL COMPLIANCE OF THE GRADING AND DRAINAGE ASPECTS OF THIS PROJECT. THOSE RELYING ON THIS RECORD DOCUMENT ARE ADVISED TO OBTAIN INDEPENDENT VERIFICATION OF ITS ACCURACY BEFORE USING IT FOR ANY OTHER PURPOSE.



REZA AFAGHPOUR, NMPE 11814      12/21/2022      DATE

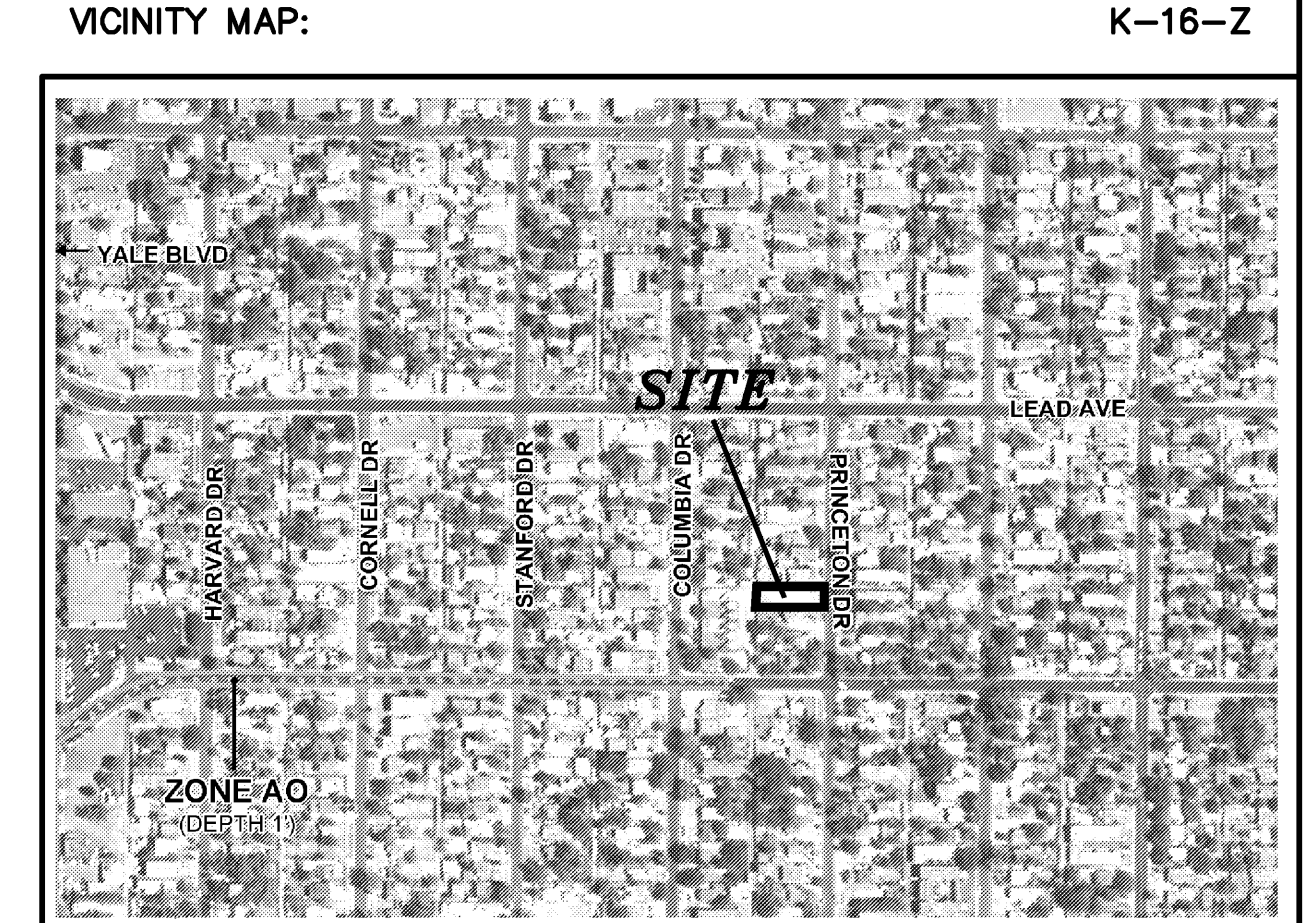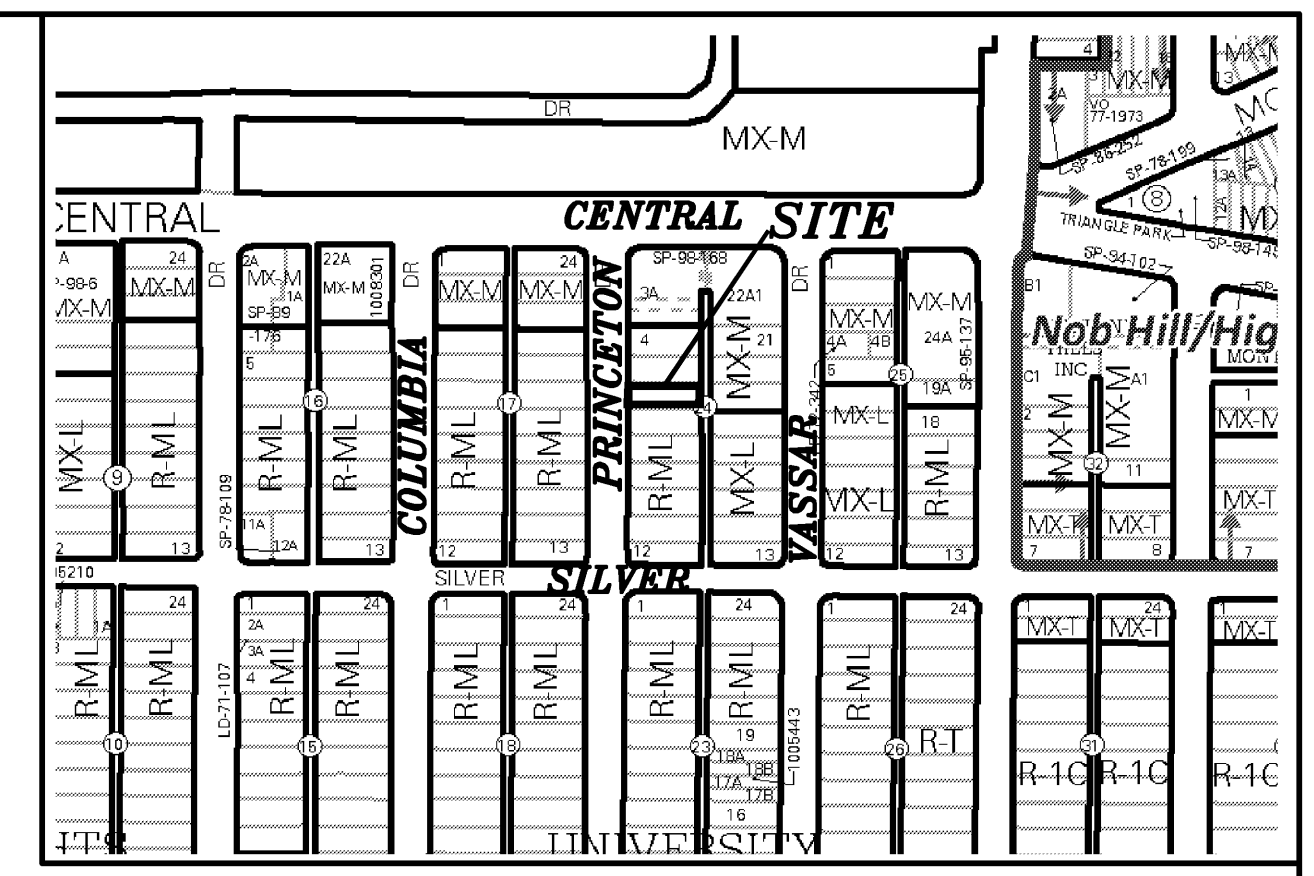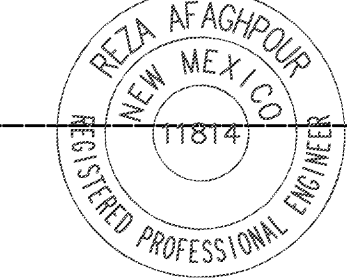

**LEGAL DESCRIPTION:**  
LOT 6, BLOCK 24, UNIVERSITY HEIGHTS ADDITION  
ADDRESS: 112 PRINCETON DR., SE ALBUQUERQUE, NM 87106

**LEGEND**

- 5030--- EXISTING CONTOUR (MAJOR)
- 5029--- EXISTING CONTOUR (MINOR)
- BOUNDARY LINE
- X 42.70 PROPOSED SPOT ELEVATION
- X 5029.16 EXISTING GRADE
- X 5075.65 EXISTING FLOWLINE ELEVATION
- FL PROPOSED RETAINING WALL
- BC=41.30 BOTTOM OF CHANEL
- TF=42.00 TOP OF FOOTING
- TRW=45.12 TOP OF RETAINING WALL
- HP HIGH POINT
- 5181.13 AS-BUILT GRADES
- 5180.65 AS-BUILT SPOT ELEVATIONS
- X81.65

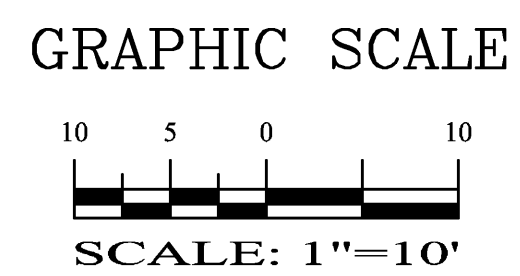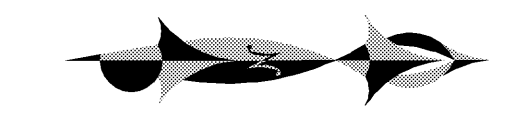

REZA AFAGHPOUR  
P.E. #11814

<b>112 PRINCETON DR., SE GRADING PLAN</b>			
DRAWING: 202138GD.DWG	DRAWN BY: SH-B	DATE: 1-25-2022	SHEET # <b>1</b>