


CITY OF ALBUQUERQUE

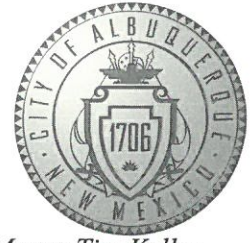

Planning Department
David Campbell, Director

Mayor Tim Keller

October 22, 2018

Matt Satches, PE
Bohannon-Huston
7500 Jefferson St NE Courtyard I
Albuquerque, NM 87109

RE: Highland High School Title IX Gymnasium Upgrade-Phase 1
4700 Coal Ave SE
Requested Permanent C. O. – Not Accepted
Engineers Stamp Date 6/23/16 (K17D021)
Certification dated: 10-16-18

Dear Mr. Satches,

PO Box 1293

Based on the certification provided in your submittal received 10/16/2018, the above referenced is disapproved for a Permanent Release of Occupancy by Hydrology. Before a permanent CO can be accepted the following comments must be addressed.

Albuquerque

- All construction fencing is to be removed from Phase 1. See attached pic.
- The further most north double Sidewalk Culvert is incomplete. See attached pic.
- The Hydrology certification must be on the drawing, not a separate letter.

NM 87103

An inspection by our office will need to take place after these corrections are made.

www.cabq.gov

If you have any questions, you can contact me at 924-3986 or Totten Elliott at 924-3982.

Sincerely,

James D. Hughes, P.E.
Principal Engineer, Planning Dept.
Development and Review Services

TE/JH
C: email

October 16, 2018

Doug Hughes, PE
Principal Engineer, Hydrology
Planning Department
City of Albuquerque
600 2nd St NW
Albuquerque, NM 87102

Re: Highland HS Title IX Gym Upgrade – Hydrology Permanent CO
COA Hydrology #K17D021A
Building Permit # 2018-11701 – Phase 1

Dear Mr. Hughes:

Enclosed for your review is a copy of the above referenced project's Drainage Certification Submittal. Per our meeting on Friday, September 14th, the Highland High School Title IX Gym Upgrade has been divided into 6 separate phases, each with their own Building Permit Number. An exhibit has been attached to this submittal showing the portion of the site to be certified. As noted during our meeting, a final As-Built Drainage Certification will be submitted at the end of the project. As requested, below is a list of minor deficiencies that will be addressed prior to the overall Drainage Certification at the end of the project:

1. 4' Wide Valley Gutter not installed at correct angle per plan. Sidewalk Culverts will need to be removed and placed in the correct location per plan as a result.
2. Landscaping not completed at the time of the site visit.

I, Matthew H. Satches, NMPE 24572, of the firm Bohannon Huston Inc, hereby certify that this project has been graded and will drain in substantial compliance with and in accordance with the design intent of the approved plan dated 6-23-16. I have reviewed record information provided by Brian Martinez, NMPLS 18374, of the firm Cartesian Surveys Inc. I further certify that I have personally visited the project site on 8/17/2018 and have determined by visual inspection that the survey data provided is representative of actual site conditions and is true and correct to the best of my knowledge and belief of the area. With this submittal, we are requesting City of Albuquerque Hydrology Permanent Certificate of Occupancy for Phase 1 **ONLY** (Building Permit # 2018-11701) of the Highland High School Title IX Gym Upgrade Project. If you have any questions or require further information, please feel free to contact me.

Sincerely,

Matt Satches, PE
Engineer
Community Development & Planning


MHS/Enclosures



Engineering ▲

Spatial Data ▲

Advanced Technologies ▲

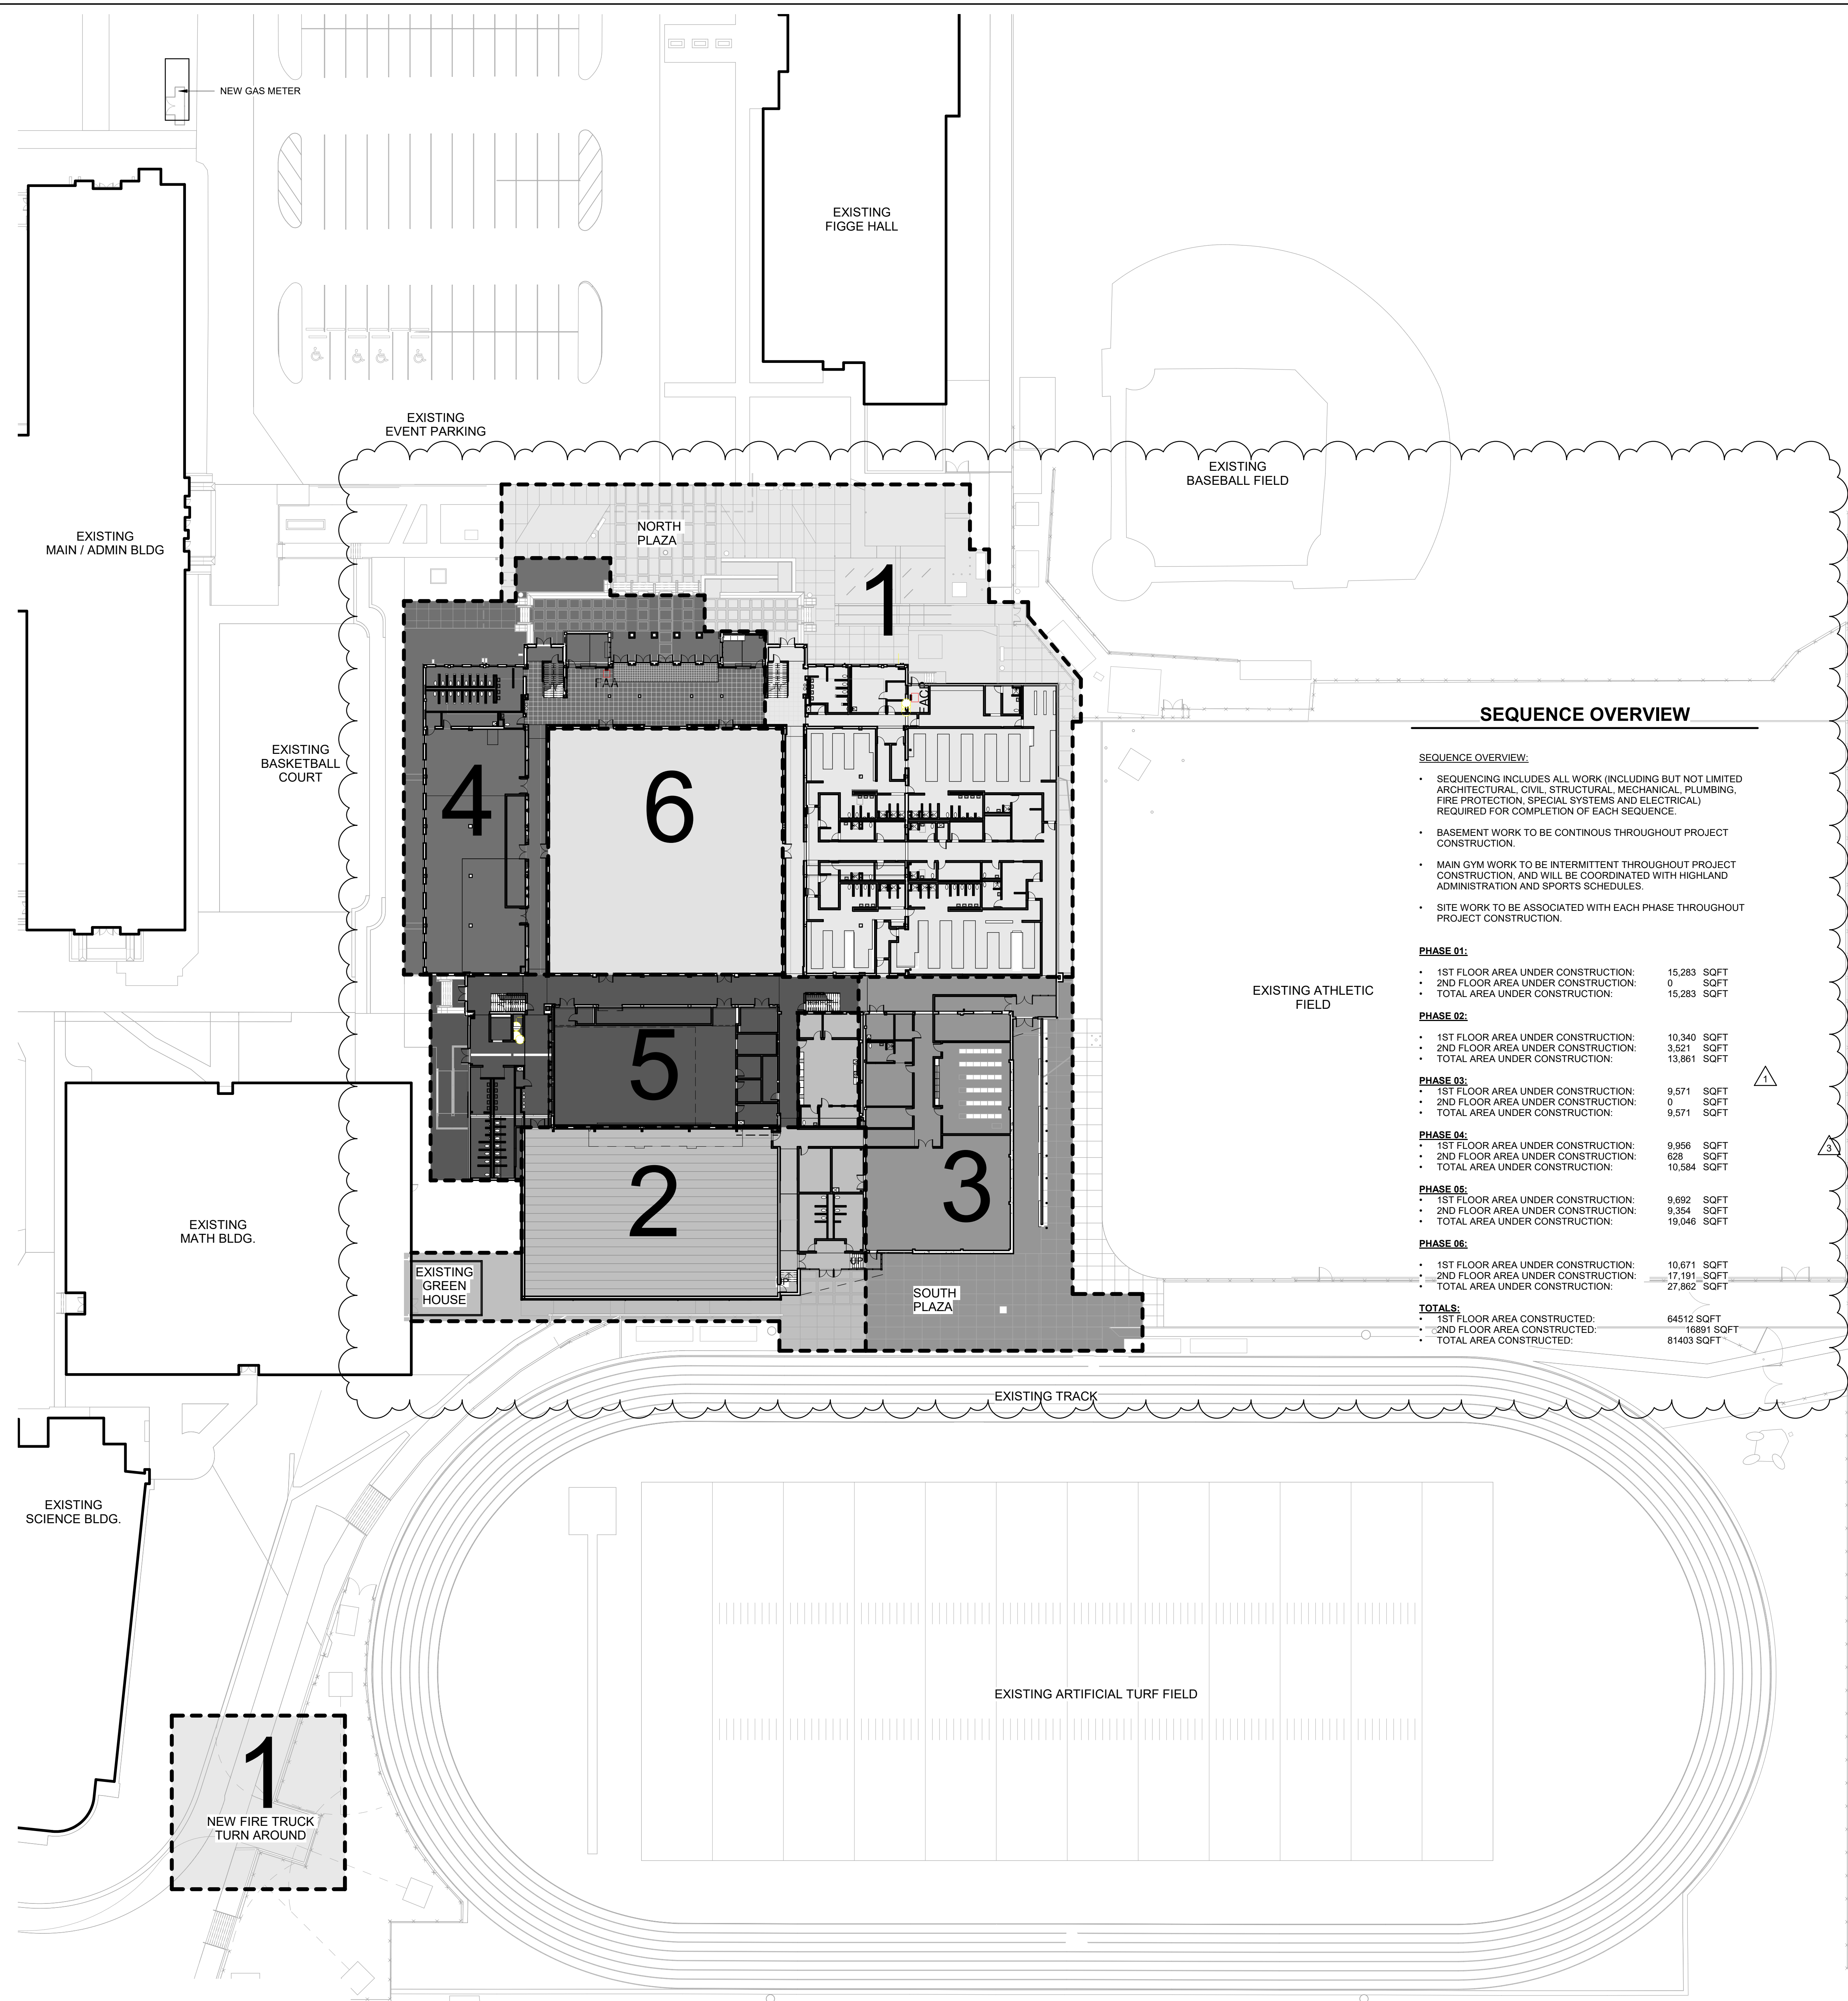

GENERAL NOTES

1. IF THIS SHEET IS NOT 30" X 42" THEN IT IS A REDUCED SIZE PLOT. USE GRAPHIC SCALE ACCORDINGLY.
2. GYMNASIUM BUILDING IS TO REMAIN IN OPERATION DURING CONSTRUCTION.
3. CONSTRUCTION SEQUENCING AND DURATION WERE USED AS A BASIS FOR DESIGN. THE CONTRACTOR MAY PROPOSE ALTERNATE SEQUENCING AND SCHEDULES PENDING APPROVAL BY APS FD&C AND HIGHLAND HIGH SCHOOL ADMINISTRATION.
4. BASEMENT LEVEL WILL BE UNDER CONSTRUCTION FOR DURATION OF PROJECT.
5. MAIN GYMNASIUM WORK TO OCCUR INTERMITTENTLY AS THE SPACE IS AVAILABLE.
6. ABATEMENT WORK BY APS TO OCCUR PRIOR TO ANY CONSTRUCTION WORK.
7. SITE WORK TO BE COORDINATED DURING ADJACENT BUILDING WORK.
8. ROOFING TO BE COORDINATED DURING ADJACENT BUILDING WORK.
9. SEE ALL DRAWINGS AND SPECIFICATIONS FOR COORDINATION OF DISCIPLINES.
10. COORDINATE WITH LANDSCAPE - WORK BY OTHERS.
11. BUILD TEMPORARY WALLS/BARRICADES AS NECESSARY.
12. COORDINATE ALL BUILDING, ROOF, AND SITEWORK UTILITIES. SUBMIT PLAN FOR APPROVAL FOR TEMPORARY SITE AND ROOF RAINWATER DIVERSION.

SEQUENCE OVERVIEW

SEQUENCE OVERVIEW:

- SEQUENCING INCLUDES ALL WORK (INCLUDING BUT NOT LIMITED ARCHITECTURAL, CIVIL, STRUCTURAL, MECHANICAL, PLUMBING, FIRE PROTECTION, SPECIAL SYSTEMS AND ELECTRICAL) REQUIRED FOR COMPLETION OF EACH SEQUENCE.
- BASEMENT WORK TO BE CONTINUOUS THROUGHOUT PROJECT CONSTRUCTION.
- MAIN GYM WORK TO BE INTERMITTENT THROUGHOUT PROJECT CONSTRUCTION, AND WILL BE COORDINATED WITH HIGHLAND ADMINISTRATION AND SPORTS SCHEDULES.
- SITE WORK TO BE ASSOCIATED WITH EACH PHASE THROUGHOUT PROJECT CONSTRUCTION.

PHASE 01:

- 1ST FLOOR AREA UNDER CONSTRUCTION: 15,283 SQFT
- 2ND FLOOR AREA UNDER CONSTRUCTION: 0 SQFT
- TOTAL AREA UNDER CONSTRUCTION: 15,283 SQFT

PHASE 02:

- 1ST FLOOR AREA UNDER CONSTRUCTION: 10,340 SQFT
- 2ND FLOOR AREA UNDER CONSTRUCTION: 3,521 SQFT
- TOTAL AREA UNDER CONSTRUCTION: 13,861 SQFT

PHASE 03:

- 1ST FLOOR AREA UNDER CONSTRUCTION: 9,571 SQFT
- 2ND FLOOR AREA UNDER CONSTRUCTION: 0 SQFT
- TOTAL AREA UNDER CONSTRUCTION: 9,571 SQFT

PHASE 04:

- 1ST FLOOR AREA UNDER CONSTRUCTION: 9,958 SQFT
- 2ND FLOOR AREA UNDER CONSTRUCTION: 628 SQFT
- TOTAL AREA UNDER CONSTRUCTION: 10,584 SQFT

PHASE 05:

- 1ST FLOOR AREA UNDER CONSTRUCTION: 9,692 SQFT
- 2ND FLOOR AREA UNDER CONSTRUCTION: 9,354 SQFT
- TOTAL AREA UNDER CONSTRUCTION: 19,046 SQFT


PHASE 06:


- 1ST FLOOR AREA UNDER CONSTRUCTION: 10,671 SQFT
- 2ND FLOOR AREA UNDER CONSTRUCTION: 17,191 SQFT
- TOTAL AREA UNDER CONSTRUCTION: 27,862 SQFT

TOTALS:

- 1ST FLOOR AREA CONSTRUCTED: 64,512 SQFT
- 2ND FLOOR AREA CONSTRUCTED: 16,891 SQFT
- TOTAL AREA CONSTRUCTED: 81,403 SQFT

CONSTRUCTION SEQUENCING PHASES

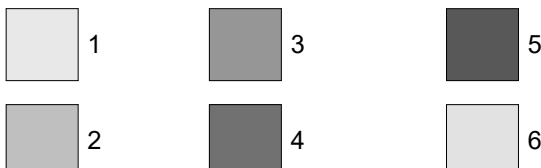

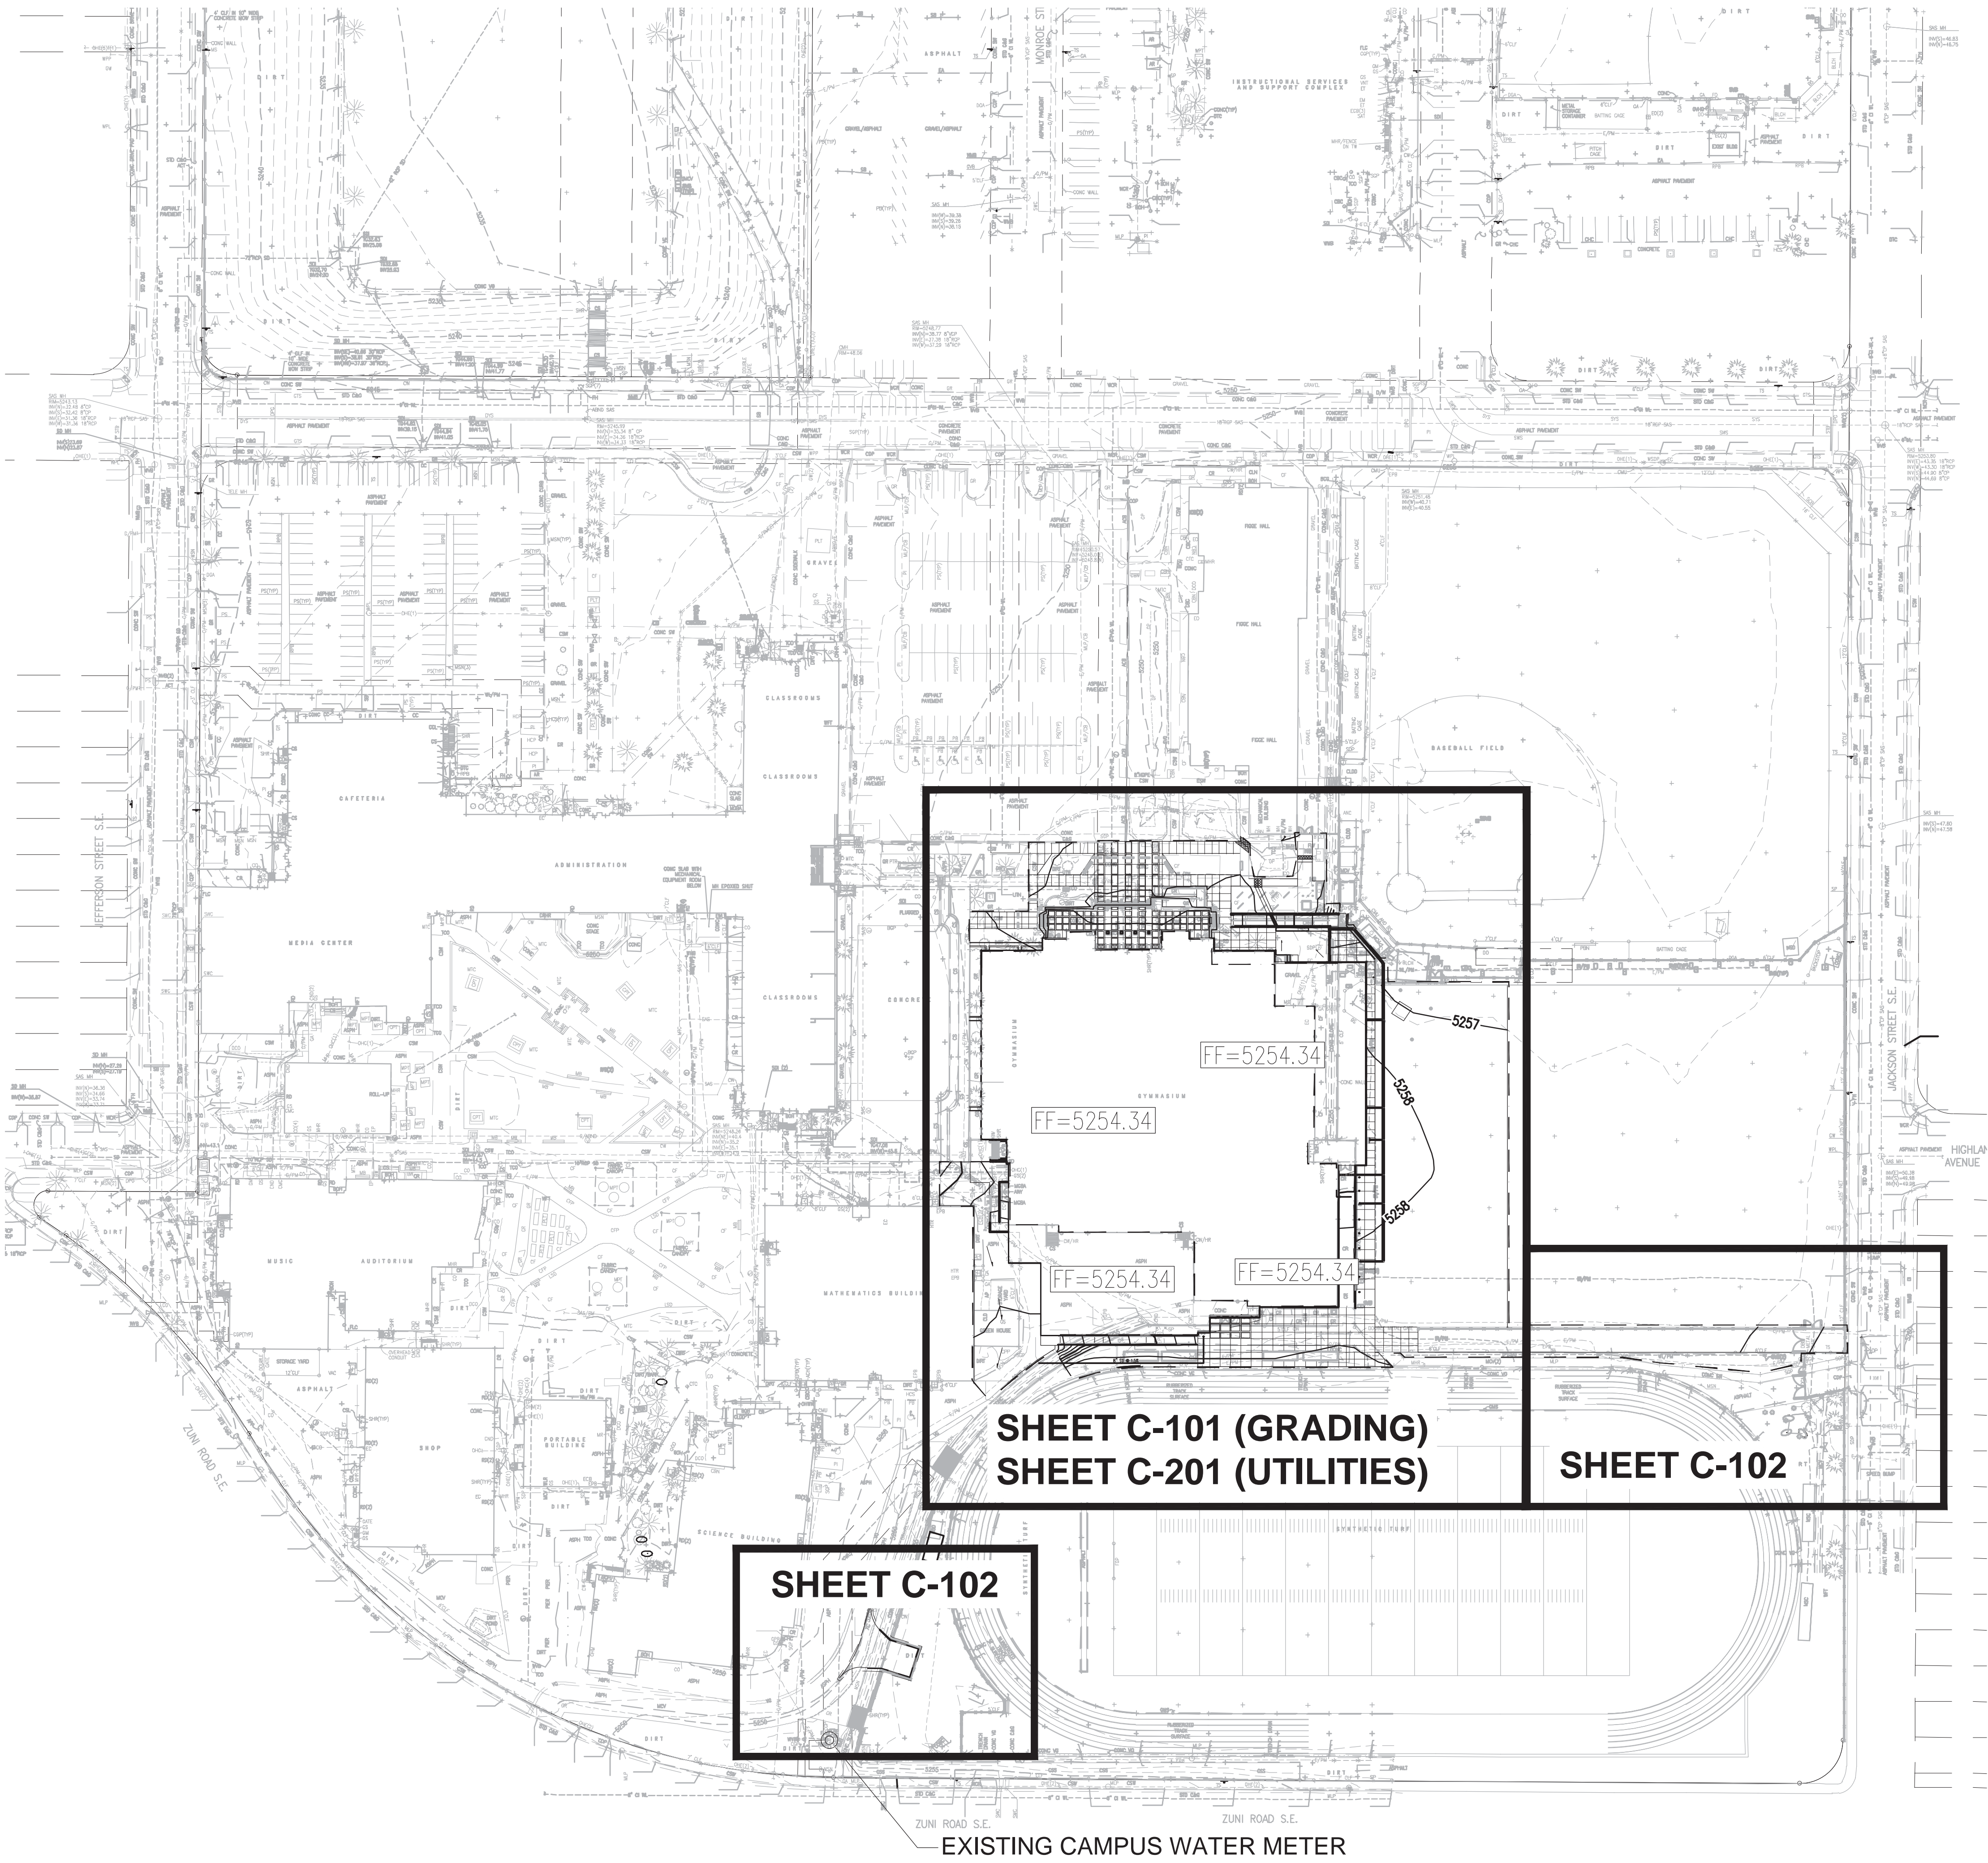

A1 OVERALL CIVIL PLAN
SCALE: 1" = 60'



GRADING SHEET NOTES

1. EXCEPT AS PROVIDED HEREIN, GRADING SHALL BE PERFORMED AT THE ELEVATIONS AND IN ACCORDANCE WITH THE DETAILS SHOWN ON THIS PLAN.
2. THE COST FOR REQUIRED CONSTRUCTION DUST AND EROSION CONTROL MEASURES SHALL BE INCIDENTAL TO THE PROJECT COST.
3. ALL WORK RELATIVE TO FOUNDATION CONSTRUCTION, SITE PREPARATION, AND PAVEMENT INSTALLATION, AS SHOWN ON THIS PLAN, SHALL BE CONSTRUCTED IN ACCORDANCE WITH THE "GEOTECHNICAL INVESTIGATION," AS PROVIDED BY THE ARCHITECT OR OWNER. ALL OTHER WORK SHALL, UNLESS OTHERWISE STATED OR PROVIDED FOR HEREON, BE CONSTRUCTED IN ACCORDANCE WITH THE PROJECT, (FIRST PRIORITY) SPECIFICATIONS, AND/OR THE CITY OF ALBUQUERQUE STANDARD SPECIFICATIONS FOR PUBLIC WORKS.
4. EARTH SLOPES SHALL NOT EXCEED 5 HORIZONTAL TO 1 VERTICAL PER THE GEOTECHNICAL REPORT UNLESS SHOWN OTHERWISE.
5. IT IS THE INTENT OF THESE PLANS THAT THIS CONTRACTOR SHALL NOT PERFORM ANY WORK OUTSIDE OF THE PROPERTY BOUNDARIES EXCEPT AS REQUIRED BY THIS PLAN.
6. THE CONTRACTOR IS TO ENSURE THAT NO SOIL ERODES FROM THE SITE ONTO ADJACENT PROPERTY OR PUBLIC RIGHT-OF-WAY.
7. A DISPOSAL SITE FOR ANY & ALL EXCESS EXCAVATION MATERIAL, AND UNSUITABLE MATERIAL AND/OR A BORROW SITE CONTAINING ACCEPTABLE FILL MATERIAL SHALL BE OBTAINED BY THE CONTRACTOR IN COMPLIANCE WITH THE APPLICABLE ENVIRONMENTAL REGULATIONS AND APPROVED BY THE OBSERVER. ALL COSTS INCURRED IN OBTAINING A DISPOSAL OR BORROW SITE AND HAUL TO OR FROM SHALL BE CONSIDERED INCIDENTAL TO THE PROJECT AND NO SEPARATE MEASUREMENT OR PAYMENT SHALL BE MADE.
8. PAVING AND ROADWAY GRADES SHALL BE +/- 0.1' FROM PLAN ELEVATIONS. PAD ELEVATION SHALL BE +/- 0.05' FROM BUILDING PLAN ELEVATION.
9. ALL PROPOSED CONTOURS REFLECT TOP OF PAVEMENT ELEVATIONS IN THE PARKING AREA AND MUST BE ADJUSTED FOR MEDIANS AND ISLANDS.
10. VERIFY ALL ELEVATIONS SHOWN ON PLAN FROM BASIS OF ELEVATION CONTROL STATION PRIOR TO BEGINNING CONSTRUCTION.
11. SIDEWALK CROSS-SLOPES SHALL BE AT A MINIMUM OF 1.0% AND A MAXIMUM OF 2.0%.
12. HDPE PIPE AND FITTINGS SHALL BE INSTALLED AND BACKFILLED PER MANUFACTURER SPECIFICATIONS. CONNECTIONS TO CONCRETE MANHOLES AND CONCRETE DROP INLETS SHALL USE WATER STOP GASKETS AND SHALL BE INSTALLED PER MANUFACTURER'S SPECIFICATIONS.
13. ENDS OF ALL STORM DRAIN PIPES, CULVERTS, & CMP END SECTIONS (LARGER THAN 12") SHALL BE COVERED WITH STEEL BARS (TO KEEP CHILDREN OUT) APPROXIMATELY 12" SQUARE. CONTRACTOR TO SUBMIT SHOP DRAWINGS FOR REVIEW AND APPROVAL. HYDRAULIC INTEGRITY SHALL NOT BE COMPROMISED. BARS TO BE PAINTED TO MATCH BUILDING.

UTILITY SHEET NOTES

1. THIS CONTRACTOR SHALL BE RESPONSIBLE FOR THE COMPLETE PROCUREMENT AND INSTALLATION OF ALL WORK AND MATERIALS RELATED TO MECHANICAL UTILITIES AS SHOWN ON THIS PLAN INCLUDING: TRENCHING, BACKFILL, SUPPORTS, CLEANOUT PADS, SERVICE STOPS AND BOXES, SERVICE LINES, TESTING, CLEANING, AND STERILIZING. ANY WORK NOT ACCEPTED BY THE ARCHITECT OR ENGINEER DUE TO IMPROPER WORKMANSHIP OR LACK OF PROPER COORDINATION SHALL BE REMOVED AND CORRECTLY INSTALLED AT THE CONTRACTOR'S EXPENSE, AS DIRECTED.
2. MINIMUM DEPTHS OF COVER SHALL BE: 36" FOR WATERLINES AND 48" FOR SEWER, EXCEPT AT BUILDING CONNECTION.
3. ALL WORK DETAILED ON THESE PLANS TO BE PERFORMED UNDER CONTRACT SHALL, EXCEPT AS OTHERWISE STATED OR PROVIDED OF HEREON, BE CONSTRUCTED IN ACCORDANCE WITH THE IAPMO UNIFORM PLUMBING CODE & NFPA 24, LATEST EDITION.
4. UTILITY LINES SHALL BE INSTALLED PRIOR TO PAVEMENT, CURB AND GUTTER, AND/OR SIDEWALK, AS APPLICABLE.
5. ROUGH GRADING OF SITE (+0.5') SHALL BE COMPLETED PRIOR TO INSTALLATION OF UTILITY LINES.
6. CONTRACTOR WILL BE RESPONSIBLE FOR CONNECTIONS TO BUILDING DRAIN LINES AND ALL NECESSARY FITTINGS.
7. ALL VALVES SHALL BE ANCHORED PER CITY OF ALBUQUERQUE STANDARD DRAWING 2333.
8. FIRE LINES SHALL USE PIPE MATERIALS UNDERWRITERS LABORATORIES LISTED AND APPROVED FOR FIRE SERVICE.
9. CONTRACTOR SHALL BE RESPONSIBLE FOR ALL WATER METER, FIRE LINE, AND SEWER HOOKUP FEES FOR INSTALLATIONS. OWNER SHALL BE RESPONSIBLE FOR UTILITY EXPANSION CHARGES, PRORATA AND OTHER SPECIAL ASSESSMENTS.
10. CONTRACTOR SHALL VERIFY INVERTS AND LOCATIONS OF EXISTING WATER/SAS LINES PRIOR TO BEGINNING WORK. ALL CONFLICTS SHALL BE BROUGHT TO ATTENTION OF THE ENGINEER AND RESOLVED PRIOR TO BEGINNING WORK.
11. CONTRACTOR SHALL NOTIFY THE AUTHORITY HAVING JURISDICTION PRIOR TO INSTALLATION OF FIRE SERVICE LINES, AND PRIOR TO TESTING OF ALL WATERLINES. CONTRACTOR SHALL COMPLETE, SIGN, AND SUBMIT THE "CONTRACTOR'S MATERIAL & TEST CERTIFICATE FOR UNDERGROUND PIPING" IN ACCORDANCE WITH NFPA 24.

LANDSCAPE GENERAL NOTE:

1. SUBGRADE FOR LANDSCAPE AREAS SHALL BE AS FOLLOWS:
 - A. FOR AREAS WHERE GRAVEL MULCH IS SPECIFIED, THE SUBGRADE SHALL BE 4" BELOW FINISHED GRADES.
 - B. FOR AREAS WHERE SOO (STAGING AREA) IS SPECIFIED, THE SUBGRADE SHALL BE 2.5' BELOW TOP OF FINISHED GRADES.
2. THE SUBGRADE FOR LANDSCAPE AREAS SHALL BE DONE BY THE GENERAL CONTRACTOR. SITE LANDSCAPE WILL BE INSTALLED BY THE APS ON-CALL LANDSCAPE CONTRACTOR AS SPECIFIED ON SHEET LP101.

NOTE:

CONTRACTOR SHALL PROVIDE AS-BUILT GRADING INFORMATION STAMPED BY A PROFESSIONAL SURVEYOR. AS-BUILT INFORMATION REQUIRED SHALL BE COORDINATED WITH THE ENGINEER AND SHALL BE SUFFICIENTLY DETAILED TO VERIFY THAT THE DRAINAGE WILL FUNCTION IN ACCORDANCE WITH THE DESIGN. AS-BUILT DATA SHALL BE PROVIDED AT LEAST 5 WORKING DAYS PRIOR TO CONTRACTOR'S REQUEST FOR TEMPORARY CERTIFICATE OF OCCUPANCY. AS-BUILT DATA SHALL BE UPDATED AND RE-SUBMITTED ONE WEEK PRIOR TO FINAL CERTIFICATE OF OCCUPANCY REQUEST. AT A MINIMUM, AS-BUILT DATA SHALL INCLUDE:

- ALL GRATES AND INVERTS OF CATCH BASINS
- APPROXIMATELY 75% OF ALL DESIGN SPOT ELEVATIONS & FINISHED FLOOR ELEVATIONS.

GENERAL SHEET NOTES

1. ALL WORK DETAILED ON THESE PLANS AND PERFORMED UNDER THIS CONTRACT SHALL BE CONSTRUCTED IN ACCORDANCE WITH THE PROJECT SPECIFICATIONS AND THE PROJECT GEOTECHNICAL REPORT, WHERE APPLICABLE, NMAPWA PUBLIC WORKS STANDARDS SHALL APPLY.
2. THE CONTRACTOR SHALL ABIDE BY ALL LOCAL, STATE, AND FEDERAL LAWS, RULES AND REGULATIONS WHICH APPLY TO THE CONSTRUCTION OF THESE IMPROVEMENTS, INCLUDING EPA REQUIREMENTS WITH RESPECT TO STORM WATER DISCHARGE.
3. PRIOR TO CONSTRUCTION, THE CONTRACTOR SHALL FIELD VERIFY THE HORIZONTAL AND VERTICAL LOCATIONS OF ALL POTENTIAL OBSTRUCTIONS INCLUDING ALL UNDERGROUND UTILITIES. SHOULD A CONFLICT EXIST, THE CONTRACTOR SHALL NOTIFY THE CONSTRUCTION OBSERVER OR ENGINEER SO THAT THE CONFLICT CAN BE RESOLVED WITH A MINIMUM AMOUNT OF DELAY.
4. TWO (2) WORKING DAYS PRIOR TO ANY EXCAVATION, THE CONTRACTOR SHALL CONTACT LINE LOCATING SERVICE FOR LOCATION OF EXISTING UTILITIES.
5. ALL ELECTRICAL, TELEPHONE, CABLE TV, GAS AND OTHER UTILITY LINES, CABLES, AND APPURTENANCES ENCOUNTERED DURING CONSTRUCTION THAT REQUIRE RELOCATION, SHALL BE COORDINATED WITH THAT UTILITY. THE CONTRACTOR SHALL BE RESPONSIBLE FOR COORDINATION OF ALL NECESSARY UTILITY ADJUSTMENTS. NO ADDITIONAL COMPENSATION WILL BE ALLOWED FOR DELAYS OR INCONVENIENCES CAUSED BY UTILITY COMPANY WORK CREWS. THE CONTRACTOR MAY BE REQUIRED TO RESCHEDULE HIS ACTIVITIES TO ALLOW UTILITY CREWS TO PERFORM THEIR REQUIRED WORK.
6. THE CONTRACTOR IS RESPONSIBLE FOR PROTECTING ALL EXISTING UTILITY LINES WITHIN THE CONSTRUCTION AREA. ANY DAMAGE TO EXISTING FACILITIES CAUSED BY CONSTRUCTION ACTIVITY SHALL BE REPAIRED OR REPLACED AT THE CONTRACTOR'S EXPENSE AND APPROVED BY THE CONSTRUCTION OBSERVER.
7. CONSTRUCTION ACTIVITY SHALL BE LIMITED TO THE PROPERTY AND/OR PROJECT LIMITS. ANY DAMAGE TO ADJACENT PROPERTIES RESULTING FROM THE CONSTRUCTION PROCESS SHALL BE REPAIRED OR REPLACED AT THE CONTRACTOR'S EXPENSE.
8. OVERNIGHT PARKING OF CONSTRUCTION EQUIPMENT SHALL NOT OBSTRUCT DRIVEWAYS OR DESIGNATED TRAFFIC LANES. THE CONTRACTOR SHALL NOT STORE ANY EQUIPMENT OR MATERIAL WITHIN THE PUBLIC RIGHT-OF-WAY.
9. THE CONTRACTOR SHALL OBTAIN ALL THE NECESSARY PERMITS FOR THE PROJECT PRIOR TO COMMENCING CONSTRUCTION (I.E., BARRICADE, TOPSOIL DISTURBANCE, EXCAVATION PERMITS, DRIVEWAY PERMITS, ETC.).
10. ALL PROPERTY CORNERS DESTROYED DURING CONSTRUCTION SHALL BE REPLACED AT THE CONTRACTOR'S EXPENSE. ALL PROPERTY CORNERS MUST BE RESET BY A REGISTERED LAND SURVEYOR.
11. THE CONTRACTOR SHALL PREPARE A CONSTRUCTION TRAFFIC CONTROL AND SIGNING PLAN AND OBTAIN APPROVAL OF SUCH PLAN FROM THE BERNALILLO COUNTY TRAFFIC ENGINEERING DEPARTMENT PRIOR TO BEGINNING ANY CONSTRUCTION WORK ON OR ADJACENT TO EXISTING STREETS.
12. ALL BARRICADES AND CONSTRUCTION SIGNING SHALL CONFORM TO APPLICABLE SECTIONS OF THE "MANUAL ON UNIFORM TRAFFIC CONTROL DEVICES" (MUTCD), US DEPARTMENT OF TRANSPORTATION, LATEST EDITION.
13. THE CONTRACTOR SHALL MAINTAIN ALL CONSTRUCTION BARRICADES AND SIGNING AT ALL TIMES. THE CONTRACTOR SHALL VERIFY THE PROPER LOCATION OF ALL BARRICADES AT THE END AND BEGINNING OF EACH DAY.
14. THE PROJECT MUST CONFORM WITH THE EROSION AND SEDIMENT REQUIREMENTS OF THE 2003 EPA CONSTRUCTION GENERAL PERMIT OR LOCAL STANDARDS & CODES WHICHEVER IS MORE STRINGENT.
15. TWO WORKING DAYS PRIOR TO ANY EXCAVATION, THE CONTRACTOR MUST CONTACT NEW MEXICO ONE CALL SYSTEM (260-1990) FOR LOCATION OF EXISTING UTILITIES.
16. PRIOR TO CONSTRUCTION, THE CONTRACTOR SHALL EXCAVATE AND VERIFY THE HORIZONTAL AND VERTICAL LOCATIONS OF ALL OBSTRUCTIONS, SHOULD A CONFLICT EXIST. THE CONTRACTOR SHALL NOTIFY THE ENGINEER IMMEDIATELY SO THAT THE CONFLICT CAN BE RESOLVED WITH A MINIMUM AMOUNT OF DELAY.
17. CONTRACTOR SHALL NOT DISTURB PERMANENT SURVEY MONUMENTS WITHOUT THE CONSENT OF THE CITY SURVEYOR AND SHALL NOTIFY THE CITY SURVEYOR AND BEAR THE EXPENSE OF REPLACING ANY THAT MAY BE DISTURBED WITHOUT PERMISSION. REPLACEMENT SHALL BE DONE ONLY BY THE CITY SURVEYOR. WHEN A CHANGE IS MADE IN THE FINISHED ELEVATIONS OF THE PAVEMENT OF ANY ROADWAY IN WHICH A PERMANENT SURVEY MONUMENT IS LOCATED, CONTRACTOR SHALL, AT HIS OWN EXPENSE, ADJUST THE MONUMENT COVER TO THE NEW GRADE UNLESS OTHERWISE SPECIFIED. REFER TO SECTION 4.4 OF THE GENERAL CONDITIONS OF THE STANDARD SPECIFICATIONS.
18. CONTRACTOR SHALL RECORD DATA ON ALL UTILITY LINES AND ACCESSORIES AS REQUIRED BY THE CITY OF ALBUQUERQUE FOR THE PREPARATION OF "AS CONSTRUCTED" DRAWINGS. CONTRACTOR SHALL NOT COVER UTILITY LINES AND ACCESSORIES UNTIL ALL DATA HAS BEEN RECORDED.
19. CONTRACTOR SHALL MAINTAIN A GRAFFITI-FREE WORK SITE. CONTRACTOR SHALL PROMPTLY REMOVE ANY GRAFFITI FROM ALL EQUIPMENT, WHETHER PERMANENT OR TEMPORARY.
20. CONTRACTOR SHALL COORDINATE WITH THE ALBUQUERQUE BERNALILLO COUNTY WATER UTILITY AUTHORITY (ABCUWA) FIVE (5) WORKING DAYS IN ADVANCE OF ANY WORK THAT MAY AFFECT EXISTING PUBLIC WATER OR SEWER UTILITIES. EXISTING VALVES TO BE OPERATED BY CITY PERSONNEL ONLY. CONTRACTOR SHALL CONTACT THE WATER SYSTEMS DIVISION THREE (3) WORKING DAYS PRIOR TO NEEDING VALVES TURNED ON OR OFF.


LEGEND

- PROPERTY LINE
- - - LIMITS OF GRADING
- - - -5025- - - EXISTING INDEX CONTOUR
- - - -5024- - - EXISTING INTERMEDIATE CONTOUR
- - - -5025- - - PROPOSED INDEX CONTOUR
- - - -5024- - - PROPOSED INTERMEDIATE CONTOUR
- == STORM DRAIN LINE
- PROPOSED STORM DRAIN MANHOLE
- PROPOSED STORM DRAIN INLETS

SMPC Architects
PRINCIPLES OF DESIGN

115 Arment Drive SE
Albuquerque, New Mexico 87106
760.255.8688
F 505.262.6662
www.smpcarchitects.com

**Bohannon
Huston**
www.bhinc.com
800.877.5332

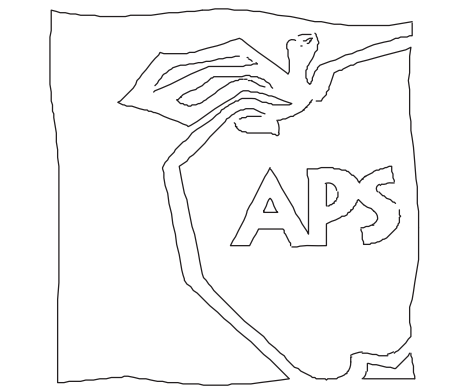


**ALBUQUERQUE PUBLIC SCHOOLS
HIGHLAND HIGH SCHOOL
TITLE IX GYMNASIUM UPGRADE**
4700 Coal Ave. SE
Albuquerque, NM 87108

100% CONSTRUCTION DOCUMENTS

NO	DATE	DESCRIPTION
1	2016-06-23	PROJECT #:
2	140001	DRAWN BY:
3	BHW	CHD BY:
4	JLM	Copyright:
5	SMPC Architects © 2014	These documents were prepared for this specific project only. SMPC Architects' liability is limited to this specific project, and does not extend to reuse of these documents for other projects.
6		SHEET TITLE

**OVERALL
CIVIL PLAN**


C-100
SHEET OF

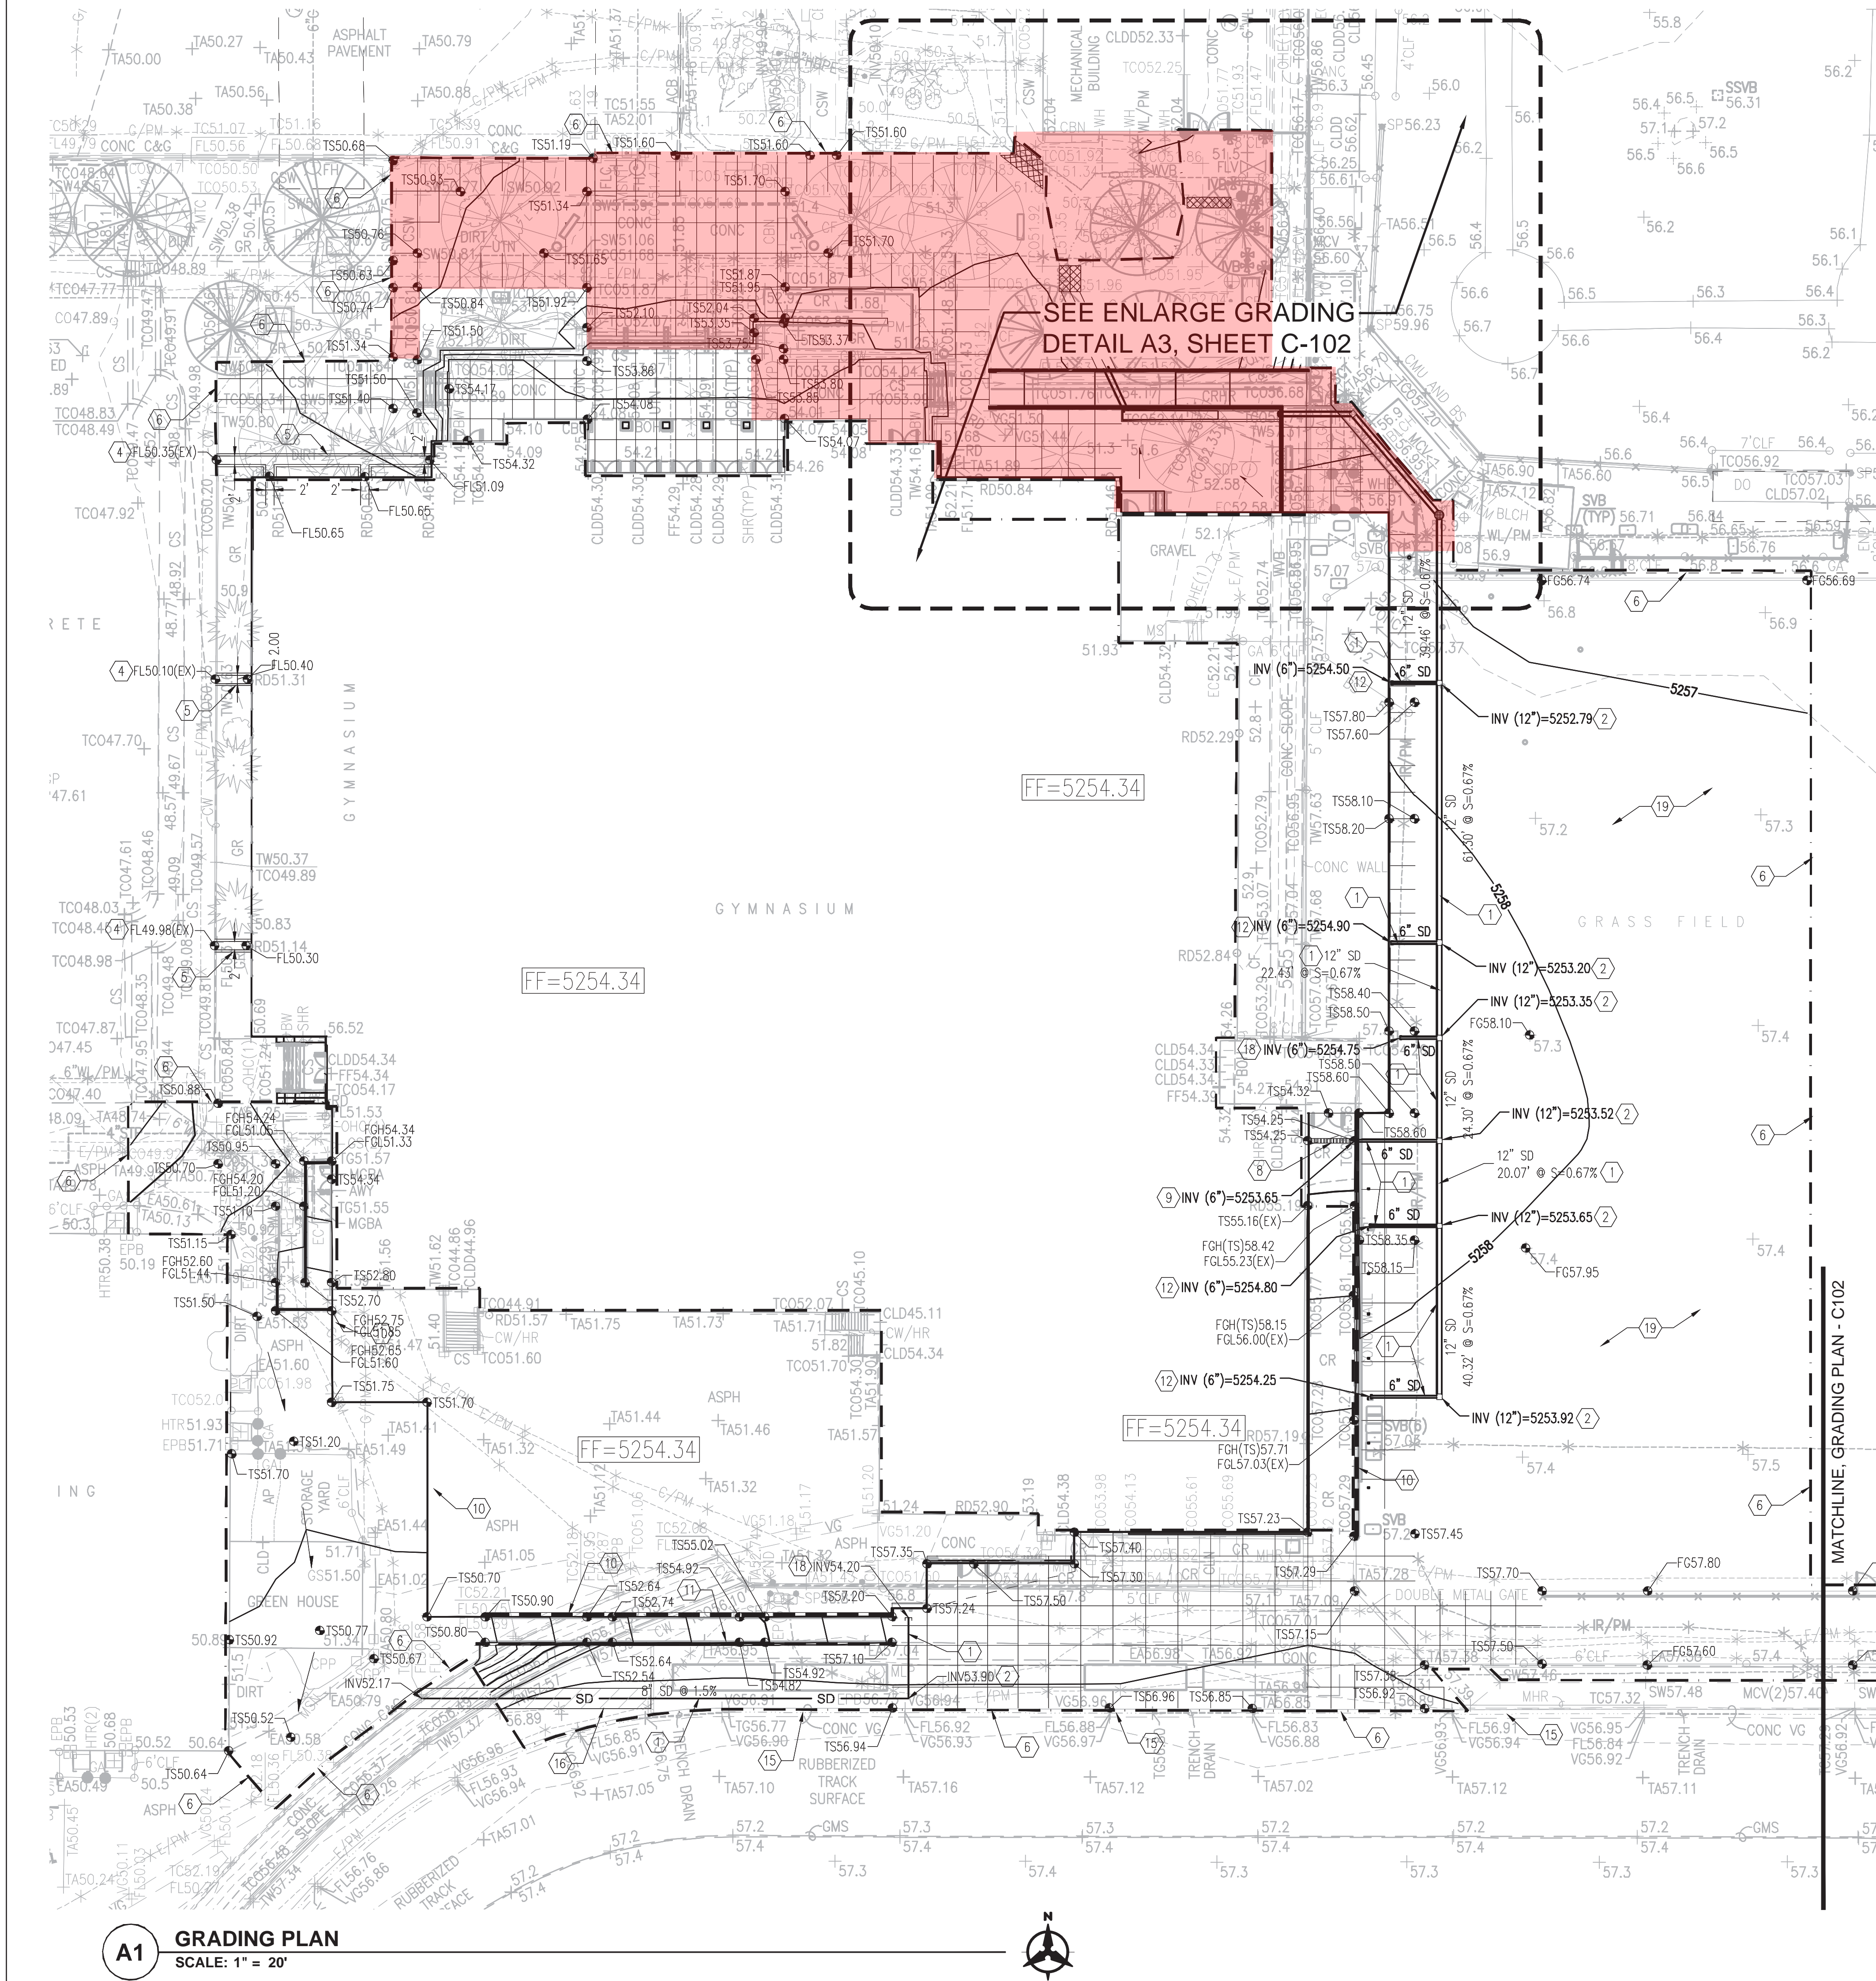


A1 GRADING PLAN
SCALE: 1" = 20'




SEE ENLARGE GRADING
DETAIL A3, SHEET C-102

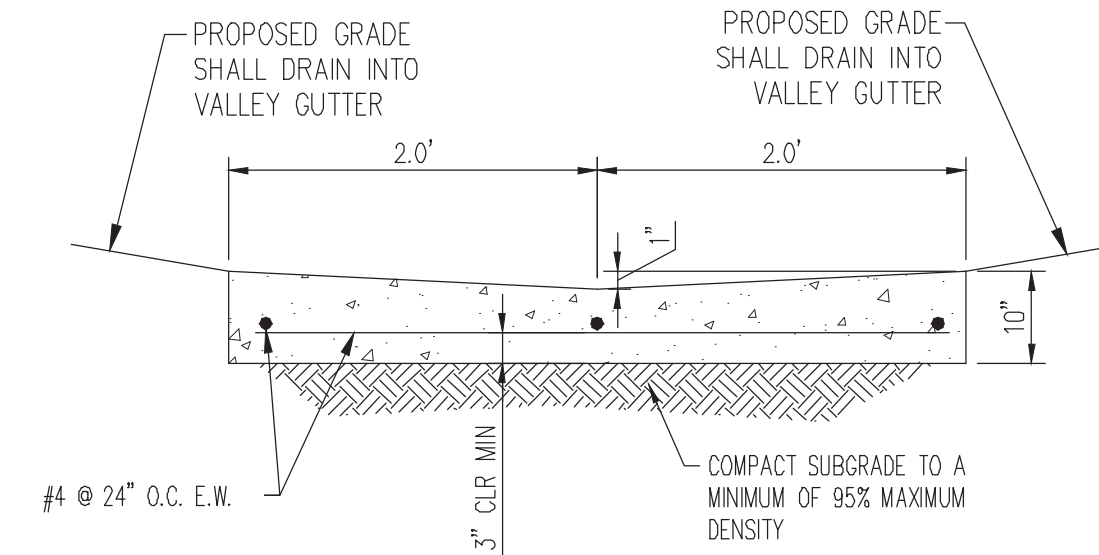


A5 4' CONCRETE VALLEY GUTTER
N.T.S.

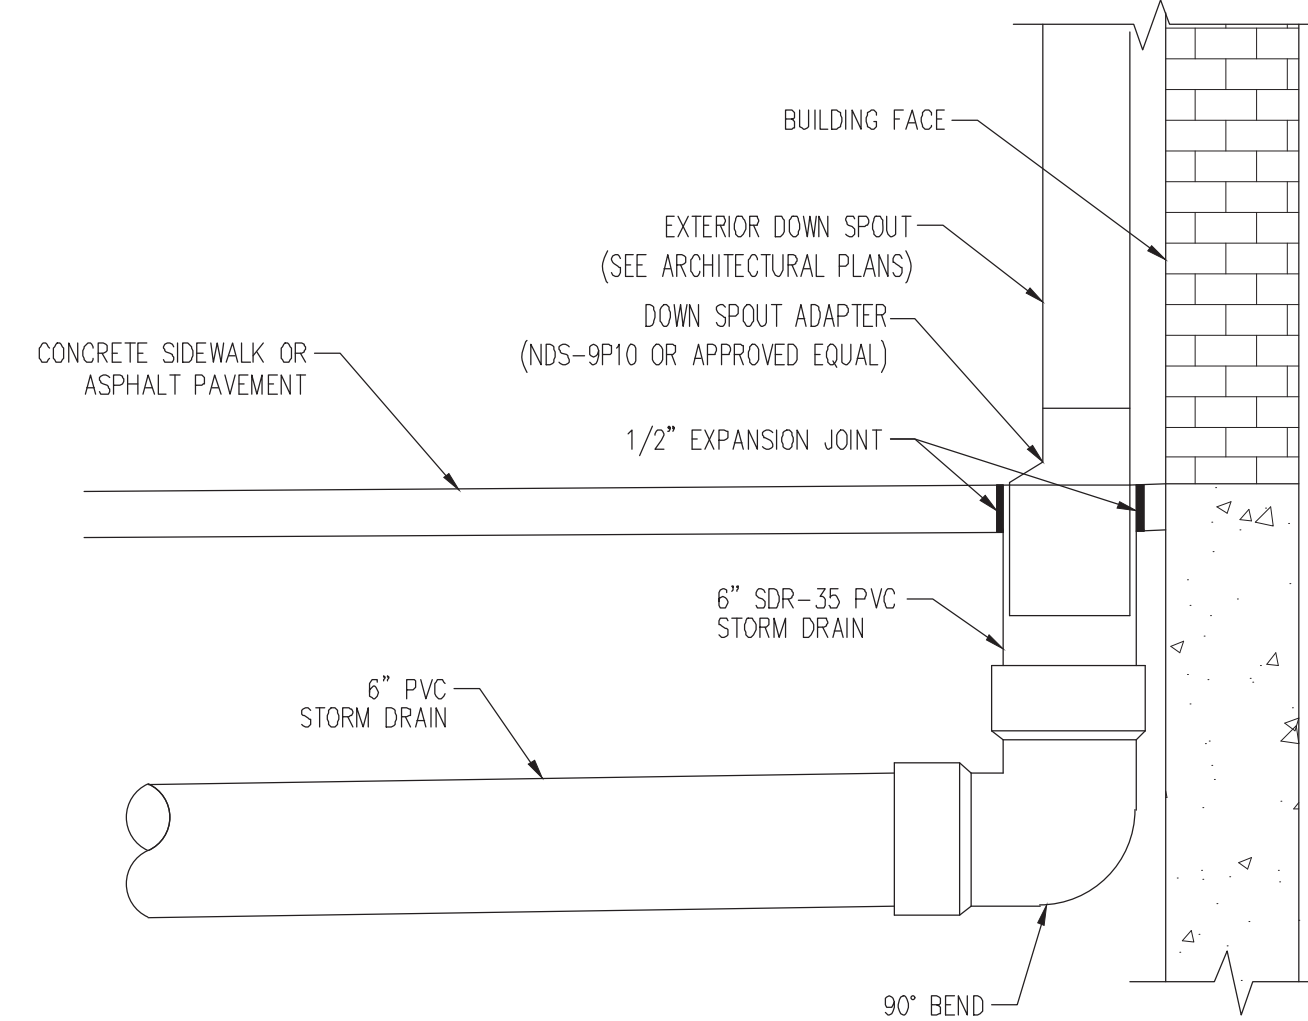

A4 DOWN SPOUT CONNECTION DETAIL
N.T.S.

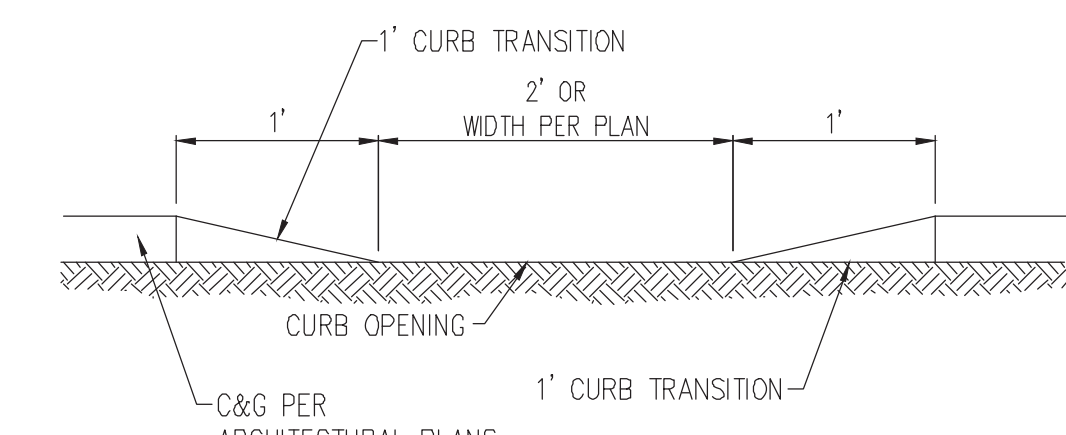

A3 TYPICAL CURB OPENING
N.T.S.

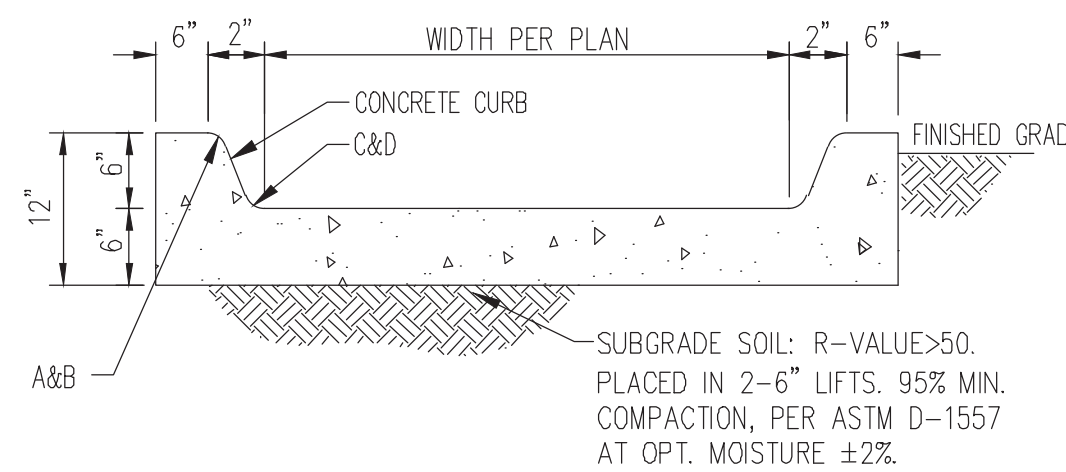

A2 CONCRETE RUNDOWN
N.T.S.

SHEET KEYNOTES*

1. INSTALL HDPE (N12 WT. OR APPROVED EQUAL) STORM DRAIN PIPE, SIZE PER PLANS.
2. INSTALL PRE-FABRICATED STORM DRAIN FITTING, SEE PLANS FOR SIZE.
3. INSTALL 24" SIDEWALK CULVERT PER COA STD DWG 2236. MODIFIED TO PROVIDE ALUMINUM DIAMOND PLATE WITH 1" x 1" ALUMINUM ANGLE.
4. INSTALL CURB OPENING PER DETAIL A3, SHEET C-101.
5. INSTALL CONCRETE RUNDOWN PER DETAIL A2, SHEET C-101.
6. MATCH EXISTING ELEVATION.
7. SEE LANDSCAPE PLAN FOR SWALE DETAILS.
8. INSTALL HDPE TRENCH DRAIN. CONTRACTOR TO SUBMIT SHOP DRAWING TO ENGINEER FOR REVIEW.
9. CONNECT TO TRENCH DRAIN CATCH BASIN; PROVIDE FITTINGS AS NECESSARY.
10. RETAINING WALL; SEE ARCHITECTURAL PLAN FOR DETAILS.
11. SITE RETAINING WALL; SEE CIVIL STRUCTURAL SHEET C-400 FOR DETAILS.
12. CONNECT TO ROOF DRAIN DOWN SPOUT PER DETAIL A4, SHEET C-101.
13. INSTALL 36" NYLOPLAST INLET BASIN (OR APPROVED EQUAL) WITH SOLID GRATE COVER.
14. REMOVE EXISTING SINGLE SIDEWALK CULVERT. INSTALL 2-24" SIDEWALK CULVERT PER COA STD DWG 2236. MODIFIED TO PROVIDE ALUMINUM DIAMOND PLATE WITH 1" x 1" ALUMINUM ANGLE.
15. CLEAN EXISTING TRENCH DRAIN CLEAR OF DEBRIS AND ENSURE PROPER FUNCTION.
16. INSTALL 4' WIDE VALLEY GUTTER PER DETAIL A5, SHEET C-101.
17. SAWCUT, REMOVE & REPLACE EXISTING ASPHALT, CURBS, LANDSCAPE MATERIALS, & IRRIGATION EQUIPMENT; REPLACE IN KIND. CONTRACTOR TO UTILIZE TRENCH BOX FOR THIS INSTALLATION.
18. CONNECT TO ROOF DRAIN WITHIN 5' OF BUILDING. SEE PLUMBING PLAN FOR CONTINUATION.
19. CONTRACTOR SHALL GRADE STAGING AREA TO TOP OF SUBGRADE (2.5' BELOW FINISHED GRADES SHOWN). COORDINATE WITH LANDSCAPE ARCHITECT AND APS ON-CALL LANDSCAPE CONTRACTOR FOR EXTENTS OF GRADING.

* - NOT ALL KEYNOTED USED ON THIS SHEET

NOTE

HDPE PIPE AND FITTINGS SHALL BE INSTALLED AND BACKFILLED PER MANUFACTURER SPECIFICATIONS. CONNECTIONS TO CONCRETE MANHOLES AND CONCRETE DROP INLETS SHALL USE WATER STOP GASKETS AND SHALL BE INSTALLED PER MANUFACTURER'S SPECIFICATIONS.

NOTE

ENDS OF ALL STORM DRAIN PIPES, CULVERTS, & CMP END SECTIONS (LARGER THAN 12") SHALL BE COVERED WITH STEEL BARS (TO KEEP CHILDREN OUT) APPROXIMATELY 12" SQUARE. CONTRACTOR TO SUBMIT SHOP DRAWINGS FOR REVIEW AND APPROVAL. HYDRAULIC INTEGRITY SHALL NOT BE COMPROMISED. BARS TO BE PAINTED TO MATCH BUILDING.

NOTE

SIDEWALK CROSS-SLOPES SHALL BE AT A MINIMUM OF 1.0% AND A MAXIMUM OF 2.0%.

LEGEND

- | | |
|-----|--|
| --- | PROPERTY LINE |
| --- | LIMITS OF GRADING |
| --- | EXISTING INDEX CONTOUR |
| --- | EXISTING INTERMEDIATE CONTOUR |
| --- | EXISTING GROUND SPOT ELEVATION |
| --- | PROPOSED INDEX CONTOUR |
| --- | PROPOSED INTERMEDIATE CONTOUR |
| --- | PROPOSED FINISHED GRADE SPOT ELEVATION |
| --- | PROPOSED CURB & GUTTER |
| --- | PROPOSED RETAINING WALL |
| --- | DIRECTION OF FLOW |
| --- | WATER BLOCK/GRADE BREAK |
| --- | PROPOSED STORM DRAIN LINE |
| --- | PROPOSED STORM DRAIN MANHOLE |
| --- | PROPOSED STORM DRAIN INLETS |

100% CONSTRUCTION DOCUMENTS

NO	DATE	DESCRIPTION
DATE:	2016-06-23	
PROJECT #:	140001	
DRAWN BY:	BHW	
CHD BY:	JLM	
Copyright:	SMPC Architects © 2014	
These documents were prepared for this specific project only. SMPC Architects' liability is limited to this specific project, and does not extend to reuse of these documents for other projects.		

SHEET KEYNOTES*

1. INSTALL HDPE (N12 WT. OR APPROVED EQUAL) STORM DRAIN PIPE, SIZE PER PLANS.
2. INSTALL PRE-FABRICATED STORM DRAIN FITTING, SEE PLANS FOR SIZE.
3. INSTALL 24" SIDEWALK CULVERT PER COA STD DWG 2236. MODIFIED TO PROVIDE ALUMINUM DIAMOND PLATE WITH 1" x 1" ALUMINUM ANGLE.
4. INSTALL CURB OPENING PER DETAIL A3, SHEET C-101.
5. INSTALL CONCRETE RUNDOWN PER DETAIL A2, SHEET C-101.
6. MATCH EXISTING ELEVATION.
7. SEE LANDSCAPE PLAN FOR SWALE DETAILS.
8. INSTALL HDPE TRENCH DRAIN. CONTRACTOR TO SUBMIT SHOP DRAWING TO ENGINEER FOR REVIEW.
9. CONNECT TO TRENCH DRAIN CATCH BASIN; PROVIDE FITTINGS AS NECESSARY.
10. RETAINING WALL; SEE ARCHITECTURAL PLAN FOR DETAILS.
11. SITE RETAINING WALL; SEE CIVIL STRUCTURAL SHEET C-400 FOR DETAILS.
12. CONNECT TO ROOF DRAIN DOWN SPOUT PER DETAIL A4, SHEET C-101.
13. INSTALL 36" NYLOPLAST INLET BASIN (OR APPROVED EQUAL) WITH SOLID GRATE COVER.
14. REMOVE EXISTING SINGLE SIDEWALK CULVERT. INSTALL 2-24" SIDEWALK CULVERT PER COA STD DWG 2236. MODIFIED TO PROVIDE ALUMINUM DIAMOND PLATE WITH 1" x 1" ALUMINUM ANGLE.
15. CLEAN EXISTING TRENCH DRAIN CLEAR OF DEBRIS AND ENSURE PROPER FUNCTION.
16. INSTALL 4' WIDE VALLEY GUTTER PER DETAIL A5, SHEET C-101.
17. SAWCUT, REMOVE & REPLACE EXISTING ASPHALT, CURBS, LANDSCAPE MATERIALS, & IRRIGATION EQUIPMENT; REPLACE IN KIND. CONTRACTOR TO UTILIZE TRENCH BOX FOR THIS INSTALLATION.
18. CONNECT TO ROOF DRAIN WITHIN 5' OF BUILDING. SEE PLUMBING PLAN FOR CONTINUATION.
19. CONTRACTOR SHALL GRADE STAGING AREA TO TOP OF SUBGRADE (2.5' BELOW FINISHED GRADES SHOWN). COORDINATE WITH LANDSCAPE ARCHITECT AND APS ON-CALL LANDSCAPE CONTRACTOR FOR EXTENTS OF GRADING.

* - NOT ALL KEYNOTED USED ON THIS SHEET


NOTE
HDPE PIPE AND FITTINGS SHALL BE INSTALLED AND BACKFILLED PER MANUFACTURER SPECIFICATIONS. CONNECTIONS TO CONCRETE MANHOLES AND CONCRETE DROP INLETS SHALL USE WATER STOP GASKETS AND SHALL BE INSTALLED PER MANUFACTURER'S SPECIFICATIONS

NOTE
ENDS OF ALL STORM DRAIN PIPES, CULVERTS, & CMP END SECTIONS (LARGER THAN 12") SHALL BE COVERED WITH STEEL BARS (TO KEEP CHILDREN OUT) APPROXIMATELY 12" SQUARE. CONTRACTOR TO SUBMIT SHOP DRAWINGS FOR REVIEW AND APPROVAL. HYDRAULIC INTEGRITY SHALL NOT BE COMPROMISED. BARS TO BE PAINTED TO MATCH BUILDING.


NOTE
SIDEWALK CROSS-SLOPES SHALL BE AT A MINIMUM OF 1.0% AND A MAXIMUM OF 2.0%

LEGEND

- | | |
|-----|--|
| --- | PROPERTY LINE |
| --- | LIMITS OF GRADING |
| --- | EXISTING INDEX CONTOUR |
| --- | EXISTING INTERMEDIATE CONTOUR |
| --- | EXISTING GROUND SPOT ELEVATION |
| --- | PROPOSED INDEX CONTOUR |
| --- | PROPOSED INTERMEDIATE CONTOUR |
| --- | PROPOSED FINISHED GRADE SPOT ELEVATION |
| --- | TC=TOP OF CURB, FL=FLOW LINE, TS=TOP OF SIDEWALK |
| --- | TC=TOP OF GRATE, FGH=FINISH GROUND HIGH, FGL=FINISH GROUND LOW |
| --- | PROPOSED CURB & GUTTER |
| --- | PROPOSED RETAINING WALL |
| --- | DIRECTION OF FLOW |
| --- | WATER BLOCK/GRADE BREAK |
| --- | PROPOSED STORM DRAIN LINE |
| --- | PROPOSED STORM DRAIN MANHOLE |
| --- | PROPOSED STORM DRAIN INLETS |

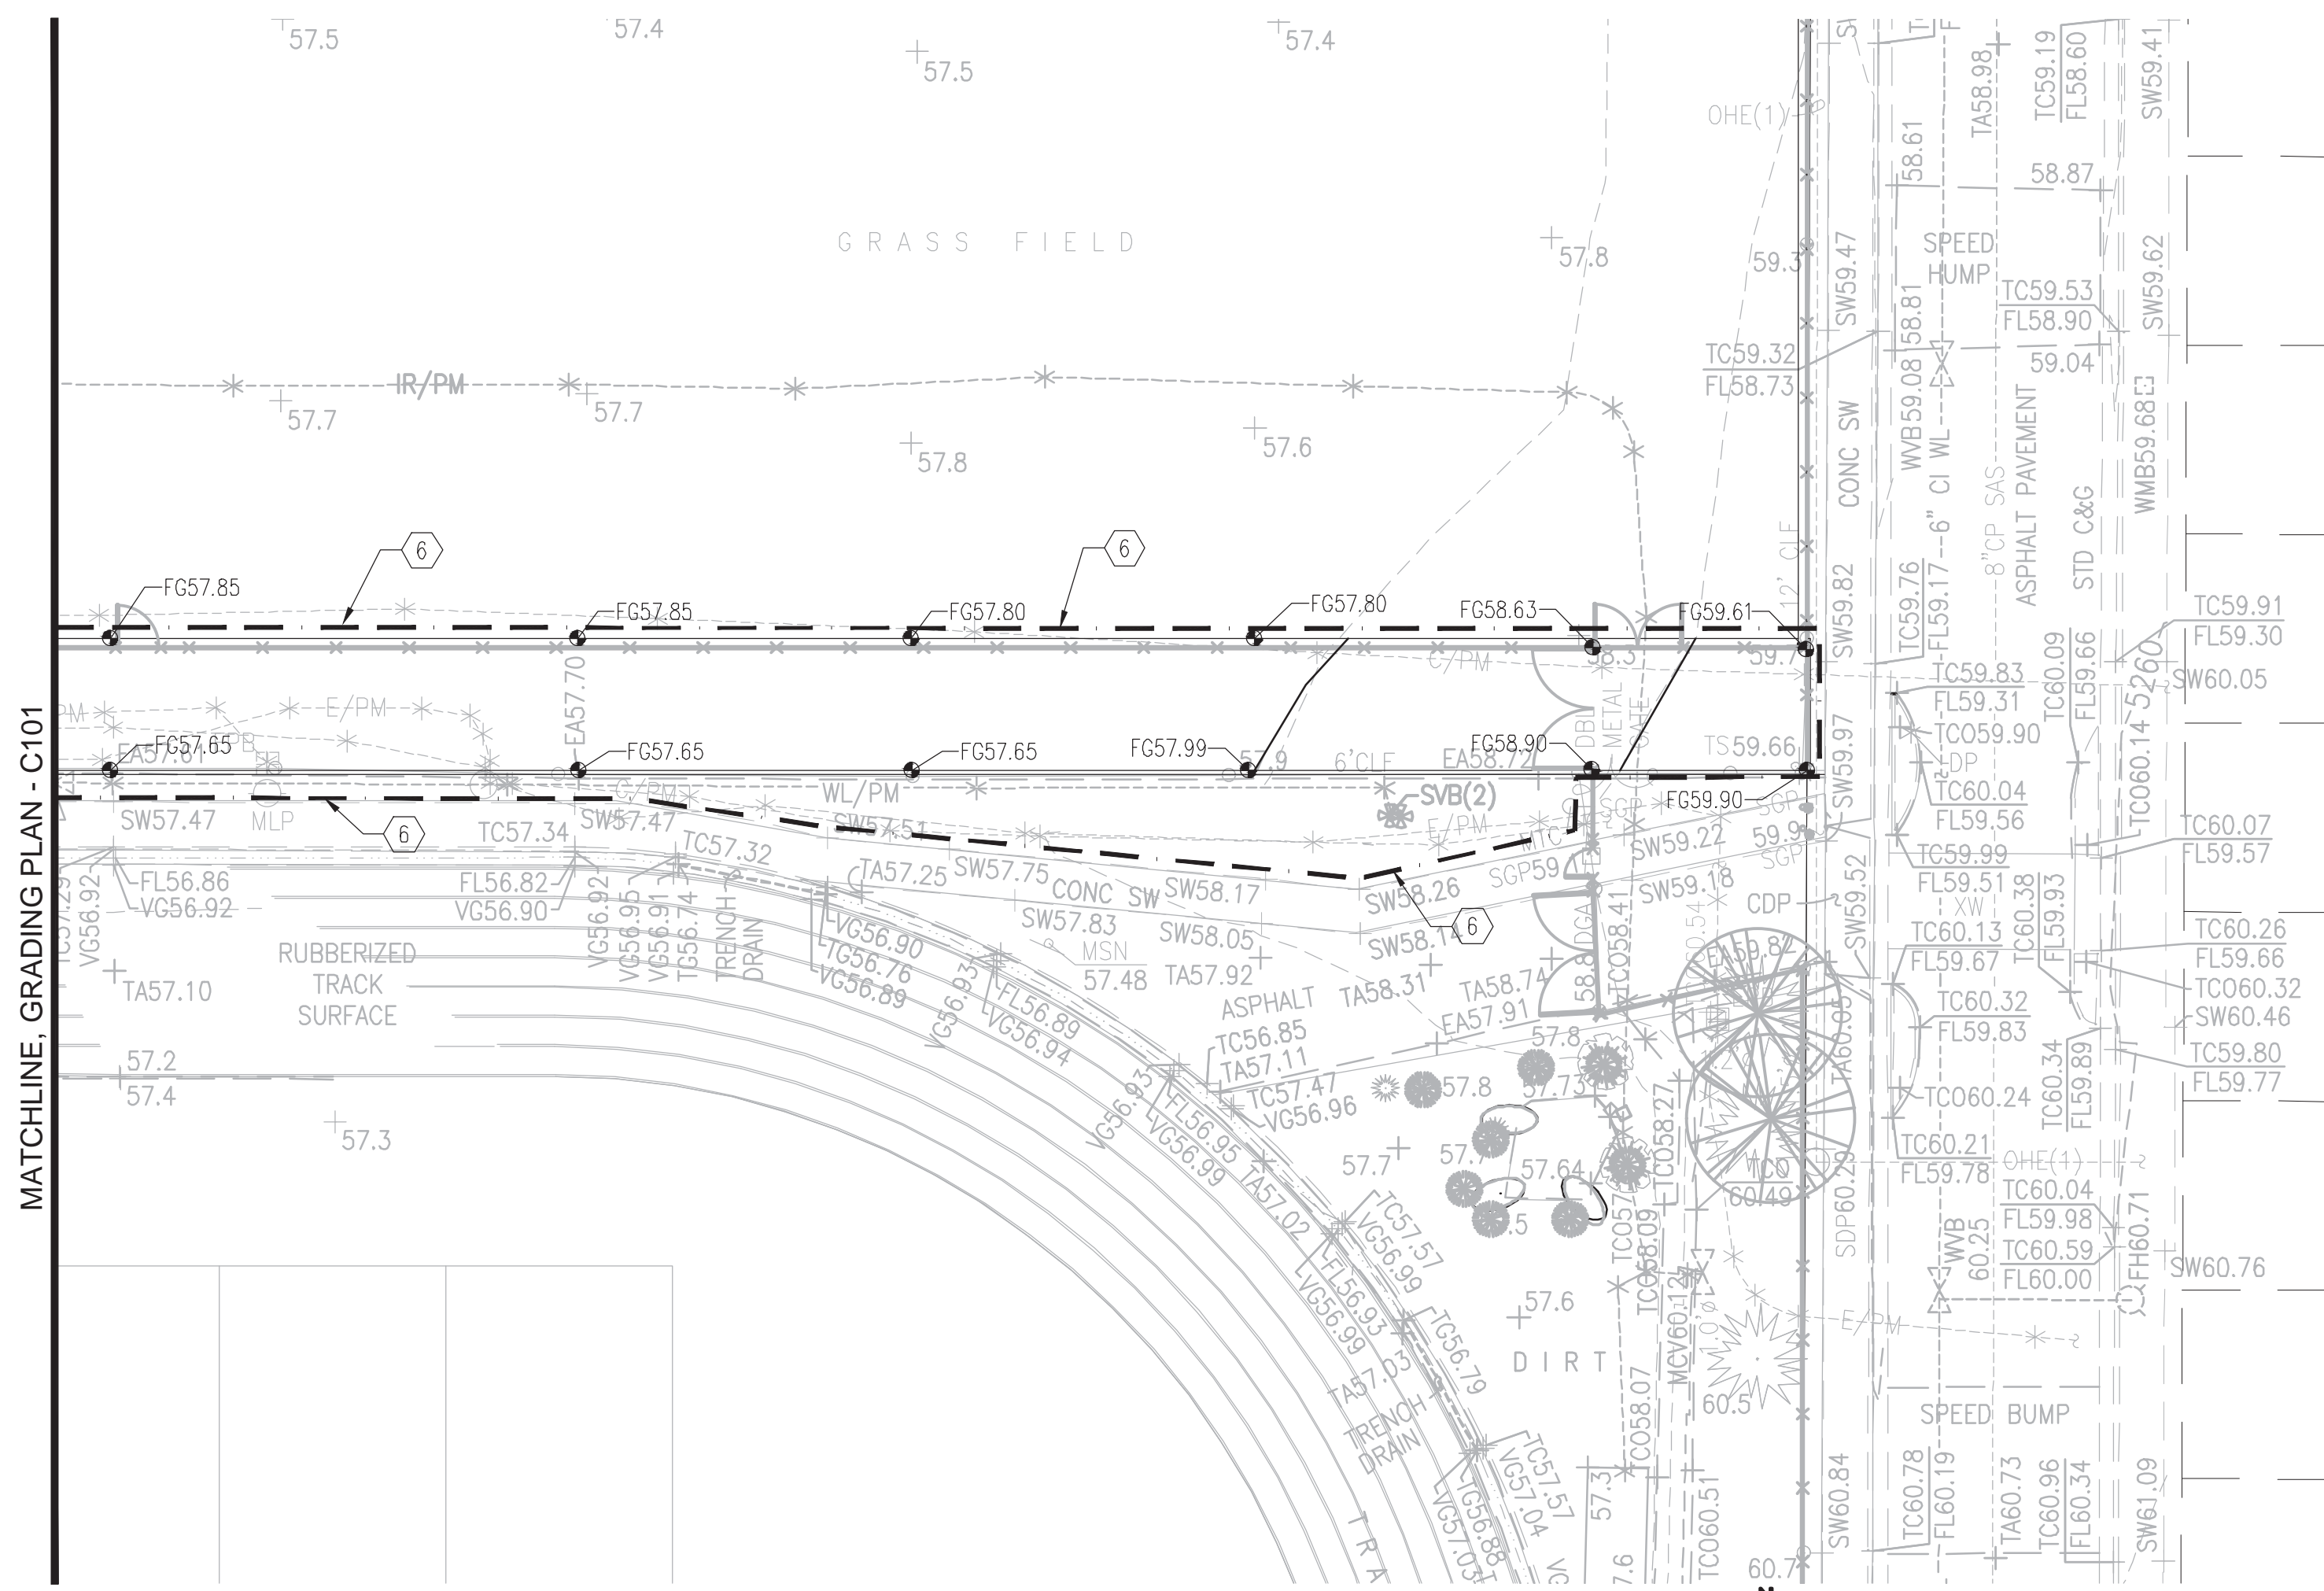


A1 GRADING PLAN
SCALE: 1" = 20'

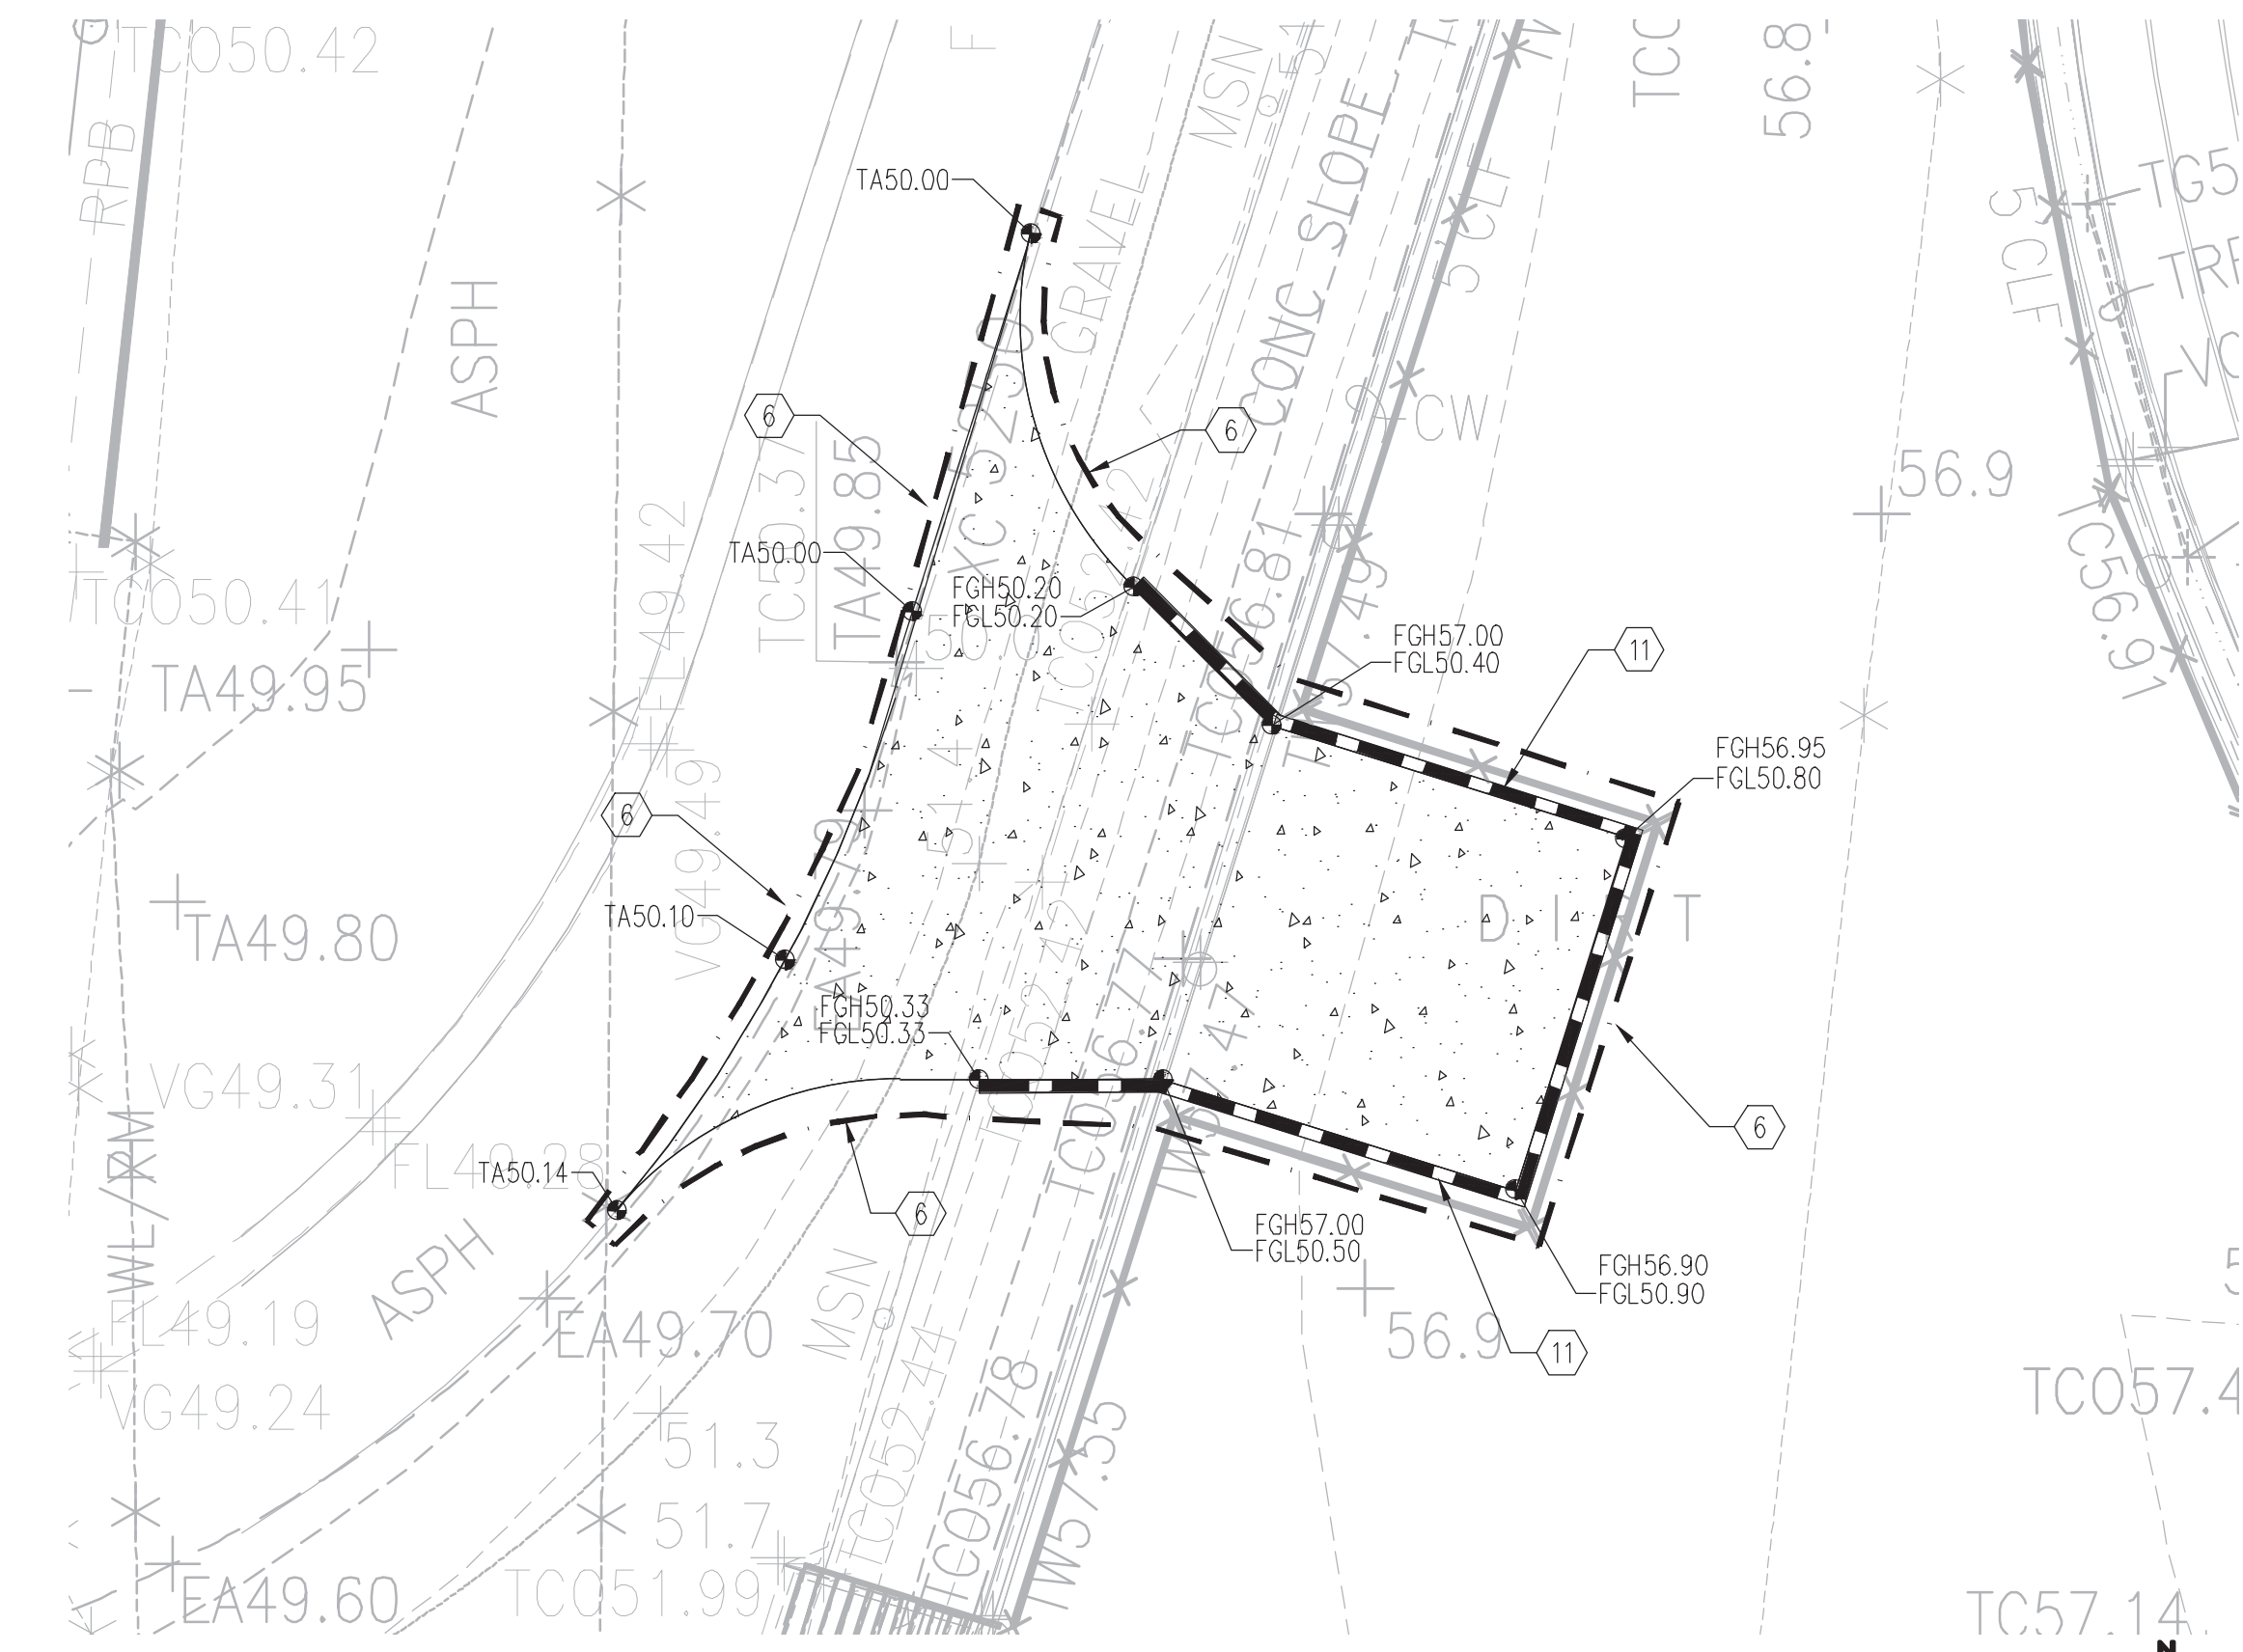


A2 GRADING PLAN - TURNAROUND AREA
SCALE: 1" = 10'

PAVING LEGEND

CONCRETE PAVEMENT SECTION
SEE DETAIL (RIGHT)

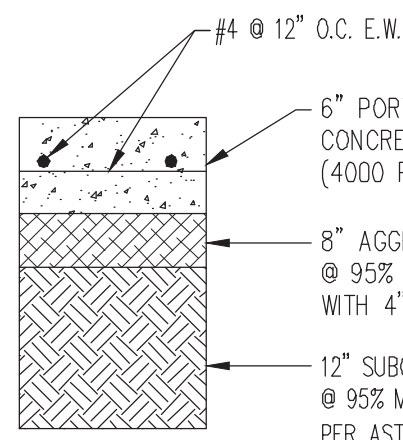

CONCRETE PAVEMENT SECTION
NOT TO SCALE

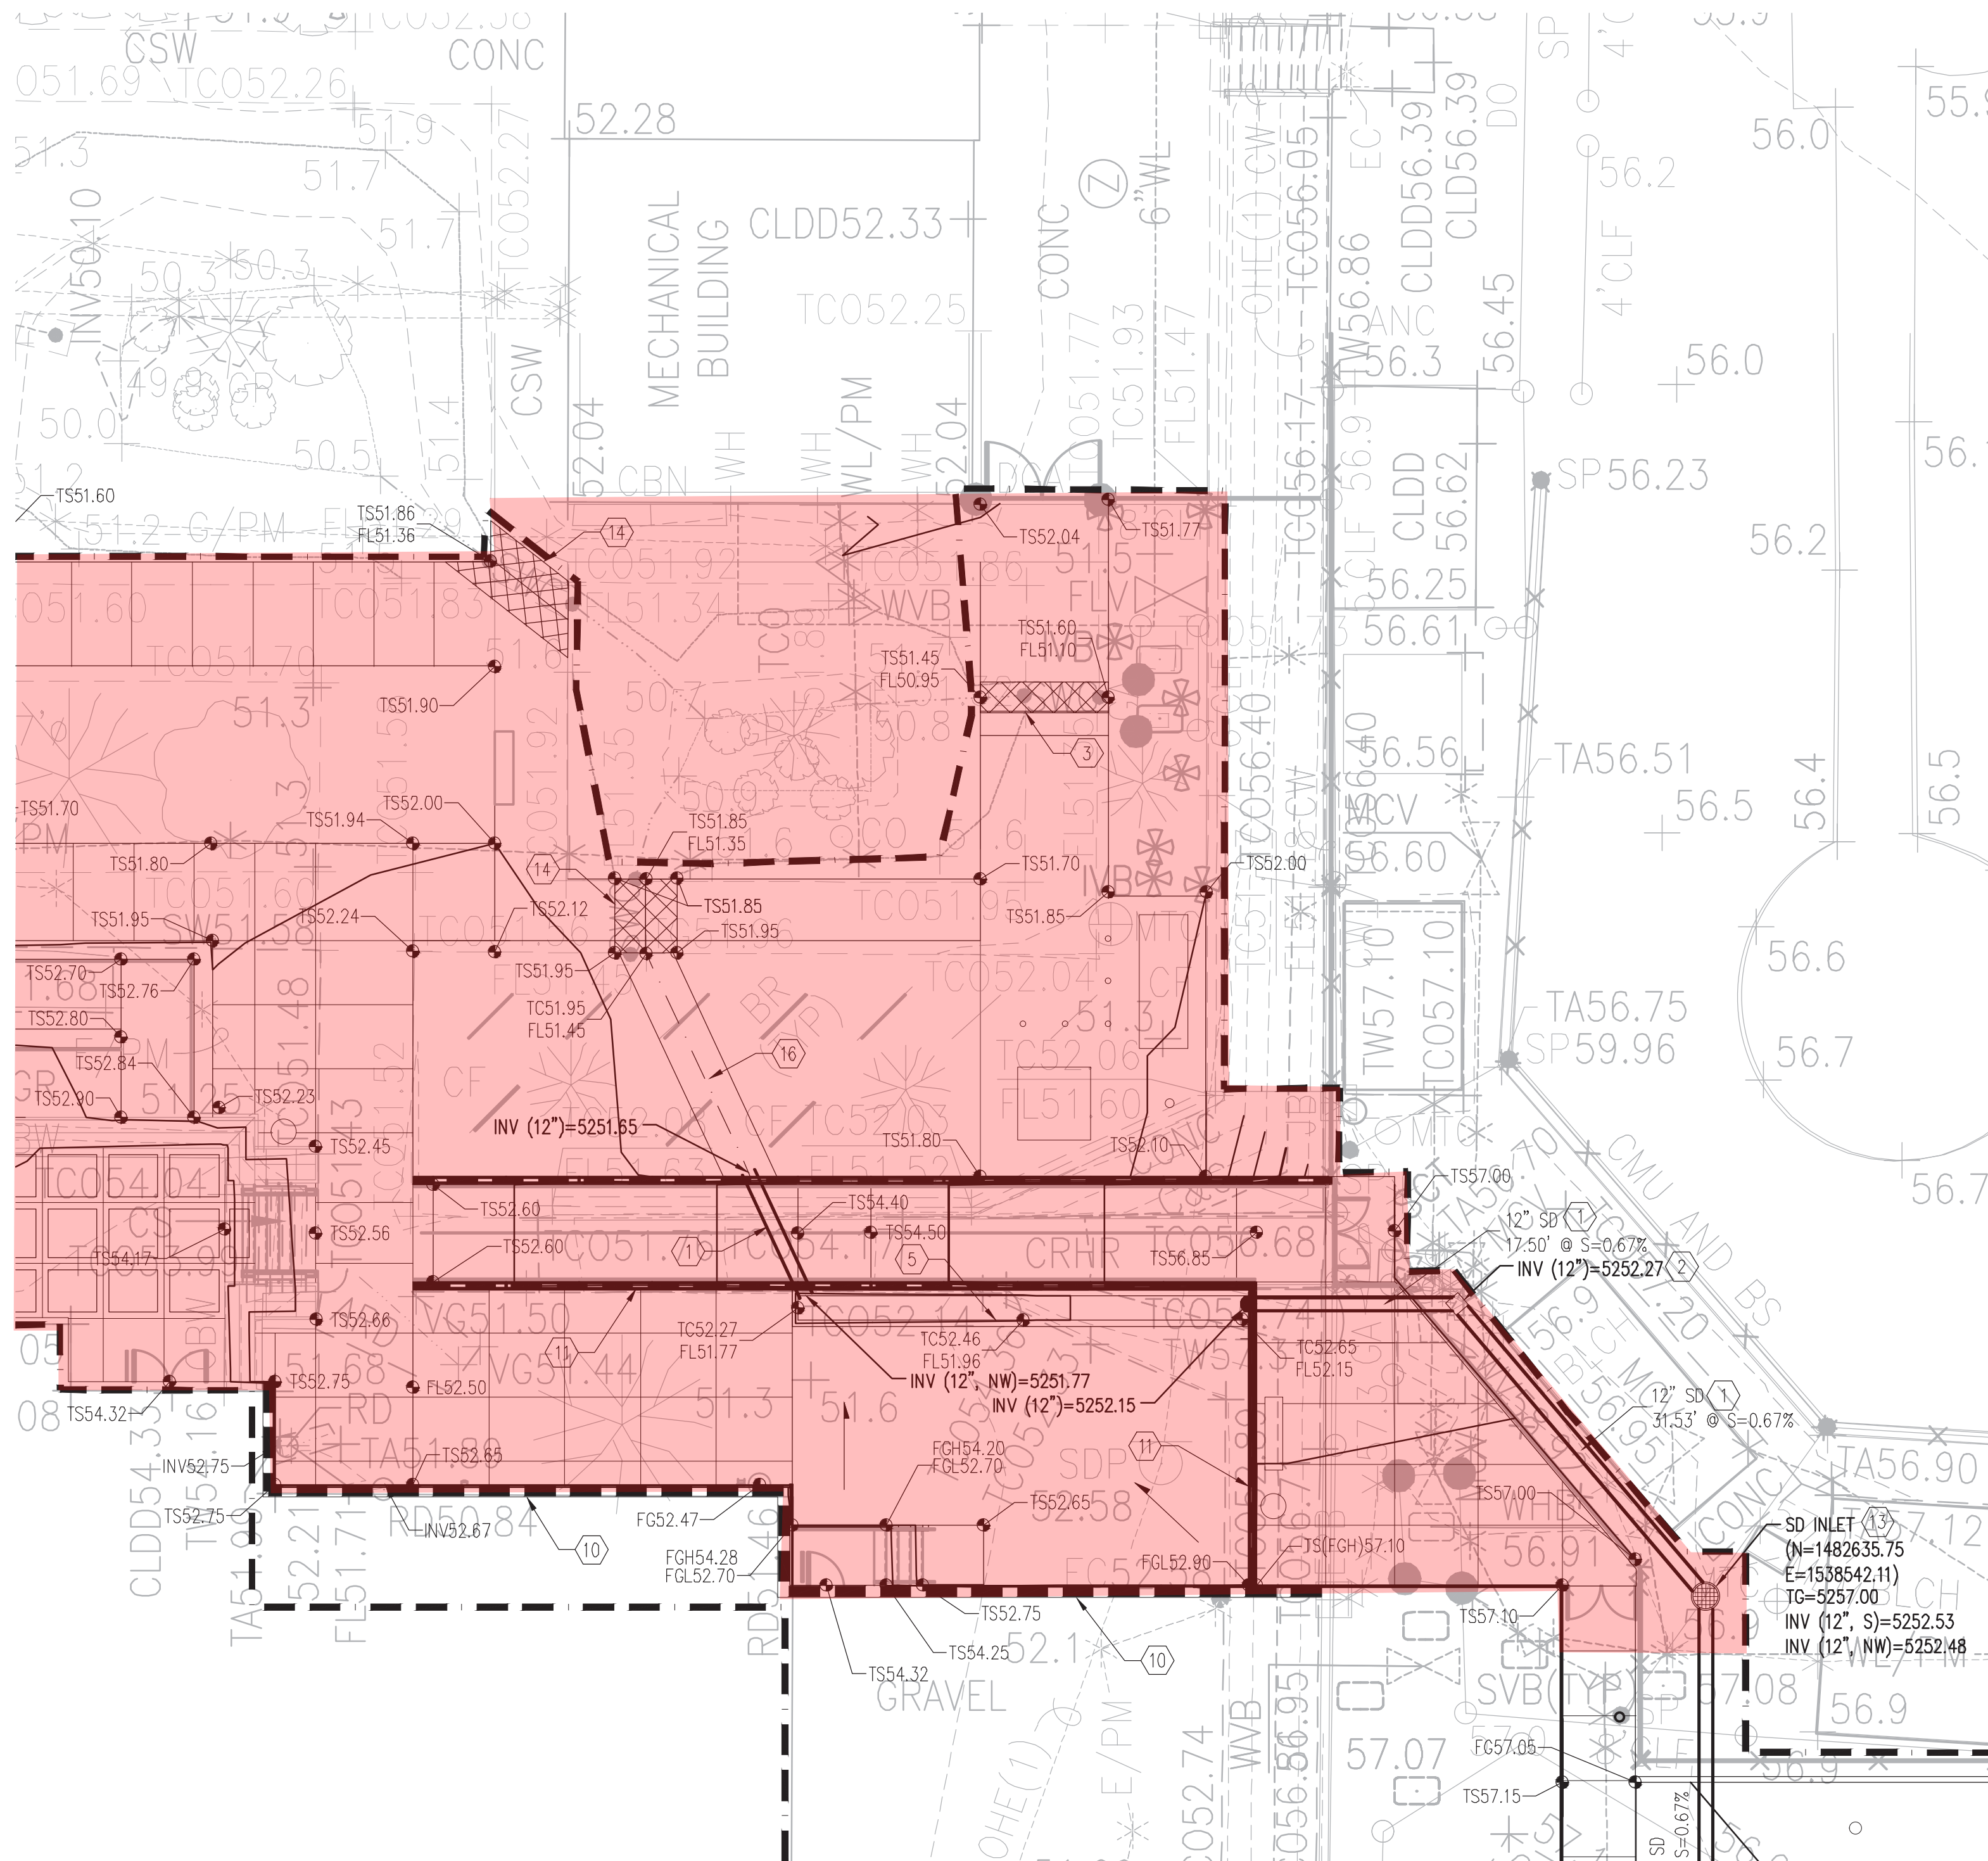

A3 ENLARGED GRADING PLAN
SCALE: 1" = 10'



City of Albuquerque

Planning Department

Development & Building Services Division

DRAINAGE AND TRANSPORTATION INFORMATION SHEET (REV 6/2018)

Project Title: _____ Building Permit #: _____ Hydrology File #: _____

DRB#: _____ EPC#: _____ Work Order#: _____

Legal Description: _____

City Address: _____

Applicant: _____ Contact: _____

Address: _____

Phone#: _____ Fax#: _____ E-mail: _____

Other Contact: _____ Contact: _____

Address: _____

Phone#: _____ Fax#: _____ E-mail: _____

TYPE OF DEVELOPMENT: _____ PLAT _____ RESIDENCE _____ DRB SITE _____ ADMIN SITE

Check all that Apply:

DEPARTMENT:

_____ HYDROLOGY/ DRAINAGE
_____ TRAFFIC/ TRANSPORTATION

TYPE OF APPROVAL/ACCEPTANCE SOUGHT:

_____ BUILDING PERMIT APPROVAL
_____ CERTIFICATE OF OCCUPANCY

TYPE OF SUBMITTAL:

_____ ENGINEER/ARCHITECT CERTIFICATION
_____ PAD CERTIFICATION
_____ CONCEPTUAL G & D PLAN
_____ GRADING PLAN
_____ DRAINAGE REPORT
_____ DRAINAGE MASTER PLAN
_____ FLOODPLAIN DEVELOPMENT PERMIT APPLIC
_____ ELEVATION CERTIFICATE
_____ CLOMR/LOMR
_____ TRAFFIC CIRCULATION LAYOUT (TCL)
_____ TRAFFIC IMPACT STUDY (TIS)
_____ STREET LIGHT LAYOUT
_____ OTHER (SPECIFY) _____
_____ PRE-DESIGN MEETING?

_____ PRELIMINARY PLAT APPROVAL
_____ SITE PLAN FOR SUB'D APPROVAL
_____ SITE PLAN FOR BLDG. PERMIT APPROVAL
_____ FINAL PLAT APPROVAL

_____ SIA/ RELEASE OF FINANCIAL GUARANTEE
_____ FOUNDATION PERMIT APPROVAL
_____ GRADING PERMIT APPROVAL
_____ SO-19 APPROVAL
_____ PAVING PERMIT APPROVAL
_____ GRADING/ PAD CERTIFICATION
_____ WORK ORDER APPROVAL
_____ CLOMR/LOMR
_____ FLOODPLAIN DEVELOPMENT PERMIT
_____ OTHER (SPECIFY) _____

IS THIS A RESUBMITTAL?: _____ Yes _____ No

DATE SUBMITTED: _____ By: _____

COA STAFF:

ELECTRONIC SUBMITTAL RECEIVED: _____

FEE PAID: _____