



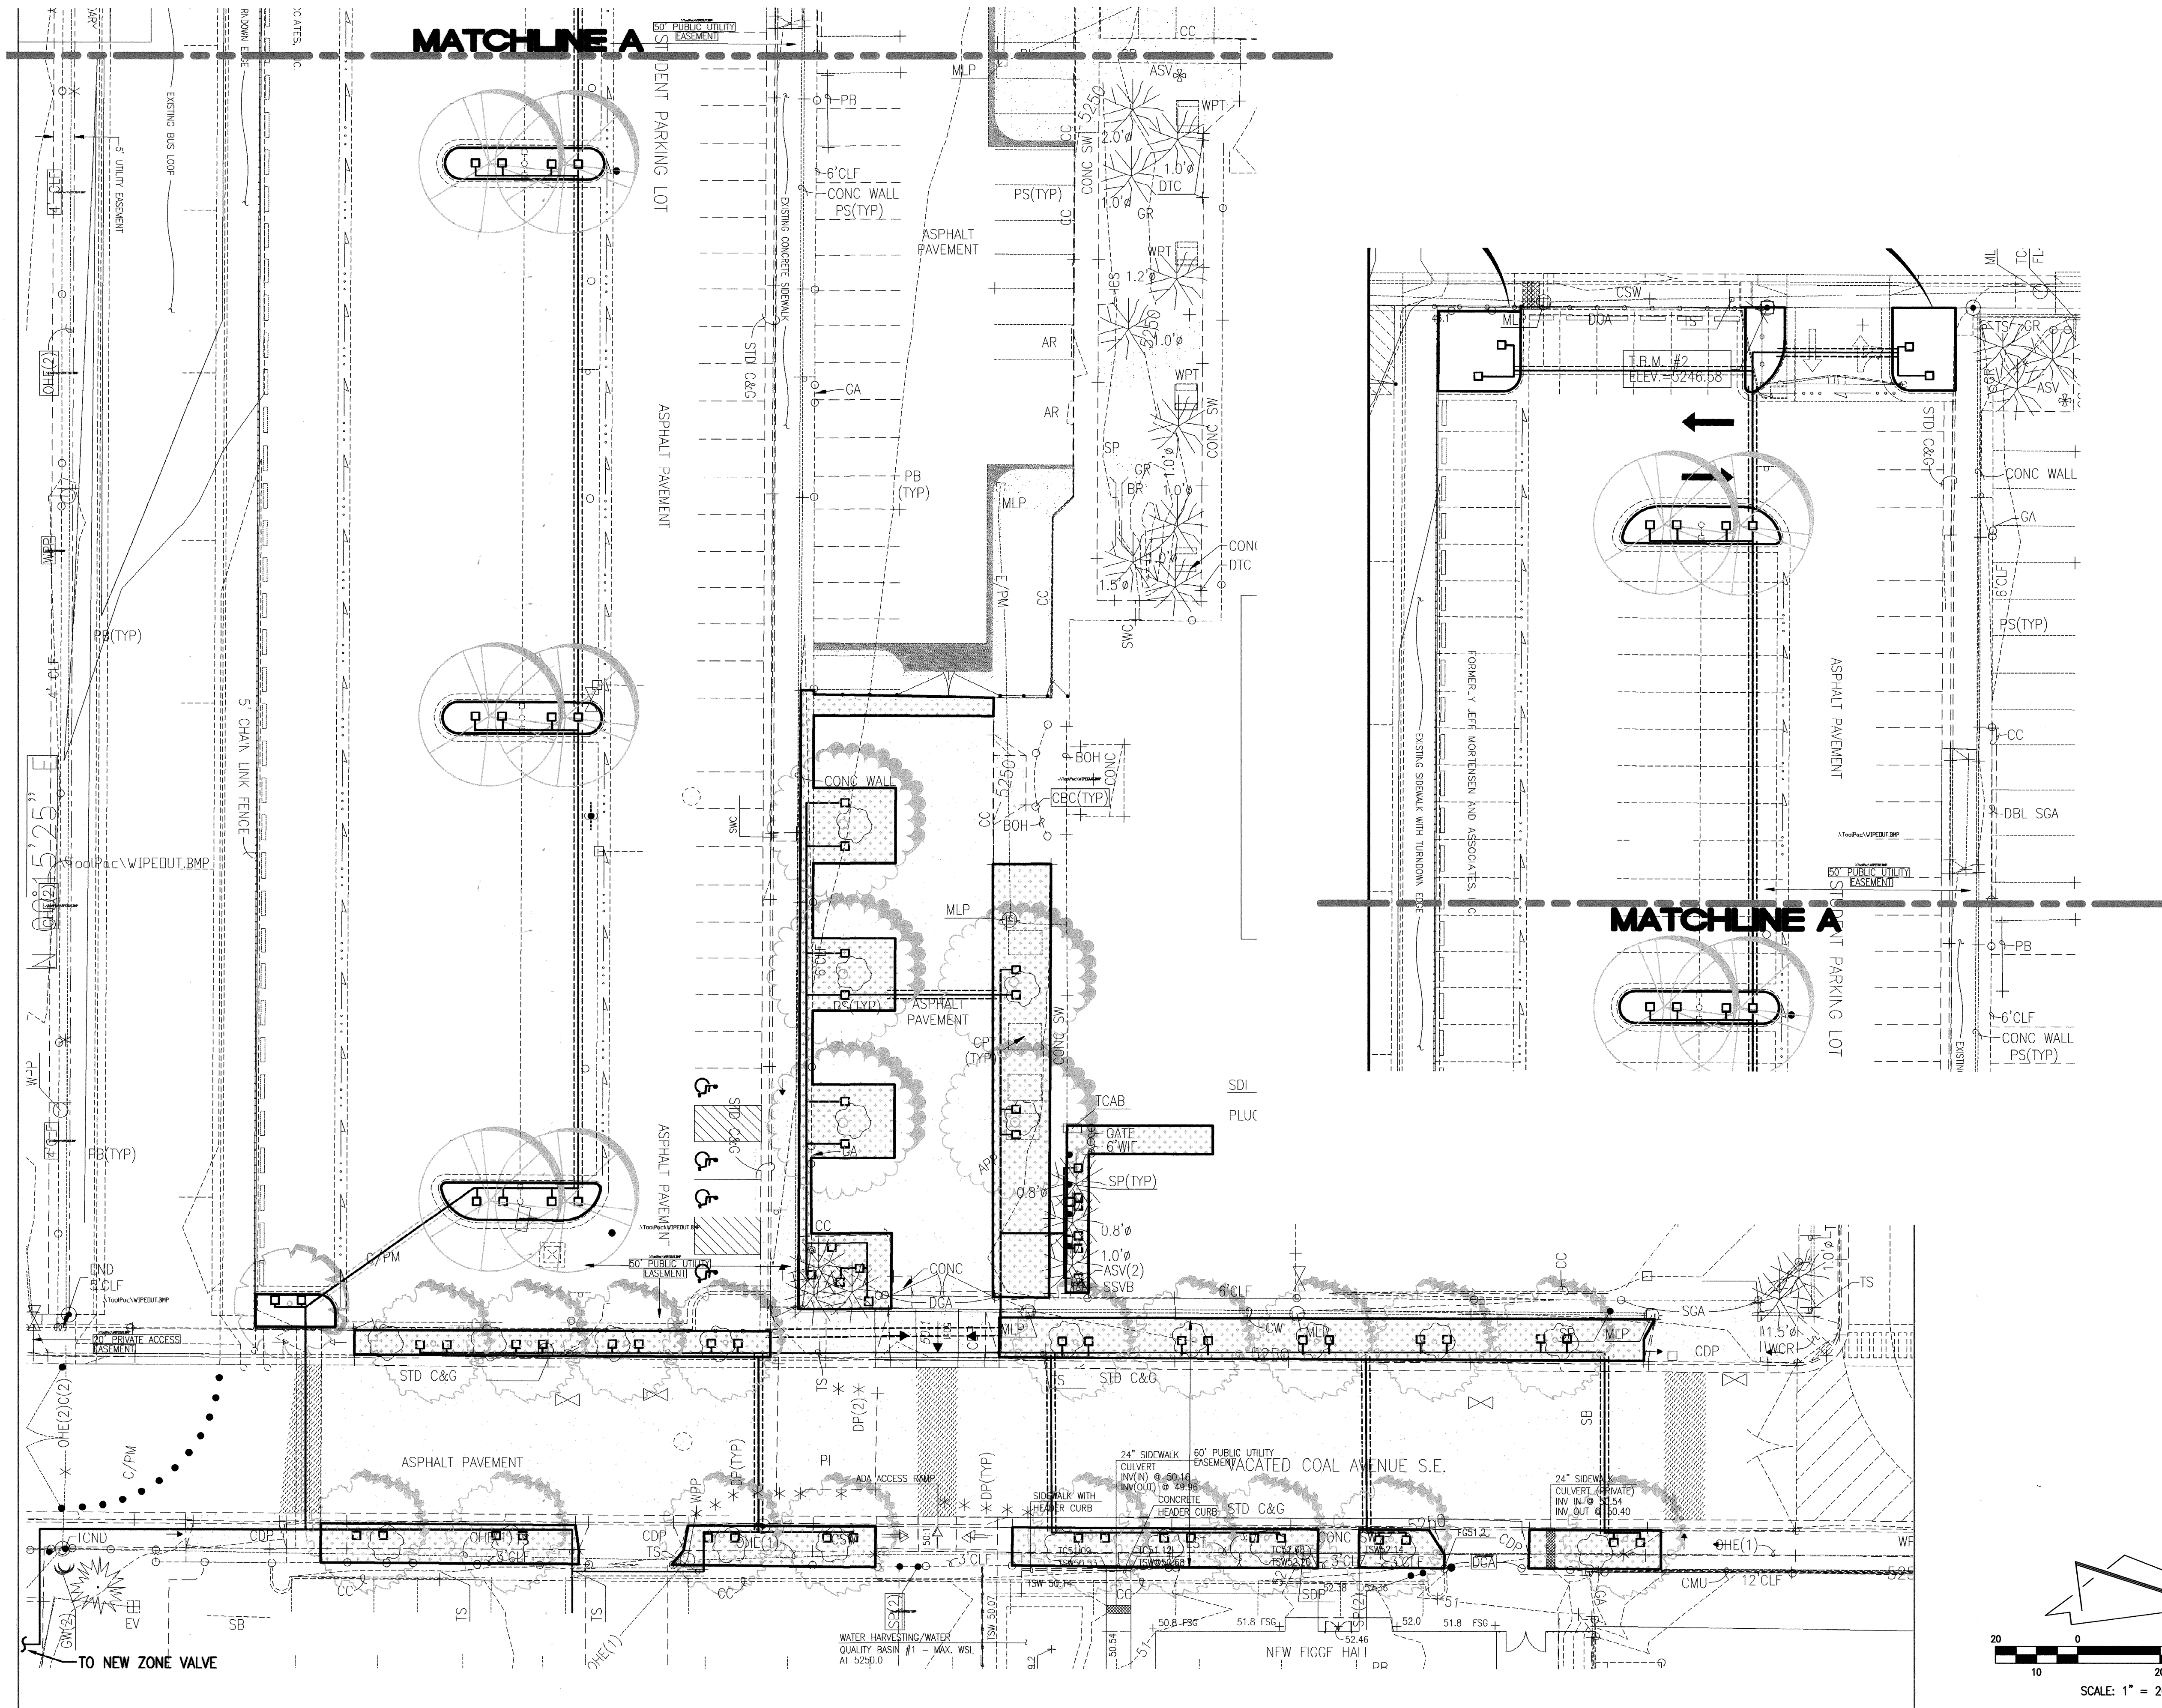

IRRIGATION LEGEND	
SYMBOL	DESCRIPTION
	SCHEDULE 40 PVC LATERAL PIPE
	EXISTING CLASS 200 PVC PIPE SLEEVE
	NEW CLASS 200 PVC PIPE SLEEVE
	RAINBIRD 1400 SERIES BUBBLER (.50 GPM)

IRRIGATION RECORD DRAWING
WESTWIND LANDSCAPE CONSTRUCTION
2739 VASSAR PLACE, N.E.
ALBUQUERQUE, NM 87109
(505) 881-8925
DATE OF INSTALLATION
JANUARY 2012

RECORD DRAWING

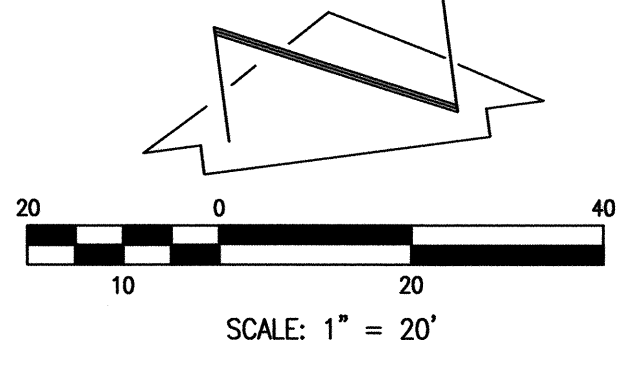

WESTWIND LANDSCAPE CONSTRUCTION INC.
2739 VASSAR PLACE, NE
ALBUQUERQUE, NM 87107
PHONE: 505-881-8925
FAX: 505-883-7052

**IRRIGATION PLAN - STUDENT LOT
COAL AVENUE PEDESTRIAN MALL
HIGHLAND HIGH SCHOOL**

DESIGNED BY	W.L.C.I.	NO.	DATE	BY	REVISIONS	JOB NO.
DRAWN BY	W.L.C.I.	1/12	B.E.E.	RECORD DRAWING		2010.180.5
APPROVED BY	W.L.C.I.					DATE 01-2012
						SHEET 1 OF 2

HIGH MESA Consulting Group

6010-B MIDWAY PARK BLVD. NE • ALBUQUERQUE, NEW MEXICO 87109
PHONE: 505.345.4250 • FAX: 505.345.4254 • www.highmesacg.com

File Path: P:\DATA\2010\180.5\180.5-2\180.5-2.dwg | Plot Date: 01-19-2012
File Name: 101805-IRR-R2.DWG | Plot Time: 4:32 pm