



File Path: P:\JWA\2010\1805\1805-2\1805-2.dwg [Plot Date: 01-19-2012
File Name: 101805-1805-2.dwg [Plot Time: 4:57 pm

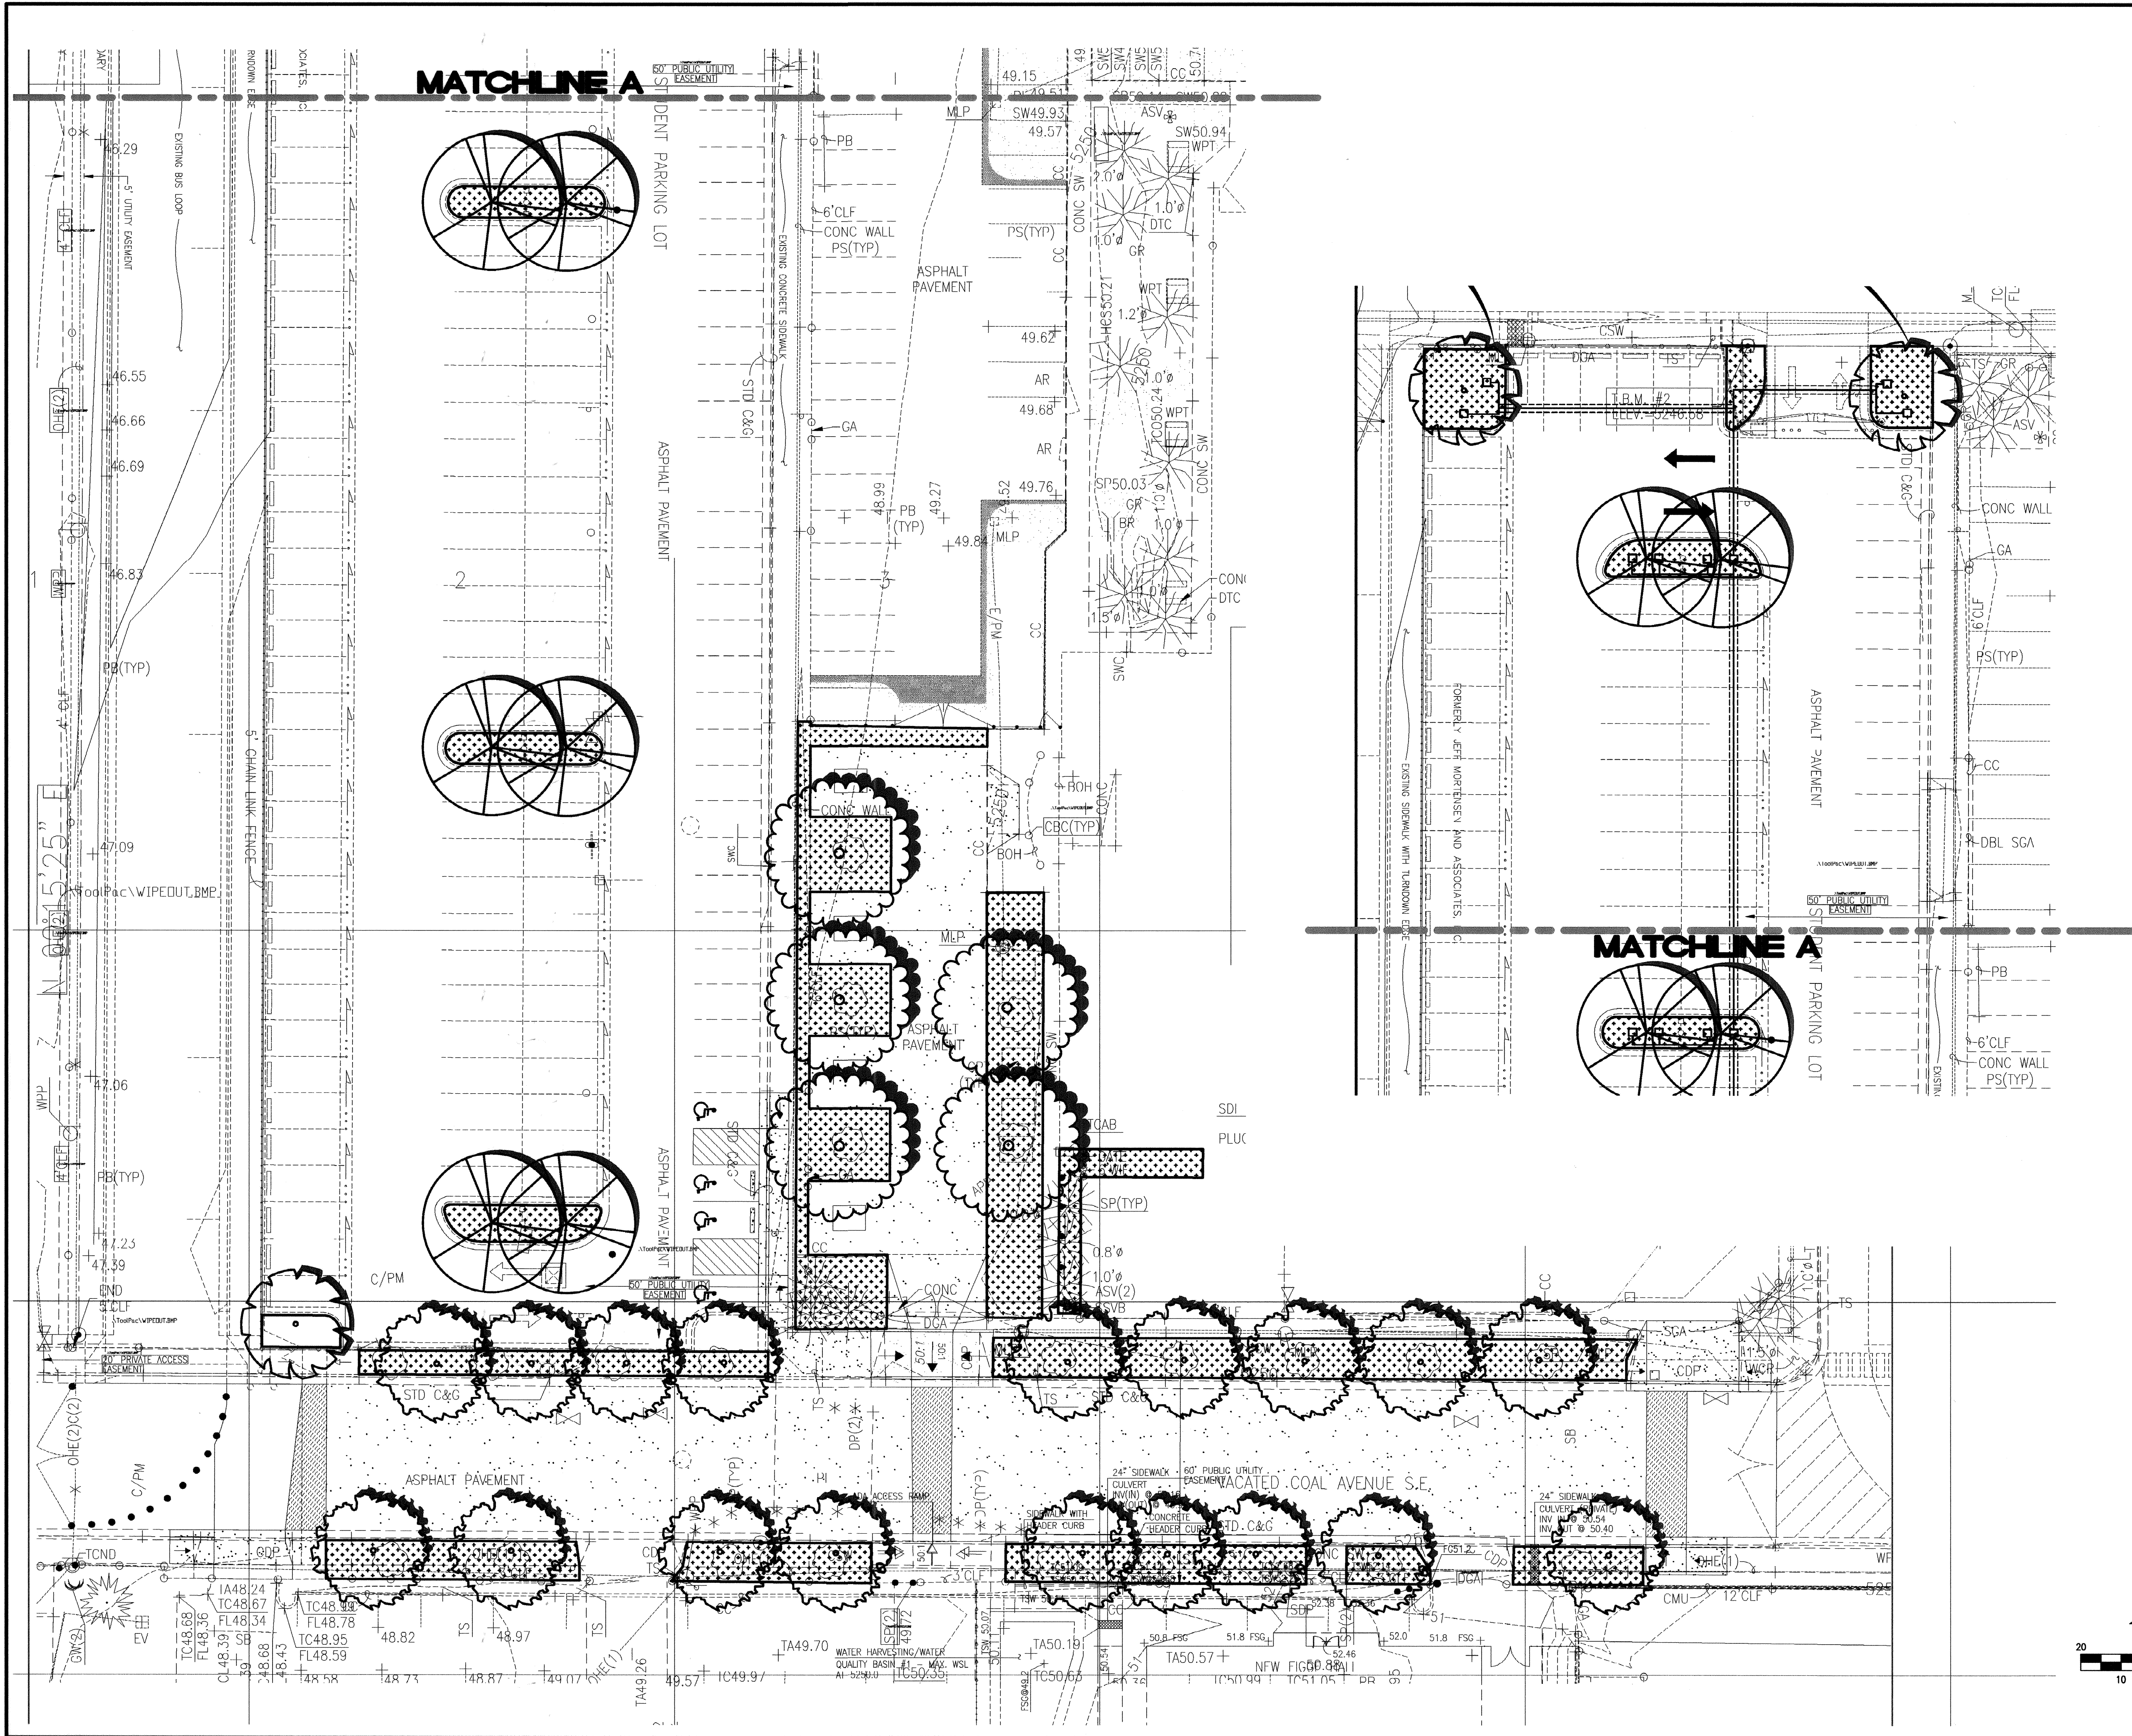

PLANT LIST			
SYMBOL	COMMON NAME BOTANICAL NAME	QTY	SIZE
	AUTUMN PURPLE ASH FRAXINUS AMERICANA	5	2" CAL
	FRAXINUS PENNSYLVANICA URBANITE ASH	8	2" CAL
	IMPERIAL HONEYLOCUST GLEDITSIA TRIACANTHOS	18	2" CAL
	CELTIS OCCIDENTALIS COMMON HACKBERRY	3	2-1/2" CAL

MULCH LEGEND	
	AMARETTO BROWN CRUSHER FINES

RECORD DRAWING

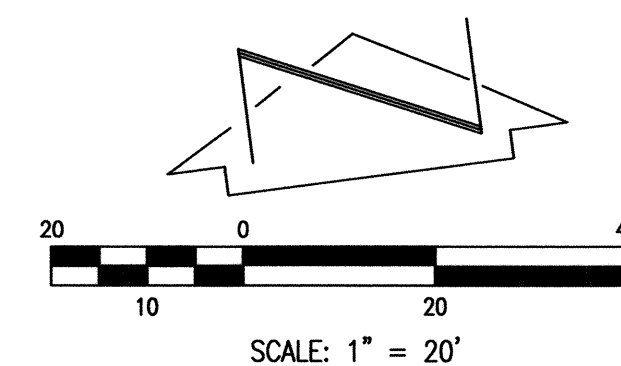

**WESTWIND LANDSCAPE
CONSTRUCTION INC.**
2739 VASSAR PLACE, NE
ALBUQUERQUE, NM 87107
PHONE: 505-881-8925
FAX: 505-883-7052

HIGH MESA Consulting Group

6010-B MIDWAY PARK BLVD. NE • ALBUQUERQUE, NEW MEXICO 87109
PHONE: 505.345.4250 • FAX: 505.345.4254 • www.highmesacg.com

**LANDSCAPE PLAN - STUDENT LOT
COAL AVENUE PEDESTRIAN MALL
HIGHLAND HIGH SCHOOL**

DESIGNED BY	DATE	BY	REVISIONS	JOB NO.
W.L.C.I.	1/12	B.E.E.	RECORD DRAWING	2010.180.5
W.L.C.I.				DATE 01-2012
W.L.C.I.				SHEET 2 OF 2