

# DRAINAGE INFORMATION SHEET

PROJECT TITLE: Hollywood Video ZONE ATLAS/DRNG, FILE#: K-17/1866A  
DRB #: \_\_\_\_\_ EPC #: \_\_\_\_\_ WORK ORDER #: \_\_\_\_\_  
LEGAL DESCRIPTION: Lot 2, Wal-mart Addition  
CITY ADDRESS: San Mateo and Highland Avenue 333 San Mateo S.E

ENGINEERING FIRM: Mark Goodwin & Associates, PA CONTACT: Mark Goodwin, PE  
ADDRESS: PO Box 90606 PHONE: 345-2010  
OWNER: Hollywood Video CONTACT: Melissa  
ADDRESS: 105 4th Street SW PHONE: 843-9639  
ARCHITECT: Design Collaborative SW CONTACT: Melissa  
ADDRESS: 105 4th Street SW PHONE: 843-9639  
SURVEYOR: Walker Surveying CONTACT: Steve Walker  
ADDRESS: \_\_\_\_\_ PHONE: \_\_\_\_\_  
CONTRACTOR: Wilger Enterprises CONTACT: John Wilger  
ADDRESS: \_\_\_\_\_ PHONE: \_\_\_\_\_

## TYPE OF SUBMITTAL:

☐ DRAINAGE REPORT  
☐ DRAINAGE PLAN  
☐ CONCEPTUAL GRADING & DRAINAGE PLAN  
☐ GRADING PLAN  
☐ EROSION CONTROL PLAN  
☒ ENGINEER'S CERTIFICATION  
☐ OTHER

## PRE-DESIGN MEETING:

☐ YES  
☒ NO  
☐ COPY PROVIDED

## CHECK TYPE OF APPROVAL SOUGHT:

☐ SKETCH PLAT APPROVAL  
☐ PRELIMINARY PLAT APPROVAL  
☐ S. DEV. PLAN FOR SUB'D APPROVAL  
☐ S. DEV. PLAN FOR BLDG PERMIT APPROVAL  
☐ SECTOR PLAN APPROVAL  
☐ FINAL PLAT APPROVAL  
☐ FOUNDATION PERMIT APPROVAL  
☐ BUILDING PERMIT APPROVAL  
☒ CERTIFICATION OF OCCUPANCY APPROVAL  
☐ GRADING PERMIT APPROVAL  
☐ PAVING PERMIT APPROVAL  
☐ S.A.D. DRAINAGE REPORT  
☐ DRAINAGE REQUIREMENTS  
☐ OTHER \_\_\_\_\_ (Specify)

DATE SUBMITTED: 5/31/95

BY: Mark Goodwin  
Mark Goodwin, PE

MAY 31 1995



# ***City of Albuquerque***

P.O. BOX 1293 ALBUQUERQUE, NEW MEXICO 87103

June 13, 1995

Mark Goodwin  
Mark Goodwin & Associates  
P.O. Box 90606  
Albuquerque, NM 87199

RE: ENGINEER CERTIFICATION FOR HOLLYWOOD VIDEO (K17-D66A)  
CERTIFICATION STATEMENT DATED 5/31/95.

Dear Mr. Goowin:

Based on the information provided on your May 31, 1995 submittal, Engineer Certification for the above referenced site is acceptable.


If I can be of further assistance, please feel free to contact me at 768-2667.

Sincerely,

Bernie J. Montoya, CE  
Engineering Associate

BJM/dl

c: Andrew Garcia  
File

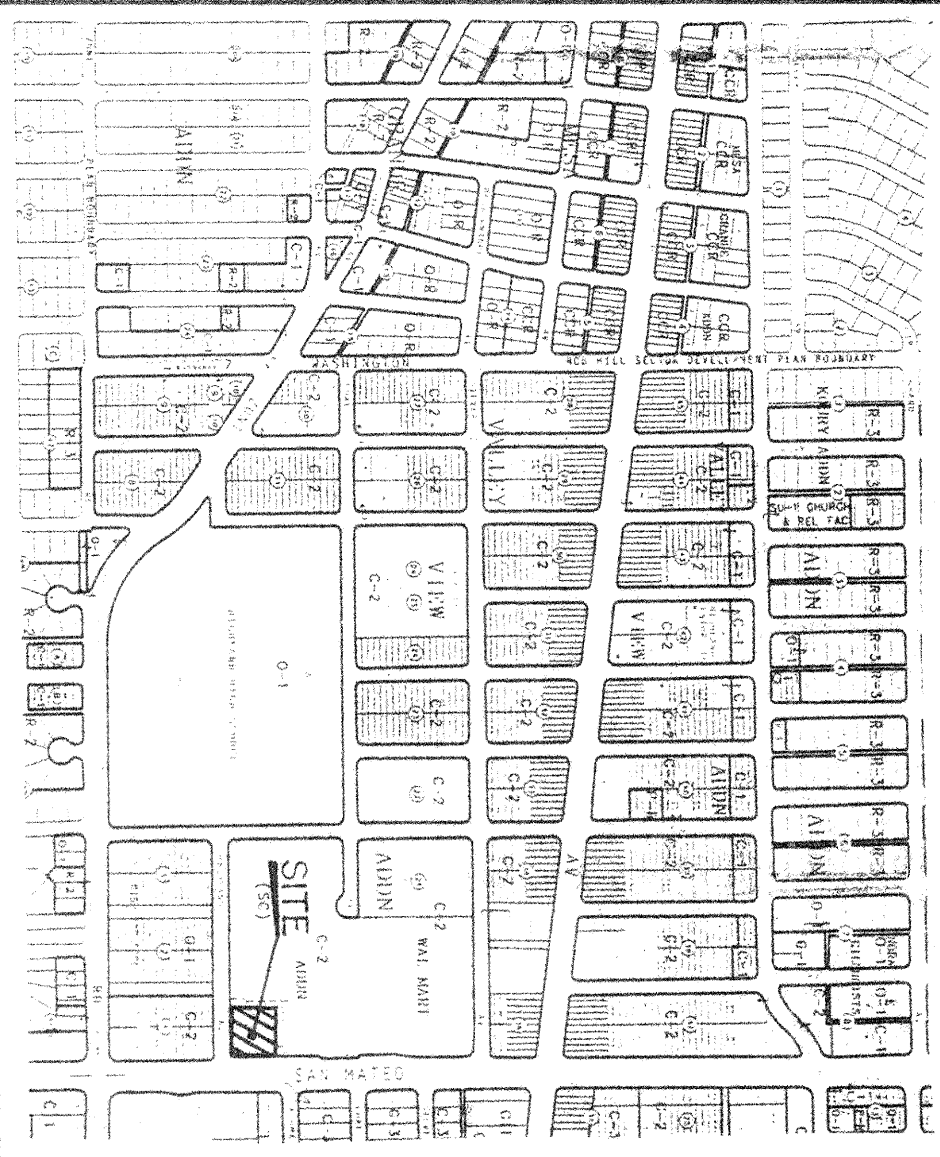

ZONE MAP K-17

ACS BENCHMARK

STATION IS A 3-1/4" ALUMINUM TABLET SET IN A DRILL HOLE FLUSH WITH THE TOP OF THE CURB AT THE NOSE OF THE MEDIAN. STATION IS STAMPED "ACS-B-K17 1984"

STATION IS LOCATED 3.6 MILES EAST, SOUTHEAST OF DOWNTOWN ALBUQUERQUE, NEW MEXICO. THE INTERSECTION OF ROAD 225 TRAVEL EAST ON GOAL AVENUE APPROXIMATELY 2.5 MILES TO WASHINGTON STREET.

X = 396.80740  
Y = 1482.72314  
Z = 5229.82

- NOTES:
1. THIS PROJECT ENTAILS CONSTRUCTION OF A NEW BUILDING ON AN EXISTING PAD SITE.
  2. NO OFF-SITE FLOWS ENTER THIS SITE.

DESIGNER'S ASSUMPTIONS

PROPOSED

A = 0.76 AC  
P = 2.35 IN  
T = 10 MIN  
TREATMENT B = 10%  
TREATMENT D = 0.4%  
Q<sub>100</sub> = 3.3 CFS  
VOL<sub>100</sub> = 5,227 CU FT

FREE DISCHARGE PER WALMART MASTERPLAN

LOT 2 OF THE WALMART ADDITION, FILED DECEMBER 17, 1992, VOLUME 92C  
FOLIO 271 BERNALILLO COUNTY, NEW MEXICO

PROPERTY LINE  
EXISTING CONTOUR  
EXISTING SPOT ELEVATION  
FLOWLINE  
PROPOSED SPOT ELEVATION

HOLLYWOOD VIDEO  
GRADING & DRAINAGE PLAN

**dmg**  
D. MARK GOODWIN & ASSOCIATES, P.A.  
CONSULTING ENGINEERS & SURVEYORS  
P.O. BOX 90606  
ALBUQUERQUE, NEW MEXICO 87199  
(505) 345-2010

REVISION	DATE	BY	CHK	APP	NO.
1	12/94	DMG	DMG		1

RECORD DRAWING

I hereby certify that the information contained on this drawing has been revised in accordance with information furnished by the Contractor, Wilger Enterprises, and by the Surveyor, Walker Surveying, and reflects the construction as actually accomplished. This plan as constructed is in substantial compliance with the Approved Plan.

*Mark Goodwin*  
Mark Goodwin, NMPE 8948

SCALE: 1" = 20'

HIGHLAND AVE. S.E.

SAN MATEO BLVD.

EXISTING PARKING

PROPOSED BUILDING  
F.F. = 5262.75 M.S.L.  
74'

ROOF  
LEADER  
TYP.

