

# GRADING & DRAINAGE PLAN


THE RETAIL RESTAURANT - COMMERCIAL PROJECT IS LOCATED IN THE MANKATO ADDITION OF ALBUQUERQUE APPROXIMATELY 3 MILES EAST OF THE DOWNTOWN CORE OF ALBUQUERQUE, NM. THE GRADING & DRAINAGE SCHEME HEREON IS IN COMPLIANCE WITH THE BERNALILLO COUNTY FLOOD HAZARD ORDINANCE, NO.88-46, AND THE CITY STORM DRAINAGE ORDINANCE. THE PLAN IS REQUIRED IN ORDER TO FACILITATE THE OWNER'S REQUEST FOR BUILDING PERMIT. THE PLAN SHOWS:

1. EXISTING CONTOURS, AND SPOT ELEVATIONS AND EXISTING DRAINAGE PATTERNS AND EXISTING IMPROVEMENTS: FORMER BUILDING, PARKING AREAS INCLD. FLATWORK.
2. PROPOSED IMPROVEMENTS: 1200 SF BUILDING ADDITION, NEW CONCRETE DRIVEPADS AND OUTDOOR PATIO AREA, NEW GRADE ELEVATIONS, FLATWORK AND LANDSCAPING.
3. CONTINUITY BETWEEN EXISTING AND PROPOSED ELEVATIONS.
4. QUANTIFICATION AND ACCEPTANCE OF UPSTREAM OFF-SITE FLOWS WHICH CONTRIBUTE TO THE DEVELOPED FLOWS GENERATED BY THE IMPROVEMENTS.

THE PURPOSE OF THE PLAN IS TO ESTABLISH CRITERIA FOR CONTROLLING STORM RUNOFF AND EROSION, AND ESSENTIALLY ALLOWING HISTORIC FLOWS TO CONTINUE TO DRAIN THROUGH THE PROPERTY. PRESENTLY, THE SITE IS BOUNDED ON THE SOUTH BY COMMERCIAL-USE ASPHALT PARKING, TO THE EAST BY COMMERCIAL USE. CENTRAL AVENUE & SOLANO STREET ON THE NORTH AND WEST ARE PAVED WITH CURB, GUTTER AND SIDEWALK, AND MAINTAINED BY THE CITY OF ALBUQUERQUE. THE SITE CURRENTLY DRAINS AT 1% FROM SOUTH TO NORTH.

HISTORICAL SITE RUNOFF OUTFALL LOCATIONS WILL REMAIN UNCHANGED. SINCE BOTH STREETS ARE IMPROVED ONLY MINIMAL GRADING (DRIVEPAD RECONSTR-N) IS PROPOSED WITHIN THE CITY R.O.W. - FREE DISCHARGE OF DEVELOPED FLOW IS ACCEPTABLE SINCE THE TOTAL INCREASE OF DEVELOPED FLOW IS MINIMAL, AND CAPACITY EXISTS DOWNSTREAM.

THE SITE IS NOT IMPACTED ADVERSELY BY ANY OFF-SITE DRAINAGE FLOWS.

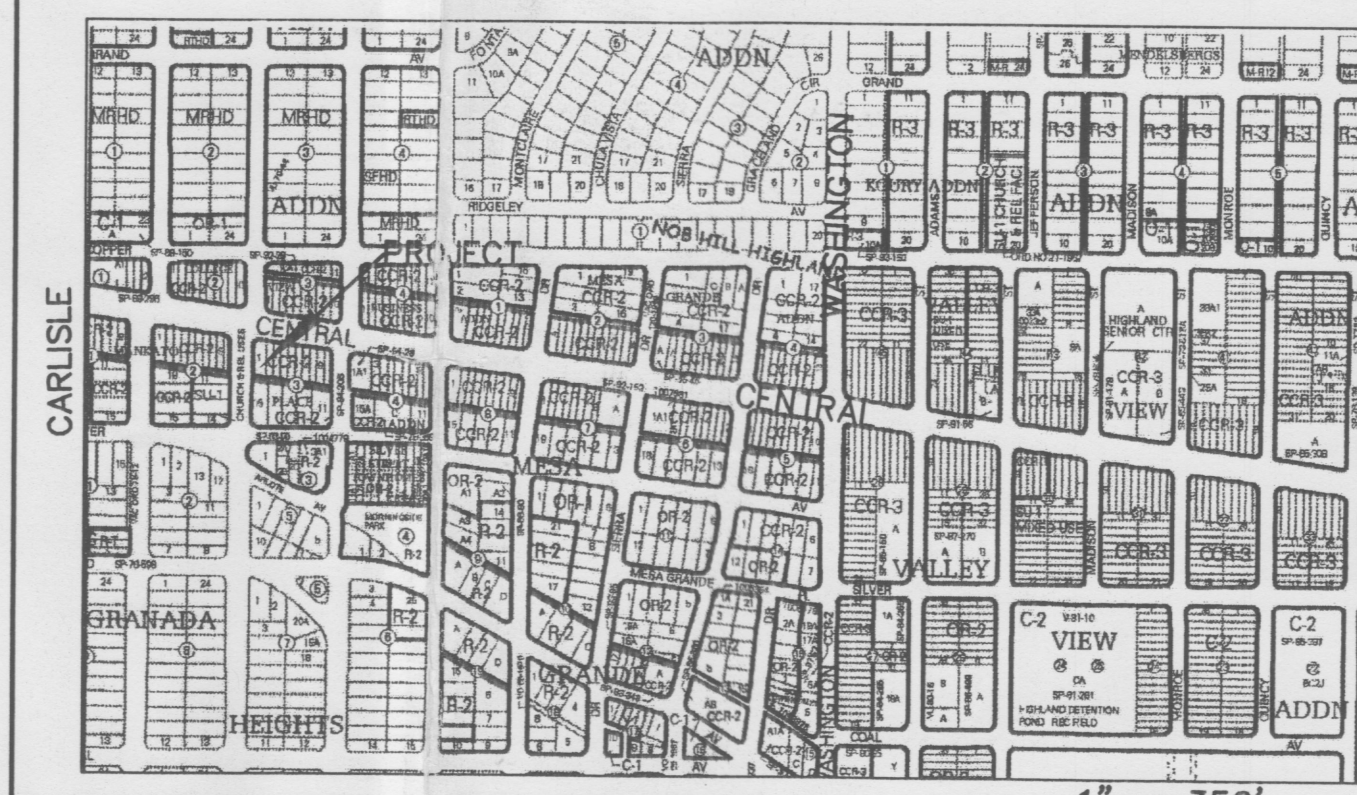

VICINITY MAP

1" = 350'

## NOTES

1. ALL WORK WITHIN THE RIGHT-OF-WAY SHALL BE CONSTRUCTED IN ACCORDANCE WITH THE CITY OF ALBUQUERQUE STANDARD SPECS. FOR PUBLIC WORKS CONSTRUCTION, 7TH EDITION W/ UPDATES.
2. AN EXCAVATION/CONSTRUCTION PERMIT IS REQUIRED BEFORE BEGINNING ANY WORK WITHIN CITY R.O.W. AN APPROVED COPY OF THIS PLAN MUST BE SUBMITTED AT THE TIME OF APPLICATION.
3. ALL WORK ON THIS PROJECT SHALL BE PERFORMED IN ACCORDANCE WITH APPLICABLE FEDERAL, STATE AND LOCAL LAWS, RULES, AND REGULATIONS CONCERNING CONSTRUCTION SAFETY AND HEALTH.
4. ALL LANDSCAPING AREA SHALL BE SOFT-LINED WITH NATIVE VEGETATION AND/OR GRAVEL. ASPHALT PARKING AREA SHALL DRAIN DIRECTLY TO EXISTING CURB CUTS.
5. CONTRACTOR SHALL ENSURE THAT NO SITE SOILS/SEDIMENT OR SILT ENTER THE RIGHT-OF-WAYS DURING CONSTRUCTION.
6. REVEGETATE ALL AREAS DISTURBED DUE TO CONSTRUCTION PER CITY OF ALBUQ. SPEC. 1011, NATIVE SEED MIX.
7. MAXIMUM SITE GRADING WITHOUT EROSION PROTECTION: 3 HORIZONTAL TO 1 VERTICAL, 3:1. ALL DIMENSIONS TO FACE OF CURB, UNLESS NOTED OTHERWISE.

- ① REMOVE EXISTING CONCRETE SLABS
- ② CLOSE EXISTING DRIVEPAD AND BUILD STD. C/G PER COA 2415 REPAIR SWWK. PER COA 2430

## LEGEND

EXIST. SPOT ELEVATION	+24.0
EXIST. CONTOUR	10
NEW SPOT ELEVATION	24.0
NEW CONTOUR	12
NEW SWALE	
DRAINAGE DIRECTION, EXISTING	
NEW CONCRETE CURB (0.5' HEIGHT)	
NEW P.C.C., CONCRETE	
TOP OF CURB, EXISTING	TC
FLOWLINE	FL
EXISTING POWER POLE	O
FACE OF CURB/FACE OF CURB	F-F
WATER BLOCK	
AS-BUILT SPOT	05.81



RECEIVED

AUG 04 2010

HYDROLOGY SECTION

## PROJECT DATA

### LEGAL DESCRIPTION

LOT 1, BLOCK 3, MANKATO PLACE ADDITION ALBUQUERQUE, BERNALILLO COUNTY, NEW MEXICO

### PROJECT BENCHMARK

TOP OF REBAR/CAP AT THE PROJECT NORTHWEST CORNER MSL ELEVATION = 5205.02, AS TIED FROM COA 1-3/4" DIAMETER BRASS DISK SET IN SIDEWALK, 5-K17A, MSL, NAVD 88, 5222.21, LOCATED 178' EAST OF THE INTERSECTION OF MORNINGSIDE AND CENTRAL AVENUE, SE.

### TOPOGRAPHIC DESIGN SURVEY

COMPILED BY CLARK CONSULTING ENGINEERS, DATE NOVEMBER 2009, FROM DATA COLLECTED BY THE SURVEY OFFICE, UNDER THE DIRECTION OF TONY HARRIS, P.S. OF HARRIS SURVEYING, INC.

Clark Consulting Engineers  
19 Ryan Road  
Edgewood, New Mexico 87015  
Tel: (505) 281-2444 Fax: (505) 281-2444

Nob Hill DEVELOPMENT CORP

Route 66 MALT SHOP & GRILL

MARTIN FM GRUMMER ARCHITECT  
331 WELLESLEY PLACE NE  
ALBUQUERQUE, NEW MEXICO 87106  
(505) 265-2507

## REVISIONS

8/3/10	AS-BUILT	AC


BEAUTY COLLEGE PROJECT  
ROUTE 66 MALT SHOP & GRILL  
ALBUQUERQUE, NM 87108  
GRADING & DRAINAGE PLAN

DATE:  
DRAWN BY:  
CHECKED BY:  
VERIFIED BY:

DESIGNS BY  
JAF CONCEPTS  
(505) 315-9644

SHEET NO:  
C1.1  
PHASE 1

AS-BUILT(S)

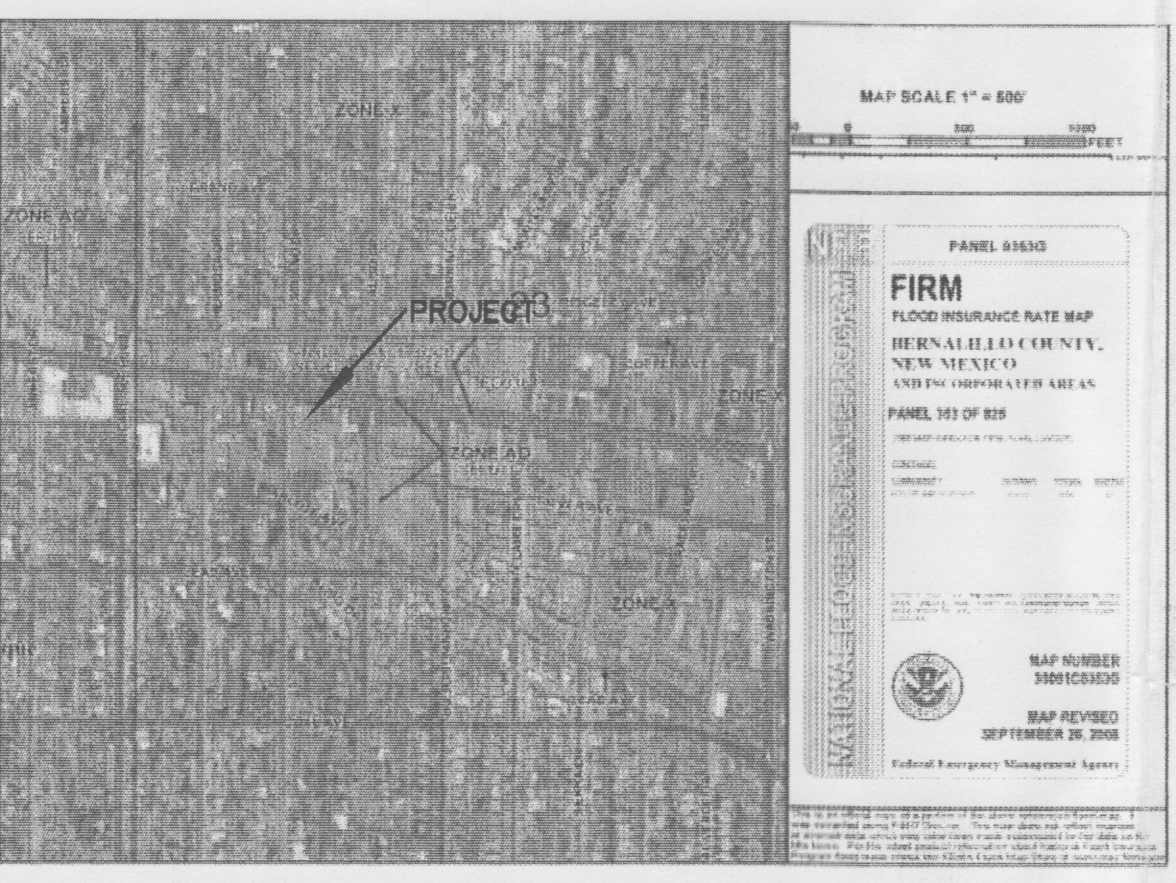

FIRM MAP PANEL # 353 G

SUBJECT PROPERTY IS ADJACENT TO A FLOOD HAZARD ZONE.

## CALCULATIONS

### DESIGN CRITERIA

HYDROLOGIC METHODS PER SECTION 22.2, HYDROLOGY OF THE DEVELOPMENT PROCESS MANUAL (DPM) REVISED JANUARY 1993 FOR CITY OF ALBUQUERQUE ADOPTED BY THE COUNTY OF BERNALILLO  
DISCHARGE RATE:  $Q = Q_{PEAK} \times AREA$ , "Peak Discharge Rates For Small Watersheds"  
VOLUMETRIC DISCHARGE:  $VOLUME = E_{WEIGHTED} \times AREA$   
 $P100 = 2.35$  inches, Zone 2 Time of Concentration,  $TC = 10$  Minutes  
DESIGN STORM: 100-YEAR/6-HOUR, 10-YEAR/6-HOUR [ ] = 10 YEAR VALUES

### EXISTING CONDITIONS

50% 'C', 50% 'D'  
TOTAL AREA = 0.13 ACRES, WHERE EXCESS PRECIP. 'W' = 1.63 in. [0.93]  
PEAK DISCHARGE,  $Q100 = 0.51$  CFS [0.31], WHERE UNIT PEAK DISCHARGE 'W' = 3.9 CFS/AC. [2.4]  
THEREFORE:  $VOLUME 100 = 769$  CF [439]

### DEVELOPED CONDITIONS

DETERMINE LAND TREATMENTS, PEAK DISCHARGE AND VOLUMETRIC DISCHARGE FOR STUDY AREA

AREA	LAND TREATM'T	Q Peak	E
UNDEVELOPED	---	1.56[0.38]	0.53[0.13]
LANDSCAPING	0.01 Ac.	2.28[0.95]	0.78[0.28]
GRAVEL & COMPACTED SOIL	0.02 Ac.	3.14[1.71]	1.13[0.52]
ROOF - PAVEMENT	0.10 Ac.	4.70[3.14]	2.12[1.34]
	0.13 Ac.		

THEREFORE:  $E_{WEIGHTED} = 1.86$  in. [1.13] &  
 $Q100 = 0.55$  CFS  
 $Q10 = 0.35$  CFS

RECOMMEND: ROUTE DEVELOPED RUNOFF THROUGH SOFT LANDSCAPING

### DRAINAGE CERTIFICATION

I, Philip W. Clark, NMPE 10265, of the firm Clark Consulting Engineers, hereby certify that this project has been graded and will drain in substantial compliance with and in accordance with the design intent of the approved plan dated 12/15/09. THE RECORD INFORMATION FORTH ON THE ORIGINAL DESIGN DOCUMENT HAS BEEN OBTAINED BY ME OR UNDER MY DIRECT SUPERVISION. I AS SUPPLEMENTAL DATA TO THE ORIGINAL TOPOGRAPHIC SURVEY PREPARED BY Tony Harris, NAPS 11463 OF THE FIRM Harris Surveying, and is TRUE AND CORRECT TO THE BEST OF MY KNOWLEDGE AND BELIEF. THIS CERTIFICATION IS SUBMITTED IN SUPPORT OF A REQUEST FOR

### Permanent Certificate of Occupancy

(DESCRIBE ANY EXCEPTIONS) Alley Gutter in Lieu of Cobble Swale - Also See Worder, CP 787484.

(DESCRIBE ANY DEFICIENCIES)

THE RECORD INFORMATION PRESENTED HEREON IS NOT NECESSARILY COMPLETE AND INTENDED ONLY TO VERIFY SUBSTANTIAL COMPLIANCE OF THE GRADING AND DRAINAGE ASPECTS OF THIS PROJECT. THOSE RELYING ON THIS RECORD DOCUMENT ARE ADVISED TO OBTAIN INDEPENDENT VERIFICATION OF ITS ACCURACY PRIOR TO USING IT FOR ANY OTHER PURPOSE.

Philip W. Clark, NMPE 10265


DATE:

Philip W. Clark  
10265  
8.3.10

I, PHILIP W. CLARK, A PROFESSIONAL ENGINEER LICENSED IN ACCORDANCE WITH THE LAWS OF THE STATE OF NEW MEXICO, DO HEREBY CERTIFY THAT I HAVE VISITED THE SITE SHOWN HEREON, AND THAT THE CONTOURS SHOWN REPRESENT THE EXISTING GROUND CONDITIONS, AND DO FURTHER CERTIFY THAT NO EARTHWORK OF ANY KIND, NOR ANY DISTURBANCE OF THE EXISTING GROUND HAS OCCURRED ON THIS SITE SINCE THE CONTOURS WERE DETERMINED.

Philip W. Clark NMPE #10265



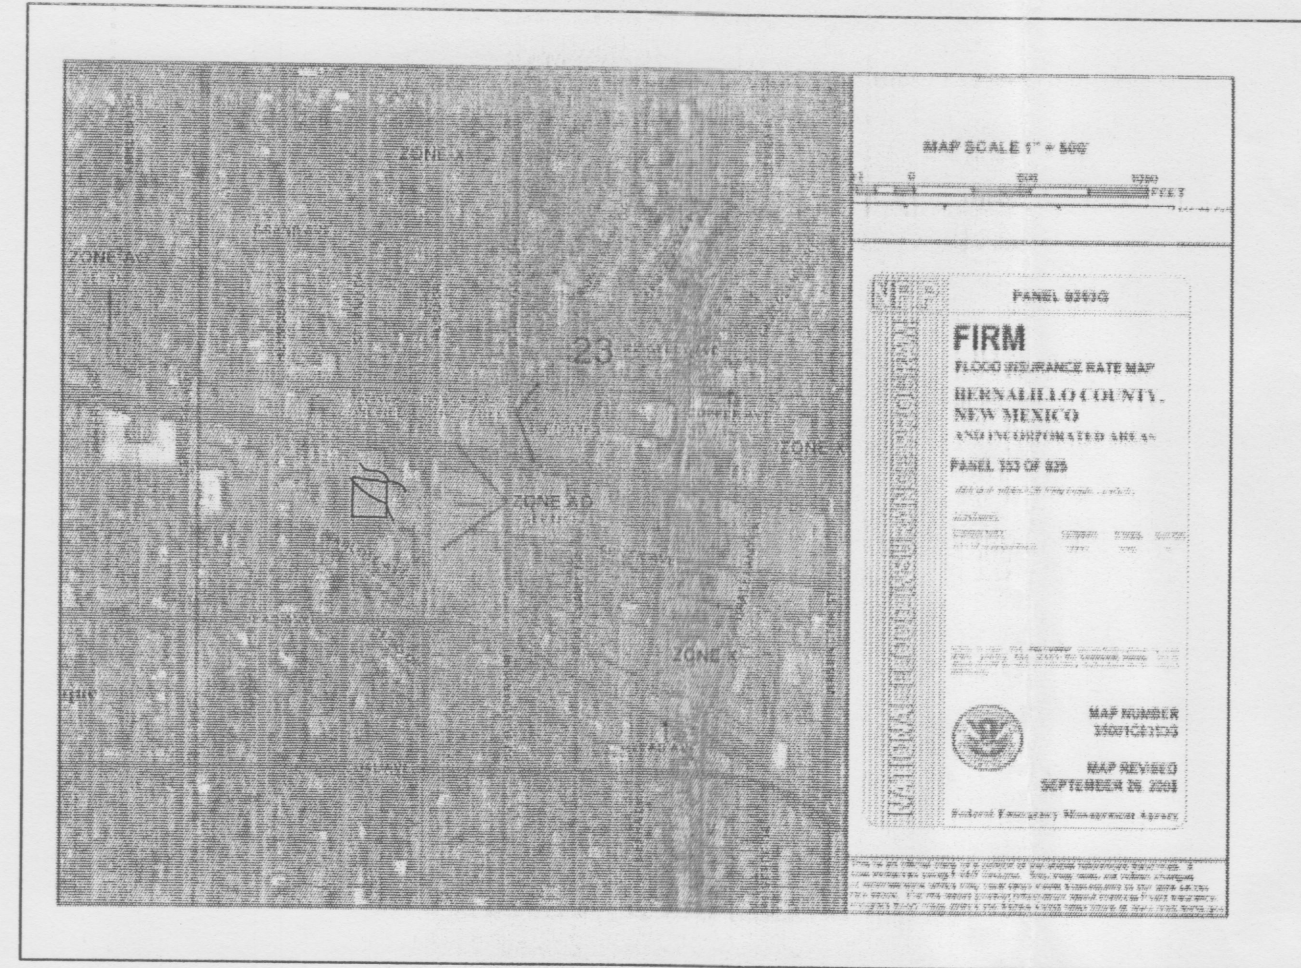

**FIRM MAP** PANEL # 353 G  
SUBJECT PROPERTY IS WITHIN A FLOOD HAZARD ZONE.

## CALCULATIONS

### DESIGN CRITERIA

HYDROLOGIC METHODS PER SECTION 22.2, HYDROLOGY OF THE DEVELOPMENT PROCESS MANUAL (DPM) REVISED JANUARY 1993 FOR CITY OF ALBUQUERQUE ADOPTED BY THE COUNTY OF BERNALILLO  
DISCHARGE RATE:  $Q = Q_{PEAK} \times AREA$ , "Peak Discharge Rates For Small Watersheds"  
VOLUMETRIC DISCHARGE:  $VOLUME = E_{WEIGHTED} \times AREA$   
 $P100 = 2.35$  Inches, Zone 2 Time of Concentration, TC = 10 Minutes  
DESIGN STORM: 100-YEAR/6-HOUR, 10-YEAR/6-HOUR [ ] = 10 YEAR VALUES

### EXISTING CONDITIONS

50% 'C', 50% 'D'  
TOTAL AREA = 0.54 ACRES, WHERE EXCESS PRECIP. 'W' = 1.63 in. [0.93]  
PEAK DISCHARGE,  $Q100 = 2.1$  CFS [1.31], WHERE UNIT PEAK DISCHARGE 'W' = 3.9 CFS/AC. [2.4]  
THEREFORE:  $VOLUME 100 = 3195$  CF [1823]

### DEVELOPED CONDITIONS

DETERMINE LAND TREATMENTS, PEAK DISCHARGE AND VOLUMETRIC DISCHARGE FOR STUDY AREA

	AREA	LAND TREATM'T	$Q_{Peak}$	$E$
UNDEVELOPED	--- Ac.	A	1.56[0.38]	0.53[0.13]
LANDSCAPING	0.11 Ac.(20%)	B	2.28[0.95]	0.78[0.28]
GRAVEL & COMPACTED SOIL	0.00 Ac.	C	3.14[1.71]	1.13[0.52]
ROOF - PAVEMENT	0.43 Ac.(80%)	D	4.70[3.14]	2.12[1.34]
	0.54 Ac.			

THEREFORE:  $E_{WEIGHTED} = 1.85$  in.[1.13] &  
 $Q100 = 2.27$  CFS VOLUME 100 = 3626 CF  
 $Q10 = 1.46$  CFS VOLUME 10 = 2215 CF

RECOMMEND : ROUTE DEVELOPED RUNOFF THROUGH SOFT LANDSCAPING

I, PHILIP W. CLARK, A PROFESSIONAL ENGINEER LICENSED IN ACCORDANCE WITH THE LAWS OF THE STATE OF NEW MEXICO, DO HEREBY CERTIFY THAT I HAVE VISITED THE SITE SHOWN HEREON, AND THAT THE CONTOURS SHOWN REPRESENT THE EXISTING GROUND CONDITIONS, AND DO FURTHER CERTIFY THAT NO EARTHWORK OF ANY KIND, NOR ANY DISTURBANCE OF THE EXISTING GROUND HAS OCCURRED ON THIS SITE SINCE THE CONTOURS WERE DETERMINED.

PHILIP W. CLARK NMPE #10265

## GRADING & DRAINAGE PLAN


THE RETAIL RESTAURANT - COMMERCIAL PROJECT IS LOCATED IN THE MANKATO ADDITION OF ALBUQUERQUE, APPROXIMATELY 3 MILES EAST OF THE DOWNTOWN CORE OF ALBUQUERQUE, NM. THE GRADING & DRAINAGE SCHEME HEREON IS IN COMPLIANCE WITH THE BERNALILLO COUNTY FLOOD HAZARD ORDINANCE, NO.88-46, AND THE CITY STORM DRAINAGE ORDINANCE. THE PLAN IS REQUIRED IN ORDER TO FACILITATE THE OWNER'S REQUEST FOR BUILDING PERMIT. THE PLAN SHOWS:

1. EXISTING CONTOURS, AND SPOT ELEVATIONS AND EXISTING DRAINAGE PATTERNS AND EXISTING IMPROVEMENTS: FORMER BUILDING, PARKING AREAS INCLDG. FLATWORK.
2. PROPOSED IMPROVEMENTS: PARKING LOT RECONSTRUCTION, NEW CONCRETE DRIVEPADS, NEW GRADE ELEVATIONS, FINE GRADING, FLATWORK AND LANDSCAPING.
3. CONTINUITY BETWEEN EXISTING AND PROPOSED ELEVATIONS.
4. QUANTIFICATION AND ACCEPTANCE OF UPSTREAM OFF-SITE

THE PURPOSE OF THE PLAN IS TO ESTABLISH CRITERIA FOR CONTROLLING STORM RUNOFF AND EROSION, AND ESSENTIALLY ALLOWING HISTORIC FLOWS TO CONTINUE TO DRAIN THROUGH THE PROPERTY. PRESENTLY, THE SITE IS BOUNDED ON THE NORTH BY COMMERCIAL-USE ASPHALT PARKING, TO THE EAST BY COMMERCIAL USE. SILVER AVENUE & SOLANO STREET ON THE SOUTH AND WEST ARE PAVED WITH CURB, GUTTER AND SIDEWALK, AND MAINTAINED BY THE CITY OF ALBUQUERQUE. THE SITE CURRENTLY DRAINS AT 10% TO 1% FROM SOUTH TO NORTH.


HISTORICAL SITE RUNOFF OUTFALL LOCATIONS WILL REMAIN UNCHANGED. SINCE BOTH STREETS ARE IMPROVED ONLY MINIMAL GRADING (DRIVEPAD RECONSTR-N) IS PROPOSED WITHIN THE CITY R.O.W. FREE DISCHARGE OF DEVELOPED FLOW IS ACCEPTABLE SINCE THE TOTAL INCREASE OF DEVELOPED FLOW IS MINIMAL, AND CAPACITY EXISTS DOWNSTREAM.

THE GRADING AND DRAINAGE SCHEME MITIGATES IMPACT TO ADJACENT PROPERTY.

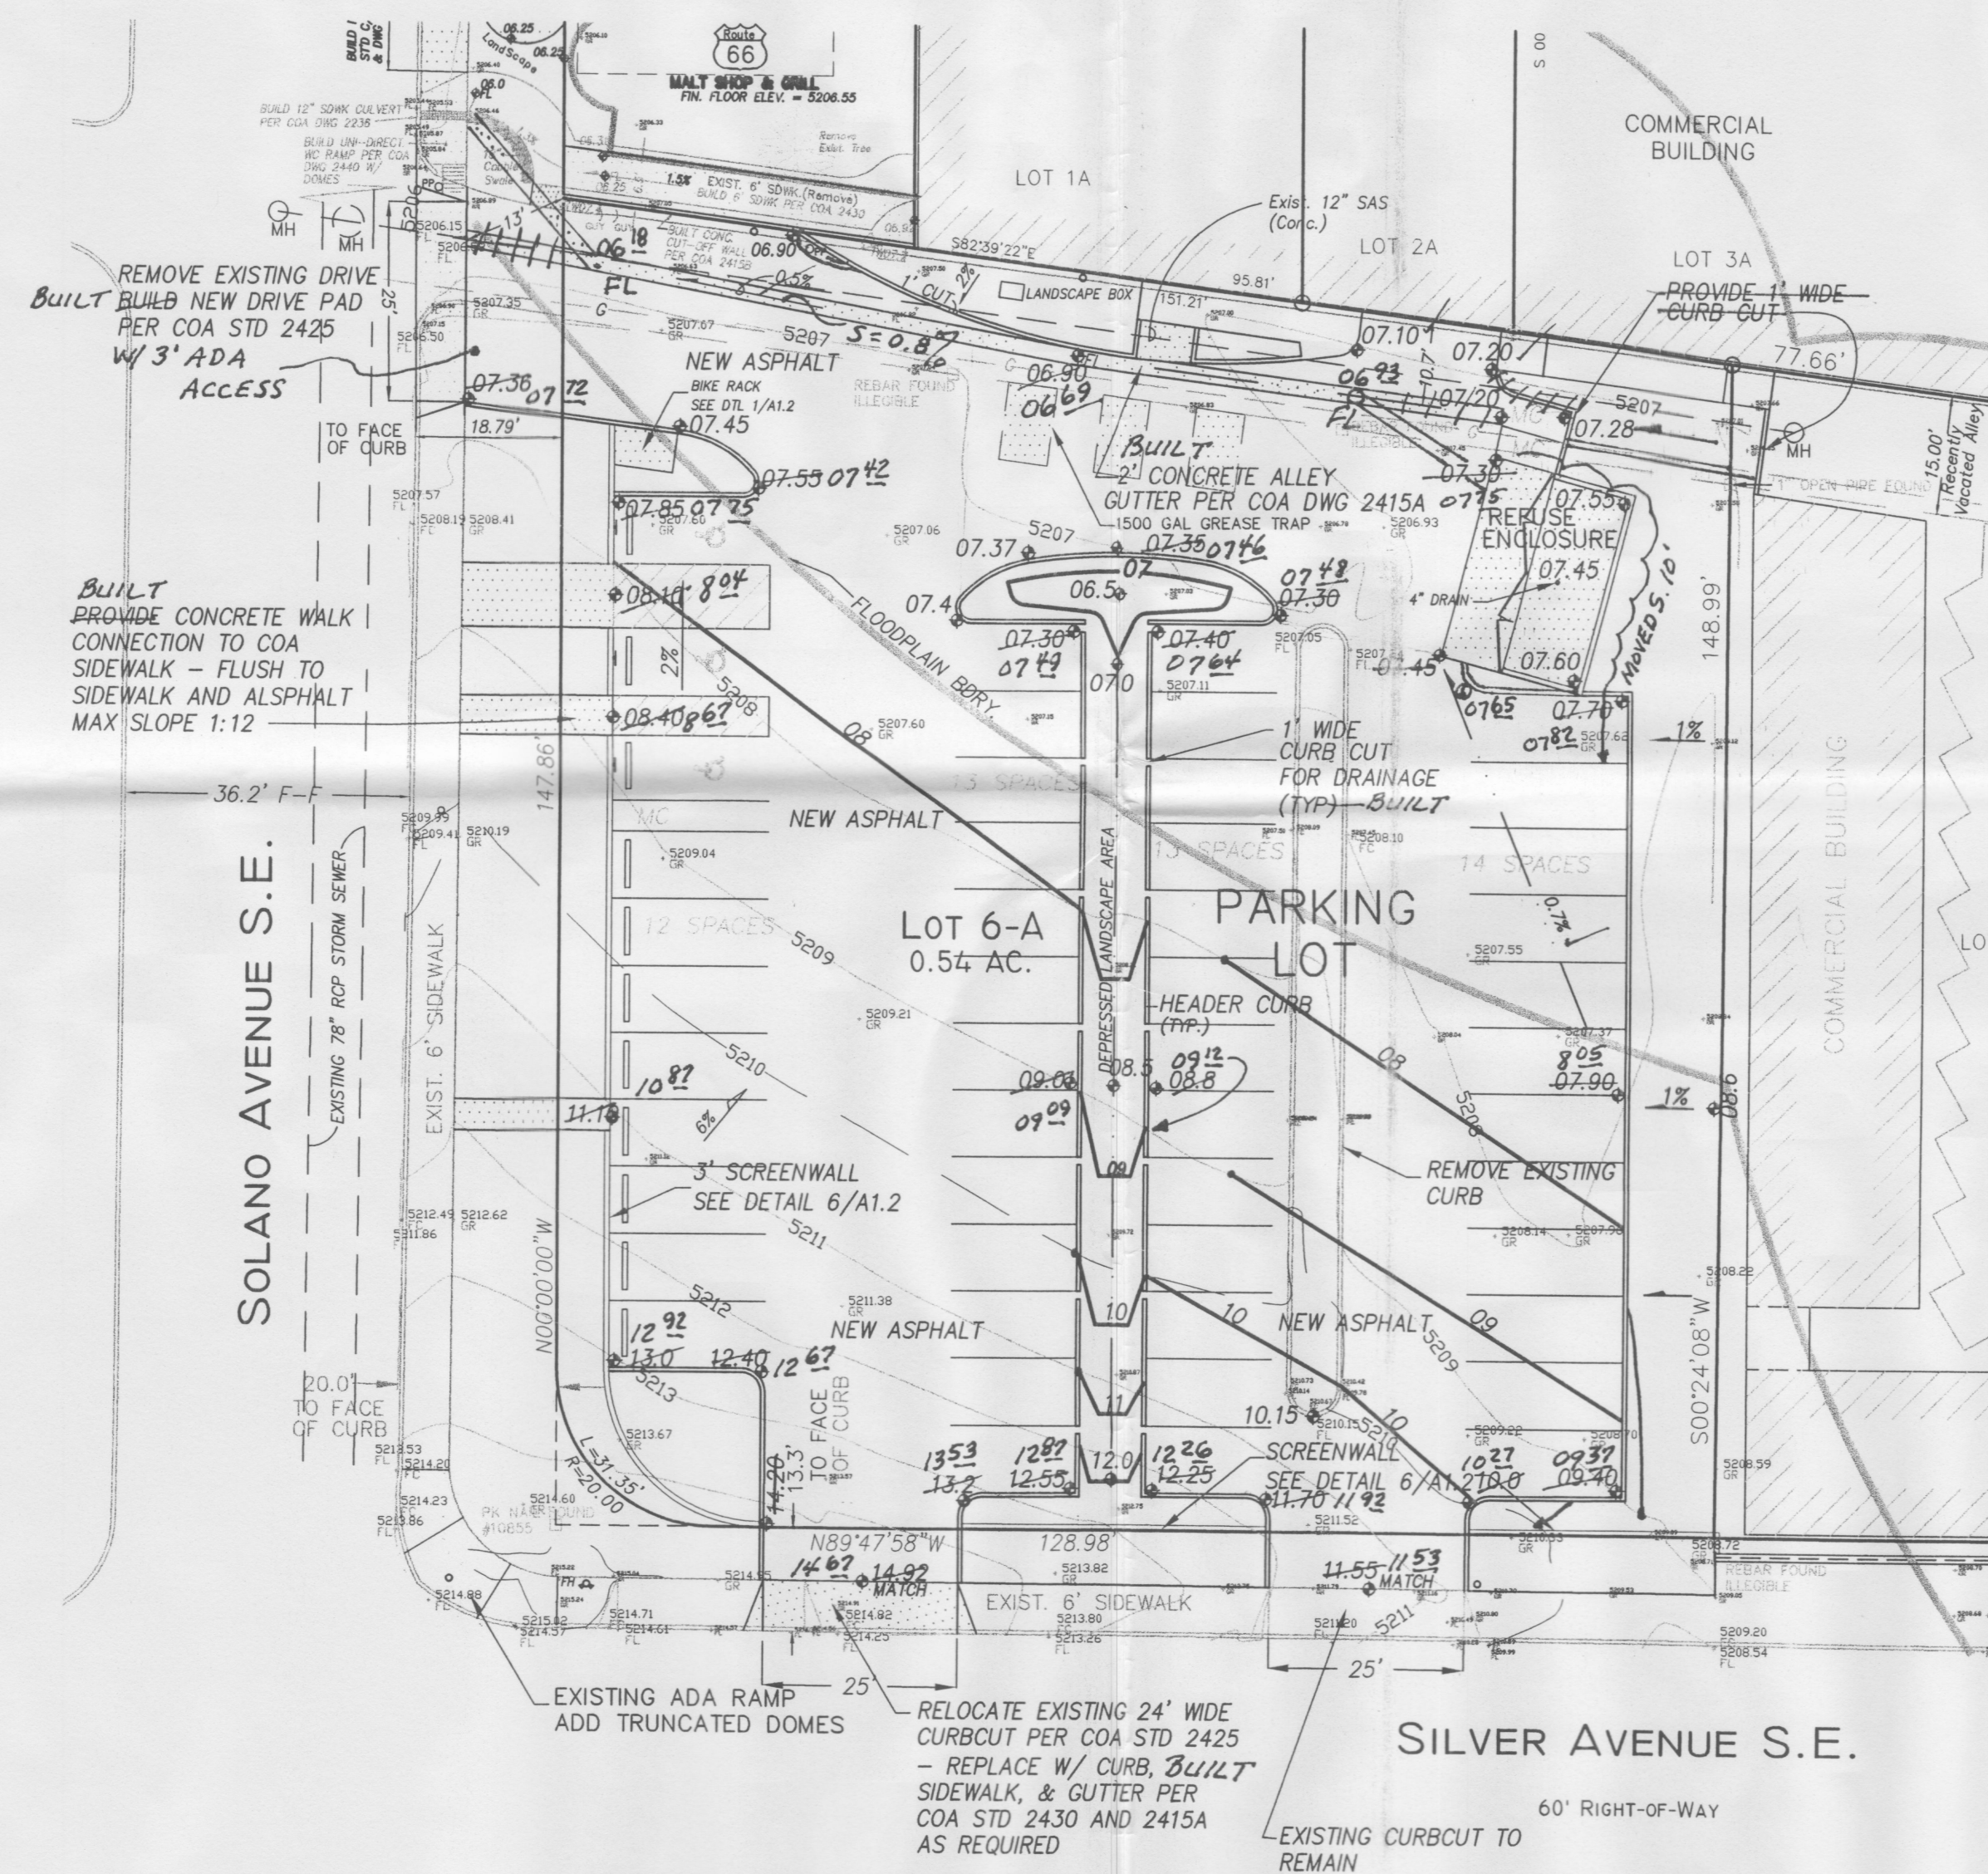

SILVER AVENUE S.E.

Scale: 1" = 20'

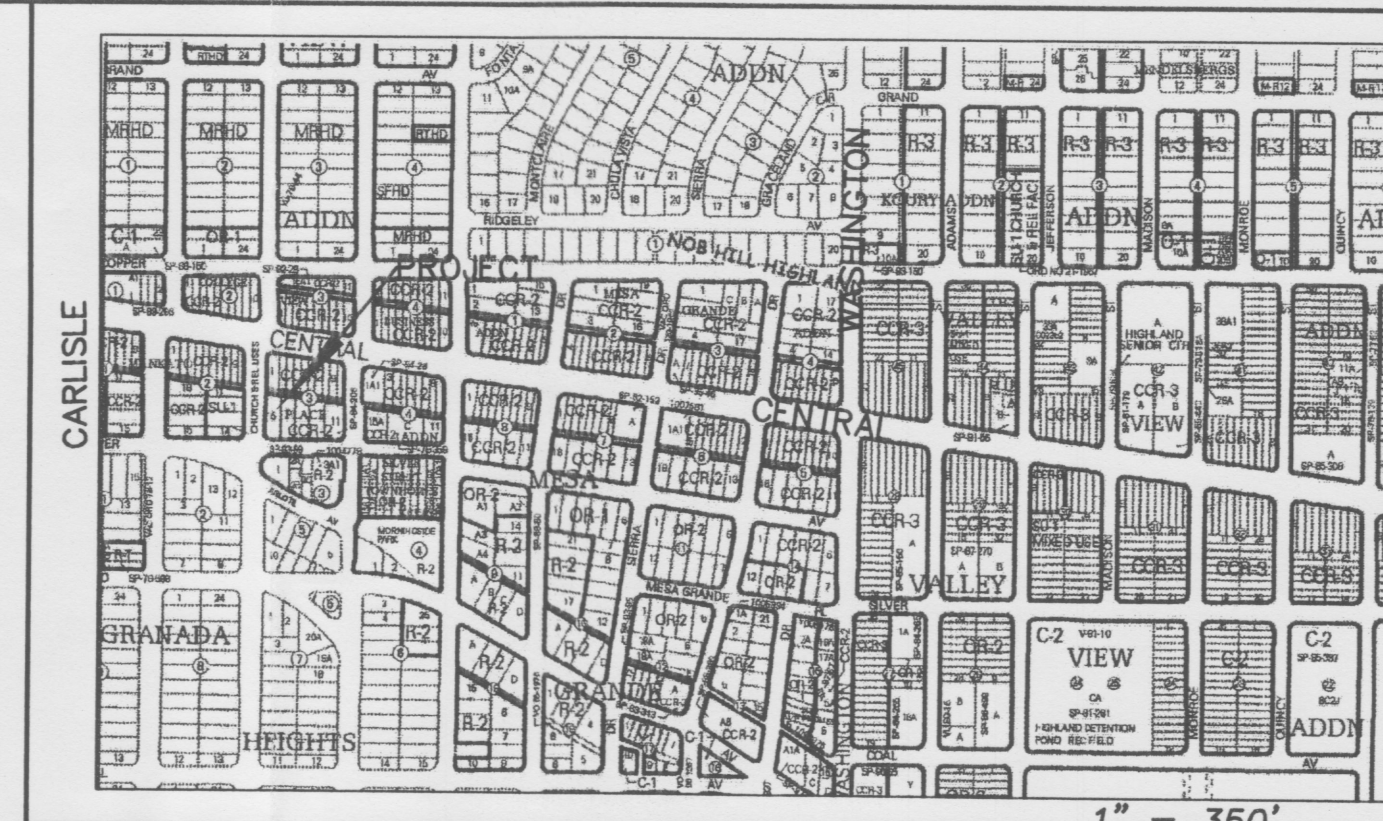

VICINITY MAP

ZONE K-17

## NOTES

1. ALL WORK WITHIN THE RIGHT-OF-WAY SHALL BE CONSTRUCTED IN ACCORDANCE WITH THE CITY OF ALBUQUERQUE STANDARD SPECS. FOR PUBLIC WORKS CONSTRUCTION, 7TH EDITION W/ UPDATES.
2. AN EXCAVATION/CONSTRUCTION PERMIT IS REQUIRED BEFORE BEGINNING ANY WORK WITHIN CITY R.O.W. AN APPROVED COPY OF THIS PLAN MUST BE SUBMITTED AT THE TIME OF APPLICATION.
3. ALL WORK ON THIS PROJECT SHALL BE PERFORMED IN ACCORDANCE WITH APPLICABLE FEDERAL, STATE AND LOCAL LAWS, RULES, AND REGULATIONS CONCERNING CONSTRUCTION SAFETY AND HEALTH.
4. ALL LANDSCAPING AREA SHALL BE SOFT-LINED WITH NATIVE VEGETATION AND/OR GRAVEL. ASPHALT PARKING AREA SHALL DRAIN DIRECTLY TO EXISTING CURB CUT.
5. CONTRACTOR SHALL ENSURE THAT NO SITE SOILS/SEDIMENT OR SILT ENTER THE RIGHT-OF-WAYS DURING CONSTRUCTION.
6. REVEGETATE ALL AREAS DISTURBED DUE TO CONSTRUCTION PER CITY OF ALBUQ. SPEC. 1011, NATIVE SEED MIX.
7. MAXIMUM SITE GRADING WITHOUT EROSION PROTECTION: 3 HORIZONTAL TO 1 VERTICAL, 3:1. ALL DIMENSIONS TO FACE OF CURB, UNLESS NOTED OTHERWISE.
8. REMOVE AND PULVERIZE EXISTING ASPHALT INTO 6" DEPTH SUBGRADE. COMPACT TO 95% MODIFIED PROCTOR, ASTM D 1557. SURFACE COURSE SHALL BE 3 INCH THICK ASPHALT CONCRETE, SUPERPAVE III.

## LEGEND

EXIST. SPOT ELEVATION	+24.0
EXIST. CONTOUR	10
NEW SPOT ELEVATION	+24.0
NEW CONTOUR	12
NEW SWALE	
DRAINAGE DIRECTION, EXISTING	
NEW CONCRETE CURB (0.5' HEIGHT)	
NEW P.C.C., CONCRETE	
TOP OF CURB, EXISTING	TC
FLOWLINE	FL
EXISTING POWER POLE	O
FACE OF CURB/FACE OF CURB	F-F
WATER BLOCK	
AS-BUILT SPOT	805/FL

PHILIP W. CLARK  
NEW MEXICO  
10265  
PROFESSIONAL ENGINEER  
4.5.10

## PROJECT DATA

### LEGAL DESCRIPTION

LOT 6A, BLOCK 3, MANKATO PLACE ADDITION ALBUQUERQUE, BERNALILLO COUNTY, NEW MEXICO

### PROJECT BENCHMARK

TOP OF REBAR/CAP AT THE PROJECT NORTHWEST CORNER MSL  
ELEVATION = 5205.02, AS TIED FROM COA 1-3/4" DIAMETER BRASS DISK SET IN SIDEWALK, 5\_K17A, MSL, NAVD 88, 5222.21, LOCATED 178' EAST OF THE INTERSECTION OF MORNINGSIDE AND CENTRAL AVENUE, SE.

### TOPOGRAPHIC DESIGN SURVEY

COMPILED BY CLARK CONSULTING ENGINEERS, DATE NOVEMBER 2009, FROM DATA COLLECTED BY THE SURVEY OFFICE, UNDER THE DIRECTION OF TONY HARRIS, P.S. OF HARRIS SURVEYING, INC.

RECEIVED

AUG 0 4 2010

HYDROLOGY  
SECTION

**Nob Hill**  
DEVELOPMENT CORP.

Route 66  
MALT SHOP  
& GRILL  
Albuquerque, New Mexico

MARTIN FM GRUMMER  
ARCHITECT  
331 BELLEVILLE PLACE NE  
ALBUQUERQUE, NEW MEXICO 87106  
(505) 265-2507

REVISIONS  
8/9/10 AS-BUILT

BEAUTY COLLEGE PROJECT  
ROUTE 66 MALT SHOP & GRILL  
ALBUQUERQUE, NM 87108  
PARKING LOT GRADING & DRAINAGE PLAN


DATE: 01 APR 2010  
DRAWN BY: PWC/MFWG  
CHECKED BY: [Signature]  
VERIFIED BY:

Clark Consulting Engineers  
19 Ryan Road  
Edgewood, New Mexico 87015  
Tel: (505) 281-2444 Fax: (505) 281-2444

SHEET NO:  
**C1.2**  
PHASE 1

ALL DIMENSIONS ARE TO BE FIELD VERIFIED. IF THERE ARE DISCREPANCIES, PLEASE NOTIFY THE ARCHITECT. DRAWING ARE NOT TO BE SCALED. USE DIMENSIONS FOR ACCURACY.



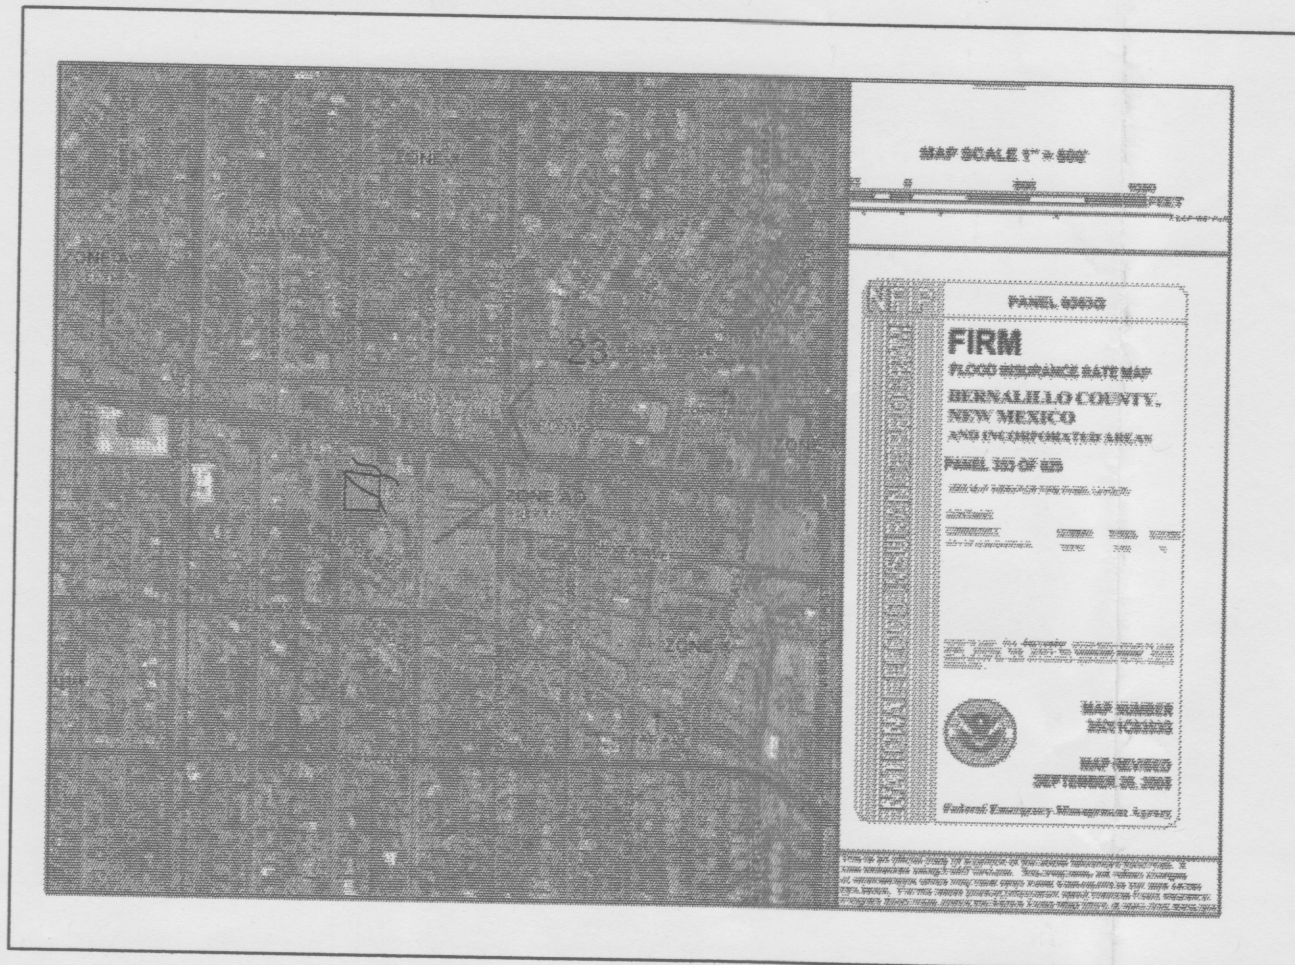

**FIRM MAP** PANEL # 353 G  
SUBJECT PROPERTY IS WITHIN A FLOOD HAZARD ZONE.

## CALCULATIONS

### DESIGN CRITERIA

HYDROLOGIC METHODS PER SECTION 22.2, HYDROLOGY OF THE DEVELOPMENT PROCESS MANUAL (DPM) REVISED JANUARY 1993 FOR CITY OF ALBUQUERQUE ADOPTED BY THE COUNTY OF BERNALILLO  
DISCHARGE RATE:  $Q = Q_{PEAK} \times AREA$ , "Peak Discharge Rates For Small Watersheds"  
VOLUMETRIC DISCHARGE:  $VOLUME = E_{Weighted} \times AREA$   
 $P100 = 2.35$  inches, Zone 2 Time of Concentration, TC = 10 Minutes  
DESIGN STORM: 100-YEAR/6-HOUR, 10-YEAR/6-HOUR [ ] = 10 YEAR VALUES

### EXISTING CONDITIONS

50% 'C', 50% 'D'  
TOTAL AREA = 0.54 ACRES, WHERE EXCESS PRECIP. 'W' = 1.63 in. [0.93]  
PEAK DISCHARGE, Q100 = 2.1 CFS [1.31], WHERE UNIT PEAK DISCHARGE 'W' = 3.9 CFS/AC. [2.4]  
THEREFORE:  $VOLUME\ 100 = 3195\ CF\ [1823]$

### DEVELOPED CONDITIONS

DETERMINE LAND TREATMENTS, PEAK DISCHARGE AND VOLUMETRIC DISCHARGE FOR STUDY AREA

	AREA	LAND TREATM'T	$\Omega$ Peak	E
UNDEVELOPED	— Ac.	A	1.56[0.38]	0.53[0.13]
LANDSCAPING	0.11 Ac.(20%)	B	2.28[0.95]	0.78[0.28]
GRAVEL & COMPACTED SOIL	0.00 Ac.	C	3.14[1.71]	1.13[0.52]
ROOF - PAVEMENT	0.43 Ac.(80%)	D	4.70[3.14]	2.12[1.34]
	0.54 Ac.			

THEREFORE:  $E_{Weighted} = 1.85\ in.[1.13]$  &  
 $Q100 = 2.27\ CFS$  VOLUME 100 = 3626 CF  
 $Q10 = 1.46\ CFS$  VOLUME 10 = 2215 CF

RECOMMEND: ROUTE DEVELOPED RUNOFF THROUGH SOFT LANDSCAPING

I, PHILIP W. CLARK, A PROFESSIONAL ENGINEER LICENSED IN ACCORDANCE WITH THE LAWS OF THE STATE OF NEW MEXICO, DO HEREBY CERTIFY THAT I HAVE VISITED THE SITE SHOWN HEREON, AND THAT THE CONTOURS SHOWN REPRESENT THE EXISTING GROUND CONDITIONS, AND DO FURTHER CERTIFY THAT NO EARTHWORK OF ANY KIND, NOR ANY DISTURBANCE OF THE EXISTING GROUND HAS OCCURRED ON THIS SITE SINCE THE CONTOURS WERE DETERMINED.

**P.W. Clark**  
PHILIP W. CLARK NMPE #10265

## GRADING & DRAINAGE PLAN


THE RETAIL RESTAURANT - COMMERCIAL PROJECT IS LOCATED IN THE MANKATO ADDITION OF ALBUQUERQUE APPROXIMATELY 3 MILES EAST OF THE DOWNTOWN CORE OF ALBUQUERQUE, NM. THE GRADING & DRAINAGE SCHEME HEREON IS IN COMPLIANCE WITH THE BERNALILLO COUNTY FLOOD HAZARD ORDINANCE, NO.88-46, AND THE CITY STORM DRAINAGE ORDINANCE. THE PLAN IS REQUIRED IN ORDER TO FACILITATE THE OWNER'S REQUEST FOR BUILDING PERMIT. THE PLAN SHOWS:

1. EXISTING CONTOURS, AND SPOT ELEVATIONS AND EXISTING DRAINAGE PATTERNS AND EXISTING IMPROVEMENTS: FORMER BUILDING, PARKING AREAS INCLDG. FLATWORK.
2. PROPOSED IMPROVEMENTS: PARKING LOT RECONSTRUCTION, NEW CONCRETE DRIVEPADS, NEW GRADE ELEVATIONS, FINE GRADING, FLATWORK AND LANDSCAPING.
3. CONTINUITY BETWEEN EXISTING AND PROPOSED ELEVATIONS.
4. QUANTIFICATION AND ACCEPTANCE OF UPSTREAM OFF-SITE


THE PURPOSE OF THE PLAN IS TO ESTABLISH CRITERIA FOR CONTROLLING STORM RUNOFF AND EROSION, AND ESSENTIALLY ALLOWING HISTORIC FLOWS TO CONTINUE TO DRAIN THROUGH THE PROPERTY. PRESENTLY, THE SITE IS BOUNDED ON THE NORTH BY COMMERCIAL-USE ASPHALT PARKING, TO THE EAST BY COMMERCIAL USE. SILVER AVENUE & SOLANO STREET ON THE SOUTH AND WEST ARE PAVED WITH CURB, GUTTER AND SIDEWALK, AND MAINTAINED BY THE CITY OF ALBUQUERQUE. THE SITE CURRENTLY DRAINS AT 10% TO 1% FROM SOUTH TO NORTH.

HISTORICAL SITE RUNOFF OUTFALL LOCATIONS WILL REMAIN UNCHANGED. SINCE BOTH STREETS ARE IMPROVED ONLY MINIMAL GRADING (DRIVEPAD RECONSTR-N) IS PROPOSED WITHIN THE CITY R.O.W. FREE DISCHARGE OF DEVELOPED FLOW IS ACCEPTABLE SINCE THE TOTAL INCREASE OF DEVELOPED FLOW IS MINIMAL, AND CAPACITY EXISTS DOWNSTREAM.

THE GRADING AND DRAINAGE SCHEME MITIGATES IMPACT TO ADJACENT PROPERTY.

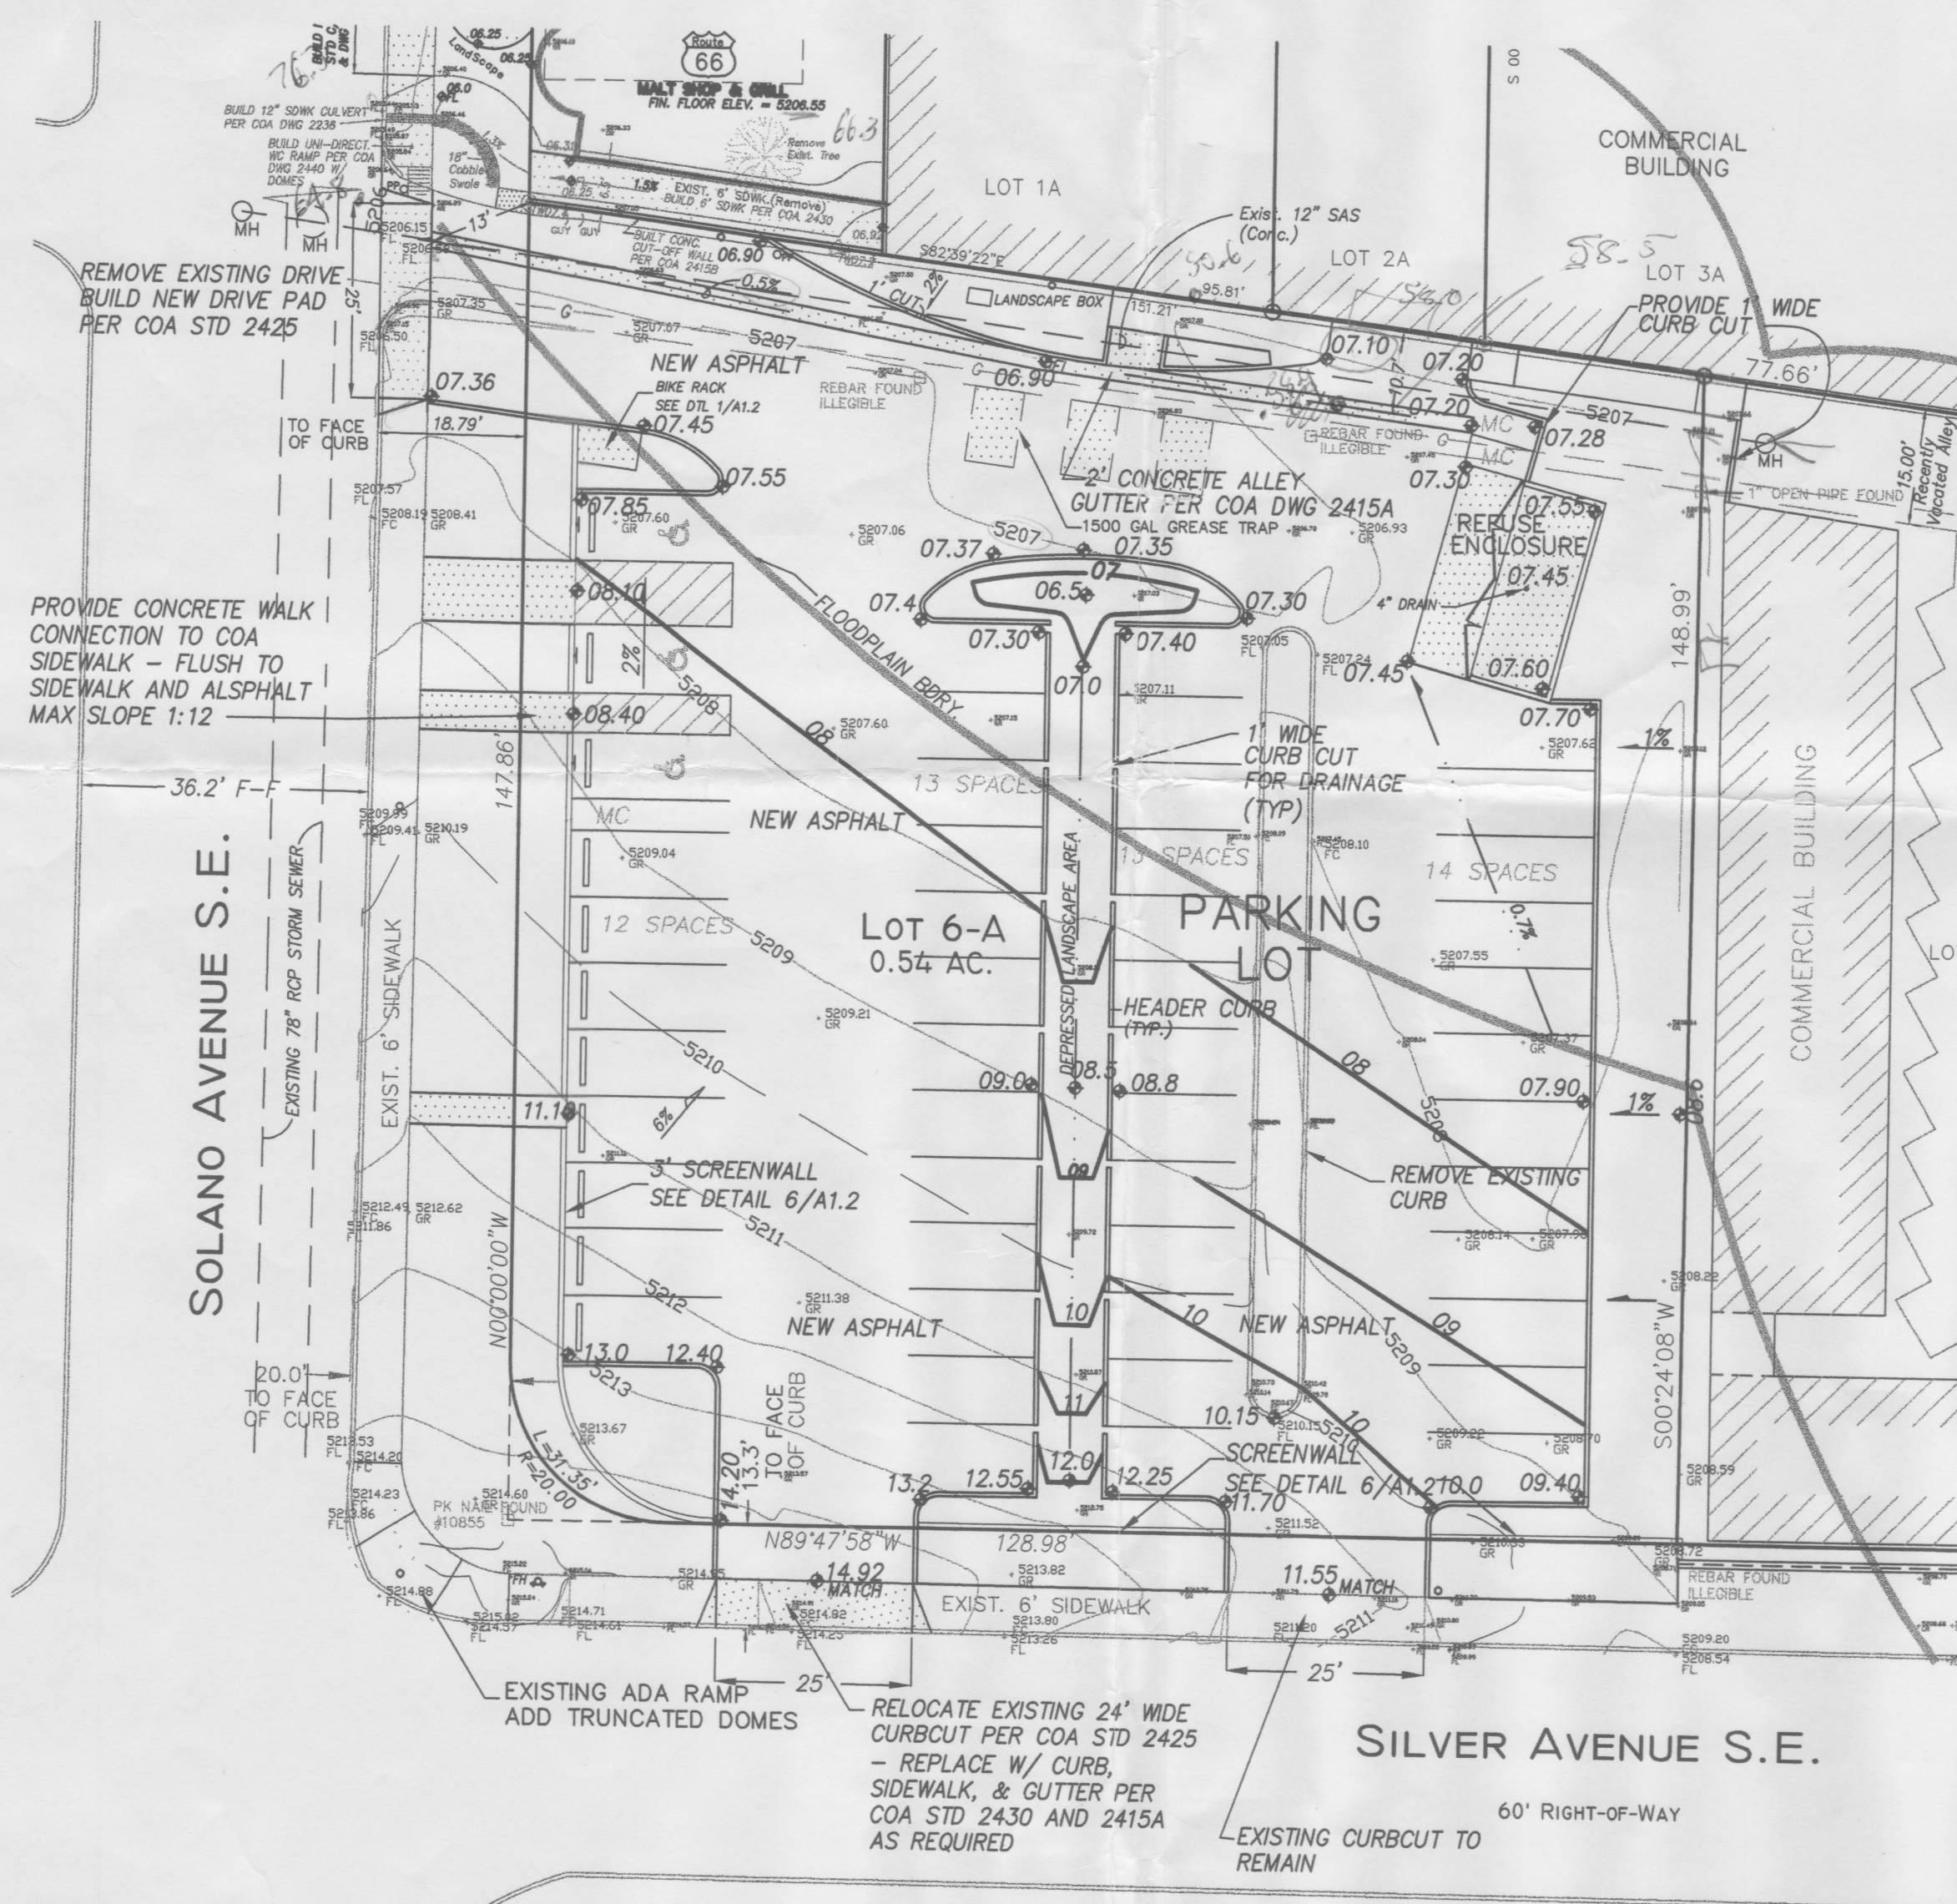

Scale: 1" = 20'

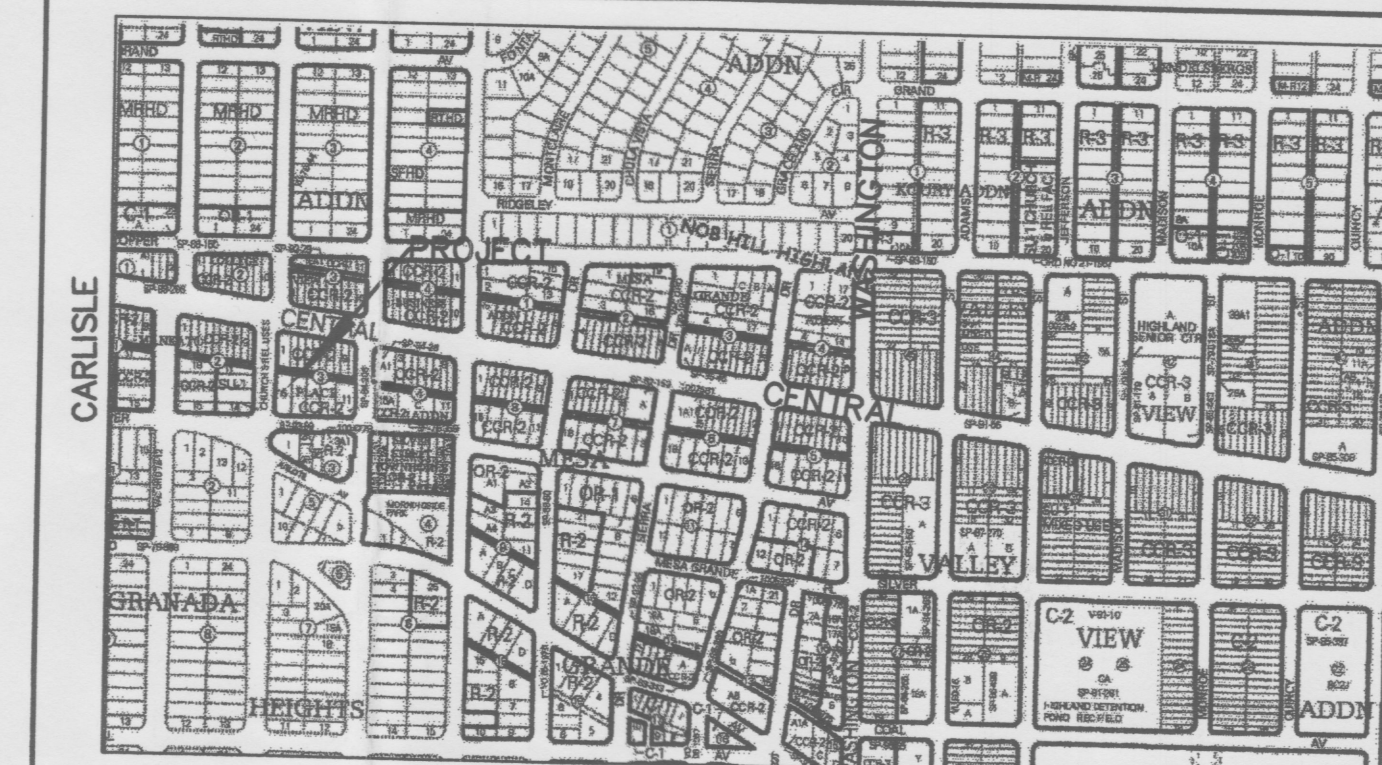

## VICINITY MAP



ZONE K-17

## NOTES

1. ALL WORK WITHIN THE RIGHT-OF-WAY SHALL BE CONSTRUCTED IN ACCORDANCE WITH THE CITY OF ALBUQUERQUE STANDARD SPECS. FOR PUBLIC WORKS CONSTRUCTION, 7TH EDITION W/ UPDATES.
2. AN EXCAVATION/CONSTRUCTION PERMIT IS REQUIRED BEFORE BEGINNING ANY WORK WITHIN CITY R.O.W. AN APPROVED COPY OF THIS PLAN MUST BE SUBMITTED AT THE TIME OF APPLICATION.
3. ALL WORK ON THIS PROJECT SHALL BE PERFORMED IN ACCORDANCE WITH APPLICABLE FEDERAL, STATE AND LOCAL LAWS, RULES, AND REGULATIONS CONCERNING CONSTRUCTION SAFETY AND HEALTH.
4. ALL LANDSCAPING AREA SHALL BE SOFT-LINED WITH NATIVE VEGETATION AND/OR GRAVEL ASPHALT PARKING AREA SHALL DRAIN DIRECTLY TO EXISTING CURB CUT.
5. CONTRACTOR SHALL ENSURE THAT NO SITE SOILS/SEDIMENT OR SILT ENTER THE RIGHT-OF-WAYS DURING CONSTRUCTION.
6. REVEGETATE ALL AREAS DISTURBED DUE TO CONSTRUCTION PER CITY OF ALBUQ. SPEC. 1011, NATIVE SEED MIX.
7. MAXIMUM SITE GRADING WITHOUT EROSION PROTECTION: 3 HORIZONTAL TO 1 VERTICAL, 3:1. ALL DIMENSIONS TO FACE OF CURB, UNLESS NOTED OTHERWISE.
8. REMOVE AND PULVERIZE EXISTING ASPHALT INTO 6" DEPTH SUBGRADE. COMPACT TO 95% MODIFIED PROCTOR, ASTM D 1557. SURFACE COURSE SHALL BE 3 INCH THICK ASPHALT CONCRETE, SUPERPAVE III.

## LEGEND

EXIST. SPOT ELEVATION	+24.0
EXIST. CONTOUR	10
NEW SPOT ELEVATION	+24.0
NEW CONTOUR	12
NEW SWALE	
DRAINAGE DIRECTION, EXISTING	
NEW CONCRETE CURB (0.5' HEIGHT)	
NEW P.C.C., CONCRETE	
TOP OF CURB, EXISTING	TC
FLOWLINE	FL
EXISTING POWER POLE	o
FACE OF CURB/FACE OF CURB	F-F
WATER BLOCK	

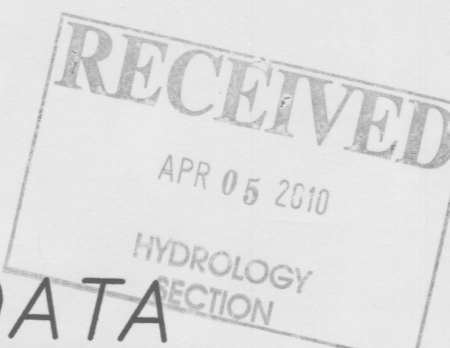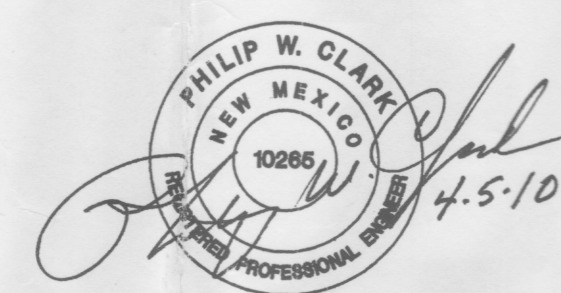

## PROJECT DATA

### LEGAL DESCRIPTION


LOT 6A, BLOCK 3, MANKATO PLACE ADDITION ALBUQUERQUE, BERNALILLO COUNTY, NEW MEXICO

### PROJECT BENCHMARK

TOP OF REBAR/CAP AT THE PROJECT NORTHWEST CORNER MSL ELEVATION = 5205.02, AS TIED FROM COA 1-3/4" DIAMETER BRASS DISK SET IN SIDEWALK, 5-K17A, MSL, NAVD 88, 5222.21, LOCATED 178' EAST OF THE INTERSECTION OF MORNINGSIDE AND CENTRAL AVENUE, SE.

### TOPOGRAPHIC DESIGN SURVEY

COMPILED BY CLARK CONSULTING ENGINEERS, DATE NOVEMBER 2009, FROM DATA COLLECTED BY THE SURVEY OFFICE, UNDER THE DIRECTION OF TONY HARRIS, P.S. OF HARRIS SURVEYING, INC.

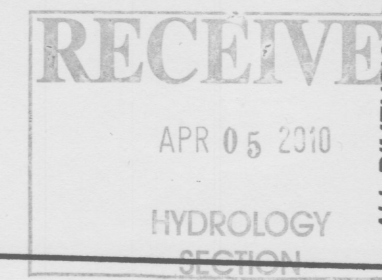

**Nob Hill**  
DEVELOPMENT CORP.  
Route 66  
MALT SHOP & GRILL  
MARTIN FM GRUMMER ARCHITECT  
331 WELLESLEY PLACE NE  
ALBUQUERQUE, NEW MEXICO 87108  
(505) 255-2507

### REVISIONS

NO.	DESCRIPTION

**BEAUTY COLLEGE PROJECT**  
**ROUTE 66 MALT SHOP & GRILL**  
**ALBUQUERQUE, NM 87108**  
**PARKING LOT GRADING & DRAINAGE PLAN**

ALL DIMENSIONS ARE TO BE FIELD VERIFIED. IF THERE ARE DISCREPANCIES, PLEASE NOTIFY THE ARCHITECT. DRAWING ARE NOT TO BE SCALED. USE DIMENSIONS FOR ACCURACY.

DATE: 01 APR 2010  
DRAWN BY: PWC/MFG  
CHECKED BY:  
VERIFIED BY:

**Clark Consulting Engineers**  
19 Ryan Road  
Edgewood, New Mexico 87015  
Tel: (505) 281-2444 Fax: (505) 281-2444

SHEET NO:  
**C1.2**  
PHASE 1



# GRADING & DRAINAGE PLAN

THE RETAIL RESTAURANT - COMMERCIAL PROJECT IS LOCATED IN THE MANKATO ADDITION OF ALBUQUERQUE APPROXIMATELY 3 MILES EAST OF THE DOWNTOWN CORE OF ALBUQUERQUE, NM. THE GRADING & DRAINAGE SCHEME HEREON IS IN COMPLIANCE WITH THE BERNALILLO COUNTY FLOOD HAZARD ORDINANCE, NO.88-46, AND THE CITY STORM DRAINAGE ORDINANCE. THE PLAN IS REQUIRED IN ORDER TO FACILITATE THE OWNER'S REQUEST FOR BUILDING PERMIT. THE PLAN SHOWS:


1. EXISTING CONTOURS, AND SPOT ELEVATIONS AND EXISTING DRAINAGE PATTERNS AND EXISTING IMPROVEMENTS: FORMER BUILDING, PARKING AREAS INCLDG. FLATWORK.
2. PROPOSED IMPROVEMENTS: 1200 SF BUILDING ADDITION, NEW CONCRETE DRIVEPADS AND OUTDOOR PATIO AREA, NEW GRADE ELEVATIONS, FLATWORK AND LANDSCAPING.
3. CONTINUITY BETWEEN EXISTING AND PROPOSED ELEVATIONS.
4. QUANTIFICATION AND ACCEPTANCE OF UPSTREAM OFF-SITE FLOWS WHICH CONTRIBUTE TO THE DEVELOPED FLOWS GENERATED BY THE IMPROVEMENTS.

THE PURPOSE OF THE PLAN IS TO ESTABLISH CRITERIA FOR CONTROLLING STORM RUNOFF AND EROSION, AND ESSENTIALLY ALLOWING HISTORIC FLOWS TO CONTINUE TO DRAIN THROUGH THE PROPERTY. PRESENTLY, THE SITE IS BOUNDED ON THE SOUTH BY COMMERCIAL-USE ASPHALT PARKING, TO THE EAST BY COMMERCIAL USE. CENTRAL AVENUE & SOLANO STREET ON THE NORTH AND WEST ARE PAVED WITH CURB, GUTTER AND SIDEWALK, AND MAINTAINED BY THE CITY OF ALBUQUERQUE. THE SITE CURRENTLY DRAINS AT 1% FROM SOUTH TO NORTH.

HISTORICAL SITE RUNOFF OUTFALL LOCATIONS WILL REMAIN UNCHANGED. SINCE BOTH STREETS ARE IMPROVED ONLY MINIMAL GRADING (DRIVEPAD RECONSTR-N) IS PROPOSED WITHIN THE CITY R.O.W. FREE DISCHARGE OF DEVELOPED FLOW IS ACCEPTABLE SINCE THE TOTAL INCREASE OF DEVELOPED FLOW IS MINIMAL, AND CAPACITY EXISTS DOWNSTREAM.

THE SITE IS NOT IMPACTED ADVERSELY BY ANY OFF-SITE DRAINAGE FLOWS.

*no runoff of flood plan*

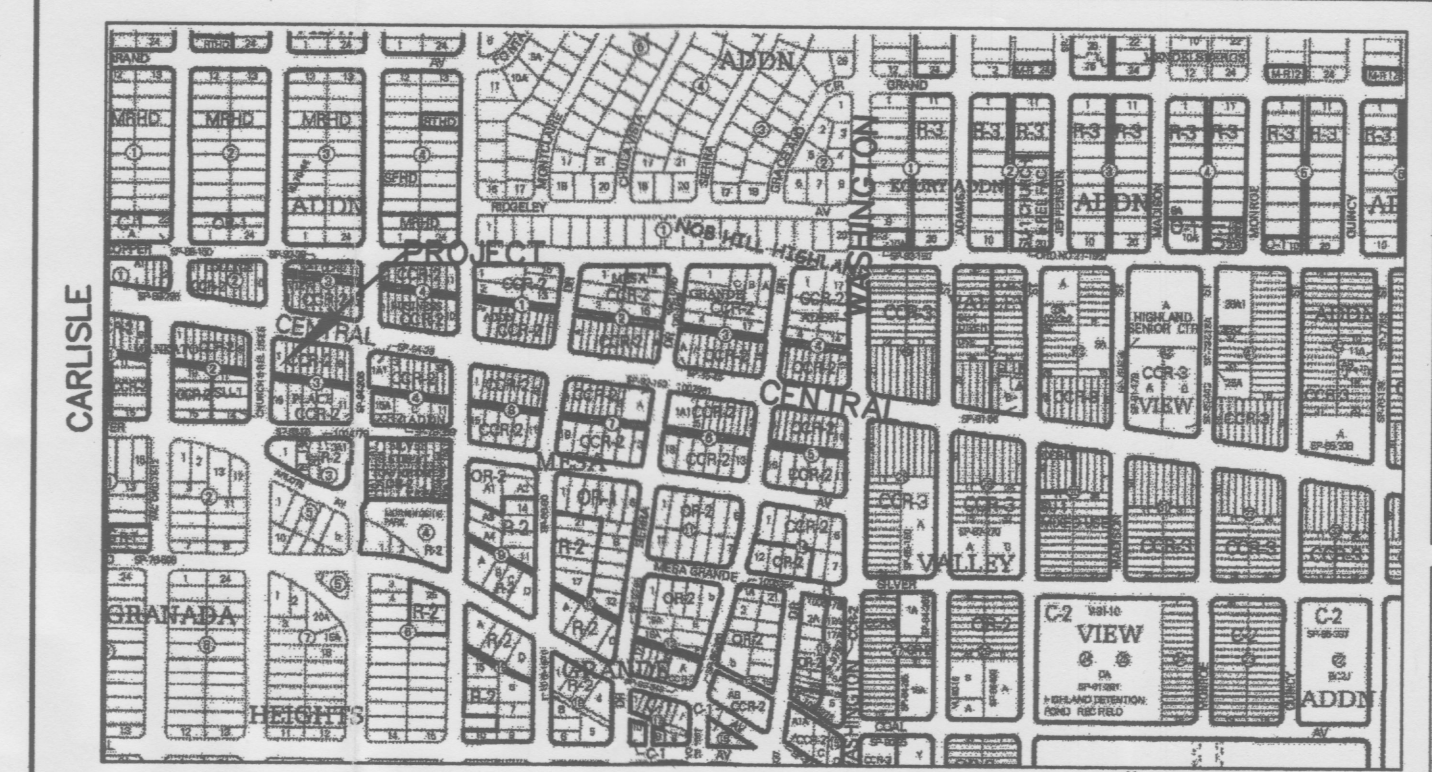

## VICINITY MAP

1" = 350'


## NOTES

1. ALL WORK WITHIN THE RIGHT-OF-WAY SHALL BE CONSTRUCTED IN ACCORDANCE WITH THE CITY OF ALBUQUERQUE STANDARD SPECS. FOR PUBLIC WORKS CONSTRUCTION, 7TH EDITION W/ UPDATES.
2. AN EXCAVATION/CONSTRUCTION PERMIT IS REQUIRED BEFORE BEGINNING ANY WORK WITHIN CITY R.O.W. AN APPROVED COPY OF THIS PLAN MUST BE SUBMITTED AT THE TIME OF APPLICATION.
3. ALL WORK ON THIS PROJECT SHALL BE PERFORMED IN ACCORDANCE WITH APPLICABLE FEDERAL, STATE AND LOCAL LAWS, RULES, AND REGULATIONS CONCERNING CONSTRUCTION SAFETY AND HEALTH.
4. ALL LANDSCAPING AREA SHALL BE SOFT-LINED WITH NATIVE VEGETATION AND/OR GRAVEL ASPHALT PARKING AREA SHALL DRAIN DIRECTLY TO EXISTING CURB CUTS.
5. CONTRACTOR SHALL ENSURE THAT NO SITE SOILS/SEDIMENT OR SILT ENTER THE RIGHT-OF-WAYS DURING CONSTRUCTION.
6. REVEGETATE ALL AREAS DISTURBED DUE TO CONSTRUCTION PER CITY OF ALBUQ. SPEC. 1011, NATIVE SEED MIX.
7. MAXIMUM SITE GRADING WITHOUT EROSION PROTECTION: 3 HORIZONTAL TO 1 VERTICAL. 3:1. ALL DIMENSIONS TO FACE OF CURB, UNLESS NOTED OTHERWISE.

- ① REMOVE EXISTING CONCRETE SLABS
- ② CLOSE EXISTING DRIVEPAD AND BUILD STD. C/G PER COA 2415 REPAIR SDWK. PER COA 2430

## LEGEND

EXIST. SPOT ELEVATION	+24.0
EXIST. CONTOUR	10
NEW SPOT ELEVATION	24.0
NEW CONTOUR	12
NEW SWALE	
DRAINAGE DIRECTION, EXISTING	
NEW CONCRETE CURB (0.5' HEIGHT)	
NEW P.C.C., CONCRETE	
TOP OF CURB, EXISTING	TC
FLOWLINE	FL
EXISTING POWER POLE	
FACE OF CURB/FACE OF CURB	F-F
WATER BLOCK	

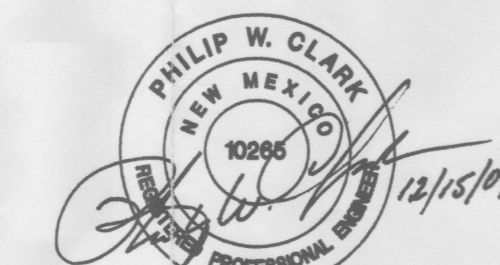

## PROJECT DATA

RECEIVED  
DEC 15 2009

### LEGAL DESCRIPTION

LOT 1, BLOCK 3, MANKATO PLACE ADDITION ALBUQUERQUE, BERNALILLO COUNTY, NEW MEXICO

### PROJECT BENCHMARK

TOP OF REBAR/CAP AT THE PROJECT NORTHWEST CORNER MSL ELEVATION = 5205.02, AS TIED FROM COA 1-3/4" DIAMETER BRASS DSK SET IN SIDEWALK, 5-K17A, MSL, NAVD 88, 5222.21, LOCATED 178' EAST OF THE INTERSECTION OF MORNINGSIDE AND CENTRAL AVENUE, SE.

### TOPOGRAPHIC DESIGN SURVEY

COMPILED BY CLARK CONSULTING ENGINEERS, DATE NOVEMBER 2009, FROM DATA COLLECTED BY THE SURVEY OFFICE, UNDER THE DIRECTION OF TONY HARRIS, P.S. OF HARRIS SURVEYING, INC.



**Clark Consulting Engineers**  
19 Ryan Road  
Edgewood, New Mexico 87015

Tele: (505) 281-2444

Fax: (505) 281-2444

**Nob Hill**  
DEVELOPMENT CORP.

Route 66  
MALT SHOP & GRILL

MARTIN FM GRUMMER  
ARCHITECT  
331 WELLESLEY PLACE NE  
ALBUQUERQUE, NEW MEXICO 87106  
(505) 285-2007

## REVISIONS

BEAUTY COLLEGE PROJECT  
ROUTE 66 MALT SHOP & GRILL  
ALBUQUERQUE, NM 87108  
GRADING & DRAINAGE PLAN


DATE:  
DRAWN BY:  
CHECKED BY:  
VERIFIED BY:

DESIGNS BY  
**JAF CONCEPTS**  
(505) 315-9644

SHEET NO:

**C1.1**  
PHASE 1

ALL DIMENSIONS ARE TO BE FIELD VERIFIED. IF THERE ARE DISCREPANCIES, PLEASE NOTIFY THE ARCHITECT. DRAWING ARE NOT TO BE SCALED. USE DIMENSIONS FOR ACCURACY.

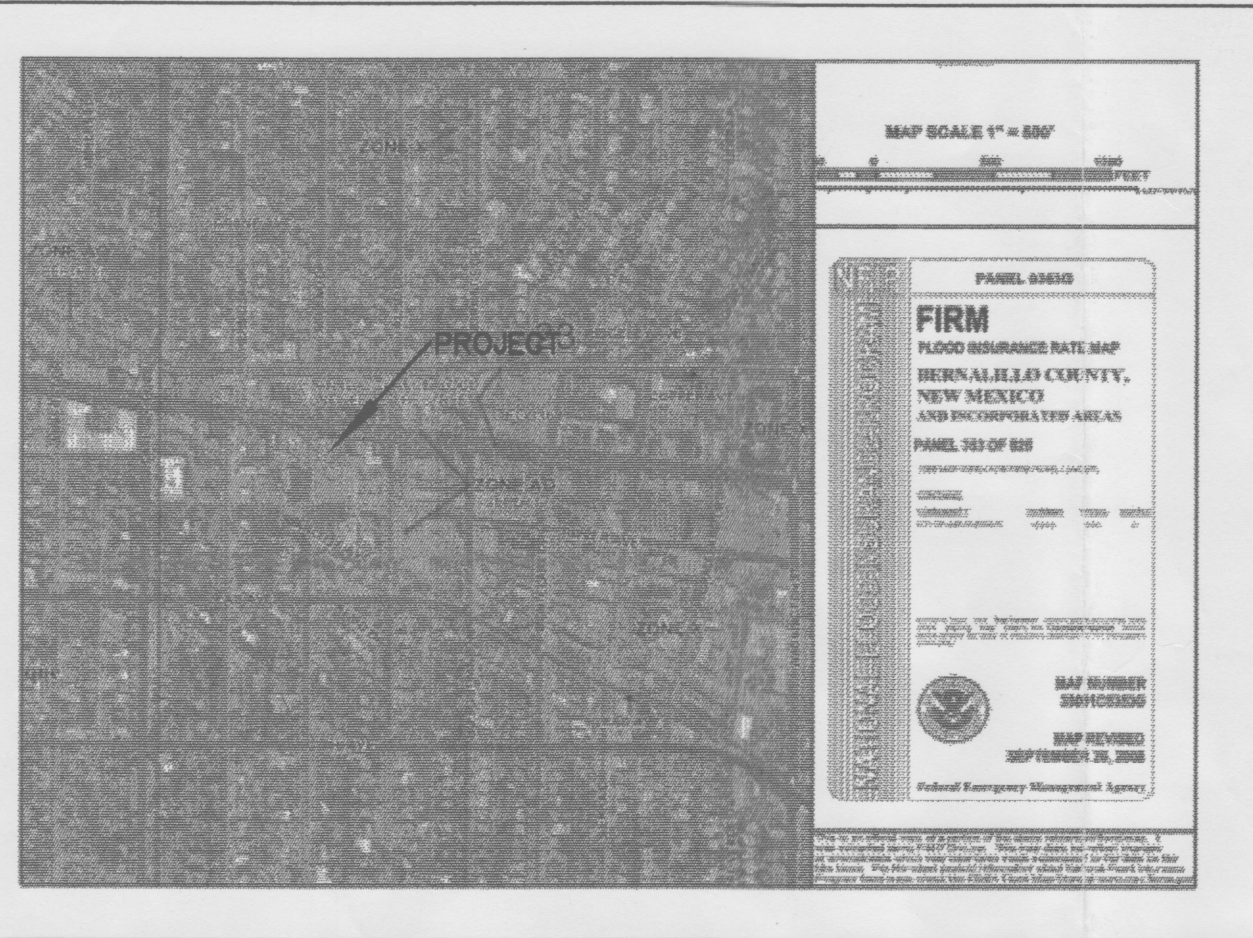

## FIRM MAP

PANEL # 353 G

SUBJECT PROPERTY IS ADJACENT TO A FLOOD HAZARD ZONE.

## CALCULATIONS

### DESIGN CRITERIA

HYDROLOGIC METHODS PER SECTION 22.2, HYDROLOGY OF THE DEVELOPMENT PROCESS MANUAL (DPM) REVISED JANUARY 1993 FOR CITY OF ALBUQUERQUE ADOPTED BY THE COUNTY OF BERNALILLO  
DISCHARGE RATE:  $Q = Q_{PEAK} \times AREA$ , "Peak Discharge Rates For Small Watersheds"  
VOLUMETRIC DISCHARGE:  $VOLUME = E_{WEIGHTED} \times AREA$   
P100 = 2.35 Inches, Zone 2 Time of Concentration, TC = 10 Minutes  
DESIGN STORM: 100-YEAR/6-HOUR, 10-YEAR/6-HOUR [ ] = 10 YEAR VALUES

### EXISTING CONDITIONS

50% 'C', 50% 'D'  
TOTAL AREA = 0.13 ACRES, WHERE EXCESS PRECIP. 'W' = 1.63 in. [0.93]  
PEAK DISCHARGE, Q100 = 0.51 CFS [0.31] WHERE UNIT PEAK DISCHARGE 'W' = 3.9 CFS/AC. [2.4]  
THEREFORE:  $VOLUME_{100} = 769 CF [439]$

### DEVELOPED CONDITIONS

DETERMINE LAND TREATMENTS, PEAK DISCHARGE AND VOLUMETRIC DISCHARGE FOR STUDY AREA


	AREA	LAND TREATM'T	Q Peak	E
UNDEVELOPED	--- Ac.	A	1.56[0.38]	0.53[0.13]
LANDSCAPING	0.01 Ac.	B	2.28[0.95]	0.78[0.28]
GRAVEL & COMPACTED SOIL	0.02 Ac.	C	3.14[1.71]	1.13[0.52]
ROOF - PAVEMENT	0.10 Ac.	D	4.70[3.14]	2.12[1.34]
	0.13 Ac.			

THEREFORE:  $E_{WEIGHTED} = 1.86 in. [1.13]$  &  
 $Q_{100} = 0.55 CFS$  &  $VOLUME_{100} = 877 CF$   
 $Q_{10} = 0.35 CFS$  &  $VOLUME_{10} = 533 CF$

RECOMMEND : ROUTE DEVELOPED RUNOFF THROUGH SOFT LANDSCAPING

SOLANO AVENUE S.E.

75' RIGHT-OF-WAY

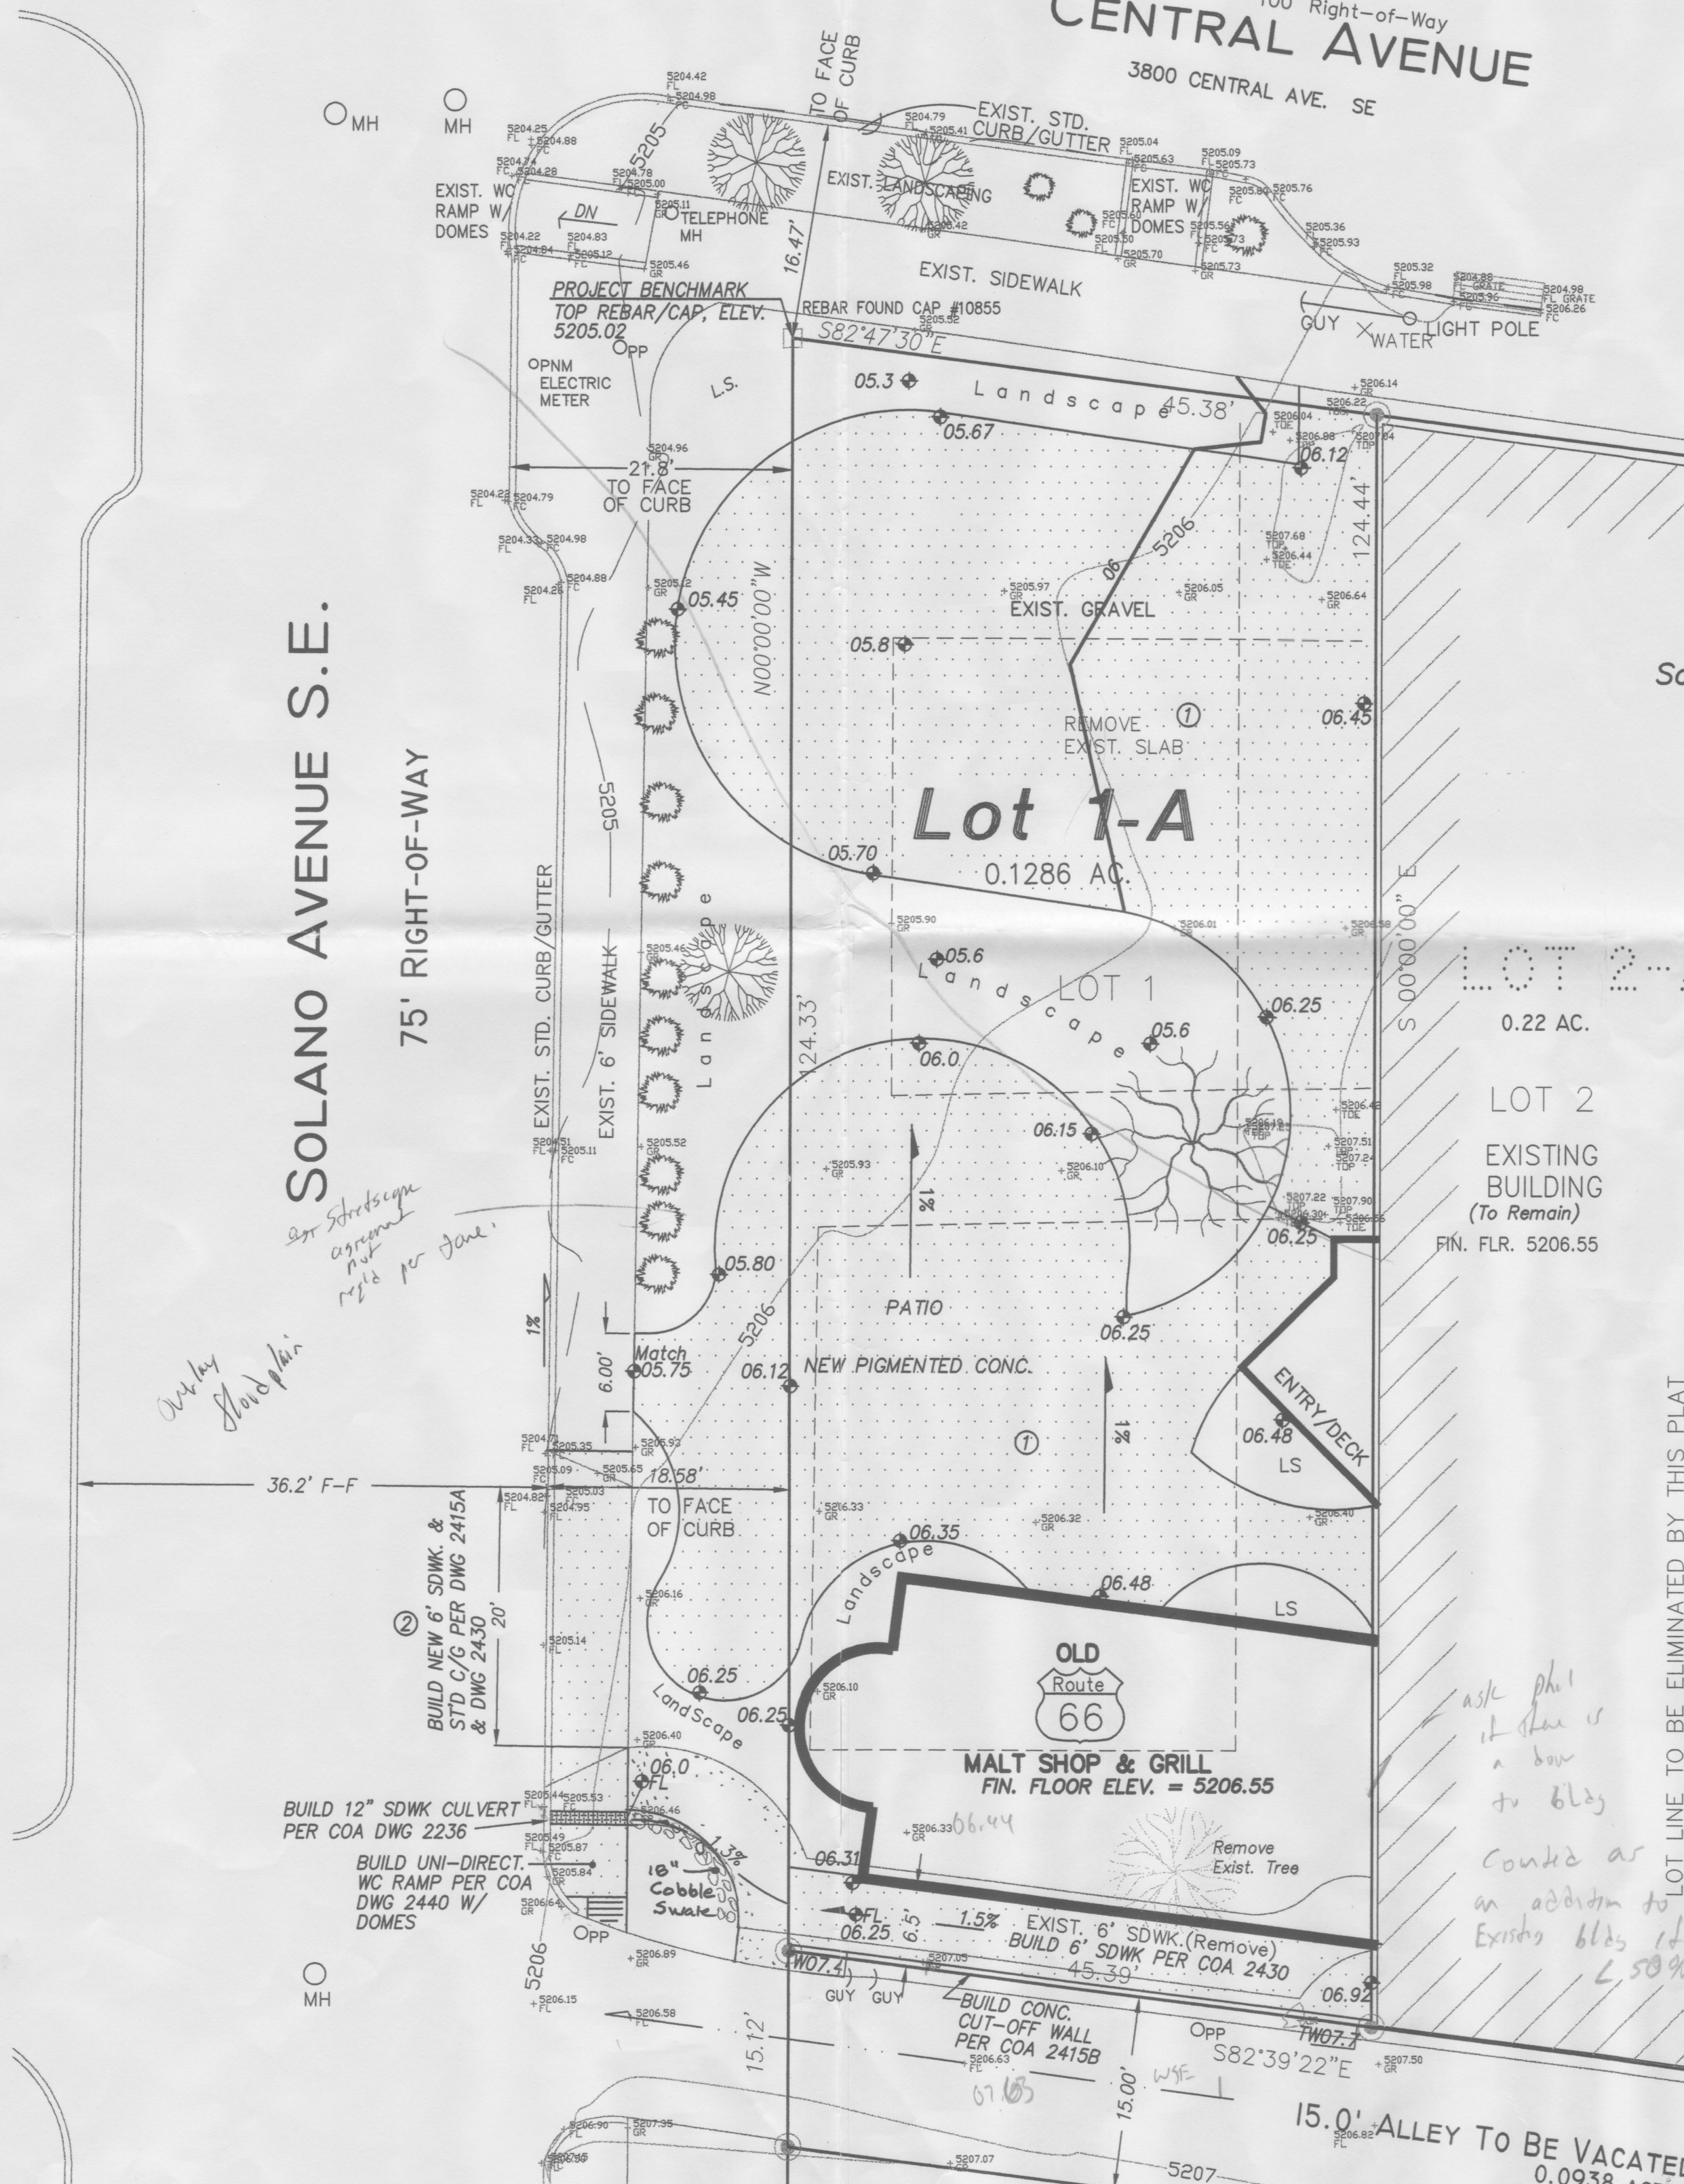

LOT LINE TO BE ELIMINATED BY THIS PLAT

I, PHILIP W. CLARK, A PROFESSIONAL ENGINEER LICENSED IN ACCORDANCE WITH THE LAWS OF THE STATE OF NEW MEXICO, DO HEREBY CERTIFY THAT I HAVE VISITED THE SITE SHOWN HEREON, AND THAT THE CONTOURS SHOWN REPRESENT THE EXISTING GROUND CONDITIONS, AND DO FURTHER CERTIFY THAT NO EARTHWORK OF ANY KIND, NOR ANY DISTURBANCE OF THE EXISTING GROUND HAS OCCURRED ON THIS SITE SINCE THE CONTOURS WERE DETERMINED.

*PhC*

PHILIP W. CLARK NMPE #10265