

# CITY OF ALBUQUERQUE



January 23, 2020

Dave Aube, P.E.  
The Design Group  
120 Vassar Dr. SE  
Albuquerque, NM 87106

**Re: De Anza, Bldg. G**  
**4301 Central Ave NE**  
**30-Day Temporary Certificate of Occupancy**  
**Transportation Development Final Inspection**  
Engineer's/Architect's Stamp dated 12-25-17 (K17D106)  
Certification dated 1-17-20

Dear Mr. Aube,

Based upon the information provided in your submittal received 1-21-20, Transportation Development has no objection to a 30-day Temporary Certificate of Occupancy based. This letter serves as a "green tag" from Transportation Development for a 30-day Temporary Certificate of Occupancy to be issued by the Building and Safety Division.

Prior to the issuance of a permanent Certificate of Occupancy, the following items must be addressed:

- Van ADA access aisle is missing ramp. Please add ramp or relocate ADA stall and access aisle. (See attached photos)
- Please stamp and date the certification language on the TCL Plan.

Once corrections are complete resubmit

1. The approved and stamped TCL with changes drawn in red.
2. Transportation Certification letter on either the plan or applicants letterhead.
3. A Drainage Transportation Information Sheet (DTIS)
4. Send an electronic copy of your submittal to [PLNDRS@cabq.gov](mailto:PLNDRS@cabq.gov).
5. The \$75 re-submittal fee for log in and evaluation by Transportation.

If you have any questions, please contact me at (505) 924-3981.

Sincerely,

Ernie Gomez, 

Plan Checker, Planning Dept.

Development Review Services

EG via: email

C: CO Clerk, File

PO Box 1293

Albuquerque

NM 87103

[www.cabq.gov](http://www.cabq.gov)





Certification is for Building G Only. A separate certification has already been filed for the remaining portions of the site

Drainage Certification (K17D106)

I, David A Aube, NMPE 14221, of the firm The Hartman + Majewski Design Group, Inc, hereby certify that Building G (located on Tract D) of the De Anza project (4301 Central Avenue NE) is in substantial compliance with and in accordance with the design intent of the Traffic Circulation Layout plan approved plan dated 12/23/17. The record information that has been edited onto the original design documents where obtained by Sandia Land Surveying LLC (Andrew Martinez NM PS # 12649). I further certify that I have personally visited the project site on January 17, 2020 and have determined by visual inspection that the actual site conditions shown on this plan to be true and correct to the best of my knowledge and belief. This certification is submitted in support of a request for Permanent Certificate of Occupancy for Building G, located on Tract D of the De Anza Project located at 4301 Central Avenue NE.


The record information presented hereon is not necessarily complete and intended only to verify substantial compliance of the drainage aspects of this project. Those relying on the record documents are advised to obtain independent verification of its accuracy before using it for any other purpose.

PEDESTRIAN ACCESS AND UTILITY EASEMENT FOR THE BENEFIT OF LOTS A, C AND D

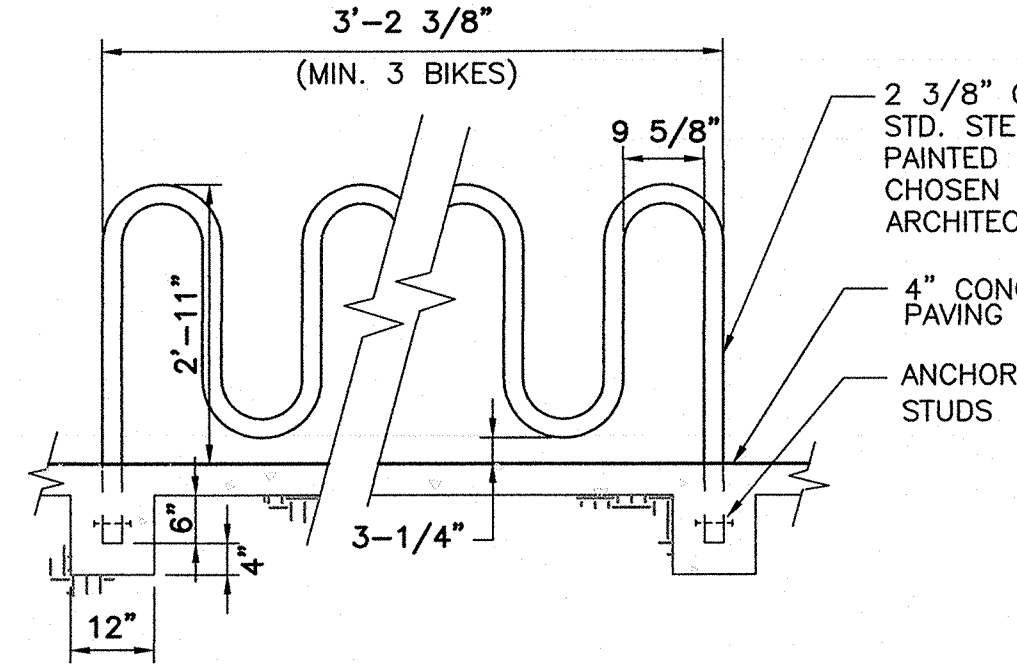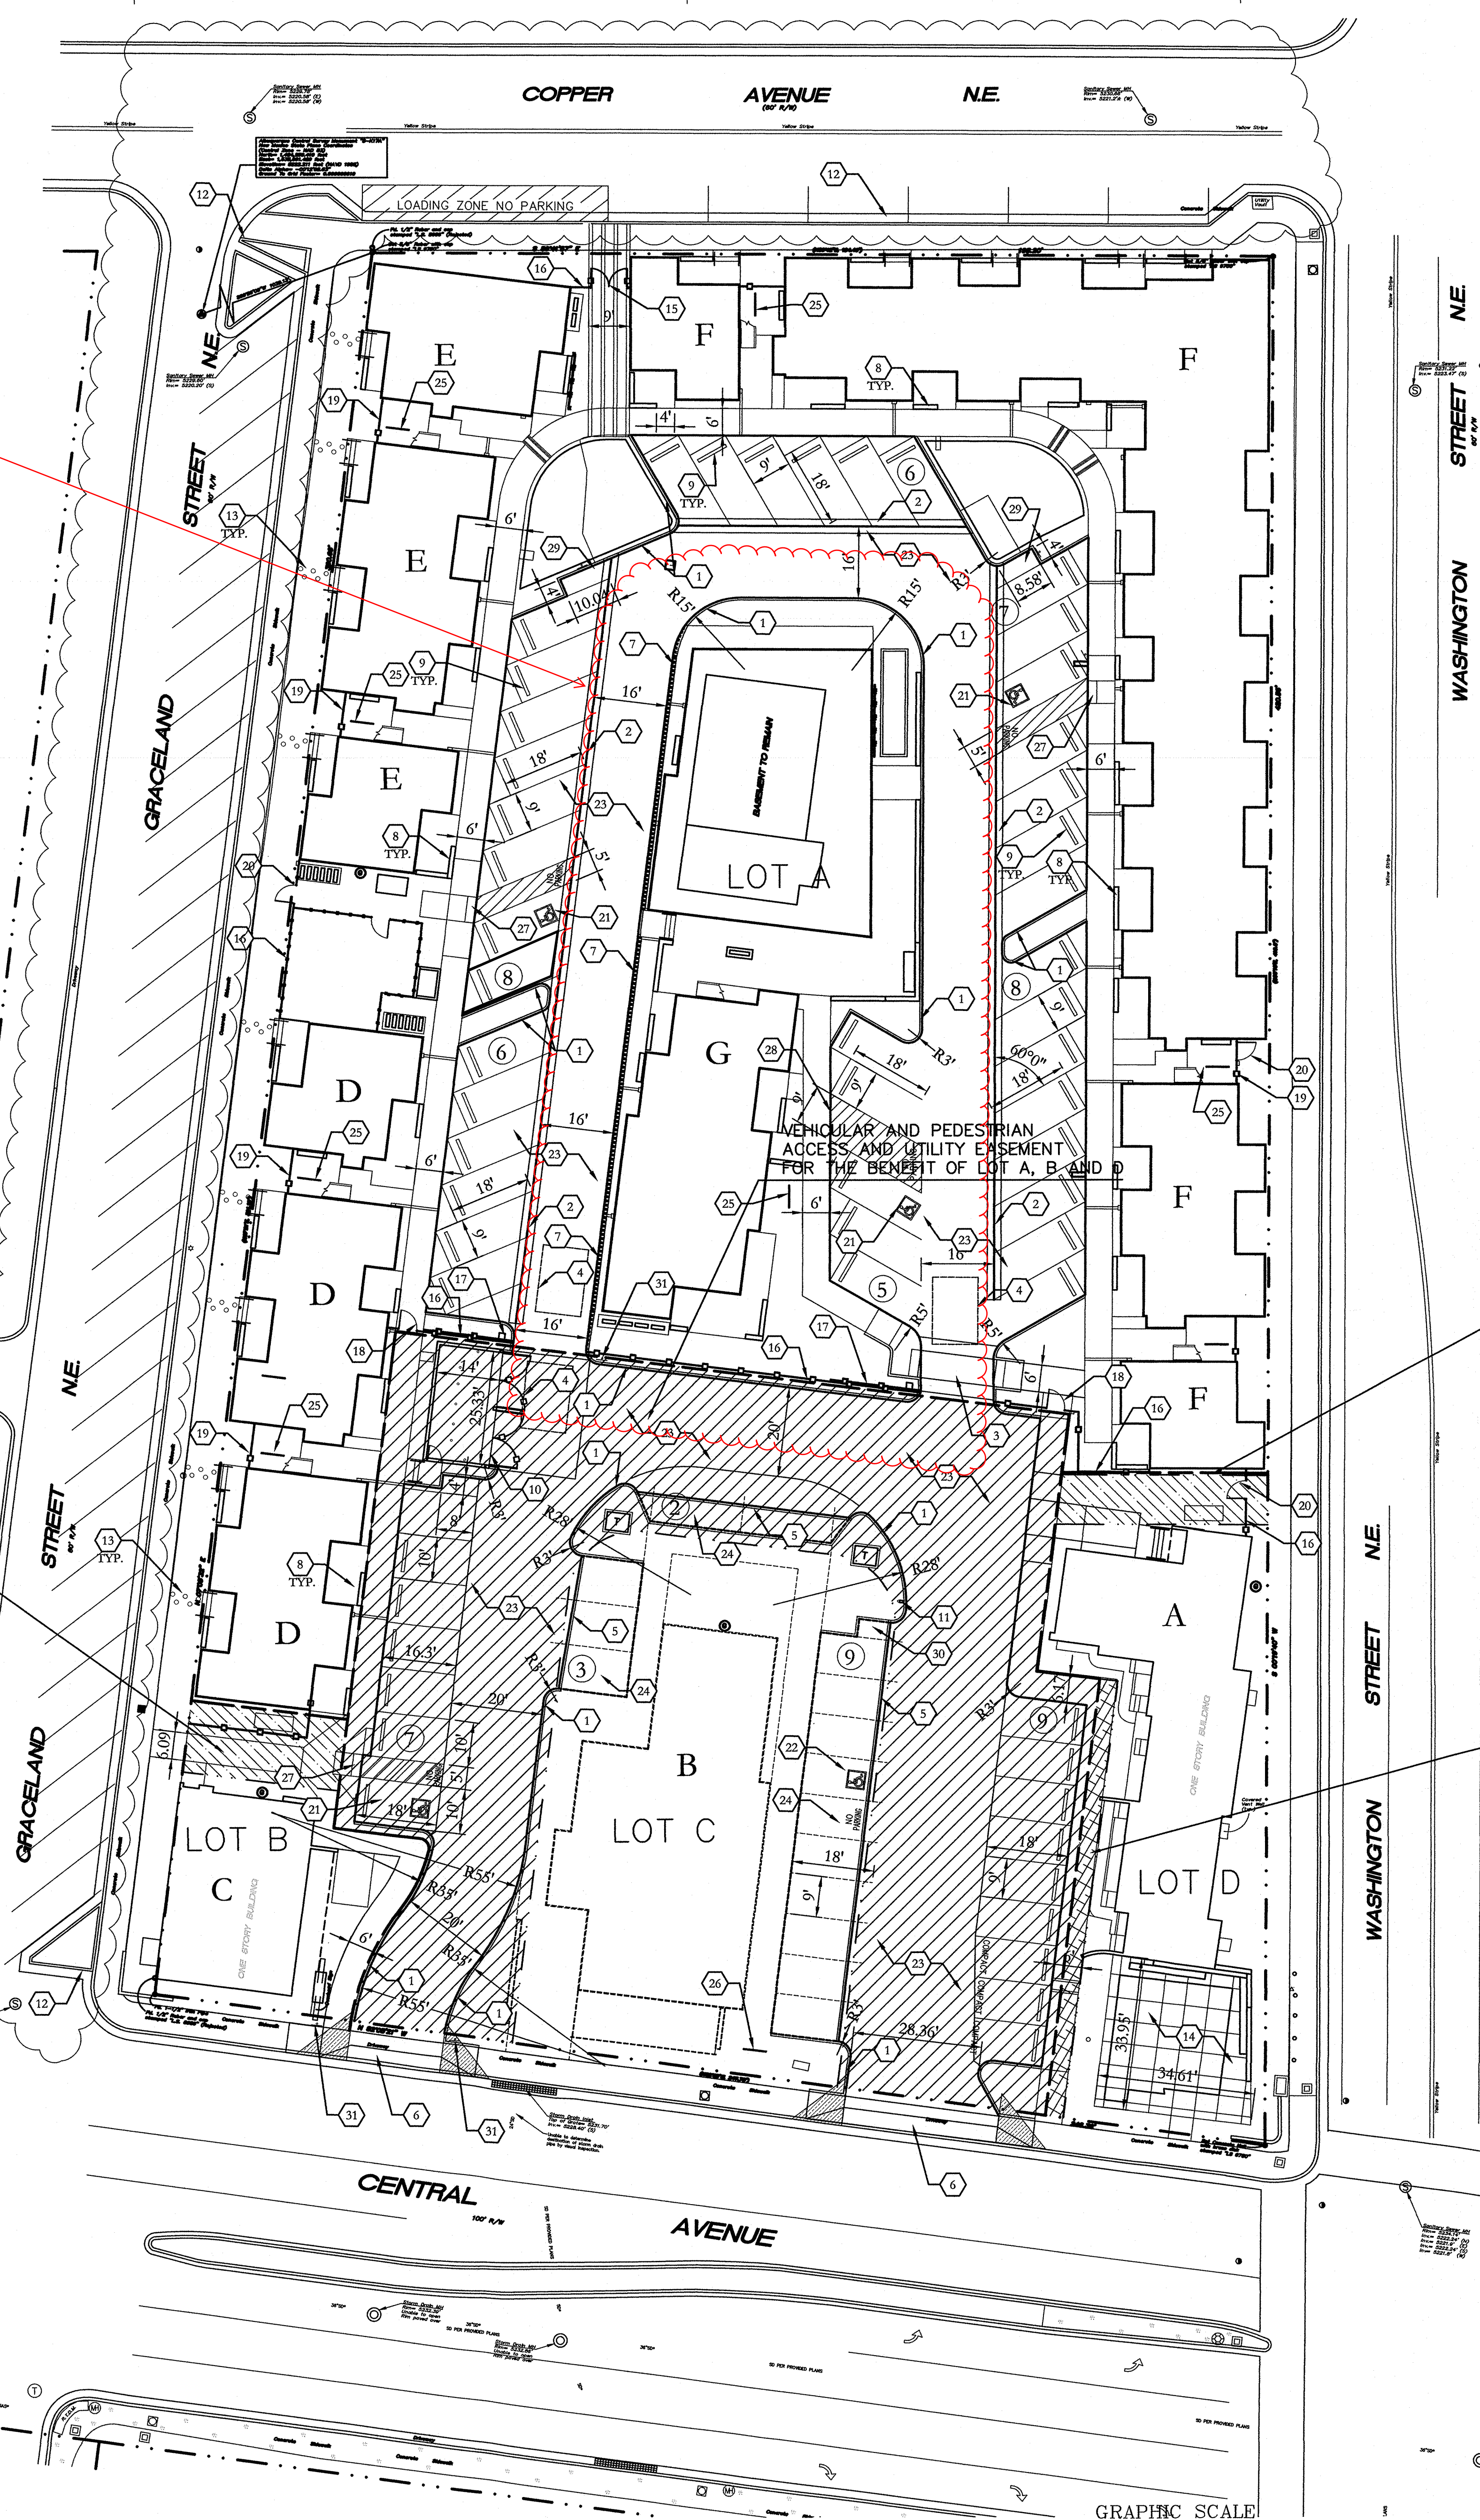

BICYCLE RACK  
NOT TO SCALE

PEDESTRIAN ACCESS AND UTILITY EASEMENT FOR THE BENEFIT OF LOTS A, B AND C

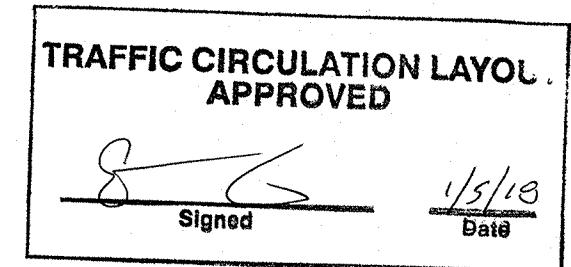

PEDESTRIAN ACCESS EASEMENT FOR THE BENEFIT OF LOTS A, B AND C

- PHASING PLAN:
- PHASE 1 INCLUDES REBUILDING/REMODELING BUILDINGS "A" AND "C". THESE BUILDINGS ARE THE HISTORIC HOTEL LOCATED IN THE SOUTH EAST CORNER OF THE SITE AND THE FORMER TURQUOISE CAFE LOCATED IN THE SOUTH WEST CORNER OF THE SITE.
  - PHASE 2 WILL BE TO CONSTRUCT THE NEW RESIDENTIAL BUILDINGS ALONG HE NORTH MOTOR COURT. THESE BUILDINGS ARE IDENTIFIED WITH LETTERS "D" THROUGH "G".
  - A FUTURE BUILDINGS WILL BE CONSTRUCTED ONCE A BUYER/TENMANT IS FOUND FOR THE MIDDLE BUILDING (IDENTIFIED AS "B") ALONG CENTRAL AVENUE.

TCL KEYED NOTES


- CONCRETE HEADER CURB, 6" TALL
- CONCRETE VALLEY GUTTER
- CONCRETE CROSS WALK/SPEED TABLE ELEVATED 4" FROM DRIVE SURFACE
- LOOP DETECTOR FOR VEHICLE GATES.
- TEMPORARY ASPHALT EXTRUDED CURB AROUND FUTURE BUILDING PAD SITE.
- EXISTING CONCRETE DRIVEPAD CONSTRUCTED UNDER A.R.T. PROJECT TO REMAIN.
- 16" TALL HEADER CURB, 8" WIDE, TO PROVIDE PROTECTION TO BUILDING FROM VEHICLES BACKING UP.
- PLANTER BOX TO SEPARATE SIDEWALK FROM PORCH. TYPICAL ON ALL INTERIOR PORCH/STOOP ALONG MOTOR COURT.
- CONCRETE PARKING BLOCK.
- REFUSE ENCLOSURE WITH GATES.
- KEY PAD TO CONTROL VEHICLE GATES.
- CURB TO BE REALIGNED UNDER COA PROJECT NUMBER 9043.15 THAT HAS ALREADY BEEN APPROVED BY DRC.
- PAVERS BETWEEN PUBLIC SIDEWALK AND SECONDARY ENTRANCE TO RESIDENTIAL UNITS ALONG GRACELAND STREET NE.
- CONCRETE SIDEWALK WITH MAP OF NEW MEXICO FOR TOURIST ATTRACTION.
- DOUBLE 3' WIDE BY 6' TALL PERSONNEL GATES IN PERIMETER FENCING.
- 6' TALL PERIMETER FENCING.
- 6' TALL BY 16' WIDE SLIDING GATE FOR VEHICLE ACCESS.
- 3' WIDE BY 6' TALL PERSONNEL GATE.
- PERIMETER FENCING TO ABOVE THE STAIR LANDINGS.
- FIRE DEPARTMENT ACCESS GATE IN PERIMETER FENCING.
- ADA PARKING STALL WITH RESERVED PARKING SYMBOL AND RESERVED PARKING SIGN.
- FUTURE ADA PARKING TO BE CONSTRUCTED WITH FUTURE BUILDING.
- ASPHALT PAVEMENT.
- FUTURE ASPHALT PAVEMENT.
- BIKE RACK FOR A MINIMUM OF 3 BIKES.
- FUTURE BIKE RACK, MINIMUM OF 3 BIKES.
- CURB ACCESS RAMP.
- SIDEWALK IS FLUSH WITH PARKING LOT SURFACE.
- MOTOR CYCLE PARKING SPACE AND "MOTOR CYCLE PARKING" SIGN.
- FUTURE MOTOR CYCLE PARKING SPACE AND "MOTOR CYCLE PARKING" SIGN TO BE CONSTRUCTED WITH FUTURE BUILDING.
- PROVIDE "DO NOT ENTER" SIGN AND SIGN POST.

SIGN TYPE R7-8 (12"x18")  
-sign field is white  
-sign lettering and border are green  
-International Symbol of Accessibility is white on a blue background

Required language per NMSA 197866-7-352.4C

SIGN TYPE R7-8a (6"x12")  
-sign field is white  
-sign lettering and border are green

Required language (Van Accessible Spaces) per ANSI 502.7

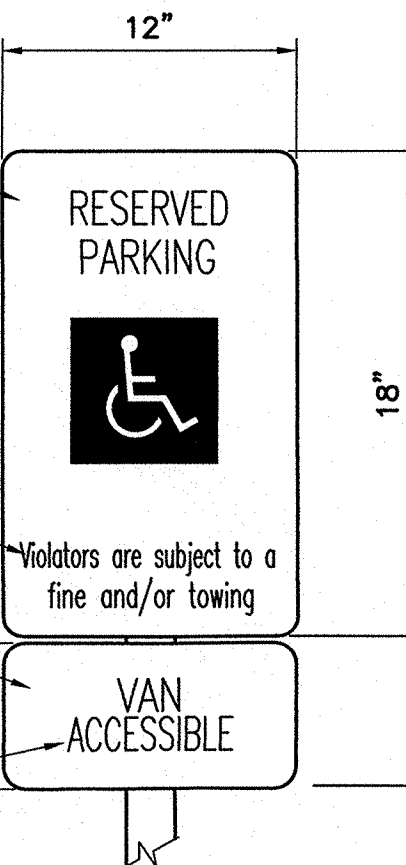

Non-Van Accessible Spaces bottom of this sign 84" min. above the ground per ANSI 502.7

Van Accessible Spaces bottom of this sign 84" min. above the ground per ANSI 502.7

RESERVED PARKING SIGNS  
NOT TO SCALE

ADD ADDITIONAL SIGN BELOW RESERVED PARKING SIGN OR VAN ACCESSIBLE SIGN THAT READS "VIOLATORS ARE SUBJECT TO A FINE AND/OR TOWING"

ACCESS AISLES AT ADA PARKING SPACES THAT BE LABELED WITH "NO PARKING"



K-17-Z ZONE ATLAS PAGE

SCALE: NOT TO SCALE

PROJECT TABULATED PARKING COUNTS

Building	Use	SF	Number of Units	Req'd Parking	After Transit Reduction	On Site Parking	HC Req'd	HC Provided	MC Req'd	MC Provided	Bicycle Req'd	Bicycle Provided
A	Office	2378	0	0	0	0	0	0	0	0	0	0
B	Office	3500	0	17.5	15.75	30	2	2	1	1	1	2
C	Office	1295	0	0	0	0	0	0	0	0	0	0
D	Residential		9	9	8.1	9	1	1	0	0	4.5	6
E	Residential		8	8	7.2	8	1	1	1	1	4	6
F	Residential		19	19	17.1	19	1	1	1	1	9.5	9
G	Residential		4	4	3.6	4	0	0	0	0	2	3
Total				40	57.5	51.75	70	5	5	3	3	26

- Notes:
- Parking required 1 space per bath, but no less than 1.0 dwelling unit per Nob Hill Sector Development Plan.
  - Bicycle parking required, 1 per 2 dwelling units.
  - Motorcycle parking required 1 space per 25 off street parking.
  - Office Buildings less than 3000 sf do not require parkin per Nob Hill Sector Development Plan.




THE HARTMAN + MAJEWSKI  
**DESIGN GROUP**  
Architects • Engineers • Interior Design  
Planners • Urban Designers • LEED®

120 Vassar Dr SE Suite 100  
Albuquerque, New Mexico 87106  
T 505 242 6880 • F 505 242 6881

CONSULTANT

STAMP

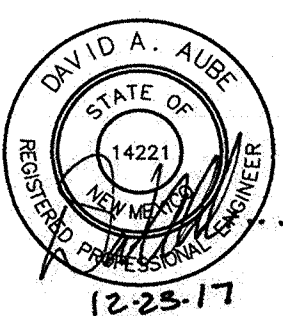

100% CONSTRUCTION  
DOCUMENT SUBMITTAL

PROJECT NAME

DE ANZA MOTOR LODGE

4301 CENTRAL AVENUE NE  
ALBUQUERQUE, NM 87108

REVISIONS

NO.	DATE	DESCRIPTION

Copyright: Design Group

Drawn by DAA

Checked by DAA

Date OCTOBER 25, 2017

Project number 2500

SHEET TITLE

TRAFFIC CIRCULATION  
LAYOUT

SHEET NUMBER

TCL





RESERVED  
PARKING



Persons are subject to a  
fine and/or towing  
NASSA 1-877-3-333-AC

VAN  
ACCESSIBLE

Jobsite Office





# City of Albuquerque

Planning Department

Development & Building Services Division

## DRAINAGE AND TRANSPORTATION INFORMATION SHEET (REV 11/2018)

**Project Title:** \_\_\_\_\_ **Building Permit #:** \_\_\_\_\_ **Hydrology File #:** \_\_\_\_\_

**DRB#:** \_\_\_\_\_ **EPC#:** \_\_\_\_\_ **Work Order#:** \_\_\_\_\_

**Legal Description:** \_\_\_\_\_

**City Address:** \_\_\_\_\_

**Applicant:** \_\_\_\_\_ **Contact:** \_\_\_\_\_

**Address:** \_\_\_\_\_

**Phone#:** \_\_\_\_\_ **Fax#:** \_\_\_\_\_ **E-mail:** \_\_\_\_\_

**Owner:** \_\_\_\_\_ **Contact:** \_\_\_\_\_

**Address:** \_\_\_\_\_

**Phone#:** \_\_\_\_\_ **Fax#:** \_\_\_\_\_ **E-mail:** \_\_\_\_\_

**TYPE OF SUBMITTAL:** \_\_\_\_\_ PLAT (\_\_\_\_# OF LOTS) \_\_\_\_\_ RESIDENCE \_\_\_\_\_ DRB SITE \_\_\_\_\_ ADMIN SITE

**IS THIS A RESUBMITTAL?:** \_\_\_\_\_ Yes \_\_\_\_\_ No

**DEPARTMENT:** \_\_\_\_\_ TRAFFIC/ TRANSPORTATION \_\_\_\_\_ HYDROLOGY/ DRAINAGE

Check all that Apply:

### TYPE OF SUBMITTAL:

- \_\_\_\_\_ ENGINEER/ARCHITECT CERTIFICATION
- \_\_\_\_\_ PAD CERTIFICATION
- \_\_\_\_\_ CONCEPTUAL G & D PLAN
- \_\_\_\_\_ GRADING PLAN
- \_\_\_\_\_ DRAINAGE MASTER PLAN
- \_\_\_\_\_ DRAINAGE REPORT
- \_\_\_\_\_ FLOODPLAIN DEVELOPMENT PERMIT APPLIC
- \_\_\_\_\_ ELEVATION CERTIFICATE
- \_\_\_\_\_ CLOMR/LOMR
- \_\_\_\_\_ TRAFFIC CIRCULATION LAYOUT (TCL)
- \_\_\_\_\_ TRAFFIC IMPACT STUDY (TIS)
- \_\_\_\_\_ OTHER (SPECIFY) \_\_\_\_\_
- \_\_\_\_\_ PRE-DESIGN MEETING?

### TYPE OF APPROVAL/ACCEPTANCE SOUGHT:

- \_\_\_\_\_ BUILDING PERMIT APPROVAL
- \_\_\_\_\_ CERTIFICATE OF OCCUPANCY
- \_\_\_\_\_ PRELIMINARY PLAT APPROVAL
- \_\_\_\_\_ SITE PLAN FOR SUB'D APPROVAL
- \_\_\_\_\_ SITE PLAN FOR BLDG. PERMIT APPROVAL
- \_\_\_\_\_ FINAL PLAT APPROVAL
- \_\_\_\_\_ SIA/ RELEASE OF FINANCIAL GUARANTEE
- \_\_\_\_\_ FOUNDATION PERMIT APPROVAL
- \_\_\_\_\_ GRADING PERMIT APPROVAL
- \_\_\_\_\_ SO-19 APPROVAL
- \_\_\_\_\_ PAVING PERMIT APPROVAL
- \_\_\_\_\_ GRADING/ PAD CERTIFICATION
- \_\_\_\_\_ WORK ORDER APPROVAL
- \_\_\_\_\_ CLOMR/LOMR
- \_\_\_\_\_ FLOODPLAIN DEVELOPMENT PERMIT
- \_\_\_\_\_ OTHER (SPECIFY) \_\_\_\_\_

**DATE SUBMITTED:** \_\_\_\_\_ **By:** \_\_\_\_\_

COA STAFF:

ELECTRONIC SUBMITTAL RECEIVED: \_\_\_\_\_

FEE PAID: \_\_\_\_\_