


SCANNED BY
PLANNING

CAUTION:
EXISTING UTILITIES ARE NOT SHOWN.
IT SHALL BE THE SOLE RESPONSIBILITY
OF THE CONTRACTOR TO CONDUCT ALL
NECESSARY FIELD INVESTIGATIONS PRIOR
TO ANY EXCAVATION TO DETERMINE THE
ACTUAL LOCATION OF UTILITIES & OTHER
IMPROVEMENTS.

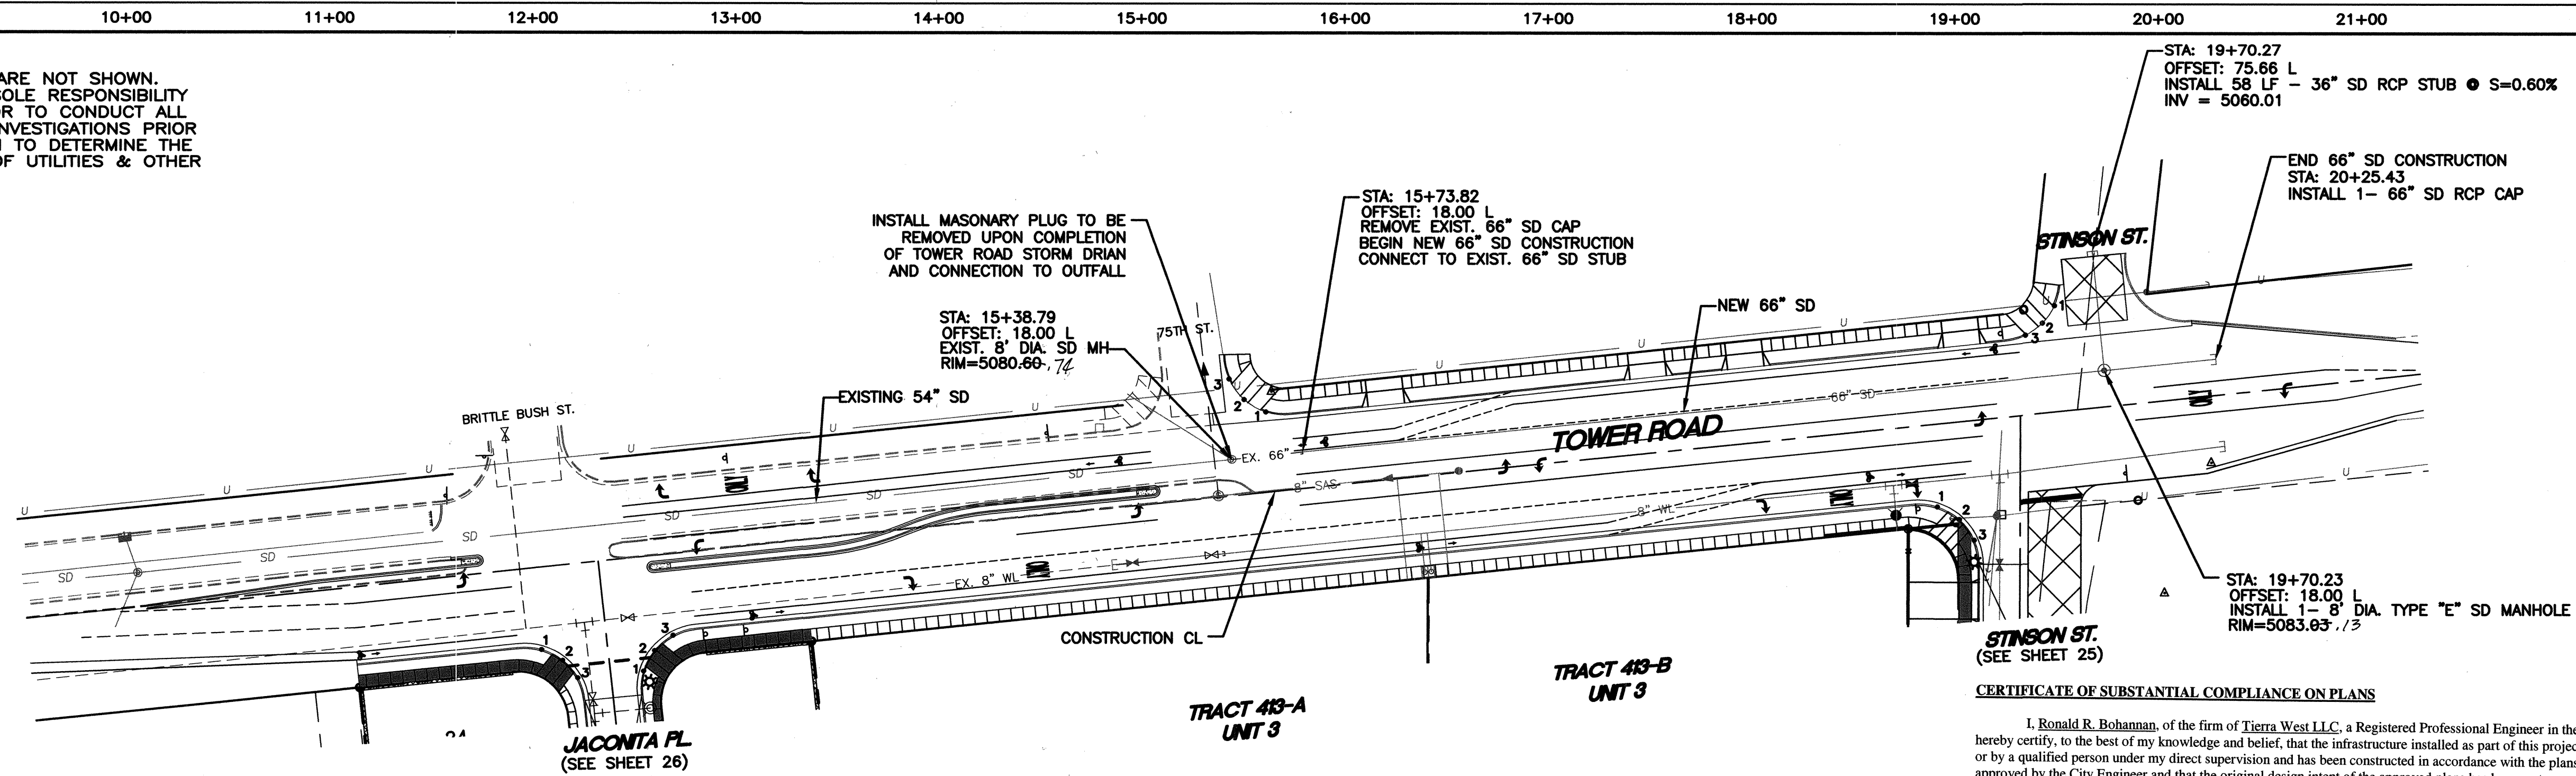



CERTIFICATE OF SUBSTANTIAL COMPLIANCE ON PLANS

I, Ronald R. Bohannon, of the firm of Tierra Verde LLC, a Registered Professional Engineer in the State of New Mexico, do hereby certify, to the best of my knowledge and belief, that the infrastructure installed as part of this project has been inspected by me or by a qualified person under my direct supervision and has been constructed in accordance with the plans and specifications approved by the City Engineer and that the original design intent of the approved plans has been met, except as noted by me on the as-built construction drawings. This Certification is based on site inspections by me, or personnel under my direction with survey information provided by Larry Medrano, of Precision Surveys, NMP# number 11993.



LEGEND

TEMPORARY PAVEMENT

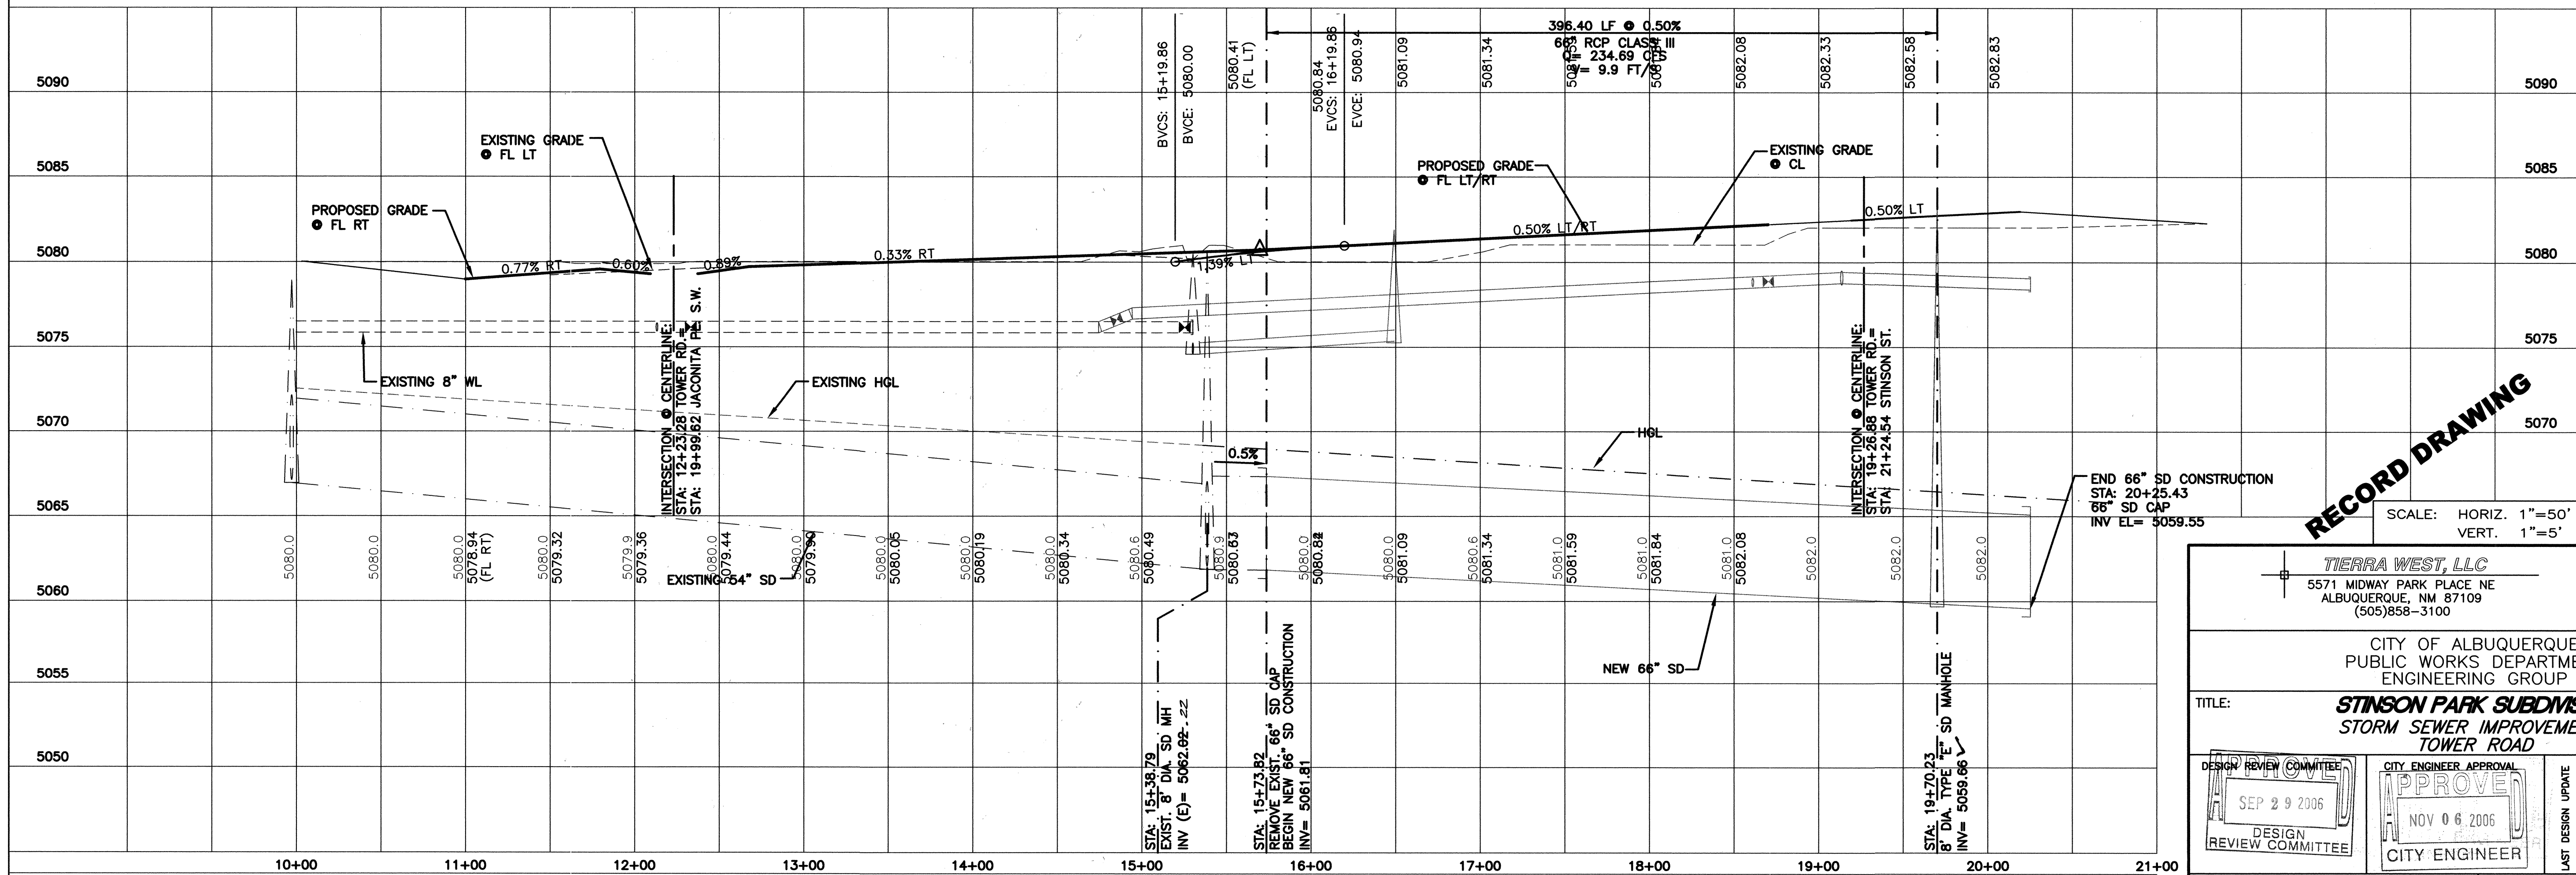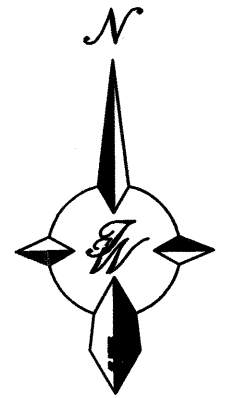

RECORD DRAWING

SCALE: HORIZ. 1" = 10'
VERT. 1" = 10'

SCALE: HORIZ. 1"=50'
VERT. 1"=5'

TIERRA WEST, LLC
5571 MIDWAY PARK PLACE NE
ALBUQUERQUE, NM 87109
(505)858-3100

CITY OF ALBUQUERQUE
PUBLIC WORKS DEPARTMENT
ENGINEERING GROUP

TITLE: **STINSON PARK SUBDIVISION**
STORM SEWER IMPROVEMENTS
TOWER ROAD

DESIGN REVIEW COMMITTEE

SEP 29 2006

DESIGN REVIEW COMMITTEE

CITY ENGINEER APPROVAL

APPROVED

NOV 06 2006

CITY ENGINEER

FAST DESIGN UPDATE

CITY PROJECT NO.

ZONE MAP NO.	
--------------	--

0.	SHEET	OF
----	-------	----

OF