

FILE COPY



KEN SCHULTZ
MAYOR

City of Albuquerque

P.O. BOX 1293 ALBUQUERQUE, NEW MEXICO 87103

April 31, 1989

Tom Mann
The Mann Company, Inc.
5312 Noreen Drive, NE
Albuquerque, New Mexico 87111

RE: REVISED DRAINAGE PLAN FOR THE VALENCIA RETIREMENT CENTER
(K-18/D35) REVISION DATED MARCH 13, 1989

Dear Mr. Mann:

Based on the information provided on your resubmittal of March 14, 1989,
the above referenced plan is approved for Building Permit.

Please be advised that the building permit will not be issued until the
approved filed copy of the replat is submitted to our office.

If I can be of further assistance, please feel free to call me at
768-2650.

Cordially,

Bernie J. Montoya
Bernie J. Montoya, C.E.
Engineering Assistant

BJM/bsj
(WP+161)

1. Copy of replat
2. Engineer Certification ✓
3. Work Concurrence

DRAINAGE INFORMATION SHEET

PROJECT TITLE: The Grand Court Addition ZONE ATLAS/DRNG. FILE #: K18/D35DRB #: 97-332 EPC #: _____ WORK ORDER #: _____LEGAL DESCRIPTION: Tract 5-A-1-A, Tijeras Place Improvement Co, IncCITY ADDRESS: 300 Valencia Dr. SEENGINEERING FIRM: Isaacson & Arfman CONTACT: Tom IsaacsonADDRESS: 128 Monroe NE PHONE: 268-8828OWNER: Grand Court Lifestyles CONTACT: Dorian LucianiADDRESS: 2650 N. Military Tr. Boca Raton FL 33433 PHONE: (561) 997-0323ARCHITECT: Dekker/Perich CONTACT: Leonard GrossmanADDRESS: 6801 Jefferson NE, Suite 100 PHONE: 761-9700SURVEYOR: Albuquerque Surveying Co CONTACT: Bob MillerADDRESS: 2119 Manual NE PHONE: 884-2036CONTRACTOR: Bradbury & Stamm CONTACT: 765-1200ADDRESS: 1217 1st NW PHONE: Bob Woodward

TYPE OF SUBMITTAL:

CHECK TYPE OF APPROVAL SOUGHT:

- ☐ DRAINAGE REPORT
☐ DRAINAGE PLAN
☐ CONCEPTUAL GRADING & DRAINAGE PLAN
☒ GRADING PLAN
☐ EROSION CONTROL PLAN
☒ ENGINEER'S CERTIFICATION
☐ OTHER


- ☐ SKETCH PLAT APPROVAL
☐ PRELIMINARY PLAT APPROVAL
☐ S. DEV. PLAN FOR SUB'D. APPROVAL
☐ S. DEV. PLAN FOR BLDG. PERMIT APPROVAL
☐ SECTOR PLAN APPROVAL
☐ FINAL PLAT APPROVAL
☐ FOUNDATION PERMIT APPROVAL
☐ BUILDING PERMIT APPROVAL
☒ CERTIFICATE OF OCCUPANCY APPROVAL
☐ GRADING PERMIT APPROVAL
☐ PAVING PERMIT APPROVAL
☐ S.A.D. DRAINAGE REPORT
☐ DRAINAGE REQUIREMENTS
☐ OTHER _____ (SPECIFY)

PRE-DESIGN MEETING:

- ☐ YES
☐ NO
☐ COPY PROVIDED

DATE SUBMITTED: 9/18/98
BY: Herma P. Isaacson

30 day Temp CO. issued on 9/21/98

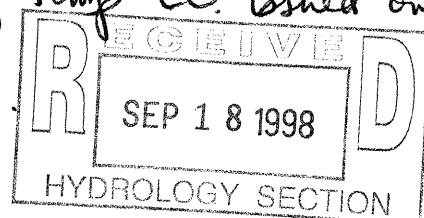

DRAINAGE INFORMATION SHEET


PROJECT TITLE: Valencia Retirement ZONE ATLAS/DRNG. FILE #: K-18/D35
 DRB #: _____ EPC #: _____ WORK ORDER #: _____
 LEGAL DESCRIPTION: Tract 5-A Tijeras Place Improvements
 CITY ADDRESS: 300 Valencia Dr SE
 ENGINEERING FIRM: The Mann Company Inc CONTACT: Tom Mann
 ADDRESS: 5312 Noreen Dr NE PHONE: 883-7700
 OWNER: Dan Cook CONTACT: Dan Cook
 ADDRESS: _____ PHONE: 345-1897
 ARCHITECT: Claudio Vigil CONTACT: Claudio Vigil
 ADDRESS: 4825 Pennsylvania NE PHONE: 265-3000
 SURVEYOR: The Mann Company CONTACT: _____
 ADDRESS: _____ PHONE: _____
 CONTRACTOR: Bradbury Stamm CONTACT: Bob Haszka
 ADDRESS: _____ PHONE: 765 1200

TYPE OF SUBMITTAL:

____ DRAINAGE REPORT
 ____ DRAINAGE PLAN
 ____ CONCEPTUAL GRADING & DRAINAGE PLAN
 ____ GRADING PLAN
 ____ EROSION CONTROL PLAN
☒ ENGINEER'S CERTIFICATION
 ____ OTHER _____

PRE-DESIGN MEETING:


____ YES
 ____ NO
 ____ COPY PROVIDED

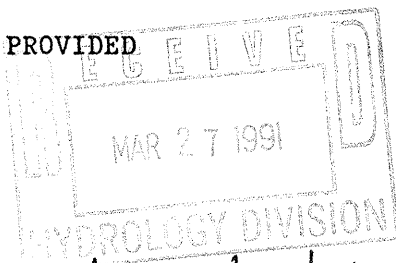

DATE SUBMITTED: 3/27/91
 BY: Jamblan

CHECK TYPE OF APPROVAL SOUGHT:

____ SKETCH PLAT APPROVAL
 ____ PRELIMINARY PLAT APPROVAL
 ____ S. DEV. PLAN FOR SUB'D. APPROVAL
 ____ S. DEV. PLAN FOR BLDG. PERMIT APPROVAL
 ____ SECTOR PLAN APPROVAL
 ____ FINAL PLAT APPROVAL
 ____ FOUNDATION PERMIT APPROVAL
 ____ BUILDING PERMIT APPROVAL
☒ CERTIFICATE OF OCCUPANCY APPROVAL
 ____ GRADING PERMIT APPROVAL
 ____ PAVING PERMIT APPROVAL
 ____ S.A.D. DRAINAGE REPORT
 ____ DRAINAGE REQUIREMENTS
 ____ OTHER _____ (SPECIFY)

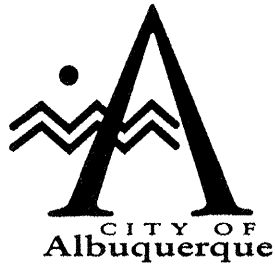

February 2, 1998

Tom Isaacson
Isaacson & Arfman Engineering
128 Monroe NE
Albuquerque, New Mexico 87108

RE: DRAINAGE PLAN FOR THE GRAND COURT ADDITION (K18-D35) ENGINEER'S
STAMP DATED 12/10/97

Dear Mr. Isaacson:

Based on the information provided on your January 12, 1998 submittal, the above referenced site is approved for Building Permit.

Please attach a copy of this approved plan to construction sets prior to sign-off by Hydrology.

Also, Engineer Certification per the DPM checklist will be required prior to Certificate of Occupancy release.

If I can be of further assistance, please feel free to contact me at 924-3986.

C: Andrew Garcia
File

Sincerely


Bernie J. Montoya CE
Associate Engineer



FILE COPY



City of Albuquerque

P.O. BOX 1293 ALBUQUERQUE, NEW MEXICO 87103

March 29, 1991

Tom Mann, P.E.
The Mann Company, Inc.
811 Dallas Street, NE
Albuquerque, New Mexico 87110


RE: ENGINEER'S CERTIFICATION FOR VALENCIA RETIREMENT
(K-18/D35) ENGINEER'S STATEMENT DATED MARCH 25, 1991

Dear Mr. Mann:

Based on the information provided on your submittal of March 27, 1991,
Certification for the referenced site is acceptable.

If I can be of further assistance, please feel free to call me at
768-2650.

Cordially,

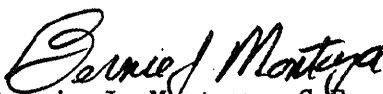
Bernie J. Montoya, C.E.
Engineering Assistant

xc: Alan Martinez

BJM:bsj
(WP+161)



PUBLIC WORKS DEPARTMENT

Walter H. Nickerson, Jr., P.E.
Assistant Director Public Works

ENGINEERING GROUP

Telephone (505) 768-2500

AN EQUAL OPPORTUNITY EMPLOYER

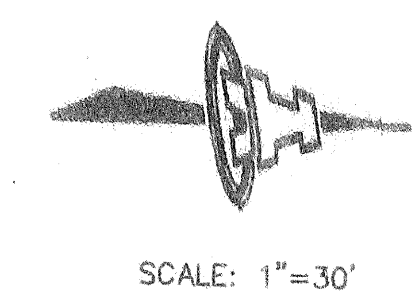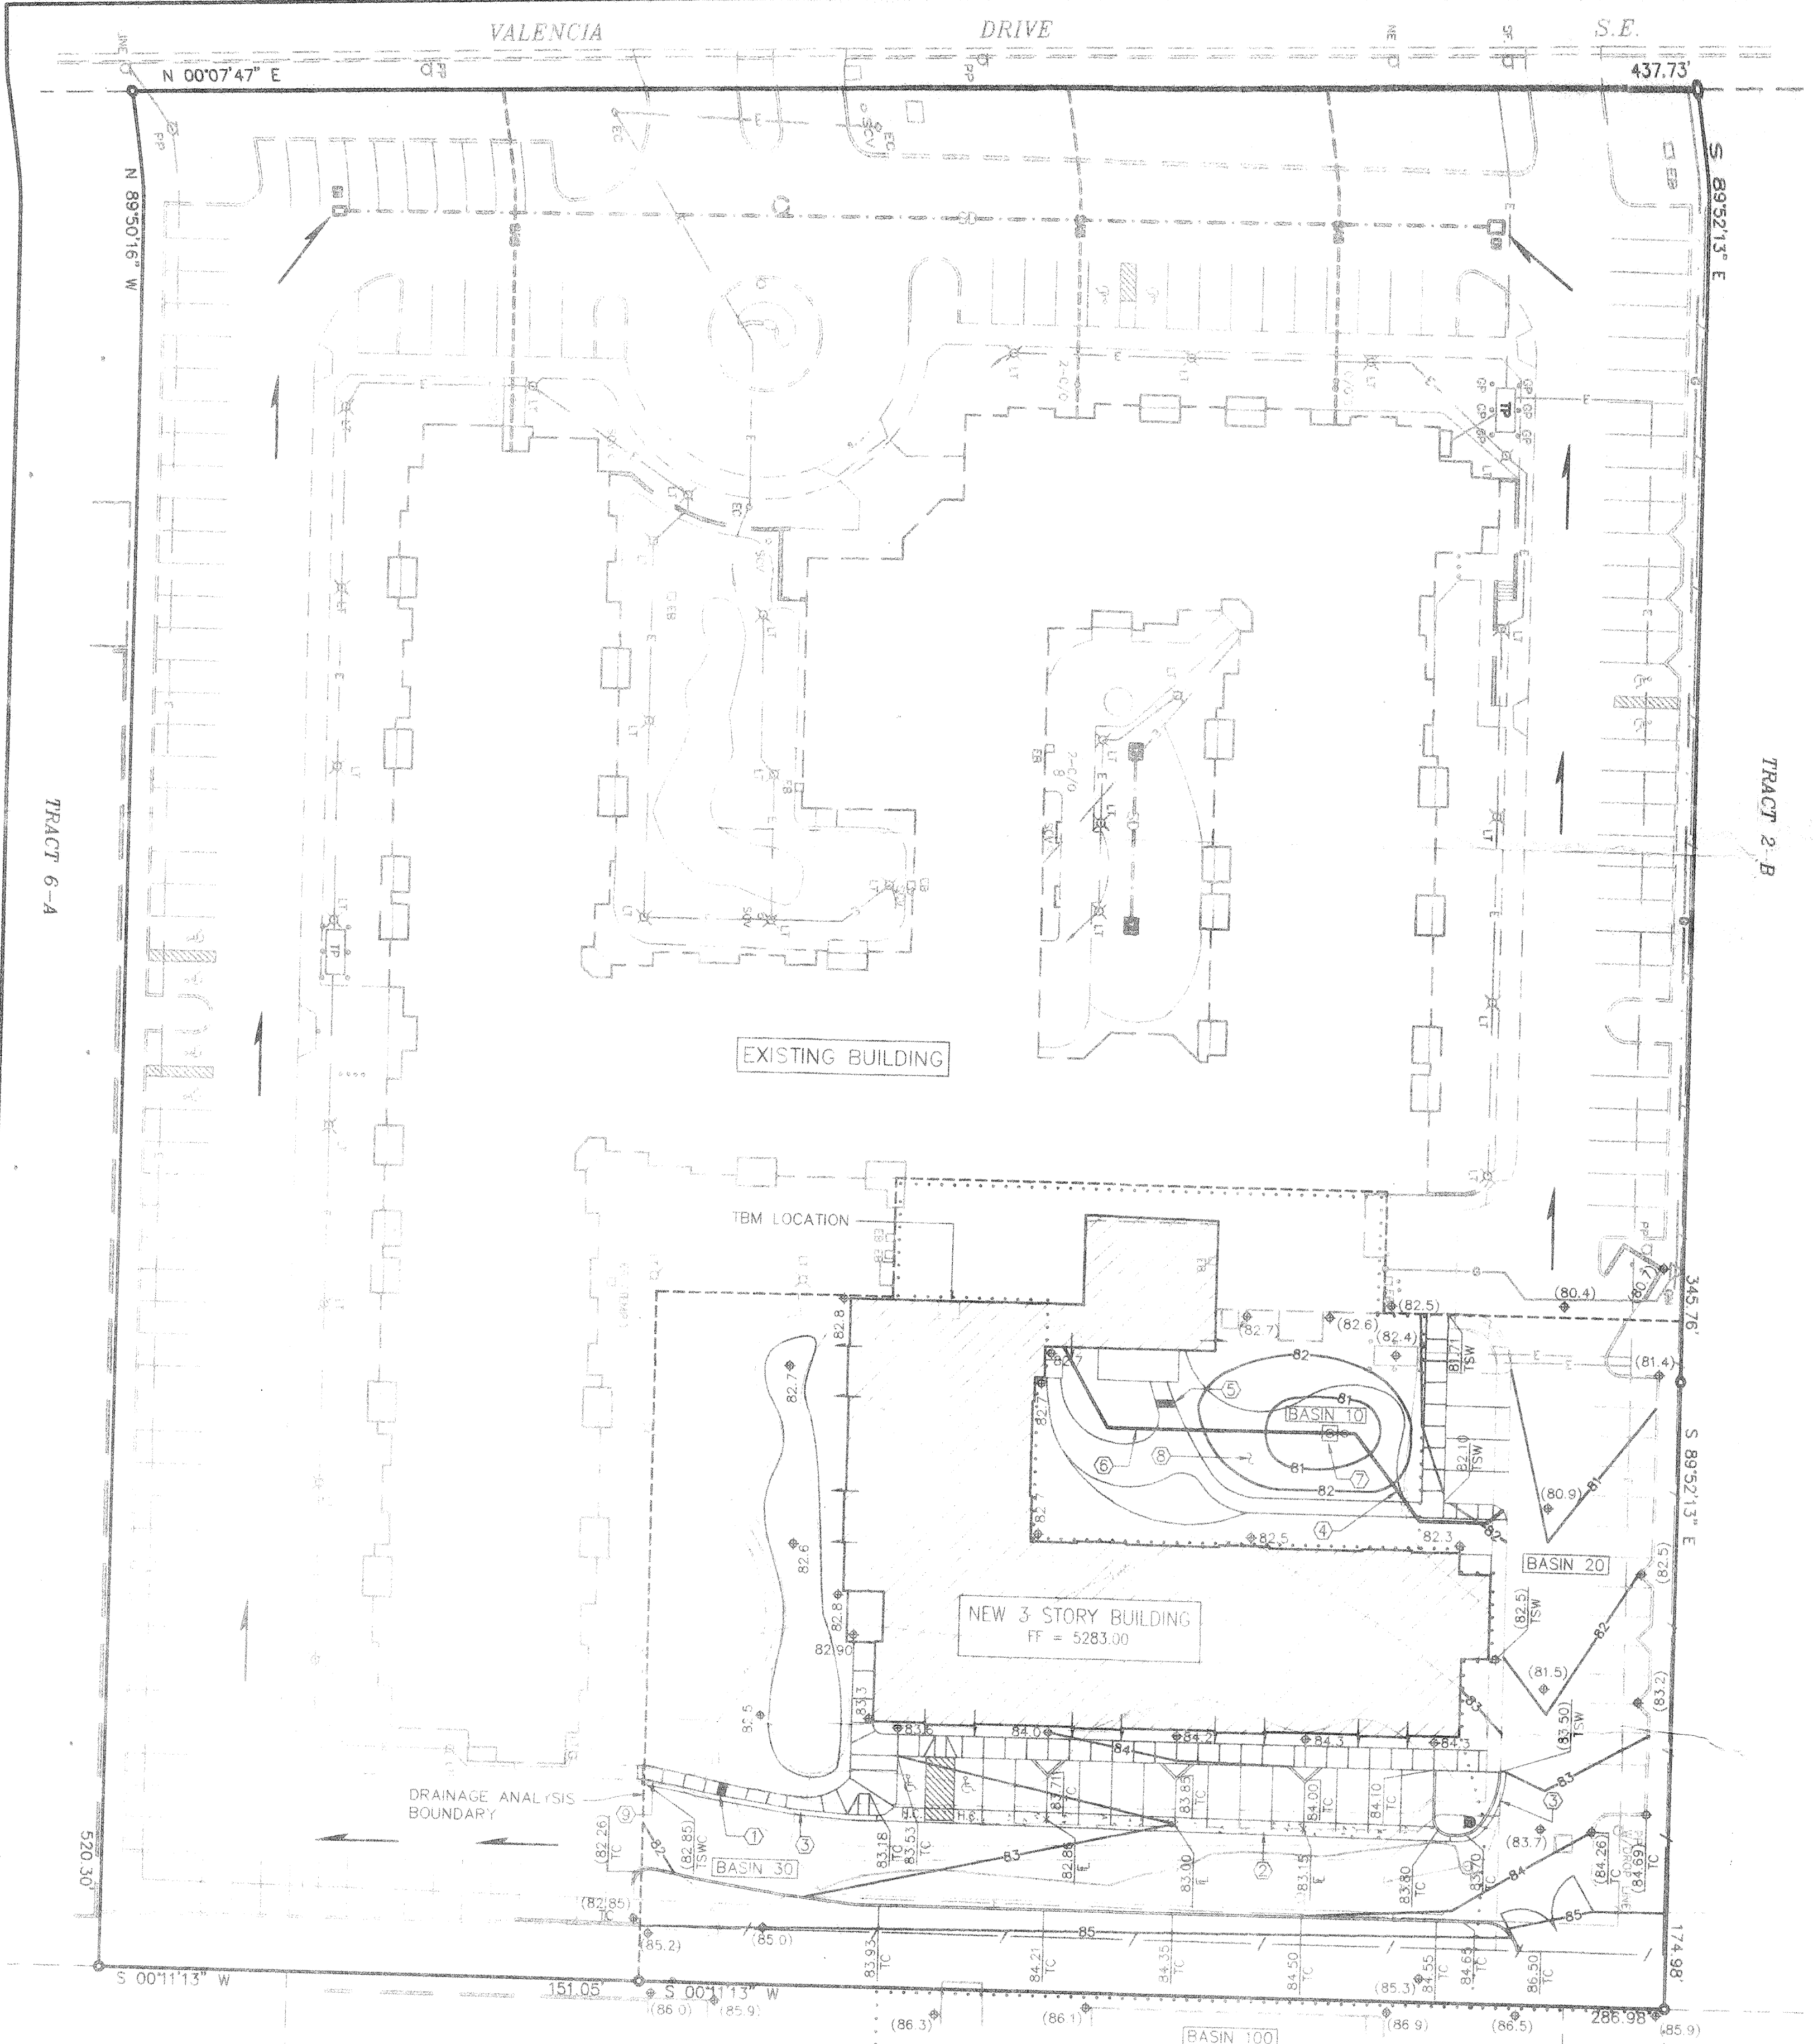

DRAINAGE INFORMATION

Legal Description:
Tract 5-A-1-A, Tijeras Place Improvement Co., Inc., Albuquerque, New Mexico

Permanent Benchmark:
City of Albuquerque Control Station "5-K18A"
Located on the north right-of-way of Central Avenue
between Alvarado Drive and Valencia Drive NE
Elevation = 5277.51

Temporary Bench Mark:
Finish floor elevation of existing building (See plan for exact location)
Elevation = 5283.00

Flood Hazard Statement: The southerly and westerly portion of Tract 5-A-1-A (existing development) lies within Flood Zone "AO" (depth 1 ft), the remainder of the tract (subject site), lies within Flood Zone "X" (areas of 500-year flood), as shown on FEMA Flood Insurance Rate Map No. 3500160354, effective date September 20, 1996.

EXISTING DRAINAGE CONDITION: The site occupies the northeasterly 1.37 acres of Tract 5-A-1-A. Approximately half the site drains to the west in an existing parking lot drive and the other half drains south and then west in another parking lot drive. Runoff from Tract 5-A-1-A is collected in a private onsite storm drain system which connects to a 54" public storm drain in Valencia Drive. There is a minor offsite tributary area (Basin 100) of 0.15 acres along the east boundary. Site is located within Precipitation Zone 3.

Onsite Flow Calculations (Basins 10, 20, and 30)
 $A_B = 0.88 \text{ ac}$, $A_C = 0.03 \text{ ac}$, $A_D = 0.46 \text{ ac}$
 $Q_{10} = .88(1.19) + .03(2.00) + .46(3.39) = 2.67 \text{ cfs}$
 $Q_{100} = .88(2.60) + .03(3.45) + .46(5.02) = 4.70 \text{ cfs}$

Offsite Flow Calculations
 $A_1 = 0.15 \text{ ac}$
 $Q_{10} = .15(3.39) = 0.51 \text{ cfs}$
 $Q_{100} = .15(5.02) = 0.75 \text{ cfs}$

PROPOSED DRAINAGE CONCEPT: A three-story building addition with additional parking is proposed as shown. New landscaping will be developed on all other areas.


Runoff from Basin 10 will flow to a detention pond with a storage area of 1265 cu ft which will be evacuated by a sump pump. The sump pump discharge rate is 45 gpm (0.10 cfs). Maximum pond discharge for 10-year runoff will be the sump pump rate. Maximum pond discharge for the 100-year runoff will be the sump pump rate, 0.10 cfs and an overflow rate of 0.15 cfs or a total of 0.25 cfs. Basin 20 flows will combine with Basin 10 flows and runoff into the northerly parking lot drive. Basin 30 flows will runoff into the southerly parking lot drive.

Basin 10 Flow Calculations
 $A_B = .04 \text{ ac}$, $A_C = .08 \text{ ac}$, $A_D = .15 \text{ ac}$
 $Q_{10} \text{ (uncontrolled)} = .04(1.19) + .08(2.00) + .15(3.39) = 0.72 \text{ cfs}$
 $Q_{10} \text{ (controlled)} = 0.10 \text{ cfs}$
 $Q_{100} \text{ (uncontrolled)} = .04(2.60) + .08(3.45) + .15(5.02) = 1.13 \text{ cfs}$
 $Q_{100} \text{ (controlled)} = 0.25 \text{ cfs}$

Basin 20 Flow Calculations
 $A_1 = .05 \text{ ac}$, $A_2 = .22 \text{ ac}$
 $Q_{10} = .05(2.00) + .22(3.39) = 0.85 \text{ cfs}$
 $Q_{100} = .05(3.45) + .22(5.02) = 1.28 \text{ cfs}$

Basin 30 Flow Calculations
 $A_B = .12 \text{ ac}$, $A_C = .10 \text{ ac}$, $A_D = .61 \text{ ac}$
 $Q_{10} = .12(1.19) + .10(2.00) + .61(3.39) = 2.41 \text{ cfs}$
 $Q_{100} = .12(2.60) + .10(3.45) + .61(5.02) = 3.72 \text{ cfs}$

Q_{100} Runoff Summary
 Existing = 4.70 cfs
 Developed = .25 + 1.28 + 3.72 = 5.25 cfs
 Increase = 0.55 cfs

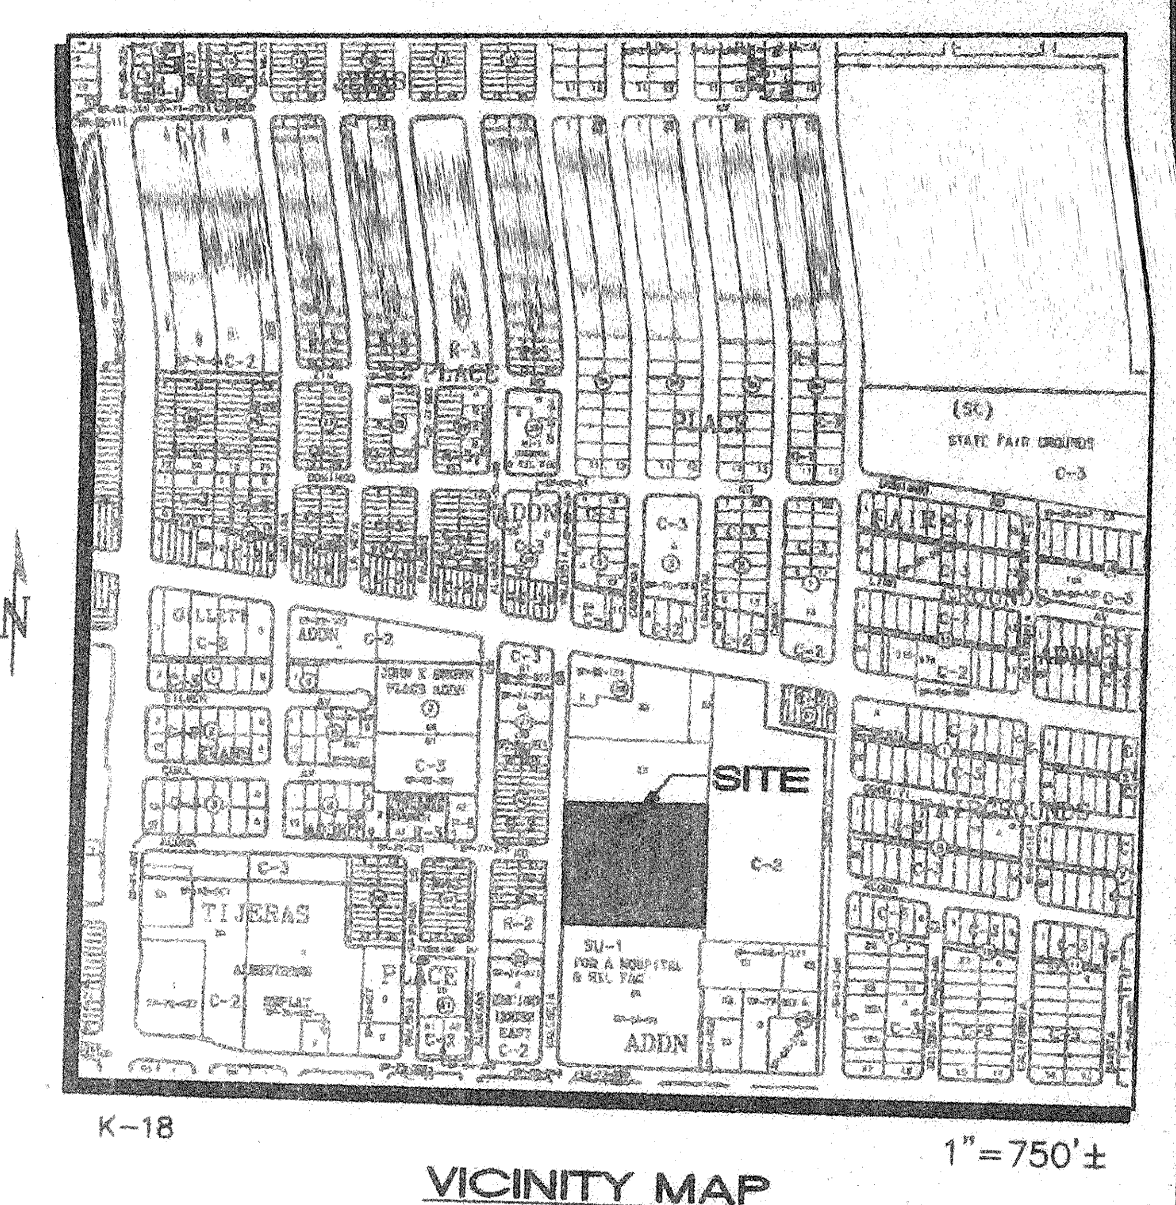

GENERAL NOTES

- SEE DETAILS FOR VALLEY GUTTER, SIDEWALK CULVERTS AND SUMP PUMP ON SHEET C-2.

KEYED CONSTRUCTION NOTES


- 24" WIDE SIDEWALK CULVERT
TOP CULVERT = 82.95
EL = 82.45
- 4" WIDE CONCRETE VALLEY GUTTER
- BUILD 18" WIDE CURB & GUTTER
- 12" SCHEDULE 40 PVC SUMP PUMP DISCHARGE LINE, CAST OUTLET END THROUGH PARKING LOT CURB
- 24" WIDE SIDEWALK CULVERT
TOP CULVERT = 82.7
EL = 82.2
- 6" SCHEDULE 40 CI OR PVC ROOF DRAIN LINE EXTENSION, SLOPE = 2%
- SUMP PUMP INLET & VAULT, TOP OF INLET GRATE = 80.5
- DETENTION POND, STORAGE VOLUME = 1265 CU. FT. WSEL = 5282.0
- MODIFY CURB HEIGHT TO MATCH EXISTING SIDEWALK HEIGHT AT CONNECTING POINT

LEGEND - EXISTING

- POWER POLE
- ANCHOR
- LIGHT POLE
- GUARD POST
- ROOF DRAIN
- CABLE TELEVISION BOX
- ELECTRIC BOX
- TELEPHONE RISER
- GAS METER
- FIRE HYDRANT
- WATER METER
- WATER VALVE

LEGEND - PROPOSED

- SPRINKLER CONTROL VALVE
- CLEAN OUT
- UNDERGROUND UTILITY SPOT (GAS)
- MANHOLE (STORM)
- MANHOLE (SANITARY)
- MANHOLE (TELEPHONE)
- TRANSFORMER PAD
- UNDERGROUND ELECTRIC LINE
- UNDERGROUND WATER LINE
- UNDERGROUND SANITARY SEWER LINE
- FIRE PREVENTION LINE
- UNDERGROUND GAS LINE
- 82.8 FINISH GRADE
- (83.50) EXISTING GRADE
- TC TOP OF CURB
- TSW TOP OF SIDEWALK
- TSWC TOP OF SIDEWALK CULVERT
- EL FLOW LINE
- ROOF DRAIN LOCATIONS
- DRAINAGE ANALYSIS BOUNDARY LINE
- BASIN BOUNDARY LINE
- BASIN NUMBER
- FLOW DIRECTION

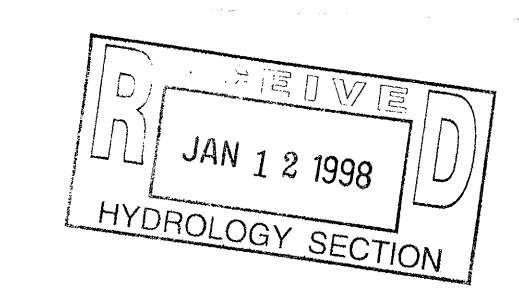

no.	date	revision

dekker/perich & associates
 6501 American Parkway, NE, Suite 100
 Albuquerque, New Mexico 87110
 505/848-3111 Fax 505/848-3100


Grand Court Addition
 Assisted Living Residence
 Albuquerque, New Mexico

GRADING & DRAINAGE PLAN

Job no: 97048
 drn. by: MD
 ckd. by: TI
 issued: 11.20.97

C-1

sheet

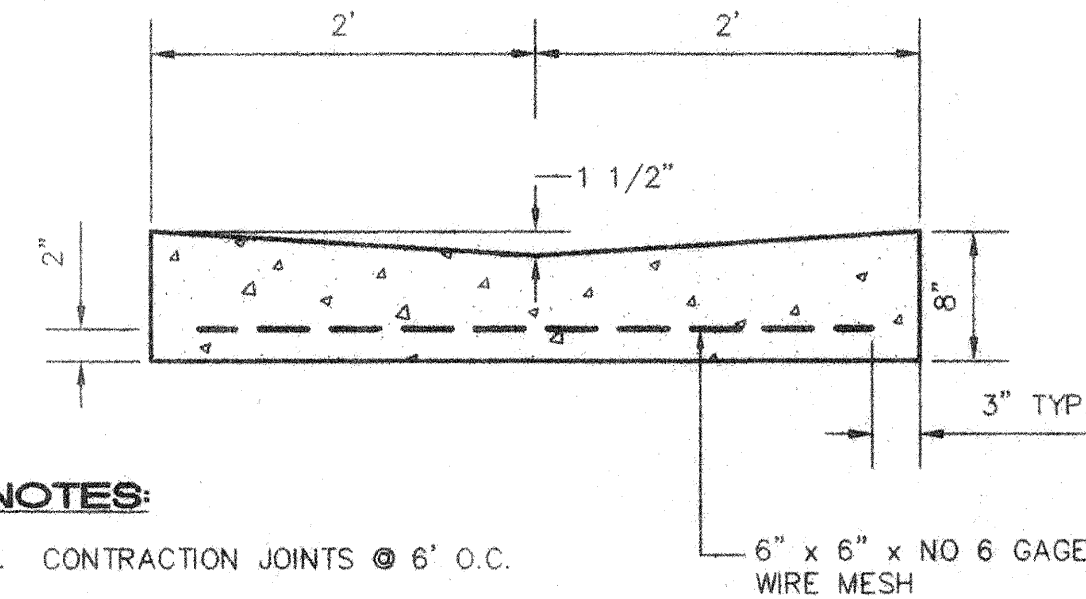


NOTES:

1. CONTRACTION JOINTS @ 6' O.C.
2. EXPANSION JOINTS @ 36' O.C.

6" x 6" x NO 6 GAGE
WIRE MESH


VALLEY GUTTER

SCALE: 1" = 1'-0"

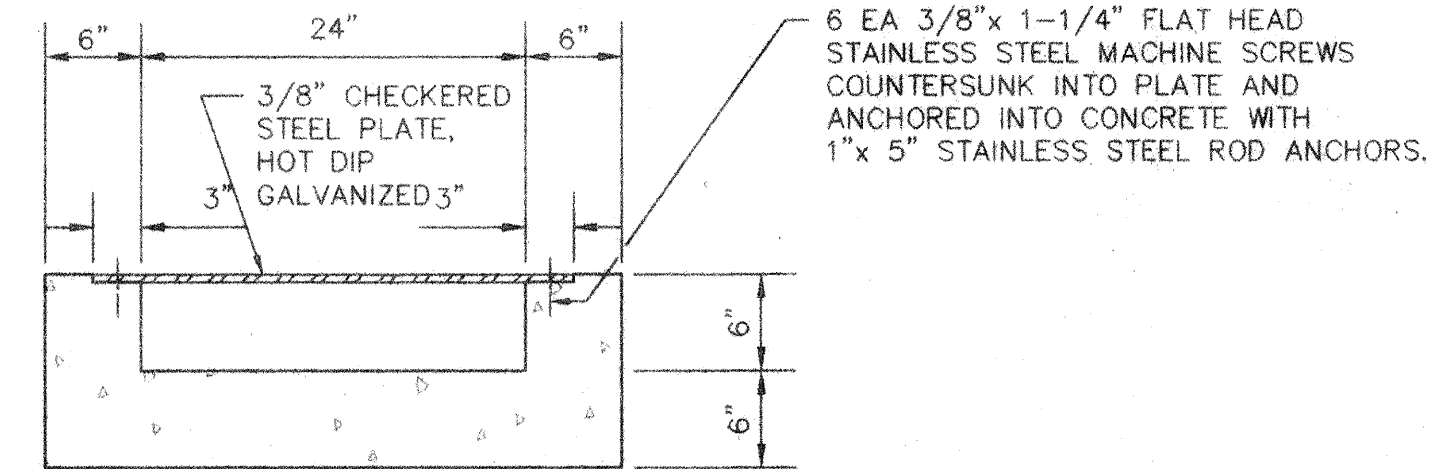

SIDEWALK CULVERT SECTION

SCALE: 1" = 1'-0"

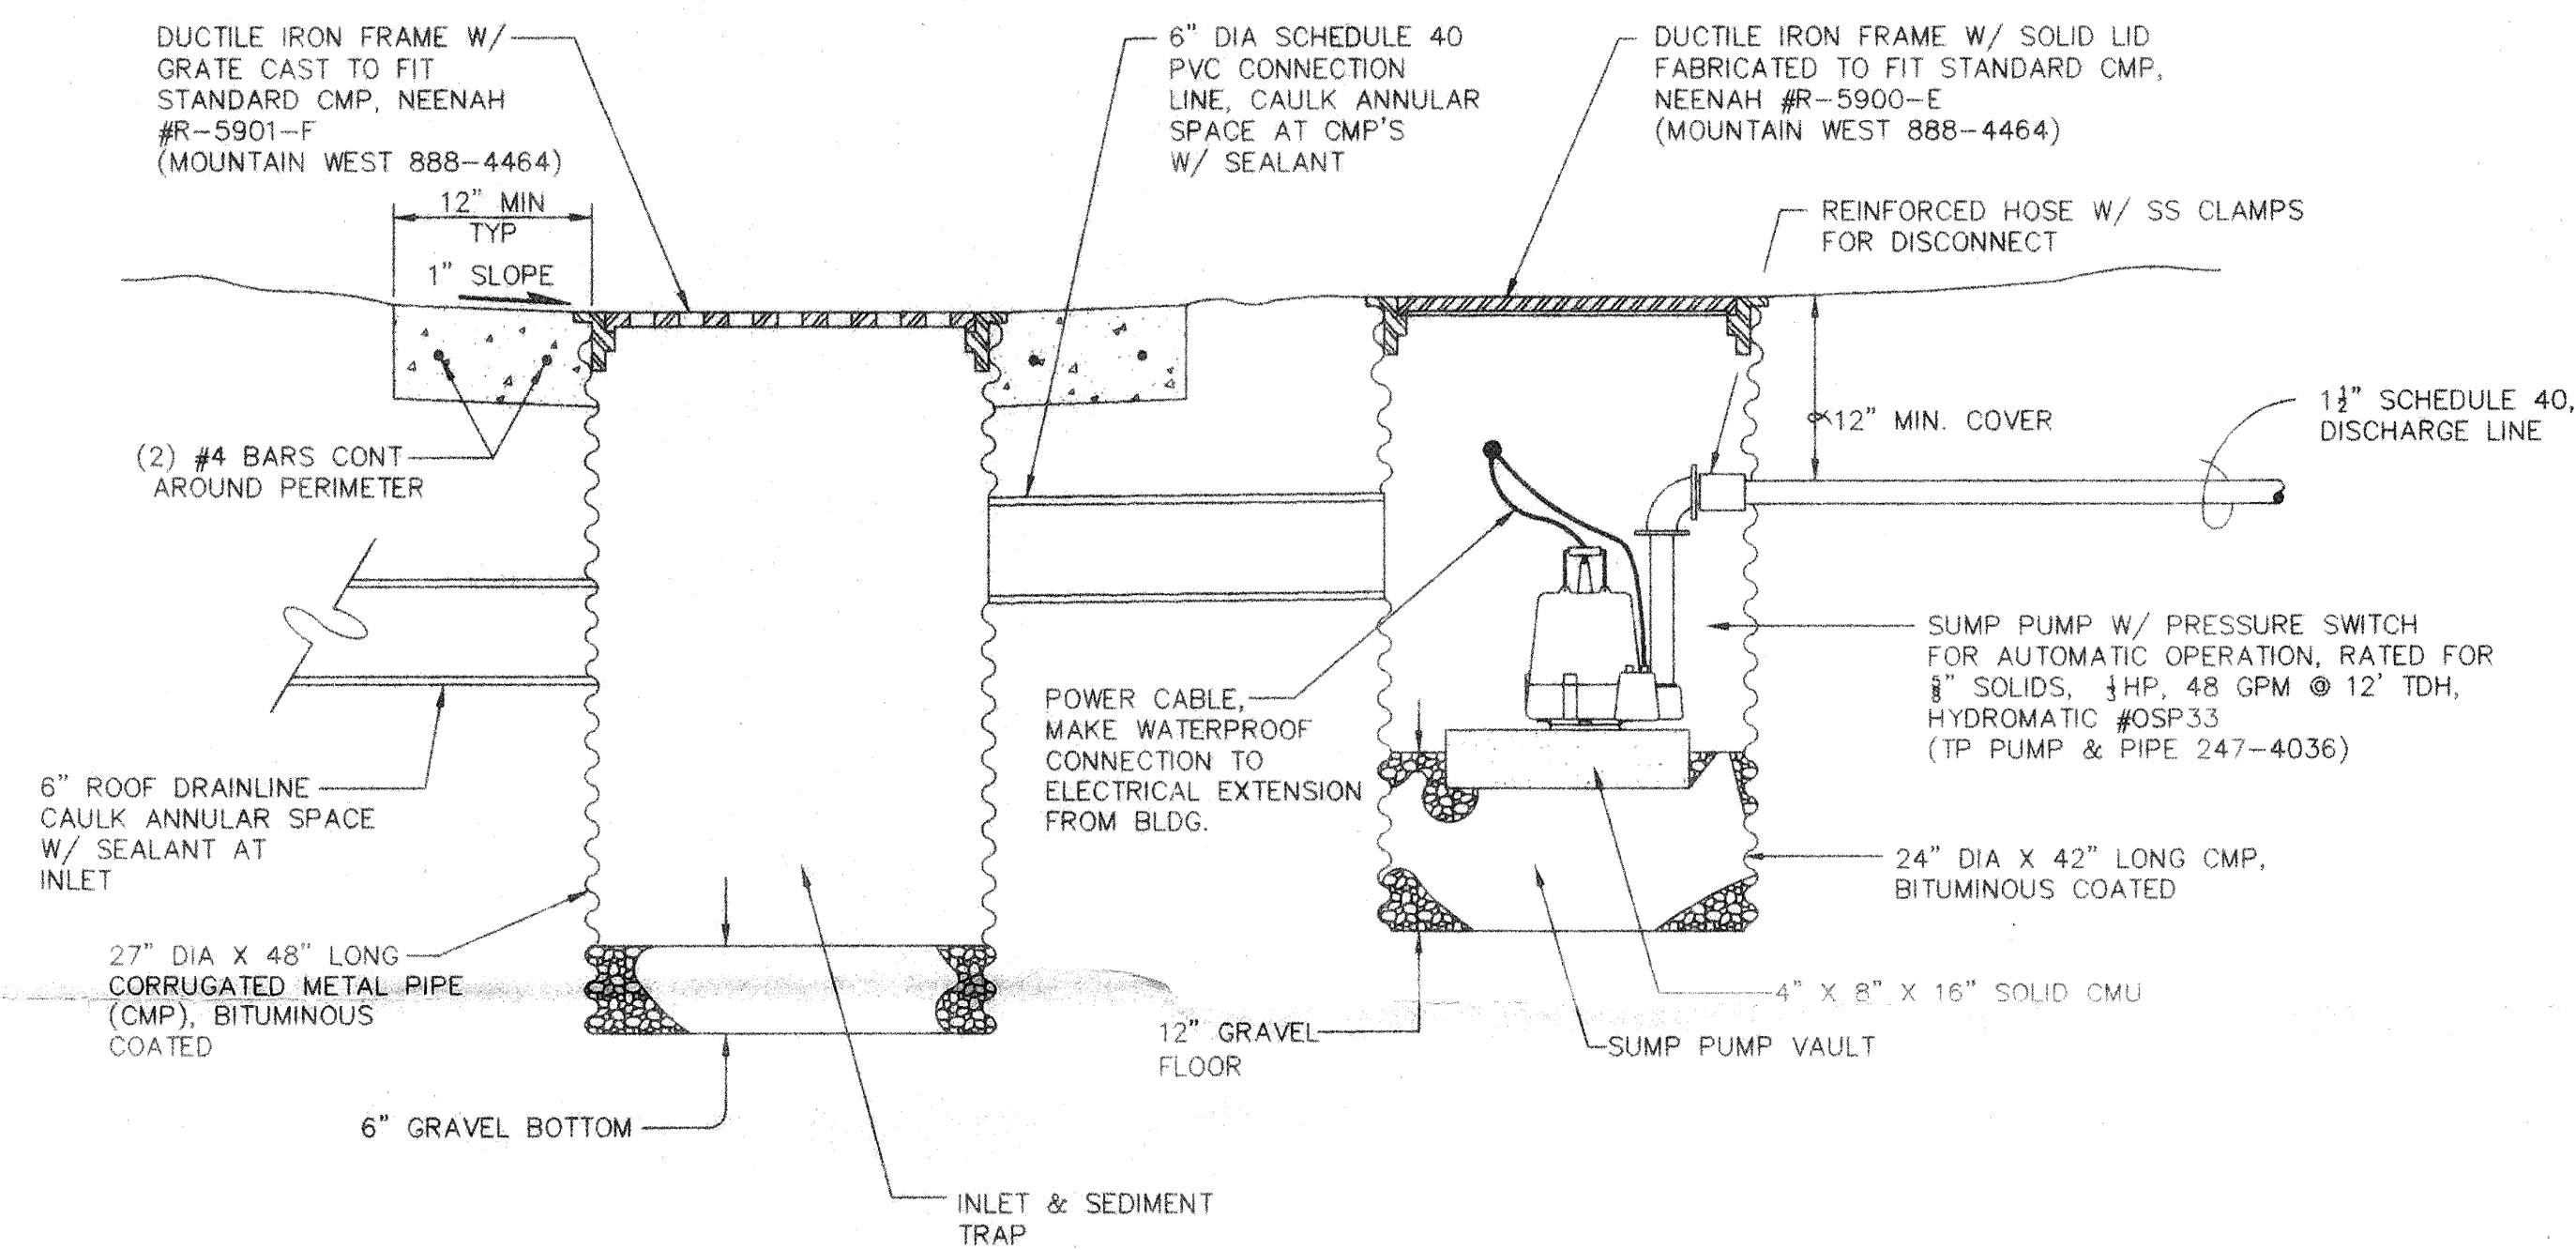

SUMP PUMP SECTION

SCALE: 1" = 1'-0"

no.	date	revision



dekker/perich & associates
architecture 6301 American Parkway, NE, Suite 205
planning Albuquerque, New Mexico 87110
interior 505 948-3111 FAX 505 948-0880

Grand Court Addition
Assisted Living Residence
Albuquerque, New Mexico


DRAINAGE DETAILS HYDROLOGY SECTION

	Job no:	97048
	drn. by:	MD
	okd. by:	TI
	issued:	1120.97

sheet **C-2** of

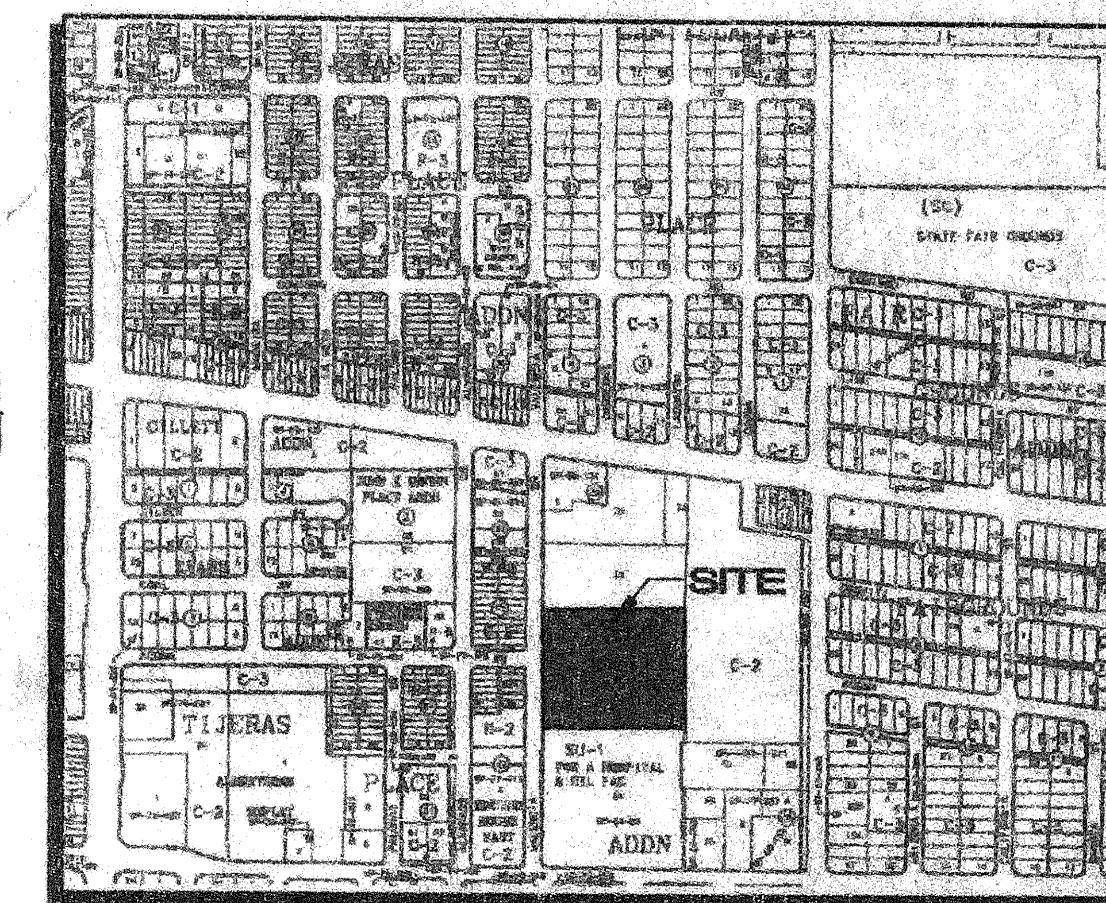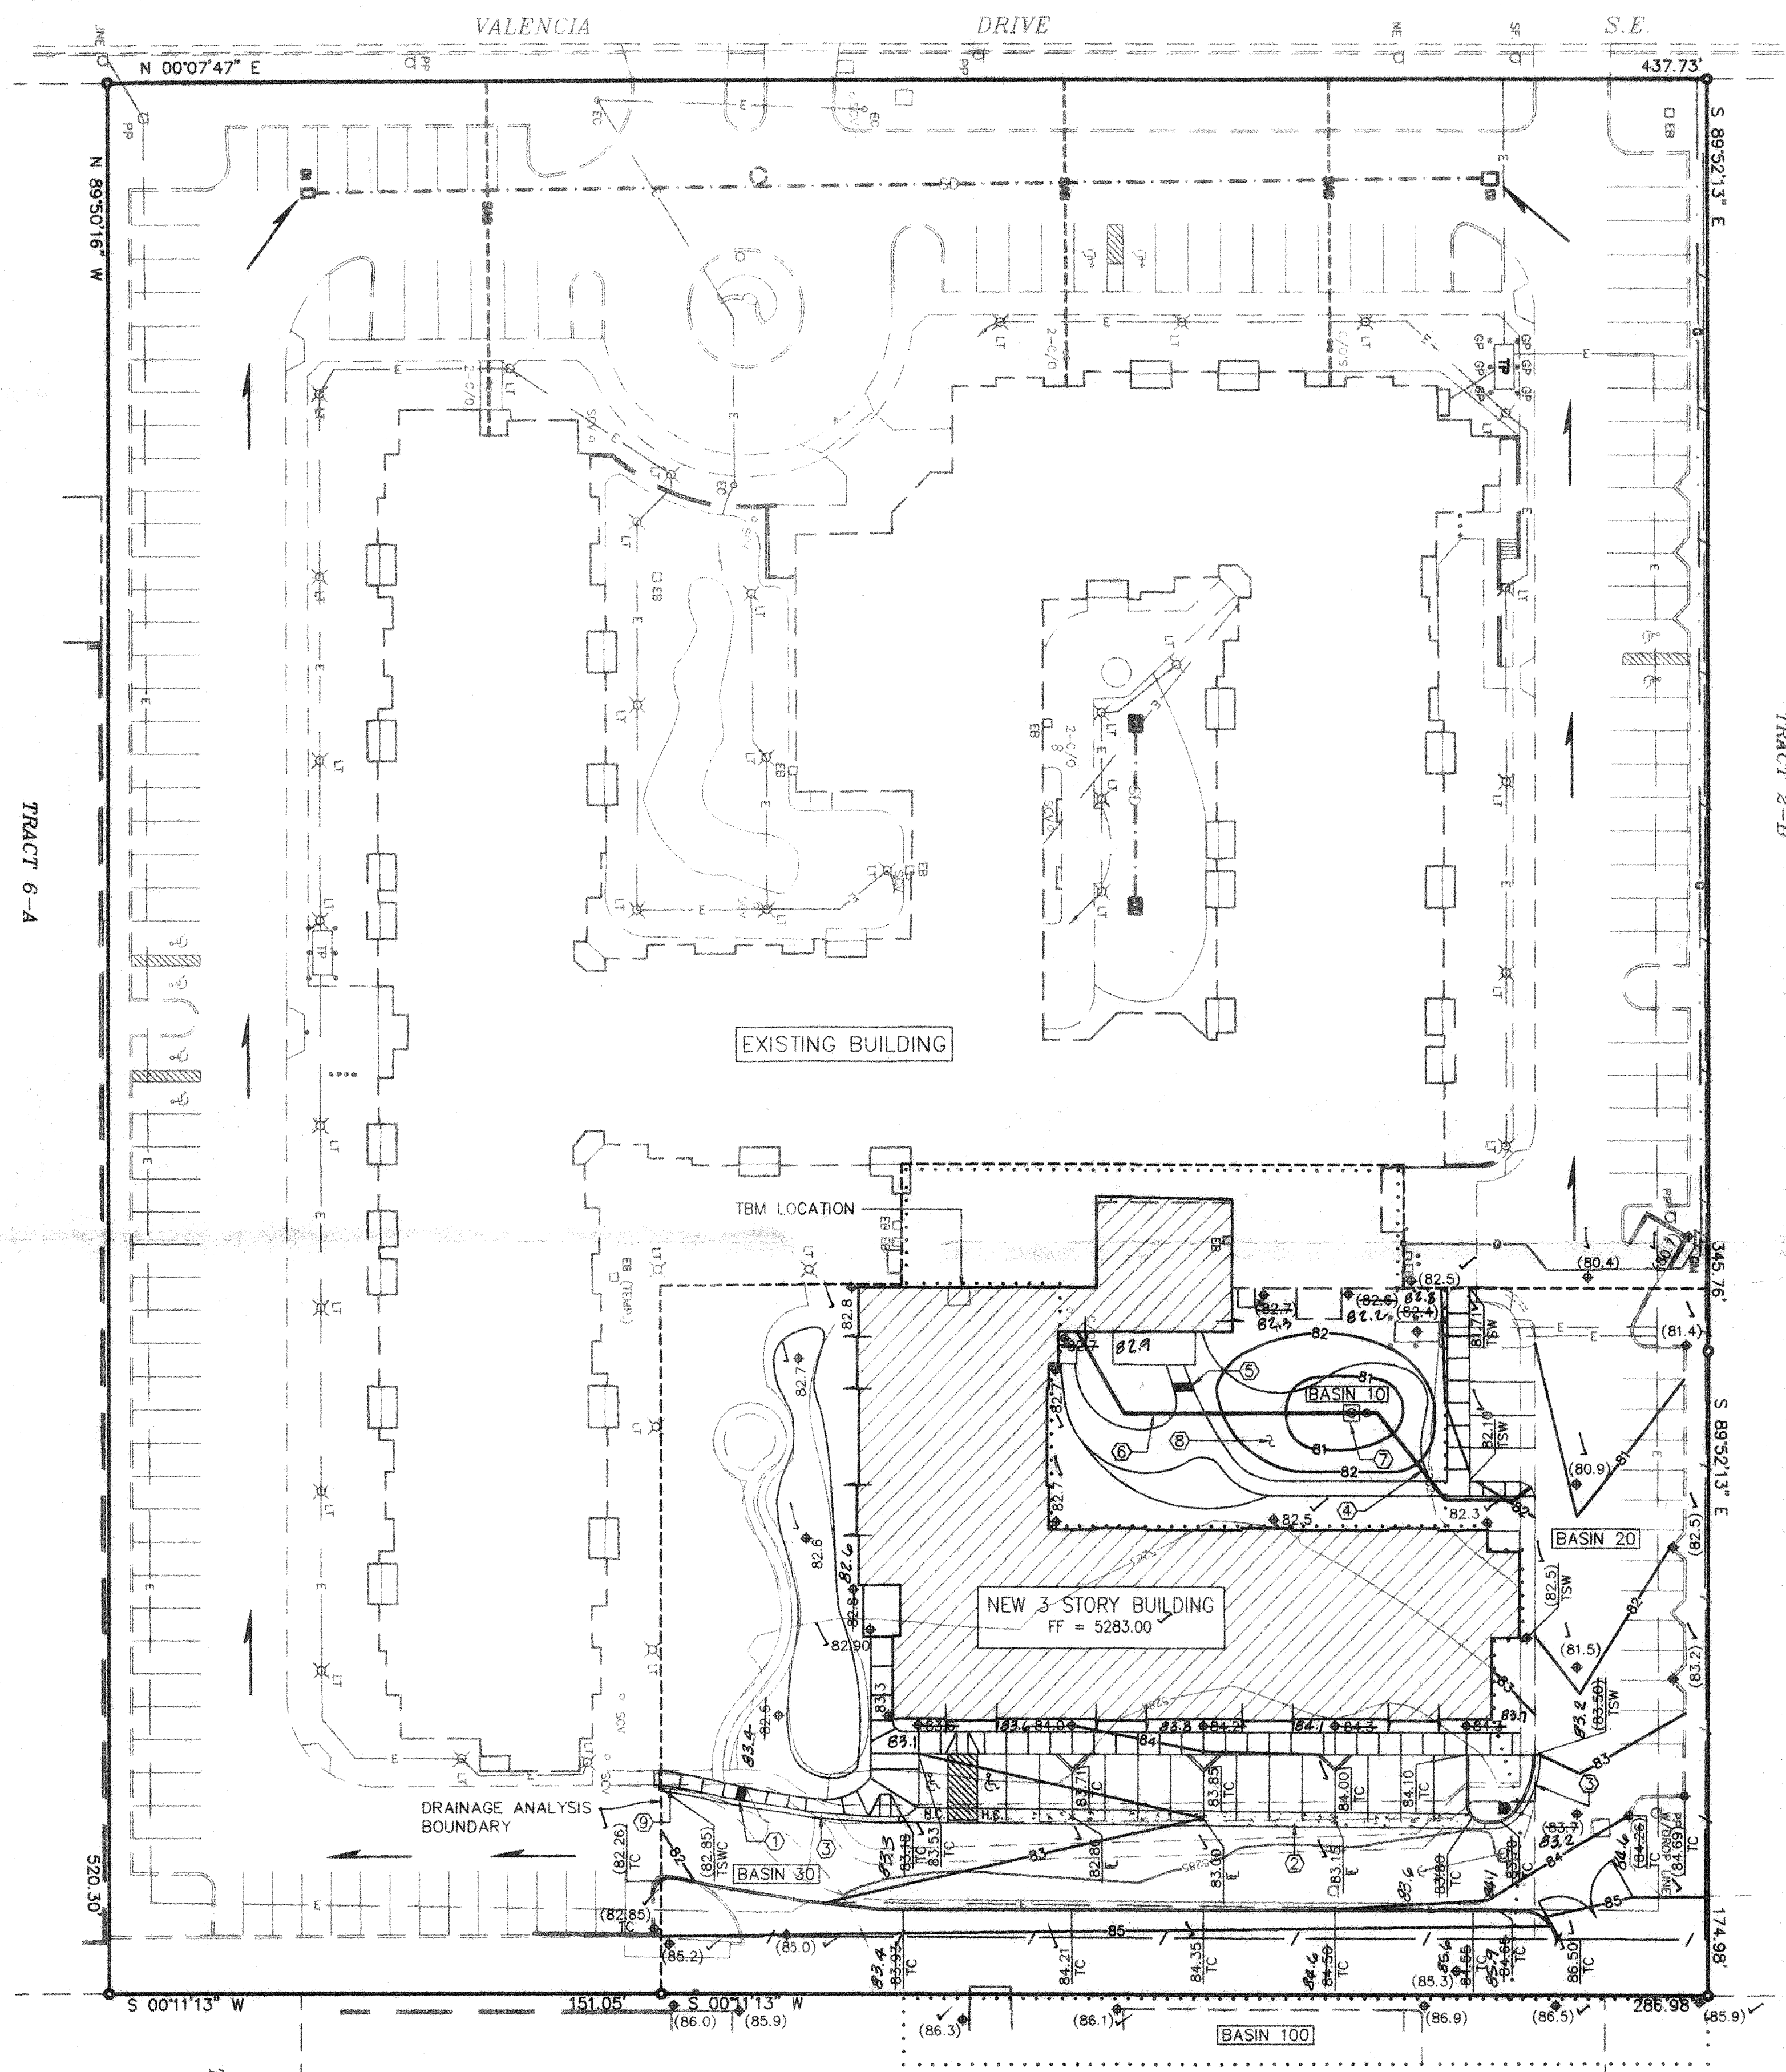

VICINITY MAP

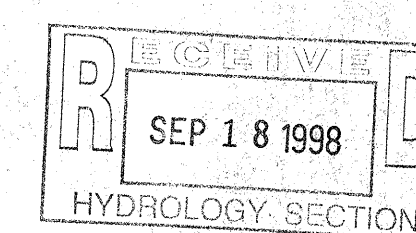

DRAINAGE INFORMATION

Legal Description:
Tract 5-A-1-A, Tijeras Place Improvement Co., Inc., Albuquerque, New Mexico

Permanent Benchmark:
City of Albuquerque Control Station "5-K18A"
Located on the north right-of-way of Central Avenue
between Alvarado Drive and Valencia Drive NE
Elevation = 5277.51

Temporary Bench Mark:
Finish floor elevation of existing building (See plan for exact location)
Elevation = 5283.00

Flood Hazard Statement: The southerly and westerly portion of Tract 5-A-1-A (existing development) lies within Flood Zone "AO" (depth 1 ft), the remainder of the tract (subject site), lies within Flood Zone "X" (areas of 500-year flood), as shown on FEMA Flood Insurance Rate Map No. 3500160354, effective date September 20, 1996.

EXISTING DRAINAGE CONDITION: The site occupies the northeasterly 1.37 acres of Tract 5-A-1-A. Approximately half the site drains to the west in an existing parking lot drive and the other half drains south and then west in another parking lot drive. Runoff from Tract 5-A-1-A is collected in a private onsite storm drain system which connects to a 54" public storm drain in Valencia Drive. There is a minor offsite tributary area (Basin 100) of 0.15 acres along the east boundary. Site is located within Precipitation Zone 3.

Onsite Flow Calculations (Basins 10, 20, and 30)
 $A_p = 0.88 \text{ ac}$, $A_c = 0.03 \text{ ac}$, $A_o = 0.46 \text{ ac}$
 $Q_{10} = .88(1.19) + .03(2.00) + .46(3.39) = 2.67 \text{ cfs}$
 $Q_{100} = .88(2.60) + .03(3.45) + .46(5.02) = 4.70 \text{ cfs}$
Offsite Flow Calculations
 $A_p = 0.15 \text{ ac}$
 $Q_{10} = .15(3.39) = 0.51 \text{ cfs}$
 $Q_{100} = .15(5.02) = 0.75 \text{ cfs}$

PROPOSED DRAINAGE CONCEPT: A three-story building addition with additional parking is proposed as shown. New landscaping will be developed on all other areas.

Runoff from Basin 10 will flow to a detention pond with a storage area of 1265 cu ft which will be evacuated by a sump pump. The sump pump discharge rate is 45 gpm (0.10 cfs). Maximum pond discharge for 10-year runoff will be the sump pump rate. Maximum pond discharge for the 100-year runoff will be the sump pump rate, 0.10 cfs and an overflow rate of 0.15 cfs or a total of 0.25 cfs. Basin 20 flows will combine with Basin 10 flows and runoff into the northerly parking lot drive. Basin 30 flows will runoff into the southerly parking lot drive.

Basin 10 Flow Calculations
 $A_p = .04 \text{ ac}$, $A_c = .08 \text{ ac}$, $A_o = .15 \text{ ac}$
 $Q_{10} \text{ (uncontrolled)} = .04(1.19) + .08(2.00) + .15(3.39) = 0.72 \text{ cfs}$
 $Q_{10} \text{ (controlled)} = 0.10 \text{ cfs}$
 $Q_{100} \text{ (uncontrolled)} = .04(2.60) + .08(3.45) + .15(5.02) = 1.13 \text{ cfs}$
 $Q_{100} \text{ (controlled)} = 0.25 \text{ cfs}$

Basin 20 Flow Calculations
 $A_c = .05 \text{ ac}$, $A_p = .22 \text{ ac}$
 $Q_{10} = .05(2.00) + .22(3.39) = 0.85 \text{ cfs}$
 $Q_{100} = .05(3.45) + .22(5.02) = 1.28 \text{ cfs}$

Basin 30 Flow Calculations
 $A_p = .12 \text{ ac}$, $A_c = .10 \text{ ac}$, $A_o = .61 \text{ ac}$
 $Q_{10} = .12(1.19) + .10(2.00) + .61(3.39) = 2.41 \text{ cfs}$
 $Q_{100} = .12(2.60) + .10(3.45) + .61(5.02) = 3.72 \text{ cfs}$

Q_{100} Runoff Summary
 Existing = 4.70 cfs
 Developed = .25 + 1.28 + 3.72 = 5.25 cfs
 Increase = 0.55 cfs



ENGINEER'S CERTIFICATION:
I, THOMAS O. ISAACSON, LICENSED UNDER THE LAWS OF THE STATE OF NEW MEXICO, DO HEREBY CERTIFY THAT THIS PROJECT WAS CONSTRUCTED IN SUBSTANTIAL COMPLIANCE WITH THE APPROVED PLAN DATED 12/10/97 (CITY APPROVAL LETTER DATED 01/12/98) AS FIELD VERIFIED BY ALBUQUERQUE SURVEYING COMPANY, NMLS NO. 3794 ON 03/17/98 IN ACCORDANCE WITH THE "NEW MEXICO ENGINEERING AND SURVEYING ACT" SECTION 61-23-1 THROUGH 61-23-32 NMSD (1979).

THOMAS O. ISAACSON, PE & LS NO. 3895

DATE 9/18/98

GENERAL NOTES

- SEE DETAILS FOR VALLEY GUTTER, SIDEWALK CULVERTS AND SUMP PUMP ON SHEET C-2.

KEYED CONSTRUCTION NOTES

- 24" WIDE SIDEWALK CULVERT
TOP CULVERT = 82.95
FL = 82.45
- 4' WIDE CONCRETE VALLEY GUTTER
- BUILD 18" WIDE CURB & GUTTER
- 12" SCHEDULE 40 PVC SUMP PUMP DISCHARGE LINE, CAST OUTLET END THROUGH PARKING LOT CURB
- 24" WIDE SIDEWALK CULVERT
TOP CULVERT = 82.7
FL = 82.2
- 6" SCHEDULE 40 CI OR PVC ROOF DRAIN LINE EXTENSION, SLOPE = 2%
- SUMP PUMP INLET & VAULT, TOP OF INLET GRATE = 80.5
- DETENTION POND, STORAGE VOLUME = 1265 CU. FT. WSEL = 5282.0
- MODIFY CURB HEIGHT TO MATCH EXISTING SIDEWALK HEIGHT AT CONNECTING POINT

LEGEND - EXISTING

- PP POWER POLE
- ANCHOR
- LT LIGHT POLE
- GP GUARD POST
- RD ROOF DRAIN
- CTV CABLE TELEVISION BOX
- EB ELECTRIC BOX
- TR TELEPHONE RISER
- GM GAS METER
- FH FIRE HYDRANT
- WM WATER METER
- WV WATER VALVE

- SCV SPRINKLER CONTROL VALVE
- C/O CLEAN OUT
- US(GAS) UNDERGROUND UTILITY SPOT (GAS)
- MANHOLE (STORM)
- MANHOLE (SANITARY)
- MANHOLE (TELEPHONE)
- TP TRANSFORMER PAD
- UNDERGROUND ELECTRIC LINE
- UNDERGROUND WATER LINE
- UNDERGROUND SANITARY SEWER LINE
- FIRE PREVENTION LINE
- UNDERGROUND GAS LINE

LEGEND - PROPOSED


- 82.8 FINISH GRADE
- (83.50) EXISTING GRADE
- TC TOP OF CURB
- TSW TOP OF SIDEWALK
- TSWC TOP OF SIDEWALK CULVERT
- EL FLOW LINE
- ROOF DRAIN LOCATIONS
- DRAINAGE ANALYSIS BOUNDARY LINE
- BASIN BOUNDARY LINE
- BASIN 100 BASIN NUMBER
- FLOW DIRECTION

no. date revision



dekker/perich & associates

Grand Court Addition
Assisted Living Residence
Albuquerque, New Mexico

GRADING & DRAINAGE PLAN

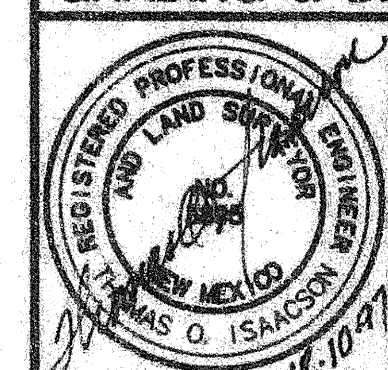

job no: 97048
 drn. by: MD
 ckd. by: TI
 issued: 1120.97
 sheet C-1
 of

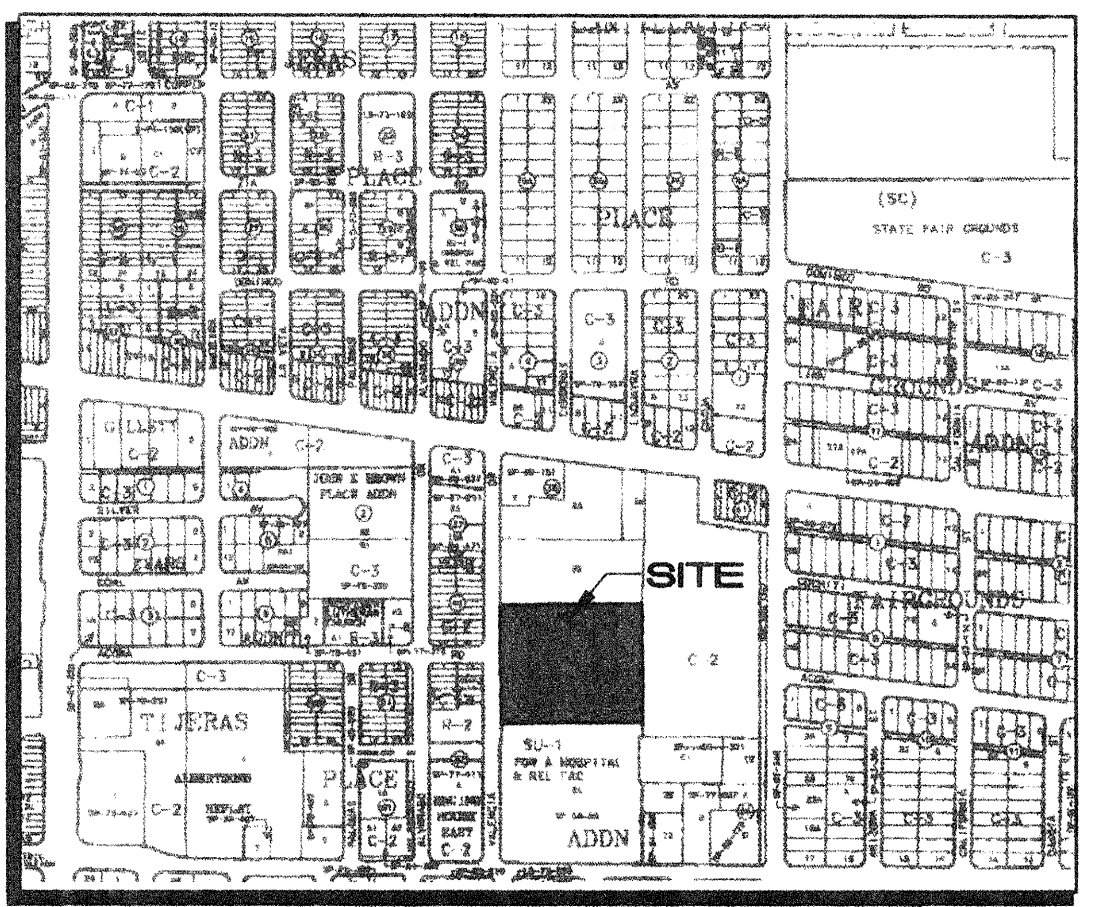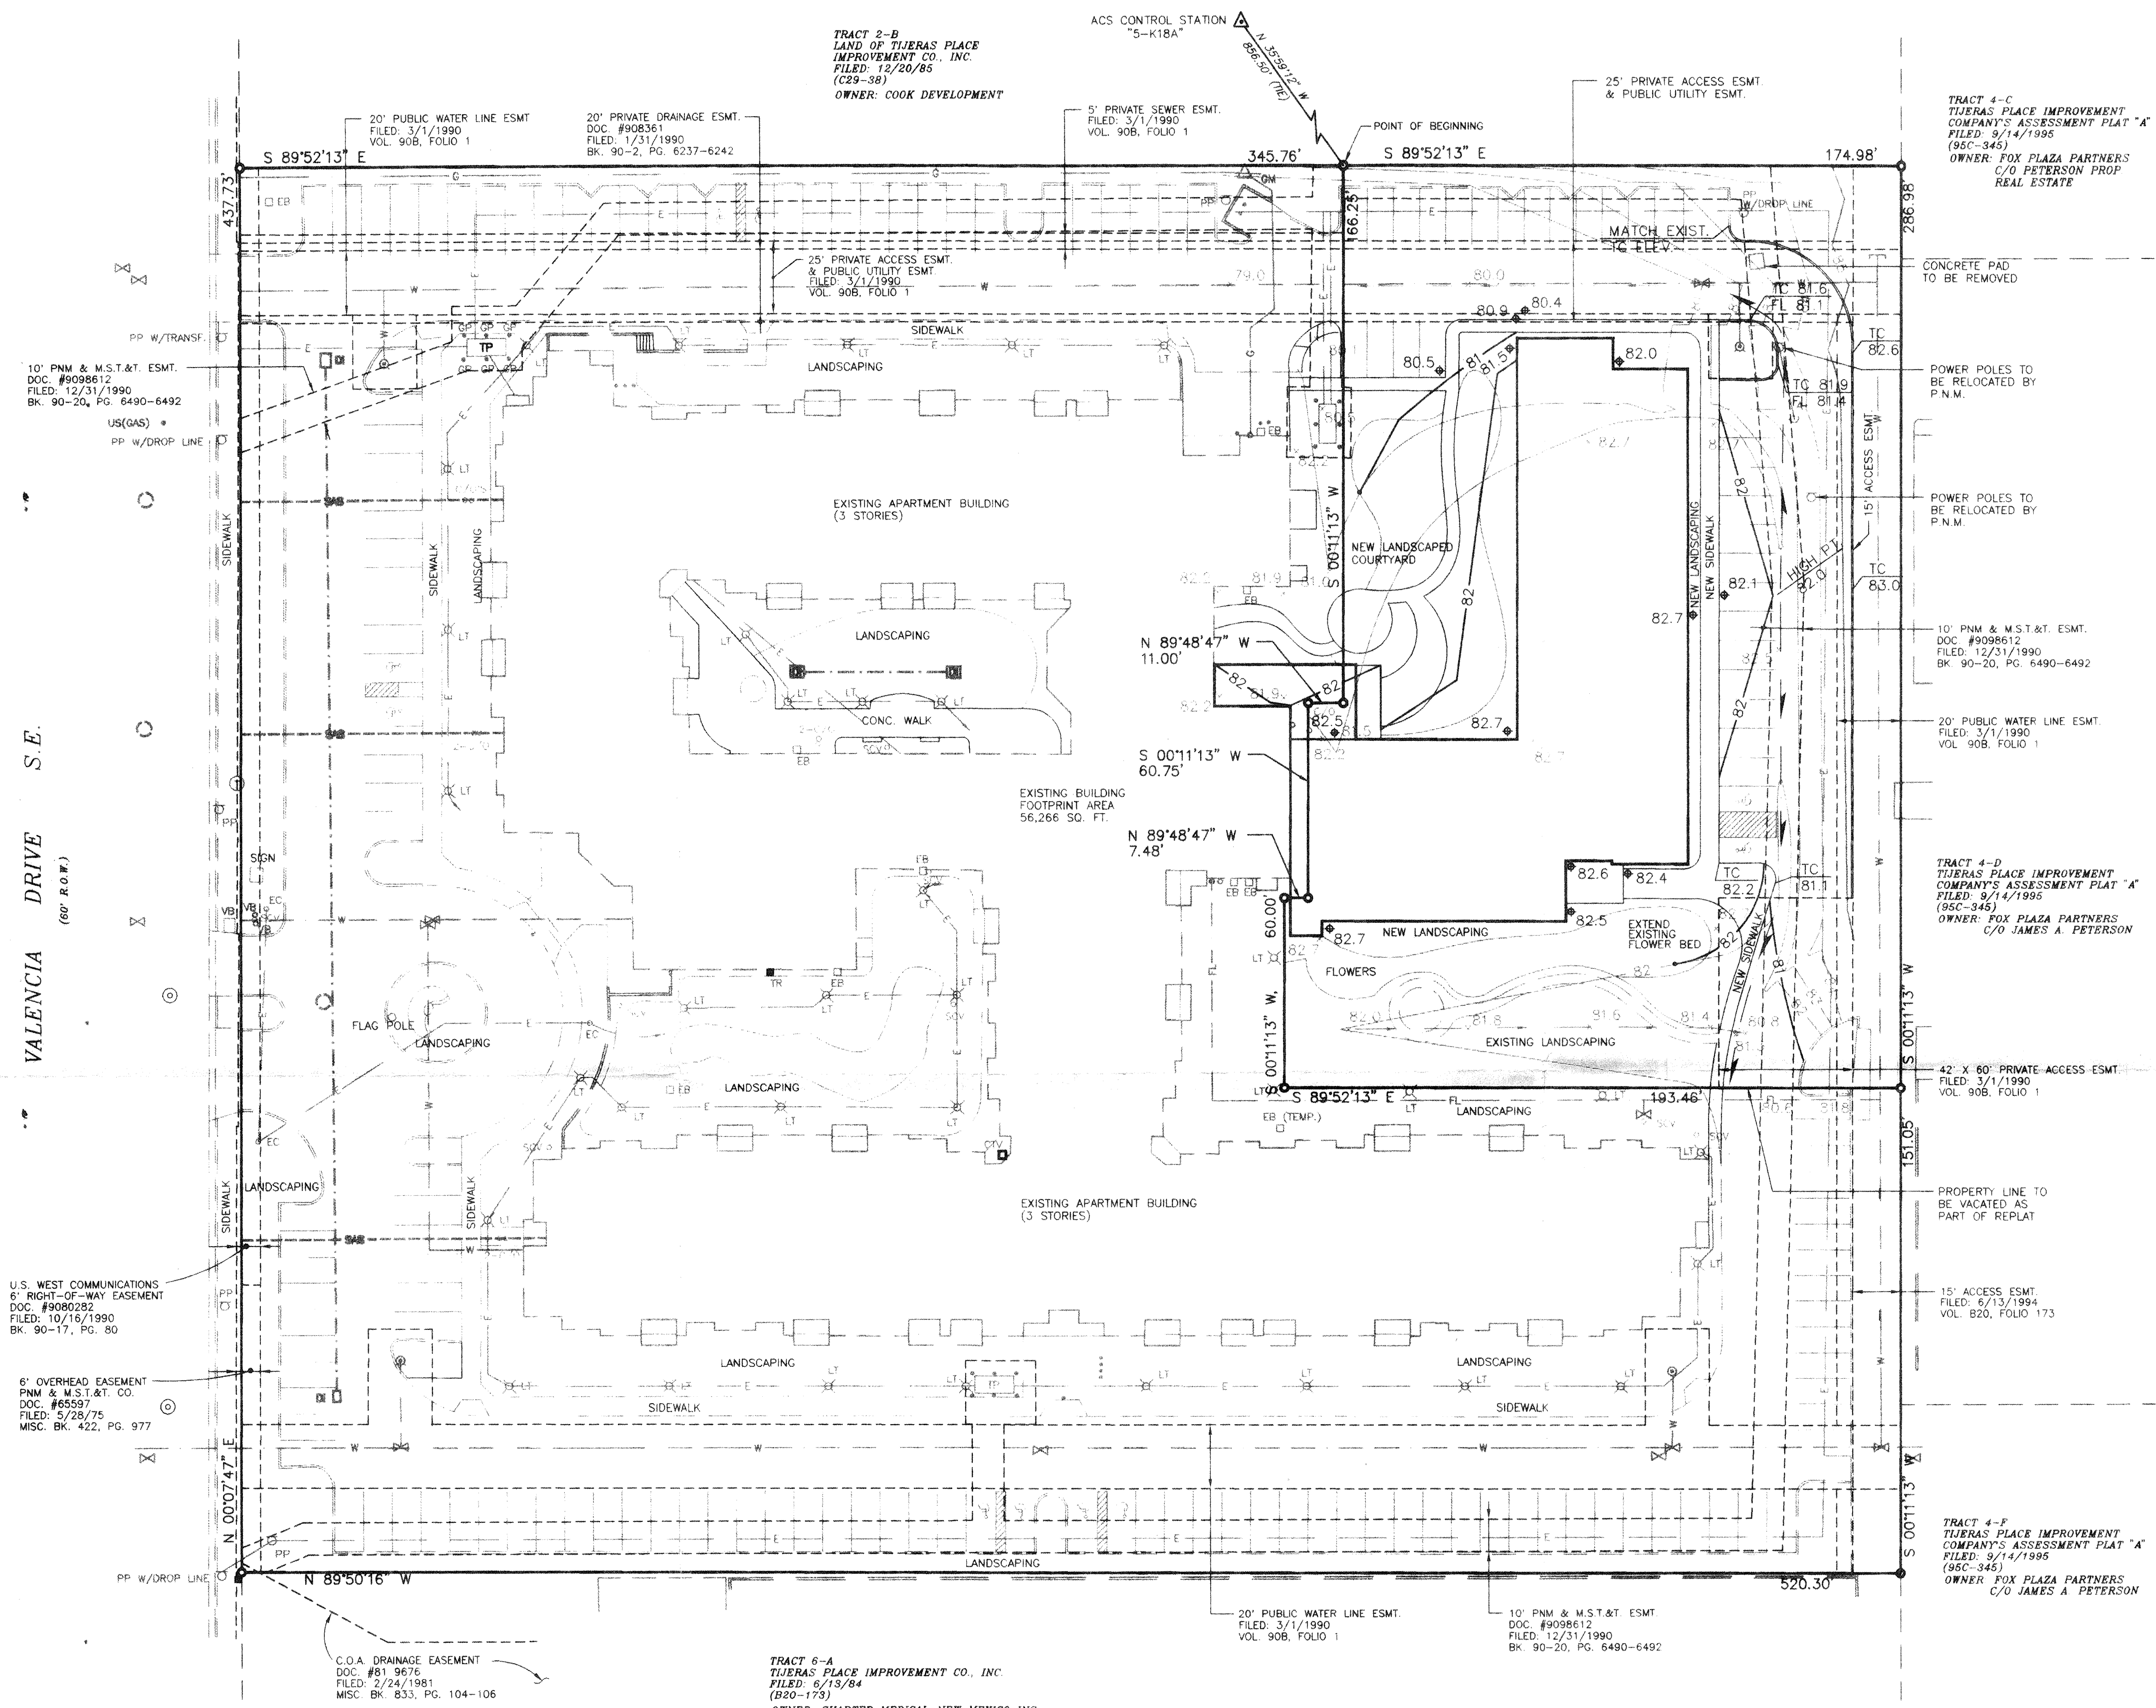

SCALE:
1"=30'

LEGAL DESCRIPTION: TRACT 5-A-2, TIJERAS PLACE IMPROVEMENT CO., INC., ALBUQUERQUE, NEW MEXICO

ENGINEER: ISAACSON AND ARFMAN, P.A.
ATTN: FRED C. ARFMAN, P.E.
128 MONROE STREET, NE
ALBUQUERQUE, NEW MEXICO 87108
(505)268-8828

SURVEYOR: ALBUQUERQUE SURVEYING CO., INC.
2119 MENAUL BOULEVARD, NE
ALBUQUERQUE, NEW MEXICO 87107
(505)884-2036

BENCHMARK: CITY OF ALBUQUERQUE CONTROL STATION "S-K18A"
LOCATED ON THE NORTH RIGHT-OF-WAY OF CENTRAL AVENUE BETWEEN
ALVARADO DRIVE AND VALENCIA DRIVE NE
ELEVATION = 5277.51

FLOOD HAZARD STATEMENT: THE SOUTHERLY AND WESTERLY PORTION OF TRACT 5-A-1 (EXISTING DEVELOPMENT) LIES WITHIN FLOOD ZONE "AO" (DEPTH 1 FT.). THE REMAINDER OF TRACT 5-A-1, AND TRACT 5-A-2 (SUBJECT SITE), LIE WITHIN FLOOD ZONE "X" (AREAS OF 500-YEAR FLOOD), AS SHOWN ON FEMA FLOOD INSURANCE RATE MAP NO. 3500160354, EFFECTIVE DATE SEPTEMBER 20, 1996.

APPROVED DRAINAGE AND GRADING PLAN: THE CITY HYDROLOGY DIVISION HAS PREVIOUSLY APPROVED A TOTAL SITE DRAINAGE PLAN (K-18/D-19) ON 19 PREVIOUS PLAN ALLOWED FOR FREE DISCHARGE ONTO VALENCIA DRIVE VIA BOTH STREET (OVERLAND) AND STORM DRAIN.

EXISTING CONDITIONS: TRACT 5-A-2 DOES NOT ACCEPT OFFSITE STORM WATERS FROM EITHER THE NORTH OR EASTERLY TRACTS. TRACT 5-A-1 (EXISTING IMPROVEMENTS) DISCHARGES DEVELOPED FLOWS ONTO THE TRACT FROM BOTH THE WEST AND SOUTH. ONSITE AND OFFSITE STORM WATERS ARE DIRECTED TO THE PERIMETER ACCESSWAY AND DRAINAGE ROUTES BY EXISTING SWALES.

HYDROLOGY: PRECIPITATION ZONE 2
LAND TREATMENT "C"
AREA = 1.1936 AC (51,993 SF)
WT. E = 1.13 INCHES
TOTAL $Q_p = (3.14)(1.19) = 3.7$ CFS
 $VOL_{(360)} = (1.13)(1.19)/12 = 0.112$ AC-FT = 4881 CU FT
STORM WATERS ARE SPLIT 65% (2.4 CFS) TO THE NORTH AND 35% (1.3 CFS) TO THE EAST.

PROPOSED CONDITIONS: TRACT 5-A-2 SHALL BE BUILT-OUT IN CONFORMANCE WITH THE APPROVED PLAN AS THE LAST THREE-STORY WING OF THE ASSISTED LIVING FACILITY. ADDITIONAL PARKING, PAVED ACCESS AND PEDESTRIAN WAYS AND NEW LANDSCAPING SHALL BE PROVIDE FOR 100% OF THE PROPOSED GROUND COVER.

AREA TREATMENT B: 0.34 AC (14,810 SF)
AREA TREATMENT D: 0.85 AC (37,030 SF)
WT. E = $\frac{(0.78)(0.34) + (0.85)(2.12)}{1.19} = 1.74$ INCHES
TOTAL $Q_p = (2.28)(0.34) + (4.70)(0.85) = 4.8$ CFS
 $VOL_{(360)} = (1.74)(1.19) = 2.07/12 = 0.173$ AC-FT = 7,516 CU FT

LEGEND

- | | | | |
|--------|----------------------|-------------------------|---------------------------------|
| PP | POWER POLE | SPRINKLER CONTROL VALVE | |
| ANCHOR | | CLEAN OUT | |
| LT | LIGHT POLE | US(GAS) | UNDERGROUND UTILITY SPOT (GAS) |
| GP | GUARD POST | MANHOLE (STORM) | |
| RD | ROOF DRAIN | MANHOLE (SANITARY) | |
| CTV | CABLE TELEVISION BOX | MANHOLE (TELEPHONE) | |
| EB | ELECTRIC BOX | TP | TRANSFORMER PAD |
| TR | TELEPHONE RISER | E | UNDERGROUND ELECTRIC LINE |
| GM | GAS METER | W | UNDERGROUND WATER LINE |
| FD | FIRE HYDRANT | SS | UNDERGROUND SANITARY SEWER LINE |
| WM | WATER METER | FL | FIRE PREVENTION LINE |
| WV | WATER VALVE | G | UNDERGROUND GAS LINE |

UTILITY NOTE:
THE PROPOSED ADDITION HAS A PUBLIC SURROUNDING PUBLIC WATER LINE AND FIRE PROTECTION. WATER AND SANITARY SEWER SERVICES SHALL BE OFF OF THIS EXISTING UTILITY STUBS PROVIDED TO SERVE THIS ADDITION.

ISAACSON & ARFMAN, P.A.
Consulting Engineering Associates
128 Monroe Street N.E.
Albuquerque, New Mexico
966PLIM.DWG.dlv 6/27/97


no. date revision

dekker/perich & associates
architecture
planning
interiors
6501 American Parkway, NE, Suite 675
Albuquerque, New Mexico 87110
505.880.9111 Fax 505.880.9080

PRELIMINARY GRADING PLAN
VALENCIA COURT RETIREMENT COMMUNITY
ALBUQUERQUE, NM

CONCEPTUAL GR. / DR. AND UTIL. PLAN

Job no: 97048
drn.by: DLV
ckd.by: FA
Issued: 07-03-97
sheet 3 of 5

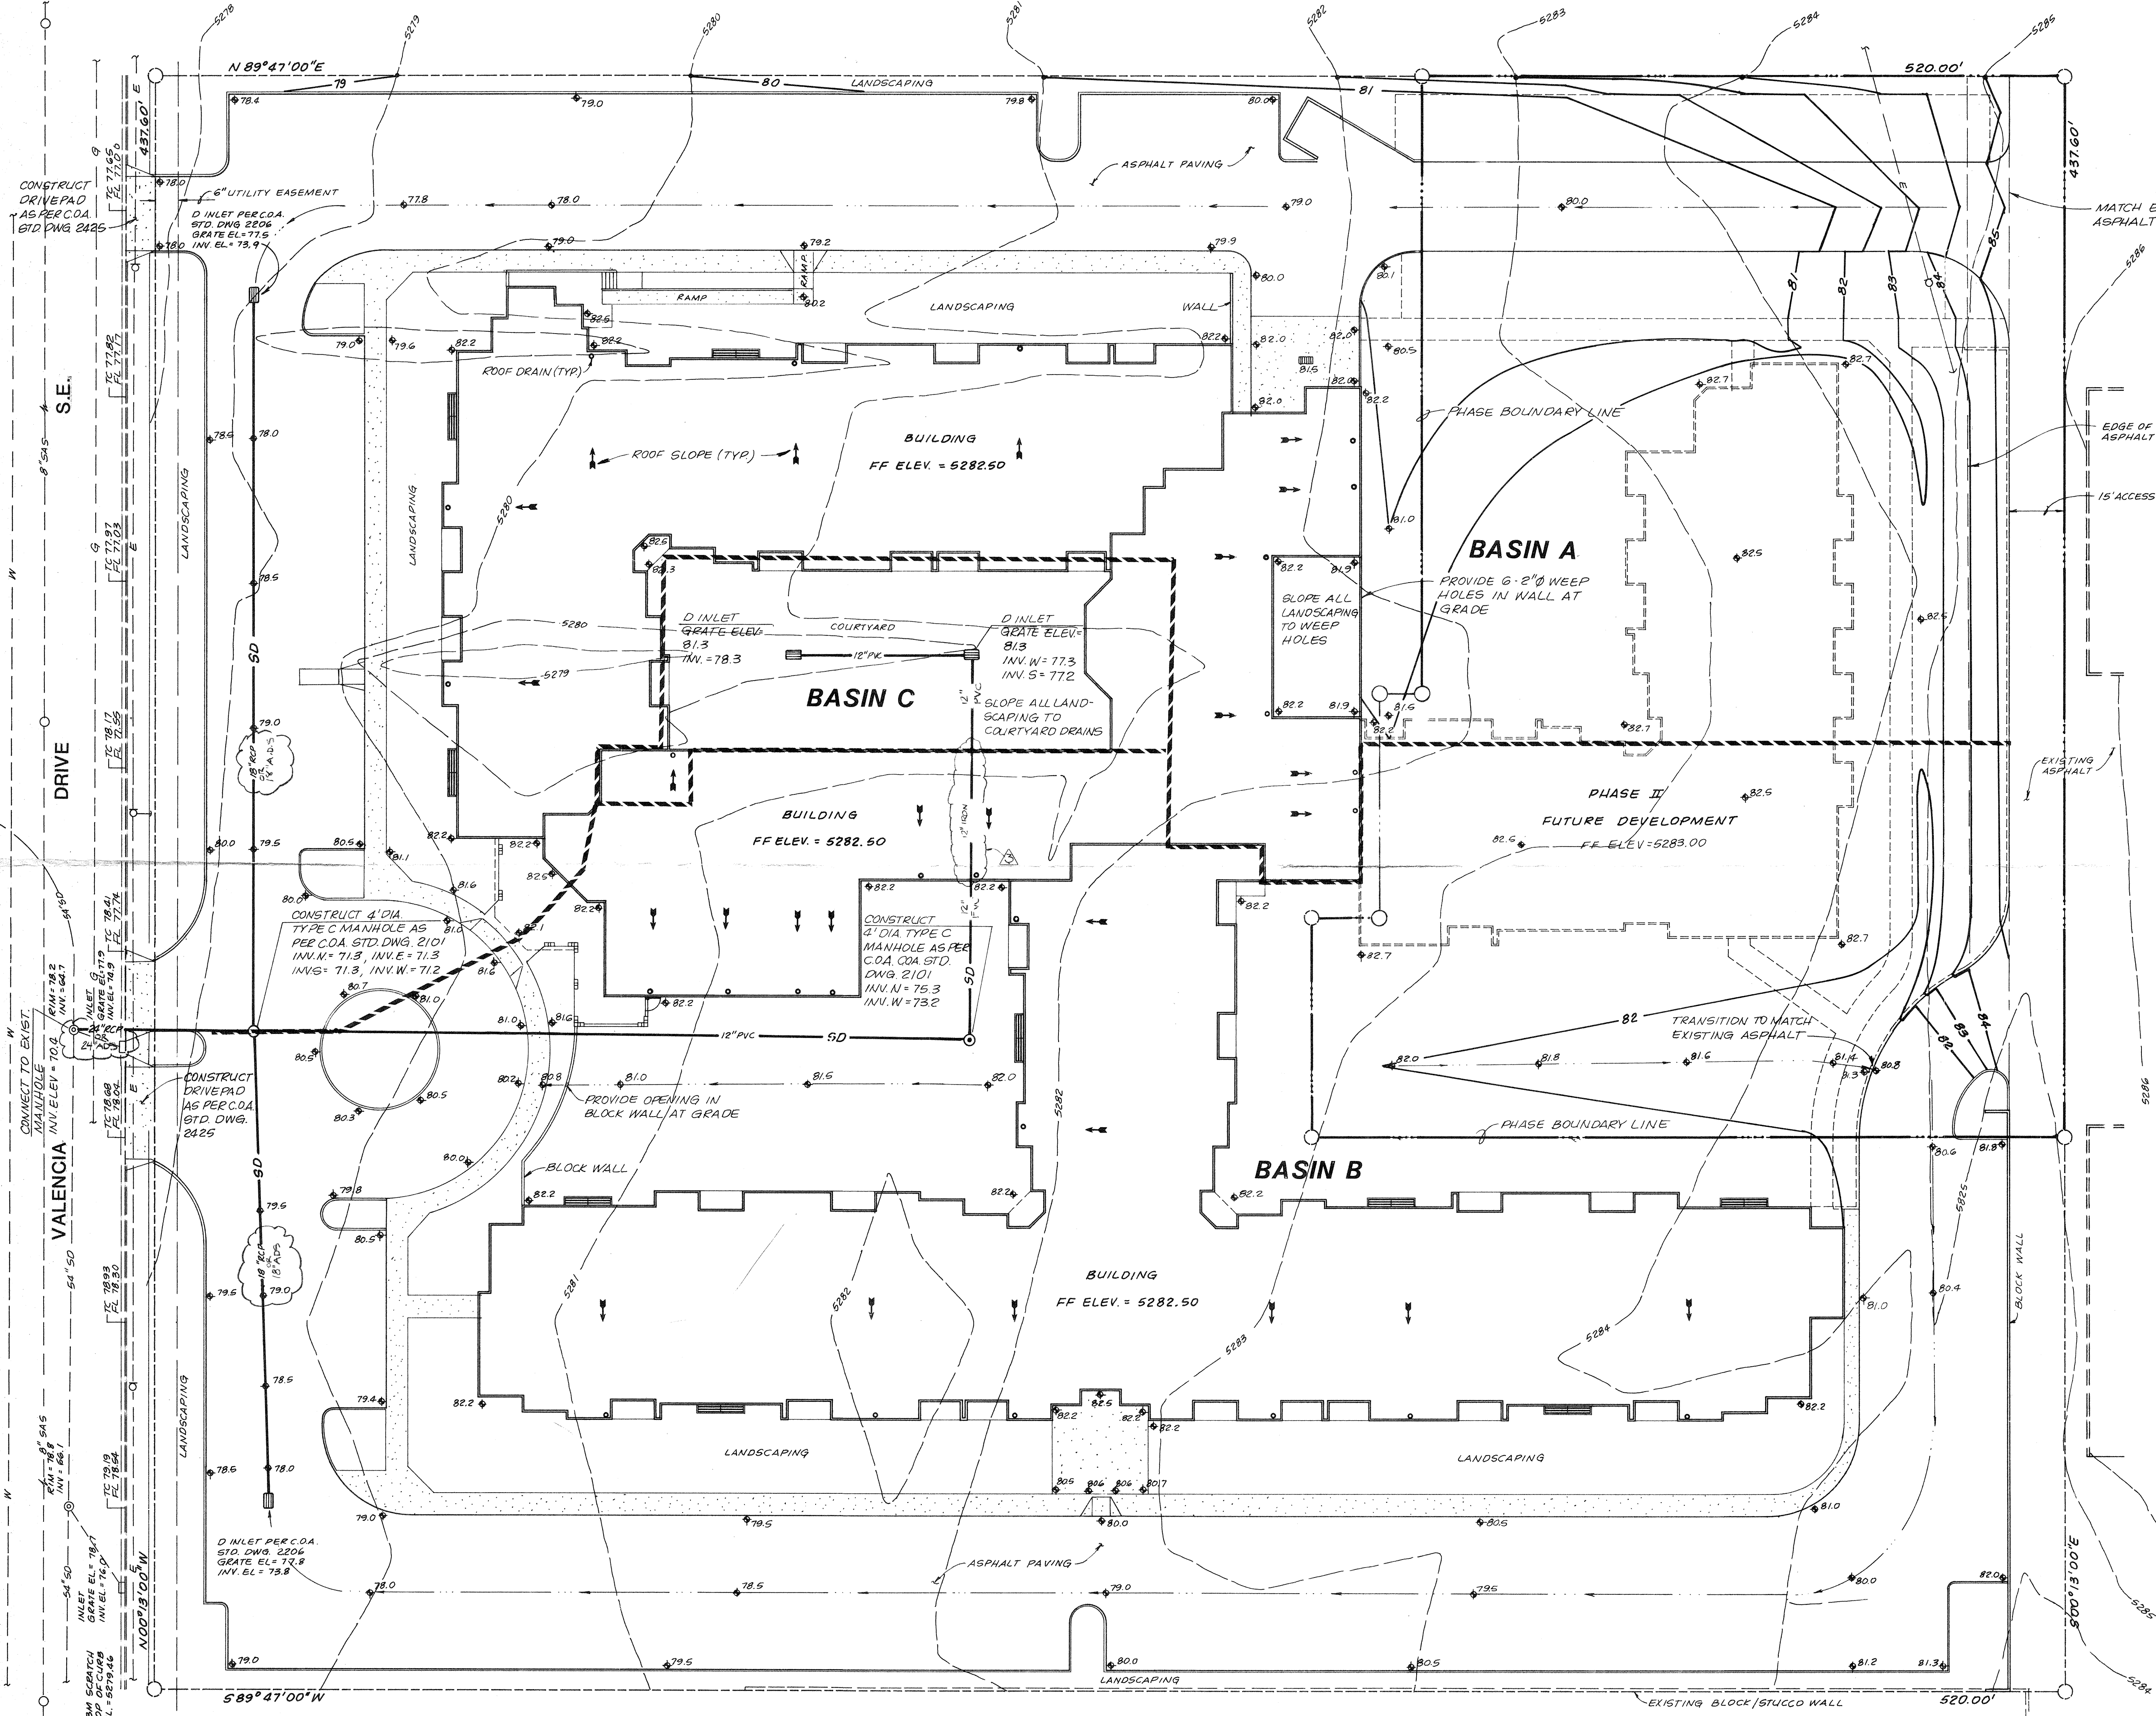

NOTE: ROOF RUNOFF SHALL NOT BE ALLOWED WITHIN LAND-SCAPED AREAS ADJACENT TO STRUCTURES.

CERTIFICATION
 THIS IS TO CERTIFY THAT THE GRADING AND DRAINAGE WAS CONSTRUCTED IN SUBSTANTIAL COMPLIANCE WITH THIS DRAWING.

THOMAS T. MANN, JR., SUPERVISOR
 3792
 NEW MEXICO
 PROFESSIONAL ENGINEER AND LAND SURVEYOR

1/6/25/91

GRADING AND DRAINAGE PLAN

FEBRUARY 6, 1989 SCALE: 1"=20'

CLAUDIO VIGIL ARCHITECTS

VALENCIA RETIREMENT COMMUNITY

200 VALENCIA DRIVE S. E.
 ALBUQUERQUE, NEW MEXICO

SHEET C-3

RECEIVED
 MAR 27 1991
 HYDROLOGY DIVISION

825 Pennsylvania NE Albuquerque, NM 87110
 505/265-3000