CITY OF ALBUQUERQUE

Planning Department Alan Varela, Director



Mayor Timothy M. Keller

October 28, 2022

Graeme Means, P.E High Mesa Consulting Group 6010-B Midway Park Blvd. Albuquerque, NM 87109

Re: Fire Flower 214 San Pedro Dr. NE Traffic Circulation Layout Engineer's Stamp 10-11-2022 (K18-D112)

Dear Mr. Means,

The TCL submittal received 10-13-2022 is approved for Building Permit by Transportation. A copy of the stamped and signed plan will be needed for each of the building permit plans. Please keep the original to be used for certification of the site for final C.O. for Transportation.

- PO Box 1293 When the site construction is completed and an inspection for Certificate of Occupancy (C.O.) is requested, use the original City stamped approved TCL for certification. Redline any minor changes and adjustments that were made in the field. A NM registered architect or engineer must stamp, sign, and date the certification TCL along with indicating that the development was built in "substantial compliance" with the TCL. Submit this certification, the TCL, and a completed Drainage and Transportation Information Sheet to front counter personnel for log in and evaluation by Transportation.
- NM 87103 Once verification of certification is completed and approved, notification will be made to Building Safety to issue Final C.O. To confirm that a final C.O. has been issued, call Building Safety at 924-3690.

www.cabq.gov

Sincerely,

Ernest Armijo, P.E. Principal Engineer, Planning Dept. Development Review Services

C: CO Clerk, File




City of Albuquerque

Planning Department Development & Building Services Division

DRAINAGE AND TRANSPORTATION INFORMATION SHEET (REV 6/2018)

Project Title:	Building Pe	ermit #: Hydrology File #:
DRB#:	EPC#:	Work Order#:
Legal Description:		
City Address:		
Applicant:		Contact:
Address:		
		E-mail:
Other Contact:		Contact:
Address:		
Phone#:	Fax#:	E-mail:
TYPE OF DEVELOPMENT:	PLAT (# of lots)	RESIDENCE DRB SITE ADMIN SITE
IS THIS A RESUBMITTAL?	YesNo	
DEPARTMENT TRANSPORTA	FIONHY	DROLOGY/DRAINAGE
Check all that Apply:		TYPE OF APPROVAL/ACCEPTANCE SOUGHT: BUILDING PERMIT APPROVAL
TYPE OF SUBMITTAL: ENGINEER/ARCHITECT CERTIFI PAD CERTIFICATION CONCEPTUAL G & D PLAN GRADING PLAN DRAINAGE REPORT DRAINAGE MASTER PLAN FLOODPLAIN DEVELOPMENT PE ELEVATION CERTIFICATE CLOMR/LOMR TRAFFIC IMPACT STUDY (TIS) STREET LIGHT LAYOUT OTHER (SPECIFY) PRE-DESIGN MEETING?	ERMIT APPLIC Γ (TCL)	CERTIFICATE OF OCCUPANCY PRELIMINARY PLAT APPROVAL SITE PLAN FOR SUB'D APPROVAL SITE PLAN FOR BLDG. PERMIT APPROVAL FINAL PLAT APPROVAL SIA/ RELEASE OF FINANCIAL GUARANTEE FOUNDATION PERMIT APPROVAL GRADING PERMIT APPROVAL GRADING PERMIT APPROVAL GRADING/ PAD CERTIFICATION WORK ORDER APPROVAL CLOMR/LOMR FLOODPLAIN DEVELOPMENT PERMIT OTHER (SPECIFY)
DATE SUBMITTED:	-	
COA STAFF:		C SUBMITTAL RECEIVED:

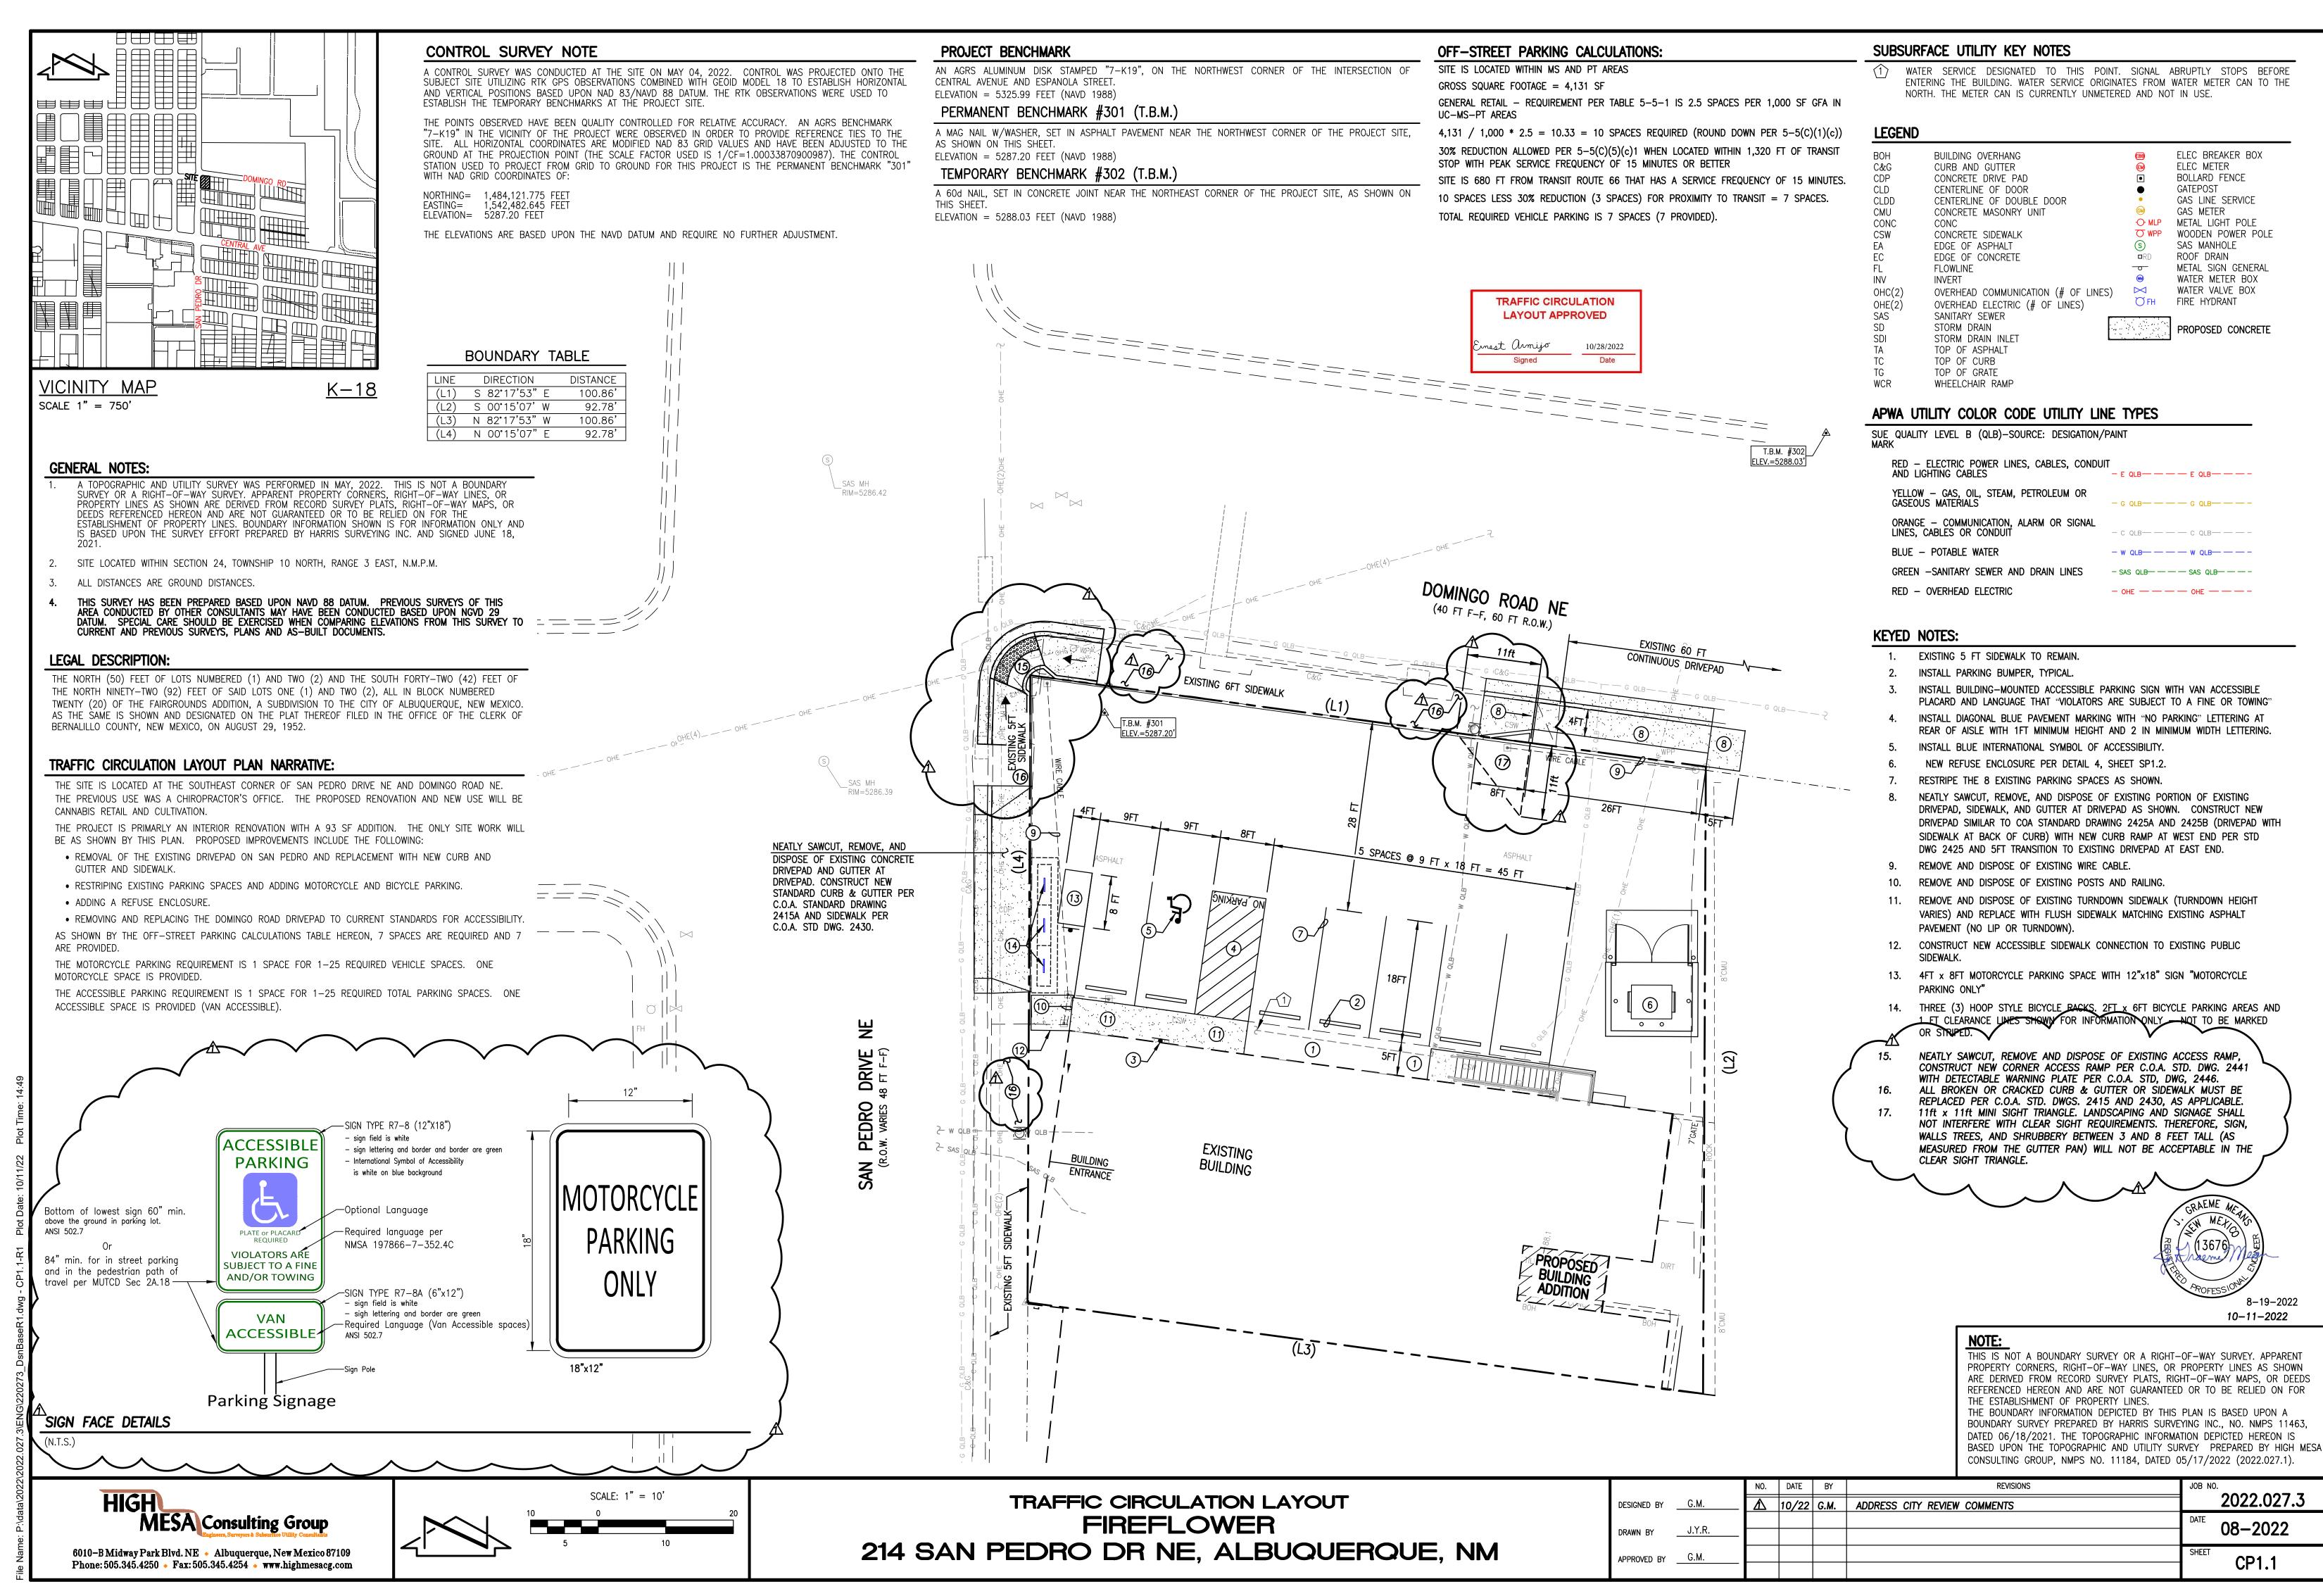

WATER SERVICE DESIGNATED TO THIS POINT. SIGNAL ABRUPTLY STOPS BEFORE ENTERING THE BUILDING. WATER SERVICE ORIGINATES FROM WATER METER CAN TO THE

