## CITY OF ALBUQUERQUE

Planning Department
David Campbell, Director



January 24, 2019

George Rodriguez 12800 San Juan N.E Albuquerque, NM 87123

RE: Route 66 Plaza

8521 Central NE

**Grading Plan Stamp Date: 1/14/19** 

**Hydrology File: K19D043** 

Dear Mr. Rodriguez:

Based on the submittal received on 1/16/19, the grading plan cannot be approved for Building Permit until the following are corrected:

PO Box 1293

1. Include project benchmark and datum.

Albuquerque

2. The Engineer's Seal and the FIRM Map are illegible. Also, it isn't necessary to include the Building Permit APPROVAL Stamp.

NM 87103

3. Payment of the Fee in Lieu (Amount =  $306CF \times \$8/CF = \$2448$ ) for the required stormwater quality volume must be made. Include a copy of the paid receipt when resubmitting.

11111 6/103

4. Because of the minor nature of these corrections, the resubmittal fee is waived. Please include a copy of this letter when resubmitting to avoid to resubmittal fee.

www.cabq.gov

If you have any questions, please contact me at 924-3695 or dpeterson@cabq.gov.

Sincerely,

Dana Peterson, P.E.

Senior Engineer, Planning Dept. Development Review Services



## City of Albuquerque

Planning Department

Development & Building Services Division

DRAINAGE AND TRANSPORTATION INFORMATION SHEET (REV 11/2016)

Project Title: ROUTE 66 PLAZA	_ Building	Permit #: BP-2016-34782 Hydrology File #: K190043
DRB#:	EPC#:	Work Order#:
		K 7 , AND PORTION OF VACATED ALLEY, MESS VERD
City Address: <u>8521 CENTRAL</u>	LYE.,	V.E.
į		
Applicant: WILLISM GSRDSER	~	Contact: WILL GARDNER
Address: 904 COPPERHEAD CT.	H.E.,	LLBUQUERQUE, NEW MEXICO 87113
Phone#: 505-507-2669	_ Fax#:	E-mail: Wegardner/Egm
Other Contact: GEORGE T. RODKIGUE	Z-DEVEL	L-CONSULTANT Contact: GEORGE RODRIGUE
Address: 12800 SAN JUAN N.E.	, LLBO	UQUERQUE, NEW MEXICO 87123
Phone#: <u>505-610-0593</u>	Fax#:	E-mail: pakradehotmai
Check all that Apply:		ı
		TYPE OF APPROVAL/ACCEPTANCE SOUGHT:
DEPARTMENT: HYDROLOGY/ DRAINAGE		BUILDING PERMIT APPROVAL
TRAFFIC/ TRANSPORTATION		CERTIFICATE OF OCCUPANCY
TYPE OF SUBMITTAL:		PRELIMINARY PLAT APPROVAL
ENGINEER/ARCHITECT CERTIFICATIO	N	SITE PLAN FOR SUB'D APPROVAL
		SITE PLAN FOR BLDG. PERMIT APPROVAL
CONCEPTUAL G & D PLAN		FINAL PLAT APPROVAL
✓ GRADING PLAN (EXISTING)		
DRAINAGE MASTER PLAN		SIA/ RELEASE OF FINANCIAL GUARANTEE
DRAINAGE REPORT		FOUNDATION PERMIT APPROVAL
CLOMR/LOMR		GRADING PERMIT APPROVAL
:		SO-19 APPROVAL
TRAFFIC CIRCULATION LAYOUT (TCL	·)	PAVING PERMIT APPROVAL
TRAFFIC IMPACT STUDY (TIS)		GRADING/ PAD CERTIFICATION
		WORK ORDER APPROVAL
OTHER (SPECIFY)		CLOMR/LOMR
<u>✓</u> PRE-DESIGN MEETING?		
	-	OTHER (SPECIFY) <u>DRAINED PLAN</u>
IS THIS A RESUBMITTAL?:YesYesN	lo	OTHER (SPECIFY) TRANSCE FLAN
DATE SUBMITTED: 01-16-19	By:	GEORGE T. RODRIGUEZ
CIO A CITTA P.P.	****************************	
COA STAFF:	ELECTRO	ONIC SUBMITTAL RECEIVED:
	FEE PAIL	);



#### TREASURY DIVISION DAILY DEPOSIT


## Transmittals for: PROJECTS Only

# Payment In-Lieu for Storm Water Quality Volume Requirement

CASH COUNT	AMOUNT	ACCOUNT NUMBER	FUND NUMBER	BUSINESS UNIT	PROJECT ID	ACTIVITY ID	AMOUNT
TOTAL CHECKS	\$ 2448.00	461615	305	PCDMD	24_MS4	7547210	\$ 2448.00
TOTAL AMOUNT						TOTAL DEPOSIT	\$2448.00

Hydrology#: K19D043 Name: Route 66 Plaza, 14,119 sf imp.  Payment In-Lieu For Storm Water Quality
Volume Requirement
Address/Legal Description: 8521 Central NE Lots 6-11, Blk 7 & Portion of Vacated Alley, Mesa Verde Addition
DEPARTMENT NAME: Planning Department/Development Review Services, Hydrology
PREPARED BY Dana Peterson PHONE 924-3695
BUSINESS DATE 1/24/19
DUAL VERIFICATION OF DEPOSIT A TOTAL EMPLOYEE SIGNATURE
AND BY EMPLOYEE SIGNATURE
REMITTER: AMOUNT: BANK:
CHECK #: DATE ON CHECK:

The Payment-in-Lieu can be paid at the Plaza del Sol Treasury, 600 2<sup>nd</sup> St. NW. **Bring two copies of this invoice to the Treasury** and provide a copy of the receipt to Hydrology, Suite 201, 600 2<sup>nd</sup> St. NW, or e-mail with the Hydrology submittal to PLNDRS@cabq.gov.

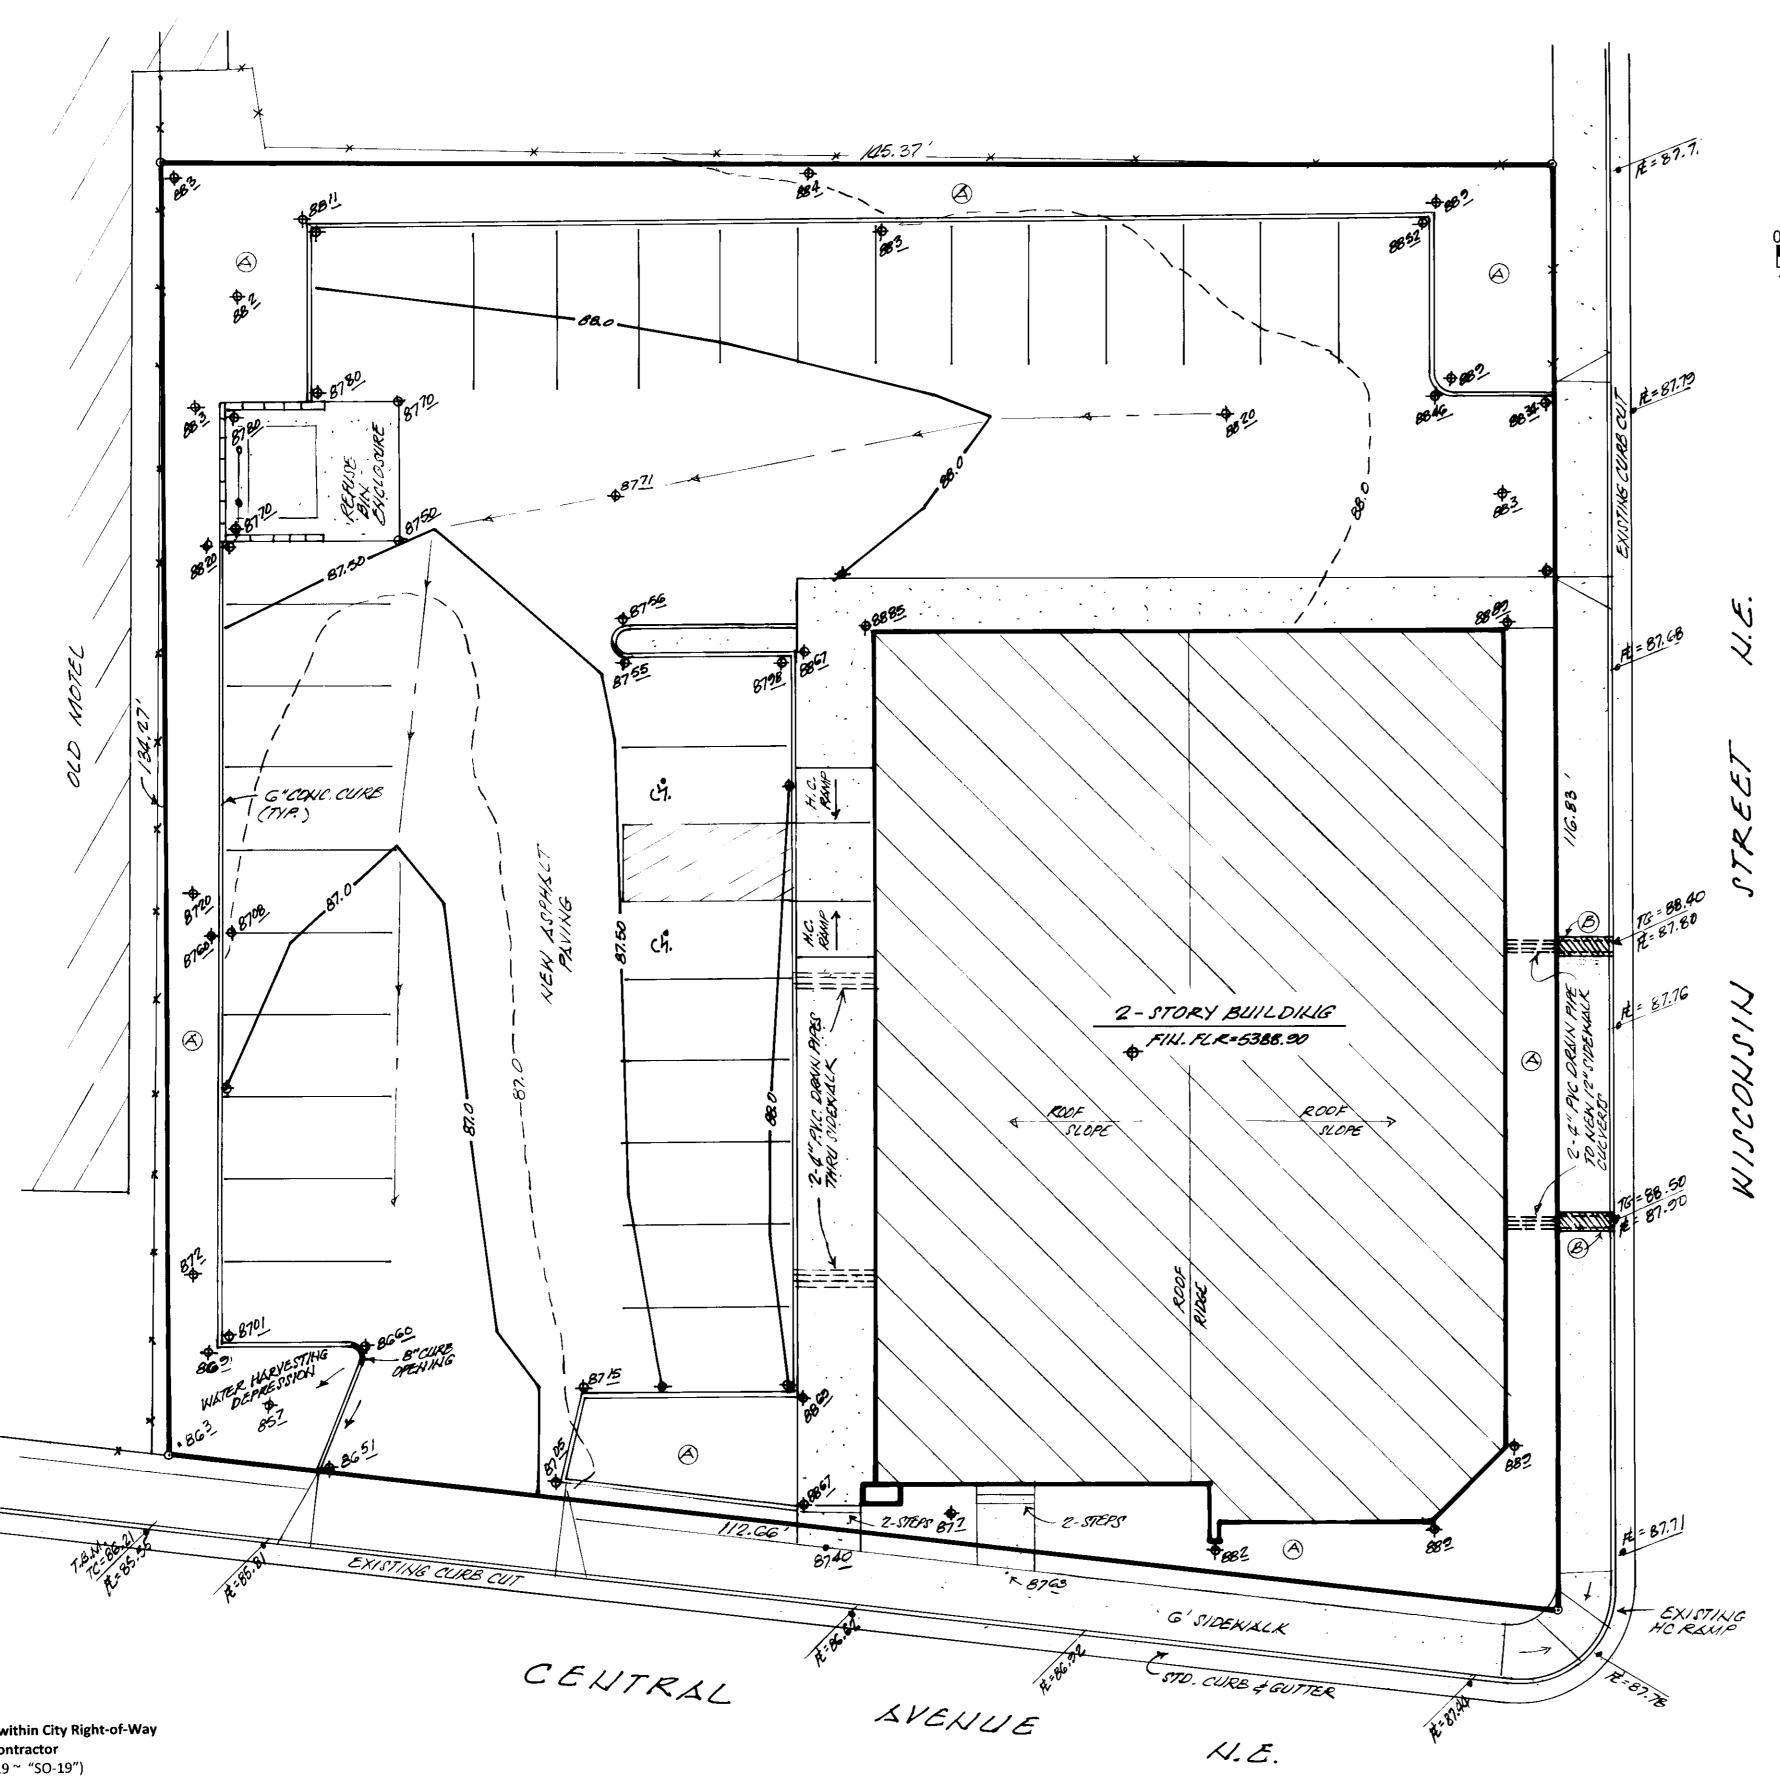

Private Drainage Facilities within City Right-of-Way
Notice to Contractor
(Special Order 19 ~ "SO-19")

- 1. An excavation permit will be required before beginning any work within City Right-Of-Way.
- All work on this project shall be performed in accordance with applicable federal, state and local laws, rules and regulations concerning construction safety and health.
- Two working days prior to any excavation, the contractor must contact New Mexico One Call, dial "811" [or (505) 260-1990]
- for the location of existing utilities.

  4. Prior to construction, the contractor shall excavate and verify the locations of all obstructions. Should a conflict exist, the contractor shall notify the engineer so that the conflict can be recolved with a minimum amount of delay.
- resolved with a minimum amount of delay.

  5. Backfill compaction shall be according to traffic/street use.

  6. Maintenance of the facility shall be the responsibility of the
- 6. Maintenance of the facility shall be the responsibility of the owner of the property being served.
- Work on arterial streets may be required on a 24-hour basis.
   Contractor must contact Jason Rodriguez at 235-8016 and Construction Coordination at 924-3416 to schedule an inspection.
- PROPOSED OR EXISTING CONCRETE SURFACE = \( \)

  EXISTING FENCE LINE = \( \)

  \( \)

  \( \)

  \(

PROPOSED SPOT ELEVATION = + 88.10 /IEN EXISTING

TOP OF CURB ELEVATION = 70 - 87.0

EXISTING SPOT ELEVATION = -- 879

CURB FLOWLINE ELEVATION = # = 87.67

EXISTING CONTOUR ELEVATION = ----87.0--

1) NO PERIMETER BOUNDARY CORNERS HAVE BEEN FIELD ESTABLISHED PER
THIS SURVEY OF THE SUBJECT PROPERTY

2) NO SEARCH HAS BEEN MADE FOR EASEMENTS OF RECORD OTHER THAN

(A) LANDSCAPE / GRAVEL AREA (B) MEKI 12" SIDENIALK CULVERTS PER C.O. A. STD. DING. \* 2236

### ENGINEER'S STATEMENT

I, THE ENGINEER OF RECORD CERTIFY THAT I HAVE PERSONALLY VISITED THE SITE AND THE EXISTING GRADES AND CONTOURS DEPICTED ON THIS PLAN MATCH WHAT PRESENTLY EXISTS AT THIS LOCATION.

LEVI J. VALDEZ, NMPE NO. 5693

### REQUEST FOR "FEE-IN-LIEU" FOR FIRST FLUSH POND VOLUME.


T I HAVE PROJECT SITE = 17,642.0 SQ. FT (0.405 AC.)

MINUS 3,523.0 SQ. FT. (LANDSCAPE AREA)
= 14,119.0 SQ. FT. (IMPERVIOUS AREA "D")

0.26" /12 X 14,119.0 SQ. FT = = 305.9 CU. FT.

305.9 CU. FT. X \$ 8.00/CU. FT. = \$ 2,447.20 (FEE-IN-LIEU AMOUNT)



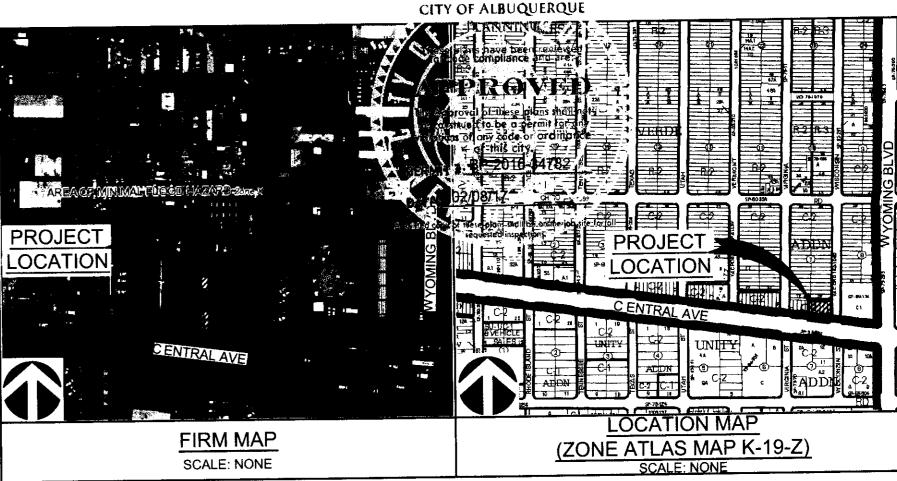

### A.1 PRECIPITATION ZONES

A-1 and on FIGURE A-1.


Bernalillo County's four precipitation zones are indicated in TABLE

TABLE A-1. PRECIPITATION ZONES		
ZONE	LOCATION	
1	West of the Rio Grande	
2	Between the Rio Grande and San Mateo	
3	Between San Mateo and Eubank, North of Interstate 40; and between San Mateo and the East boundary of Range 4 East, South of Interstate 40	
4	East of Eubank, North of Interstate 40; and East of the East boundary of Range 4 East, South of Interstate 40	

TABL	E A-4. LAND TREATMENTS		
Treatment	Land Condition		
A	Soil uncompacted by human activity with 0 to 10 percent slopes. Native grasses, weeds and shrubs in typical densities with minimal disturbance to grading, groundcover and infiltration capacity. Croplands. Unlined Arroyos.		
В	Irrigated lawns, parks and golf courses with 0 to 10 percent slopes. Native grasses, weeds and shrubs, and soil uncompacted by human activity with slopes greater than 10 percent and less than 20 percent.		
С	Soil uncompacted by human activity. Minimal vegetation. Unpaved parking, roads, trails. Most vacant lots. Gravel or rock on plastic (desert landscaping). Irrigated lawns and parks with slopes greater than 10 percent. Native grasses, weeds, and shrubs, and soil uncompacted by human activity with slopes at 20 percent or greater. Native grass, weed and shrub areas with clay or clay loam soils and other soils of very low permeability as classified by SCS Hydrologic Soil Group D.		
D	Impervious areas, pavement and roofs.		
treatments, measur	ontain a mix of land treatments. To determine proportional re respective subareas. In lieu of specific measurement for real percentages in TABLE A-5 may be employed		

TABL	E A-9. PE	A-9. PEAK DISCHARGE (cfs/acre)			
Zone		Treatment 100-YF (2-YR, 10-T			
	A	В	C	D	
1	1.29	2.03	2.87	4.37	
	(0.00, 0.24)	(0.33, 0.76)	(0.47, 1.49)	(1.69, 2.89)	
2	1.56	2.28	3.14	4.70	
	(0.00, 0.38)	(0.08, 0.95)	(0.60, 1.71)	1.86, 3.14)	
3	1.87	2.60	3.45	5.02	
	(0.00, 0.58)	(0.21, 1.19)	(0.78, 2.009)	(2.04, 3.39)	
4	2.20	2.92	3.73	5.25	
	(0.05, 0.87)	(0.38, 1.45)	(1.00, 2.26)	(2.17, 3.57)	

TABLE A-10. PEAK INTENSITY (IN/HR at L=0.2 hour)			
Zone	Intensity	100-YR (2-YR, 10-YR)	
1	4.70 (1.84, 3.14)		
2	5.05 (2.04, 3.41)		
3	5.38 (2.21, 3.65)		
4	5.61 (2.34, 3.83)		

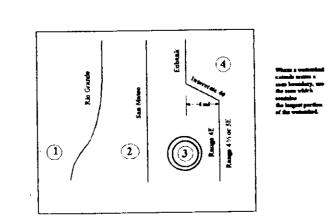

### DRAINAGE NARRATIVE:

THIS SITE IS LOCATED AT THE NORTHWEST CORNER OF THE INTERSECTION OF CENTRAL AVENUE N.E. AND WISCONSIN STREET N.E., IN THE CITY OF ALBUQUERQUE, NEW MEXICO, AND CONTAINS 0.405 ACRES (MORE OR LESS); THE SITE IS LOCATED ON F.E.M.A. FIRM MAP NO. 35001 PANEL 0358 WHICH SHOWS THE SITE TO BE LOCATED IN ZONE 'X' AND THAT NO PORTION OF THE SITE IS LOCATED WITHIN A 100 YEAR FLOOD PLAIN.

THIS PLAN IS BASED ON AN EXISTING 'AS-BUILT' TOPOGRAPHY SURVEY OF THE SUBJECT SITE THAT WAS PERFORMED BY WAYJOHN SURVEYING, INC. OF ALBUQUERQUE, NEW MEXICO, (DATED 09-18-2018). THE PURPOSE OF THIS PLAN IS TO SHOW THE CONSTRUCTED REVISIONS TO THE APPROVED GRADING AND DRAINAGE PLAN OF THE SUBJECT SITE THAT WAS PREPARED BY ABQ ENGINEERING ( JAMES CRAIG HAGELGANTZ, NMPE NO. 15559); SAID REFERENCED DRAINAGE PLAN REQUIRED AN ON-SITE POND TO CAPTURE THE "FIRST FLUSH RUNOFF" FOR DEVELOPMENT PER COA DRAINAGE ORDINANCE. A "FEE-IN-LIEU" OF 'FIRST FLUSH POND VOLUME' IS HEREBY BEING REQUESTED, ( REFERENCE CALCULATIONS SHOWN ON THE PLAN HEREON ).

PROJECT AREA = 0.405 ACRES ZONE : THREE (3)

PRECIPITATION: 360 = 2.60 IN. 1440 = 3.10 IN. 10DAY = 4.90 IN.

TREATMENT A 0.66 IN. 1.87 CFS/AC.

TREATMENT B 0.92 IN. 2.60 CFS/AC.

TREATMENT C 1.29 IN. 3.45 CFS/AC.

EXISTING CONDITIONS: (ORIGINAL)

NEW EXISTING CONDITIONS:

TREATMENT A 0.000 AC. AREA 0.000 AC.

TREATMENT B 0.000 AC. 0.081 AC. (LANDSCAPE AREAS)

5.02 CFS/AC.

0.324 AC. (IMPERVIOUS, ROOF, ASPHALT)

TREATMENT C 0.004 AC. 0.000 AC.

TREATMENT D 0.401 AC.

EXISTING EXCESS PRECIPITATION:

WEIGHTED E = (0.66)X(0.00)+(0.92)X(0.00)+(1.29)X(0.004)+(2.36)X(0.401) / 0.405 = 2.348 IN.

V100-360 = (2.348)X(0.405) / 12 = 0.07925 AC.-FT = 3,451.9 CF

EXISTING PEAK DISCHARGE:

TREATMENT D 2.36 IN.

Q100 = (1.87)X(0.00) + (2.60)X(0.00) + (3.45)X(0.004) + (5.02)X(0.401) = 2.03 CFS

PROPOSED EXCESS PRECIPITATION:

WEIGHTED E = (0.66)X(0.00)+(0.92)X(0.081)+(1.29)X(0.00)+(2.36)X(0.324)/0.405 = 2.07 IN.

V100-360 = (2.07)X(0.405) / 12 = 0.06986 AC.-FT. = 3,043.2 CF

V100-1440 = (0.07)+(0.32)X(3.10-2.60) / 12 = 0.08333 AC.-FT. = 3,630.0.0 CF

V100-10 DAY = (0.08)+(0.32)X(4.90 - 2.60) / 12 = 0.14133 AC.-FT. = 6,156.3 CF

PROPOSED PEAK DISCHARGE:

Q100 = (1.87)X(0.00)+(2.60)X(0.081)+(3.45)X(0.00)+(5.02)X(0.324) = 1.84 CFS

Q100 = 2.03 - 1.84 = 0.19 CFS (DECREASE)

V100-360 = 3,451.9 - 3,043.2 = 408.7 CF (DECREASE)



ROUTE 66 PLAZA

LIVE/WORK DEVELOPMENT

8521 CENTRAL AVENUE, N.E.

ALBUQUERQUE, NEW MEXICO

JANUARY, 2019

DRAINAGE PLAN
Scale: 1" = 10'