CITY OF ALBUQUERQUE

Planning Department Alan Varela, Director



Mayor Timothy M. Keller

July 10, 2023

Racquel Michel, PE Bohannan Huston, Inc. 7500 Jefferson St NE Albuquerque, NM 87109

RE: Fiesta Subaru 7100 Lomas Blvd NE 30-day Temporary C.O. - Accepted Engineer's Certification Date: 07/06/23 Engineer's Stamp Date: 01/12/22 Hydrology File: K19D108A

Dear Ms. Michel:

PO Box 1293 Based **solely** on the Certification received 07/07/2023, this letter serves as a "green tag" from Hydrology Section for a **30-day** Temporary Certificate of Occupancy to be issued by the Building and Safety Division.

Albuquerque

PRIOR TO PERMANENT CERTIFICATE OF OCCUPANCY:

- NM 87103
 Please Resubmit to <u>PLNDRS@cabq.gov</u> when ready with an updated engineer's certification.
- 2. Please provide the executed paper Drainage Covenant (latest revision) printed on one-side only with Exhibit A and a check for \$25.00 made out to "Bernalillo County" for the stormwater quality ponds per Article 6-15(C) of the DPM to Hydrology for review at Plaza de Sol.
 - 3. Please pay the Payment-in-Lieu of **\$ 17,480.00** by emailing the attached approved Waiver Application from Stormwater Quality Volume Management On-site to <u>PLNDRS@cabg.gov</u>. Once this is received, a receipt will then be produced and email back. Follow the instructions on the bottom of the form and pay it at the Treasury in Plaza de Sol. Once paid, please provide me proof of payment.

CITY OF ALBUQUERQUE

Planning Department Alan Varela, Director



Mayor Timothy M. Keller

If you have any questions, please contact me at 924-3995 or <u>rbrissette@cabq.gov</u>.

Sincerely,

Renée C. Brissette

Renée C. Brissette, P.E. CFM Senior Engineer, Hydrology Planning Department

PO Box 1293

Albuquerque

NM 87103

www.cabq.gov



City of Albuquerque

Planning Department Development & Building Services Division DRAINAGE AND TRANSPORTATION INFORMATION SHEET (REV 11/2018)

Project Title: Fiesta Subaru	Building Permit #:	Hydrology File #: K19D108A
DRB#:	EPC#:	Work Order#:
Legal Description:		
City Address: 7100 LOMAS BLVD NE, ALE	BUQUERQUE NM 87110	
Applicant: Bohannan Huston		Contact: Racquel Michel
Address: 7500 Jefferson St. NE, Albuqu	uerque, NM 87109	
Phone#: 505-823-1000	Fax#:	E-mail: michel@bhinc.com
Owner: JD Auto LP, dba Fiesta Auto Group		Contact: Derek Kulach
Address: 8220 Lomas NE Albuquerque, NM 8	7110	
Phone#:	Fax#:	E-mail:
IS THIS A RESUBMITTAL?: DEPARTMENT: TRAFFIC/ T		DROLOGY/ DRAINAGE
Check all that Apply: TYPE OF SUBMITTAL: × ENGINEER/ARCHITECT CERT PAD CERTIFICATION CONCEPTUAL G & D PLAN GRADING PLAN DRAINAGE MASTER PLAN DRAINAGE REPORT FLOODPLAIN DEVELOPMENT ELEVATION CERTIFICATE CLOMR/LOMR TRAFFIC CIRCULATION LAYO TRAFFIC IMPACT STUDY (TIS OTHER (SPECIFY)	PERMIT APPLIC	YPE OF APPROVAL/ACCEPTANCE SOUGHT: BUILDING PERMIT APPROVAL CERTIFICATE OF OCCUPANCY PRELIMINARY PLAT APPROVAL SITE PLAN FOR SUB'D APPROVAL SITE PLAN FOR BLDG. PERMIT APPROVAL SIA/ RELEASE OF FINANCIAL GUARANTEE FOUNDATION PERMIT APPROVAL GRADING PERMIT APPROVAL SO-19 APPROVAL PAVING PERMIT APPROVAL GRADING/ PAD CERTIFICATION

DATE SUBMITTED: 07-06-2023

By: <u>Racquel Michel</u>

ELECTRONIC SUBMITTAL RECEIVED:

Bohannan 🛦 Huston

July 6, 2023

Courtyard I 7500 Jefferson St. NE Albuquerque, NM 87109-4335

www.bhinc.com

voice: 505.823.1000 facsimile: 505.798.7988 toll free: 800.877.5332

Ms. Renee Brissette Hydrology Section City of Albuquerque 600 2nd Street NW Albuquerque, NM 87102

Re: Grading and Drainage Certification (Fiesta Subaru, 7100 Lomas Blvd. NE) Hydrology File K19D108A

Dear Renee,

We are submitting these documents for the grading and drainage certification for the Fiesta Subaru project. Per our coordination with your office, we are requesting that a modified fee-in-lieu of providing the full required volume be acceptable. Enclosed for your review is the as-built survey of the latest grading and drainage plan as well as the marked up drainage management plan indicating the volume built and associated fee-in-lieu amount for the outstanding amount.

After reviewing the as-built elevations and visiting the site on 07/05/23, it is my belief that the above noted lot has been graded in substantial compliance with the approved grading and drainage plan.

The site work has been constructed and based on our review there are a few items to be corrected that have already been communicated to the contractor through a punchlist report and will be corrected in the field. These items are noted on the as-built survey for your reference and documentation. With your review, we are requesting that only the Temporary Certificate of Occupancy (TCO) be released and that once all the punchlist items are completed and the cash in lieu is submitted, that the Permanent CO be released.

I appreciate your time and consideration. If you have questions or require additional information, please contact me at (505) 823-1000.

Sincerely,

Ford Mint


Racquel M. Michel, P.E. Project Manager Community Development & Planning

Enclosure


Engineering **A**

- Spatial Data 🔺
- Advanced Technologies 🔺


Image: https://product							Fiesta S	Subaru									CC	DNCRETE	RUNDOWN	TABLE	
Bain Area Land Treatment Percentages Q(10)(r) V(10)(r) V(10)(r) </th <th></th> <th></th> <th></th> <th></th> <th></th> <th></th> <th>•</th> <th></th> <th></th> <th></th> <th></th> <th></th> <th></th> <th></th> <th>Rundown</th> <th></th> <th>Rundown</th> <th>Actual</th> <th>Capacity</th> <th>Channel</th> <th>Channel</th>							•								Rundown		Rundown	Actual	Capacity	Channel	Channel
D ISO_FT (AC) A B C D (FS) (CF) CUP CUP C					This table is	based on t	he DPM Sect	tion 6-2, Zone:	3		•		•		#	Basin ID	Туре	Flow	Weir (CFS)	Width ft	Height ft
PROPOSED PSC 0 C <	Basin	Area	Area	Lan	d Treatme	nt Percen ⁻	tages	Q(100yr)	Q(100yr)	V(100yr)	V _(100yr-6hr)	V _(100yr-24hr)	Weighted	SW Quality	R1	BASIN 1C	Rectang	0.63	0.94	1.00	0.50
PROPOSED Product Image: Product of the state of the	ID	(SQ. FT)	(AC.)	Α	В	С	D	(cfs/ac.)	(CFS)	(inches)	(CF)	(CF)	Curve #	(CF)	R2		Rectang				
PROPOSED BASN1 Prode r	PROPC	SED																			
1A 1360 0.03 0.0% 10.0% 15.0% 0.0% 1.0% 4.20 0.63 2.26 2.27 307 96 25 1C 6160 0.14 0.0% 0.0% 0.0% 4.29 0.63 2.26 12.24 1432 96 177 1D 41626 0.96 0.0% 0.0% 4.49 0.63 2.28 132 96 173 1E 7110 0.16 0.9% 0.0% 4.49 0.43 2.26 97 9.4 2A 160 0.3 0.0% 0.0% 0.0% 2.21 2.80 97 2.44 2B 2722 0.66 0.0% 0.0% 0.0% 2.41 0.46 2.51 95 79 0 3A 4651 0.10 0.0% 0.0% 0.0% 0.0% 2.44 3.073 3.45 97 2.46 3B 90.24 0.21 0.06 0.05 0.05 0.05 0.05 0.05 0.05 0.05 0.05 0.05 <td< td=""><td></td><td></td><td>1.75</td><td></td><td></td><td></td><td></td><td></td><td></td><td></td><td></td><td></td><td></td><td></td><td></td><td></td><td></td><td></td><td></td><td></td><td></td></td<>			1.75																		
1B 6333 0.16 0.0% 10.0% 10.0% 10.0% 44.90 0.63 2.58 172 172 173 175 176 <td></td> <td></td> <td></td> <td>0.0%</td> <td>0.0%</td> <td>15.0%</td> <td>85.0%</td> <td>4.29</td> <td>0.13</td> <td>2.36</td> <td>267</td> <td>307</td> <td>96</td> <td>25</td> <td></td> <td></td> <td></td> <td></td> <td></td> <td></td> <td></td>				0.0%	0.0%	15.0%	85.0%	4.29	0.13	2.36	267	307	96	25							
1C 6160 0.14 0.0%																	v				
ID IE 710 0.16 0.0% <th< td=""><td></td><td></td><td></td><td></td><td></td><td></td><td></td><td></td><td></td><td></td><td></td><td></td><td></td><td></td><td></td><td></td><td></td><td></td><td></td><td></td><td></td></th<>																					
IE T110 0.16 0.0%																					
IF 13805 0.22 0.0% 0.0% 5.0% 94.0% 2.61 2.82 3330 97 264 PROPOSED BASN2 1007 0.44 0.0% <td></td> <td>v</td> <td></td> <td></td> <td></td> <td></td>																	v				
PROPOSED BASN 2 1907 0.44 r <td></td> <td>÷</td> <td></td> <td></td> <td></td> <td></td> <td></td> <td></td> <td></td>														÷							
2A 1161 0.03 0.0% 5.0% 9.5% 4.42 0.12 2.57 2.42 2.80 9.7 2.4 2B 272 0.06 0.0% 0.	••			0.070	0.070	0.070	00.070	1.12													
2B 2722 0.06 0.0% 100% 0.0%				0.0%	0.0%	5.0%	95.0%	4 4 2	0.12	2.51	242	280	97	24	R12	BASIN 4B + 4C + 4D	Rectang	-		3.00	
2C 15194 0.35 0.0% 0.0% 4.36 1.52 2.43 3078 3545 97 296 3A 4561 0.10 0.0% 5.0% 95.0% 4.42 0.46 2.51 952 1100 97 94 3B 9024 0.21 0.0% 0.0% 0.0% 4.42 0.46 2.51 952 1100 97 94 3B 9024 0.21 0.0% 0.0% 0.0% 4.49 0.93 2.58 1940 2248 98 196 3G 1010 0.91 V <th< td=""><td></td><td></td><td></td><td></td><td></td><td></td><td></td><td></td><td></td><td></td><td></td><td></td><td></td><td></td><td></td><td></td><td></td><td>Weir Eq: Q=</td><td>2.65L(h^1.5) - **</td><td></td><td>Capacity bas</td></th<>																		Weir Eq: Q=	2.65L(h^1.5) - **		Capacity bas
PROPOSED BASN3 11166 0.35 v														-							
3A 4561 0.10 0.0% 5.0% 95.0% 4.42 0.46 2.51 952 1100 97 94 3B 9024 0.21 0.0% 0.0% 0.0% 100.0% 4.49 0.93 2.58 1940 9248 986 1960 9CPOPOSED BASIN4 39601 0.91 v				0.070	0.070	10.070	00.070	1.00													-
3B 9024 0.21 0.0% 0.0% 0.0% 4.49 0.93 2.58 1940 2248 98 196 3C 1601 0.04 0.0% 0.				0.0%	0.0%	5.0%	95.0%	4 4 2	0.46	2.51	952	1100	97	94		STOR	M DRAIN PIP	E TABLE			
3C 1601 0.04 0.09 100.09 0.09 0.09 0.86 115 115 79 0 PROPOSED BASN4 39601 0.91 - </td <td></td> <td>ACTUAL</td> <td>1</td>																				ACTUAL	1
PROPOSED BASIN4 39601 0.91 0.00														-	Pipe #	INLET/SD/BASIN	Size	Slope	Capacity*	FLOW	
4A 1846 0.04 0.0% 0.0% 0.0% 100.0% 4.49 0.19 2.58 397 460 98 40 4B 3516 0.08 0.0% 100.0% 0.0% 0.0% 0.0% 0.0% 2.49 0.20 0.86 252 252 79 0 4C 29594 0.68 0.0% 0.0% 100.0% 4.49 3.05 2.58 6363 7374 98 641 4D 4644 0.11 0.0% 0.0% 4.29 0.46 2.36 912 1047 96 86 SD 0.45 V				,.													in.			cfs	
4B 3516 0.08 0.0% 100 % 0.0% 2.49 0.20 0.86 252 252 79 0 4C 29594 0.68 0.0% 0.0% 0.0% 100.0% 4.49 3.05 2.58 6363 7374 98 641 4D 4644 0.11 0.0% 0.0% 100.0% 4.49 3.05 2.58 6363 7374 98 641 9PROPSED BASIN5 19502 0.45 0.0% 100.0% 4.49 0.55 2.58 1142 1324 98 115 SD4 SD5 25% OF 1D 6 6.08% 2.25% 3.29 3.22 53 19502 0.45 0.0% 0.0% 100.0% 4.49 0.55 2.58 1142 1324 98 115 SD6 SD4 + SD5 18 1.00% 1.050 4.29 54 14189 0.33 0.0% 0.0% 1.40 2.55 3.819 3860 3260 50 14189 0.33 0.0% 0.0% 1.40 <th< td=""><td></td><td></td><td></td><td>0.0%</td><td>0.0%</td><td>0.0%</td><td>100.0%</td><td>4.49</td><td>0.19</td><td>2.58</td><td>397</td><td>460</td><td>98</td><td>40</td><td>SD1</td><td>50% OF 1D</td><td>10</td><td>2.25%</td><td>3.29</td><td>2.15</td><td>1</td></th<>				0.0%	0.0%	0.0%	100.0%	4.49	0.19	2.58	397	460	98	40	SD1	50% OF 1D	10	2.25%	3.29	2.15	1
4C 29594 0.68 0.0% 0.0% 100.0% 4.49 3.05 2.58 6363 7374 98 641 4D 4644 0.11 0.0% 0.0% 15.0% 85.0% 4.29 0.46 2.36 912 1047 96 86 PROPOSED BASIS 19502 0.45 0.0% 0.0% 0.0% 4.49 0.55 2.58 1142 1324 98 115 5B 14189 0.33 0.0% 0.0% 100.0% 4.49 1.46 2.58 3051 3535 98 307 5B 14189 0.33 0.0% 0.0% 100.0% 4.49 1.46 2.58 3051 3535 98 307 5D 14189 0.33 0.0% 0.0% 100.0% 4.49 1.46 2.58 3051 3535 98 307 5D 5D 6.313 0.0% 0.0% 0.0% 1.40 1.40 2.58 3051 3535 98 307 5D 5D <t< td=""><td>4B</td><td></td><td></td><td></td><td></td><td></td><td></td><td></td><td>0.20</td><td></td><td>252</td><td>252</td><td></td><td>0</td><td></td><td></td><td></td><td></td><td></td><td></td><td></td></t<>	4B								0.20		252	252		0							
4D 4644 0.11 0.0% 0.0% 15.0% 85.0% 4.29 0.46 2.36 912 1047 96 86 PROPOSED BASIN 5 19502 0.45 - <t< td=""><td>4C</td><td>29594</td><td>0.68</td><td>0.0%</td><td></td><td>0.0%</td><td>100.0%</td><td>4.49</td><td>3.05</td><td>2.58</td><td>6363</td><td>7374</td><td>98</td><td>641</td><td></td><td></td><td>8</td><td></td><td></td><td></td><td></td></t<>	4C	29594	0.68	0.0%		0.0%	100.0%	4.49	3.05	2.58	6363	7374	98	641			8				
PROPOSE DASINS 1950 0.45 I	4D	4644	0.11	0.0%	0.0%	15.0%	85.0%	4.29	0.46	2.36	912	1047	96	86			10				
5A 5313 0.12 0.0% 0.0% 100.0% 4.49 0.55 2.58 1142 1324 98 115 5B 14189 0.33 0.0% 0.0% 100.0% 4.49 1.46 2.58 3051 3535 98 307 5D 14189 0.33 0.0% 0.0% 100.0% 4.49 1.46 2.58 3051 3535 98 307 TOTAL 169774 3.90 - - - - 1.7 - 33819 38960 3260 Unlet Inlet Type Basin Actual Flow (CFS) Avail Head (ft) Capacity (CFS) ¹ State	PROPOSED BASIN 5	19502	0.45														6				1
5B 14189 0.33 0.0% 0.0% 100.0% 4.49 1.46 2.58 3051 3535 98 307 TOTAL 169774 3.90 - - - 17 - 33819 38960 3260 Understand Intervision	5A	5313	0.12	0.0%	0.0%	0.0%	100.0%	4.49	0.55	2.58	1142	1324	98	115			18			-	-
TOTAL 169774 3.90 - - - 17 - 33819 38960 3260 INLET TABLE INLET TABLE Inlet Type Basin Actual Flow (CFS) Avail Head (ft) Capacity (CFS) ¹ N1 1-12" Nyloplast (Dome Grate) BASIN 1F 1.40 0.50 1.65	5B	14189	0.33	0.0%	0.0%	0.0%		4.49	1.46	2.58	3051	3535	98	307			_				-
Inlet # Inlet Type Basin Actual Flow (CFS) Avail Head (ft) Capacity (CFS) ¹ IN1 1 - 12" Nyloplast (Dome Grate) BASIN 1F 1.40 0.50 1.65	TOTAL	169774	3.90	-	-	-	-	-	17	-	33819	38960		3260							
INLET TABLE Inlet # Inlet Type Basin Actual Flow (CFS) Avail Head (ft) Capacity (CFS) ¹ IN1 1 - 12" Nyloplast (Dome Grate) BASIN 1F 1.40 0.50 1.65		•									•	•	•	•	300	300 + 307	10				4
Inlet TypeBasinActual Flow (CFS)Avail Head (ft)Capacity (CFS)^1IN11 - 12" Nyloplast (Dome Grate)BASIN 1F1.400.501.65				INI	ΕΤ ΤΔΕ													Capacity b	ased on Manning	<u>s Eq w/ N=0.013</u>	<u>'</u>
IN1 1 - 12" Nyloplast (Dome Grate) BASIN 1F 1.40 0.50 1.65	Inlet #	Inlet T	уре			Actu		Avail Head	d (ft) Cap	acity (CFS))1										
	IN1 1 - 1	2" Nyloplast	(Dome Gra	te)	BASIN 1F	`	,	0.50		1.65											
				/					I												

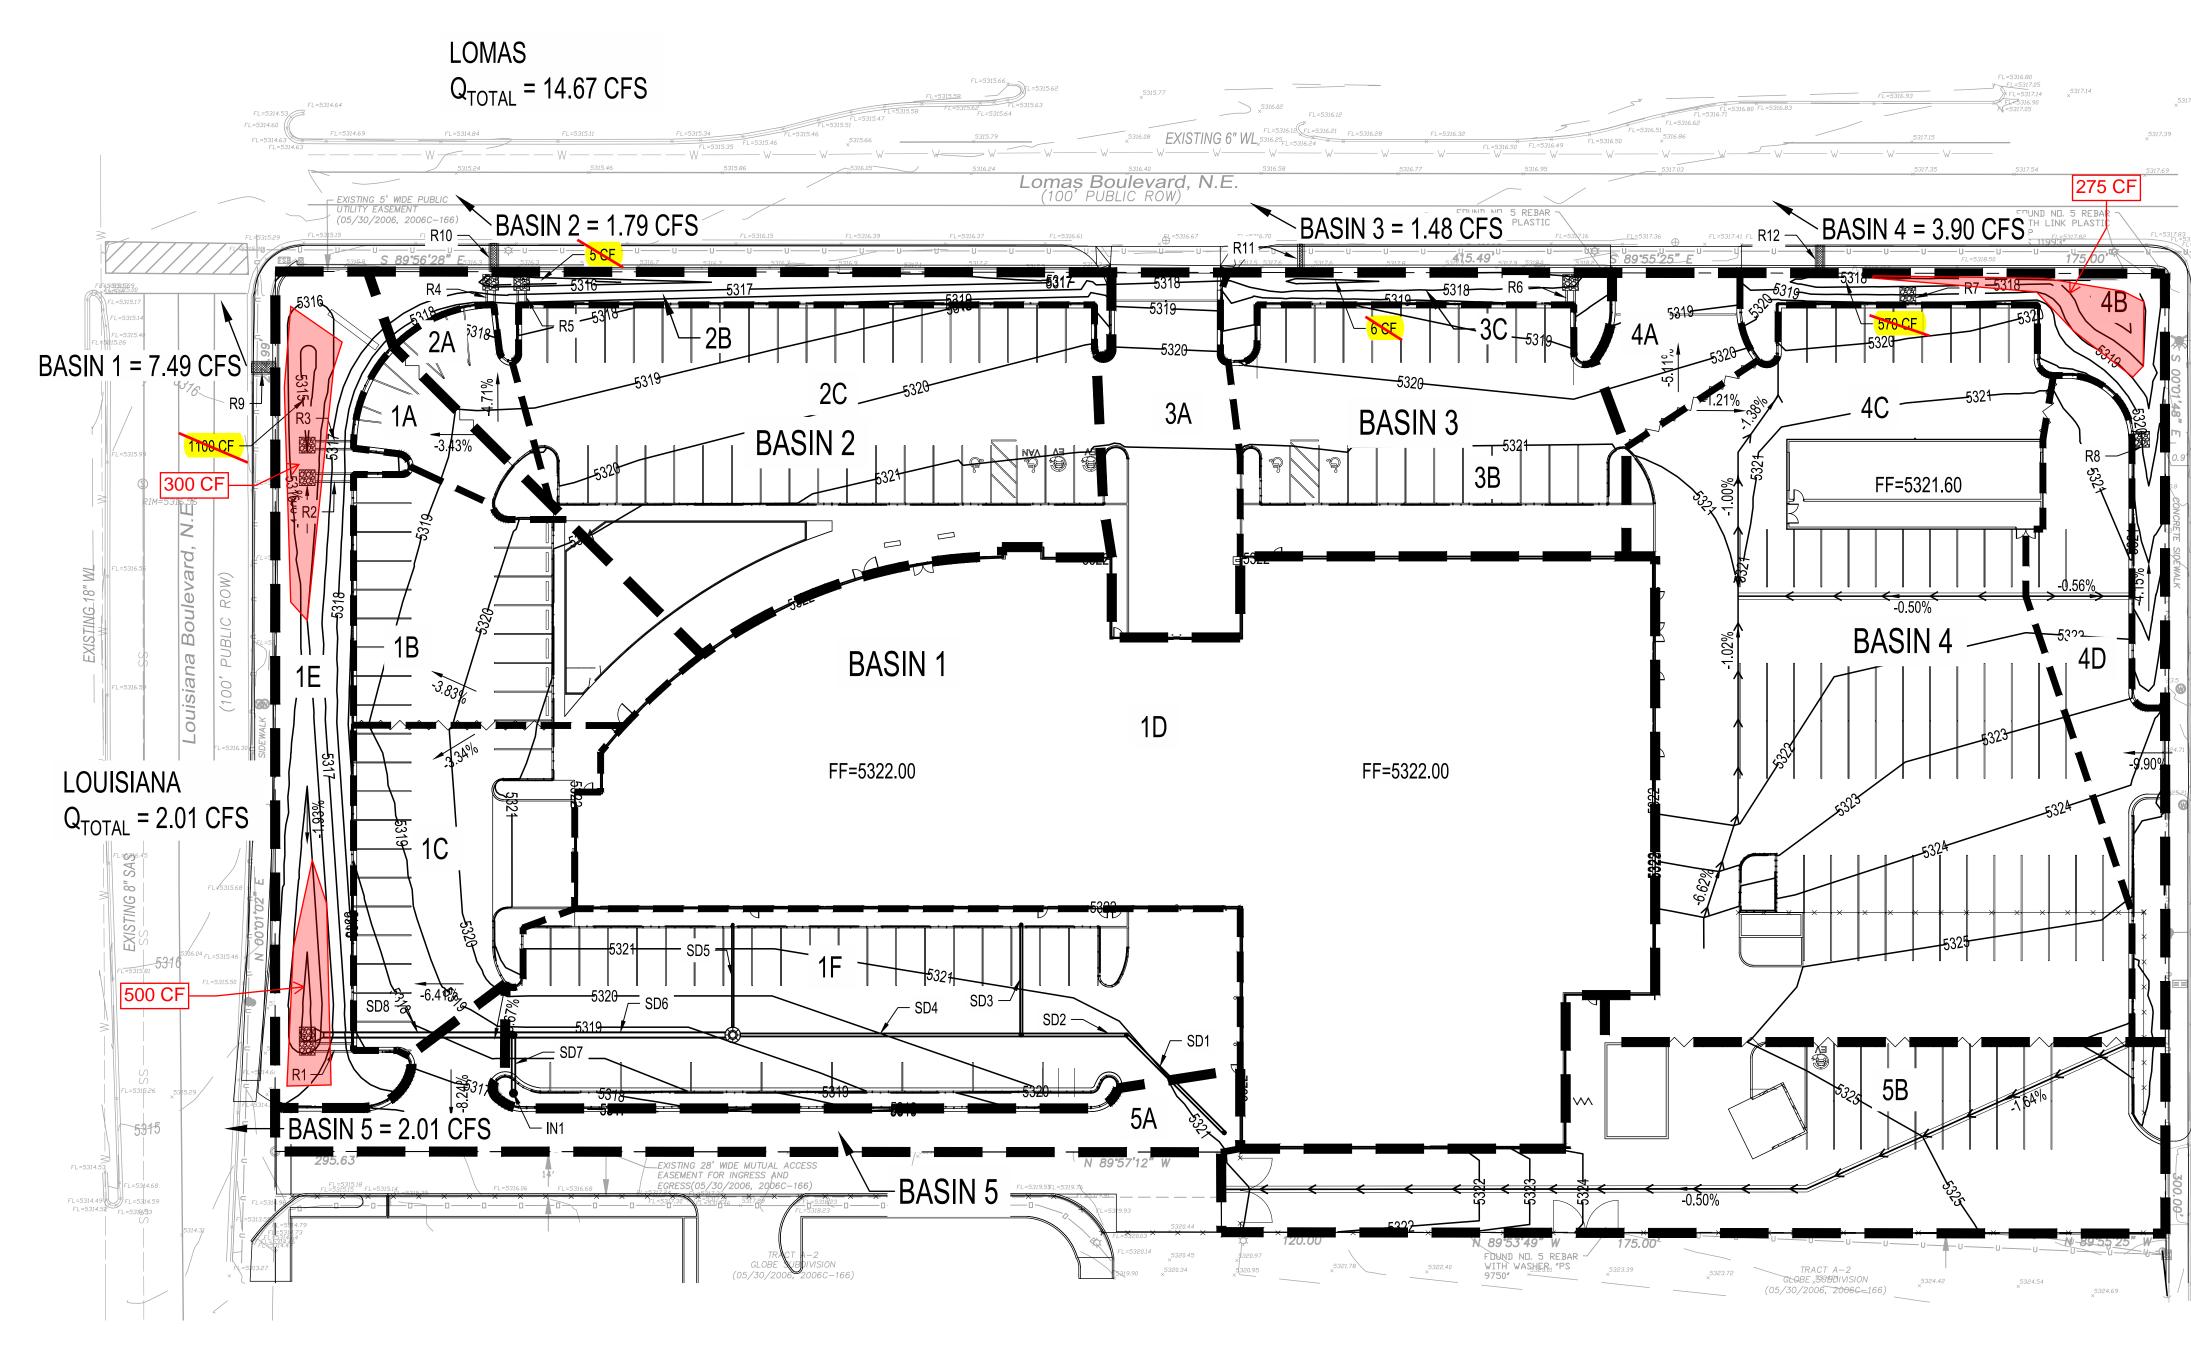


	Minimum	Capacity		SMPC Architects
: :	Slope 1.15% 1.15%	Mannings (CFS) 2.43 2.43		PRINCIPLES OF DESIGN. 219 Central Ave, NW, Suite #800 Albuquerque, New Mexico 87102
	1.15% 1.15% 1.15%	2.43 2.43 5.89		T 505 255 8668 F 505 268 6665 www.smpcarchitects.com
	1.15% N/A N/A	2.43 N/A N/A		
	N/A N/A N/A N/A	N/A N/A N/A		
bas	N/A	N/A N/A s Eq w/ N=0.013 - *	LEGEND	
			Property line	
			LIMITS OF GRADING	THEW H. SAN
			EXISTING INTERMEDIATE CONTOUR	MEX CE FO
				24572
			DRAINAGE BASIN	
			DRAINAGE NARRATIVE	
			INTRODUCTION: THIS PROJECT IS LOCATED ON THE SOUTHEAST CORNER OF LOMAS AND LOUISIANA. THE PROPOSED FACILITY IS THE CONSTRUCTION OF A FIESTA SUBARU DEALERSHIP. THE TWO EXISTING TRACTS WILL BE CONSOLIDATED INTO ONE. THE PROPOSED FACILITY IS A COMPLETE DEMOLITION OF THE EXISTING DEALERSHIP AND RESTAURANT BEING REPLACED WITH AN ENTIRELY NEW FIESTA SUBARU DEALERSHIP.	
317.29	× ^{5317.54} × ^{5317.72}	× ^{5317.90}	METHODOLOGY: THE HYDROLOGIC ANALYSIS PROVIDED WITH THIS DRAINAGE SUBMITTAL HAS BEEN PREPARED IN ACCORDANCE WITH THE RECENT ADOPTION OF THE NEW DEVELOPMENT PROCESS MANUAL, SPECIFICALLY CHAPTER 6 (DRAINAGE, FLOOD CONTROL, AND EROSION CONTROL). LAND TREATMENT PERCENTAGES WERE CALCULATED BASED ON THE ACTUAL CONDITIONS IN EACH ONSITE BASIN AND ARE SUMMARIZED IN THE "PROPOSED BASIN DATA TABLE" (THIS SHEET). THE SITE IS IN RAINFALL ZONE 3. THIS SITE WAS ANALYZED FOR THE 100-YEAR, 6-HOUR STORM EVENT.	
3 5317/8 FL=53	3 3 17.96 5-5318.08 5-5318.23 -5318.23 -5318.29 -5318.23 -		<u>PROPOSED:</u> THE PROPOSED SITE WILL FOLLOW THE SAME EXISTING DRAINAGE SCHEME. THE SITE IS DIVIDED INTO 5 PROPOSED BASINS THAT WILL DISCHARGE TO FIVE MAIN OUTFALL LOCATIONS.	
*	=5318.87 =5318.97 x 5320.20 x	9.33	BASIN 1 IS LOCATED ON THE WEST SIDE OF THE SITE AND IS THE PRIMARY DISCHARGE LOCATION FOR THE NEW BUILDING. THIS BASIN CONTAINS THE ONLY STORM DRAIN SYSTEM ONSITE. THE REMAINDER OF THIS BASIN THAT DOESN'T DISCHARGE TO THE NEW STORM DRAIN SHEET FLOWS TO NEW CONCRETE RUNDOWNS ALONG THE WEST SIDE OF THE SITE. THE NEW BUILDING DISCHARGES BELOW GRADE TO THE NEW STORM DRAIN. SEE THE STORM DRAIN PIPE AND INLET TABLE, THIS SHEET, FOR MORE INFORMATION. THE ULTIMATE OUTFALL OF THIS BASIN IS A NEW SIDEWALK CULVERT IN THE NORTHWEST CORNER OF THE SITE. THIS CULVERT DISCHARGES INTO LOUISIANA BLVD PRIOR TO CONTINUING INTO LOMAS BLVD.	
9 * FL	=531988/EXISTING 6" WL	0.42	BASIN 2, 3, AND 4 ARE LOCATED ON THE NORTH AND EAST PORTIONS OF THE SITE. THESE BASINS ALL SHEET FLOW TO THE NORTH INTO PROPOSED CURB OPENINGS AND RUNDOWNS PRIOR TO ENTERING STORMWATER QUALITY PONDS AND DISCHARGING TO THE NORTH INTO LOMAS BLVD. BASINS 1 THROUGH 4 ALL DISCHARGE A TOTAL OF 14.67 CFS TO LOMAS BLVD. A NEGLIGABLE INCREASE FROM EXISTING CONDITIONS.	
	160' FL=532	TRACT A DEL NORTE SUBDIVIS (08/21/1974, C10-2	BASIN 5 IS LOCATED ON THE SOUTHERN PORTION OF THE SITE. THIS BASIN SHEET FLOWS FROM CHAMA ST TOWARDS LOUISIANA BLVD. A TOTAL OF 2.01 CFS DISCHARGES INTO LOUISIANA BLVD, A SLIGHT DECREASE FROM EXISTING CONDITIONS.	
FL ×	=5322 45 RO		NEW STORMWATER QUALITY PONDS ARE LOCATED ALONG THE NORTH AND WEST PORTIONS OF THE SITE:	
FL	-5323.3 K	^{3.97} 324 *	STORMWATER QUALITY VOLUME REQUIRED = 3,260 CF STORMWATER QUALITY VOLUME PROVIDED = 1677 CF STORMWATER QUALITY VOLUME REMAINING = 1569 CF	
- N I -	=5324.27 × =5324.56 FL=532		ALL LANDSCAPED AREAS ARE DEPRESSED TO THE MAXIMUM EXTENT FEASIBLE. ADDITIONAL VOLUME CAN'T BE ACCOMDATED DUE TO THE SITE CONSTRAINTS.	
FL	←5325.46 ←5324.92 FL=532	5.22	<u>CONCLUSION:</u> THE CALCULATED PEAK DISCHARGE FROM MAINTAINS THE EXISTING RUNOFF FLOWRATE. THE GRADING AND DRAINAGE PLAN AS PRESENTED IS IN CONFORMANCE WITH THE CITY OF	NO DATE DESCRIPTION DATE:
		*	ALBUQUERQUE HYDROLOGY REQUIREMENTS. WITH THIS SUBMITTAL WE ARE REQUESTING COA HYDROLOGY BUILDING PERMIT & SO-19 APPROVAL.	PROJECT #: DRAWN BY: CHECKED BY:
FL ×	FL=532:	5.18 TRACT B DEL NORTE SUBDIVIS (08/21/1974, C10-	Based on as-built elevations of ponds and revised volume listed above, Payment in Lieu is 2,185 CF * \$8/CF = \$17,480	COPYRIGHT: These documents were prepared for this specific project only. SMPC Architects' liability is limited to this specific project, and does not extend to reuse of
	FL=532:	5.03	Previous SWQ Waiver approved 2/25/22 and Fee in Lieu of \$12,744 already paid.	these documents for other projects. SHEET TITLE
	.=5 .=5		Remaining fee in lieu to be paid is \$17,480 - \$12,744 = \$4,736	PROPOSED DRAINAGE MANAGEMENT PLAN
/ FL	.=5	VISI C—7		DMP00

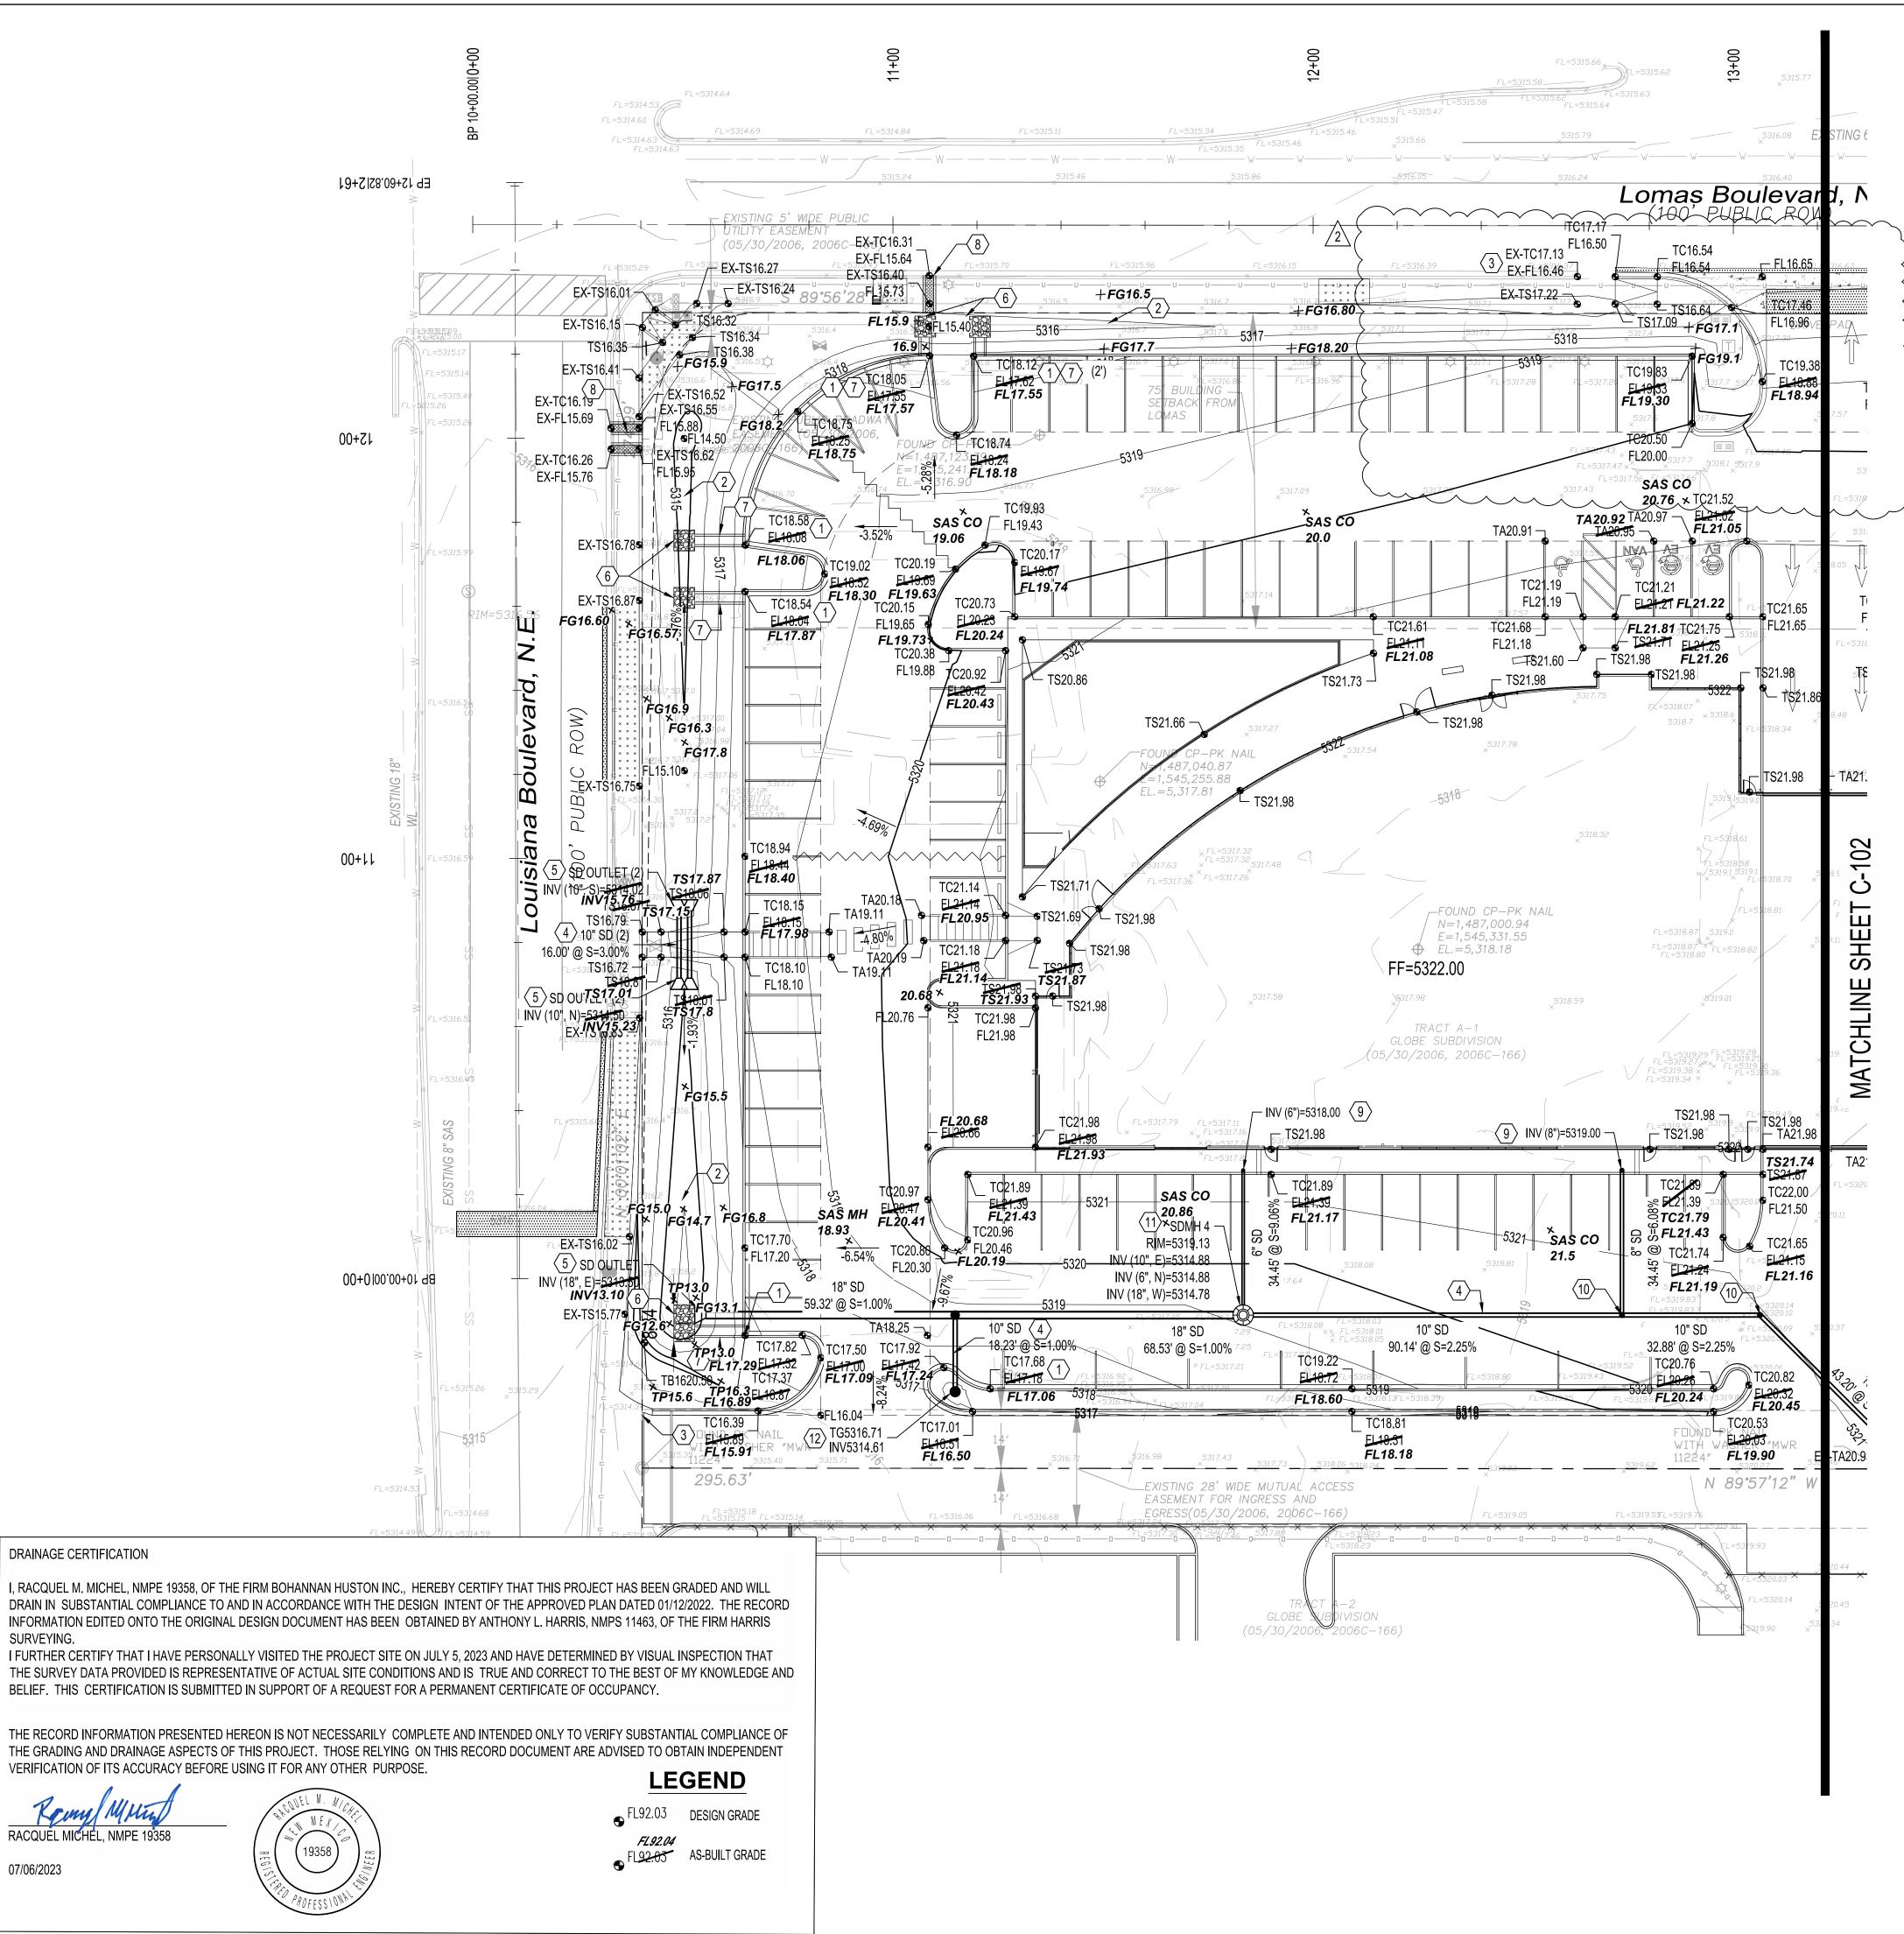

Thu, 6-Jul-2023 - 8:47:am, Plotted by: RMICHEL P:\20220043\CDP\Design\Workarea\20220043_Grading Cert.dwg

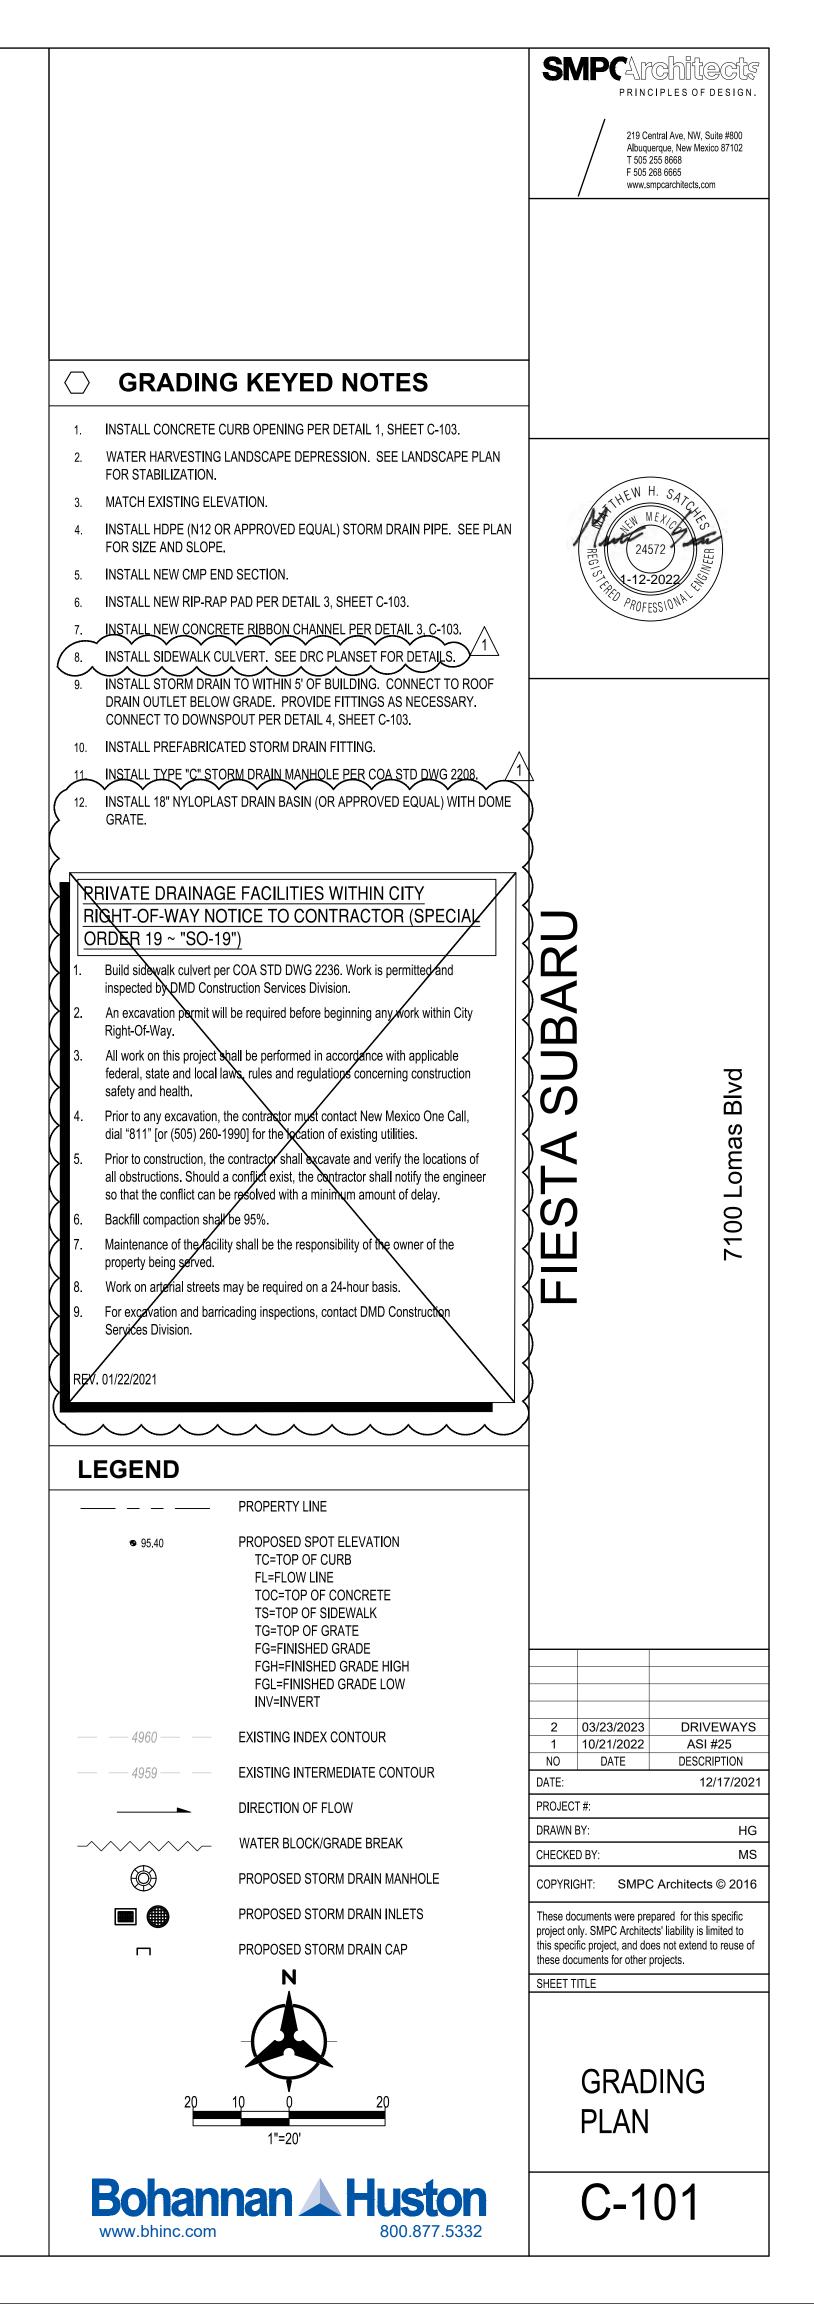

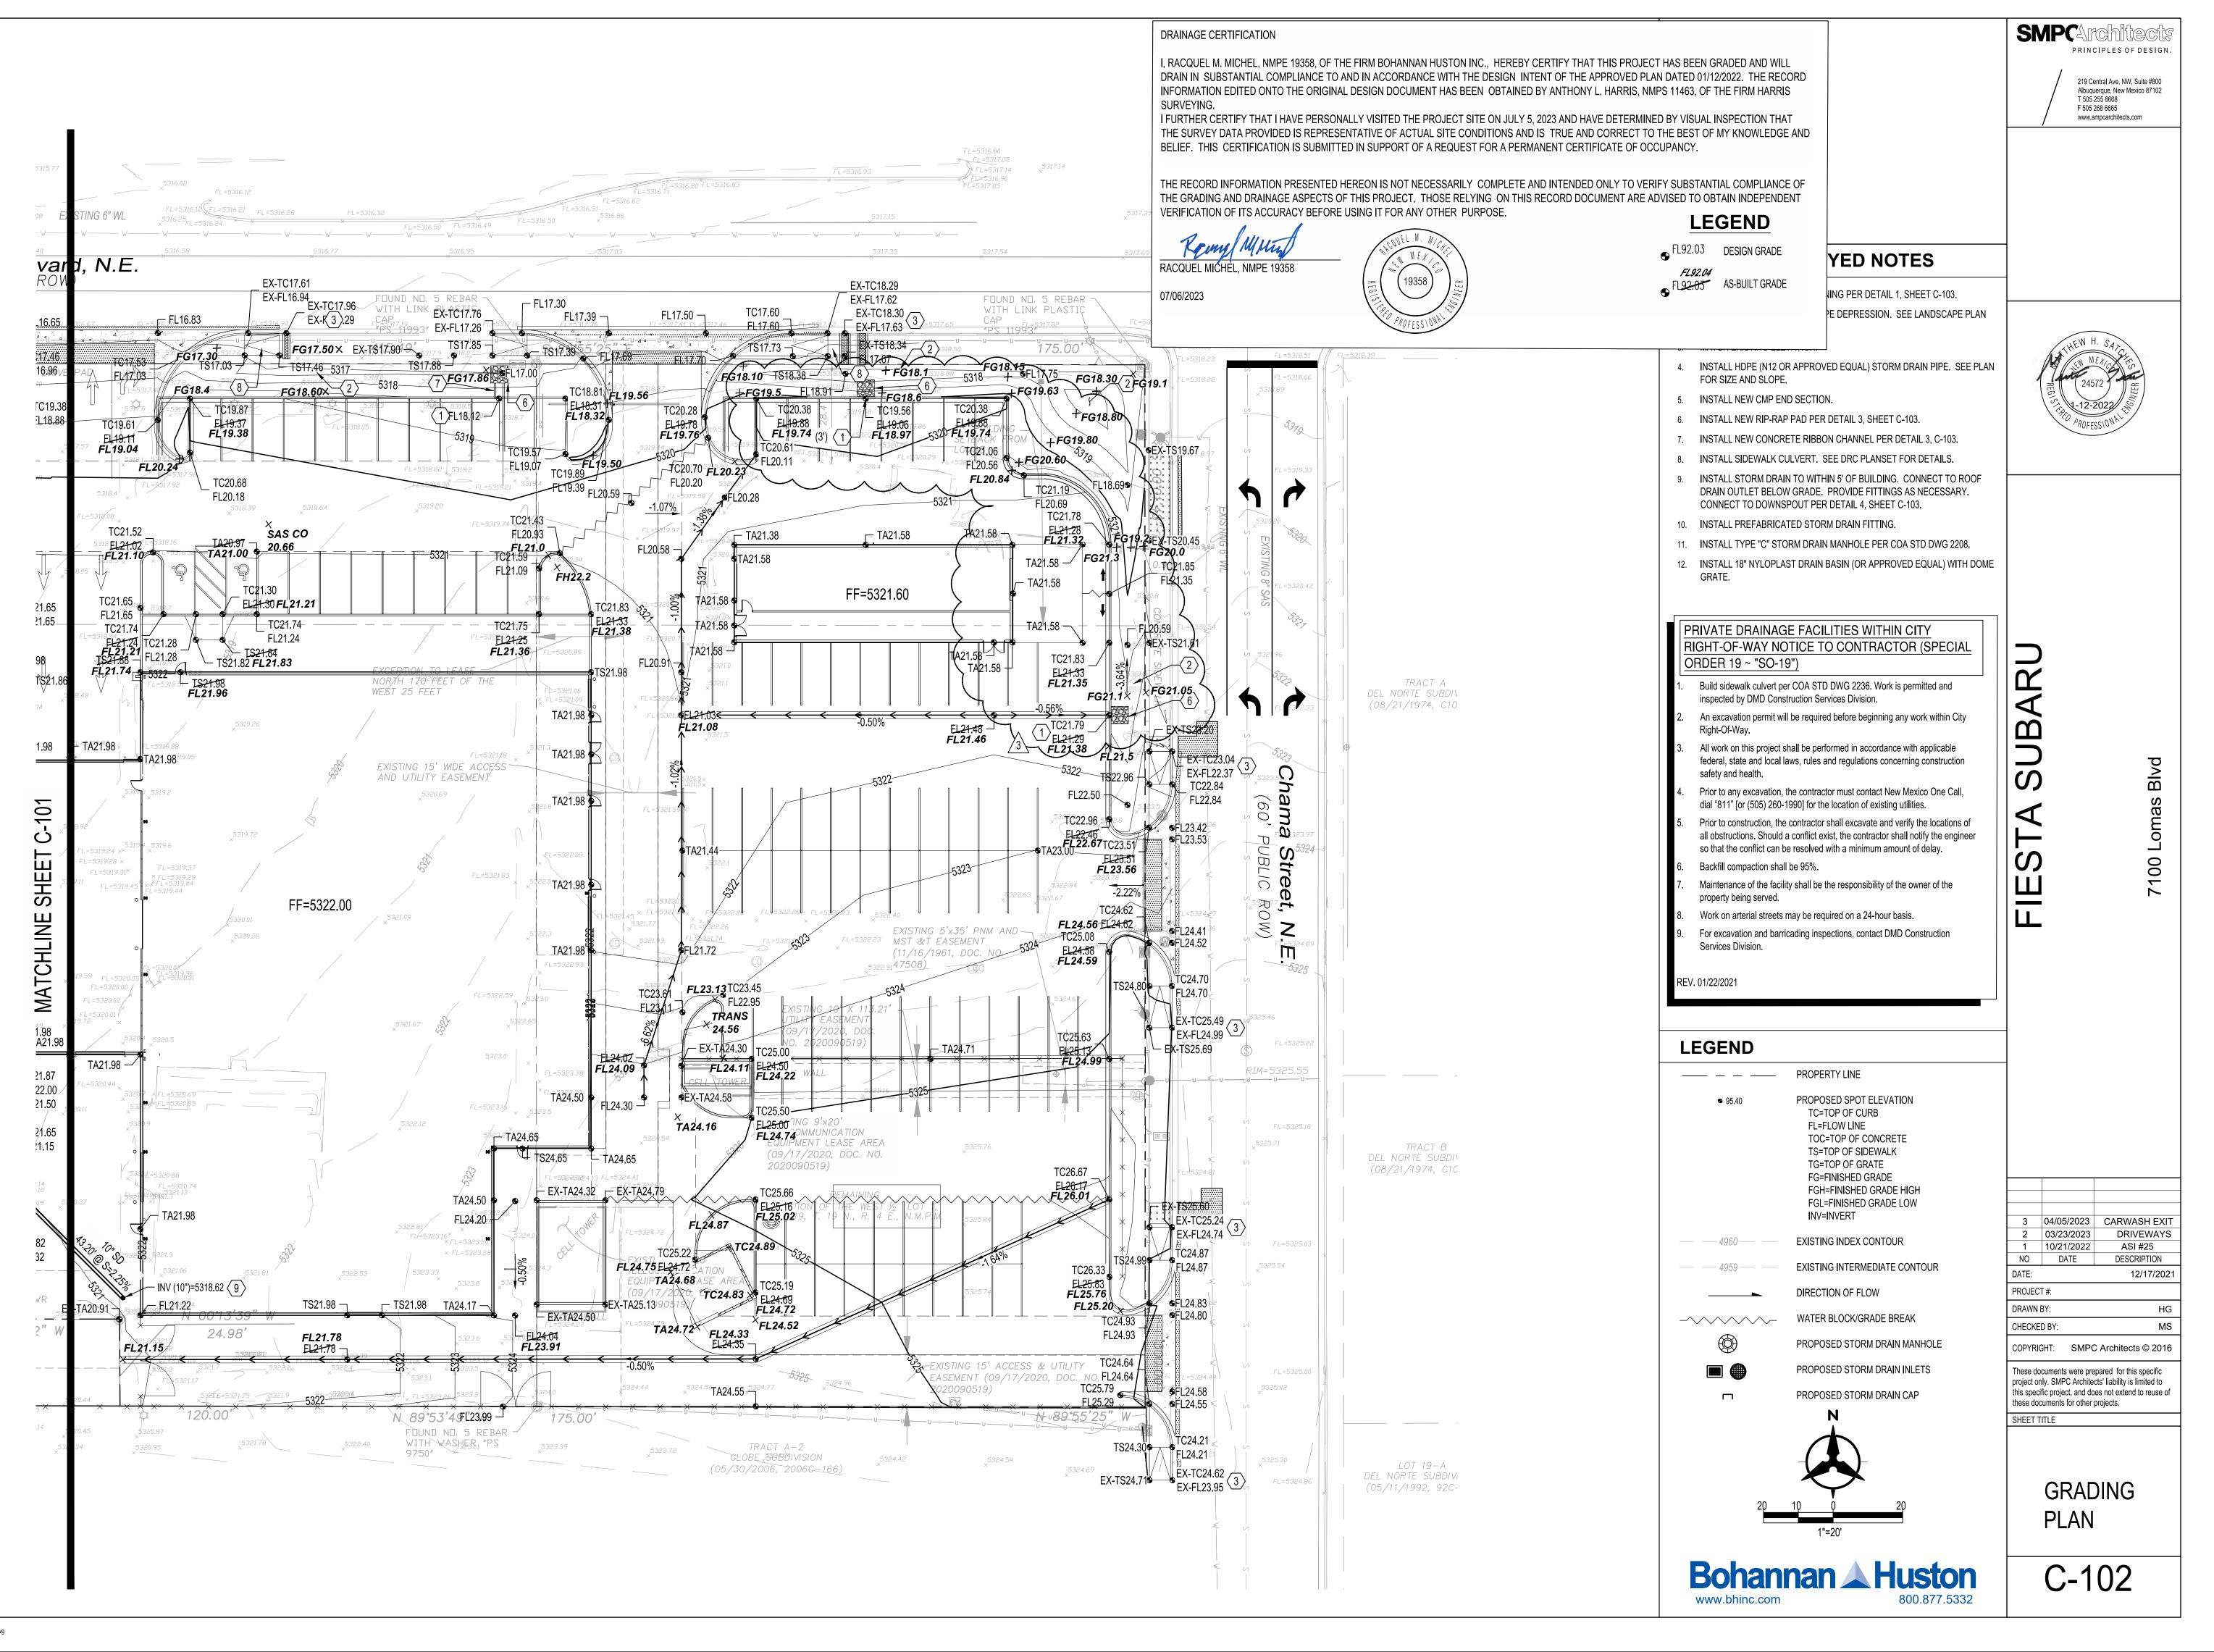

L Thu, 6-Jul-2023 - 8:47:am, Plotted by: RMICHEL P:\20220043\CDP\Design\Workarea\20220043_Grading Cert 2.dwg

CITY OF ALBUQUERQUE PLANNING DEPARTMENT HYDROLOGY DEVELOPMENT SECTION

WAIVER APPLICATION FROM STORMWATER QUALITY VOLUME MANAGEMENT ON-SITE

GENERAL INFORMATION

APPLICANT: Bohannan Huston

_{DATE:} 7/6/23

DEVELOPMENT: Fiesta Subaru

LOCATION: 7100 Lomas Blvd NE 87110

STORMWATER QUALITY POND VOLUME

Per the DPM Article 6-12 - Stormwater Quality and Low-Impact Development, the calculated sizing for required Stormwater Quality Pond volume is equal to the impervious area draining to the BMP multiplied by 0.42 inches for new development sites and by 0.26 inches for redevelopment sites.

The required volume is 3,260	cubic feet
The provided volume is 1,075	_cubic feet
The deficient volume is 1,593 2,185	_cubic feet

WAIVER JUSTIFICATION

Per the DPM Article 6-12(C), private off-site mitigation and payment-in-lieu may only be considered if management on-site is waived in accordance with the following criteria and procedures.

1. Management on-site shall be waived by the City Engineer if the following conditions are met:

- a. Stormwater quality can be effectively controlled through private off-site mitigation or through an arrangement (approved by the City) to use a cooperator's existing regional stormwater management infrastructure or facilities that are available to control stormwater quality.
- b. Any of the following conditions apply:
 - i. The lot is too small to accommodate management on site while also accommodating the full plan of development.
 - ii. The soil is not stable as demonstrated by a geotechnical report certified by a professional engineer licensed in the State of New Mexico.
 - iii. The site use is inconsistent with the capture and reuse of stormwater.
 - iv. Other physical conditions exist where compliance with on-site stormwater quality control leaves insufficient area.
 - v. Public or private off-site facilities provide an opportunity to effectively accomplish the mitigation requirements of the Drainage Ordinance (Part 14-5-2 ROA 1994) as demonstrated on as-built construction drawings and an approved drainage report.
 - vi. The developer constructs a project to replenish regional groundwater supplies at an off-site location.
 - vii. A waiver to State water law or acquisition of water rights would be required in order to implement management on site.
- 2. The basis for requesting payment-in-lieu or private off-site mitigation is to be clearly demonstrated on the drainage plan.

This project's justification:

Stormwater quality ponds have been added and maximized where possible. Site constraints don't allow for additional pond volume

Lot is too small based on proposed site use to accommodate additional volume than currently shown.

Additionally, existing utilities were found that prevented the pond to be constructed as deep as designed.

Racquel Michel

Professional Engineer or Architect

PAYMENT-IN-LIEU

Per the DPM Article 6-12(C)(1), the amount of payment-in-lieu is deficient volume (cubic feet) times \$6 per cubic feet for detached single-family residential projects or \$8 per cubic feet for all other projects.

AMOUNT OF PAYMENT-IN-LIEU = $\frac{12,744}{2}$

\$17,480

THIS SECTION IS FOR CITY USE ONLY

X Waiver is approved. The amount of payment-in-lieu from above must be paid prior to Certificate of Occupancy.



Waiver is DENIED.

Renée C. Brissette

07/07/23

City of Albuquerque Hydrology Section