

# CITY OF ALBUQUERQUE



March 1, 2019

Michael Heitman, AIA  
Greer Stafford / SJCF Architecture, Inc.  
1717 Louisiana Blvd NE, Suite 205,  
Albuquerque, NM 87110

**Re: The New Los Altos Pool,  
10100 Lomas Blvd NE, 87123  
30-Day Temporary Certificate of Occupancy- Traffic Certification Only  
Transportation Development Final Inspection  
Engineer's/Architect's Stamp dated 5-17-17 (K20D037)  
Certification dated 3-1-19**

Dear Mr. Heitman,

Based upon the information provided in your submittal received 3-1-19, Transportation Development will issue a 30-day Temporary Certificate of Occupancy. This letter serves as a "green tag" from Transportation Development for a 30-day Temporary Certificate of Occupancy to be issued by the Building and Safety Division.

Prior to the issuance of a permanent Certificate of Occupancy, the Transportation Department must receive photos of corrections.

1. Please remove construction equipment & debris.
2. Prior to requesting Final CO please complete north side parking striping and signage.

Once corrections are complete resubmit acceptable package along with fully completed Drainage Transportation Information Sheet to front counter personnel for log in and evaluation by Transportation. For digital submittal and minor comments and/or repairs, please submit photos to [PLNDRS@cabq.gov](mailto:PLNDRS@cabq.gov) prior to submittal. If you have any questions, please contact me at (505) 924-3981. If you have any questions, please contact me at (505) 924-3981.

Sincerely,

Ernie Gomez  
Plan Checker, Planning Dept.  
Development Review Services

EG via: email  
C: CO Clerk, File









- |    |   |
|----|---|
| 1. | THIS PROJECT WILL DECREASE THE EXISTING BATHER LOAD COUNT BY APPROXIMATELY 30 PATRONS, BY VIRTUE OF DEMOLISHING THE EXISTING WADING POOL.     |
| 2. | THIS PROJECT RE-UTILIZES THE EXISTING PARKING LOTS EAST AND NORTH INTACT INCLUDING EXISTING INGRESS/EGRESS DRIVES.                            |
| 3. | THIS PROJECT BRINGS THE PARKING STALL COUNTS INTO COMPLIANCE BY RE-STRIPING AND ADDING NEW PARKING- REFERENCE PARKING CALCULATIONS THIS SHEET |
| 4. | THIS PROJECT RE-UTILIZES THE EXISTING SITE LIGHTING, DOES NOT MODIFY THE LIGHTING QUANTITY OR FIXTURE TYPE.                                   |
| 5. | ANY FUTURE SIGNAGE OF CHANGES TO SIGNAGE MUST BE IN COMPLIANCE WITH THE SIGN REGULATIONS OF THE C-2 ZONE.                                     |

## PARKING CALCULATIONS: LOS ALTOS POOL

STANDARD PARKING STALLS: PURSUANT TO 14.16.2.22 SU-1 ZONE REQUIREMENTS, OFF-STREET PARKING SHALL BE PROVIDED AS REQUIRED BY THE PLANNING COMMISSION. NO OTHER SPECIFIC OFF-STREET PARKING REGULATIONS FOR SWIMMING POOL FACILITIES ARE INCLUDED IN THE ZONING CODE.



**CURRENT PROVIDED: 112** STANDARD PARKING SPACES: CURRENT PROVIDED: 110; REQUIRED: 22,000/2000 = 110

- CURRENT ACCESSIBLE PARKING SPACES: 8; REQUIRED: 8 (PER 14.16.3.1.F.9.A)
- CURRENT MOTORCYCLE PARKING: CURRENT PROVIDED 6; REQUIRED 4
- CURRENT BICYCLE PARKING: CURRENT PROVIDED 6; REQUIRED 6

## EPC SITE KEYNOTE LEGEND

- |    |   |
|----|---|
| 1  | EXISTING ADA PARKING - UPDATE SIGNAGE TO ADA COMPLIANT, INCLUDING VAN ACCESSIBLE WITH REQUIRED LANGUAGE "VIOLATORS ARE SUBJECT TO FINE AND/OR TOWING." RE-STRIPE ACCESSIBLE ROUTE AISLES. |
| 2  | CMU SCREENING WALL, 7'-4"HI, BURNISHED SEASHORE SAND COLORED, WITH PAINTED HM STEEL GATES.  |
| 4  | 18" SPHERICAL BOLLARD, PRE-CAST CONCRETE, NATURAL COLORED.  |
| 5  | ORNAMENTAL STEEL PICKET FENCE TO MATCH EXISTING, 6"HI, BLACK  |
| 6  | ORNAMENTAL STEEL PICKET GATE TO MATCH FENCE, 6"HI, BLACK  |
| 7  | NEW BENCH- 3 SEAT CAPACITY  |
| 8  | RE-STRIPE EXISTING PARKING STALLS IN PLACE  |
| 9  | ADA PASSENGER DROP-OFF ZONE 8' X 20'  |
| 10 | PANIC DOOR- EMERGENCY EGRESS ONLY   |
| 12 | NEW XERISCAPE LANDSCAPING   |
| 13 | EXISTING NATIVE VEGETATION  |
| 14 | EXISTING RETENTION POND- REF CIVIL  |
| 16 | ADA ROUTE STRIPING 4" WIDE @ 18" OC   |
| 17 | NEW CONCRETE WALK PER COA STD DWG 2720  |
| 18 | NEW ADA RAMP WITH DETECTIBLE SURFACE PER COA STD DWG 2418   |
| 20 | ASPHALT PATCH PER COA STD DWG 2405A   |
| 21 | NEW ADA RAMP WITH HEADER CURB, DETECTIBLE SURFACE PER COA STD DWG 2441  |
| 22 | TIE INTO EXISTING CURB AND GUTTER   |
| 23 | NEW POWDER COATED STEEL BIKE RACK- 6 BIKE CAPACITY  |
| 25 | EXISTING GRAVEL   |
| 27 | Existing chain link fence   |
| 28 | EXISTING GRAVEL MAINTENANCE ROAD  |
| 29 | EXISTING CONCRETE WALK PATH TO REMAIN   |
| 30 | EXISTING LIGHT POLE   |
| 32 | RELOCATE EXISTING ADA PARKING SIGNS TO CENTER OF PARKING STALL  |
| 33 | RELOCATE EXISTING ORNAMENTAL FENCE  |
| 34 | NEW CONCRETE CURB   |
| 35 | ROLLING GATE  |
| 36 | NEW CIP CONCRETE PAVING PER COA STD   |
| 37 | NEW 6" COMPACTED BASE COURSE  |
| 38 | PROPOSED TRANSFORMER LOCATION SHOWING CLEARANCES REQUIRED BY NEM  |


## KEY PLAN

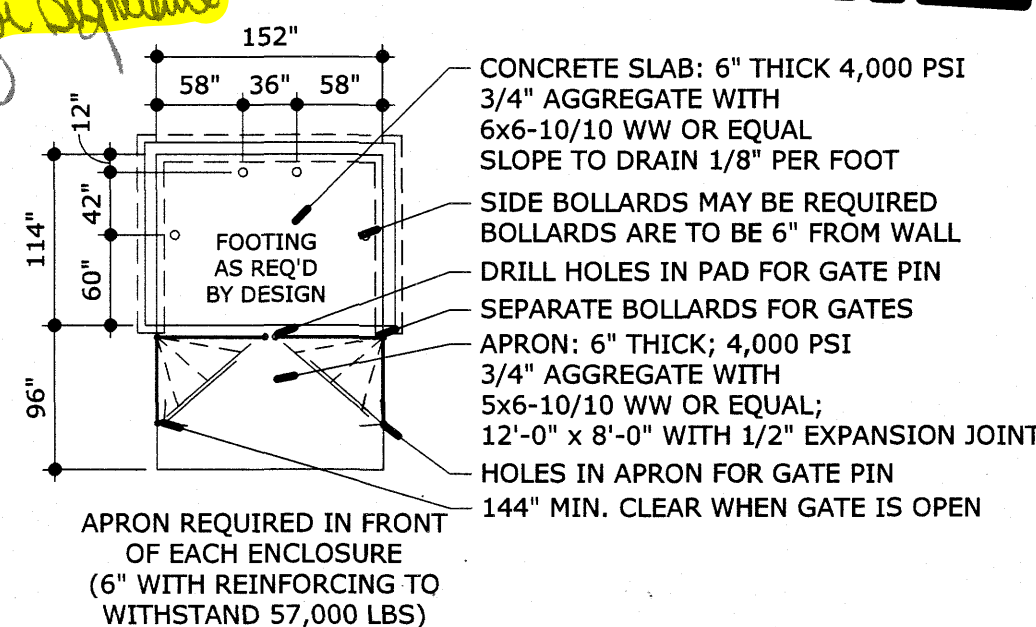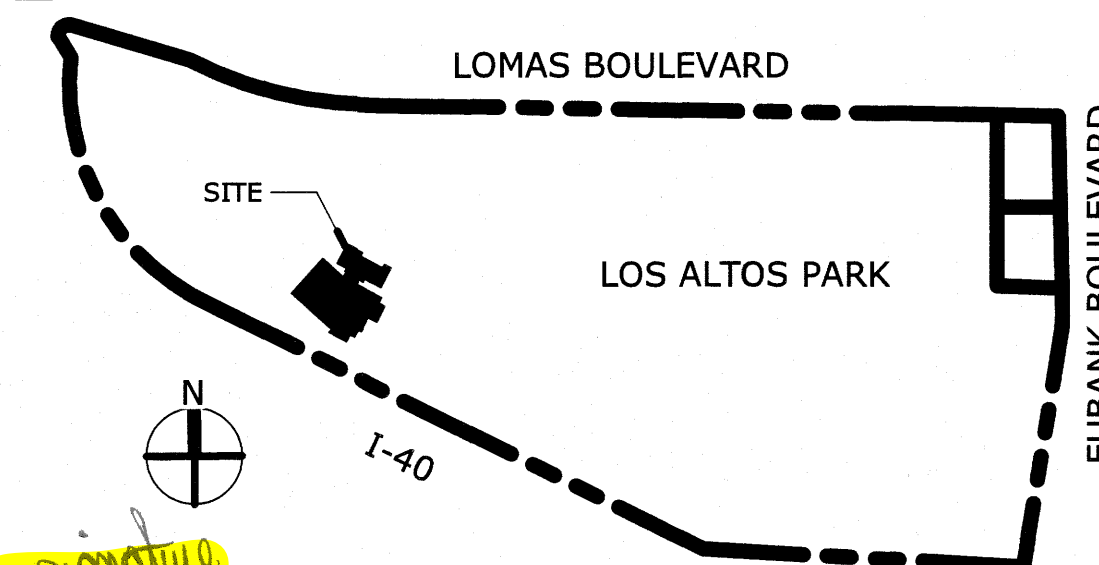

ADDITIONAL INFORMATION CONCERNING THESE SPECIFICATIONS MAY BE  
OBTAINED BY CALLING THE SOLID WASTE MANAGEMENT DEPARTMENT AT 761-8100

**REFUSE ENCLOSURE**

(A5)  $3/32'' = 1'-0''$

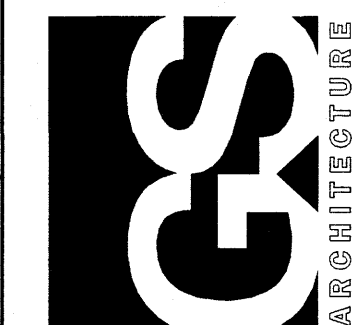

THIS DRAWING IS INCOMPLETE AND NOT TO BE  
USED FOR CONSTRUCTION UNLESS IT IS  
STAMPED, SIGNED, AND DATED BELOW

THE NEW LOS ALTOS POOL  
CITY OF ALBUQUERQUE  
10100 LOMAS BOULEVARD NE  
ALBUQUERQUE, NM 87123


[illegible]

PROJECT	5280.00
NO:	
DRAWN BY:	Author
CHECKED BY:	Checker
GREER STAFFORD/SJCI	
ARCHITECTURE	
SHEET TITLE	
SITE PLAN	

DRAWING SHEET

101.1



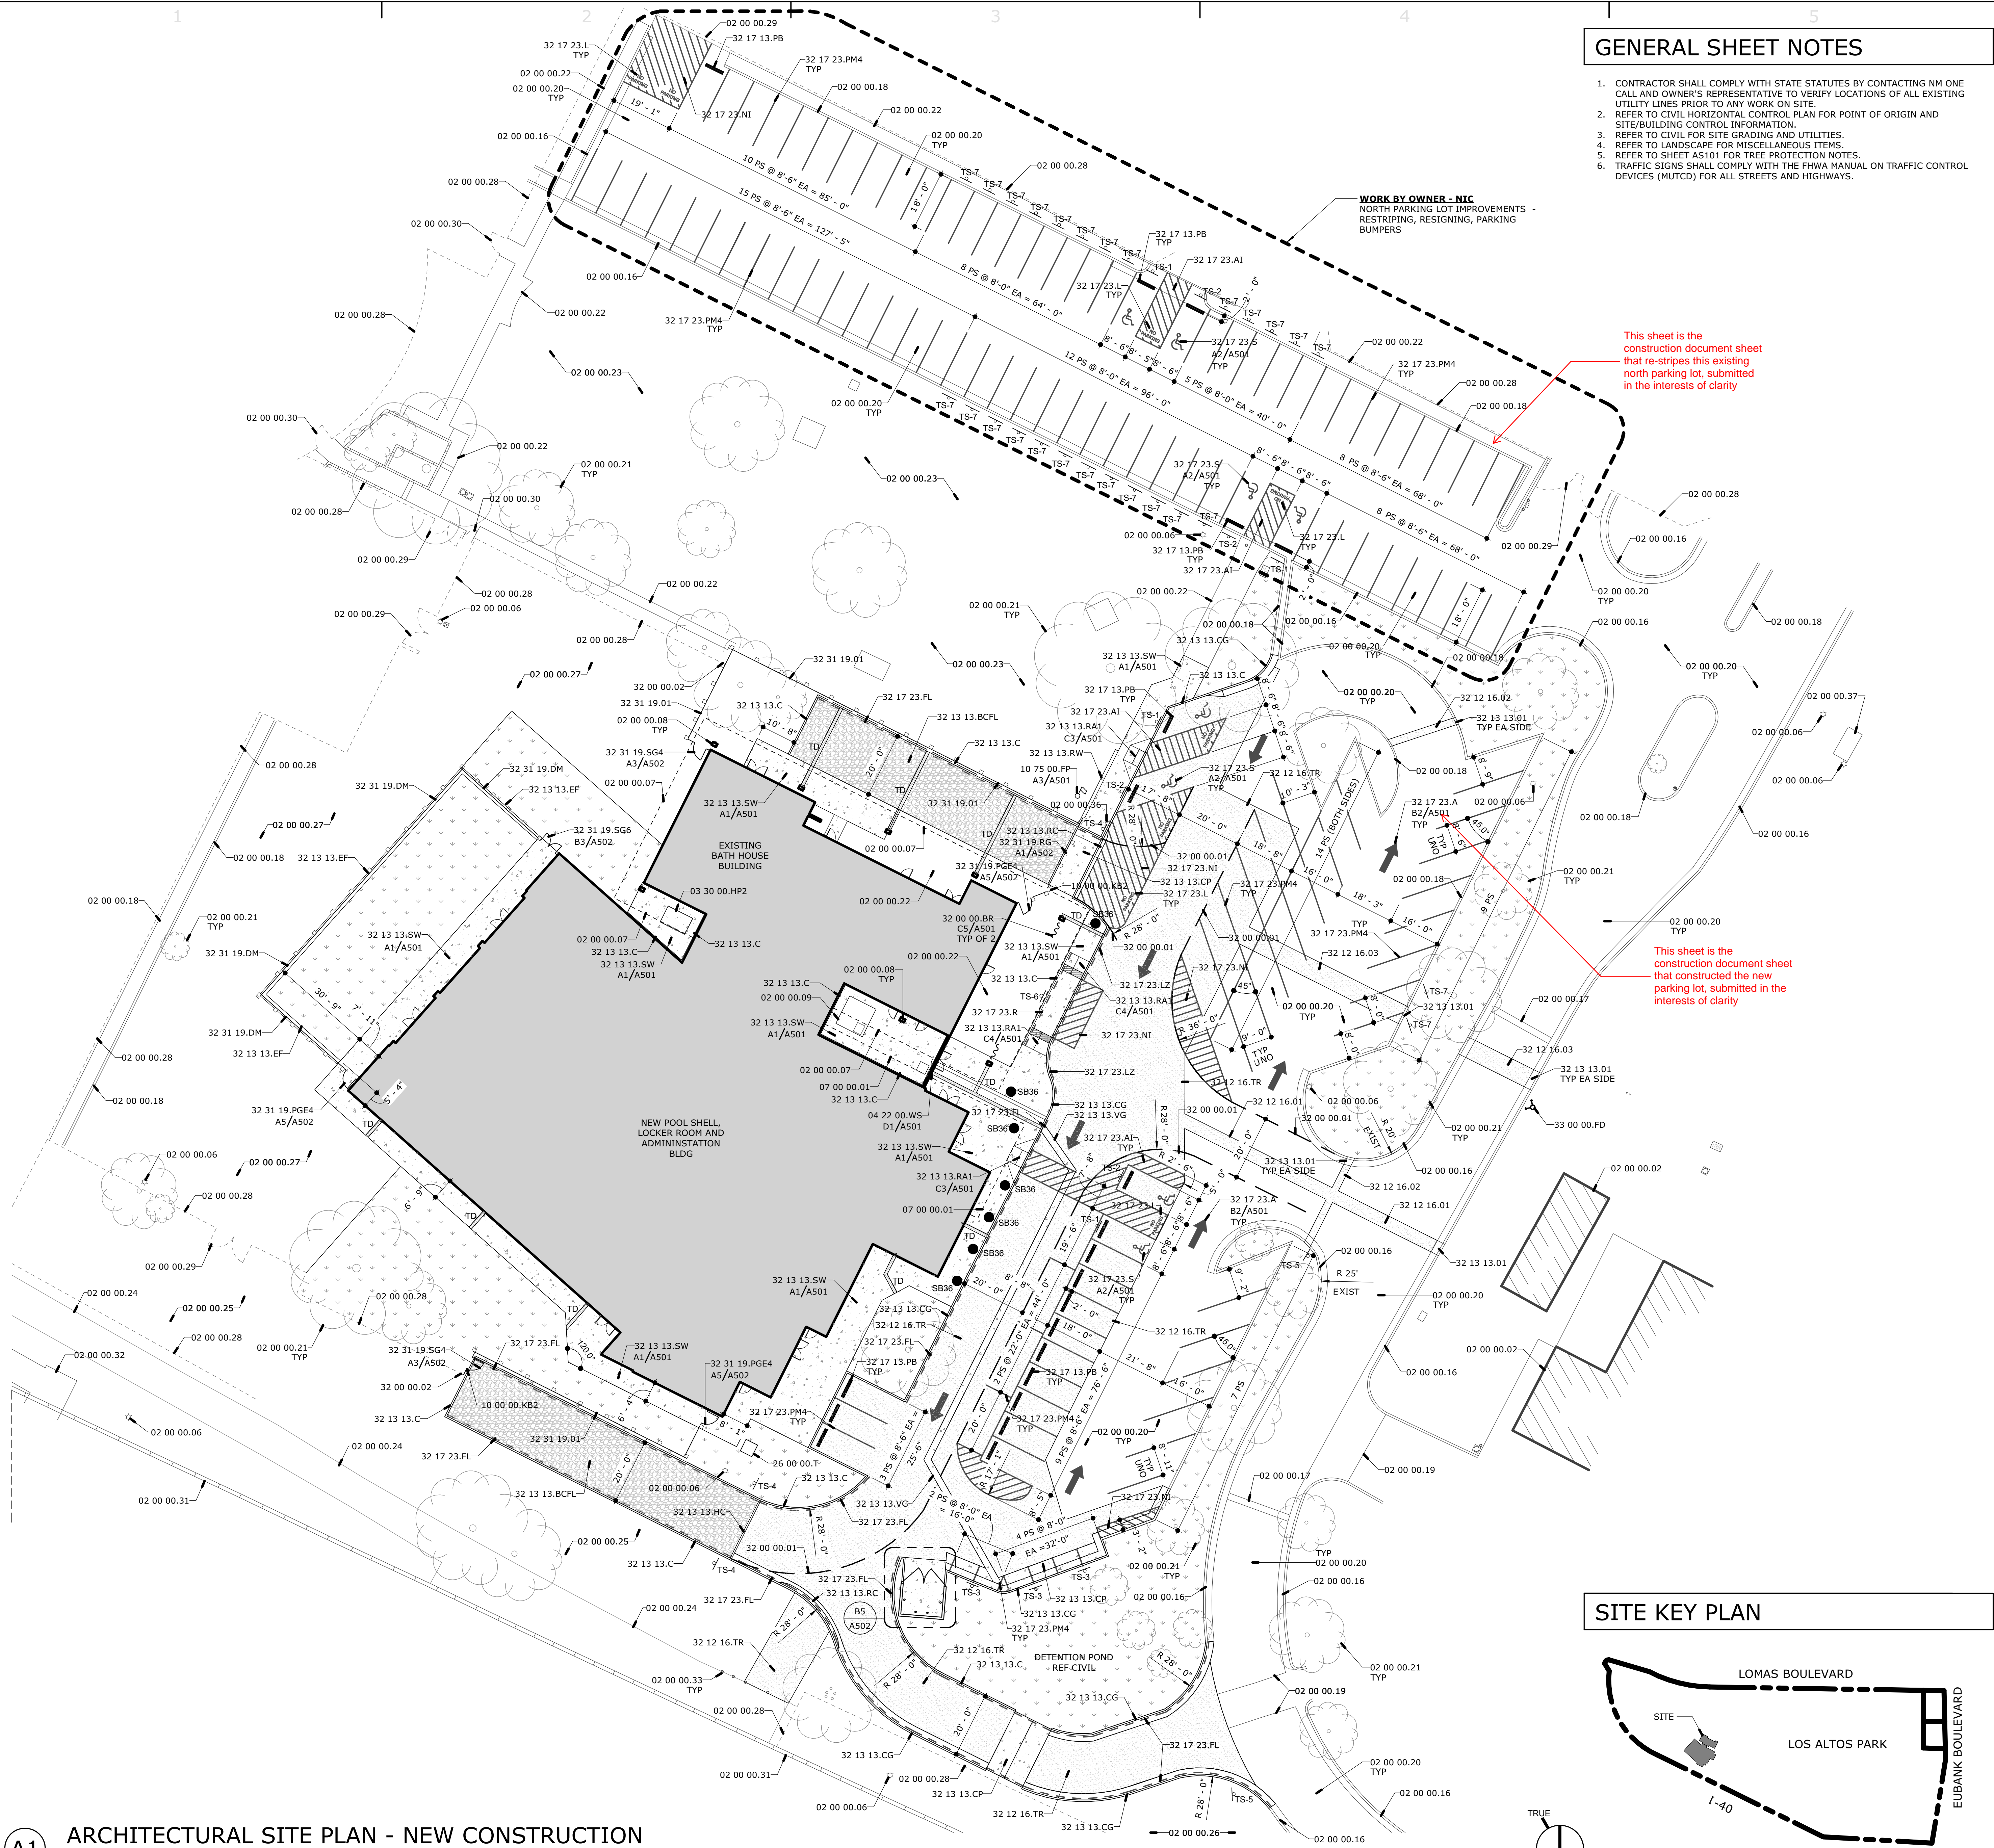

GENERAL SHEET NOTES

1. CONTRACTOR SHALL COMPLY WITH STATE STATUTES BY CONTACTING NM ONE CALL AND OWNER'S REPRESENTATIVE TO VERIFY LOCATIONS OF ALL EXISTING UTILITY LINES PRIOR TO ANY WORK ON SITE.
2. REFER TO CIVIL HORIZONTAL CONTROL PLAN FOR POINT OF ORIGIN AND SITE/BUILDING CONTROL INFORMATION.
3. REFER TO CIVIL FOR SITE GRADING AND UTILITIES.
4. REFER TO LANDSCAPE FOR MISCELLANEOUS ITEMS.
5. REFER TO SHEET AS101 FOR TREE PROTECTION NOTES.
6. TRAFFIC SIGNS SHALL COMPLY WITH THE FHWA MANUAL ON TRAFFIC CONTROL DEVICES (MUTCD) FOR ALL STREETS AND HIGHWAYS.


PARKING REQUIREMENTS

OFF-STREET PARKING REQUIRED FOR LOS ALTOS POOL (ZONE SU-1) PER CITY OF ALBUQUERQUE (ZONING ORDINANCE 1-13-3-1):  
STANDARD PARKING PERMIT - **BP-2017-19345**  
22,000 SF / 20' WIDE - 110 PS REQUIRED; 112 PS PROVIDED  
ADA ACCESSIBLE PARKING - 10 PS REQUIRED; 10 PS PROVIDED  
MOTORCYCLE PARKING  
101 TO 150 OFF-STREET PS = 4 PS REQUIRED; 6 PS PROVIDED  
BICYCLE PARKING  
1 BICYCLE PS / 20 AUTOMOBILE PS = 6 PS REQUIRED; 10 PS PROVIDED

KEYNOTE LEGEND

02 00 00.02	EXISTING BUILDING TO REMAIN
02 00 00.05	EXISTING LIGHT/POWER POLE TO REMAIN
02 00 00.07	LINE OF EXISTING ROOF ABOVE, TYPICAL
02 00 00.08	EXISTING CIP CONCRETE COLUMNS TO REMAIN, TYPICAL
02 00 00.09	EXISTING SURGE TANK AND RAILING TO REMAIN. PROTECT DURING CONSTRUCTION. PAINT RAILING PER SECTION 09 90 00.
02 00 00.16	EXISTING CURB AND GUTTER TO REMAIN
02 00 00.17	EXISTING SPEED BUMP TO REMAIN
02 00 00.18	EXISTING CONCRETE CURB TO REMAIN
02 00 00.19	EXISTING CONCRETE APRON TO REMAIN
02 00 00.20	EXISTING ASPHALT PAVING TO REMAIN
02 00 00.21	EXISTING TREE TO REMAIN. REFER TO TREE PROTECTION NOTES
02 00 00.22	EXISTING CONCRETE WALK TO REMAIN
02 00 00.23	EXISTING GRASS TURF FIELD TO REMAIN
02 00 00.24	EXISTING ASPHALT BIKE PATH TO REMAIN
02 00 00.25	EXISTING SERVICE ACCESS TO REMAIN
02 00 00.26	EXISTING LANDSCAPED AREA - REFER TO LANDSCAPE SHEETS.
02 00 00.27	EXISTING GRAVEL SERVICE AREA TO REMAIN
02 00 00.28	EXISTING FENCE TO REMAIN
02 00 00.29	EXISTING TRAFFIC GATE TO REMAIN
02 00 00.30	EXISTING PEDESTRIAN GATE TO REMAIN
02 00 00.31	EXISTING CONCRETE FREEWAY BARRIER TO REMAIN
02 00 00.32	EXISTING ELEVATED WALKWAY TO REMAIN
02 00 00.33	EXISTING BOLLARD TO REMAIN
02 00 00.36	EXISTING LIGHT POLE TO BE RELOCATED. PROVIDE NEW CONCRETE BASE - REFER TO ELECTRICAL
02 00 00.37	EXISTING ELECTRICAL PMH SWITCH GEAR. REFER TO ELECTRICAL
03 30 00.HP2	CAST-IN-PLACE CONCRETE HOUSE KEEPING PAD. COORDINATE SIZE WITH MEP EQUIPMENT. REFER TO STRUCTURAL.
04 22 00.WS	WALL SCUPPER, COORDINATE OPENING WIDTH WITH TRENCH DRAIN - REFER TO DETAIL
07 00 00.01	LINE OF ROOF ABOVE, TYPICAL
10 00 00.KB2	KNOX BOX KEY VAULT, TYPE AS REQUIRED BY FIRE DEPARTMENT. PROVIDE SURFACE MOUNTED INSTALLATION AT FENCE POST. COORDINATE EXACT INSTALL LOCATION AND REQUIREMENTS WITH FIRE MARSHAL'S INSPECTOR.
10 75 00.FP	FLAGPOLE
26 00 00.T	TRANSFORMER ON CONCRETE PAD - REFER TO ELECTRICAL
32 00 00.01	FIRE DEPARTMENT ACCESS BOUNDARY - FOR INFORMATION ONLY
32 00 00.02	PROVIDE NEW END POST AND RESTRETCH CHAIN LINK FENCING AS REQUIRED
32 00 00.BR	BIKE RACK - REFER TO DETAIL
32 00 00.SB	PRECAST CONCRETE SPHERICAL BOLLARD, 36" DIAMETER - REFER TO DETAIL
32 00 00.TS	TRAFFIC SIGN - REFER TO DETAIL
32 12 16.01	PATCH ASPHALT PAVING WITH TRAFFIC RATED ASPHALT SECTION. COORDINATE EXTENTS WITH REQUIRED UTILITY WORK. REFER TO ELECTRICAL. REFER ALSO STANDARD DETAIL #2465.
32 12 16.02	PATCH ASPHALT PAVING WITH TRAFFIC RATED ASPHALT SECTION. COORDINATE EXTENTS WITH REQUIRED IRRIGATION WORK. REFER TO LANDSCAPE. REFER ALSO TO COA STANDARD DETAIL #2465.
32 12 16.03	PATCH ASPHALT PAVING WITH TRAFFIC RATED ASPHALT SECTION. COORDINATE EXTENTS WITH REQUIRED UTILITY WORK. REFER TO LANDSCAPE. REFER ALSO TO COA STANDARD DETAIL #2465.
32 12 16.TR	ASPHALT PAVING, TRAFFIC RATED - REFER TO CIVIL
32 13 13.01	PATCH CONCRETE CURB AND GUTTER TO MATCH EXISTING. COORDINATE EXTENTS WITH REQUIRED UTILITY/IRRIGATION WORK. REFER ALSO TO COA STANDARD DETAILS #2458 & #2459.
32 13 13.BCFL	COMPACTED BASE FIRE LANE - REFER TO CIVIL
32 13 13.C	CONCRETE CURB - REFER TO CIVIL
32 13 13.CG	CONCRETE CURB AND GUTTER - REFER TO CIVIL
32 13 13.CP	CONCRETE PAVING - REFER TO CIVIL
32 13 13.EF	CONCRETE EDEGE AT FENCE - REFER TO COA STANDARD DETAIL #2725
32 13 13.HC	CONCRETE HEADER CURB - REFER TO CIVIL
32 13 13.RA1	CONCRETE RAMP WITH ADA DETECTABLE WARNING DEVICE - REFER TO DETAIL
32 13 13.RC	CONCRETE ROLL CURB - REFER TO CIVIL
32 13 13.RW	4" THICK CONCRETE ROLL GATE RUNWAY. COORDINATE SIZE WITH GATE REQUIREMENTS.
32 13 13.SW	CONCRETE SIDEWALK - REFER TO DETAIL AND CIVIL
32 13 13.TD	TRENCH DRAIN AT DOWNSPOUT - REFER TO DETAIL
32 13 13.VG	CONCRETE VALLEY GUTTER - REFER TO DETAIL
32 17 13.PB	PARKING BUMPER
32 17 23.A	PAINTED TRAFFIC ARROW - REFER TO DETAIL
32 17 23.AI	PAINTED ADA ACCESS AISLE, 4" WIDE, 45 DEGREE DIAGONAL STRIPS AT 24" OC
32 17 23.FL	PAINTED CURB AT FIRE LANE
32 17 23.L	PAINTED LETTERING, "NO PARKING", 12" TALL AT END OF ACCESS AISLE
32 17 23.LZ	PAINTED CURB AT LOADING ZONE
32 17 23.NI	PAINTED NO PARKING AISLE, 4" WIDE, 45 DEGREE DIAGONAL STRIPS AT 24" OC
32 17 23.PM4	PAINTED PAVEMENT MARKINGS, 4" WIDE
32 17 23.R	PAINTED CURB AT RAMP
32 17 23.S	PAINTED ADA SYMBOL - REFER TO DETAIL
32 31 19.01	REINSTALL SALVAGED DECORATE METAL FENCE PANELS. PROVIDE NEW POSTS SET IN CONCRETE FOOTINGS AS REQUIRED. PAINT EXISTING FENCE PANELS TO MATCH SPECIFIED NEW FENCING/GATES. REFER TO D2/A502 (SIM) - NIC, WORK BY OWNER
32 31 19.DM	DECORATIVE METAL FENCE - REFER TO C2/A502 - NIC, WORK BY OWNER
32 31 19.PGE4	4'-0" WIDE SINGLE PEDESTRIAN GATE WITH EMERGENCY PANIC HARDWARE - REFER TO DETAIL - NIC, WORK BY OWNER
32 31 19.RG	22'-0" LONG ROLLING TRAFFIC GATE - REFER TO DETAIL - NIC, WORK BY OWNER
32 31 19.SG4	4'-0" WIDE SINGLE SWING GATE - REFER TO DETAIL - NIC, WORK BY OWNER
32 31 19.SG6	6'-0" WIDE DOUBLE SWING GATE - REFER TO DETAIL - NIC, WORK BY OWNER
33 00 00.FD	RELOCATED FIRE HYDRANT - REFER TO CIVIL

SITE KEY PLAN

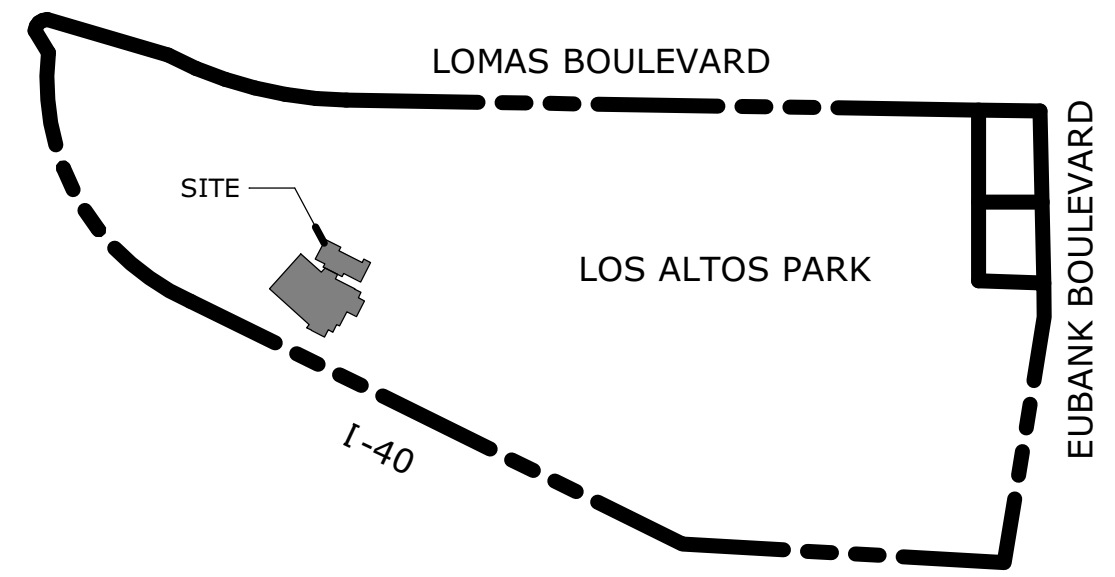

LEGEND

	NEW CONCRETE PAVING/SIDEWALK - REF SITE PLAN FOR TYPE
	NEW ASPHALT PAVING - REF SITE PLAN FOR TYPE
	LANDSCAPED AREA - REF LANDSCAPE SHEETS
	32 00 00.TS TRAFFIC SIGN - REFER TO DETAIL A4/A501
	32 00 00.SB PRECAST CONCRETE SPHERICAL BOLLARD, 36" DIAMETER - REFER TO DETAIL D5/A501
	32 13 13.TD TRENCH DRAIN AT DOWNSPOUT - REFER TO DETAIL C1/A501

ARCHITECTURAL SITE PLAN - NEW CONSTRUCTION

1" = 20'-0"

GREER STAFFORD/SJCF ARCHITECTURE, INC.

1717 LOUISIANA NE, SUITE 205  
ALBUQUERQUE, NM 87102-7027  
(505) 621-0239 • FAX: (505) 621-0348

3005 NORTHBRIDGE DR., SUITE F  
FARMINGTON, NM 87401-2085  
(505) 325-7475 • FAX: (505) 325-6464

THIS DRAWING IS INCOMPLETE AND NOT TO BE USED FOR CONSTRUCTION UNLESS IT IS SIGNED, SEALED, AND DATED BELOW.

THE NEW LOS ALTOS POOL  
CITY OF ALBUQUERQUE  
10100 LOMAS BOULEVARD NE  
ALBUQUERQUE, NM 87123

Mark	Date	Description	Issue
			JUNE 5, 2017

PROJECT NO: 5287.00

DRAWN BY:

CHECKED BY:

© GREER-STAFFORD/SJCF, INC.

SHEET TITLE  
ARCHITECTURAL  
SITE PLAN - NEW  
CONSTRUCTION

DRAWING SHEET

AS102





**GREER STAFFORD / SJCF ARCHITECTURE, INC.**

1717 Louisiana Blvd NE, Suite 205

Albuquerque, NM 87110


OFFICE: (505) 821-0235 | FAX: (505) 821-0348

www.greer-stafford.com

## TRAFFIC CERTIFICATION

I, **Michael Heitman**, NMRA 4458, of the firm **Greer Stafford / SJCF ARCHITECTURE, Inc.**, hereby certify that this project is in substantial compliance with and in accordance with the design intent of the approved **DRB Amended Site Plan for Building Development Sheet A101.1** dated **February 21, 2017** as modified in the **Site Plan for Building Permit Sheet AS102** dated **June 5, 2017**. The record information edited onto the original design document has been obtained by **myself** of the firm **Greer Stafford / SJCF ARCHITECTURE, Inc.** I further certify that I have personally visited the project site on **February 28, 2019** and have determined by visual inspection that the survey data provided is representative of actual site conditions and is true and correct to the best of my knowledge and belief. This certification is submitted in support of a request for **final Certificate of Occupancy**.

THE RECORD INFORMATION PRESENTED HEREON IS NOT NECESSARILY COMPLETE AND INTENDED ONLY TO VERIFY SUBSTANTIAL COMPLIANCE OF THE TRAFFIC ASPECTS OF THIS PROJECT. THOSE RELYING ON THE RECORD DOCUMENT ARE ADVISED TO OBTAIN INDEPENDENT VERIFICATION OF ITS ACCURACY BEFORE USING IT FOR ANY OTHER PURPOSE.

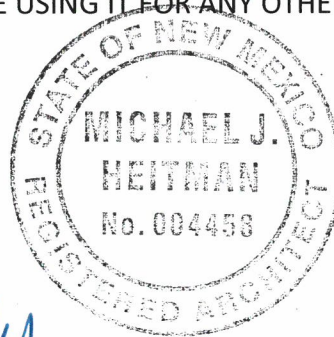

*Michael Heitman, AIA*

ARCHITECT'S STAMP

Signature of Architect

03.01.19

Date





# City of Albuquerque

Planning Department

Development & Building Services Division

## DRAINAGE AND TRANSPORTATION INFORMATION SHEET (REV 6/2018)

**Project Title:** The New Los Altos Pool **Building Permit #:** BP-2017-19345 **Hydrology File #:** \_\_\_\_\_

**DRB#:** 1011048 **EPC#:** 16EPC-40066 **Work Order#:** \_\_\_\_\_

**Legal Description:** Tract 4, Municipal Addition No 2

**City Address:** 10100 Lomas Boulevard NE, Albuquerque NM 87123

**Applicant:** Greer Stafford / SJCF ARCHITECTURE, Inc **Contact:** Michael Heitman, AIA

**Address:** 1717 Louisiana Boulevard NE, Suite 205 Albuquerque NM 87110

**Phone#:** 505.821.0235 **Fax#:** 505.821.0348 **E-mail:** mheitman@greer-stafford.com

**Other Contact:** COA Parks and Recreation Department c/o Christina Sandoval, Principal Planner

**Address:** PO Box 1293 Albuquerque NM

**Phone#:** 505. 768.5370 **Fax#:** \_\_\_\_\_ **E-mail:** cmsandoval@cabq.gov

**TYPE OF DEVELOPMENT:** \_\_\_\_\_ PLAT (# of lots) \_\_\_\_\_ RESIDENCE ☒ DRB SITE \_\_\_\_\_ ADMIN SITE

**IS THIS A RESUBMITTAL?** \_\_\_\_\_ Yes ☒ No

**DEPARTMENT** ☒ TRANSPORTATION \_\_\_\_\_ HYDROLOGY/DRAINAGE

Check all that Apply:

### TYPE OF SUBMITTAL:

- ☒ ENGINEER/ARCHITECT CERTIFICATION  
\_\_\_\_ PAD CERTIFICATION  
\_\_\_\_ CONCEPTUAL G & D PLAN  
\_\_\_\_ GRADING PLAN  
\_\_\_\_ DRAINAGE REPORT  
\_\_\_\_ DRAINAGE MASTER PLAN  
\_\_\_\_ FLOODPLAIN DEVELOPMENT PERMIT APPLIC  
\_\_\_\_ ELEVATION CERTIFICATE  
\_\_\_\_ CLOMR/LOMR  
☒ TRAFFIC CIRCULATION LAYOUT (TCL)  
\_\_\_\_ TRAFFIC IMPACT STUDY (TIS)  
\_\_\_\_ STREET LIGHT LAYOUT  
\_\_\_\_ OTHER (SPECIFY) \_\_\_\_\_  
\_\_\_\_ PRE-DESIGN MEETING?

### TYPE OF APPROVAL/ACCEPTANCE SOUGHT:

- \_\_\_\_ BUILDING PERMIT APPROVAL  
☒ CERTIFICATE OF OCCUPANCY  
\_\_\_\_ PRELIMINARY PLAT APPROVAL  
\_\_\_\_ SITE PLAN FOR SUB'D APPROVAL  
\_\_\_\_ SITE PLAN FOR BLDG. PERMIT APPROVAL  
\_\_\_\_ FINAL PLAT APPROVAL  
\_\_\_\_ SIA/ RELEASE OF FINANCIAL GUARANTEE  
\_\_\_\_ FOUNDATION PERMIT APPROVAL  
\_\_\_\_ GRADING PERMIT APPROVAL  
\_\_\_\_ SO-19 APPROVAL  
\_\_\_\_ PAVING PERMIT APPROVAL  
\_\_\_\_ GRADING/ PAD CERTIFICATION  
\_\_\_\_ WORK ORDER APPROVAL  
\_\_\_\_ CLOMR/LOMR  
\_\_\_\_ FLOODPLAIN DEVELOPMENT PERMIT  
\_\_\_\_ OTHER (SPECIFY) \_\_\_\_\_

**DATE SUBMITTED:** 03.01.19 **By:** Michael Heitman **Architect of Record, Greer Stafford / SJCF ARCHITECTURE**

COA STAFF:

ELECTRONIC SUBMITTAL RECEIVED: \_\_\_\_\_

FEE PAID: \_\_\_\_\_