

CITY OF ALBUQUERQUE



February 3, 2016

Paul Engel
Anderson Engineering, Inc.
2045 W. Woodland
Springfield, MO 65807

Re: O'Reilly Auto Parts- Albuquerque (A15)
12700 Lomas Blvd., NE
Traffic Circulation Layout
Engineer's/Architect's Stamp dated 1-28-16 (K22-D019)

Dear Mr. Engel,

The TCL submittal received 2-1-16 is approved for Building Permit. A copy of the stamped and signed plan will be needed for each of the building permit plans. Please keep the original to be used for certification of the site for final C.O. for Transportation.

When the site construction is completed and a Certificate of Occupancy (C.O.) is requested, use the original City stamped approved TCL for certification. Redline any minor changes and adjustments that were made in the field. A NM registered architect or engineer must stamp, sign, and date the certification TCL along with indicating that the development was built in "substantial compliance" with the TCL. Submit this certification TCL with a completed Drainage and Transportation Information Sheet to front counter personnel for log in and evaluation by Transportation.

Once verification of certification is completed and approved, notification will be made to Building Safety to issue Final C.O. To confirm that a final C.O. has been issued, call Building Safety at 924-3690.

Sincerely,

Racquel M. Michel, P.E.
Traffic Engineer, Planning Dept.
Development Review Services

\gs via: email
C: CO Clerk, File



City of Albuquerque

Planning Department
Development & Building Services Division

DRAINAGE AND TRANSPORTATION INFORMATION SHEET (REV 09/2015)

Project Title: O'Reilly Auto Parts - Albuquerque, NM (A15) Building Permit #: T201592448 City Drainage #: K2220019
DRB#: _____ EPC#: _____ Work Order#: _____
Legal Description: All of Block One (1) of Chelwood Park
City Address: 12700 Lomas Blvd NE, Albuquerque, NM 87123

Engineering Firm: Anderson Engineering, Inc. Contact: Paul J. Engel
Address: 2045 W. Woodland, Springfield, MO 65807
Phone#: (417) 866-2741 Fax#: (417) 866-2778 E-mail: pengel@aeincmo.com

Owner: O'Reilly Automotive Stores, Inc. Contact: Sheldon Jennings
Address: 233 South Patterson, Springfield, MO 65802
Phone#: (417) 862-2674 Fax#: (417) 874-7112 E-mail: sjennings@oreillyauto.com

Architect: CASCO Contact: Mike Chura
Address: 10877 Watson Road, St. Louis, MO 63127
Phone#: (314) 821-1100 Fax#: (314) 821-4162 E-mail: oreillygu@cascoCorp.com

Other Contact: _____ Contact: _____
Address: _____
Phone#: _____ Fax#: _____ E-mail: _____

Check all that Apply:

DEPARTMENT:
☐ HYDROLOGY/ DRAINAGE
☒ TRAFFIC/ TRANSPORTATION
☐ MS4/ EROSION & SEDIMENT CONTROL

TYPE OF SUBMITTAL:
☐ ENGINEER/ ARCHITECT CERTIFICATION

☐ CONCEPTUAL G & D PLAN
☐ GRADING PLAN
☐ DRAINAGE MASTER PLAN
☐ DRAINAGE REPORT
☐ CLOMR/LOMR

☒ TRAFFIC CIRCULATION LAYOUT (TCL)
☐ TRAFFIC IMPACT STUDY (TIS)
☐ EROSION & SEDIMENT CONTROL PLAN (ESC)

☐ OTHER (SPECIFY) _____

CHECK TYPE OF APPROVAL/ACCEPTANCE SOUGHT:

☒ BUILDING PERMIT APPROVAL
☐ CERTIFICATE OF OCCUPANCY

☐ PRELIMINARY PLAT APPROVAL
☐ SITE PLAN FOR SUB'D APPROVAL
☐ SITE PLAN FOR BLDG. PERMIT APPROVAL
☐ FINAL PLAT APPROVAL
☐ SIA/ RELEASE OF FINANCIAL GUARANTEE
☐ FOUNDATION PERMIT APPROVAL
☐ GRADING PERMIT APPROVAL
☐ SO-19 APPROVAL
☐ PAVING PERMIT APPROVAL
☐ GRADING/ PAD CERTIFICATION
☐ WORK ORDER APPROVAL
☐ CLOMR/LOMR

☐ PRE-DESIGN MEETING
☐ OTHER (SPECIFY) _____




IS THIS A RESUBMITTAL? ☒ Yes ☐ No

DATE SUBMITTED: 2/1/16 By: Ryan Curley

COA STAFF: _____ ELECTRONIC SUBMITTAL RECEIVED: _____

STAGES OF CONSTRUCTION:

1. CONTRACTOR TO PERFORM DETAILED SITE INSPECTION TO LOCATE ALL EXISTING UTILITIES AND VERIFY ANY POSSIBLE CONFLICTS WITH PROPOSED IMPROVEMENTS PRIOR TO BEGINNING ANY CONSTRUCTION. CONTACT OWNER WITH ANY CONFLICTS. MONTH 1
2. INSTALLATION OF CONSTRUCTION ENTRANCE. MONTH 1
3. INSTALLATION OF EROSION CONTROL FENCE. MONTH 1
4. DEMOLITION OF EXISTING SITE IMPROVEMENTS. MONTH 1
5. REMOVAL OF EXISTING PAVEMENT ON THE SITE. MONTH 1
6. INSTALLATION OF ALL STORM WATER DRAINAGE IMPROVEMENTS. MONTH 1
7. ROUGH GRADING. MONTH 1 & MONTH 2
8. CONSTRUCTION OF NEW SITE IMPROVEMENTS. MONTH 2
9. FINAL GRADING. MONTH 3
10. PLACEMENT OF FINAL LANDSCAPING ITEMS AND SOD. MONTH 3
11. REMOVAL OF EROSION CONTROL FENCE. MONTH 3

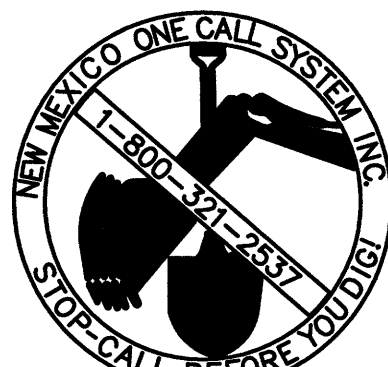

GENERAL NOTES:

- REFER TO PROJECT MANUAL FOR ADDITIONAL REQUIREMENTS.
- ALL SITE DIMENSIONS TO THE FACE OF CURB, CONCRETE OR PROPERTY LINE UNLESS OTHERWISE NOTED. CONTRACTOR TO FIELD VERIFY EXISTING CONDITIONS BY DETAILED INSPECTION PRIOR TO SUBMITTING BID AND STARTING CONSTRUCTION.
- COORDINATE WORK WITH OTHER SITE RELATED DEVELOPMENT DRAWINGS.
- REFER TO STRUCTURAL PLANS FOR DEVELOPMENT OF SIDEWALKS ADJACENT TO FOUNDATIONS.

SPECIAL NOTE:
ALL BROKEN OR CRACKED SIDEWALK MUST BE REPLACED WITH SIDEWALK AND CURB & GUTTER. REFER TO CITY OF ALBUQUERQUE STANDARD DRAWING 2430.

GENERAL INFORMATION:

TYPE OF DEVELOPMENT: COMMERCIAL RETAIL
SIZE OF DEVELOPMENT: BUILDING = 7,453 SQ. FT.
PARKING LOT = 23,477 SQ. FT.
7,453 / 200 = 37.27 = 38 SPACES
PARKING SPACES REQUIRED: 38 SPACES
PARKING SPACES PROVIDED: 38 SPACES
MOTORCYCLE SPACES PROVIDED: 2 SPACES
BICYCLE SPACES PROVIDED: 2 SPACES
HANDICAP SPACES PROVIDED: 2 SPACES

EXECUTIVE SUMMARY:

THIS COMMERCIAL PROJECT IS LOCATED AT 12700 LOMAS BLVD NE ALBUQUERQUE, NM. O'REILLY AUTO PARTS IS PROPOSING A 7,453 SQ. FT. BUILDING AND 23,050 SQ. FT. OF PARKING LOT. THE PARKING LOT PROVIDES 38 TOTAL PARKING SPACES WITH 2 HANDICAP SPACES, 2 MOTORCYCLE SPACES, 2 BICYCLE SPACES AND AN UNLOADING ZONE. THE PARKING LAYOUT PROVIDES 3 DRIVEWAY ACCESSES WITH 30' WIDE DRIVE AISLES.

LEGAL DESCRIPTION (AS-SURVEYED):


ALL OF BLOCK ONE (1) OF CHELWOOD PARK, LYING WITHIN SECTION 22, T.10N., R.4E., N.M.P.M., WITHIN THE CITY OF ALBUQUERQUE, BERNALILLO COUNTY, NEW MEXICO, AS SHOWN ON PLAT OF SURVEY FILED ON MAY 25, 1955, IN PLAT BOOK D1, FOLIO 138, RECORDS OF BERNALILLO COUNTY, NEW MEXICO.

KEY NOTES:

1. CONCRETE PAVING: REFER TO DETAIL 1C3.
2. NOT USED.
3. CONCRETE CURB: REFER TO DETAIL 3C3.
4. CONCRETE SIDEWALK: REFER TO DETAIL 4C3.
5. CONCRETE DOOR LANDING: REFER TO DETAIL 4C3 AND STRUCTURAL DETAILS. RAMP PAVING AS INDICATED. LANDING CAN BE POURED MONOLITHIC IF CONCRETE PAVING IS USED.
6. STEEL BOLLARD: REFER TO DETAIL 8C3. PROVIDE (2) AT TRASH PAD AND (2) AT OVERHEAD DOOR. PROVIDE (8) AT SIDEWALK AND (2) AT MOTORCYCLE PARKING SPACES. REFER TO STRUCTURAL PLAN FOR LOCATION.
7. HANDICAP PARKING SIGN: REFER TO DETAIL 7C3 AND THIS SHEET.
8. NEW CURB: NEW CURB TO MATCH EXISTING ADJACENT CURB.
9. HANDICAP PARKING SYMBOL: REFER TO DETAIL 9C3.
10. HANDICAP ACCESS UNLOADING ZONE: SLOPE 2% MAX. EACH WAY (ADA COMPLIANT) AND STRIPE AS SHOWN. ACCESS AISLE SHALL HAVE THE WORDS "NO PARKING" IN CAPITAL LETTERS EACH OF WHICH SHALL BE AT LEAST ONE FOOT HIGH AND AT LEAST TWO INCHES WIDE. PAVED AS SHOWN ON PLANS.
11. SCREEN FENCE: REFER TO DETAIL 11C3.
12. SCREEN FENCE GATES: REFER TO DETAIL 12C3.
13. CONCRETE BUMPER BLOCK: 8" x 5" x 6" LONG CONCRETE. ANCHOR TO PAVING WITH (2) 1" x 5" LONG #4 REBAR (TO SIT LEVEL WITH PAVING).
14. PARKING LOT LIGHTING: REFER TO SITE LIGHTING PLAN FOR LOCATION AND TYPE.
15. LIMITS OF NEW PAVING: MATCH EXISTING PER CITY AND OR STATE STANDARDS.
16. CONSTRUCTION LIMIT LINE.
17. NOT USED.
18. STRIPING: PROVIDE 4" WIDE PARKING LOT STRIPING AS SHOWN. USE HIGHWAY MARKING PAINT- WHITE (2 COATS)
19. 3' CURB CUT.
20. CONCRETE HANDICAP RAMP: REFER TO DETAIL 3C3.
21. MOTORCYCLE PARKING SIGN: REFER TO DETAIL 2C3.1.
22. PROVIDE 2 BICYCLE PARKING SPACES. REFER TO DETAIL 8C3.
23. CONCRETE PAVING IN TRASH ENCLOSURE: REFER TO DETAIL 1C3.1.
24. INSTALL DRIVEPADS PER COA STD DWG 2425. REFER TO DETAIL 3C2.
25. INSTALL 3' X 2' TRUNCATED DOMES PER ADA STANDARDS.


SYMBOLS LEGEND

REFER TO SURVEY FOR EXISTING CONDITION SYMBOLS LEGEND	
	NEW BUILDING CONSTRUCTION
	AREA OF CONCRETE
	AREA OF PAVING
	NEW CONCRETE PAVING BLOCK
	NEW LIGHT POLE LOCATION
	CONSTRUCTION LIMIT LINE

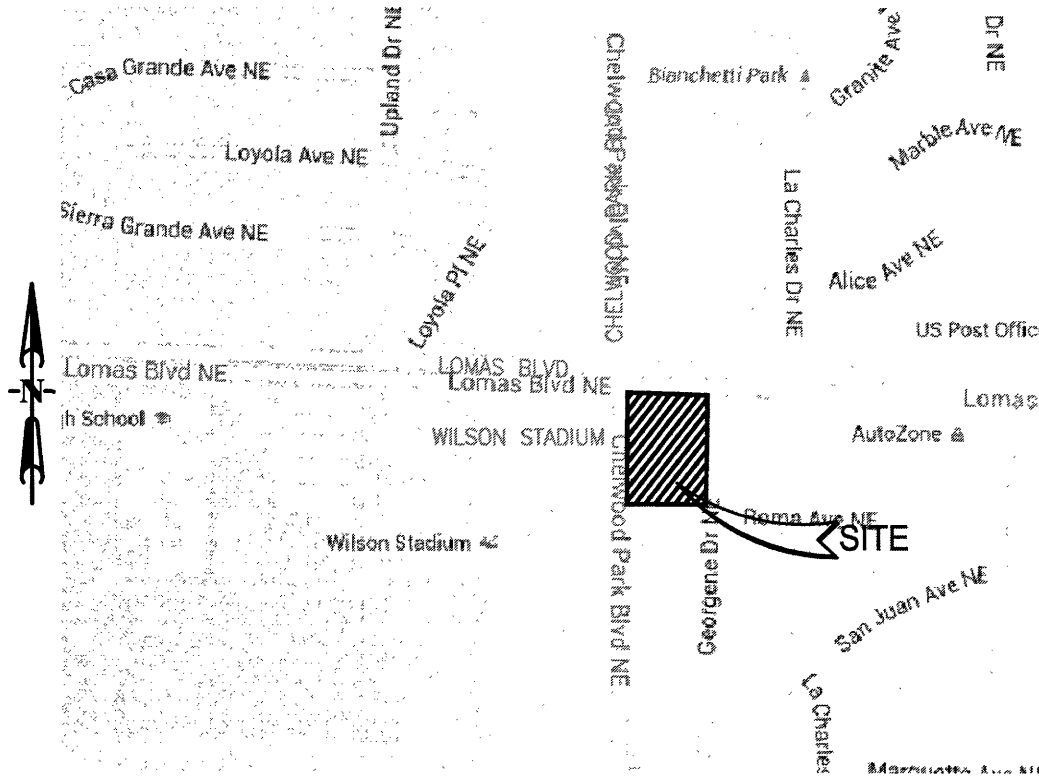



VICINITY MAP:
(NOT TO SCALE)
ZONE ATLAS PAGE: K-22-Z

ALL WHEELCHAIR RAMPS LOCATED WITHIN THE PUBLIC RIGHT OF WAY MUST HAVE TRUNCATED DOMES.

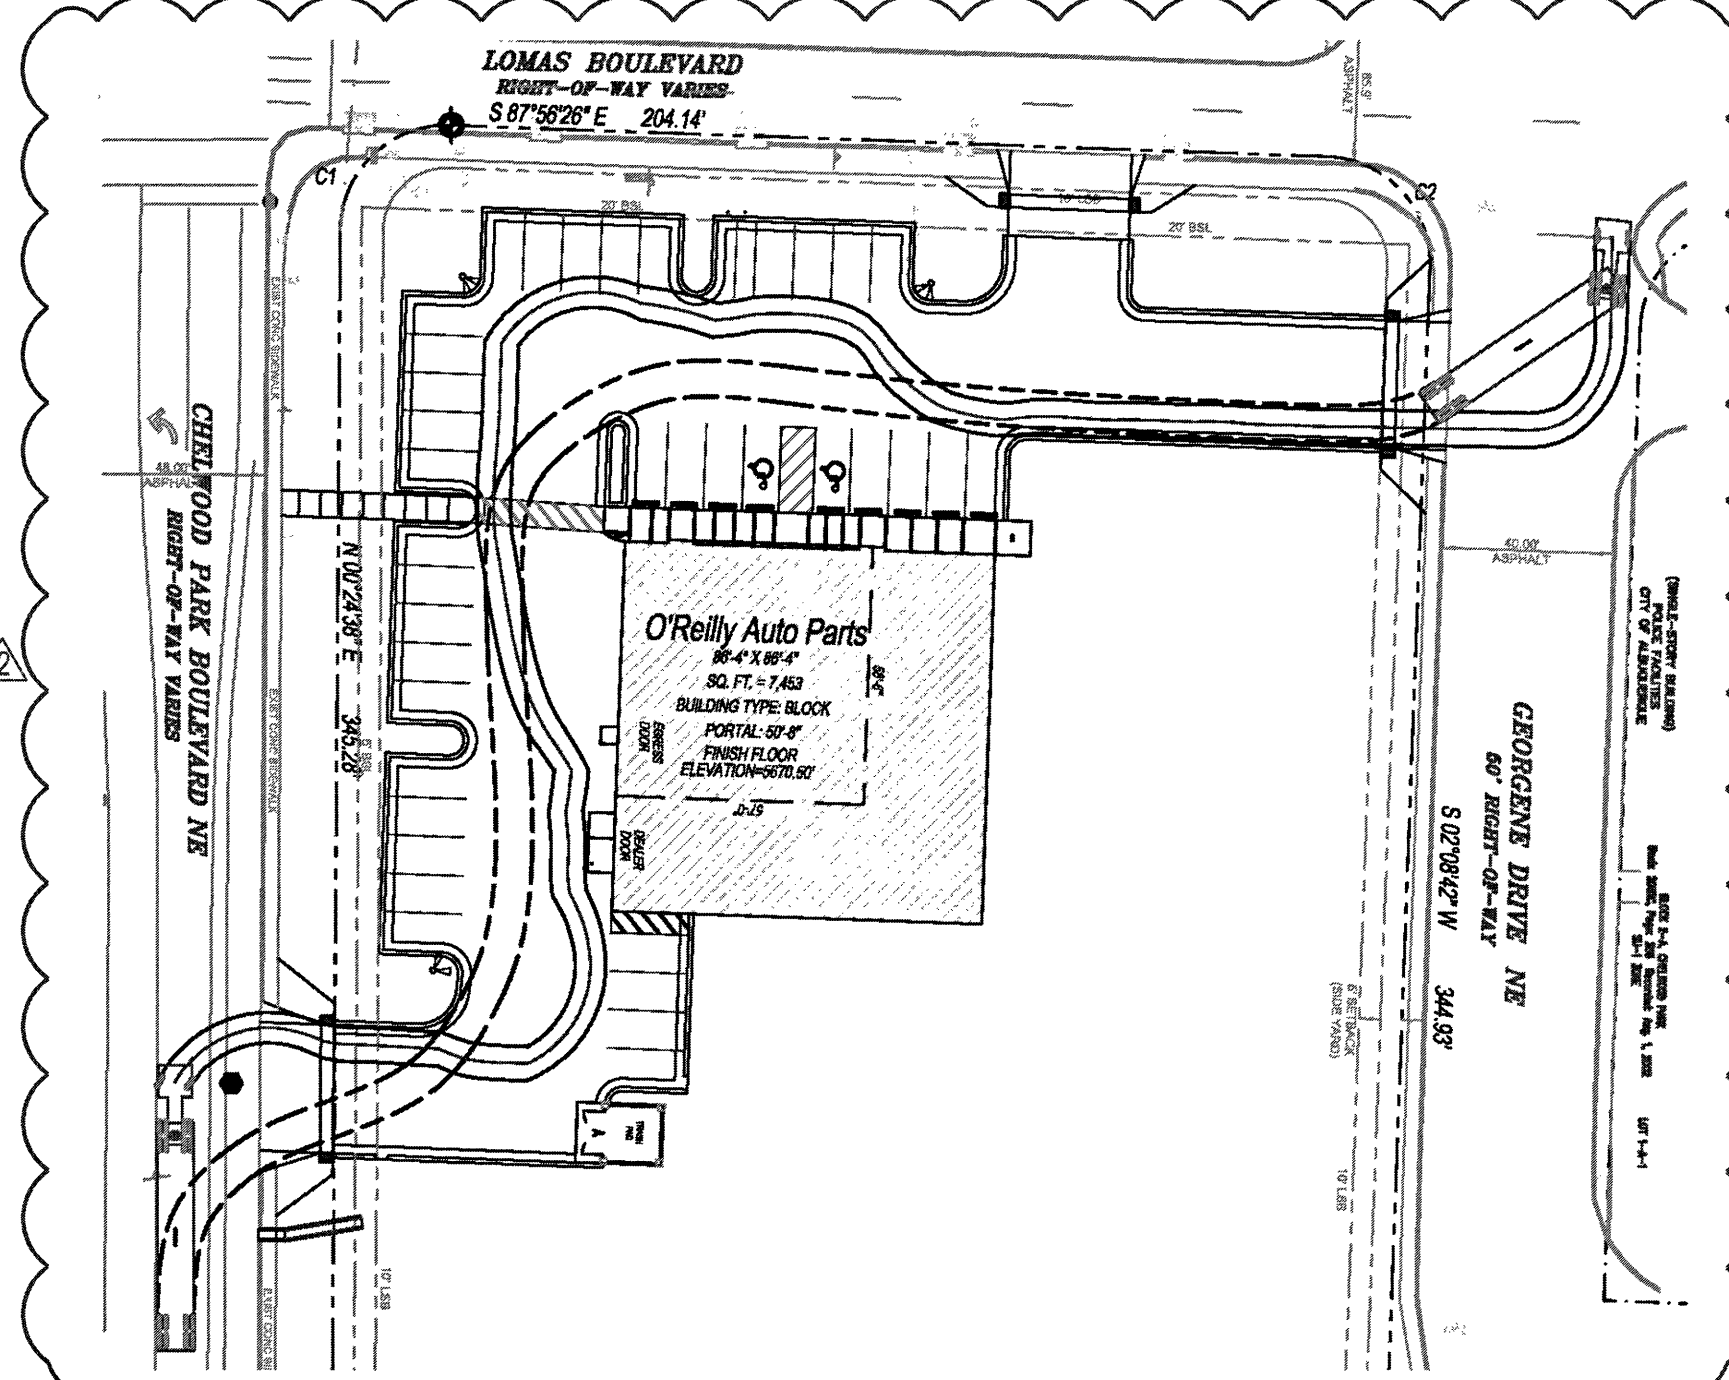



2 DELIVERY TRUCK VEHICLE ROUTE

SCALE: NOT TO SCALE

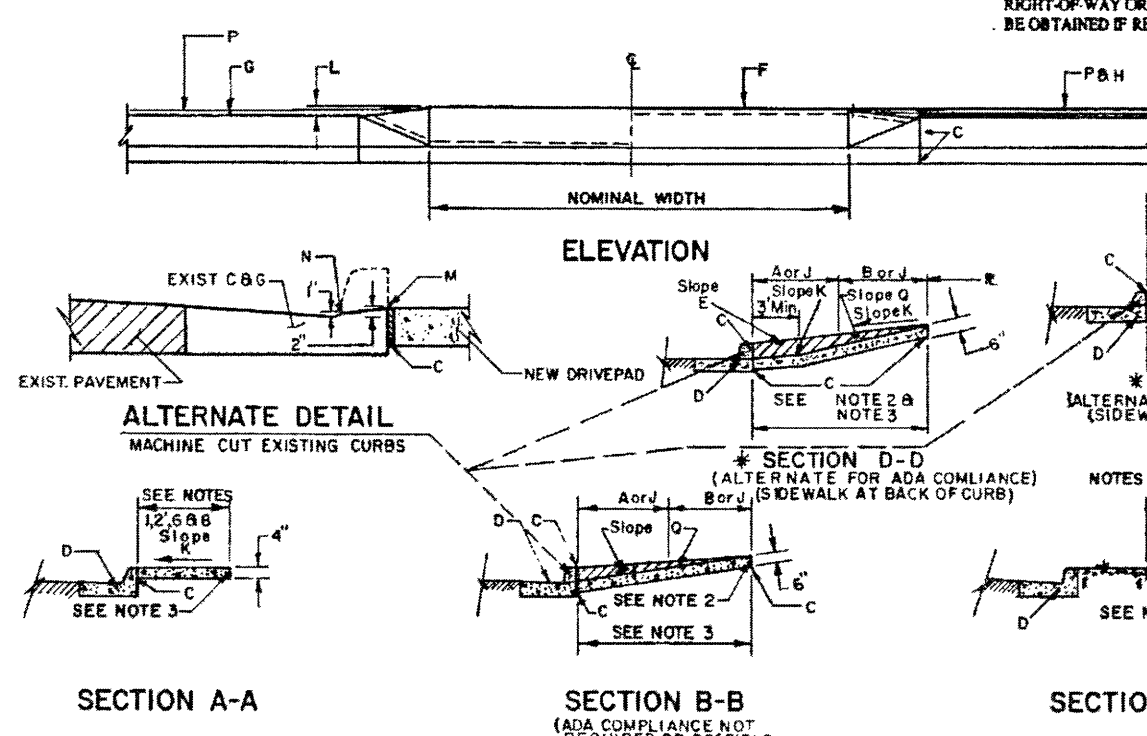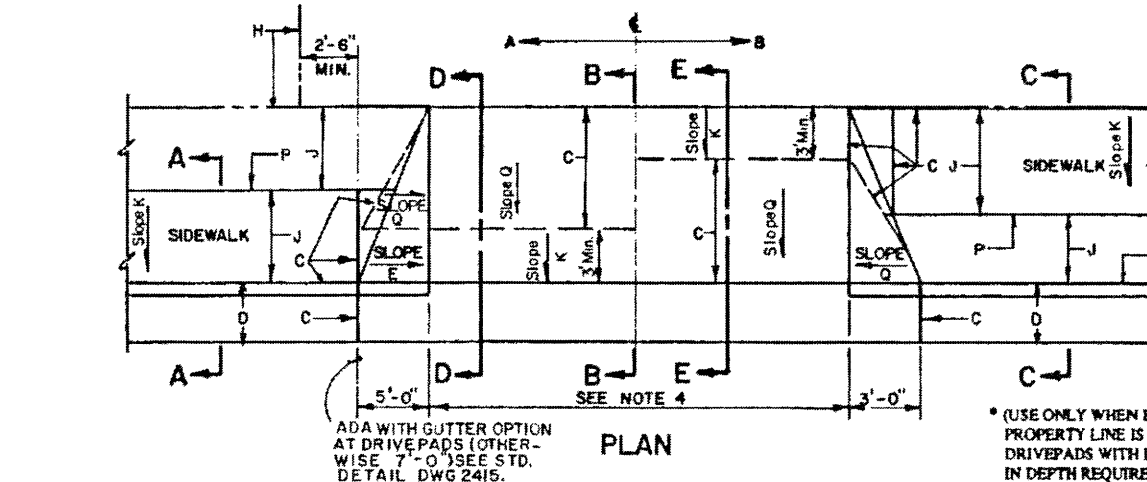


- GENERAL NOTES
1. DEVIATIONS FROM THESE STANDARDS SHALL BE SUBMITTED TO THE CITY ENGINEER AND/OR TRAFFIC ENGINEER FOR APPROVAL PRIOR TO CONSTRUCTION.
 2. REQUEST FOR SIDEWALK VARIANCES SHALL BE SUBMITTED TO THE DEVELOPMENT REVIEW BOARD.
 3. USE 1/2" x 2" x 24" WIDE SIDEWALK OR INTERLOCKED BRICK BLOCKS. FENCES, WALLS OR OTHER IMMOVABLE OBJECTS.
 4. ALL DRIVEPADS SHALL BE A MIN. 12' x 12' x 12" AND SHALL BE CONSTRUCTED FROM BACK OF CURB TO PAV. DRIVEPADS WIDER THAN 12' (PORTAL) SHALL HAVE A 1/2" x 2" x 24" AT MIDPOINT. DRIVEPADS WIDER THAN 16' SHALL HAVE 2 OF MORE 1/2" x 2" x 24" AT MIDPOINT. DRIVEPADS WIDER THAN 18' SHALL HAVE 3 OF MORE 1/2" x 2" x 24" AT MIDPOINT. DRIVEPADS WIDER THAN 20' SHALL HAVE 4 OF MORE 1/2" x 2" x 24" AT MIDPOINT. DRIVEPADS WIDER THAN 526' SHALL HAVE 257 OF MORE 1/2" x 2" x 24" AT MIDPOINT. DRIVEPADS WIDER THAN 528' SHALL HAVE 258 OF MORE

Dimensions given are to the inside of enclosure walls and are the minimum sizes required for the slab itself. Footing will vary with the design of the enclosure.

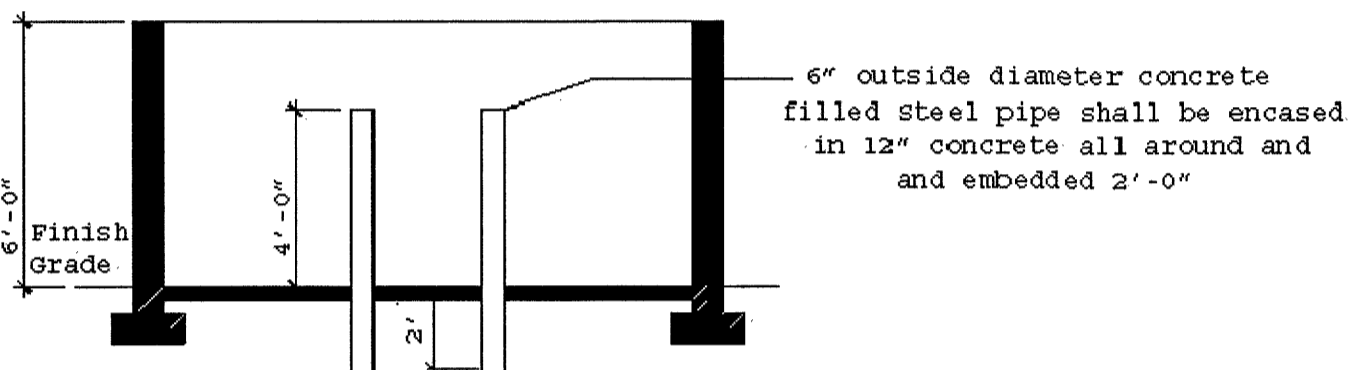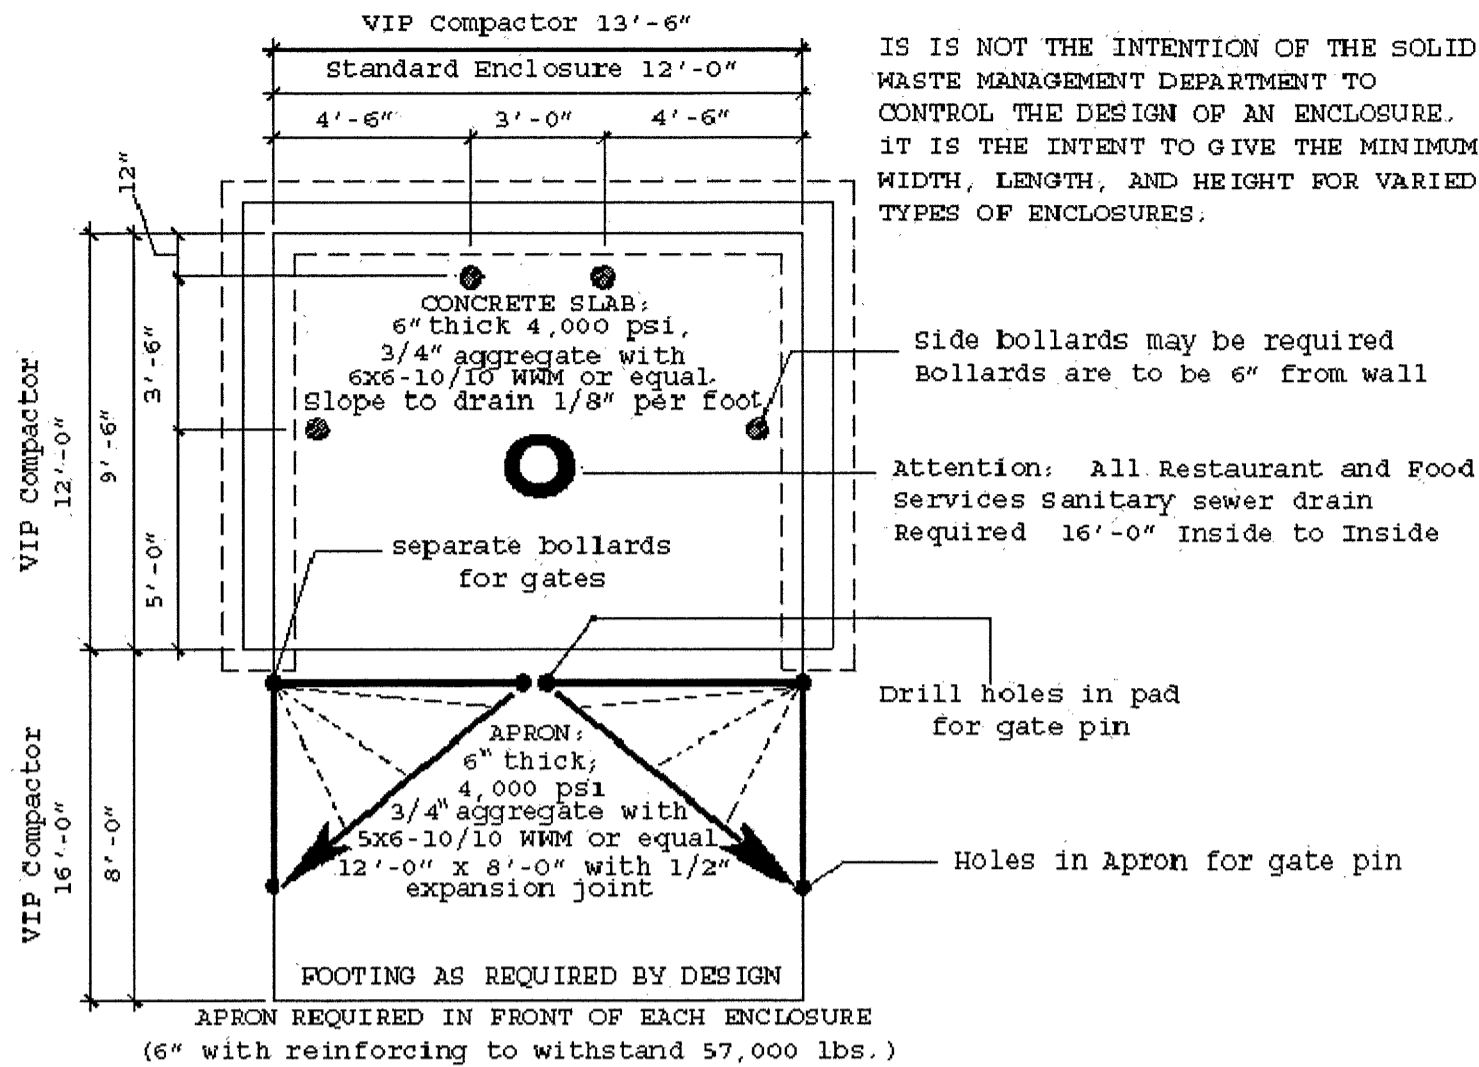


1 TRASH PAD ENCLOSURE DETAIL

C3.1 SCALE: NOT TO SCALE

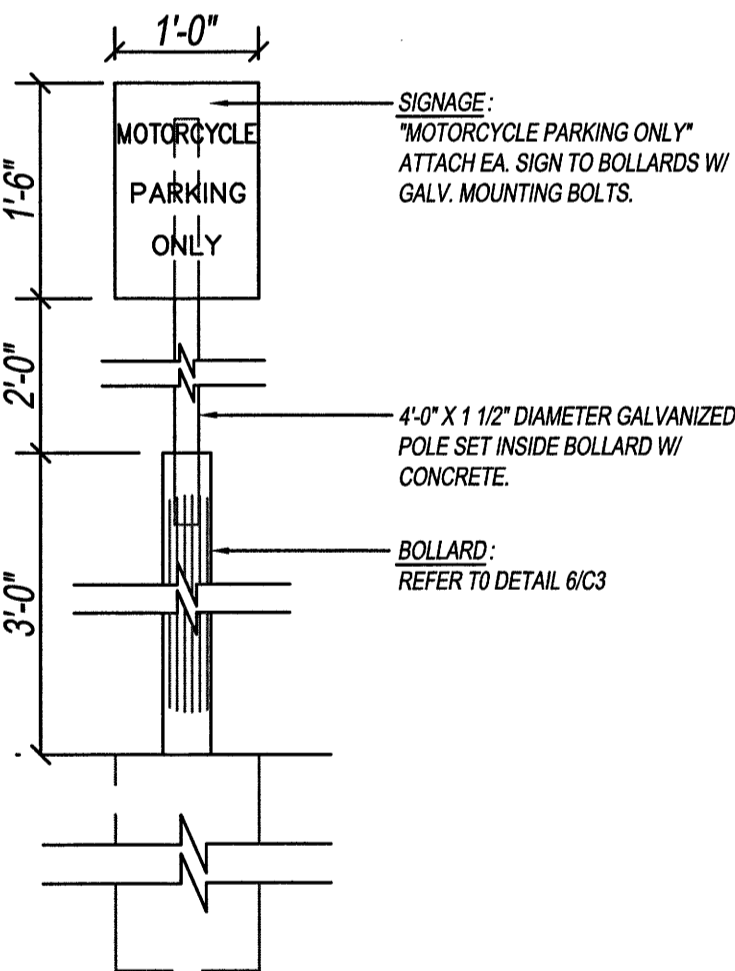

2 MOTORCYCLE PARKING SIGN

C3.1 SCALE: NOT TO SCALE

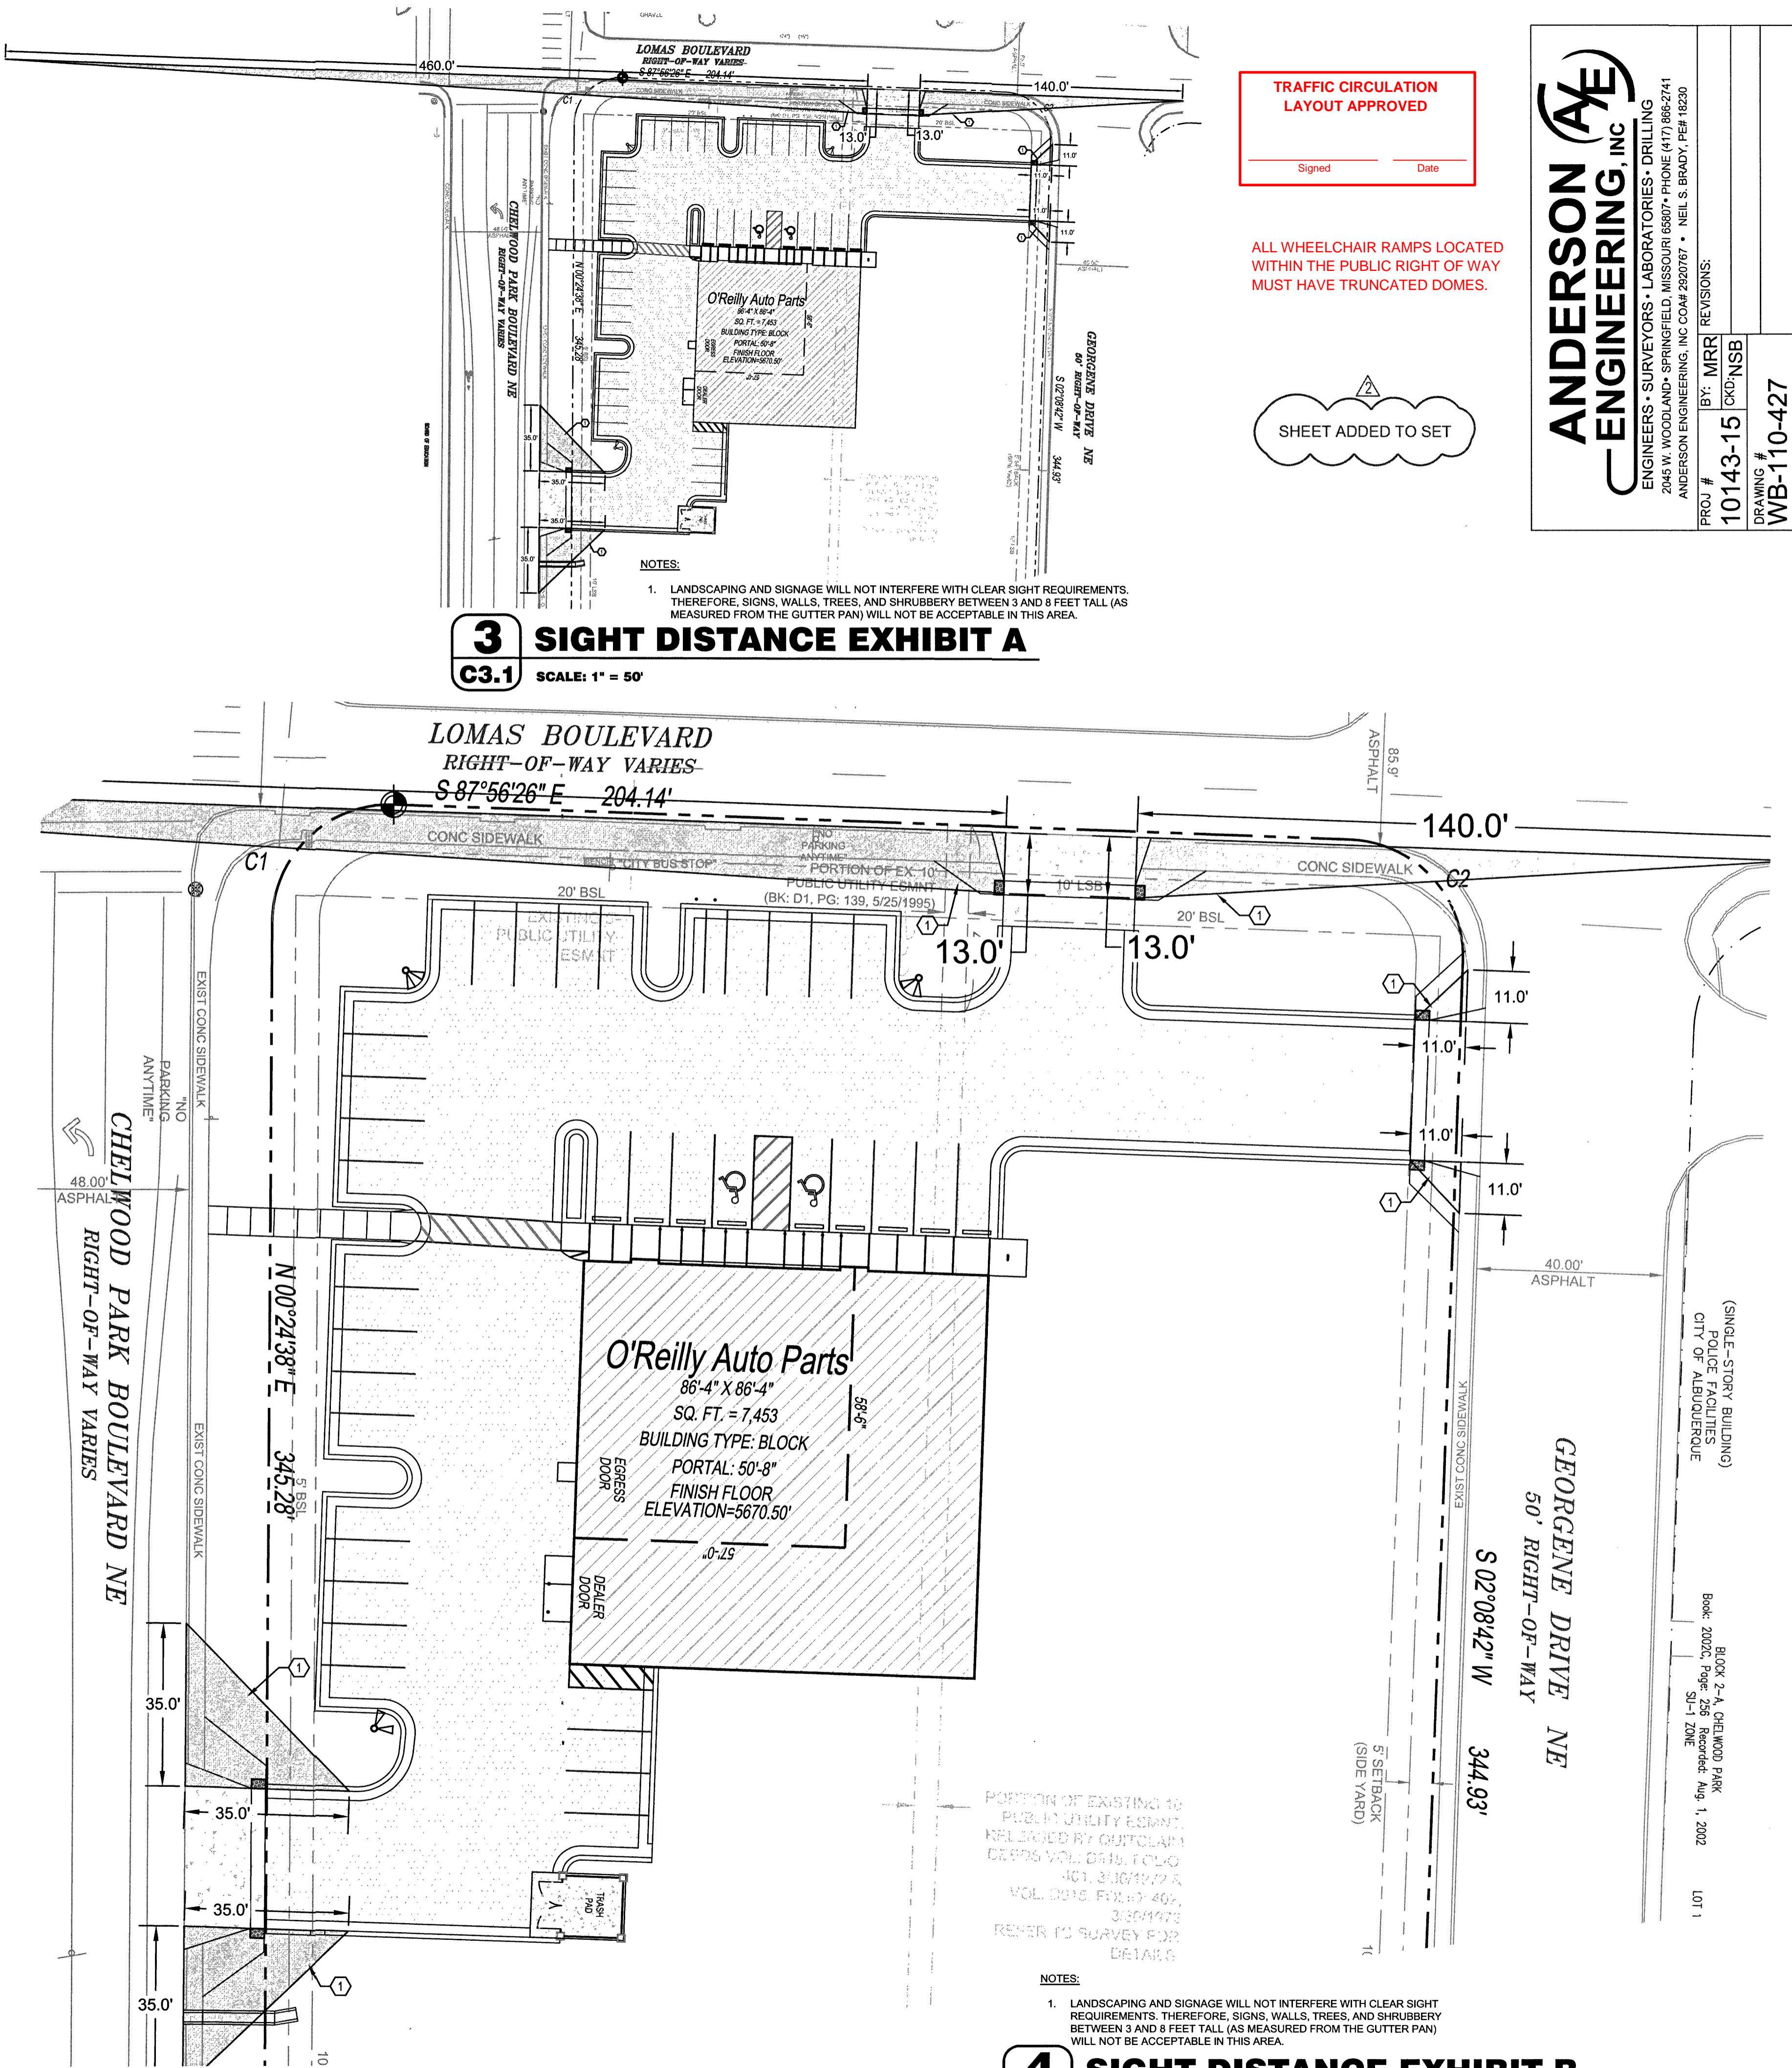


4 SIGHT DISTANCE EXHIBIT B

C3.1 SCALE: 1" = 20'

O'Reilly AUTO PARTS

PROJECT: NEW O'REILLY AUTO PARTS STORE
12700 LOMAS BLVD NE
ALBUQUERQUE, NM 87123
SITE DETAILS

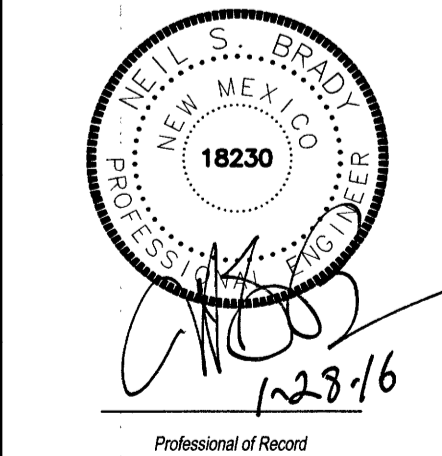


DRAWN: MRR
CHECKED: NSB
DATE: 2-1-2016
JOB NO.: 315621 (A15)
SHEET:

C3.1
SHEET 4 OF 6

PAVEMENT TYPE	PAVEMENT SECTION	
	AUTOMOBILE PARKING AREAS	TRUCK TRAFFIC AND MAIN DRIVE LANES
PORTLAND CEMENT CONCRETE (A)	5 INCHES	5-10 INCHES

PROVIDE CONTROL JOINTS AT 12' O.C. (25% SLAB THICKNESS)

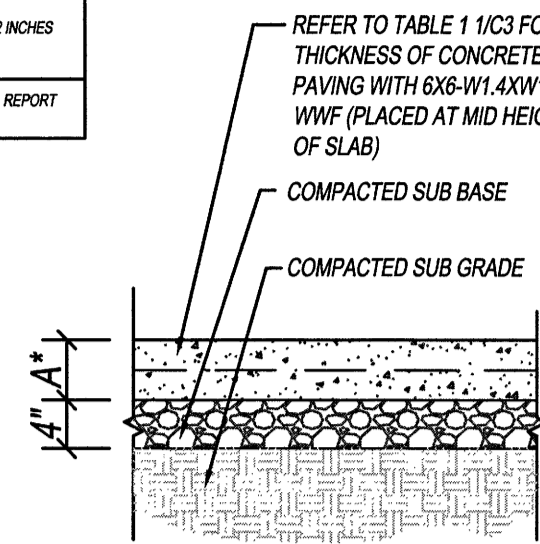


1 CONCRETE PAVING SECTION

C3 SCALE: NOT TO SCALE


PAVEMENT TYPE	PAVEMENT SECTION	
	AUTOMOBILE PARKING AREAS	TRUCK TRAFFIC AND MAIN DRIVE LANES
ASPHALT CONCRETE SURFACE (B)	2-1/2 INCHES	3-1/2 INCHES

PROVIDE CONTROL JOINTS AT 10' O.C. (25% SLAB THICKNESS)

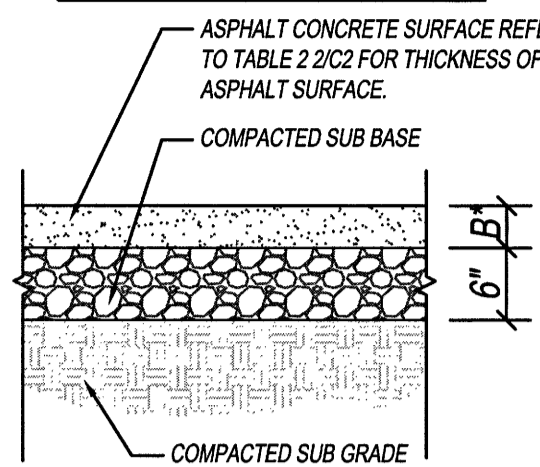

2 ASPHALT PAVING SECTION

C3 SCALE: NOT TO SCALE

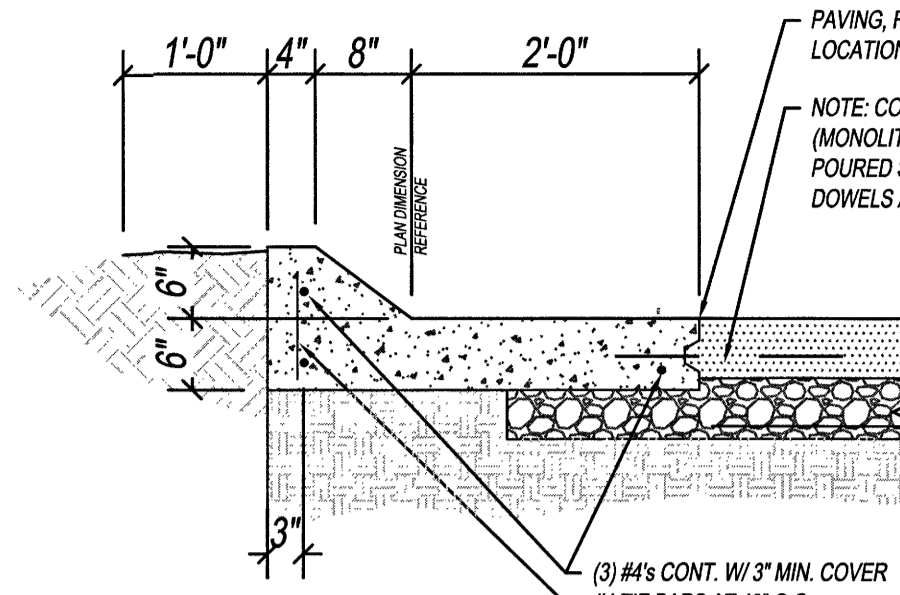

3 CONCRETE CURB SECTION


C3 SCALE: NOT TO SCALE

TRAFFIC CIRCULATION LAYOUT APPROVED

Signed _____ Date _____

ALL WHEELCHAIR RAMPS LOCATED WITHIN THE PUBLIC RIGHT OF WAY MUST HAVE TRUNCATED DOMES.

PROVIDE TOOLED CONTROL JOINTS AT 6' O.C. (25% SLAB THICKNESS) AND ISOLATION JOINTS AT 24' O.C., UNLESS OTHERWISE NOTED.

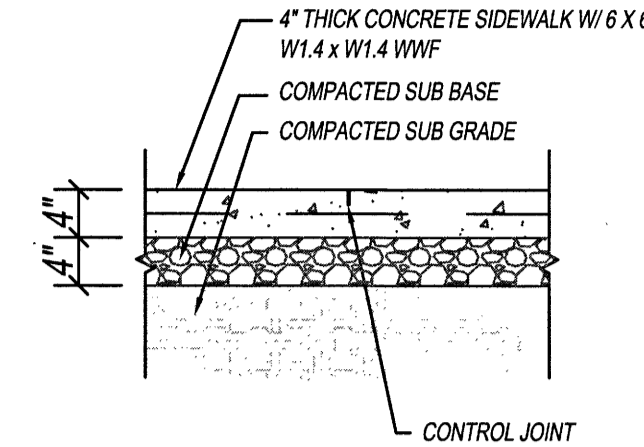


4 CONCRETE SIDEWALK SECTION

C3 SCALE: NOT TO SCALE


ANDERSON ENGINEERING, INC.
 ENGINEERS - SURVEYORS - LABORATORIES - DRILLING
 2085 N. WILSON ROAD, SPRINGFIELD, MISSOURI 65802 • PHONE: (417) 862-2741
 ANDERSON ENGINEERING, INC. CD# 2382767 • NELL S. BRADY, P.E. 18230

PROJ # 10143-15
 BY: MRR
 REVISIONS: CKN/NSB
 DRAWING # WB-110-427

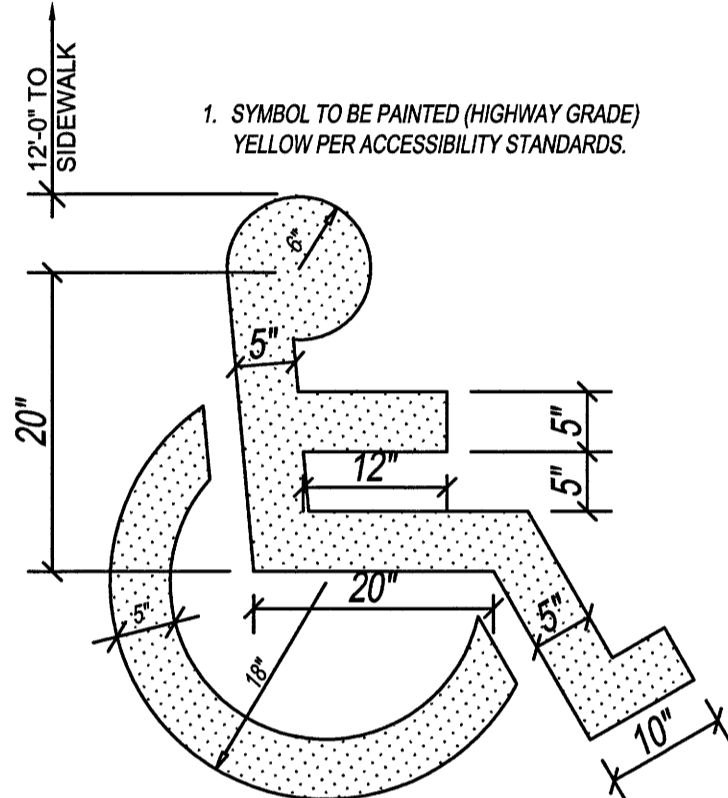


5 HANDICAP PARKING SYMBOL

C3 SCALE: NOT TO SCALE

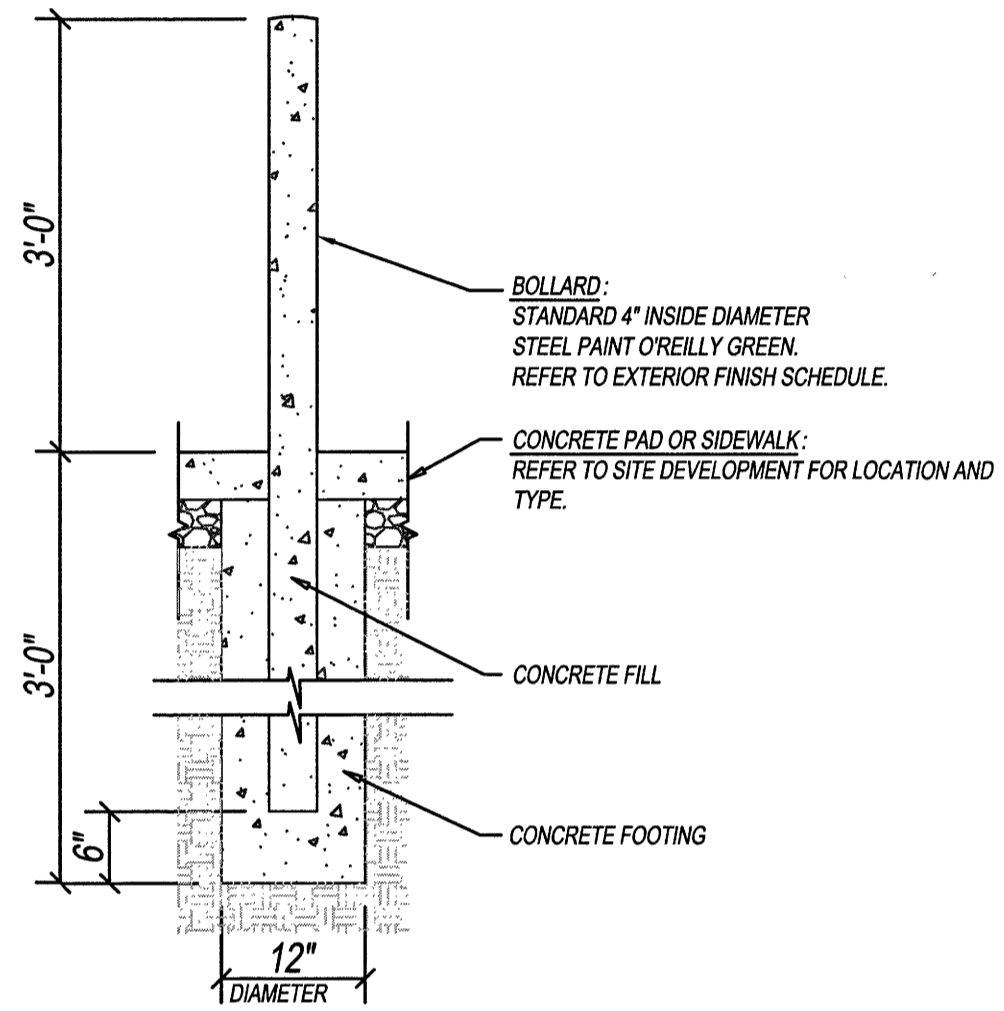


6 STEEL BOLLARD SECTION

C3 SCALE: NOT TO SCALE

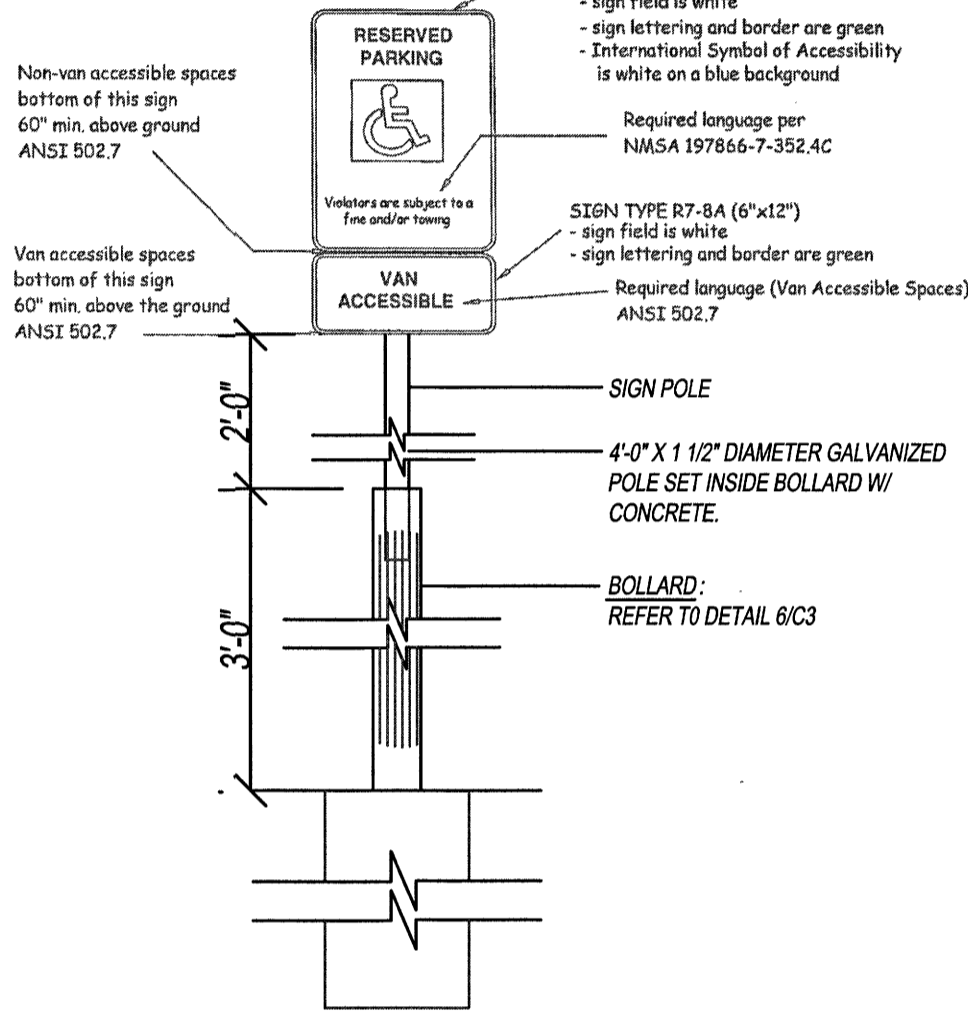

7 HANDICAP PARKING SIGN


C3 SCALE: NOT TO SCALE

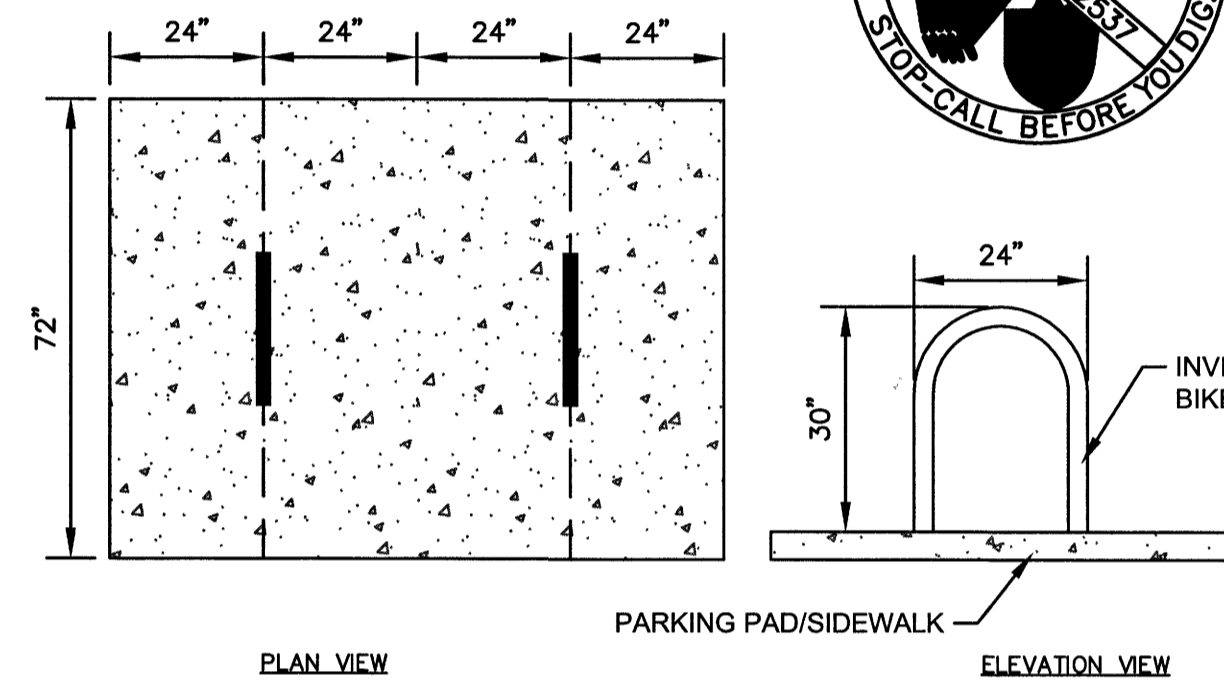

8 BICYCLE PARKING DETAIL



C3 SCALE: NOT TO SCALE

PROVIDE DETECTABLE WARNINGS WITH RAISED PATTERN (CAUTION YELLOW COLOR WITH .9" DIA. AND RAISE .02" PER ADAAG 4.7.7)

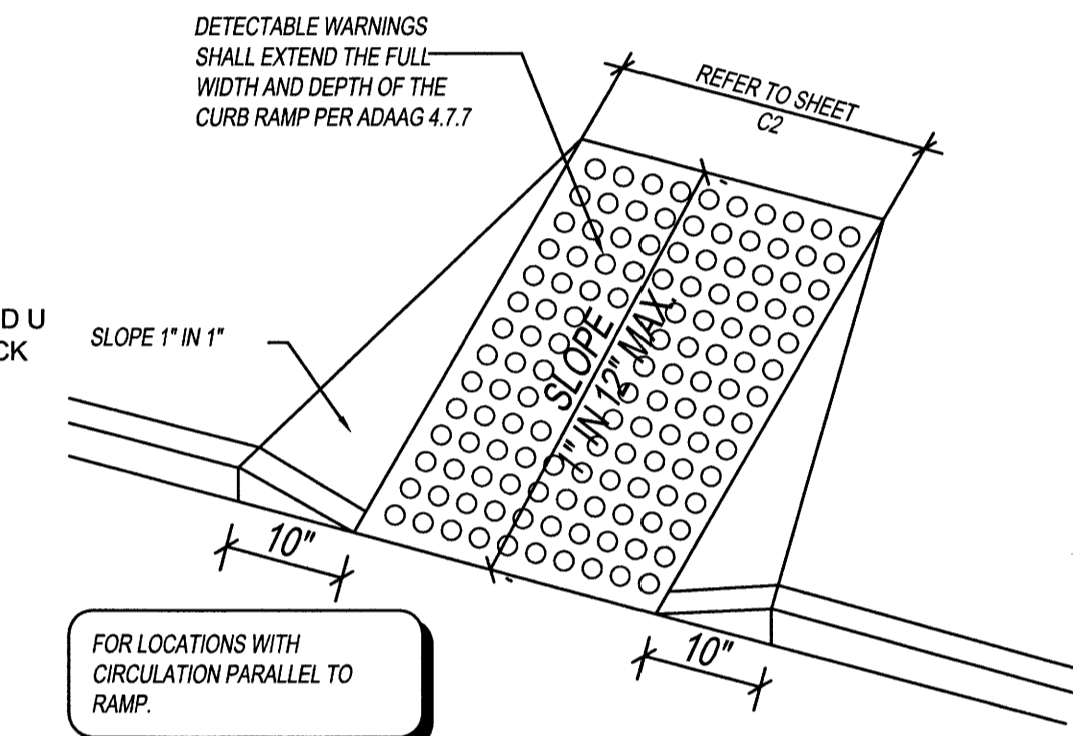

9 CONCRETE HANDICAP RAMP


C3 SCALE: NOT TO SCALE

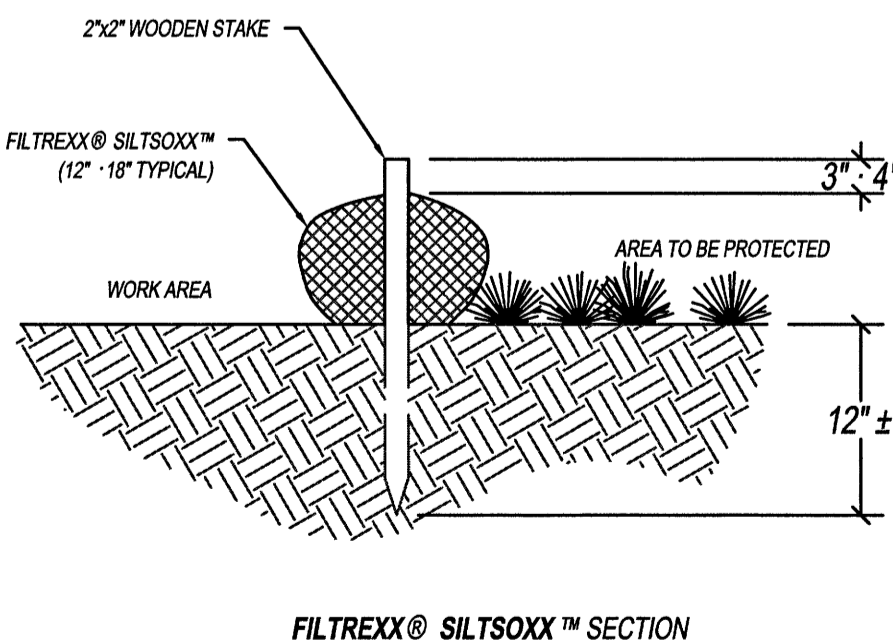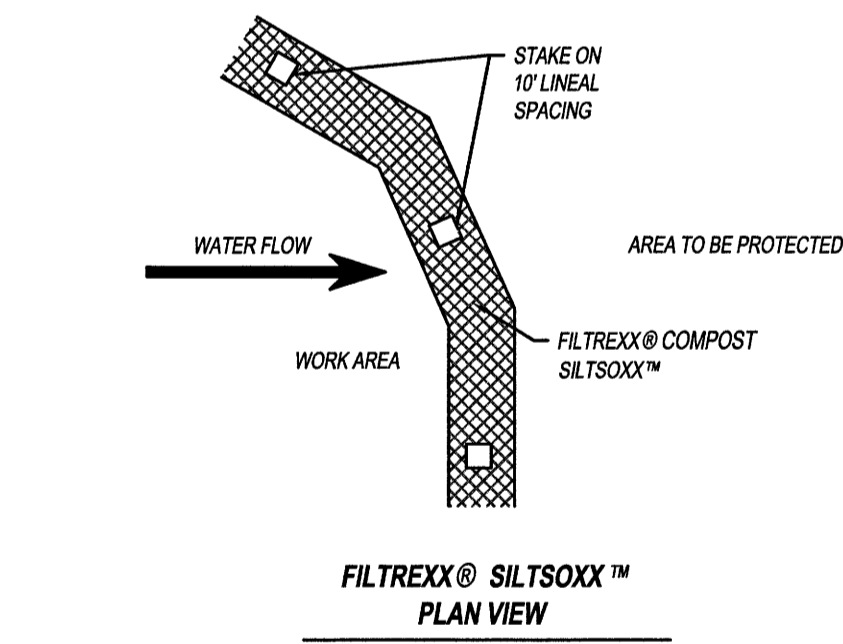

NOTE:
 1. ALL MATERIAL TO MEET FILTREXX® SPECIFICATIONS OR APPROVED EQUAL.
 2. SILTISOXX™ COMPOST/SOIL/ROCK/SEED FILL TO MEET APPLICATION REQUIREMENTS.
 3. SILTISOXX™ DEPICTED IS FOR MINIMUM SLOPES. GREATER SLOPES MAY REQUIRE LARGER SOCKS PER THE ENGINEER.
 4. COMPOST MATERIAL TO BE DISPERSED ON SITE, AS DETERMINED BY ENGINEER.


10 FILTREXX® SILTISOXX™

C3 SCALE: NOT TO SCALE

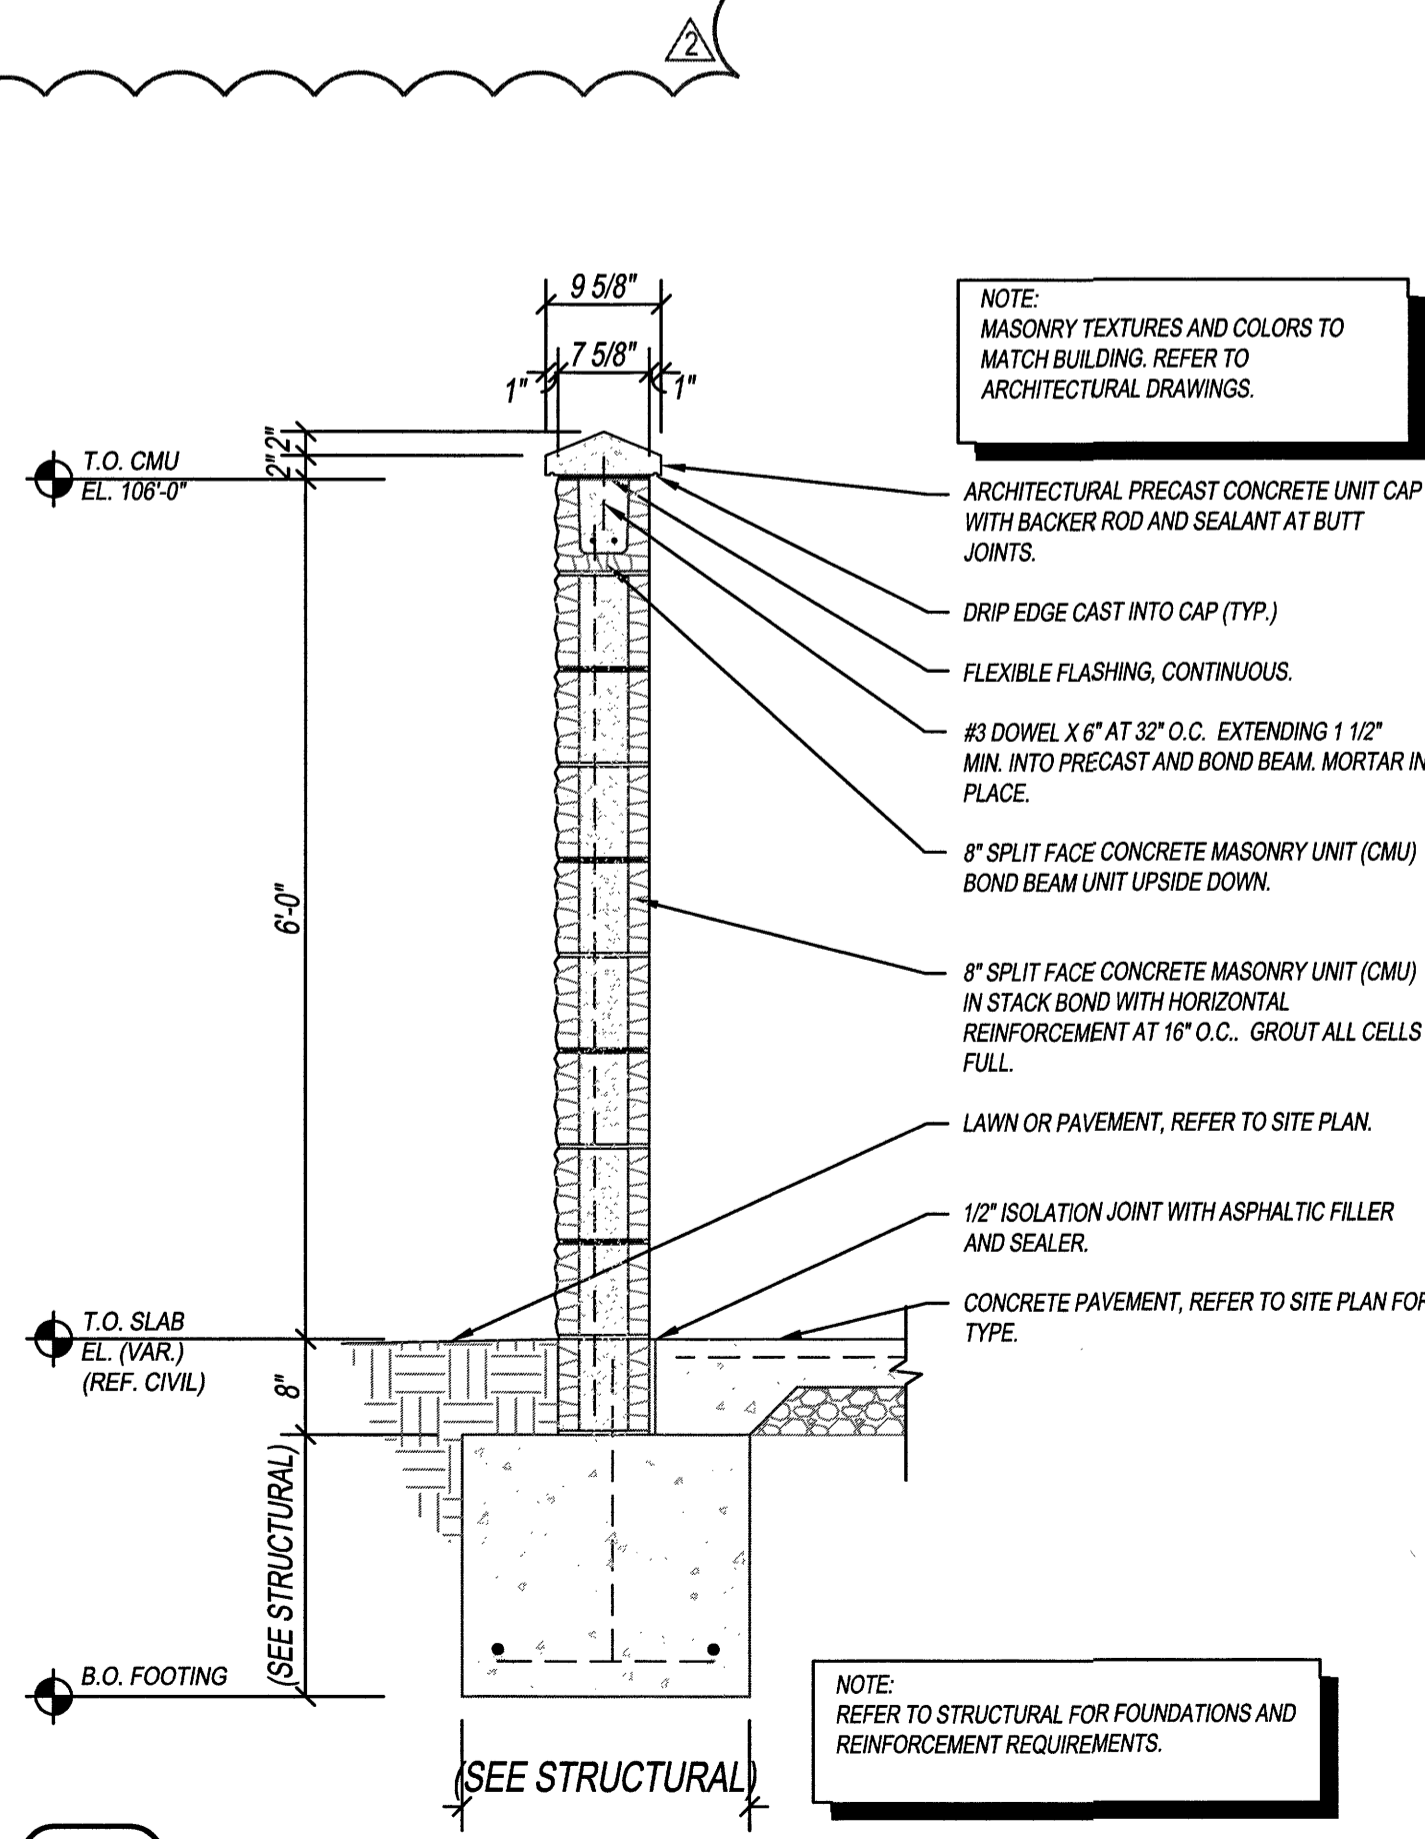

11 SCREEN FENCE

C3 SCALE: NOT TO SCALE

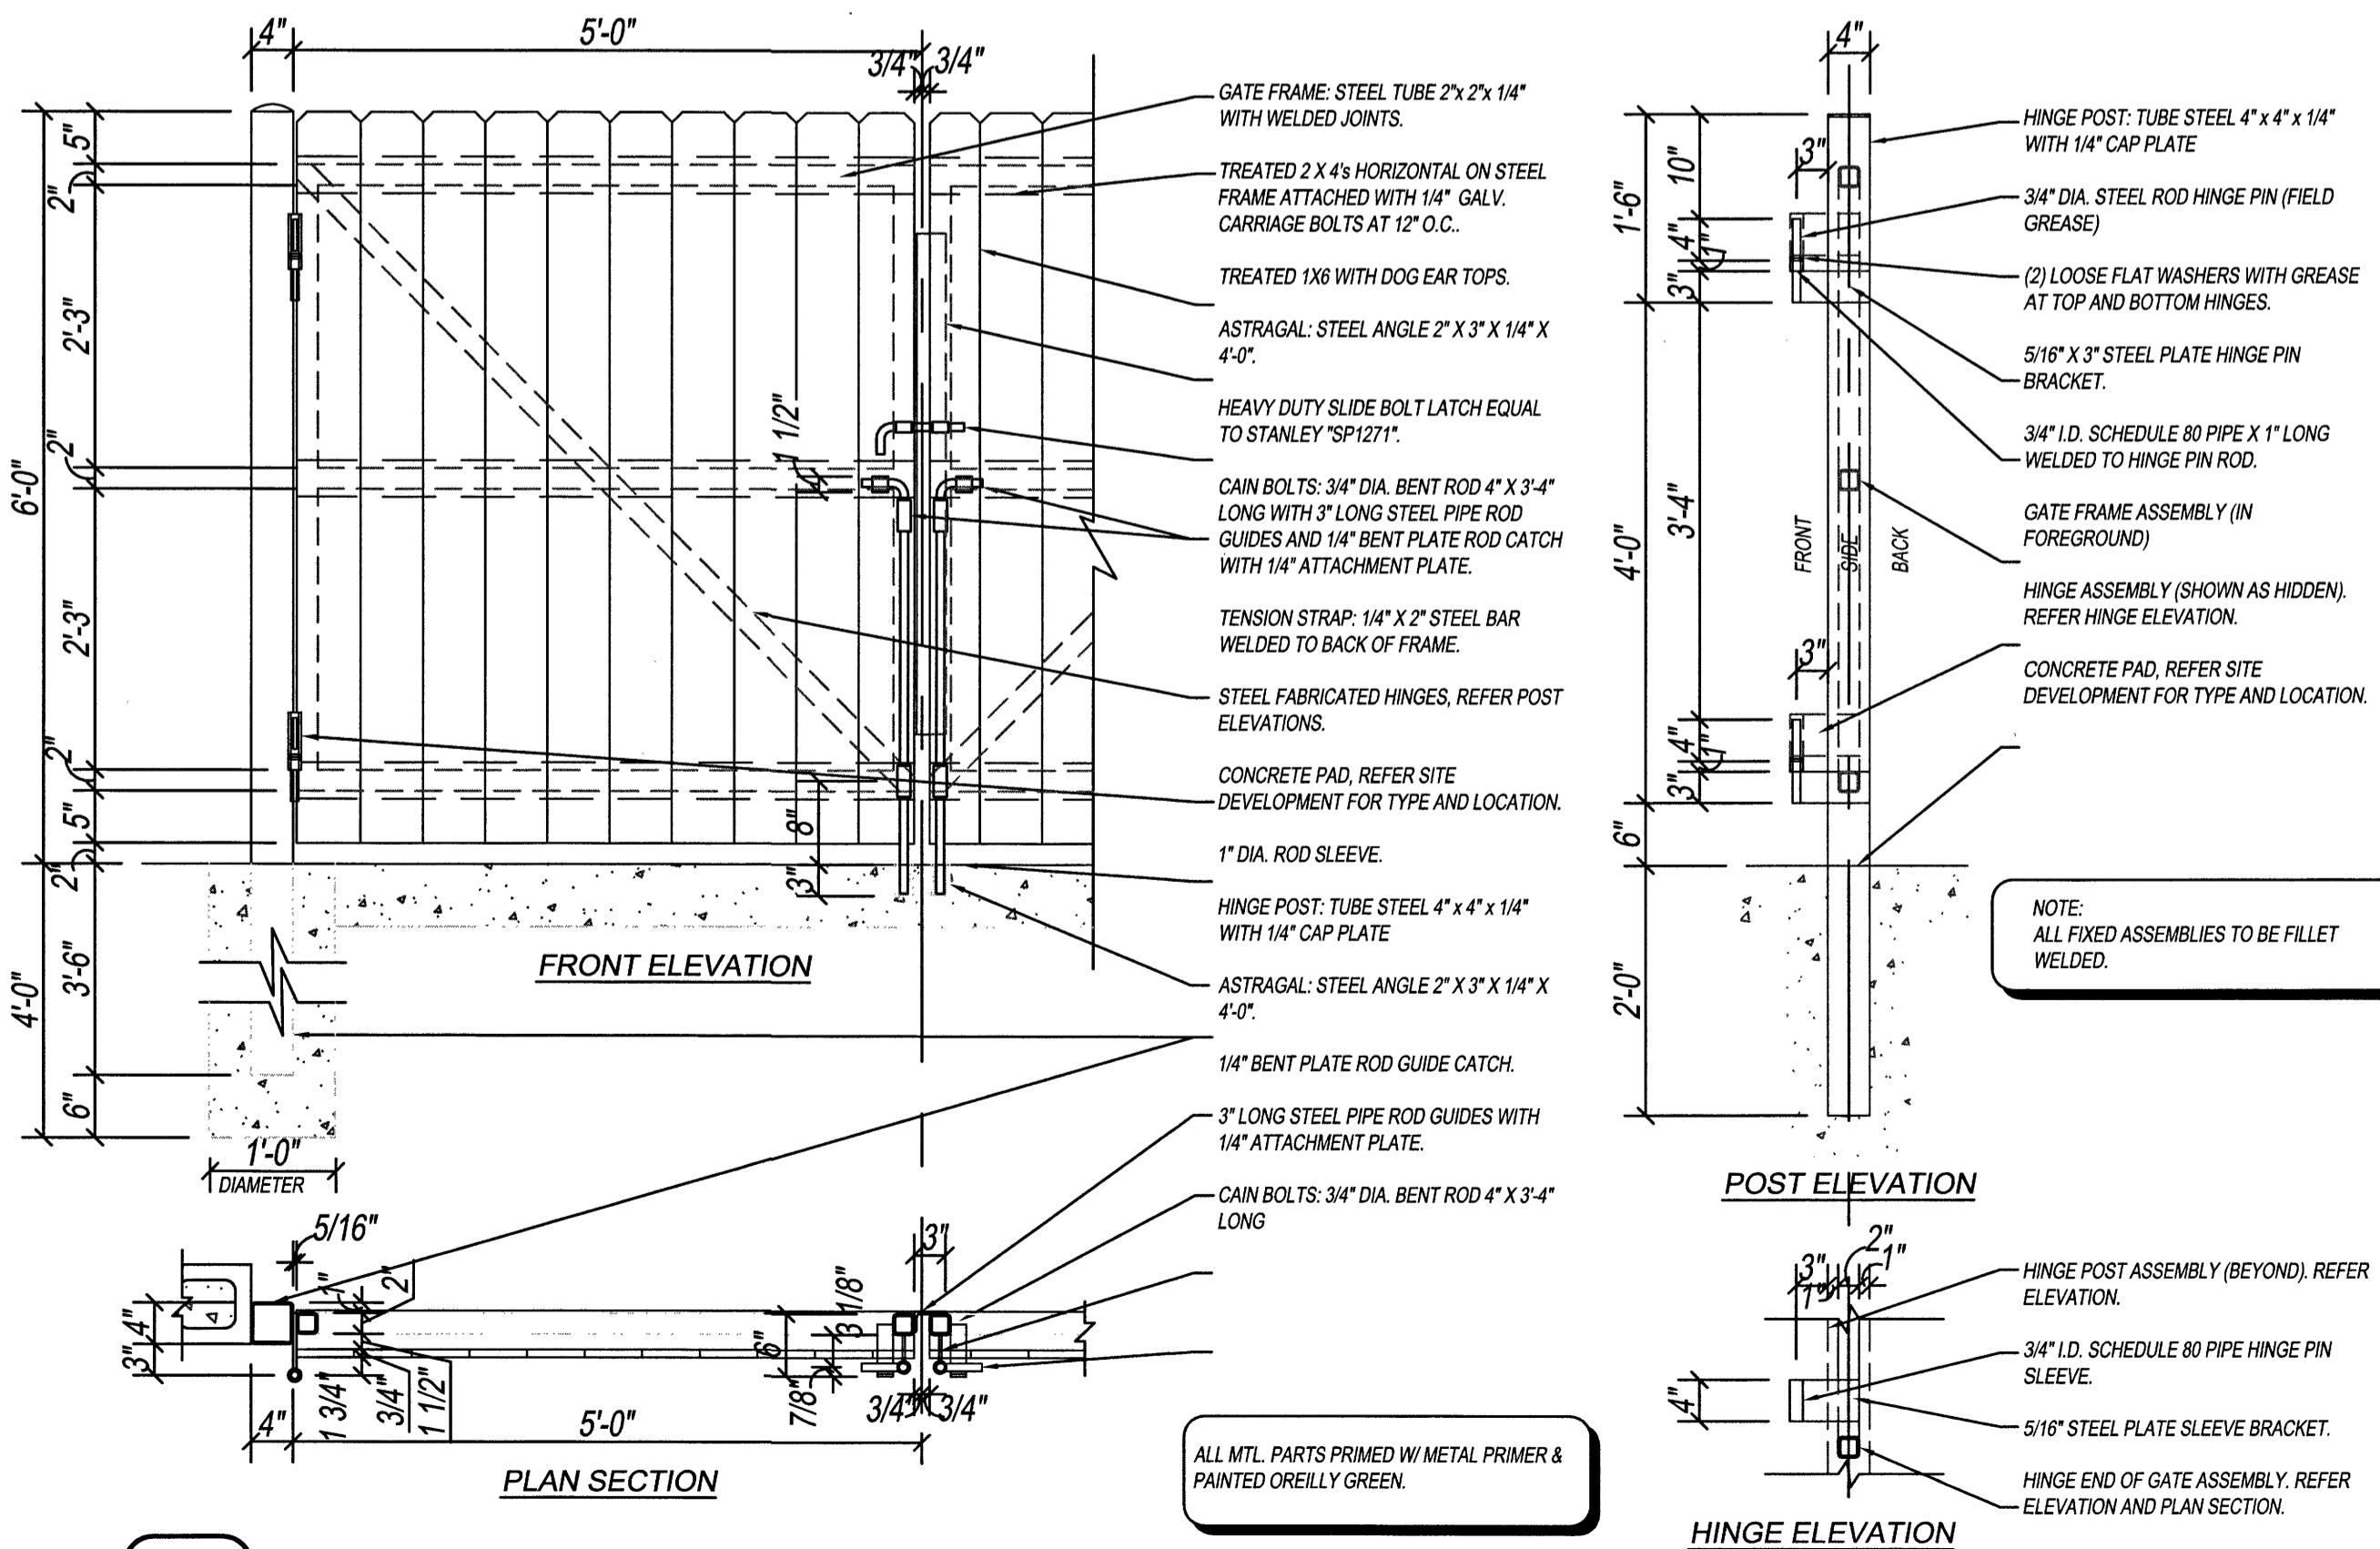

12 SCREEN FENCE GATE


C3 SCALE: NOT TO SCALE

O'Reilly AUTO PARTS

CORPORATE OFFICES
 233 SOUTH PATTERSON
 SPRINGFIELD, MISSOURI 65802
 417-862-2674 PHONE

PROJECT:
NEW O'REILLY AUTO PARTS STORE
12700 LOMAS BLVD NE
ALBUQUERQUE, NM 87123

SITE DETAILS

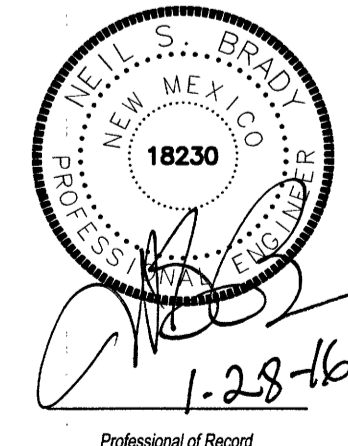

DRAWN: MRR
 CHECKED: NSB
 DATE: 10-08-2015
 JOB NO.: 315621 (A15)
 SHEET:

C3
 SHEET 3 OF 6