


LINE TABLE				
LINE	LENGTH		BEARING	
L1	361.22	(360.76)	N 18°39'55" W	(N 18°23' W)
L2	100.00	(100.00)	N 18°25'02" W	(N 18°23' W)
L3	10.00	(10.00)	N 74°51'58" E	(N 74°54' E)
L4	10.00	(10.00)	N 74°51'58" E	(N 74°54' E)

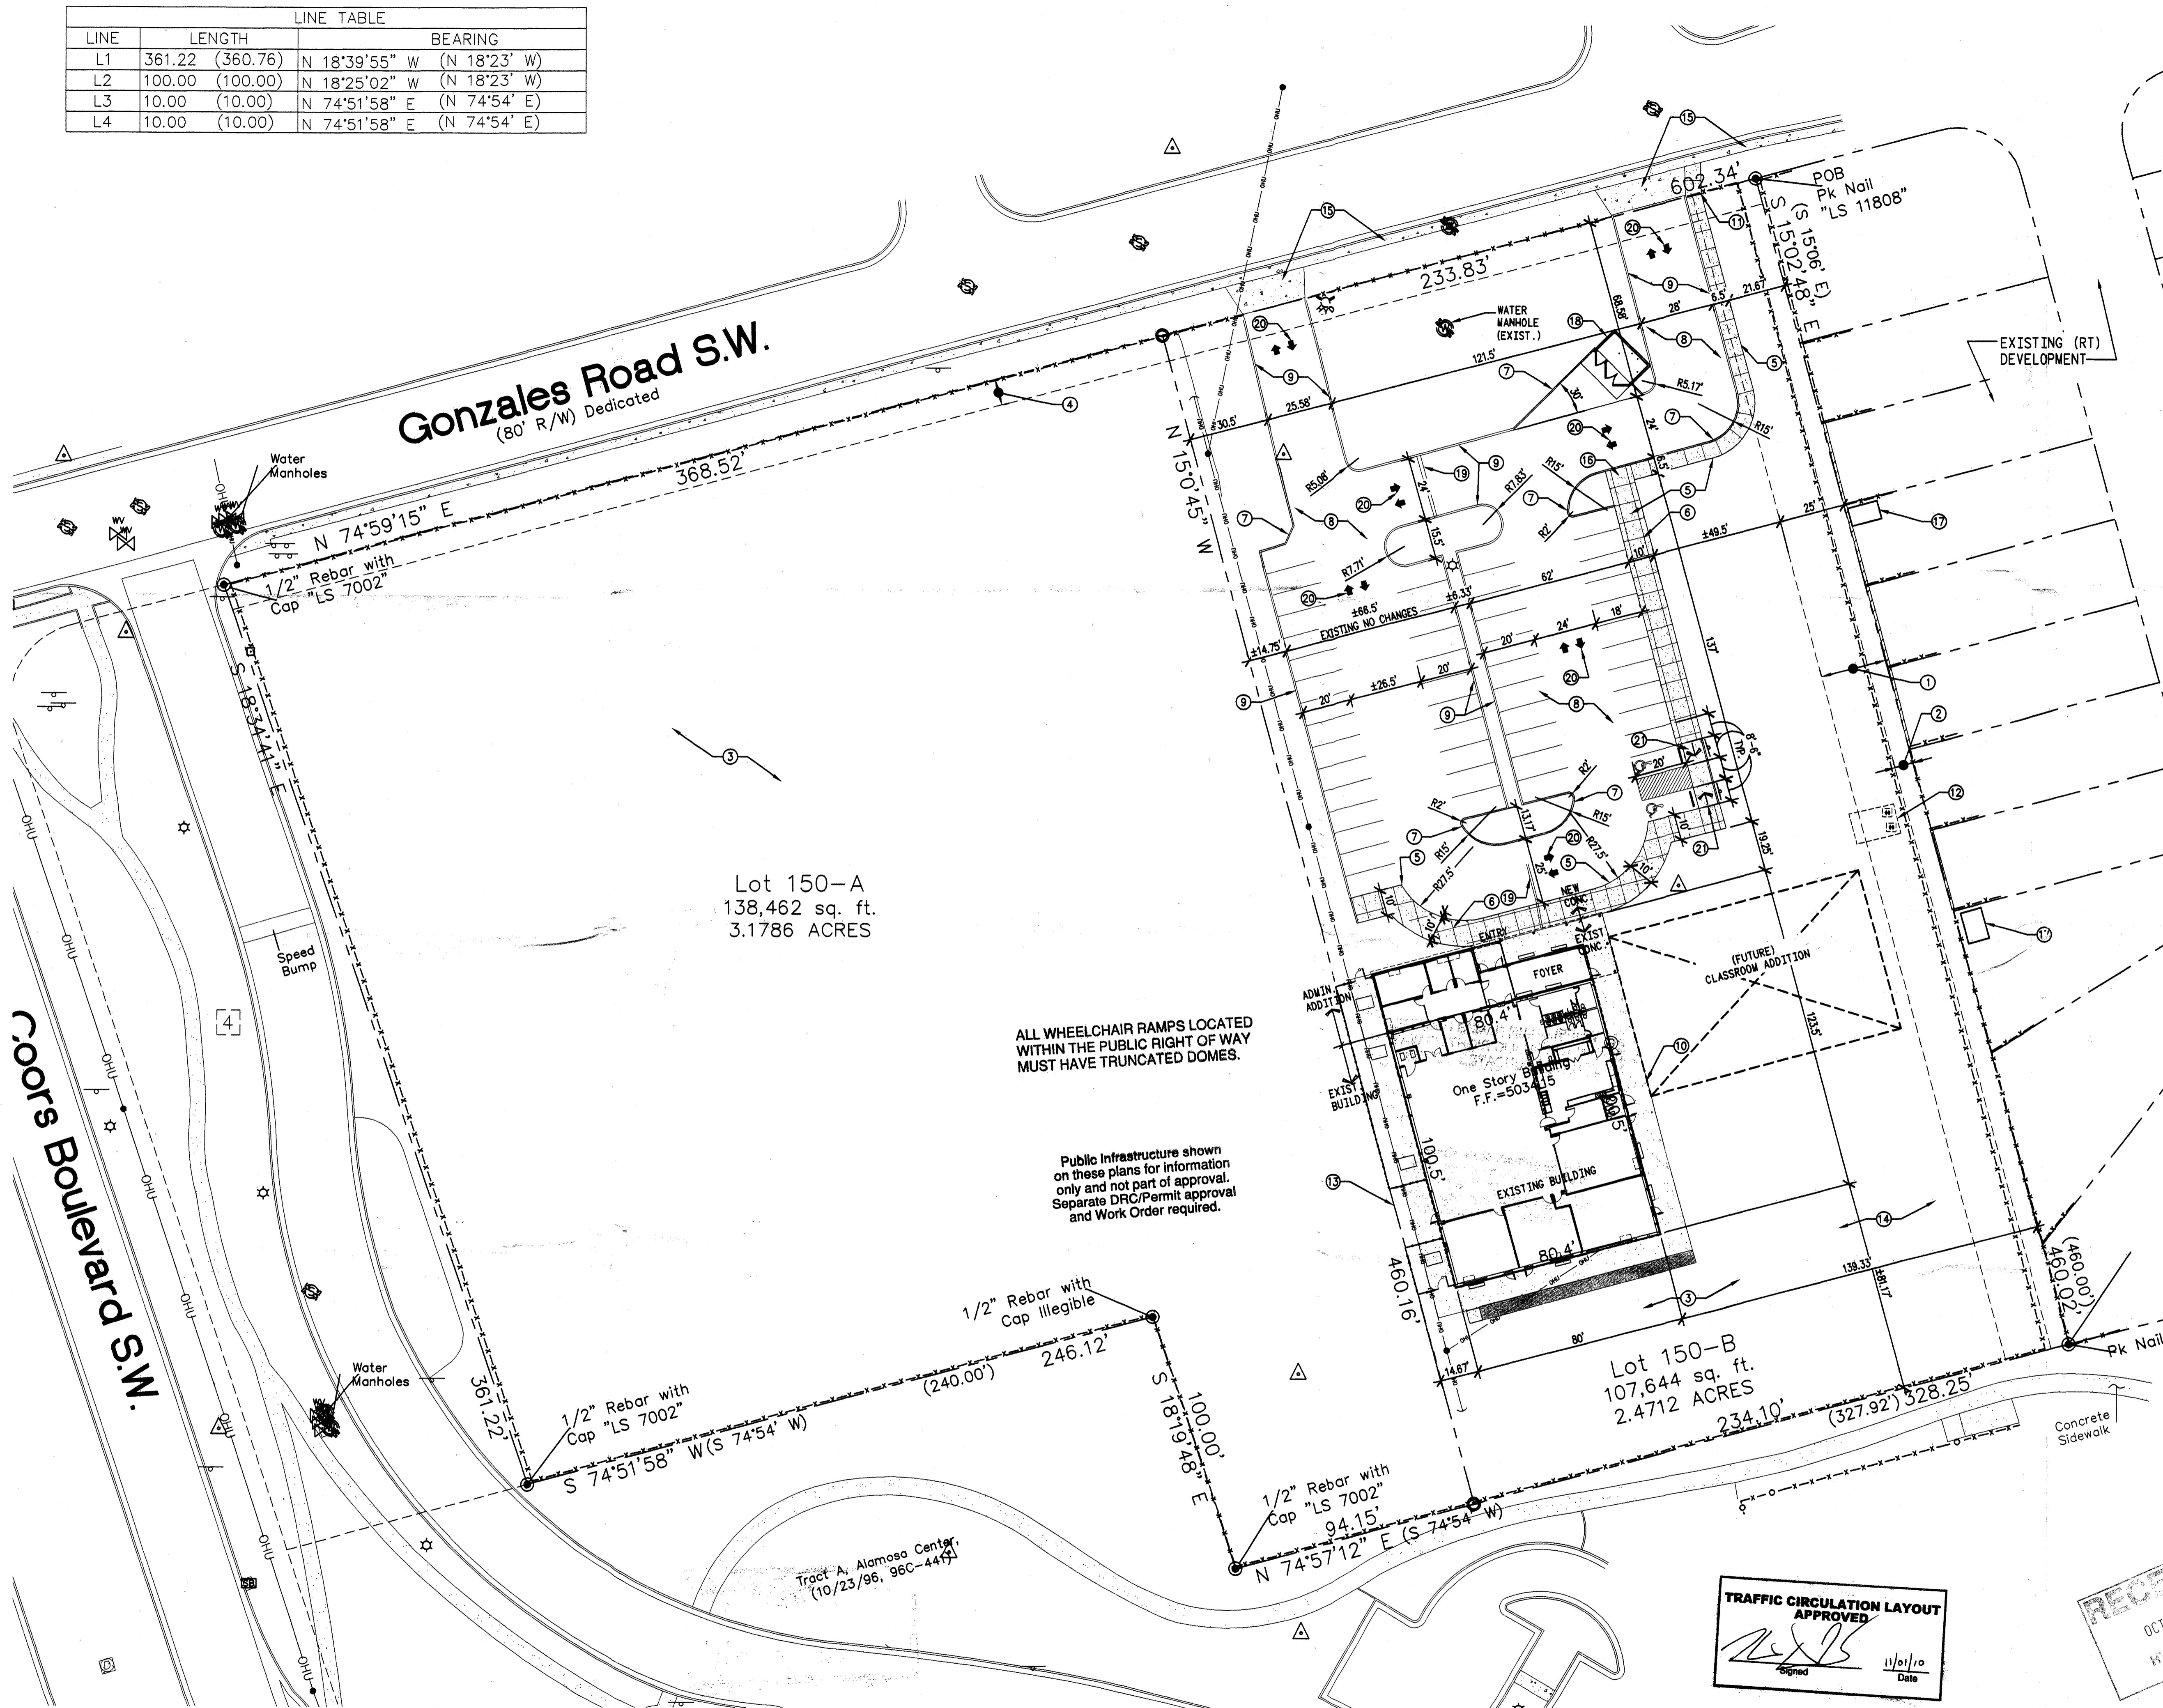

- General Notes**
- SEE SITE SURVEY FOR EXTENT OF EXISTING BUILDING, PAVING AND LANDSCAPING.
 - CONTRACTOR SHALL VISIT SITE TO FAMILIARIZE HIMSELF WITH ALL EXISTING VISIBLE CONDITIONS.
 - PROTECT ALL EXISTING PARKING LOT TREES AND CONSTRUCTION OUTSIDE OF REMOVAL ZONES.
 - WHERE REMOVAL OCCURS, MODIFY PER DRAWINGS. IF NO MODIFICATIONS ARE INDICATED ON DRAWINGS REPAIR TO MATCH EXISTING.
 - DEMO SITE ONLY AS REQUIRED FOR NEW WORK, PATCH BACK TO MATCH EXISTING OR NEW FINISH.
 - CONTRACTOR TO MAINTAIN EXISTING ASPHALT AND CONCRETE PAVING IN ITS CURRENT CONDITION, REPAIR ANY DAMAGE, AND INSTALL NEW ASPHALT OVERLAY AND STRIPING.

- Keyed Notes**
- EXISTING 25' ROAD AND UTILITY EASEMENT.
 - EXISTING 7' TEMPORARY DRAINAGE EASEMENT BENEFITING THE SUBJECT PROPERTY.
 - EXISTING DRAINAGE EASEMENT AFFECTING AND BENEFITING BOTH SUBJECT TRACTS FOR THE PURPOSES OF TRANSMITTING WATER FLOW ACROSS EACH LOT.
 - NEW 10' PUBLIC UTILITY EASEMENT.
 - NEW CONC. WALKWAY, SEE SHEET AS-3.0.
 - SAWCUT CONTROL JOINTS, SEE SHEET AS-3.0.
 - NEW CONC. CURB, SEE SHEET AS-3.0.
 - EXISTING ASPHALT WITH NEW OVERLAY.
 - EXISTING CONC. CURBS TO REMAIN.
 - FUTURE PORTAL ON EXISTING CONC. PLATFORM, N.I.C.
 - MODIFY FENCE AT PUBLIC SIDEWALK TO ALLOW FOR PEDESTRIAN ENTRY.
 - DEMO EXIST. CONC. PAD REUSE EXISTING STEEL BOLLARDS.
 - NEW PROPERTY LINE, SEE CIVIL.
 - MODIFY EXISTING PAVING AREA FOR PROPOSED PLAYGROUND, SEE CIVIL.
 - EXISTING CONC. DRIVEPADS AND SIDEWALKS.
 - DROP OFF AREA.
 - EXISTING WOOD SHED.
 - TRASH ENCLOSURE, SEE SHEET AS-3.0.
 - EXISTING TRENCH.
 - TRAFFIC DIRECTIONAL ARROWS PAINTED ON ASPHALT.
 - ACCESSIBLE RAMP. MAX SLOPE 1:12.

CODE DATA:

PROJECT DESCRIPTION:
ADDITION TO AND REMODELING OF EXISTING METAL BUILDING INCLUDING NEW WALLS, WINDOWS, DOORS, FINISHES, PLUMBING, MECHANICAL AND ELECTRICAL. CHANGE OF USE FROM CHURCH TO A SCHOOL.

BUILDING CODE ANALYSIS - LA PROMESA CHARTER SCHOOL

INTERNATIONAL BUILDING CODE - 2006
INTERNATIONAL EXISTING BUILDING CODE - 2006
INTERNATIONAL MECHANICAL CODE - 2006
INTERNATIONAL PLUMBING CODE - 2006
INTERNATIONAL PROPERTY MAINTENANCE CODE - 2006
NATIONAL ELECTRICAL CODE - 2005
INTERNATIONAL FIRE CODE - 2006
ICC/ANSI A117.1, ACCESSIBLE & USABLE BUILDINGS & FACILITIES - 2003

PROJECT INFORMATION:
OWNER: Y.E.S. HOUSING
ADDRESS: 6900 GONZALES ROAD SW.
ALBUQUERQUE, NM 87121

LEGAL DESCRIPTION: LOT 150-B, TOWN OF ATRISCO GRANT UNIT 6, CITY OF ALBUQUERQUE, BERNALILLO COUNTY, NEW MEXICO

ZONING:
R-T - TOWER-UNSER SECTOR DEVELOPMENT PLAN (08EPC - 40025, AMENDMENT)

CONSTRUCTION TYPE:
EXISTING: V-B, SPRINKLERED
ADDITION: V-B, SPRINKLERED

OCCUPANCY TYPE:
E (EDUCATIONAL)

LOT SIZE: 107,644 SQ. FT. (2.47 ACRES)

SETBACKS: PER SECTOR DEVELOPMENT PLAN (R-T):
15' FRONT SETBACK @ GONZALES ROAD (±255' PROVIDED)
5' SIDE SETBACK @ WEST PROPERTY LINE (14'-9" PROVIDED)
5' SIDE SETBACK @ EAST PROPERTY LINE (139'-2" PROVIDED)
15' REAR SETBACK @ SOUTH PROPERTY LINE (81'-1" PROVIDED)

PARKING: REQUIRED (1 PER EMPLOYEE) = 15 SPACES.
PROVIDED - 51 SPACES.

MAIN BUILDING:
HEIGHT - 16.17 FEET

EXISTING FLOOR : 8,008 SQ. FT.
NEW ADDITION : 1,431 SQ. FT.
EXISTING COVERED ENTRY: 115 SQ. FT.
COVERED WALKWAY (ALT): 2,458 SQ. FT.
TOTAL: 12,012 SQ. FT.

PER IBC TABLE 503: ALLOWABLE FLOOR AREA IS 9,500 S.F. + 300% FOR SPRINKLERS = 28,500 S.F.

OCCUPANT LOADS:
CLASSROOM OCCUPANTS: 126
OFFICE OCCUPANTS: 30
KITCHEN OCCUPANTS: 3
TOTAL OCCUPANTS: 159


CAFETERA & ASSEMBLY OCCUPANTS: 208

(ASSEMBLY AND OTHER OCCUPANT LOADS DO NOT OCCUR SIMULTANEOUSLY
ASSEMBLY OCCUPANT LOAD IS USED FOR PLUMBING CALCULATIONS)

PLUMBING FIXTURES: 104 OCC MALE & 104 OCC FEMALE

PER TABLE 2902.1: PER GENDER WATER CLOSET PER GENDER LAVATORIES DRINKING SERVICE FOUNTAINS (SINK)

REQUIRED: 3 3 3 3
PROVIDED: 4 3 3 3

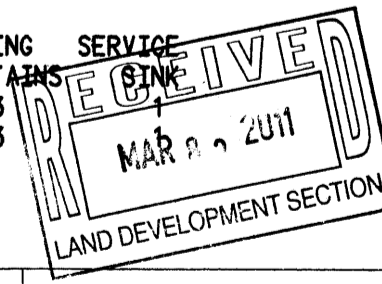

TRAFFIC CIRCULATION LAYOUT APPROVED

[Signature] 11/21/10
Signed Date

RECEIVED
OCT 26 2010
HYDROLOGY SECTION

906 1/2 Park Avenue SW
Albuquerque, NM 87102
505.243.3499
505.243.3583
info@integrateddesignarch.com
www.integrateddesignarch.com

La Promesa Charter School
Albuquerque, New Mexico

PROJECT ARCHITECT: ISAAC BENTON, AIA


Project #:
Date: SEPTEMBER 2, 2010

TRAFFIC CIRCULATION LAYOUT

By: JAM
File: (TCL-1.0) TCL.dwg
Plot Date: 10/22/2010 3:41 PM

Sheet of
TCL-1.0

LINE TABLE			
LINE	LENGTH	BEARING	
L1	361.22 (360.76)	N 18°39'55" W (N 18°23' W)	
L2	100.00 (100.00)	N 18°25'02" W (N 18°23' W)	
L3	10.00 (10.00)	N 74°51'58" E (N 74°54' E)	
L4	10.00 (10.00)	N 74°51'58" E (N 74°54' E)	

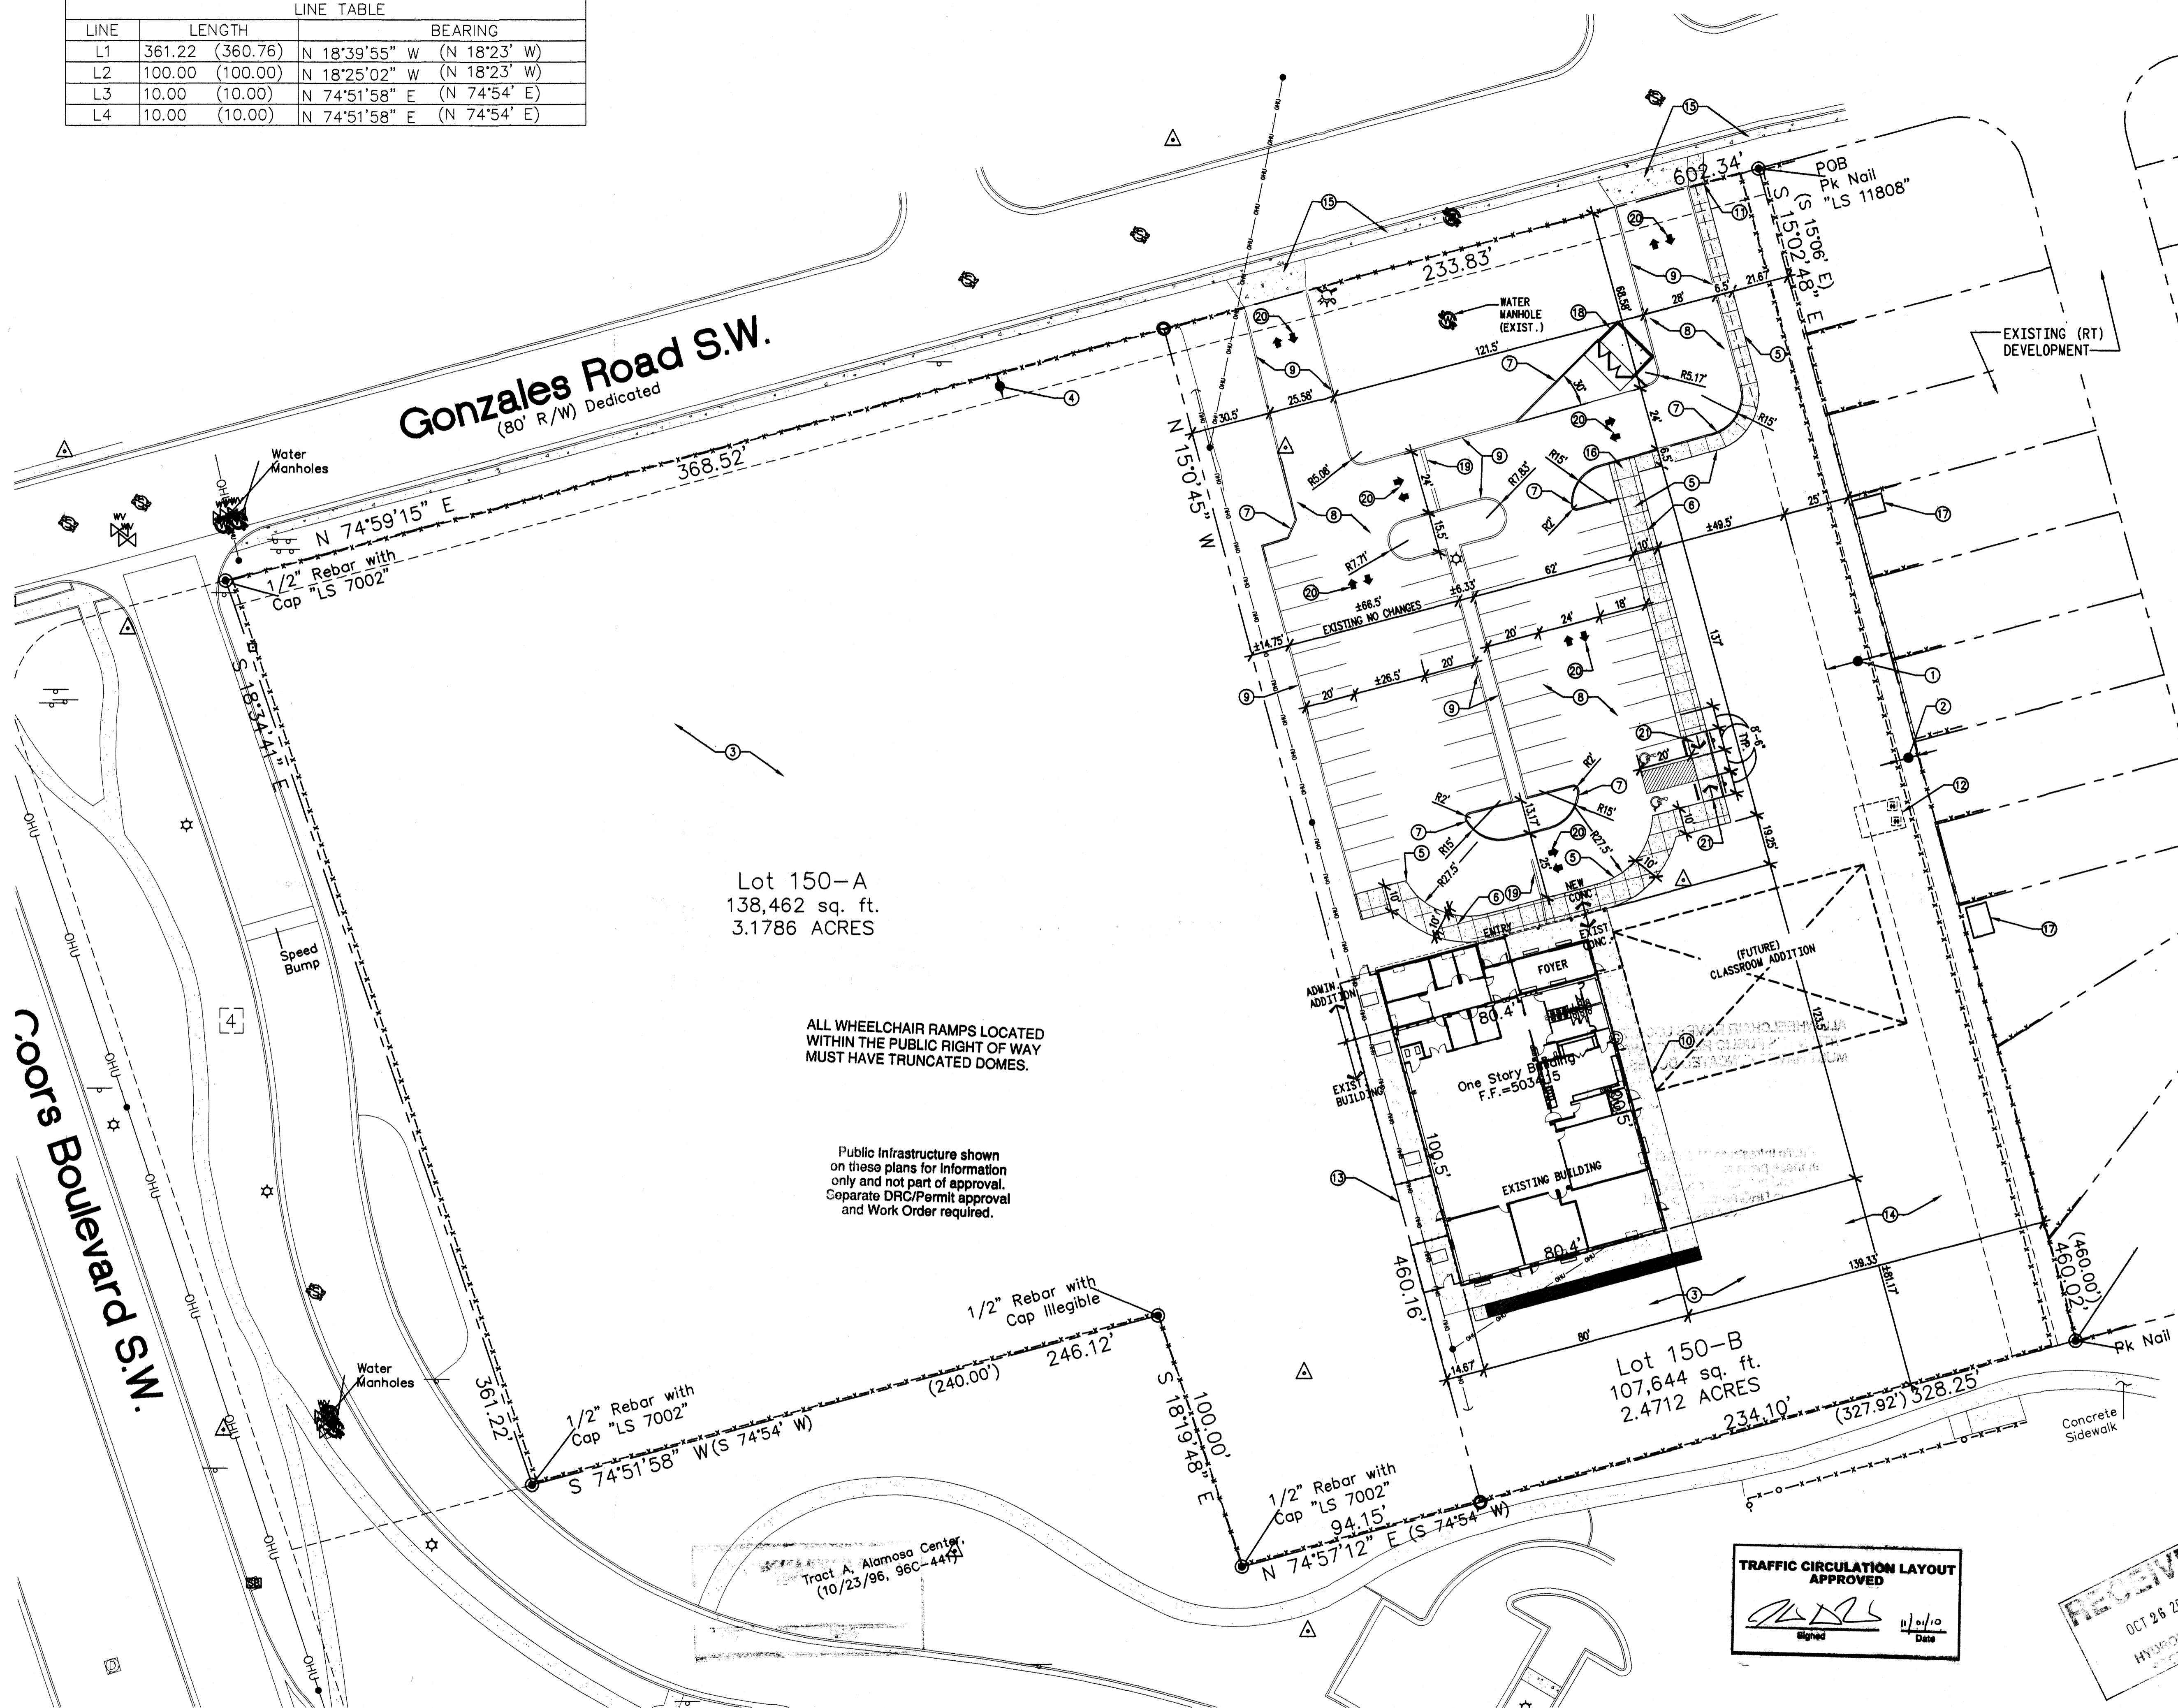

General Notes

- SEE SITE SURVEY FOR EXTENT OF EXISTING BUILDING, PAVING AND LANDSCAPING.
- CONTRACTOR SHALL VISIT SITE TO FAMILIARIZE HIMSELF WITH ALL EXISTING VISIBLE CONDITIONS.
- PROTECT ALL EXISTING PARKING LOT TREES AND CONSTRUCTION OUTSIDE OF REMOVAL ZONES.
- WHERE REMOVAL OCCURS, MODIFY PER DRAWINGS. IF NO MODIFICATIONS ARE INDICATED ON DRAWINGS REPAIR TO MATCH EXISTING.
- DEMO SITE ONLY AS REQUIRED FOR NEW WORK, PATCH BACK TO MATCH EXISTING OR NEW FINISH.
- CONTRACTOR TO MAINTAIN EXISTING ASPHALT AND CONCRETE PAVING IN ITS CURRENT CONDITION. REPAIR ANY DAMAGE, AND INSTALL NEW ASPHALT OVERLAY AND STRIPING.

Keyed Notes

- EXISTING 25' ROAD AND UTILITY EASEMENT.
- EXISTING 7' TEMPORARY DRAINAGE EASEMENT BENEFITING THE SUBJECT PROPERTY.
- EXISTING DRAINAGE EASEMENT AFFECTING AND BENEFITING BOTH SUBJECT TRACTS FOR THE PURPOSES OF TRANSMITTING WATER FLOW ACROSS EACH LOT.
- NEW 10' PUBLIC UTILITY EASEMENT.
- NEW CONC. WALKWAY, SEE SHEET AS-3.0.
- SAWCUT CONTROL JOINTS, SEE SHEET AS-3.0.
- NEW CONC. CURB, SEE SHEET AS-3.0.
- EXISTING ASPHALT WITH NEW OVERLAY.
- EXISTING CONC. CURBS TO REMAIN.
- FUTURE PORTAL ON EXISTING CONC. PLATFORM, N.I.C.
- MODIFY FENCE AT PUBLIC SIDEWALK TO ALLOW FOR PEDESTRIAN ENTRY.
- DEMO EXIST. CONC. PAD REUSE EXISTING STEEL BOLLARDS.
- NEW PROPERTY LINE, SEE CIVIL.
- MODIFY EXISTING PONDING AREA FOR PROPOSED PLAYGROUND, SEE CIVIL.
- EXISTING CONC. DRIVEPADS AND SIDEWALKS.
- DROP OFF AREA.
- EXISTING WOOD SHED.
- TRASH ENCLOSURE, SEE SHEET AS-3.0.
- EXISTING TRENCH.
- TRAFFIC DIRECTIONAL ARROWS PAINTED ON ASPHALT.
- ACCESSIBLE RAMP. MAX SLOPE 1:12.

CODE DATA:

PROJECT DESCRIPTION:
ADDITION TO AND REMODELING OF EXISTING METAL BUILDING INCLUDING NEW WALLS, WINDOWS, DOORS, FINISHES, PLUMBING, MECHANICAL AND ELECTRICAL. CHANGE OF USE FROM CHURCH TO A SCHOOL.

BUILDING CODE ANALYSIS - LA PROMESA CHARTER SCHOOL

INTERNATIONAL BUILDING CODE - 2006
INTERNATIONAL EXISTING BUILDING CODE - 2006
INTERNATIONAL MECHANICAL CODE - 2006
INTERNATIONAL PLUMBING CODE - 2006
INTERNATIONAL PROPERTY MAINTENANCE CODE - 2006
NATIONAL ELECTRICAL CODE - 2005
INTERNATIONAL FIRE CODE - 2006
ICC/ANSI A117.1, ACCESSIBLE & USABLE BUILDINGS & FACILITIES - 2003

PROJECT INFORMATION:

OWNER: Y.E.S. HOUSING
ADDRESS: 6900 GONZALES ROAD SW.
ALBUQUERQUE, NM 87121

LEGAL DESCRIPTION: LOT 150-B, TOWN OF ATRISCO GRANT UNIT 6, CITY OF ALBUQUERQUE, BERNALILLO COUNTY, NEW MEXICO

ZONING:

R-T - TOWER-UNSER SECTOR DEVELOPMENT PLAN (OBEP - 40025, AMENDMENT)

CONSTRUCTION TYPE:

EXISTING: V-B, SPRINKLERED
ADDITION: V-B, SPRINKLERED

OCCUPANCY TYPE:

E (EDUCATIONAL)

LOT SIZE: 107,644 SQ. FT. (2.47 ACRES)

SETBACKS: PER SECTOR DEVELOPMENT PLAN (R-T):
15' FRONT SETBACK @ GONZALES ROAD (±255' PROVIDED)
5' SIDE SETBACK @ WEST PROPERTY LINE (14'-9" PROVIDED)
5' SIDE SETBACK @ EAST PROPERTY LINE (139'-2" PROVIDED)
15' REAR SETBACK @ SOUTH PROPERTY LINE (81'-1" PROVIDED)

PARKING: REQUIRED (1 PER EMPLOYEE) = 15 SPACES.
PROVIDED - 51 SPACES.

MAIN BUILDING

HEIGHT - 16.17 FEET

EXISTING FLOOR: 8,008 SQ. FT.
NEW ADDITION: 1,431 SQ. FT.
EXISTING COVERED ENTRY: 115 SQ. FT.
COVERED WALKWAY (ALT): 2,458 SQ. FT.
TOTAL: 12,012 SQ. FT.

PER IBC TABLE 503: ALLOWABLE FLOOR AREA IS 9,500 S.F. + 300% FOR SPRINKLERS = 28,500 S.F.

OCCUPANT LOADS:



CLASSROOM OCCUPANTS: 126
OFFICE OCCUPANTS: 30
KITCHEN OCCUPANTS: 3
TOTAL OCCUPANTS: 159

CAFETERA & ASSEMBLY OCCUPANTS: 208


(ASSEMBLY AND OTHER OCCUPANT LOADS DO NOT OCCUR SIMULTANEOUSLY
ASSEMBLY OCCUPANT LOAD IS USED FOR PLUMBING CALCULATIONS)

PLUMBING FIXTURES: 104 OCC MALE & 104 OCC FEMALE

PER TABLE 2902.1: PER GENDER WATER CLOSET PER GENDER LAVATORIES DRINKING SERVICE
REQUIRED: 3 3 3 1
PROVIDED: 4 3 3 1

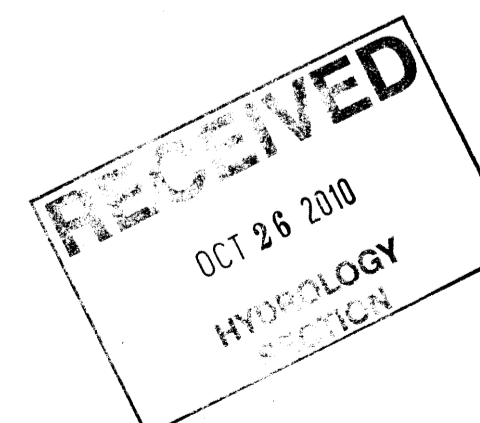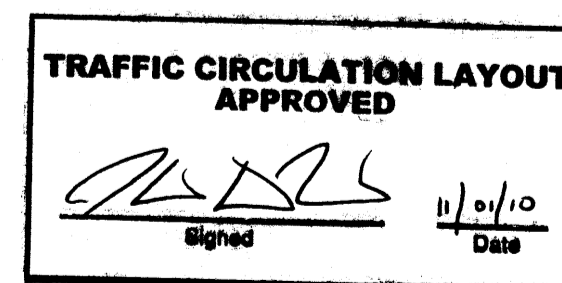

integrated design architecture
906 1/2 Park Avenue SW
Albuquerque, NM 87102
tel:505.243.3499
fax:505.243.3583
info@integrateddesignarch.com
www.integrateddesignarch.com

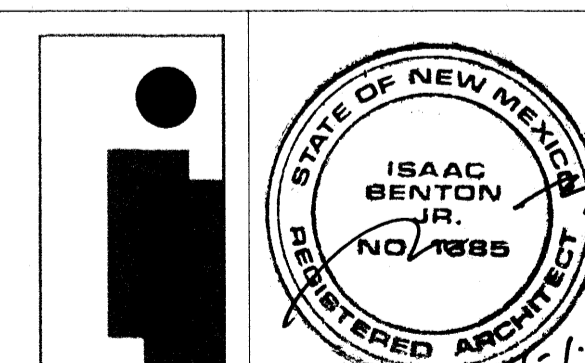

La Promesa Charter School

Albuquerque, New Mexico

PROJECT ARCHITECT:
ISAAC BENTON, AIA

Project #:
Date: SEPTEMBER 2, 2010

TRAFFIC CIRCULATION LAYOUT


By: JAM
File: (TCL-1.0) TCL.dwg
Plot Date: 10/22/2010 3:41 PM
Sheet of
TCL-1.0

SITE PLAN


Easement Notes

- EXISTING 25' ROAD AND UTILITY EASEMENT (WARRANTY DEED 11/20/64, BK. D 761, PG. 844)
- EXISTING 7' TEMPORARY DRAINAGE EASEMENT BENEFITING THE SUBJECT PROPERTY (4/7/81, MISC. 842, PG. 816)
- EXISTING DRAINAGE EASEMENT AFFECTING AND BENEFITING BOTH SUBJECT TRACTS FOR THE PURPOSES OF TRANSMITTING WATER FLOW ACROSS EACH LOT. APPEARS TO BE A BLANKET EASEMENT. (1/15/86, MISC. 312A, PG. 29-30)
- EXISTING PRIVATE ACCESS EASEMENT SERVING THE REMAINDER OF TRACT 151, UNIT 6 AS DEFINED ON THE SITE DEVELOPMENT PLAN FOR ALAMOSA CENTER (Z-95-91). (10/23/96, BK. 96C, PG. 441)
- 10' PUBLIC UTILITY EASEMENT TO BE GRANTED WITH THE FILING OF THIS PLAT

Site Plan **Lots 150-A and 150-B** **Town of Atrisco Grant Unit 6** City of Albuquerque Bernalillo County, New Mexico June 2010

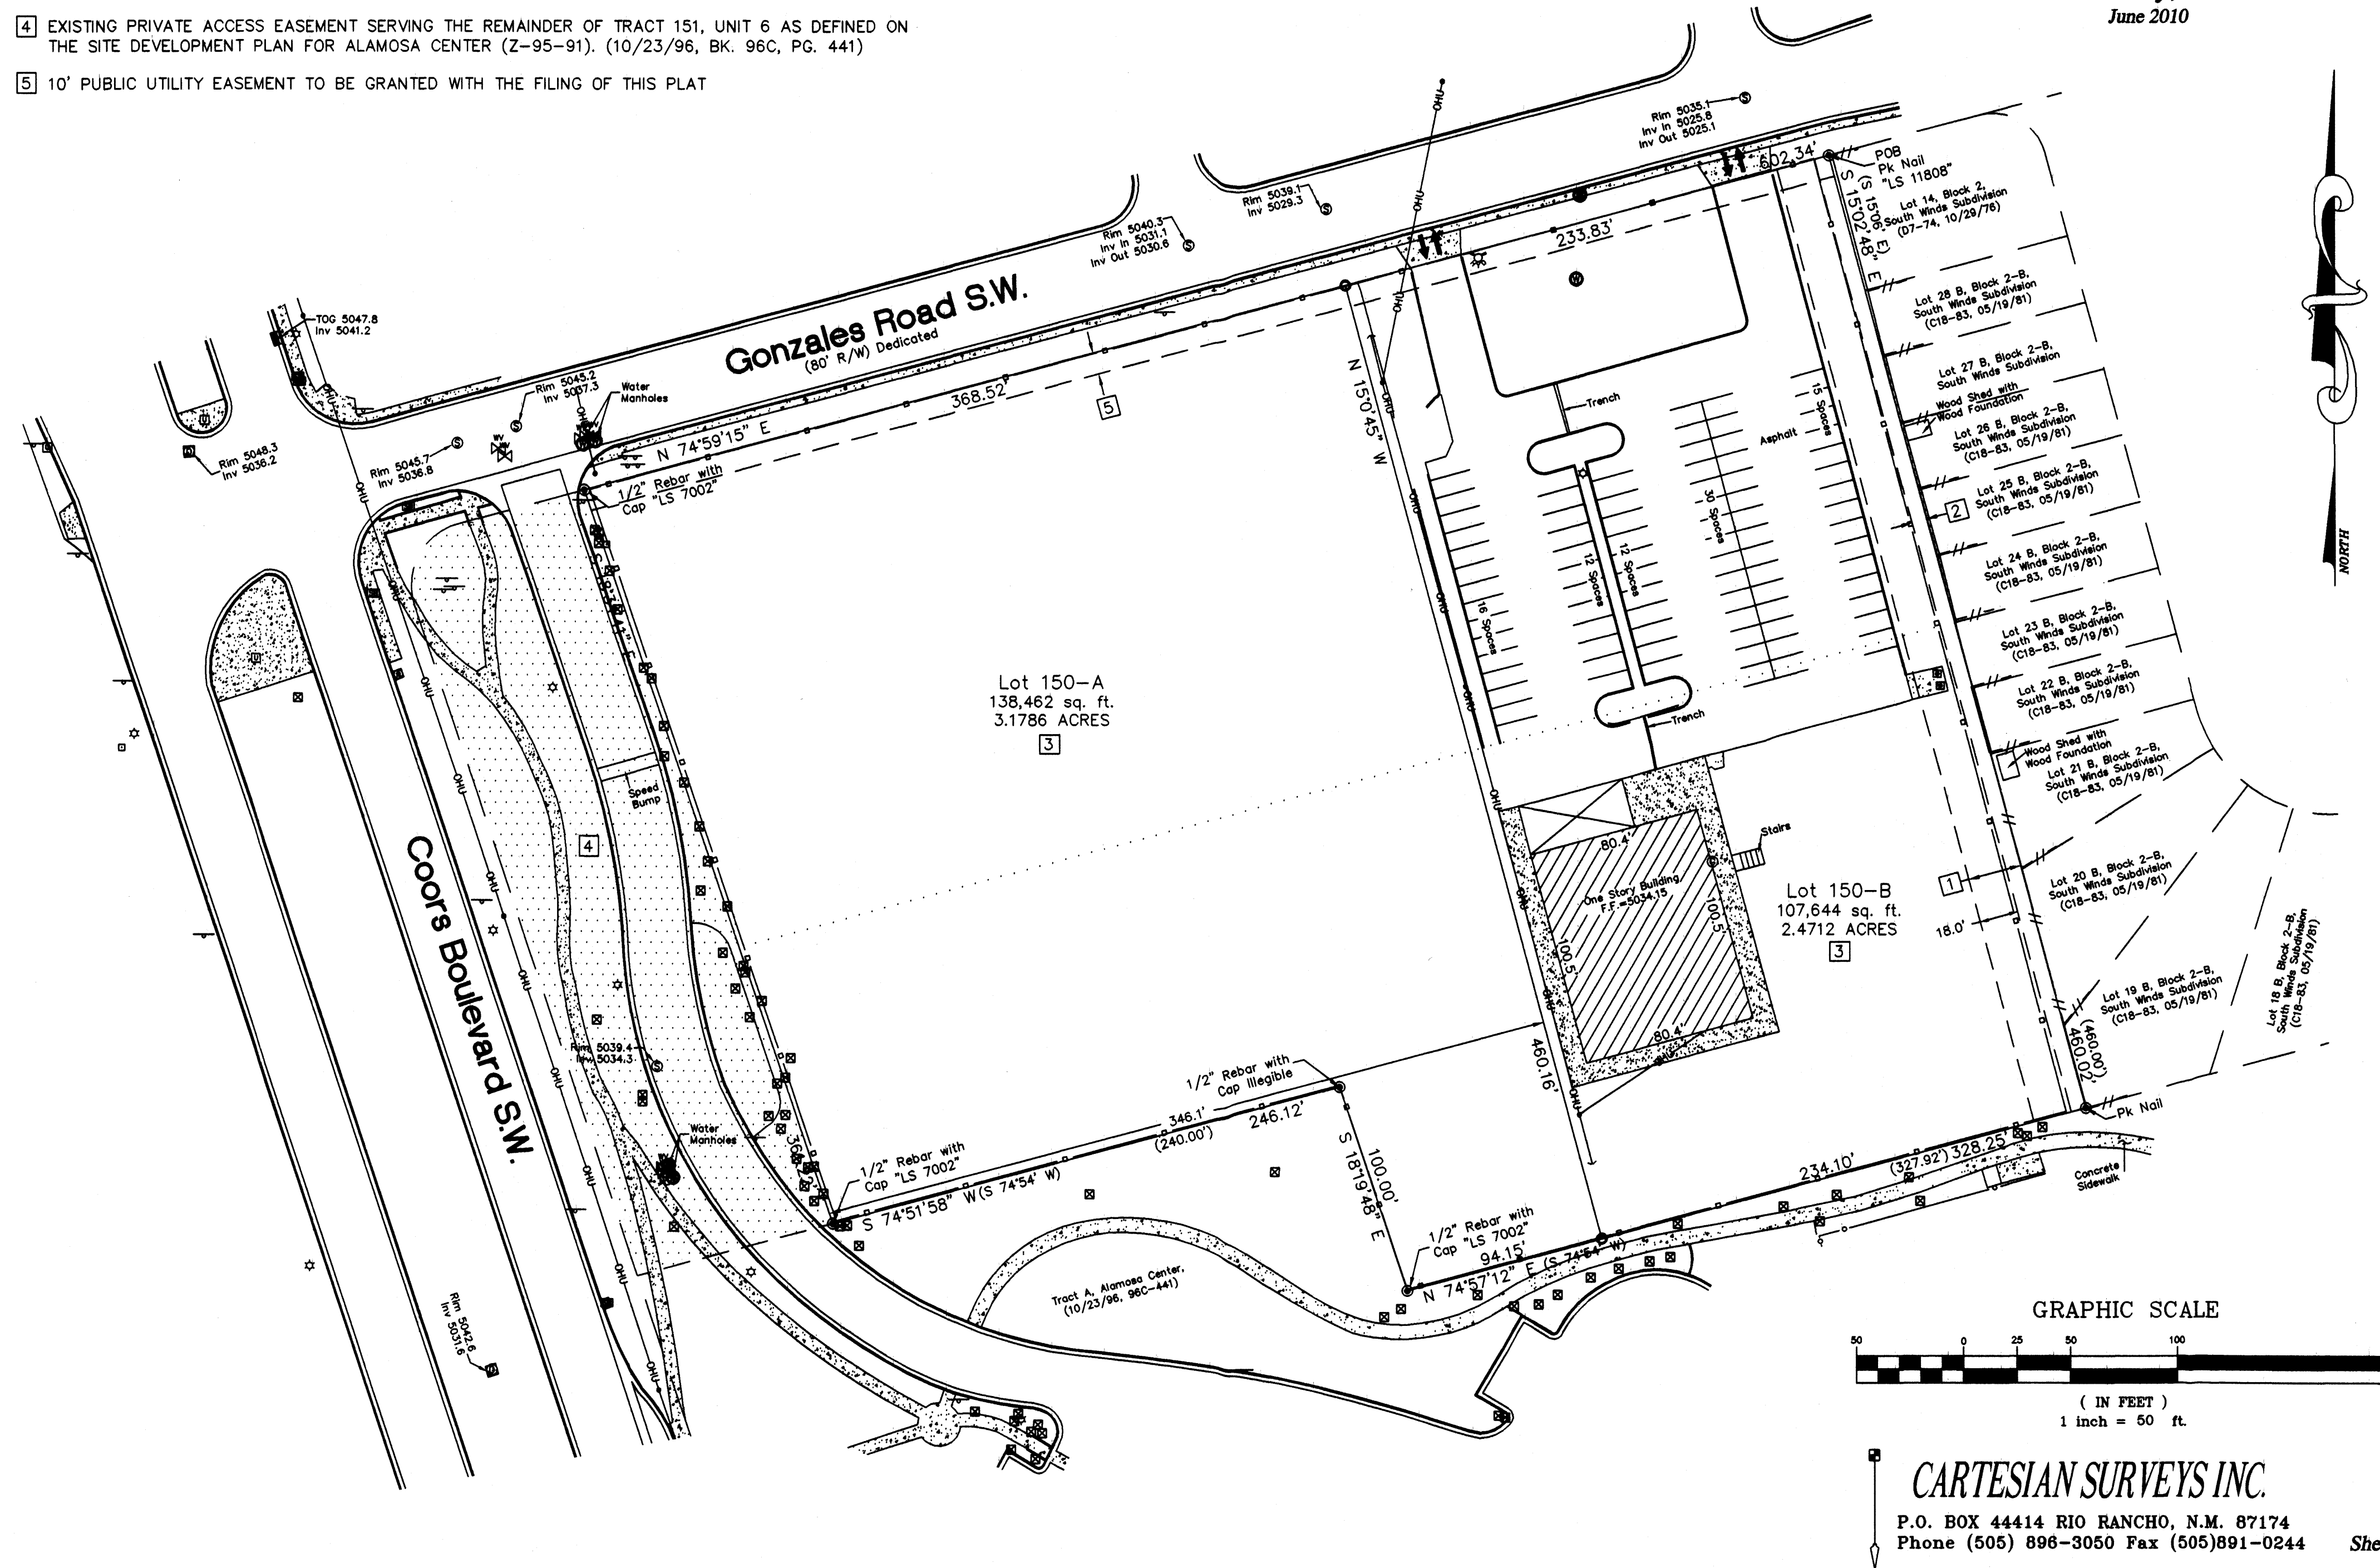

GRAPHIC SCALE

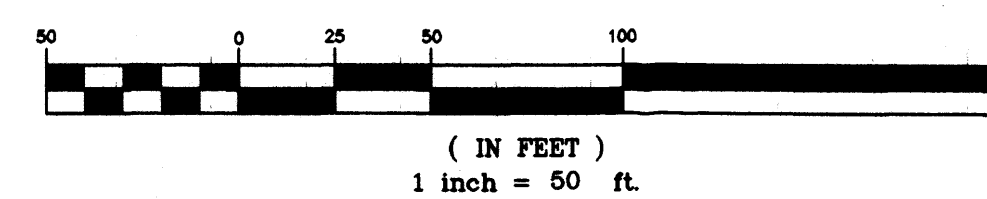

CARTESIAN SURVEYS INC.

P.O. BOX 44414 RIO RANCHO, N.M. 87174
 Phone (505) 896-3050 Fax (505) 891-0244

Sheet 1 of 1
 073135

RECEIVED
 OCT 26 2010
 HYDROLOGY
 SECTION

integrated
 design architecture

906 1/2 Park Avenue SW
 Albuquerque, NM 87102
 tel: 505.243.3499
 fax: 505.243.3563
 info@integrateddesignarch.com
 www.integrateddesignarch.com

La Promesa Charter School

Albuquerque, New Mexico

PROJECT ARCHITECT:
 ISAAC BENTON, AIA

Project #:
 Date: SEPTEMBER 2, 2010

TCL - SURVEY

By: CARTESIAN
 File:
 Plot Date: 10/22/2010 3:37 PM


Sheet of
TCL-2.0

SURVEY

NORTH
 1"=50'-0"


Gonzales Road S.W.

(80' R/W) Dedicated

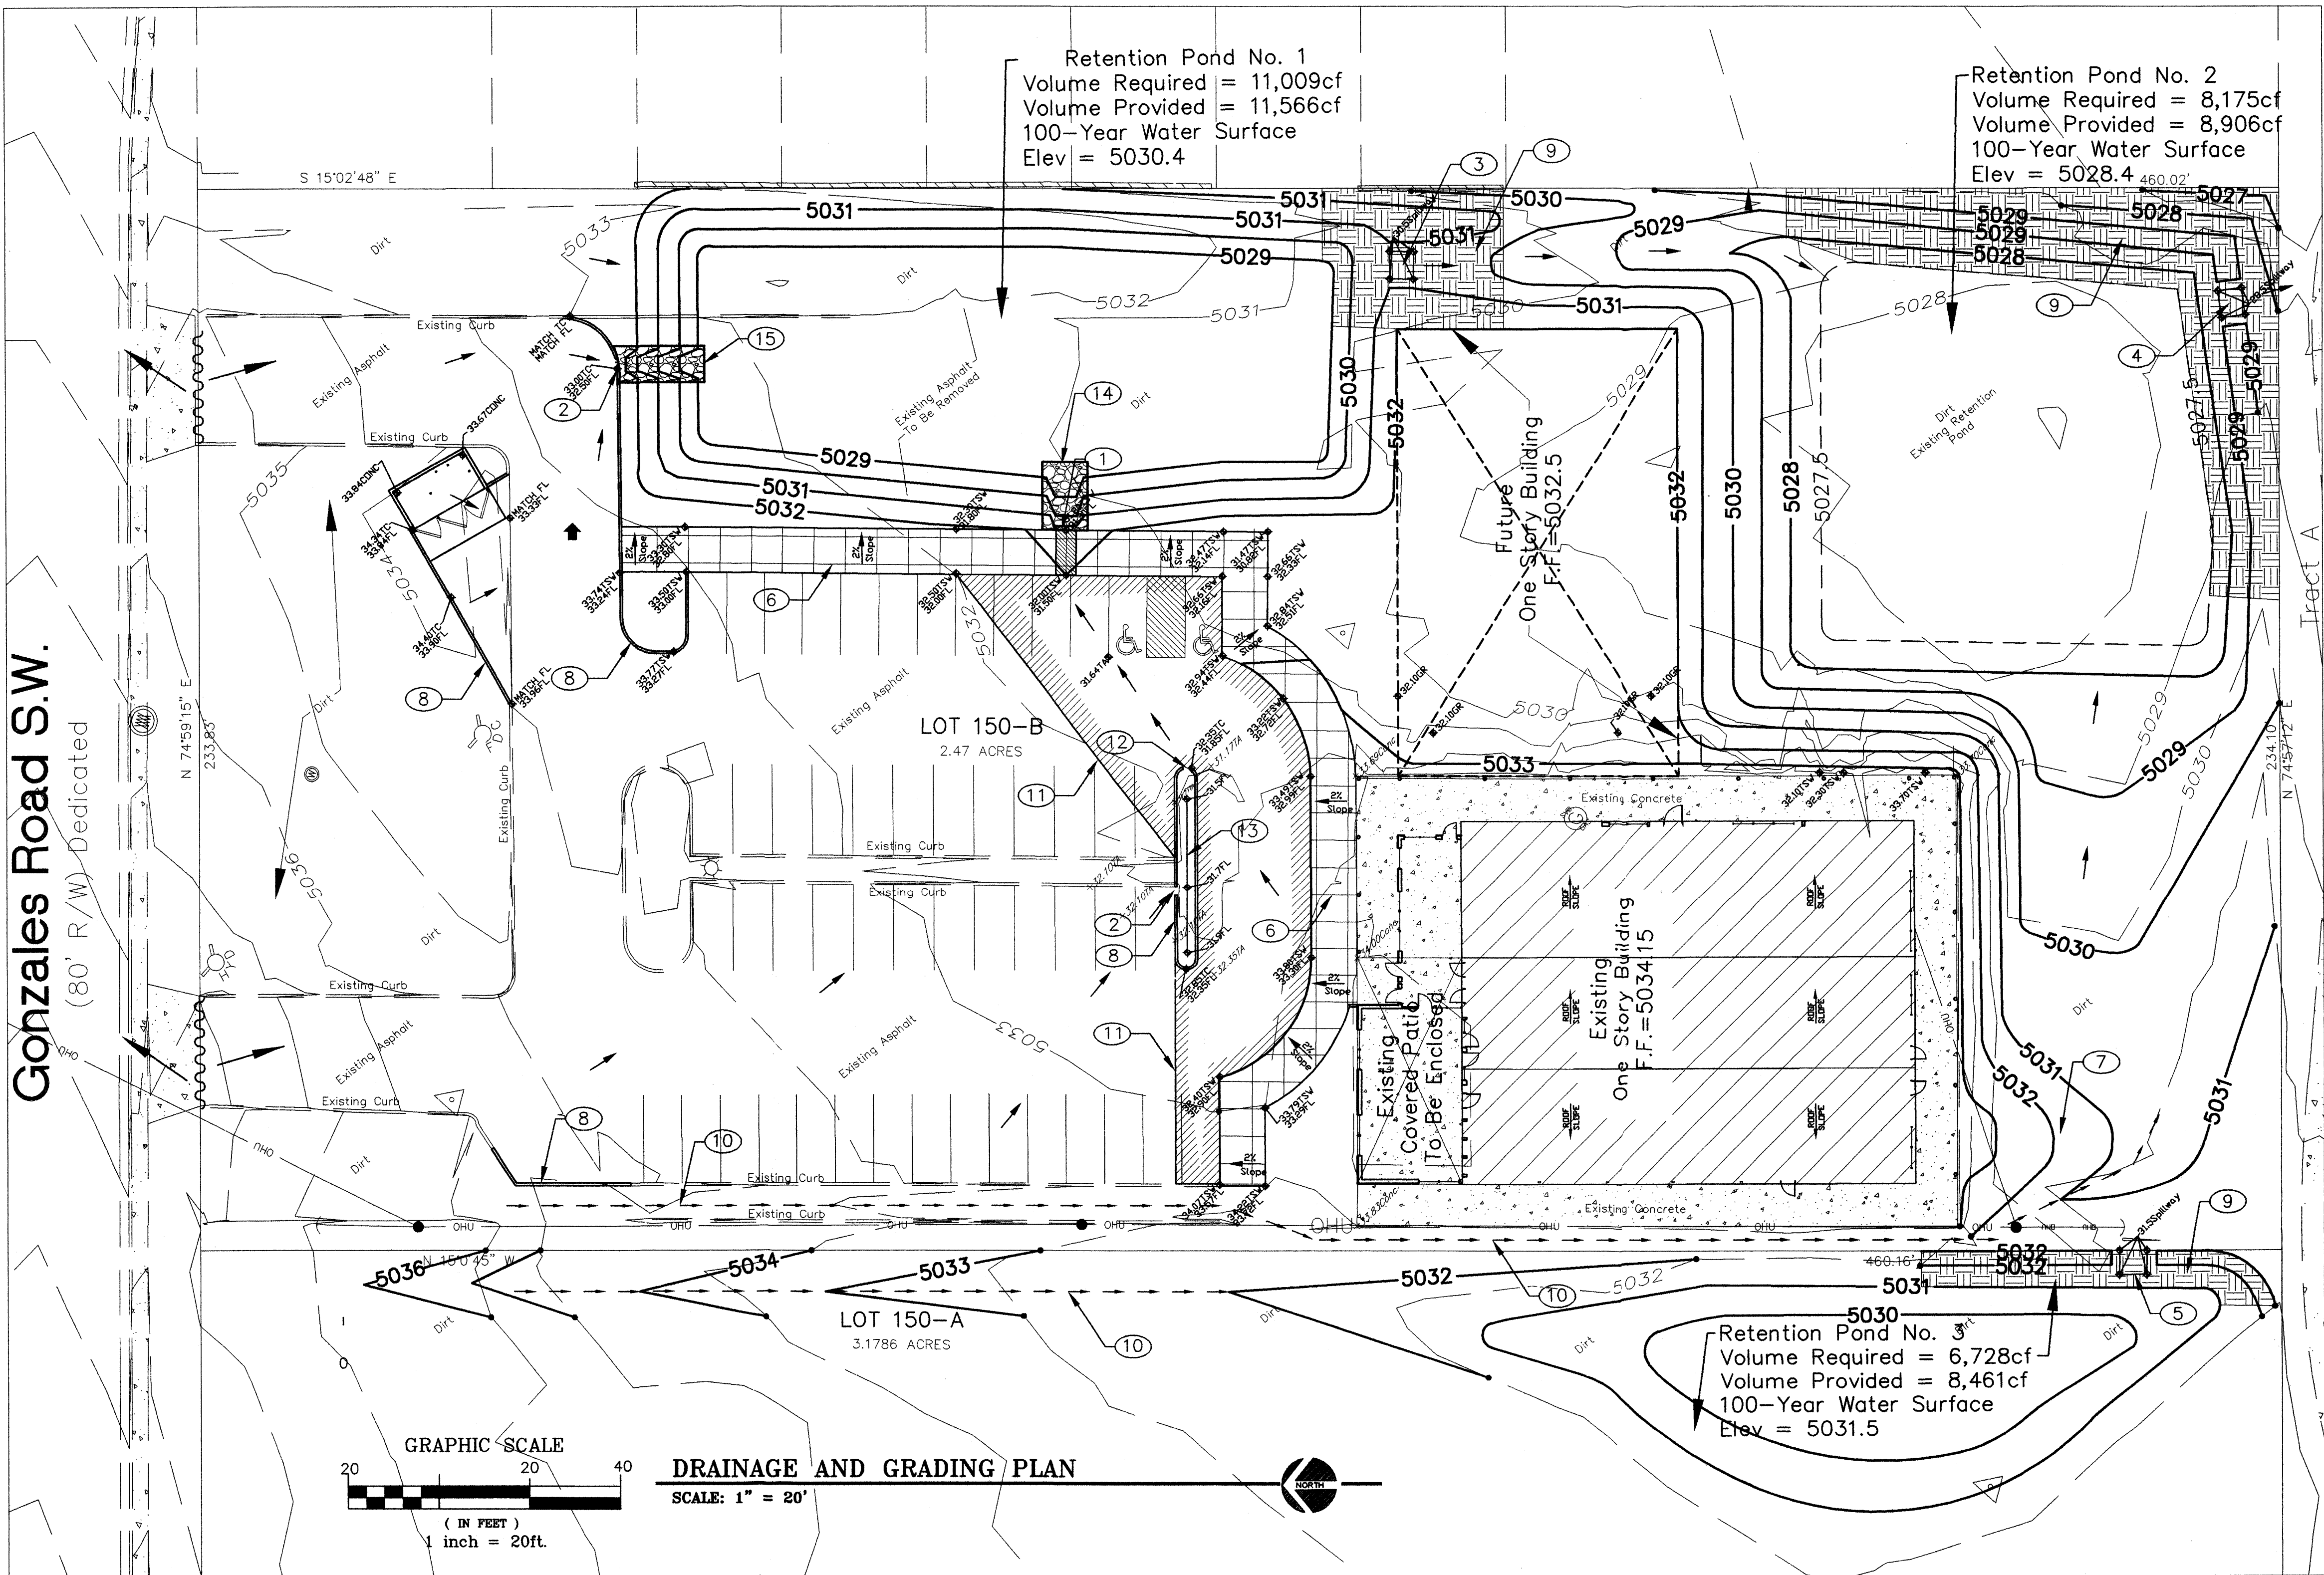


CONSTRUCTION NOTES:

1. CONSTRUCT 2'-18" WIDE BY 6" DEEP SIDEWALK CULVERTS WITH STEEL PLATE TOP PER CITY STD. DWG. 2236
2. PROVIDE 2' WIDE CURB OPENING TO ALLOW FLOWS FROM ASPHALT AREA TO DRAIN INTO LANDSCAPED AREA.
3. CONSTRUCT A DRAINAGE POND SPILLWAY FOR POND NO. 1 WITH SPILLWAY ELEVATION = 5030.5 PER DETAIL SHOWN ON THIS SHEET.
4. CONSTRUCT A DRAINAGE POND SPILLWAY FOR POND NO. 2 WITH SPILLWAY ELEVATION = 5028.5 PER DETAIL SHOWN ON THIS SHEET.
5. CONSTRUCT A DRAINAGE POND SPILLWAY FOR POND NO. 3 WITH SPILLWAY ELEVATION = 5031.5 PER DETAIL SHOWN ON THIS SHEET.
6. NEW SIDEWALK, SEE SITE PLAN BY ARCHITECT.
7. NEW HANDICAP RAMP, SEE DETAILS BY ARCHITECT.
8. NEW CURB, SEE SITE PLAN BY ARCHITECT.
9. COMPACTION REQUIREMENTS - FOLLOWING ALL CUT EARTHWORK, THE SOILS AT THE BASE OF EXCAVATIONS SHOULD BE SCARIFIED TO A DEPTH OF 8 INCHES AND MOISTURE CONDITIONED TO OPTIMUM MOISTURE CONTENT (+/-3%). THE SURFACE OF THE NATURAL SOILS AT THE BASE OF EXCAVATIONS SHOULD BE COMPACTED TO 95% MAXIMUM DRY DENSITY AS DETERMINED BY ASTM STANDARD D1557. MODIFIED PROCTOR TESTING (ASTM D-1557) WILL BE NECESSARY TO DETERMINE THE MAXIMUM DRY DENSITY AND OPTIMUM MOISTURE CONTENT OF THE NATURAL SOILS AT THE BASE OF EXCAVATIONS AS WELL AS ON ALL ENGINEERED FILL PLACED. THE SURFACE OF NATURAL SOILS SHOULD BE TESTED FOR COMPACTION PRIOR TO PLACING ENGINEERED FILL. ENGINEERED FILL SHOULD BE PLACED IN LOOSE LIFTS A MAXIMUM OF EIGHT-INCHES THICK. EACH LIFT OF FILL SHOULD BE COMPACTED PRIOR TO PLACING ADDITIONAL LIFTS. COMPACTION TESTING SHOULD BE PERFORMED ON FILL AT A MINIMUM OF EVERY OTHER LIFT UNTIL FINISHED GRADE IS REACHED.
10. CONSTRUCT 6" DEEP EARTH SWALE TO DRAIN FLOWS.
11. LIMITS OF ASPHALT REMOVAL AND REPLACEMENT.
12. PROVIDE 2' WIDE CURB OPENING TO ALLOW OVERFLOWS FROM WATERHARVESTING AREA TO DRAIN INTO ASPHALT.
13. GRADE 6" DEEP SWALE FOR WATER HARVESTING ISLAND.
14. 15' LONG X 10' WIDE X 12" THICK, 4" ROUND FRACTURE ROCK WITH FILTER BLANKET AT BOTTOM
15. 19' LONG X 8' WIDE X 12" THICK, 4" ROUND FRACTURE ROCK WITH FILTER BLANKET AT BOTTOM

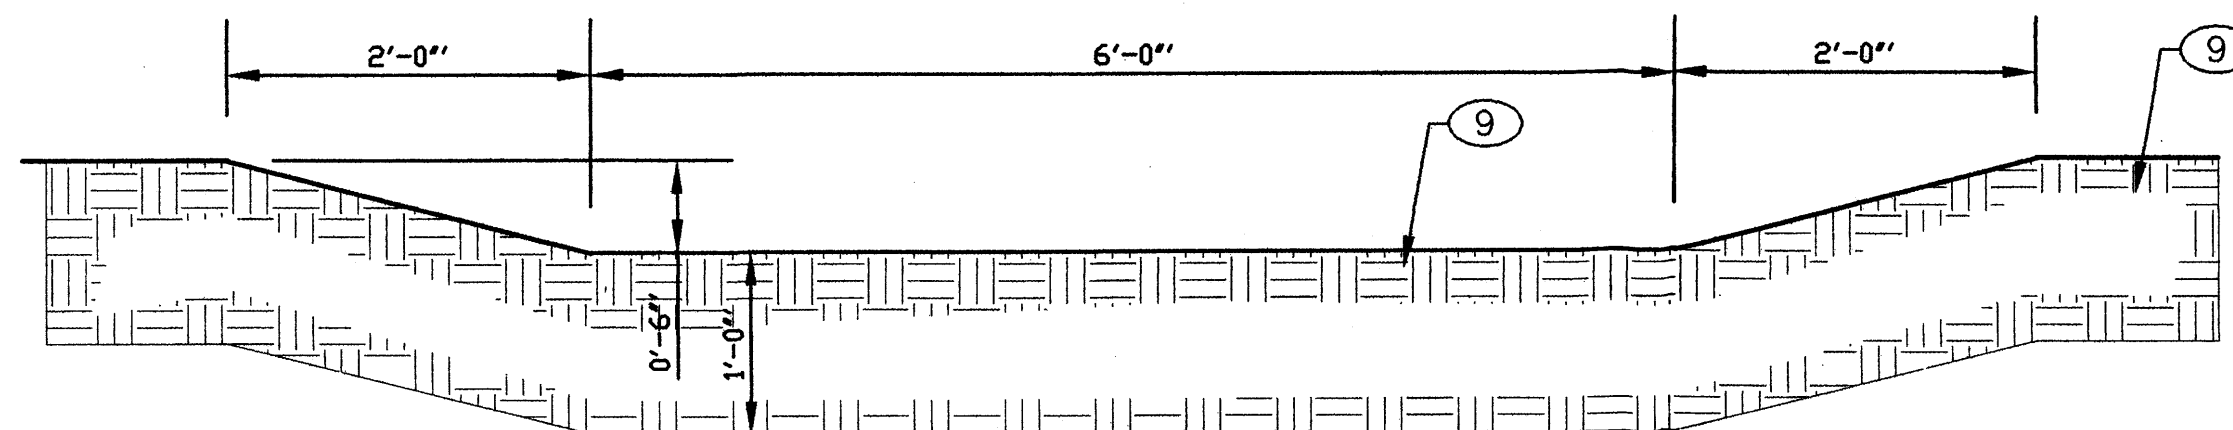


TYPICAL SPILLWAY - LONGITUDINAL VIEW

SCALE: 1" = 1'-0"

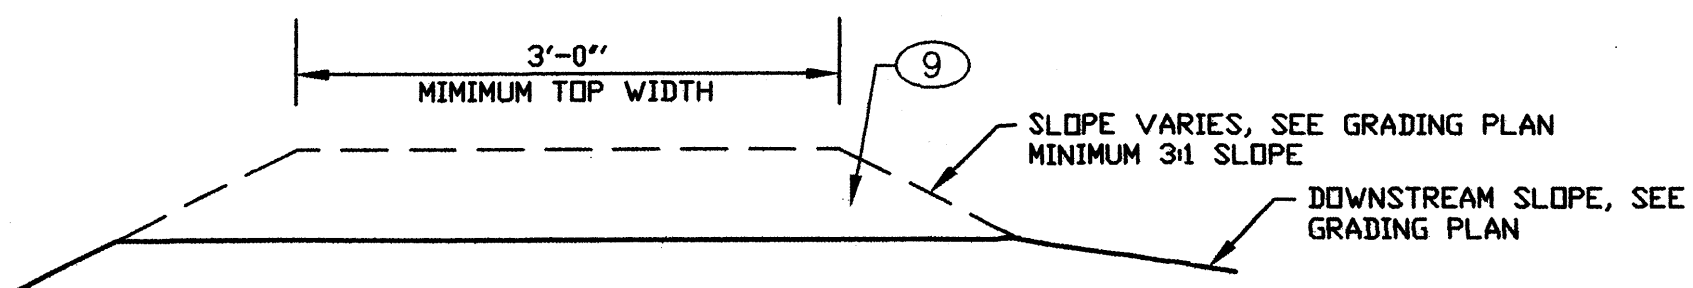


TYPICAL SPILLWAY - CROSS SECTION VIEW

SCALE: 1" = 1'-0"

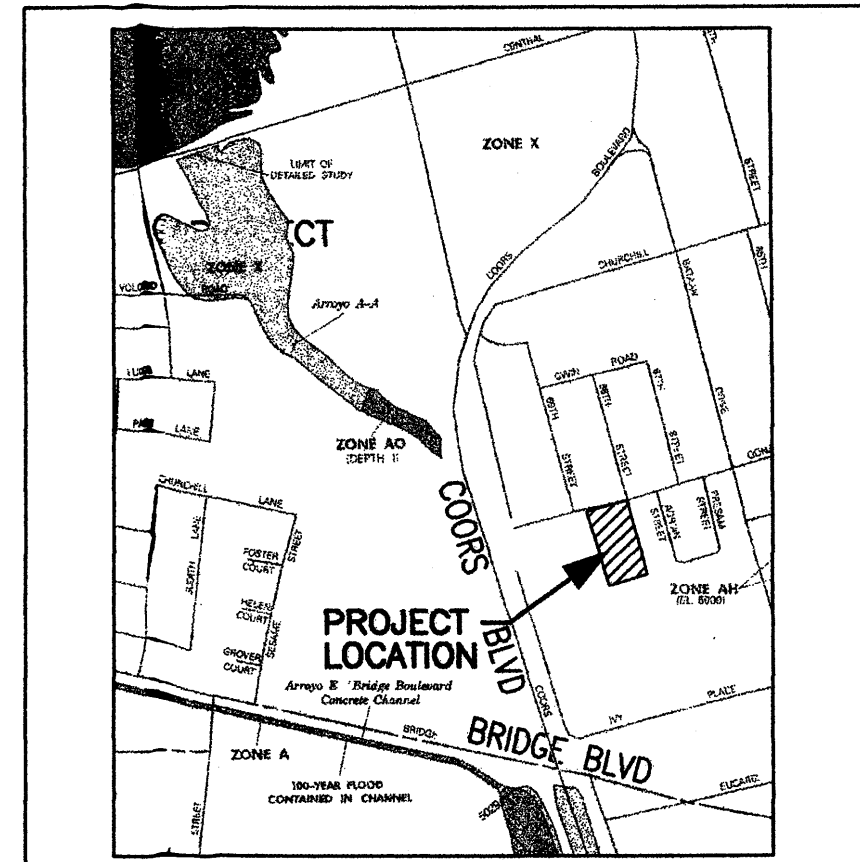

FIRM MAP 35001C0329D


SCALE: N.T.S.

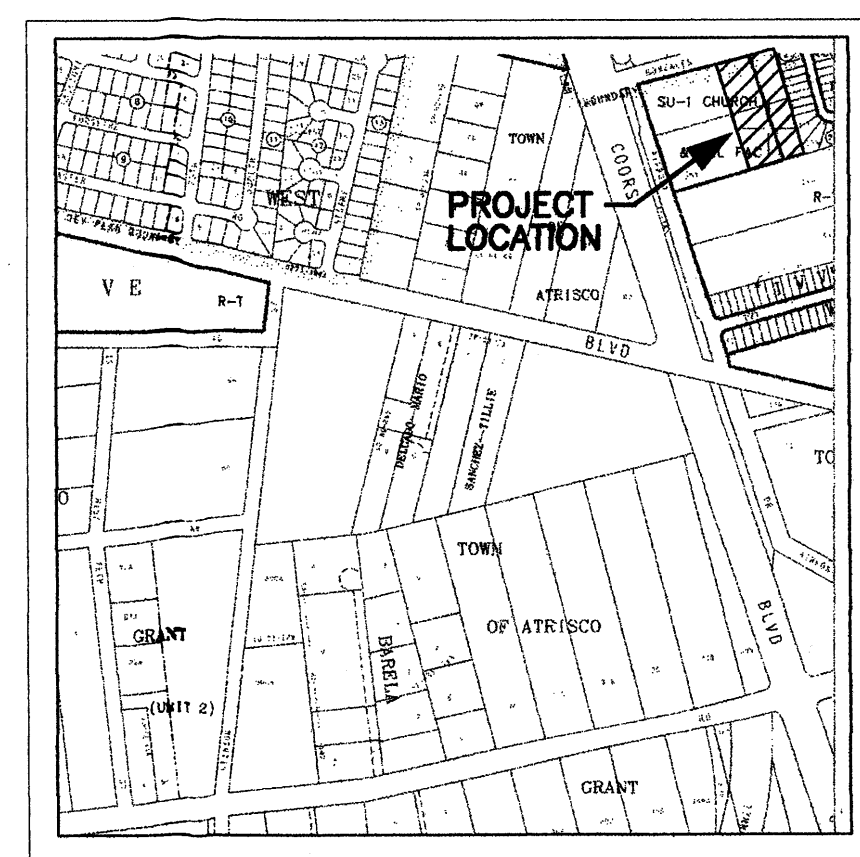

VICINITY MAP L-10

SCALE: N.T.S.

LEGEND

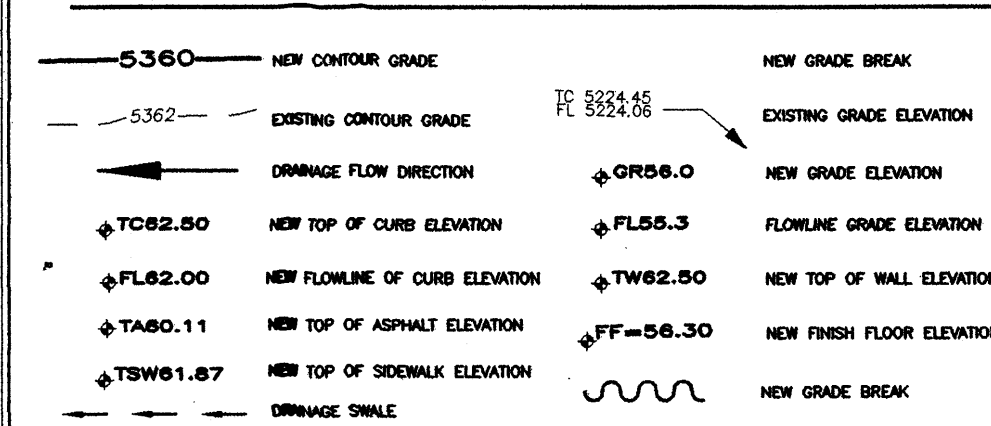

UTILITY PRECAUTIONS

THE CONTRACTOR SHALL INFORM ITSELF OF THE LOCATION OF ANY UTILITY LINE, PIPELINE, OR UNDERGROUND UTILITY LINE IN OR NEAR THE AREA OF THE WORK IN ADVANCE OF AND DURING EXCAVATION WORK. THE CONTRACTOR IS FULLY RESPONSIBLE FOR ANY AND ALL DAMAGE CAUSED BY ITS FAILURE TO LOCATE, IDENTIFY AND PRESERVE ANY AND ALL EXISTING UTILITIES, PIPELINES, AND UNDERGROUND UTILITY LINES IN PLANNING AND CONDUCTING EXCAVATION. THE CONTRACTOR SHALL COMPLY WITH STATE, MUNICIPAL, AND LOCAL ORDINANCES, RULES AND REGULATIONS, IF ANY, PERTAINING TO THE LOCATION OF THESE LINES AND

APPLIED ENGINEERING AND SURVEYING, INC.


CIVIL ENGINEERING, LAND PLANNING AND SURVEYING

1605 Blair Drive NE Albuquerque, New Mexico 87112
Office: (505) 480-8125 Facsimile: (505) 237-8164
email: gddaz47@yahoo.com

OWNERSHIP OF INSTRUMENTS OF SERVICE
All design concepts, details, specifications, plans, computer files, field data, notes and other documents and instruments prepared by Applied Engineering Inc. as instruments of service shall remain the property of Applied Engineering Inc. shall retain all common law, statutory and other reserved rights, including the copyright thereto.

CONSULTANTS

PROFESSIONAL SEAL

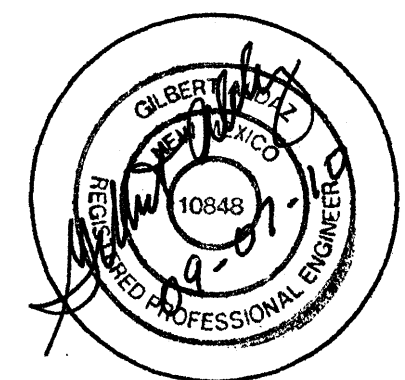

LA PROMESSA
CHARTER SHOOL
ALBUQUERQUE, NEW MEXICO



MARK	DATE	DESCRIPTION

PROJECT NUMBER: 090800
DRAWING FILE:
DRAWN BY:
CHECK BY:
COPYRIGHT: JULY 24, 2009

SHEET TITLE
PROPOSED
GRADING/DRAINAGE
IMPROVEMENTS

SHEET NUMBER
C-101

review
9-7-10

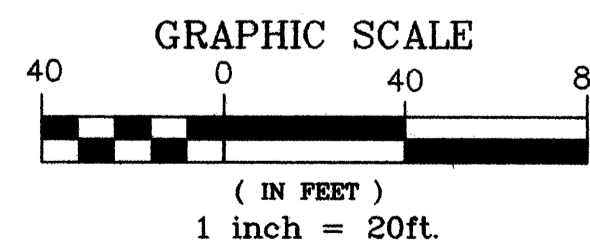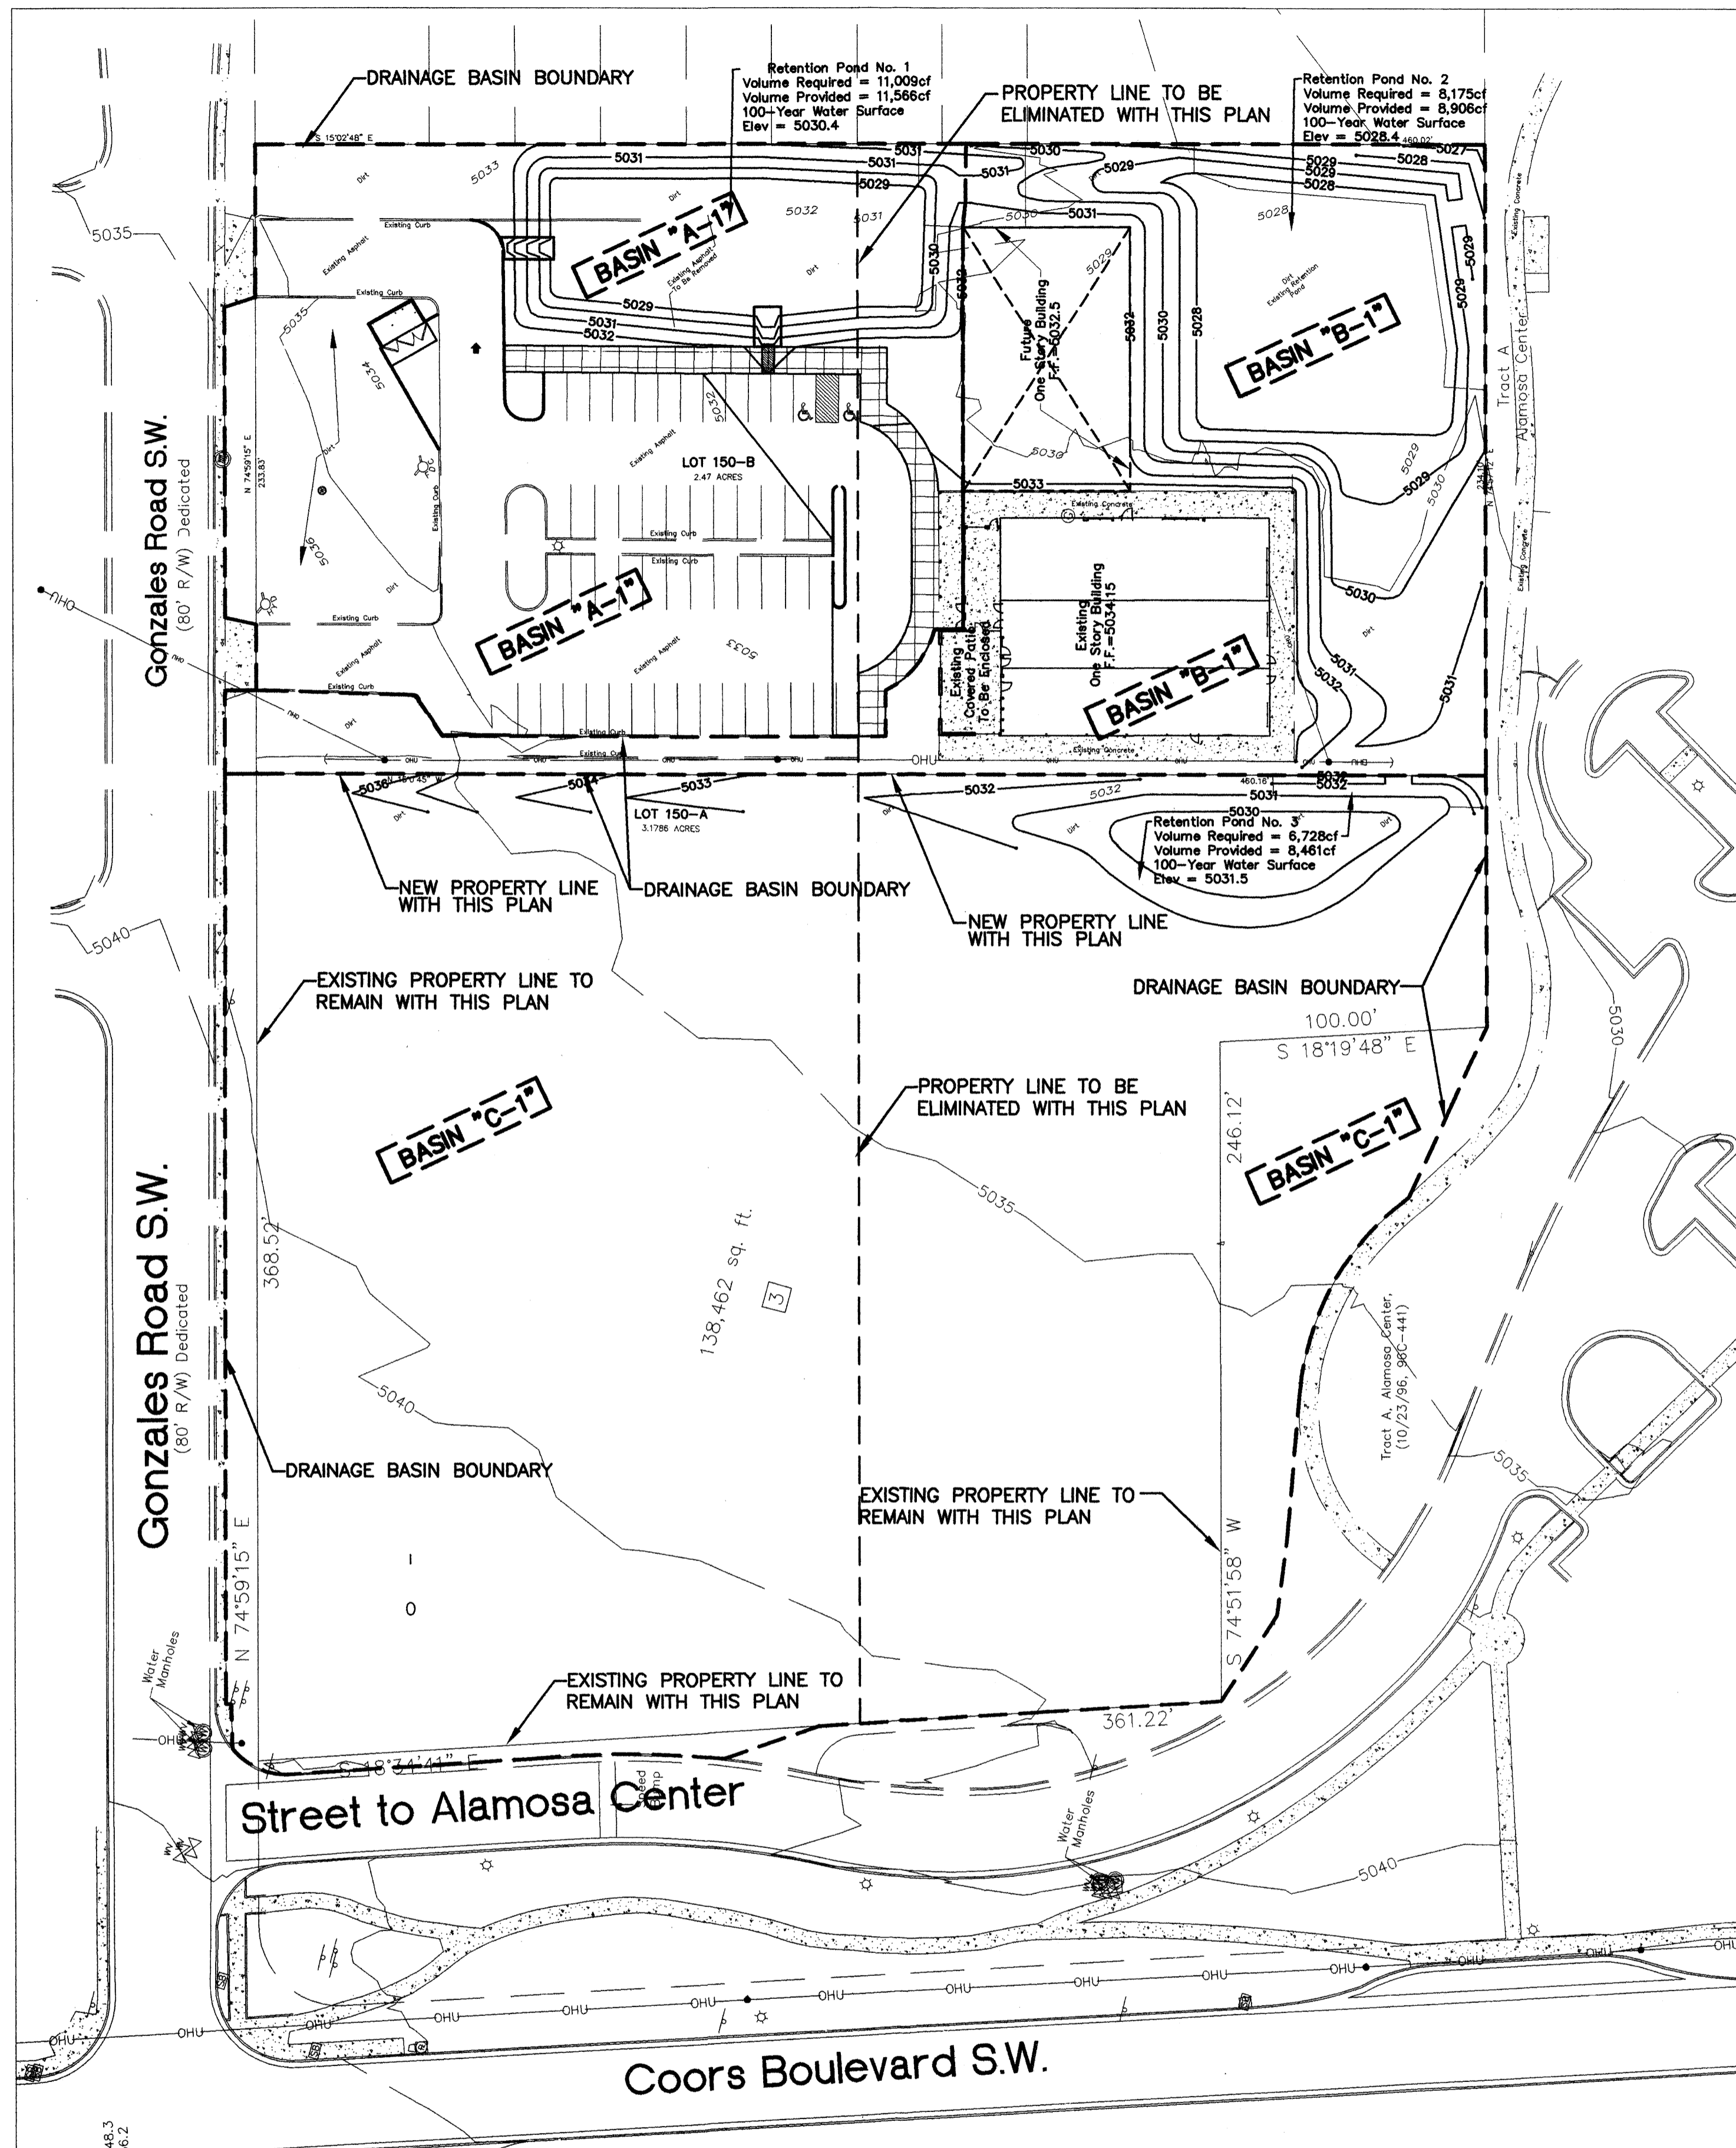

OVERALL DRAINAGE BASIN BOUNDARY MAP
SCALE: 1" = 40'

DRAINAGE PLAN

THE FOLLOWING ITEMS CONCERN THE RECONSTRUCTION OF AN EXISTING BUILDING AND PARKING LOT TO INCLUDE VACANT LAND FOR THE PROPOSED REPLATED LOTS OF 150-A AND 150-B LOCATED AT THE SOUTHEAST CORNER OF COORS BOULEVARD SW AND GONZALES ROAD SW, ALBUQUERQUE, NEW MEXICO. THE FOLLOWING INFORMATION CONTAINED HEREON IS AS FOLLOWS:

1. DRAINAGE CALCULATIONS
2. VICINITY MAP K-10
3. FLOOD INSURANCE RATE MAP 35001C0329D, Dated 09/20/1996

EXISTING CONDITIONS

AS SHOWN BY THE VICINITY MAP, THE SITE IS LOCATED AT THE SOUTHEAST CORNER OF COORS BOULEVARD SW AND GONZALES ROAD SW. THE PARCELS CURRENT LEGAL DESCRIPTION IS LOTS 150 AND 151, TOWN OF ATRISCO GRANT UNIT 6, CITY OF ALBUQUERQUE, BERNALILLO COUNTY, NEW MEXICO, FILED IN THE COUNTY CLERK'S OFFICE ON NOVEMBER 1, 1976 IN BOOK D-18-A. THE PROPERTY IS BOUNDED ON THE SOUTH BY THE CITY ALAMOSA CENTER, ON THE EAST BY A RESIDENTIAL SUBDIVISION, ON THE NORTH BY GONZALES ROAD SW AND ON THE WEST BY THE PAVED ACCESS ROAD THAT SERVES THE CITY ALAMOSA CENTER.

THE OVERALL SITE CONTAINS APPROXIMATELY 5.65 ACRES. THE EASTERN PORTION OF LOTS 150 AND 151 IS CURRENTLY DEVELOPED WITH A METAL BUILDING THAT WAS USED AS A CHURCH AND A PAVED PARKING LOT. THIS DEVELOPED PORTION CURRENTLY DRAINS TO AN EXISTING RETENTION POND LOCATED AT THE SOUTHEAST CORNER OF THE SITE. THE EASTERN PORTION OF THE EXISTING DEVELOPED AREA WAS ANALYZED PER THE DRAINAGE PLAN NO. L-10/D7 AT CITY HYDROLOGY DATED 1984. THE WESTERN PORTION OF THE SITE IS CURRENTLY UNDEVELOPED AND CONTAINS SOME NATIVE GRASSES.

THE SITE IS CURRENTLY NOT IN A DESIGNATED 100-YEAR FLOODPLAIN PER FIRM MAP 35001C0334D

PROPOSED CONDITIONS

AS SHOWN BY THE PLAN THE PROPOSAL IS TO DIVIDE THE 5.65 ACRE SITE INTO TWO LOTS. THE EASTERN LOT 150-B WILL NOW CONTAIN 2.47 ACRES WHICH WILL NOW INCLUDE ALL OF THE CURRENT EXISTING DEVELOPED AREA WHICH CONSIST OF THE EXISTING PARKING LOT AND BUILDING. THE WESTERN LOT 150-A WILL NOW CONTAIN 3.17 ACRES WHICH WILL REMAIN UNDEVELOPED AS PART OF THIS PLAN.

THIS PROPOSED GRADING AND DRAINAGE PLAN WILL ADDRESS LOT 150-B WHICH WILL HAVE THE EXISTING PARKING LOT RECONSTRUCTED. THE EXISTING BUILDING WILL BE REMODELED AND ADDITIONAL SIDEWALKS WILL BE ADDED ALONG WITH SOME PLAYGROUND EQUIPMENT. THERE WILL BE A PORTION SET ASIDE FOR A FUTURE BUILDING. THE EXISTING RETENTION POND WILL BE ANALYZED FOR EXISTING FLOWS AND FOR PROPOSED FLOWS BASED ON THE PROPOSED IMPROVEMENTS AS PART OF THIS PLAN TO INCLUDE SIZING THE RETENTION POND FOR THE FUTURE BUILDING.

THE CALCULATIONS WHICH APPEAR HEREON, ANALYZE BOTH THE EXISTING AND DEVELOPED CONDITIONS FOR THE 100-YEAR, 6 HOUR RAINFALL RUNOFF FOR PEAK FLOWS AND STORM DURATION FOR VOLUME REQUIREMENTS. THE PROCEDURE FOR 40 ACRE AND SMALLER BASINS AS SET FORTH IN THE REVISION OF SECTION 22.7 HYDROLOGY OF THE DEVELOPMENT PROCESS MANUAL, VOLUME 2, DESIGN CRITERIA, DATED JANUARY 1993. THIS D.P.M. PROCEDURE IS USED FOR ANALYZING ONSITE FLOWS.

DOWNSTREAM CAPACITY

BASED ON A REVIEW OF THE EXISTING DRAINAGE PLAN FOR THE ALAMOSA CENTER WHICH EXISTS ALONG THE SOUTH BOUNDARY OF THIS SITE, NO OFFSITE FLOWS WERE CONSIDERED FOR THIS DEVELOPMENT PER DRAINAGE PLAN L-10/D13. BASED ALSO ON THE FACT THAT THE EXISTING DRAINAGE PLAN L-10/D7 UTILIZED A RETENTION POND, THE MODIFICATIONS TO THE EXISTING DEVELOPED SITE WILL ALSO PROPOSE A RETENTION POND.

OFFSITE FLOWS

A REVIEW OF THE TOPOGRAPHIC SURVEY AND A FIELD VISIT TO THE SITE INDICATES THAT OFFSITE FLOWS FOR THE PROPOSED UNDEVELOPED TRACT TO THE WEST (LOT 150-A) COULD ENTER THIS SITE. BASED ON THE EXISTING CONTOURS THERE APPEARS TO BE AN EXISTING RETENTION POND AT THE SOUTHEAST CORNER OF THIS LOT 150-A. AS PART OF THIS PLAN A NEW DRAINAGE ANALYSIS WILL BE PERFORMED TO DETERMINE THE SIZE OF THE RETENTION POND REQUIRED TO MEET CURRENT CITY HYDROLOGY STANDARDS. THE EXISTING RETENTION POND WILL BE INCREASED TO ACCOMMODATE EXISTING UNDEVELOPED DRAINAGE CONDITIONS FOR LOT 150-A. WHEN LOT 150-A DEVELOPS IN THE FUTURE A REVISED RETENTION POND WILL BE NEEDED FOR LOT 150-A WITH THE POSSIBILITY FOR A NEED TO DEVELOP AN OUTFALL TO BATTAN DRIVE WHICH CURRENTLY HAS EXISTING DRAINAGE IMPROVEMENTS. THIS WOULD ALLOW THIS RETENTION POND TO BE CONVERTED TO A DETENTION POND. THIS WILL ASSUME THAT A DRAINAGE EASEMENT CAN BE SECURED ACROSS THE CITY OWNED ALAMOSA CENTER IN ORDER TO CONVEY FLOWS FROM THIS SITE.

DRAINAGE CALCULATIONS

1. PRECIPITATION ZONE = 1

2. DESIGN STORM = DEPTH (INCHES) AT 100-YEAR STORM
6-HOUR = 2.20 INCHES
24-HOUR = 2.66 INCHES
10 DAY = 3.67 INCHES

3. PEAK DISCHARGE (CFS/ACRE) FOR 100-YEAR, ZONE 2, TABLE A-9:

Q = 1.29 CFS/ACRE SOIL UNCOMPACTED "A"
Q = 2.03 CFS/ACRE LANDSCAPED "B"
Q = 2.87 CFS/ACRE COMPACTED SOIL "C"
Q = 4.37 CFS/ACRE IMPERVIOUS AREA "D"
FOR WATERSHEDS LESS THAN OR EQUAL TO 40 ACRES

4. EXCESS PRECIPITATION, E (INCHES), 6 HOUR STORM, ZONE 2, TABLE A-8:

E = 0.44 INCHES SOIL UNCOMPACTED "A"
E = 0.67 INCHES LANDSCAPED "B"
E = 0.99 INCHES COMPACTED SOIL "C"
E = 1.97 INCHES IMPERVIOUS AREA "D"

5. EXISTING CONDITIONS:

EXISTING AREA OF SCHOOL SITE CURRENTLY DEVELOPED = 2.47 ACRES
EXISTING ASPHALT AREA = 37,785SF
EXISTING BUILDING AREA = 9,235SF
EXISTING CONCRETE AREA = 4,068SF
TOTAL TREATMENT "D" AREA = 37,778 + 9,235 + 4,068 = 51,091SF = 1.17 ACRES (EXISTING BUILDING, CONCRETE AND ASPHALT TREATMENT):

TREATMENT "B" AREA = 0.15 ACRES (EXISTING RETENTION POND CONTOUR 5028)

TREATMENT "C" = 1.15 ACRES (REMAINING AREA)

TREATMENT	AREA (ACRES)
A	0
B	0.15
C	1.15
D	1.17

Q (EXISTING-6HR) = (2.03 X 0.15) + (2.87 X 1.15) + (4.37 X 1.17) = 8.71 CFS (6HR)

EXISTING ONSITE FLOW TO RETENTION POND
V (EXISTING-6HR) = ((0.67 X 0.15) + (0.99 X 1.15) + (1.97 X 1.17)) / 12
= 0.30 AC-FT EXISTING ONSITE VOLUME RETENTION

CURRENT RETENTION POND VOLUME:

ELEV.	AREA (SF)	DEPTH (FT)	VOLUME (CF-FT)
5027.0	35	1	5,386
5028.0	5,351	0.15	896
5028.15	6,596		6,282CF

CURRENT RETENTION POND VOLUME = 6,282CF
= 0.14 AC-FT < 0.30 AC-FT UNDERSIZED FOR 6-HR STORM

6. SIZE PROPOSED RETENTION POND VOLUME:

PROPOSED AREA OF LOT 150-B TO BE DEVELOPED = 2.47 ACRES

BASIN "A-1" - RETENTION POND NO. 1
TOTAL AREA = 57,568SF = 1.32 ACRES
EXISTING ASPHALT AND CONCRETE TO REMAIN AND NEW ASPHALT TO BE RECONSTRUCTED AREA = 27,157SF
NEW CONCRETE AREA = 2,940SF
TOTAL TREATMENT "D" AREA = 27,157 + 2,940SF = 30,097SF = 0.69 ACRES
TREATMENT "B" & "C" AREA = 1.32 AC - 0.69 AC = 0.63 AC
USE 50% TREATMENT "B" AND "C"
TREATMENT "B" = 0.50 X 0.63 AC = 0.32 ACRES
TREATMENT "C" = 0.50 X 0.63 AC = 0.31 ACRES
TREATMENT

TREATMENT	AREA (ACRES)
A	0
B	0.32
C	0.31
D	0.69

Q (PROPOSED-6HR) = (2.03 X 0.32) + (2.87 X 0.31) + (4.37 X 0.69) = 4.55 CFS (6HR) PROPOSED ONSITE FLOW TO RETENTION POND

V (PROPOSED-6HR) = ((0.67 X 0.32) + (0.99 X 0.31) + (1.97 X 0.69)) / 12
= 0.16 AC-FT PROPOSED ONSITE VOLUME RETENTION
V (PROPOSED-10DAY) = (0.16 AC-FT + (0.49 X (3.67-2.20)) / 12)
= 0.25 AC-FT PROPOSED ONSITE VOLUME RETENTION
= 11,009CF PROPOSED ONSITE VOLUME RETENTION

PROPOSED RETENTION POND NO. 1 VOLUME:

ELEV.	AREA (SF)	DEPTH (FT)	VOLUME (CF-FT)
5029	6,620	1	7,374
5030	8,128	0.5	4,193
5030.5	8,643		

PROPOSED RETENTION POND VOLUME PROVIDED = 11,566CF

= 0.27 AC-FT
= 0.27 AC-FT > 0.25 AC-FT REQUIRED FOR 10-DAY STORM

BASIN "B-1" - RETENTION POND NO. 2:

TOTAL AREA = 51,748SF = 1.19 AC
EXISTING BUILDING AREA + ENCLOSE PORCH = 9,527SF
EXISTING CONCRETE AREA = 3,770SF
FUTURE BUILDING = 6,121SF
TOTAL TREATMENT "D" AREA = 9,527 + 3,770 + 6,121SF = 19,418SF = 0.45 ACRES (EXISTING BUILDING, CONCRETE AND FUTURE BUILDING)
TREATMENT "B" & "C" AREA = 1.19 AC - 0.45 = 0.74 ACRES
USE 50% TREATMENT "B" AND "C"
TREATMENT "B" = 0.50 X 0.74 AC = 0.37 ACRES
TREATMENT "C" = 0.50 X 0.74 AC = 0.37 ACRES

TREATMENT	AREA (ACRES)
A	0
B	0.37
C	0.37
D	0.45

Q (PROPOSED-6HR) = (2.03 X 0.37) + (2.87 X 0.37) + (4.37 X 0.45) = 3.78 CFS (6HR) PROPOSED ONSITE FLOW TO RETENTION POND

V (PROPOSED-6HR) = ((0.67 X 0.37) + (0.99 X 0.37) + (1.97 X 0.45)) / 12
= 0.13 AC-FT PROPOSED ONSITE VOLUME RETENTION

V (PROPOSED-10DAY) = (0.13 AC-FT + (0.45 X (3.67-2.20)) / 12)
= 0.19 AC-FT PROPOSED ONSITE VOLUME RETENTION
= 8,175CF PROPOSED ONSITE VOLUME RETENTION

PROPOSED RETENTION POND NO. 2 VOLUME:

ELEV.	AREA (SF)	DEPTH (FT)	VOLUME (CF-FT)
5027.5	7,770	0.5	4,131
5028	8,754	0.5	4,774
5028.5	10,344		

PROPOSED RETENTION POND VOLUME PROVIDED = 8,906CF

= 0.20 AC-FT
= 0.20 AC-FT > 0.19 AC-FT REQUIRED FOR 10-DAY STORM

BASIN "C-1" - RETENTION POND NO. 3:

EXISTING UNDEVELOPED LAND AREA = 154,702SF = 3.55 AC
85% UNDISTURBED TREATMENT "A" = 0.85 X 3.55 AC = 3.02 AC
15% DISTURBED TREATMENT "C" = 0.15 X 3.55 AC = 0.53 AC

TREATMENT	AREA (ACRES)
A	3.02
B	0
C	0.53
D	0

Q (PROPOSED-6HR) = (1.29 X 3.02) + (2.87 X 0.53) = 5.42 CFS (6HR)

PROPOSED ONSITE FLOW TO RETENTION POND

V (PROPOSED-6HR) = ((0.44 X 3.02) + (0.99 X 0.53)) / 12
= 0.15 AC-FT PROPOSED ONSITE VOLUME RETENTION
= 6,728CF PROPOSED ONSITE VOLUME RETENTION

PROPOSED RETENTION POND NO. 2 VOLUME:

ELEV.	AREA (SF)	DEPTH (FT)	VOLUME (CF-FT)
5030	2,589	1.0	3,896
5031	5,203	0.5	2,991
5031.5	6,762		

PROPOSED RETENTION POND VOLUME PROVIDED = 6,887CF

= 0.16 AC-FT
= 0.16 AC-FT > 0.15 AC-FT REQUIRED FOR 10-DAY STORM

7. SIDE WALK CULVERT:

EXISTING ASPHALT AND SIDEWALK AREA = 25,783SF

TOTAL TREATMENT "D" AREA = 25,783SF = 0.59 AC

LANDSCAPED AREAS = 3,594SF

TREATMENT "B" AREA = 3,594SF = 0.08 ACRES

TREATMENT "C" = 4,631SF = 0.11 ACRES (REMAINING AREA)

TREATMENT	AREA (ACRES)
A	0
B	0.08
C	0.11
D	0.59

Q (EXISTING-6HR) = (2.03 X 0.08) + (2.87 X 0.11) + (4.37 X 0.59) = 3.06 CFS (6HR) ONSITE FLOW TO SIDEWALK CULVERT

USE WEIR EQUATION FOR SIZING OPENING:
Q = C X L X (H)^{3/2}
L = Q / C X (H)^{3/2}
Q = 3.06 CFS C = 3.0 COEFFICIENT H = 0.5' HIGH CURB
L = 3.06 / 3.0 (0.5)^{3/2}

APPLIED ENGINEERING AND SURVEYING, INC.


CIVIL ENGINEERING, LAND PLANNING AND SURVEYING

1605 Blair Drive NE Albuquerque, New Mexico 87112
Office: (505) 480-8125 Facsimile: (505) 237-8164
email: gldaz47@yahoo.com

OWNERSHIP OF INSTRUMENTS OF SERVICE
All design concepts, details, specifications, plans, computer files, field data, notes and other documents and instruments prepared by Applied Engineering Inc. as instruments of service shall remain the property of Applied Engineering Inc. shall retain all common law, statutory and other reserved rights, including the copyright thereto.

CONSULTANTS

PROFESSIONAL SEAL

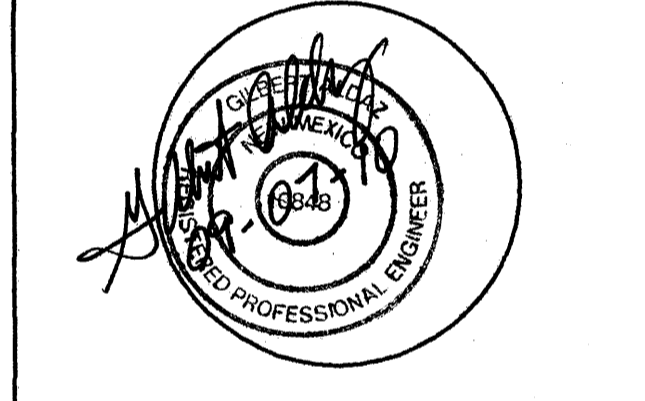

LA PROMESSA CHARTER SHOOOL ALBUQUERQUE, NEW MEXICO

MARK	DATE	DESCRIPTION
-	-	-
-	-	-
PROJECT NUMBER: 090800
DRAWING FILE:
DRAWN BY:
CHECK BY:
COPYRIGHT: JULY 24, 2009

SHEET TITLE DRAINAGE CALCULATIONS


SHEET NUMBER
C-102

Gonzales Road S.W.

(80' R/W) Dedicated

As indicated by the as-built information shown hereon for the La Promessa Charter School Grading and Drainage Plan has been constructed in substantial compliance with the approved Grading and Drainage Plan. This Certification is presented in fulfillment of drainage requirements requested by the City of Albuquerque. The information shown hereon has been obtained by Harris Surveying, Inc. and is true and correct to the best of my knowledge and belief.


Gilbert Aldaz
Gilbert Aldaz, NMPE 10848
Date 3-19-11

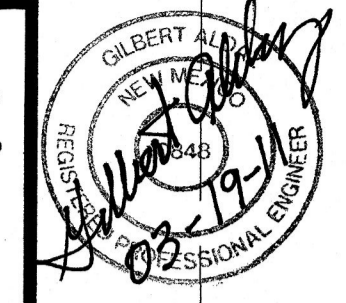

Retention Pond No. 1
Volume Required = 11,009cf
Volume Provided = 11,566cf
100-Year Water Surface
Elev = 5030.4

Retention Pond No. 2
Volume Required = 8,175cf
Volume Provided = 8,906cf
100-Year Water Surface
Elev = 5028.4


Retention Pond No. 3
Volume Required = 6,728cf
Volume Provided = 8,461cf
100-Year Water Surface
Elev = 5031.5

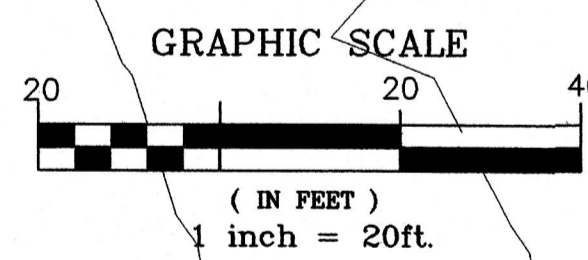


DRAINAGE AND GRADING PLAN
SCALE: 1" = 20'

CONSTRUCTION NOTES:


- CONSTRUCT 2'-18" WIDE BY 6" DEEP SIDEWALK CULVERTS WITH STEEL PLATE TOP PER CITY STD. DWG. 2236
- PROVIDE 2' WIDE CURB OPENING TO ALLOW FLOWS FROM ASPHALT AREA TO DRAIN INTO LANDSCAPED AREA.
- CONSTRUCT A DRAINAGE POND SPILLWAY FOR POND NO. 1 WITH SPILLWAY ELEVATION = 5030.5 PER DETAIL SHOWN ON THIS SHEET.
- CONSTRUCT A DRAINAGE POND SPILLWAY FOR POND NO. 2 WITH SPILLWAY ELEVATION = 5028.5 PER DETAIL SHOWN ON THIS SHEET.
- CONSTRUCT A DRAINAGE POND SPILLWAY FOR POND NO. 3 WITH SPILLWAY ELEVATION = 5031.5 PER DETAIL SHOWN ON THIS SHEET.
- NEW SIDEWALK, SEE SITE PLAN BY ARCHITECT.
- NEW HANDICAP RAMP, SEE DETAILS BY ARCHITECT.
- NEW CURB, SEE SITE PLAN BY ARCHITECT.
- COMPACTION REQUIREMENTS - FOLLOWING ALL CUT EARTHWORK, THE SOILS AT THE BASE OF EXCAVATIONS SHOULD BE SCARIFIED TO A DEPTH OF 8 INCHES AND MOISTURE CONDITIONED TO OPTIMUM MOISTURE CONTENT (+/-3%). THE SURFACE OF THE NATURAL SOILS AT THE BASE OF EXCAVATIONS SHOULD BE COMPACTED TO 95% MAXIMUM DRY DENSITY AS DETERMINED BY ASTM STANDARD D1557, MODIFIED PROCTOR TESTING (ASTM D-1557) WILL BE NECESSARY TO DETERMINE THE MAXIMUM DRY DENSITY AND OPTIMUM MOISTURE CONTENT OF THE NATURAL SOILS AT THE BASE OF EXCAVATIONS AS WELL AS ON ALL ENGINEERED FILL PLACED. THE SURFACE OF NATURAL SOILS SHOULD BE TESTED FOR COMPACTION PRIOR TO PLACING ENGINEERED FILL. ENGINEERED FILL SHOULD BE PLACED IN LOOSE LIFTS A MAXIMUM OF EIGHT-INCHES THICK. EACH LIFT OF FILL SHOULD BE COMPACTED PRIOR TO PLACING ADDITIONAL LIFTS. COMPACTION TESTING SHOULD BE PERFORMED PRIOR TO PLACING ADDITIONAL LIFTS UNTIL FINISHED GRADE IS REACHED.
- CONSTRUCT 6" DEEP EARTH SWALE TO DRAIN FLOWS.
- LIMITS OF ASPHALT REMOVAL AND REPLACEMENT.
- PROVIDE 2' WIDE CURB OPENING TO ALLOW OVERFLOWS FROM WATERHARVESTING AREA TO DRAIN INTO ASPHALT.
- GRADE 6" DEEP SWALE FOR WATER HARVESTING ISLAND.
- 15' LONG X 10' WIDE X 12" THICK, 4" ROUND FRACTURE ROCK WITH FILTER BLANKET AT BOTTOM
- 19' LONG X 8' WIDE X 12" THICK, 4" ROUND FRACTURE ROCK WITH FILTER BLANKET AT BOTTOM

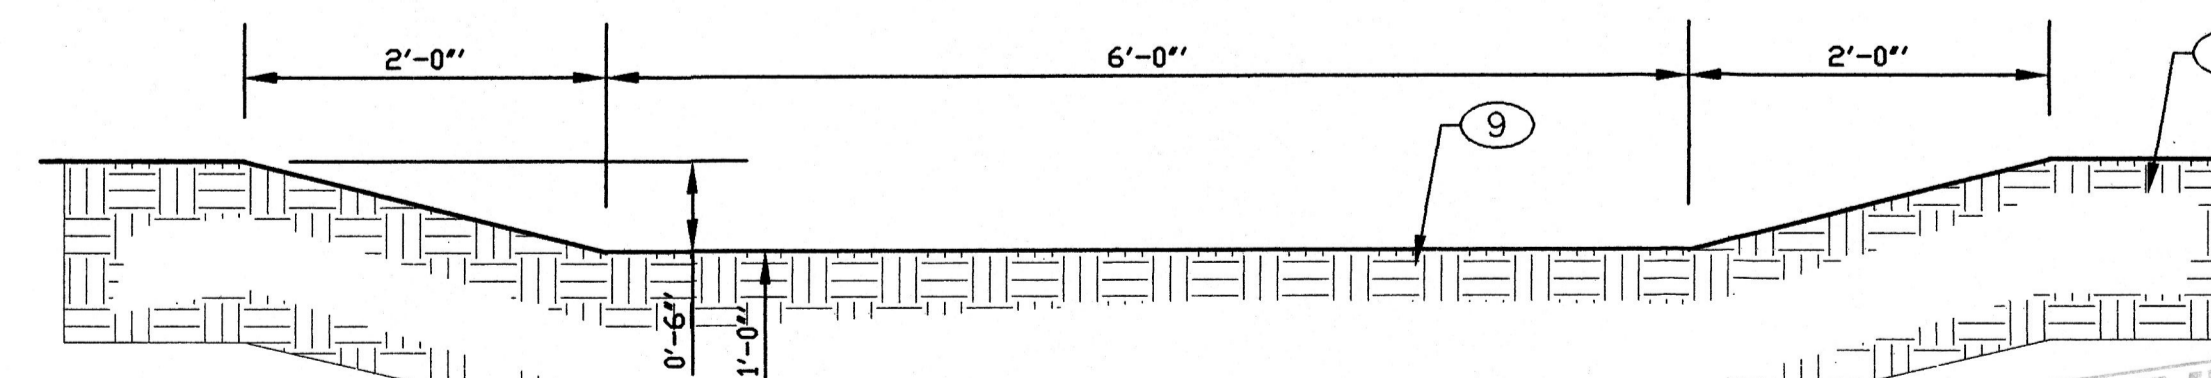


TYPICAL SPILLWAY - LONGITUDINAL VIEW
SCALE: 1" = 1'-0"

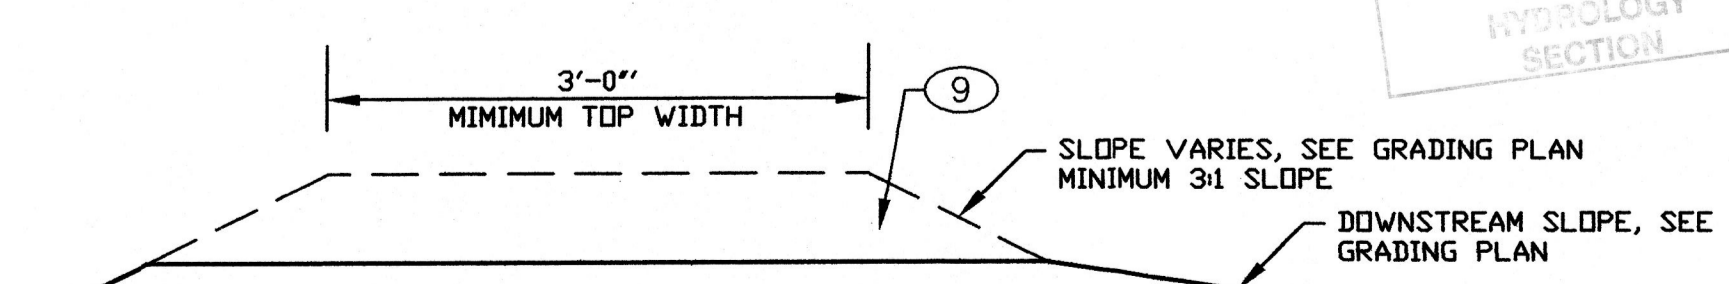

TYPICAL SPILLWAY - CROSS SECTION VIEW
SCALE: 1" = 1'-0"

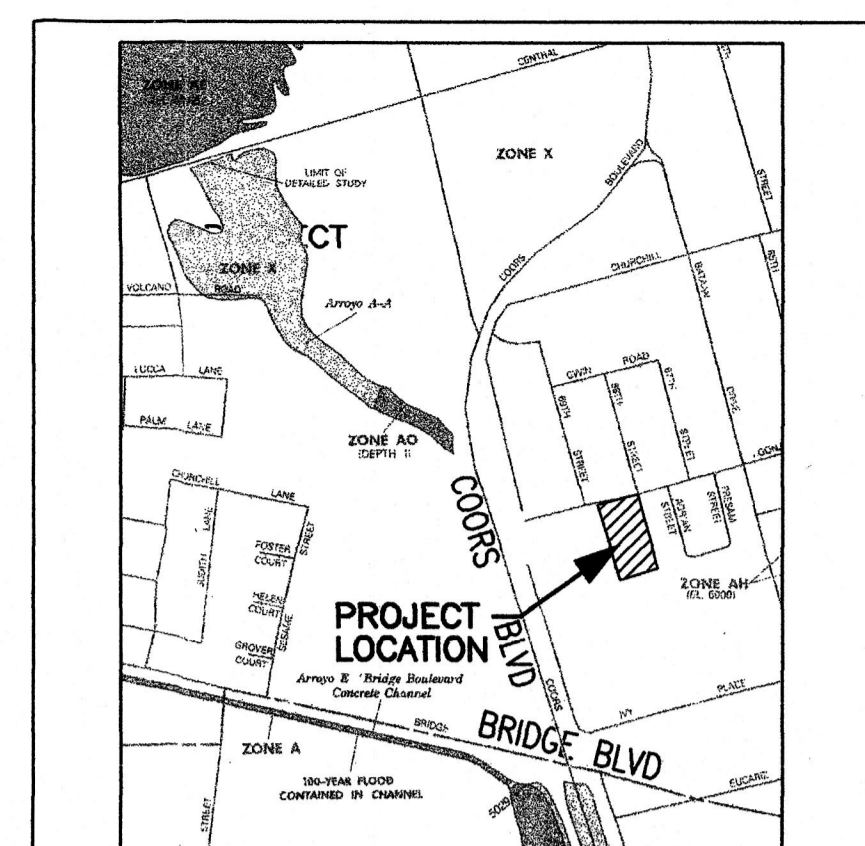

FIRM MAP 35001C0329D
SCALE: N.T.S.

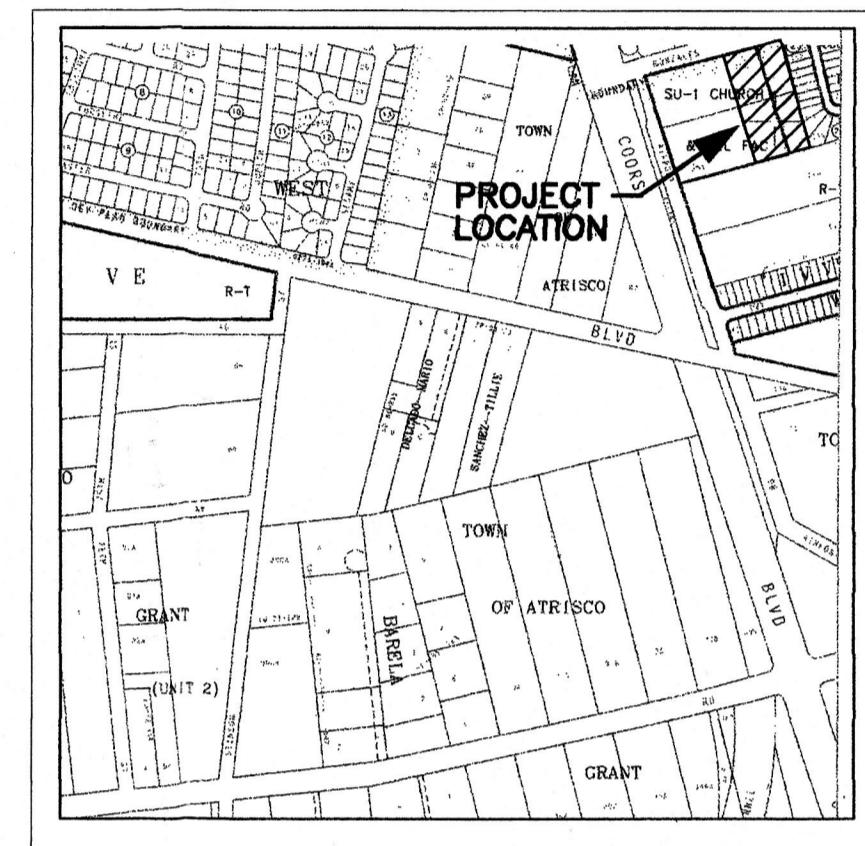

VICINITY MAP L-10
SCALE: N.T.S.

LEGEND

- 5360 NEW CONTOUR GRADE
- 5362 EXISTING CONTOUR GRADE
- 33.0% AS-BUILT NEW TOP OF CURB ELEVATION
- 33.0% AS-BUILT NEW FLOWLINE OF CURB ELEVATION
- TABO.11 NEW TOP OF ASPHALT ELEVATION
- TSW61.67 NEW TOP OF SIDEWALK ELEVATION
- ORANGE SHALE
- NEW GRADE BREAK
- PR 5324.45 EXISTING GRADE ELEVATION
- GR56.0 NEW GRADE ELEVATION
- FL55.3 FLOWLINE GRADE ELEVATION
- TW62.50 NEW TOP OF WALL ELEVATION
- FF-56.30 NEW FINISH FLOOR ELEVATION
- 27.3 AS-BUILT ELEV.

UTILITY PRECAUTIONS

THE CONTRACTOR SHALL INFORM ITSELF OF THE LOCATION OF ANY UTILITY LINE, PIPELINE, OR UNDERGROUND UTILITY LINE IN OR NEAR THE AREA OF THE WORK IN ADVANCE OF AND DURING EXCAVATION WORK. THE CONTRACTOR IS FULLY RESPONSIBLE FOR ANY AND ALL DAMAGE CAUSED BY ITS FAILURE TO LOCATE, IDENTIFY AND PRESERVE ANY AND ALL EXISTING UTILITIES, PIPELINES, AND UNDERGROUND UTILITY LINES. IN PLANNING AND CONDUCTING EXCAVATION, THE CONTRACTOR SHALL COMPLY WITH STATE STATUTES, MUNICIPAL AND LOCAL ORDINANCES, RULES AND REGULATIONS, IF ANY, PERTAINING TO THE LOCATION OF THESE LINES AND

APPLIED ENGINEERING AND SURVEYING, INC.
CIVIL ENGINEERING, LAND SURVEYING, PLANNING AND SURVEYING

1605 Blair Drive NE Albuquerque, New Mexico 87112
Office: (505) 460-8125 Facsimile: (505) 237-8164
email: galdaz17@yahoo.com

OWNERSHIP OF INSTRUMENTS OF SERVICE
All design concepts, details, specifications, plans, computer files, field data, notes and other documents and instruments prepared by Applied Engineering Inc. as instruments of service shall remain the property of Applied Engineering Inc. shall retain all common law, statutory and other reserved rights, including the copyright thereto.

CONSULTANTS

PROFESSIONAL SEAL



LA PROMESSA CHARTER SHOOL
ALBUQUERQUE, NEW MEXICO

MARK	DATE	DESCRIPTION

PROJECT NUMBER: 090800
DRAWING FILE:
DRAWN BY:
CHECK BY:
COPYRIGHT:
DATE: JULY 24, 2009

SHEET TITLE
PROPOSED GRADING/DRAINAGE IMPROVEMENTS

SHEET NUMBER
C-101