

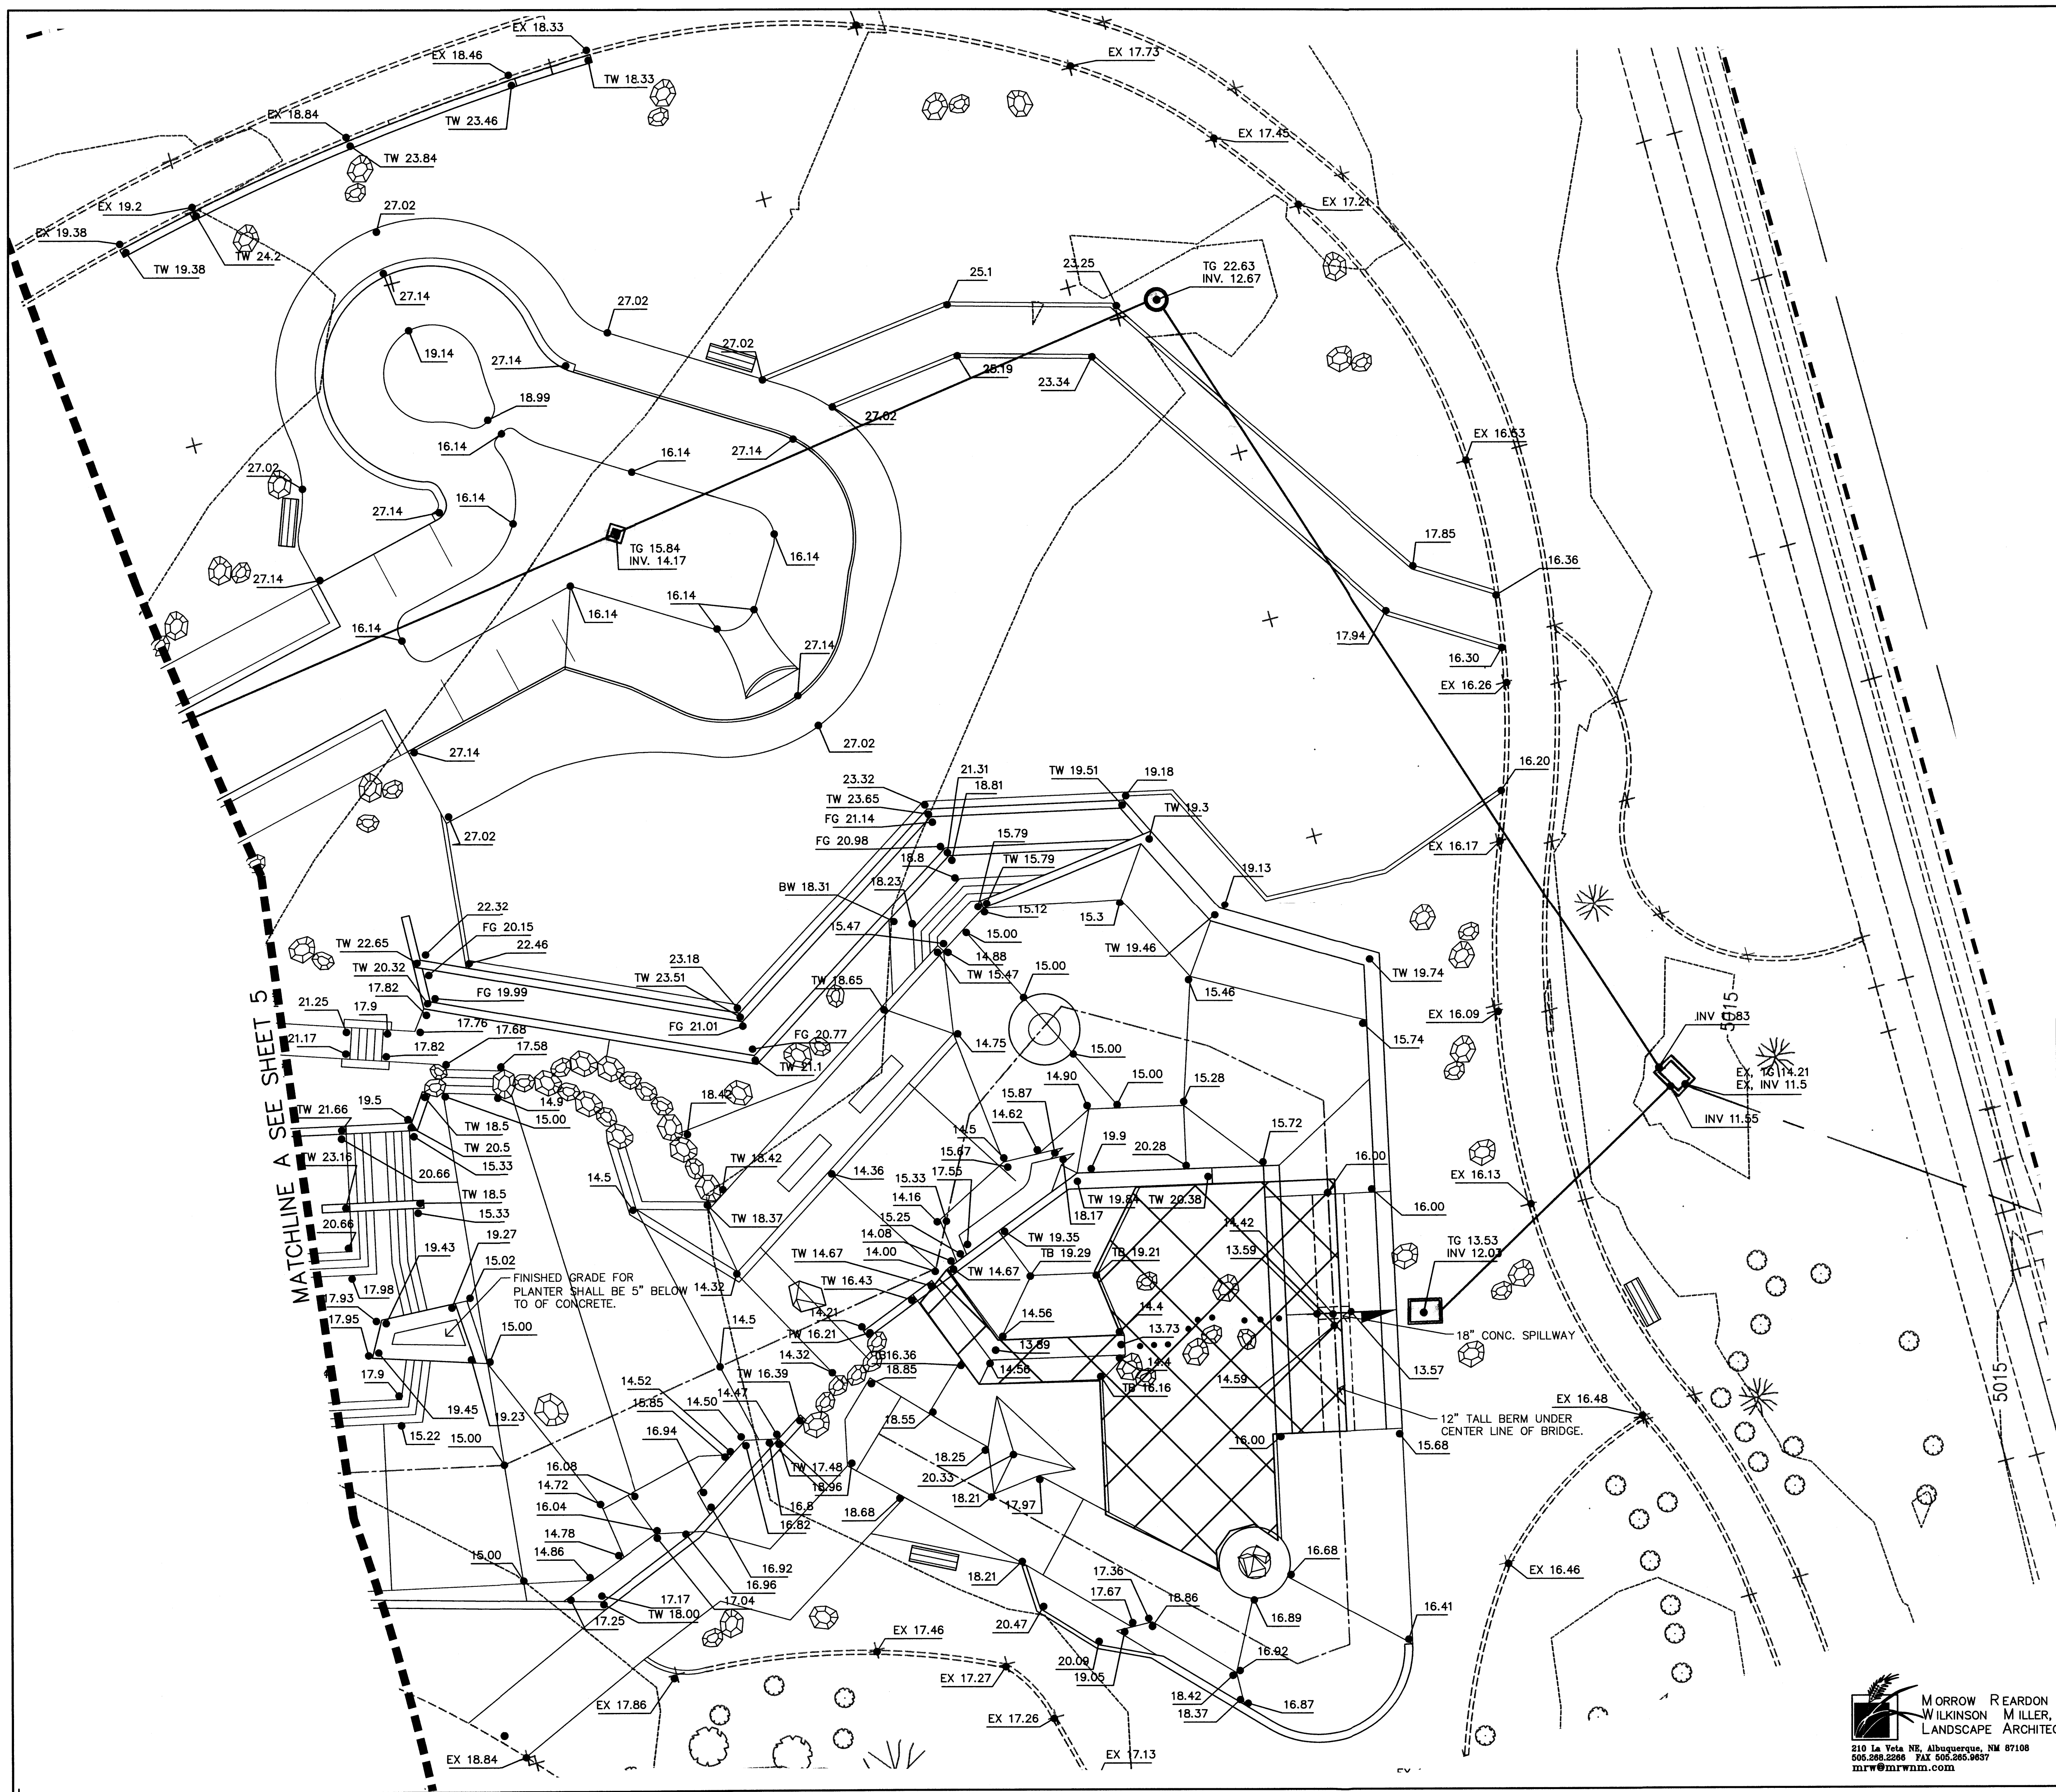


MORROW REARDON
WILKINSON MILLER, LTD.,
LANDSCAPE ARCHITECTS

210 La Veta NE, Albuquerque, NM 87108
505.268.2286 FAX 505.265.9637
mrw@mrwnm.com

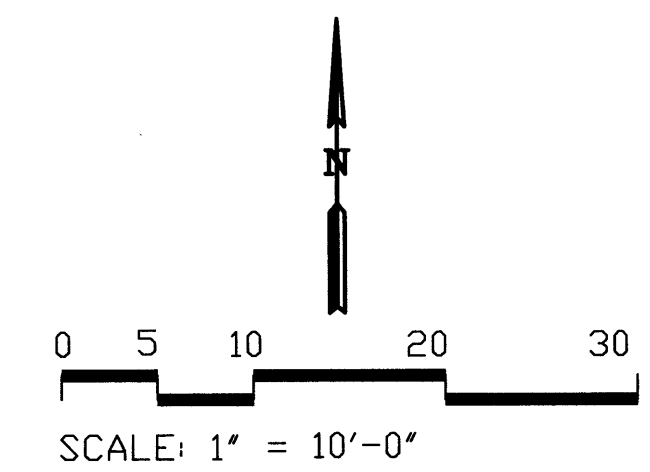

LEGEND	
KEY	DESCRIPTION
BW	BOTTOM OF WALL
EX	EXISTING ELEVATION
INV	INVERT
SD	EXISTING STORM DRAIN
SI	STORM INLET
TC	TOP OF CONCRETE
TG	TOP OF GRATE
TW	TOP OF WALL

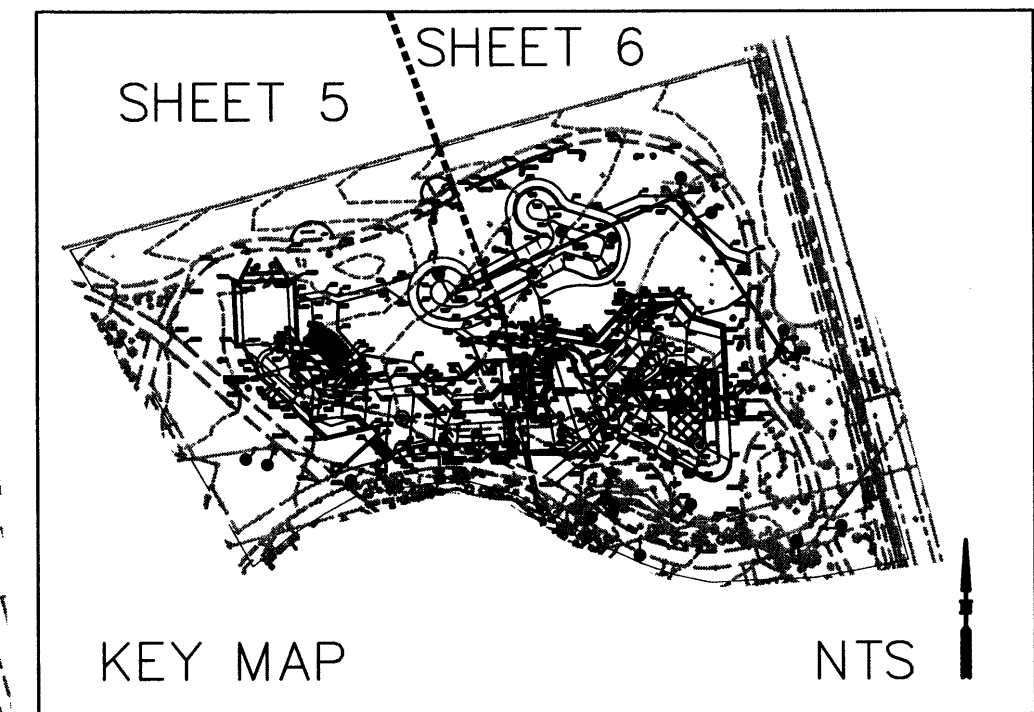


MORROW REARDON
WILKINSON MILLER, LTD.,
LANDSCAPE ARCHITECTS
210 La Veta NE, Albuquerque, NM 87108
505.265.2286 FAX 505.265.9837
mrw@mrwm.com

CITY OF ALBUQUERQUE DEPARTMENT OF MUNICIPAL DEVELOPMENT	
TITLE: WESTSIDE SKATE PARK - PHASE 1-A GRADING PLAN	
Design Review Committee	City Engineer Approval
City Project No. XXXXX	Zone Map No. K & L-11-Z
Last Design Update	
Sheet 6 of 11	

NO.		DATE	REVISIONS /	REMARKS	BY	SEAL	SURVEY INFORMATION		BENCHMARK	AS BUILT INFORMATION	
							FIELD NOTES				
							NO.	BY	DATE		





HYDROLOGY SECTION
AUG 8 2005

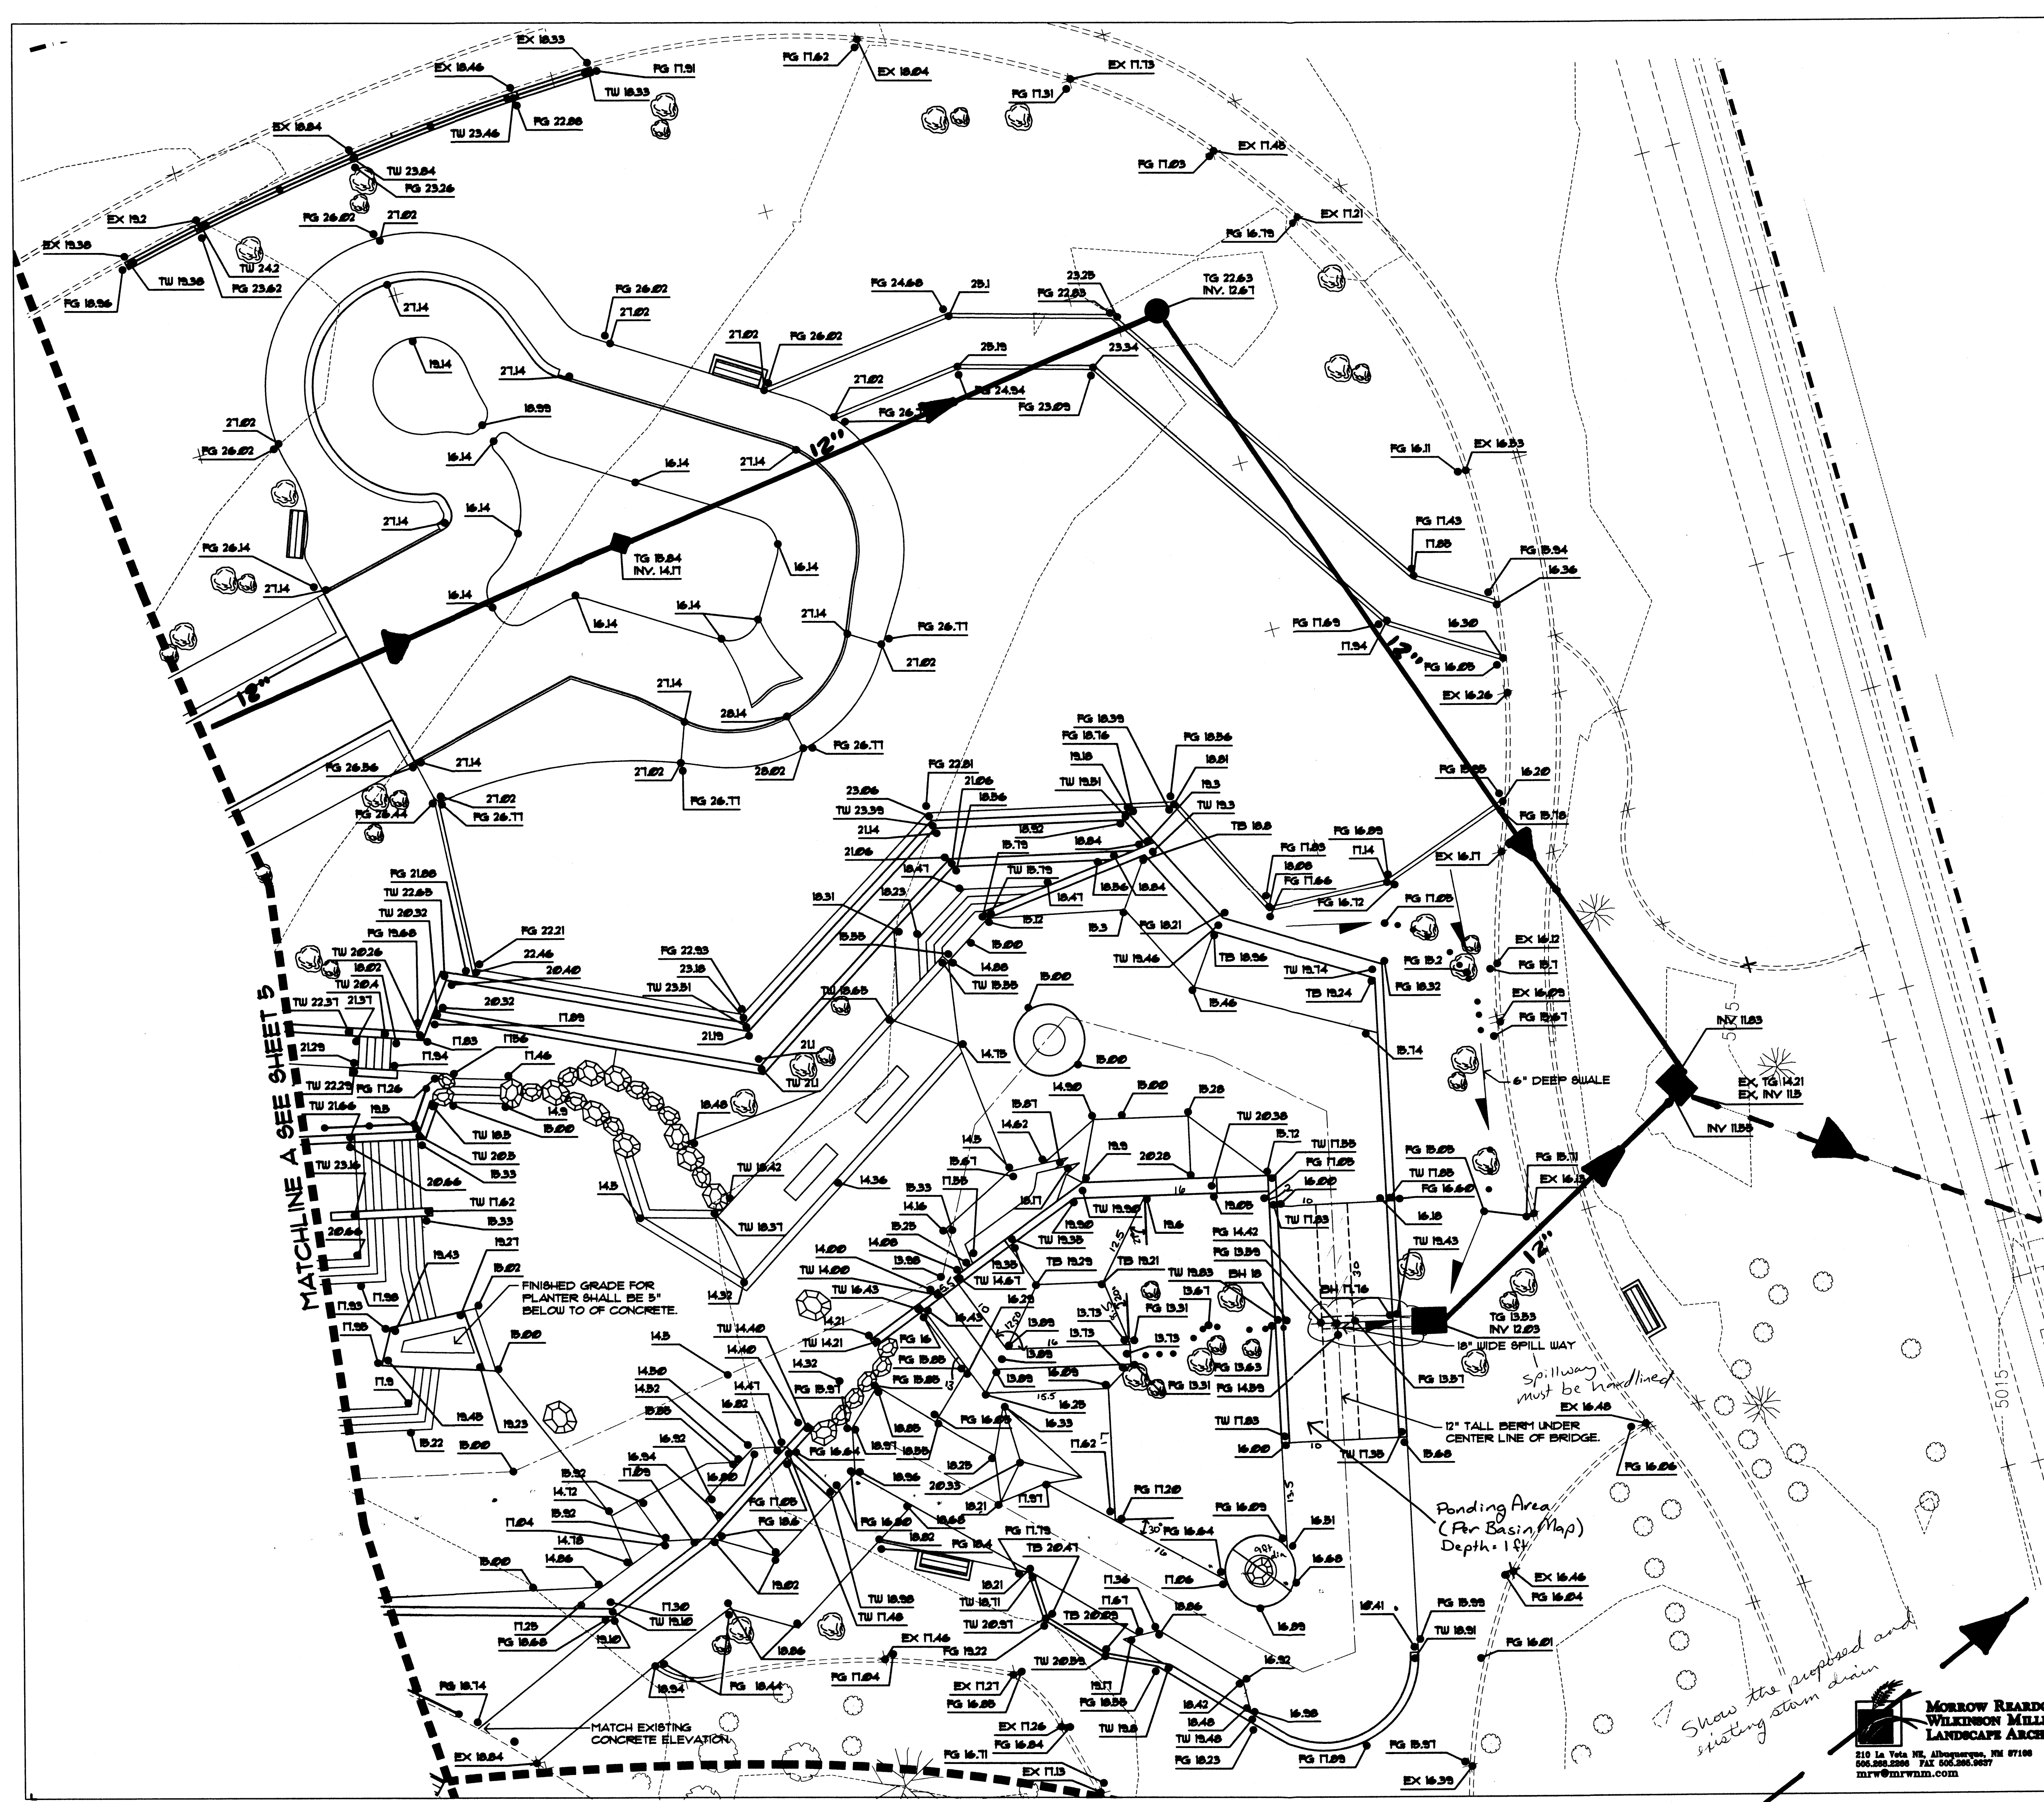

LEGEND

KEY	DESCRIPTION
EX	EXISTING ELEVATION
INV	INVERT
SD	EXISTING STORM DRAIN
SI	STORM INLET
TG	TOP OF GRATE
TW	TOP OF WALL
BH	BRIDGE HIGH POINT
TB	TOP OF BANK
FG	FINISH GRADE

NOTE:
1. PG IN THE ELEVATION OF GRADE PRIOR TO APPLICATION OF MULCH OR SOD.
2. SPOT ELEVATION THAT DO NOT HAVE A KEY INDICATION SHALL BE TOP OF CONCRETE.

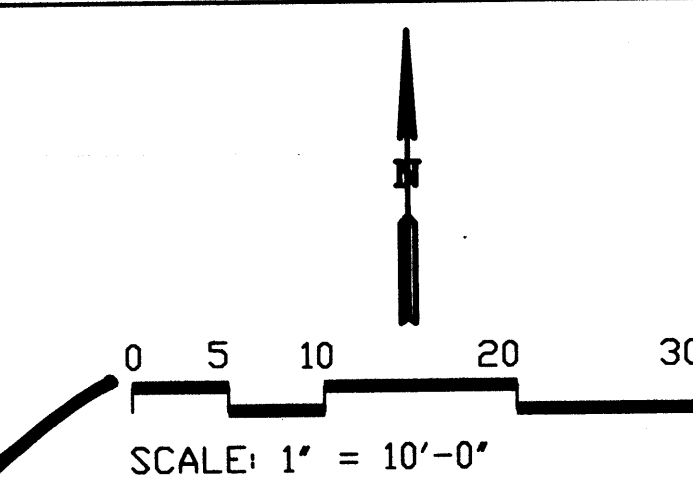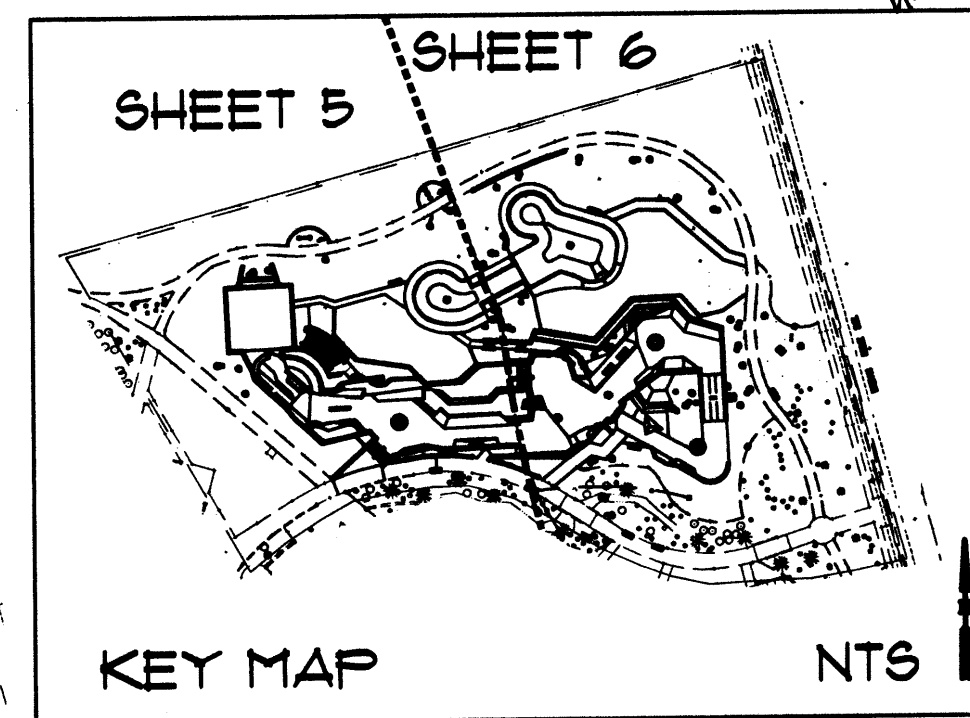

**CITY OF ALBUQUERQUE
DEPARTMENT OF MUNICIPAL DEVELOPMENT**

**TITLE: WESTSIDE SKATE PARK - PHASE 1-A
GRADING PLAN**

Design Review Committee	City Engineer Approval	MO/DATE/YR	MO/DATE/YR

City Project No. **704501** Zone Map No. **K & L-11-Z**

Sheet **6** Of **12**

JUL 18 2005

HYDROLOGY SECTION

AS BUILT INFORMATION		BENCHMARK		SURVEY INFORMATION		FIELD NOTES		REVISIONS / REMARKS		NO. DATE	
CONTRACTOR	DATE:	ACS STATION	"2-110", 1989. THE STATION IS IN THE SOUTHEAST QUADRANT OF THE INTERSECTION OF COORS BLVD. AND BRIDGE IN THE NORTHWEST NOSE OF A TRAFFIC ISLAND. ELEVATION 5053.25 FEET	NO.	BY	DATE	NO.	DATE	REVISIONS / REMARKS	NO.	DATE
WORK STAKED BY	DATE:										
INSPECTOR'S APPROVAL	DATE:										
FIELD VERIFICATION BY	DATE:										
DRAWING CORRECTED BY	DATE:										
MICRO-FILM INFORMATION	DATE:										
RECORDED BY	NO.										

DESIGNED BY: JSP DATE: JUNE 20, 2005

DRAWN BY: JSP DATE: JUNE 20, 2005

CHECKED BY: GN DATE: JUNE 20, 2005

SEAL OF THE STATE OF NEW MEXICO


REGISTERED LANDSCAPE ARCHITECT

6/20/05


MORROW REARDON
WILKINSON MILLER, LTD.
LANDSCAPE ARCHITECTS

210 La Vista NE, Albuquerque, NM 87108
505.260.2200 FAX 505.260.2657
mlw@mrmw.com

EXISTING BASINS

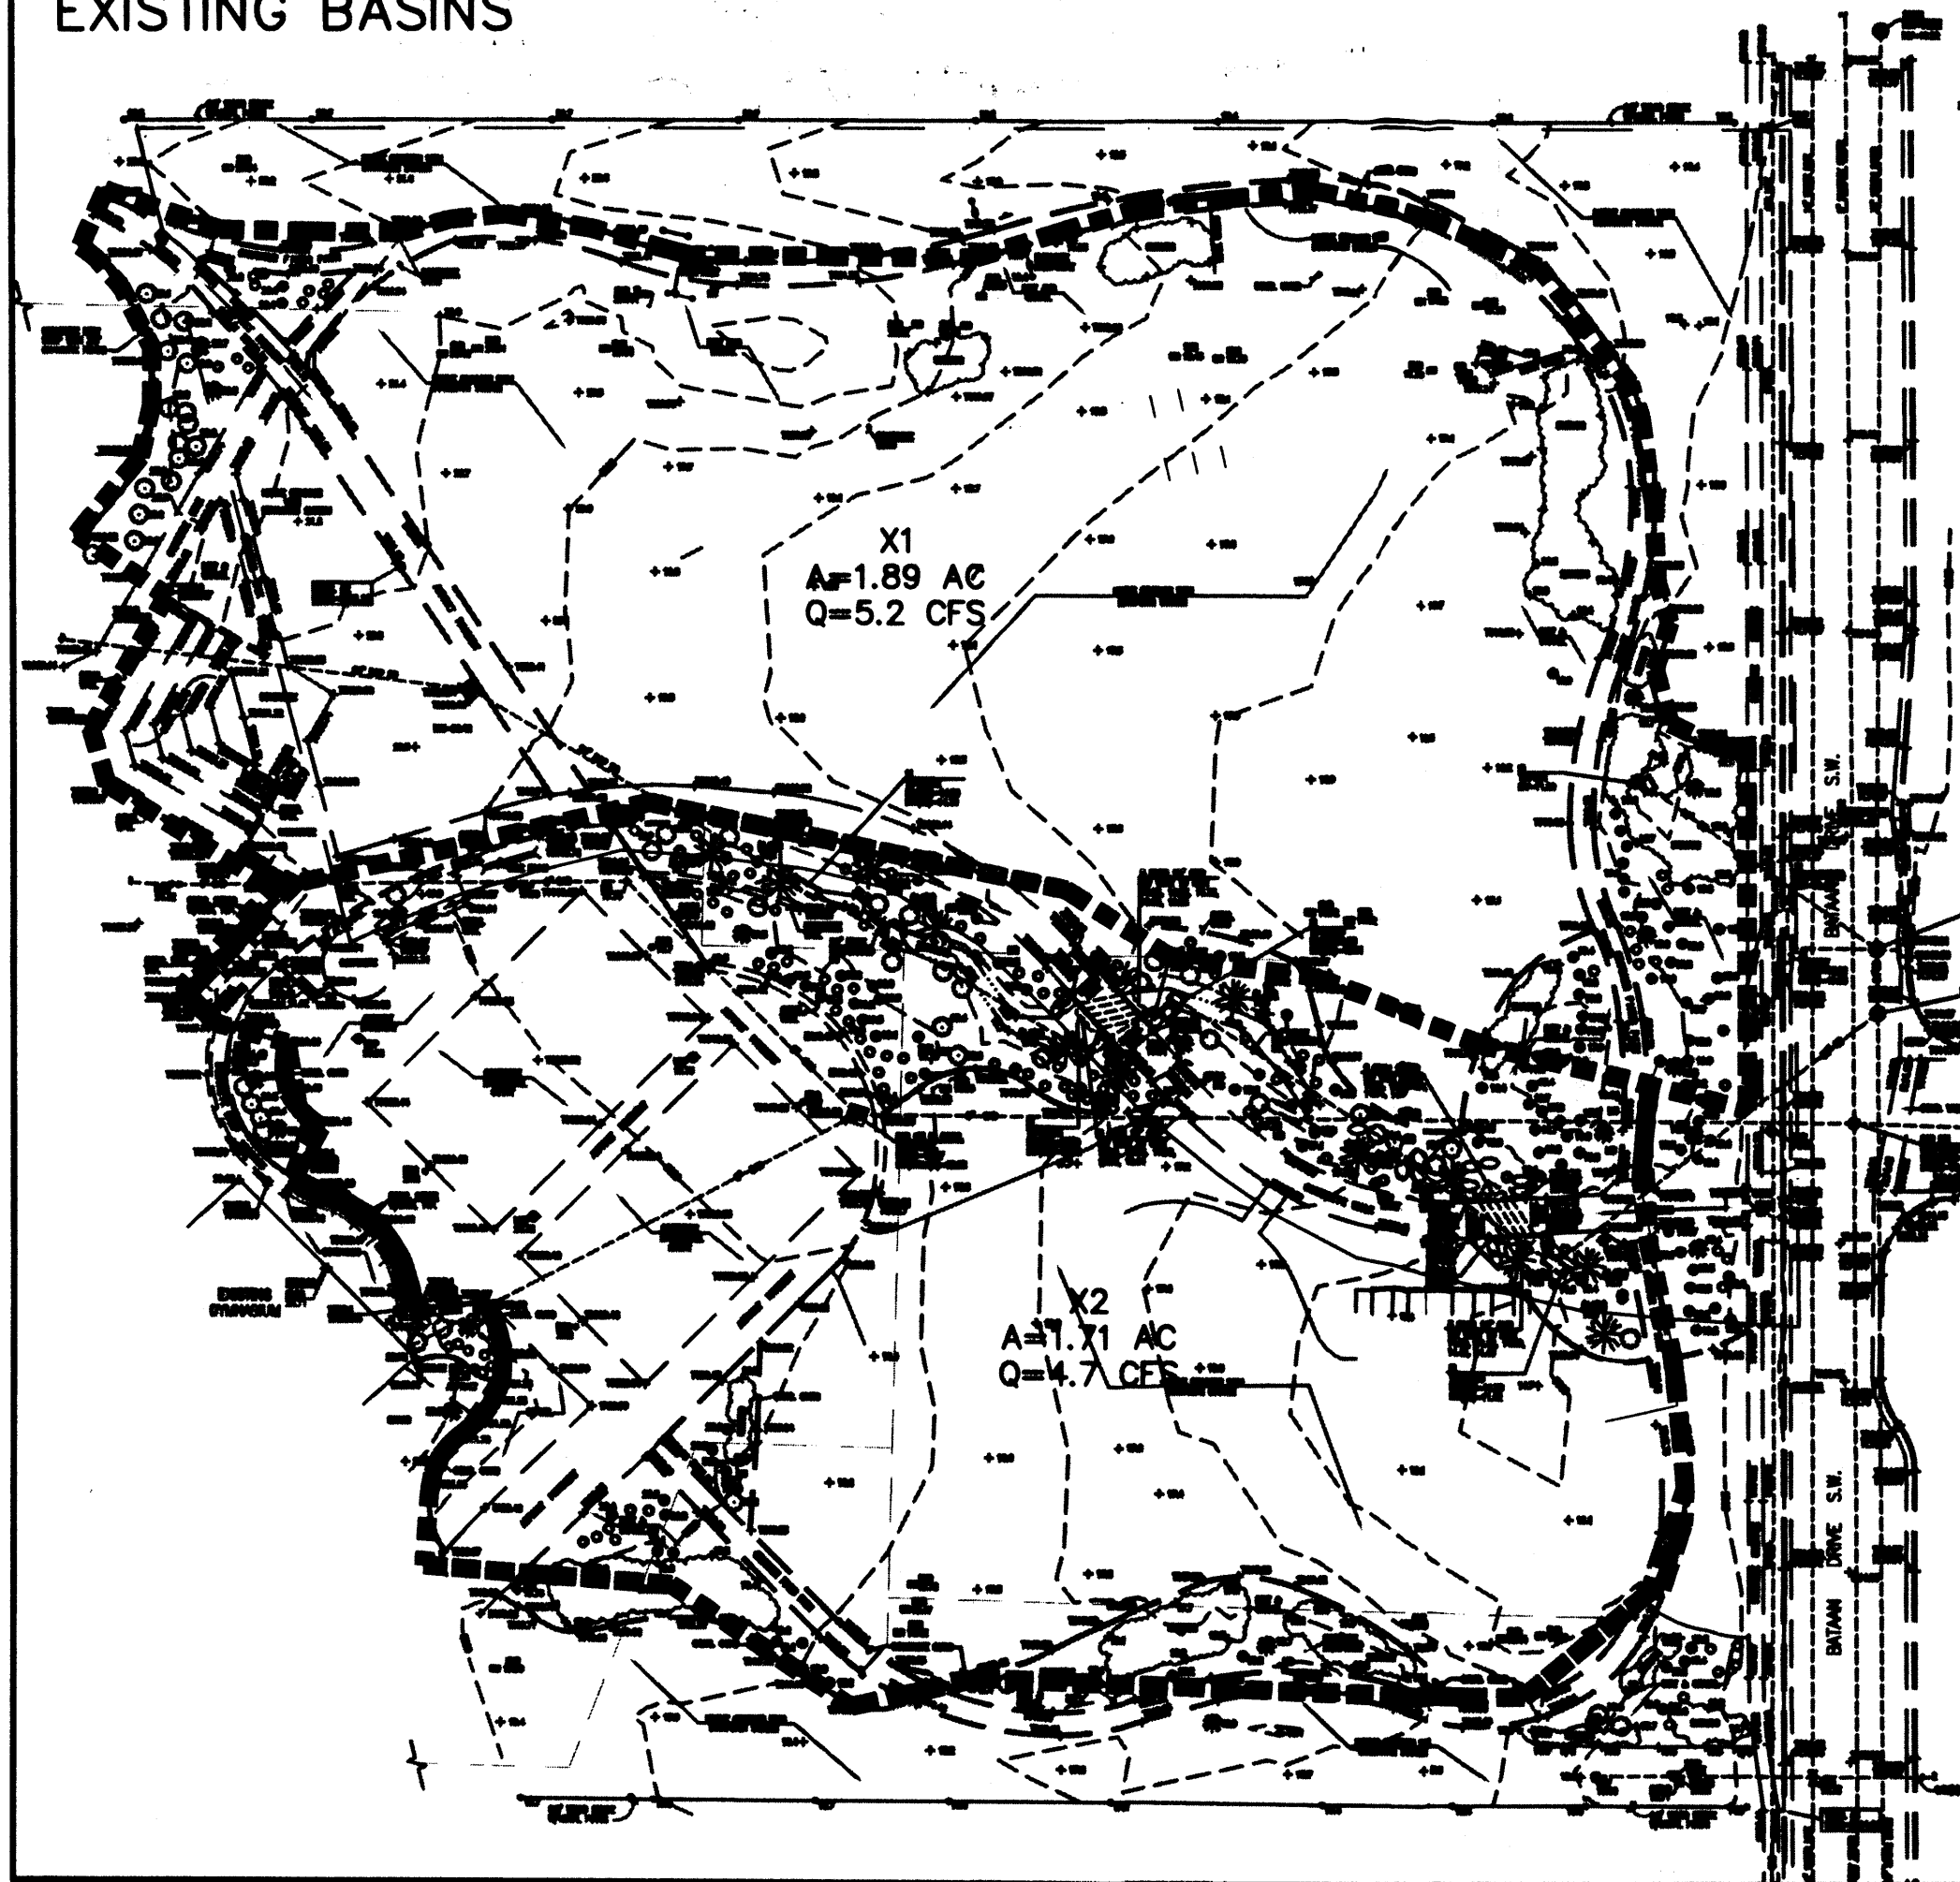

PROPOSED BASINS

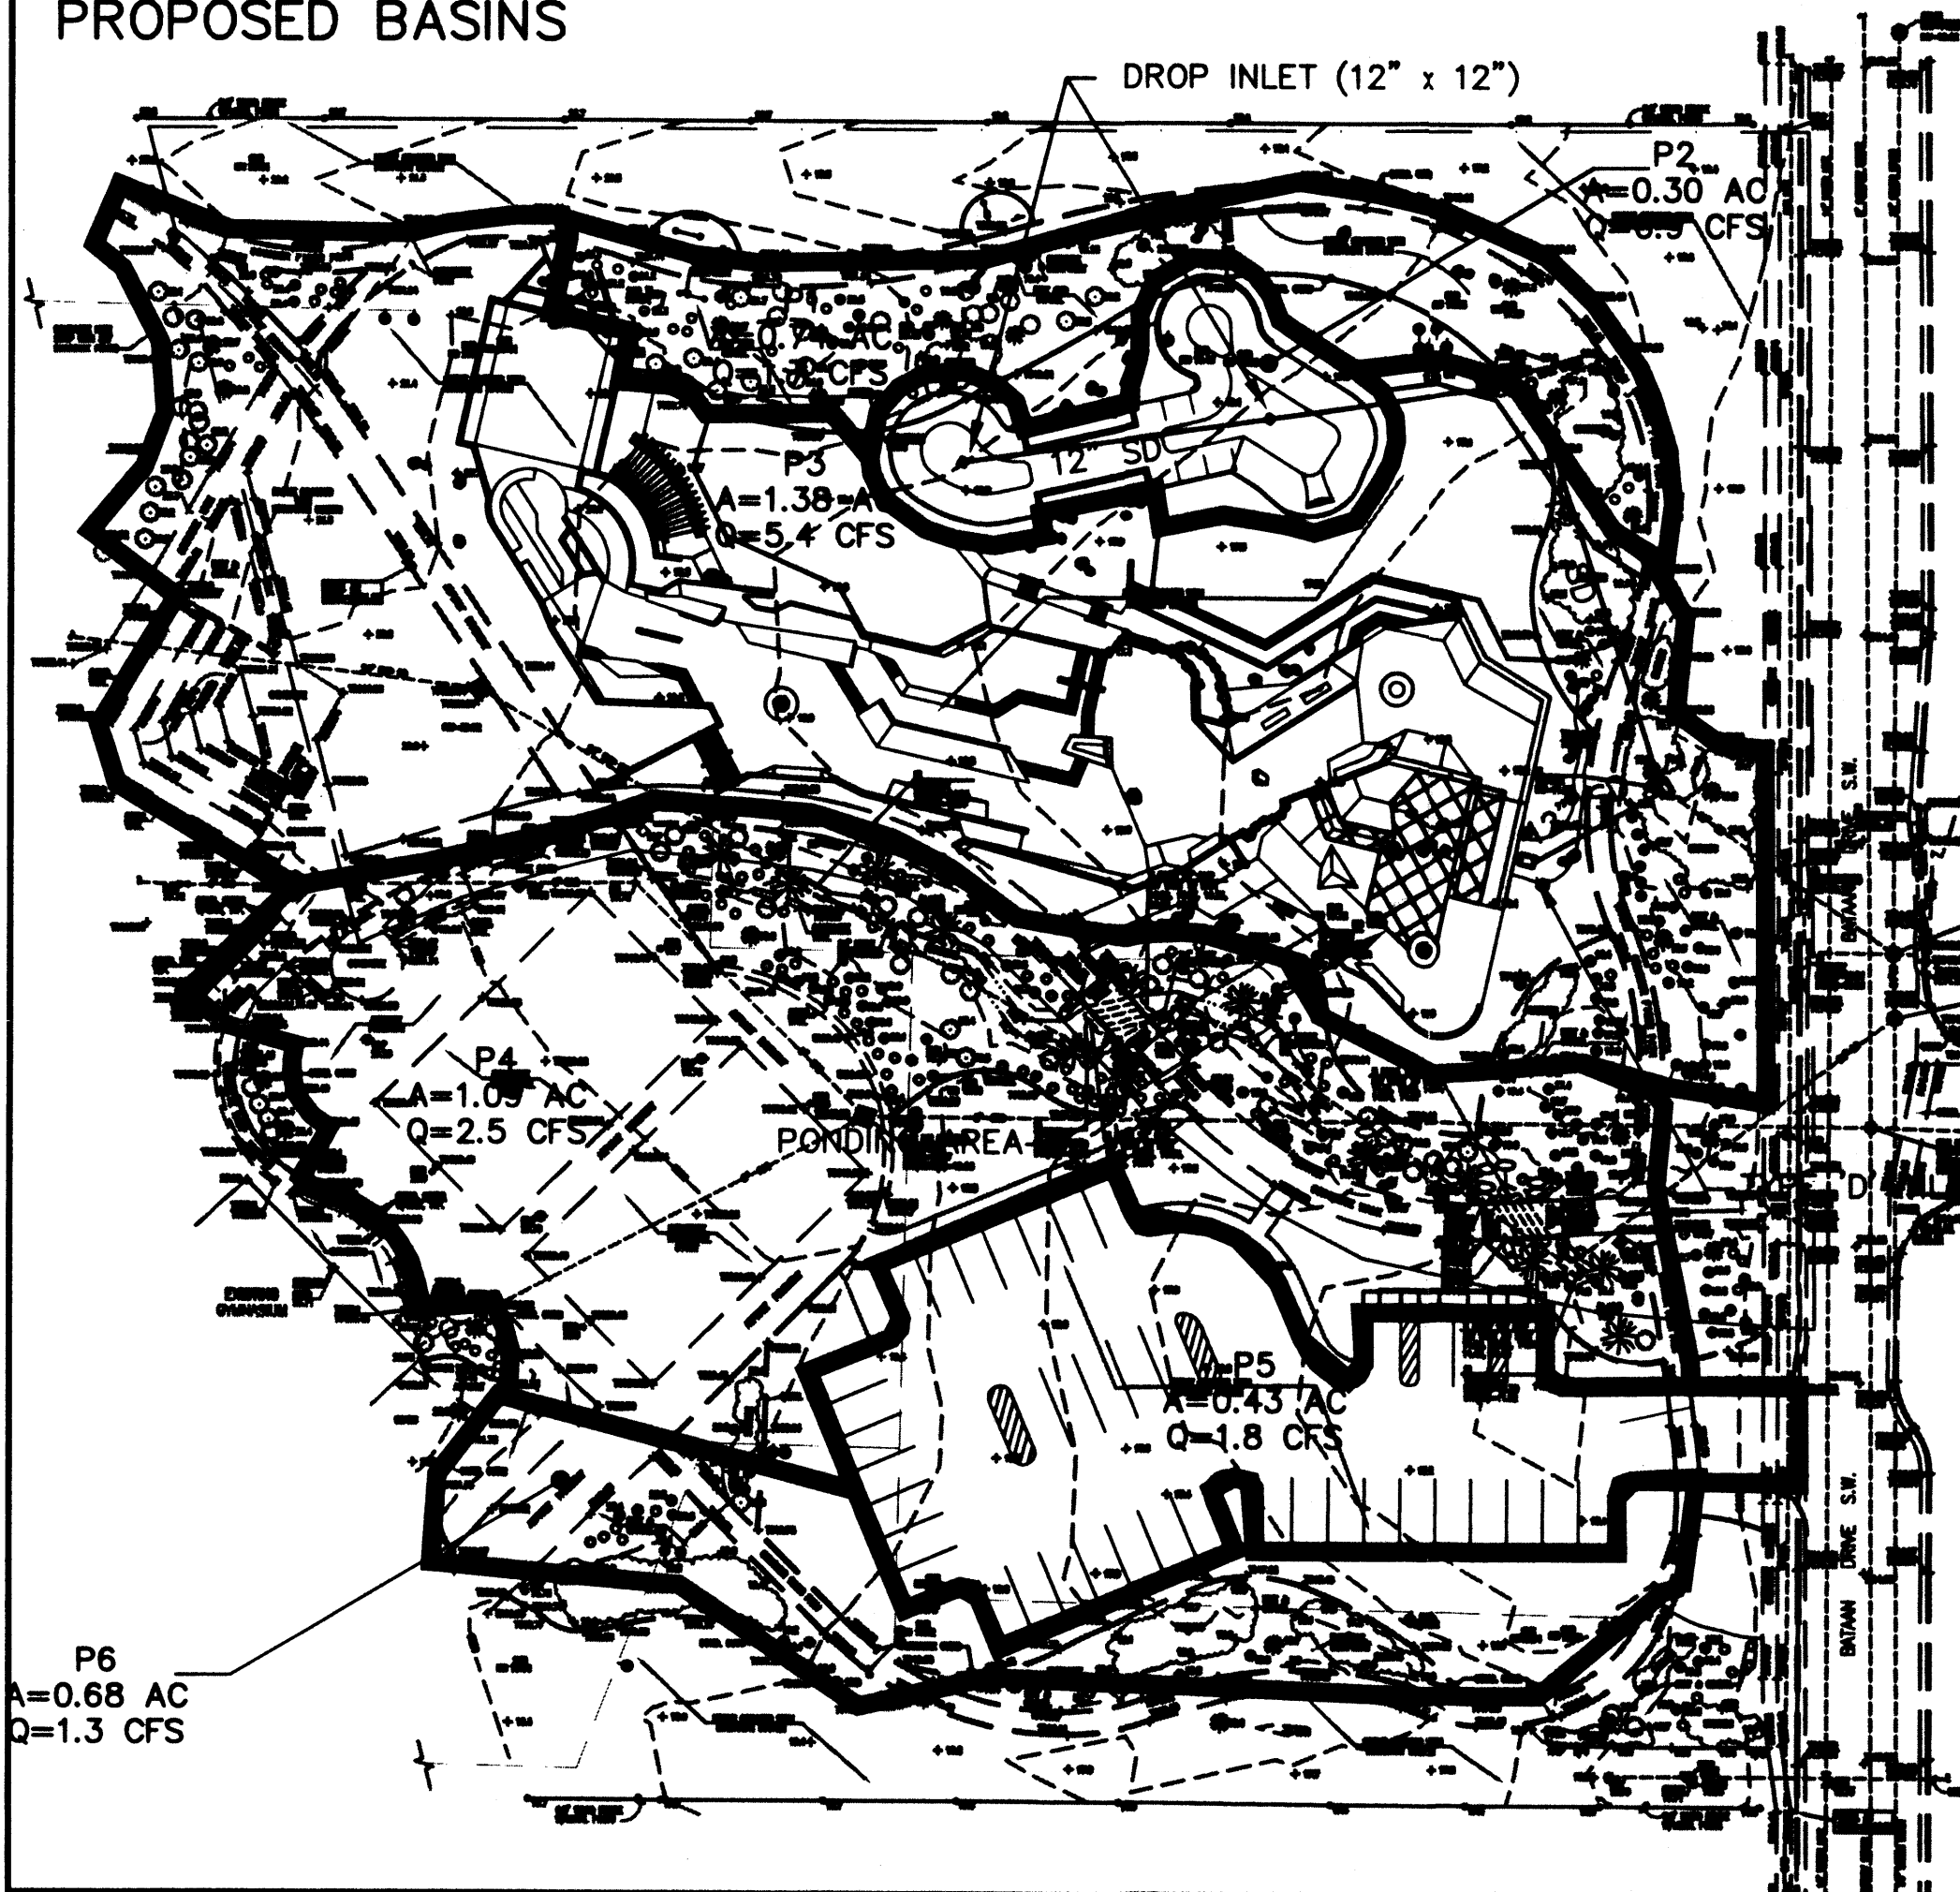

DRAINAGE REPORT

Site Location: The Alamosa Community Center and Skate Park is a 3.6 acre property located in southwest Albuquerque, NM, bordered by Coors Boulevard to the west, Gonzales Road to the north, Ivy Place to the south, and Bataan Drive to the east. This drainage report assumes full build of the skate park facility and accompanying landscaping improvements; however, actual construction of the project will occur in two phases. Phase I will include the skate park and associated landscaping improvements, while Phase II will include the parking lot, concession facilities, and associated landscaping improvements. This report seeks approval only for Phase I computations, though Phase II conditions and computations have been included for information.

Methodology: Section 22.2 of the City of Albuquerque DPM was followed to calculate design flows. The procedure in Part A, for 40 acre or smaller basins, was followed using the 100-year, 24-hour storm event frequency. All basins were delineated using AutoCAD software to determine areas. The site is located in Zone 1, west of the Rio Grande, as designated in Table A-1. The basis of this drainage report is the Alamosa Community Center Drainage Report (1995) by Jeff Mortenson and Associates (hereafter Reference 1).

Existing Conditions: The existing topography of the site is relatively flat with some areas of local ponding, sloping slightly to the east-southeast with slopes typically less than 1.5%. The site also contains concrete and asphalt site work from existing facilities. Runoff from existing infrastructure to the west discharges to an existing storm drain system, and existing slopes of the land are such that offsite flows do not enter the project site. Onsite areas are currently drained by an existing 24" to 30" storm drain system with five (5) median drop inlets which convey flow into the 54" storm drain in Bataan Road.

Hydrologic Analysis Basins X1 and X2 delineate the existing drainage boundary. It should be noted that Basin X2 does not contribute to Phase I improvements. The existing drainage boundary is approximately 3.6 acres and is made up of asphalt paving, concrete site work, and vegetated area with mature trees. Basin X1 at the north portion of the site drains via an existing swale to an existing drop inlet at the east portion of the site. Basin X2 drains to one of four (4) median drop inlets along a swale. Peak discharge rates for watersheds smaller than 40 acres may be computed using the Rational Method, $Q_P = C i A$ (ft³/s), where Q_P is the peak discharge, i is the 12-minute peak intensity, C is the rational coefficient, and A is the area in acres.

For Zone 1, values of C are 0.27 for land treatment A, 0.43 for land treatment B, 0.61 for land treatment C, and 0.93 for land treatment D. The value of i is 4.70 inches/hour. Pre-development peak discharge is computed as follows:
 Basin X1 = $[(0.27)(4.70 \text{ in/hr})(0.85 \text{ acres}) + (0.43)(4.70 \text{ in/hr})(0.19 \text{ acres}) + (0.61)(4.70 \text{ in/hr})(.66 \text{ acres}) + (0.93)(4.70 \text{ in/hr})(0.19 \text{ acres})] = 4.2 \text{ ft}^3/\text{s}$
 Basin X2 = $[(0.27)(4.70 \text{ in/hr})(0.51 \text{ acres}) + (0.43)(4.70 \text{ in/hr})(0.09 \text{ acres}) + (0.61)(4.70 \text{ in/hr})(0.09 \text{ acres}) + (0.93)(4.70 \text{ in/hr})(1.03 \text{ acres})] = 5.6 \text{ ft}^3/\text{s}$

Proposed Conditions: Under proposed conditions (both Phases) miscellaneous buildings, a skate park, and parking lot will be constructed at the site. Phase I improvements will consist of the skate park and associated landscaping improvements; Phase II will consist of the parking area, concession facilities, and associated landscaping improvements. Runoff from the proposed site will continue to discharge to the existing storm drain system. Existing flow patterns (existing swales, drop inlets, etc.) will be maintained to the extent possible, although additional drop inlets will be constructed to facilitate drainage. Additional storm drain inlets will tie into the existing system, either directly into existing inlets, or with new manholes. Per Reference 1, this drainage report assumes adequate capacity in the Bataan Drive storm drain system at full build per the Sunset Gardens Master Plan Drainage Study.

Hydrologic Analysis Basins P1 through P3 represent proposed conditions for Phase I. Basins P4 through P6 represent proposed conditions for Phase II. Basins P1 and P6, at the north and south portions of the site, will contain landscaping improvements only and will continue to discharge to existing infrastructure, as under existing conditions. Basin P2 is a skate park bowl structure, and will be predominately land treatment 'D'. Basin P3 will contain the remainder of the skate park structures with landscaping. Drainage will be facilitated by new drop inlets. Basin P4 will contain landscaping improvements only, and Basin P5 contains the parking area. Drainage improvements for Phase II basins, P4 through P6, have not been finalized at this point. Proposed flows are computed in the same manner as presented above. In addition, the values of C and i are unchanged.

Basin P1 = $[(0.27)(4.70 \text{ in/hr})(0.27 \text{ acres}) + (0.93)(4.70 \text{ in/hr})(0.01 \text{ acres})] = 0.4 \text{ ft}^3/\text{s}$
 Basin P2 = $[(0.61)(4.70 \text{ in/hr})(0.01 \text{ acres})] + [(0.93)(4.70 \text{ in/hr})(0.14 \text{ acres})] = 0.6 \text{ ft}^3/\text{s}$
 Basin P3 = $[(0.27)(4.70 \text{ in/hr})(0.29 \text{ acres}) + (0.61)(4.70 \text{ in/hr})(0.44 \text{ acres}) + (0.93)(4.70 \text{ in/hr})(0.74 \text{ acres})] = 4.9 \text{ ft}^3/\text{s}$
 Basin P4 = $[(0.27)(4.70 \text{ in/hr})(0.54 \text{ acres}) + (0.93)(4.70 \text{ in/hr})(0.44 \text{ acres})] = 2.6 \text{ ft}^3/\text{s}$
 Basin P5 = $[(0.61)(4.70 \text{ in/hr})(0.02 \text{ acres}) + (0.93)(4.70 \text{ in/hr})(0.39 \text{ acres})] = 1.8 \text{ ft}^3/\text{s}$
 Basin P6 = $[(0.27)(4.70 \text{ in/hr})(0.25 \text{ acres}) + (0.43)(4.70 \text{ in/hr})(0.01 \text{ acres}) + (0.93)(4.70 \text{ in/hr})(0.03 \text{ acres})] = 0.5 \text{ ft}^3/\text{s}$

EXISTING BASIN SUMMARY

Basin	Total	A		B		C		D		Peak Discharge
	Area (Ac)	%	Ac	%	Ac	%	Ac	%	Ac	(cfs)
X1	1.887	45	0.85	10	0.19	35	0.66	10	0.19	4.2
X2*	1.709	30	0.51	5	0.09	5	0.09	60	1.03	5.6
Σ=	3.596		1.36		0.27		0.75		1.21	9.8

PROPOSED BASIN SUMMARY

Basin	Total Area	A		B		C		D		Peak Discharge, CFS
		%	Ac	%	Ac	%	Ac	%	Ac	
P1	0.282	95	0.27	0	0.00	0	0.00	5	0.01	0.4
P2	0.151	5	0.01	0	0.00	0	0.00	95	0.14	0.6
P3	1.471	20	0.29	0	0.00	30	0.44	50	0.74	4.9
P4*	0.985	55	0.54	0	0.00	0	0.00	45	0.44	2.6
P5*	0.413	0	0.00	0	0.00	5	0.02	95	0.39	1.8
P6*	0.294	85	0.25	5	0.01	0	0.00	10	0.03	0.5
Σ=	3.596	1.36		0.01		0.46		1.76		10.8
Phase I only:	1.904	0.57		0.00		0.44		0.89		5.9

*Denotes basins NOT associated with Phase I improvements

Detention Pond: The area upstream of the pedestrian bridge in Basin P3 will serve as a detention pond, and was sized following an assumed triangular inflow hydrograph and trapezoidal outflow hydrograph procedure. Values for excess precipitation, E , for the 100-year, 6-hour storm in Zone 1 are given in Table A-8. For the 100-year, 10-day storm, the required ponding area is approximately 0.0311 acre-ft. The ponding area is 1360 ft³ (0.0312 acre-ft) therefore, water depth in the pond will be 1.0 ft. Discharge will be limited to Qallowable, 3.2 cfs. Pond calculations are as follows:

Given: $AC = 1.471$ acres; $E = 1.37$ inches; $(Q_P)P3 = 4.9$ cfs; $(Q_P)X1 = 4.2$ cfs; $(Q_P)\text{proposed} = 5.9$ cfs

Find: Volumetric runoff for the 100-year, 6-hour storm, V360, and the 100-year, 10-day storm, V10day

Soln:

Step 1, Compute V360 = Weighted $E \cdot A_{\text{total}} = (1.37 \cdot 1.471)/12 = 0.168$ acre-ft

Step 2, Compute V10day = $V360 + (AD \cdot (P_{10\text{day}} - P_{360}))/12 = 0.168 + (0.74 \cdot (3.67 - 2.20))/12 = 0.2580$ acre-ft

Step 3, Compute Qallowable = $(Q_P)P3 - [(Q_P)X1 - (Q_P)\text{proposed}] = [4.9 \text{ cfs} - (5.9 \text{ cfs} - 4.2 \text{ cfs})] = 3.2 \text{ cfs}$

Step 4, Compute base, t_D , of triangular inflow hydrograph $\rightarrow Vt = \frac{1}{2} t_D Q_P \rightarrow t_D = (2 \cdot Vt)/Q_P = (2 \cdot 0.258 \text{ ac-ft})/4.9 \text{ cfs} = (0.0874 \text{ ac-ft-cfs})/[(43560 \text{ ft}^2/\text{acre})/(3600 \text{ sec/hr})] = 1.2742 \text{ hr}$

Step 5, Compute slope of rising limb of hydrograph = $4.9 \text{ cfs}/0.6371 \text{ hr} = 7.691 \text{ cfs/hr}$

Step 6, Compute intercepts at Qallowable (3.2 cfs)

a. $= 4.2/(7.691 \text{ cfs/hr}) = 0.42 \text{ hr}$

b. $= 1.2742 \text{ hr} - 0.42 \text{ hr} = 0.86 \text{ hr}$

Step 7, Compute required storage = $\frac{1}{2} b h = \frac{1}{2} \cdot (4.9 - 3.2 \text{ cfs}) \cdot (0.86 - 0.42 \text{ hr}) \cdot (3600 \text{ sec/hr}) = 1353 \text{ ft}^3 = 0.0311 \text{ acre-ft}$

Step 8, Compute weir equation to verify $Q_w \leq Q_{\text{allow}} = 3.2 \text{ cfs} = C_w \cdot L \cdot H^{1.5}$

$L = 3.2 \text{ cfs} / [(3.0) \cdot (1 \text{ ft})^{1.5}] = 1.1 \text{ ft}$. For 18" trapezoidal weir, $L_{\text{avg}} = 1.5 / 2 = 0.75 \text{ ft}$

Drop Inlet & Hydraulics Computations: Three new drop inlets are proposed for Phase I improvements, including 2-12"x12" drop inlets at the skate park bowl structure (Basin P2), and 1-Type "D" area inlet near the pedestrian bridge (Basin P3). Drop inlet capacities assume orifice flow, 50% reduction in opening area due to bars, and 50% clogging. All proposed pipes were checked to verify a minimum velocity of 3 fps. Pipe computations were verified using FlowMaster software.

Per the orifice equation, $Q = C_o A \sqrt{2gd}$

Where: C_o = orifice coefficient (0.67);

g = gravitational constant (32.2 ft/sec²);

A = opening area (ft²);


d = ponding depth (ft)

12"x12" Grate Inlet: $Q = 0.67 \cdot 0.5 \cdot 0.5 \cdot (1 \text{ ft})^2 \cdot (2 \cdot 32.2 \text{ ft/sec}^2 \cdot 0.5 \text{ ft})^{1/2} = 0.95 \text{ cfs}$

Type "D" Grate Inlet: $Q = 0.67 \cdot 0.5 \cdot 0.5 \cdot (2 \text{ ft})^2 \cdot (2 \cdot 32.2 \text{ ft/sec}^2 \cdot 0.5 \text{ ft})^{1/2} = 5.7 \text{ cfs}$

Conclusion: This site has been inspected, and no grading, filling, or excavation has occurred since this plan was prepared. Analysis indicates that the proposed improvements to the existing storm drain system adequately convey storm runoff generated by the proposed improvements at the site. It should be noted that the proposed improvements will not appreciably increase discharge from the site (less than 0.1%); thus, there will be no change to the HGL in the Bataan Drive storm drain system.

PROJECT SITE

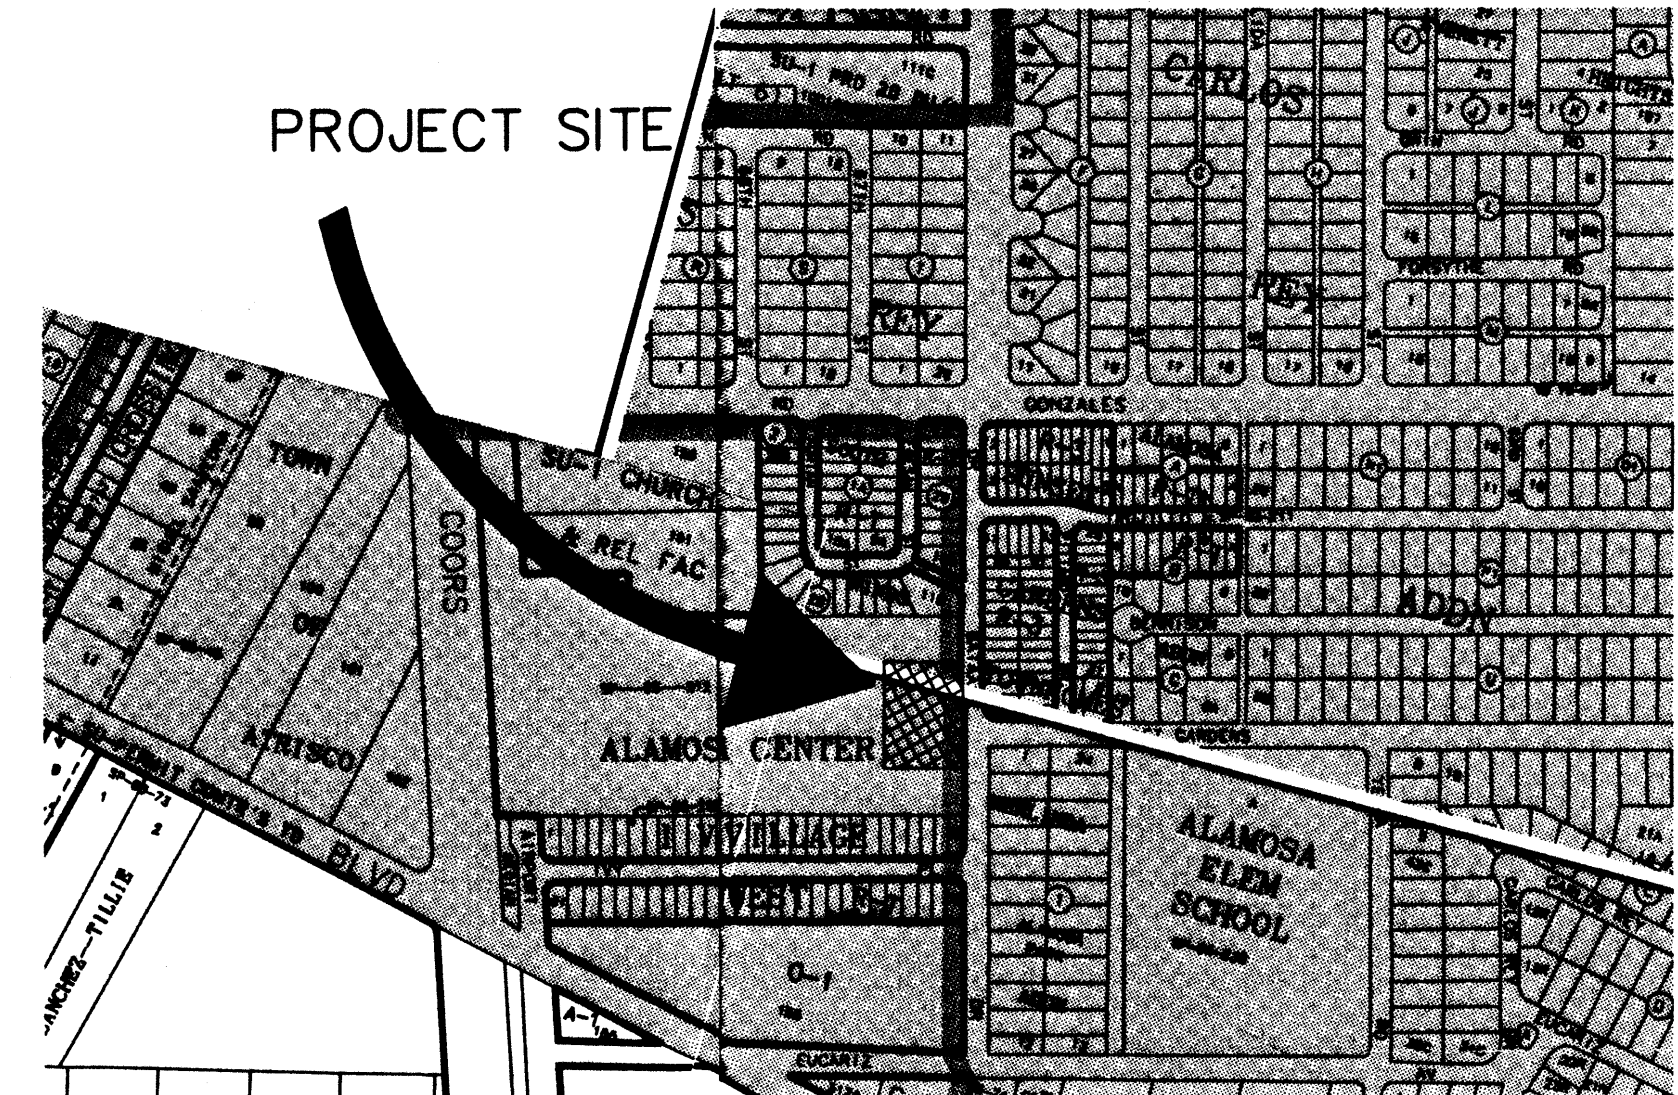


VICINITY MAP

GENERAL NOTES

- PHASE I PROJECT LIMITS
- EXISTING BASIN
- PROPOSED BASIN
- PONDING AREA

GRAPHIC SCALE

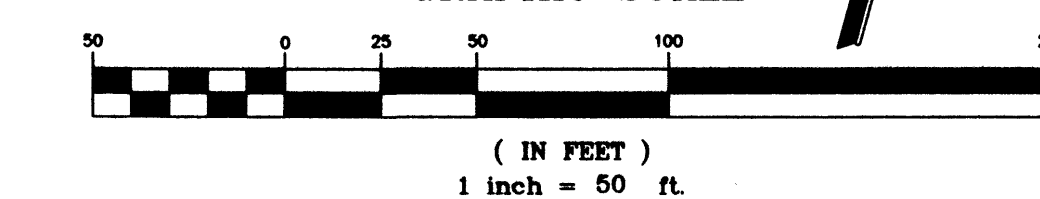



WCEA #X5218028
MAY 2005

CITY OF ALBUQUERQUE PUBLIC WORKS DEPARTMENT ENGINEERING GROUP			
WESTSIDE SKATE PARK, PHASE I GRADING AND DRAINAGE			
Design Review Committee	City Engineer Approval	Mo./Day/Yr.	Mo./Day/Yr.
City Project No.	Zone Map No.	Sheet	Of
764591	K & L-11-Z	1	1
WILSON & COMPANY		JUL 18 2005	
HYDROLOGY SECTION			

DRAINAGE KEYED NOTES

- CONTRACTOR SHALL INSTALL A 12" STORM DRAIN INLET PER DETAIL A/ 4.
- CONTRACTOR SHALL INSTALL 12" STORM DRAIN INLET PER DETAIL B/ 4.
- CONTRACTOR SHALL INSTALL 12" CORRUGATED PIPE, FOR DEPTH OF BURY SEE GRADING PLAN FOR INVERT ELEVATIONS.
- EXISTING 8" SANITARY SEWER PIPE.
- CONTRACTOR SHALL INSTALL TYPE "E" MANHOLE AT LOCATION WHERE DRAIN PIPE CHANGES DIRECTION PER C.O.A. DRAWING 2102 AND MANHOLE COVER PER C.O.A. DRAWING 2102 WITH "STORM" ON COVER.
- CONTRACTOR SHALL INSTALL STORM DRAIN INLET TYPE "D", WITH SINGLE GRATE PER C.O.A. DRAWING 2106.
- EXISTING STORM DRAIN INLET.
- EXISTING MANHOLE.
- EXISTING 24" HIGH DENSITY POLYURETHANE PIPE (HDPE) PERFORATED STORM DRAIN PIPE TO REMAIN.
- EXISTING 24" REINFORCED CONCRETE PIPE (RCP) STORM DRAIN PIPE TO REMAIN.

AS BUILT INFORMATION		BENCHMARK		SURVEY INFORMATION		SEAL		REVISIONS / REMARKS	
CONTRACTOR	DATE:	ACS STATION	THE STATION IS IN	FIELD NOTES	DATE	NO.	BY	NO.	DATE
WORK STAKED BY	DATE:	THE SOUTHEAST QUADRANT OF THE INTERSECTION OF	COORS BLVD. AND BRIDGE IN THE NORTHWEST NOSE	DATE					
INSPECTOR'S APPROVAL	DATE:	OF A TRAFFIC ISLAND.	ELEVATION 5033.25 FEET	BY					
FIELD VERIFICATION BY	DATE:								
DRAWING CORRECTED BY	DATE:								
MICRO-FILM INFORMATION	DATE:								
RECORDED BY	DATE:								
NO.									

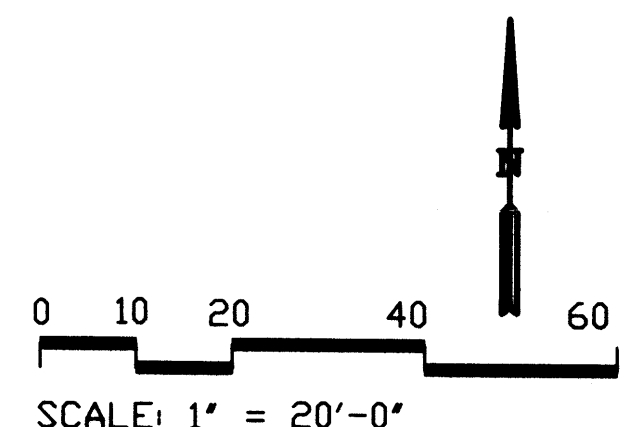
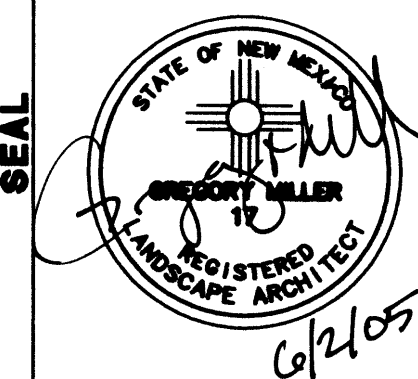


CITY OF ALBUQUERQUE DEPARTMENT OF MUNICIPAL DEVELOPMENT

TITLE: **WESTSIDE SKATE PARK - PHASE 1-A
DRAINAGE PLAN**


Design Review Committee	City Engineer Approval	MM/DD/YY	MM/DD/YY
City Project No. 704501	Zone Map No. K & L-11-Z	Sheet 12	Of 12

**MORROW REARDON
WILKINSON MILLER, LTD.
LANDSCAPE ARCHITECTS**
210 La Veta NE, Albuquerque, NM 87106
505.261.5500 FAX 505.261.5507
mrw@mrwm.com

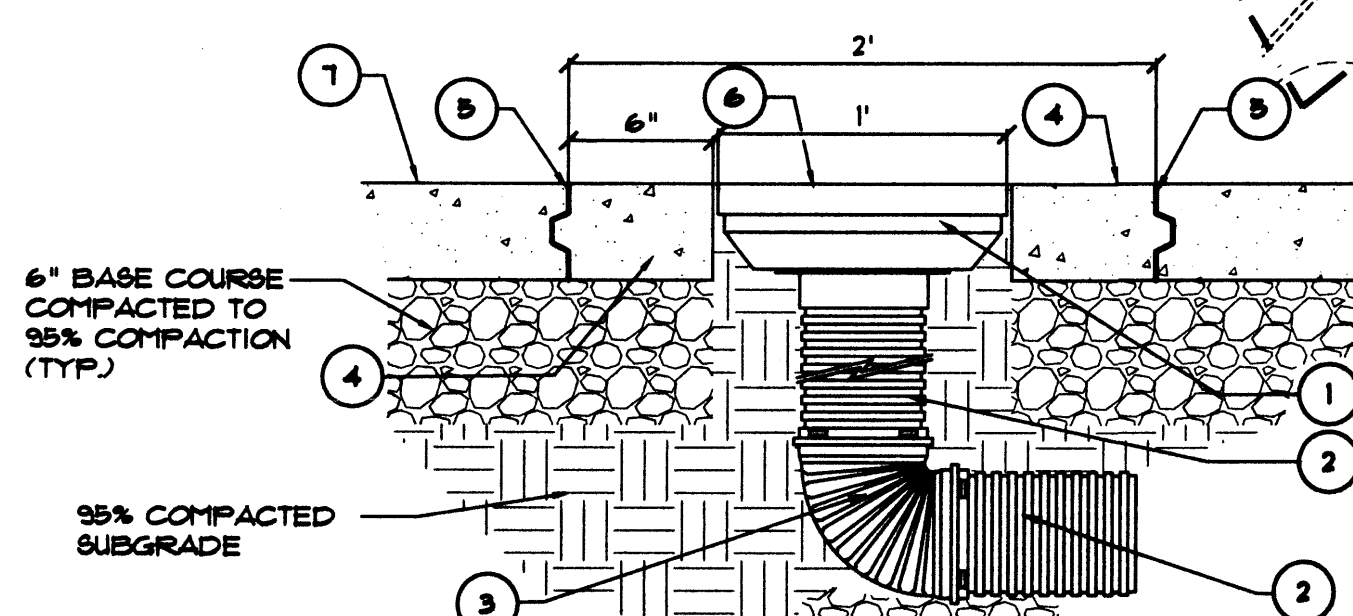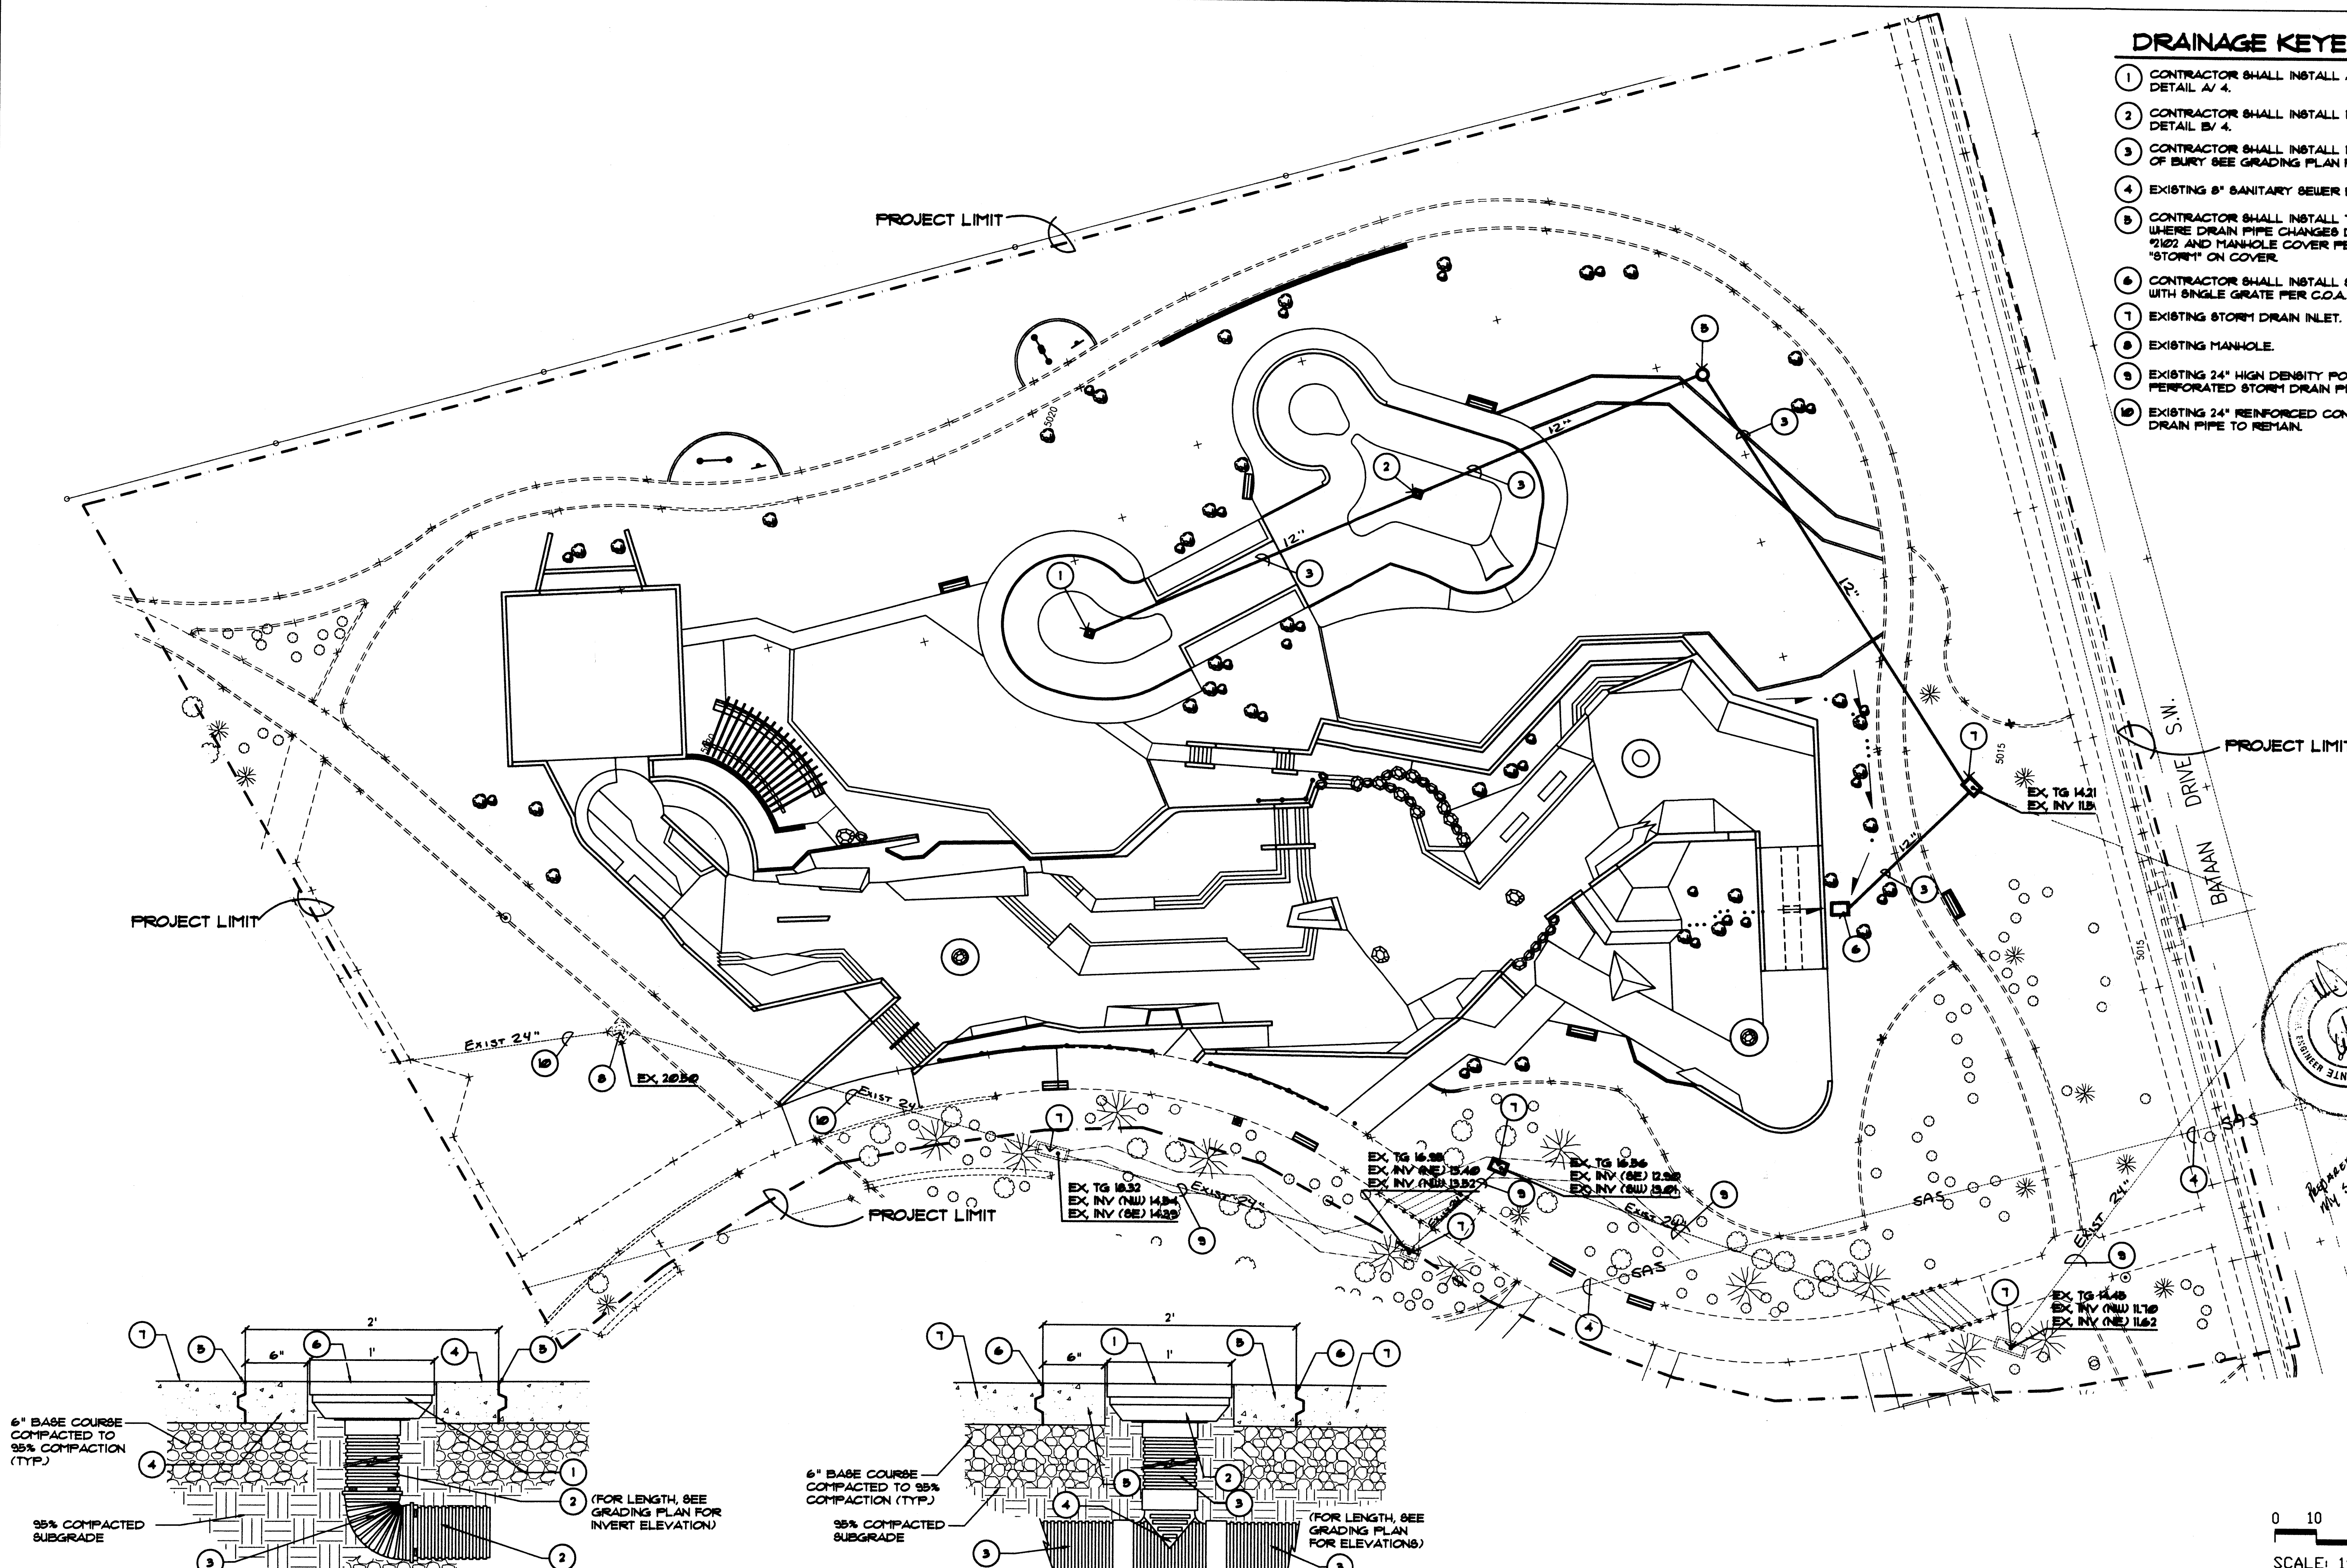

- ND6 12" X 12" SQUARE, LOW PROFILE SPIGOT ADAPTER, MODEL #1222. AVAILABLE FROM LOVING & ASSOCIATES (505) 293-1122.
- 12" CORRUGATED PIPE.
- 12" CORRUGATED ELBOW.
- 6" WIDE CONCRETE COLLAR AROUND DRAIN INLET.
- CONTRACTOR SHALL INSTALL KEYWAY JOINT.
- ND6 12" X 12" MANGANESE BRONZE SQUARE GRATE, MODEL #214. SET TOP OF GRATE FLUSH WITH TOP OF ADJACENT CONCRETE. AVAILABLE FROM LOVING & ASSOCIATES (505) 293-1122.
- CONCRETE SLAB. SEE CONSTRUCTION PLAN.


A 12" DRAIN INLET
12INCHDRAININLET 4/25/05 1-1/2"=1'

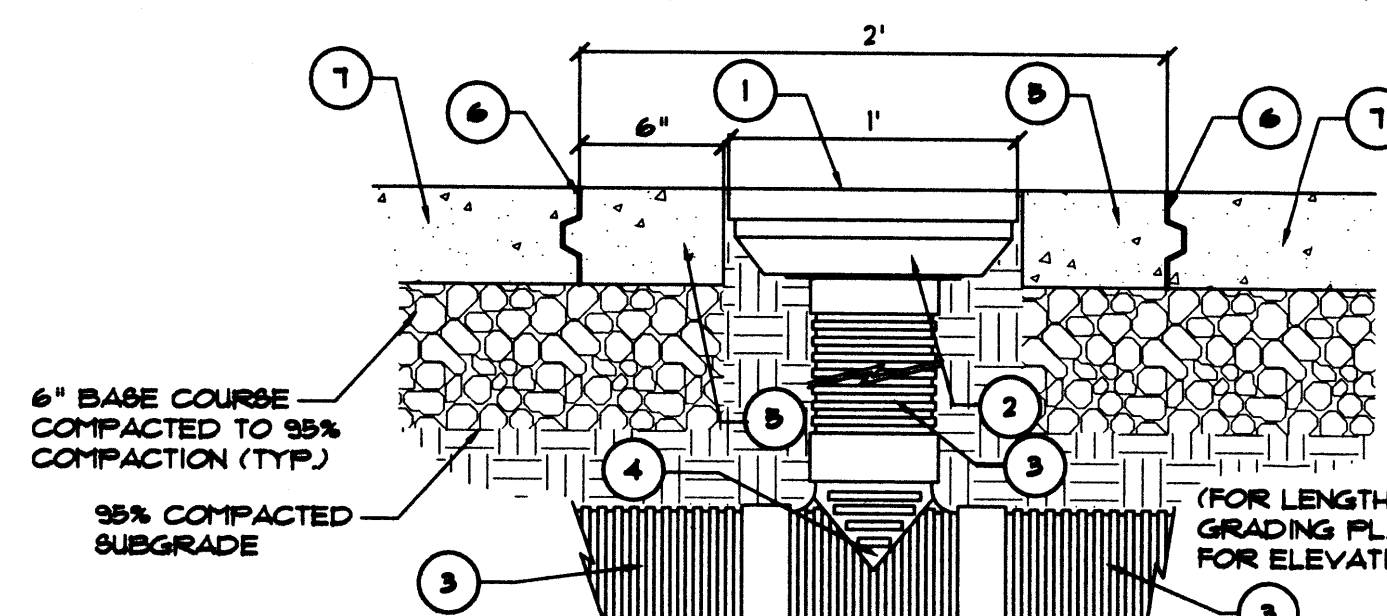


- ND6 12" X 12" MANGANESE BRONZE SQUARE GRATE, MODEL #214. SET TOP OF GRATE FLUSH WITH TOP OF ADJACENT CONCRETE. AVAILABLE FROM LOVING & ASSOCIATES (505) 293-1122.
- ND6 12" X 12" SQUARE, LOW PROFILE SPIGOT ADAPTOR, MODEL #1222. AVAILABLE FROM LOVING & ASSOCIATES (505) 293-1122.
- 12" CORRUGATED PIPE.
- 12" "T" CORRUGATED PIPE CONNECTION.
- 6" WIDE CONCRETE COLLAR AROUND DRAIN INLET.
- CONTRACTOR SHALL INSTALL KEYWAY JOINT.
- CONCRETE SLAB. SEE CONSTRUCTION PLAN.

B 12" DRAIN INLET/T
DRAININLET2.DWG 5/26/05 1-1/2"=1'

EXISTING BASINS

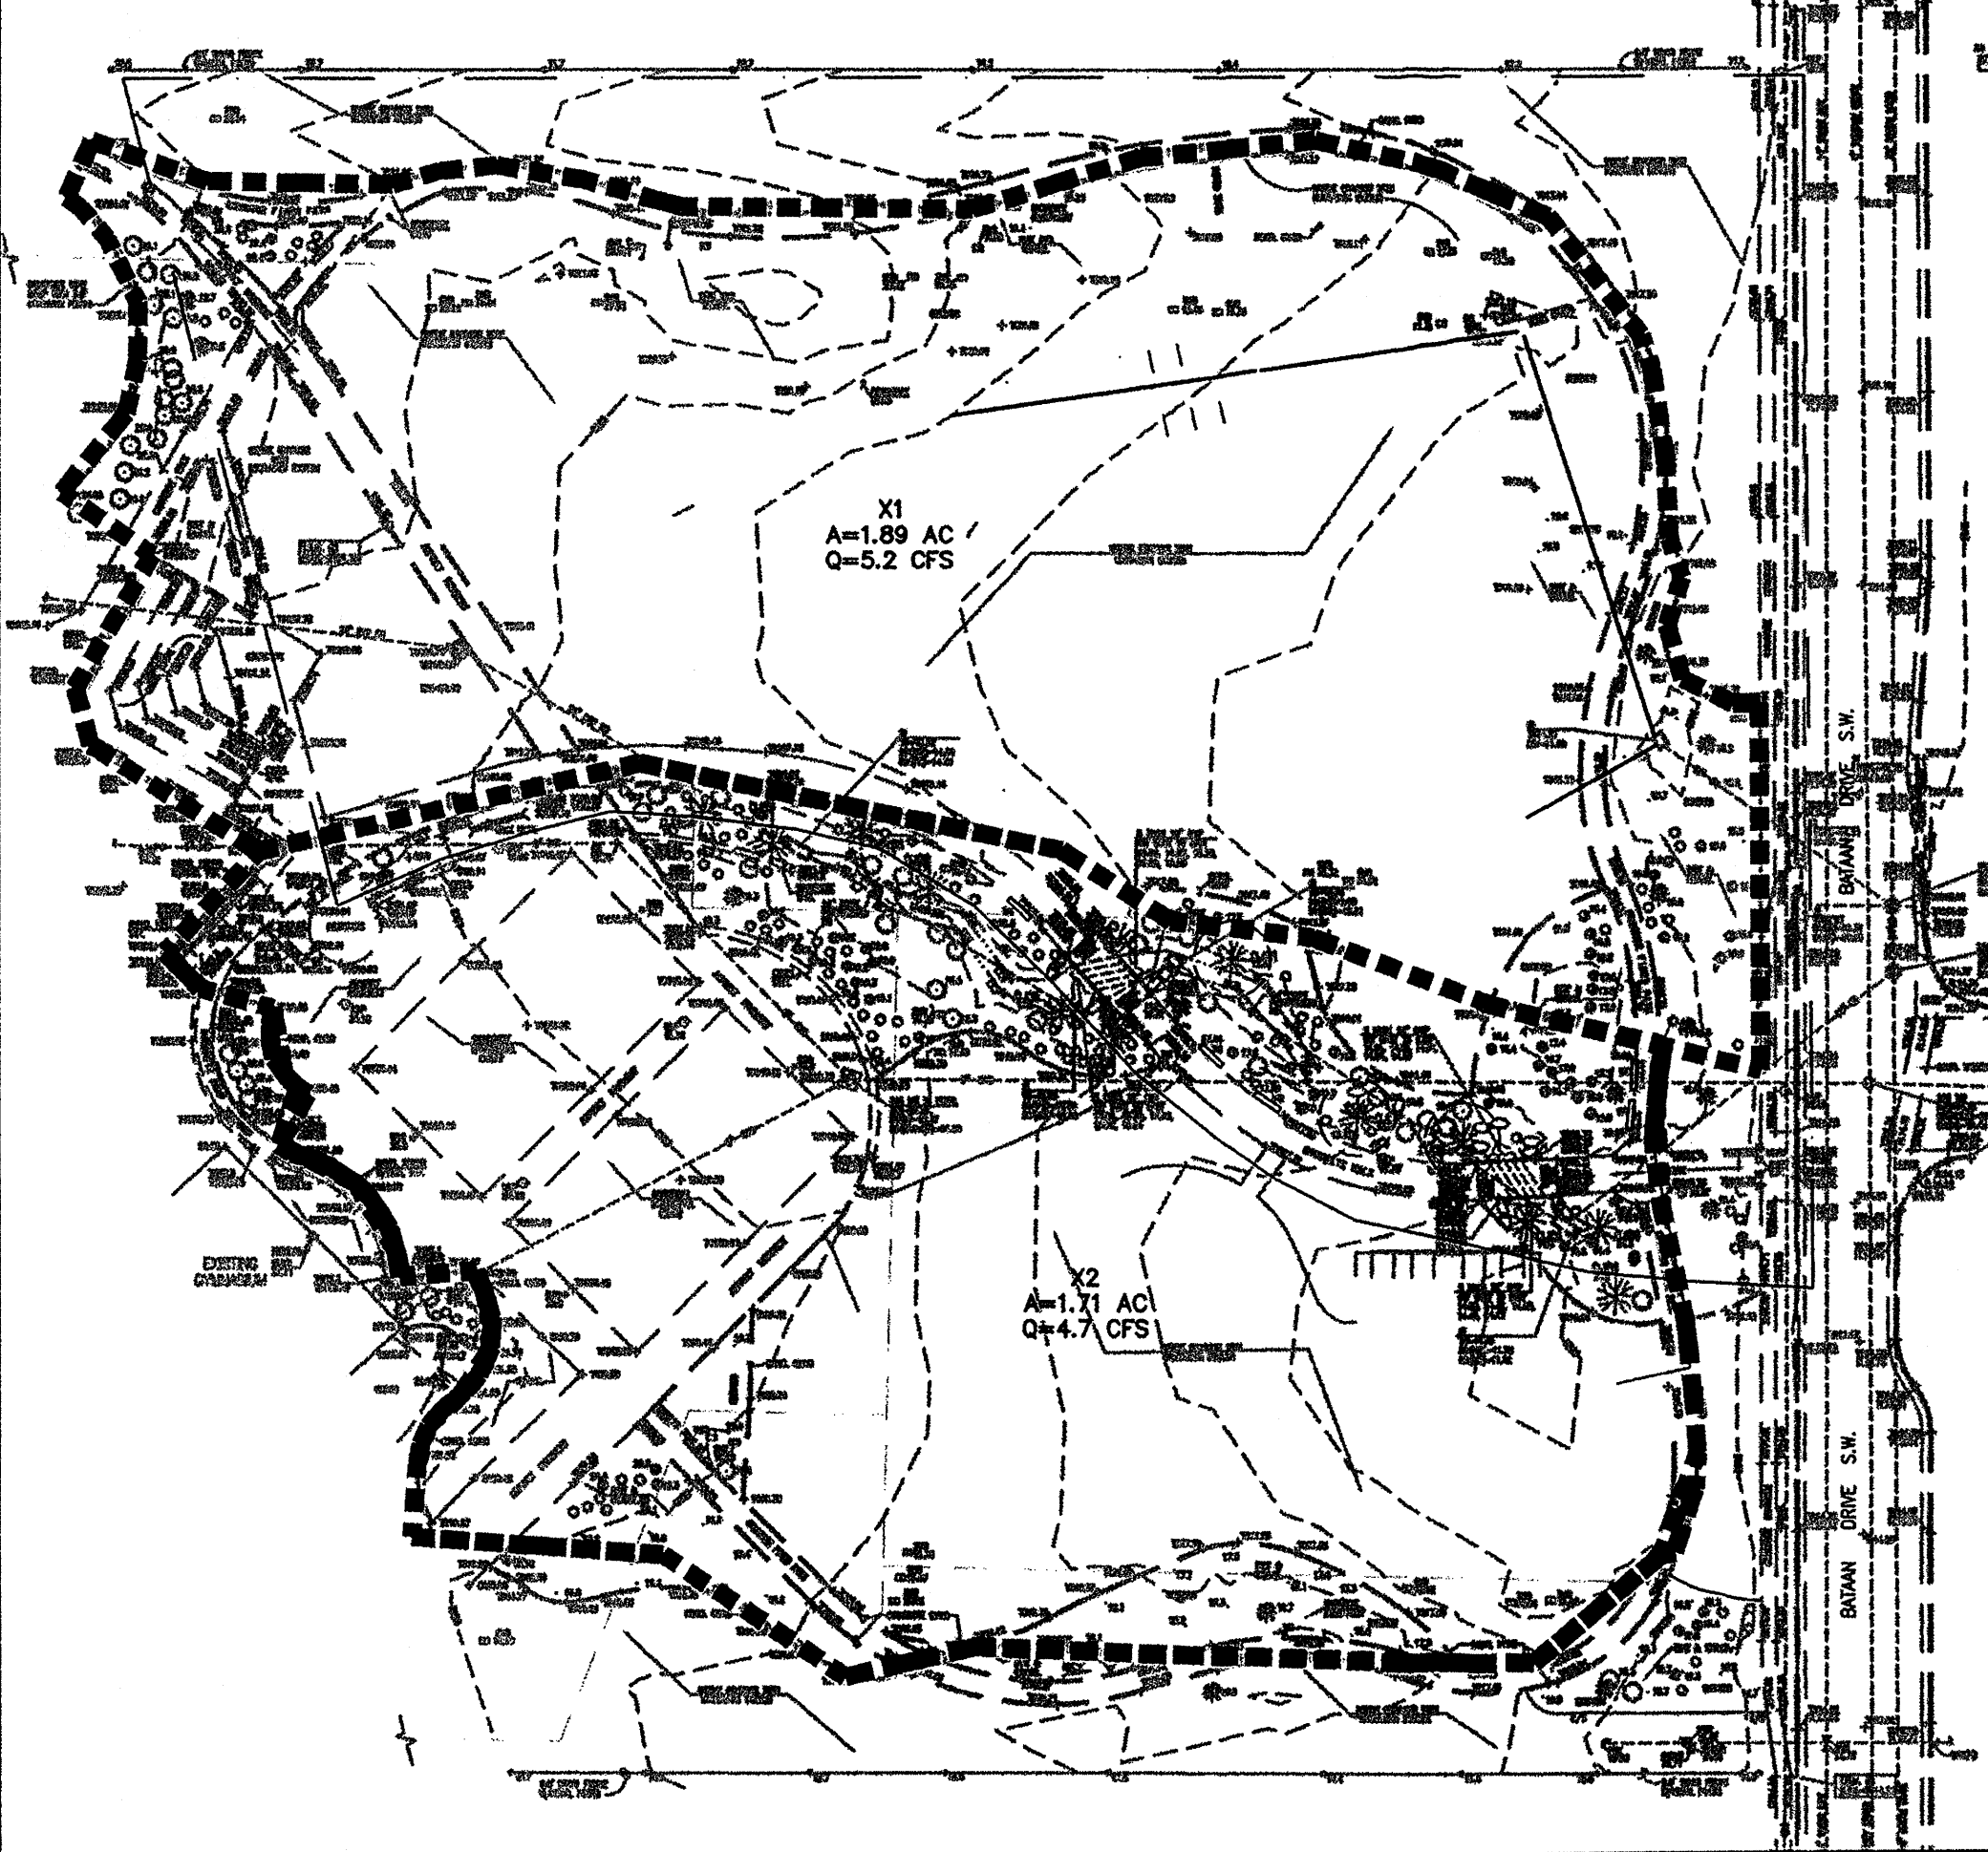

PROPOSED BASINS

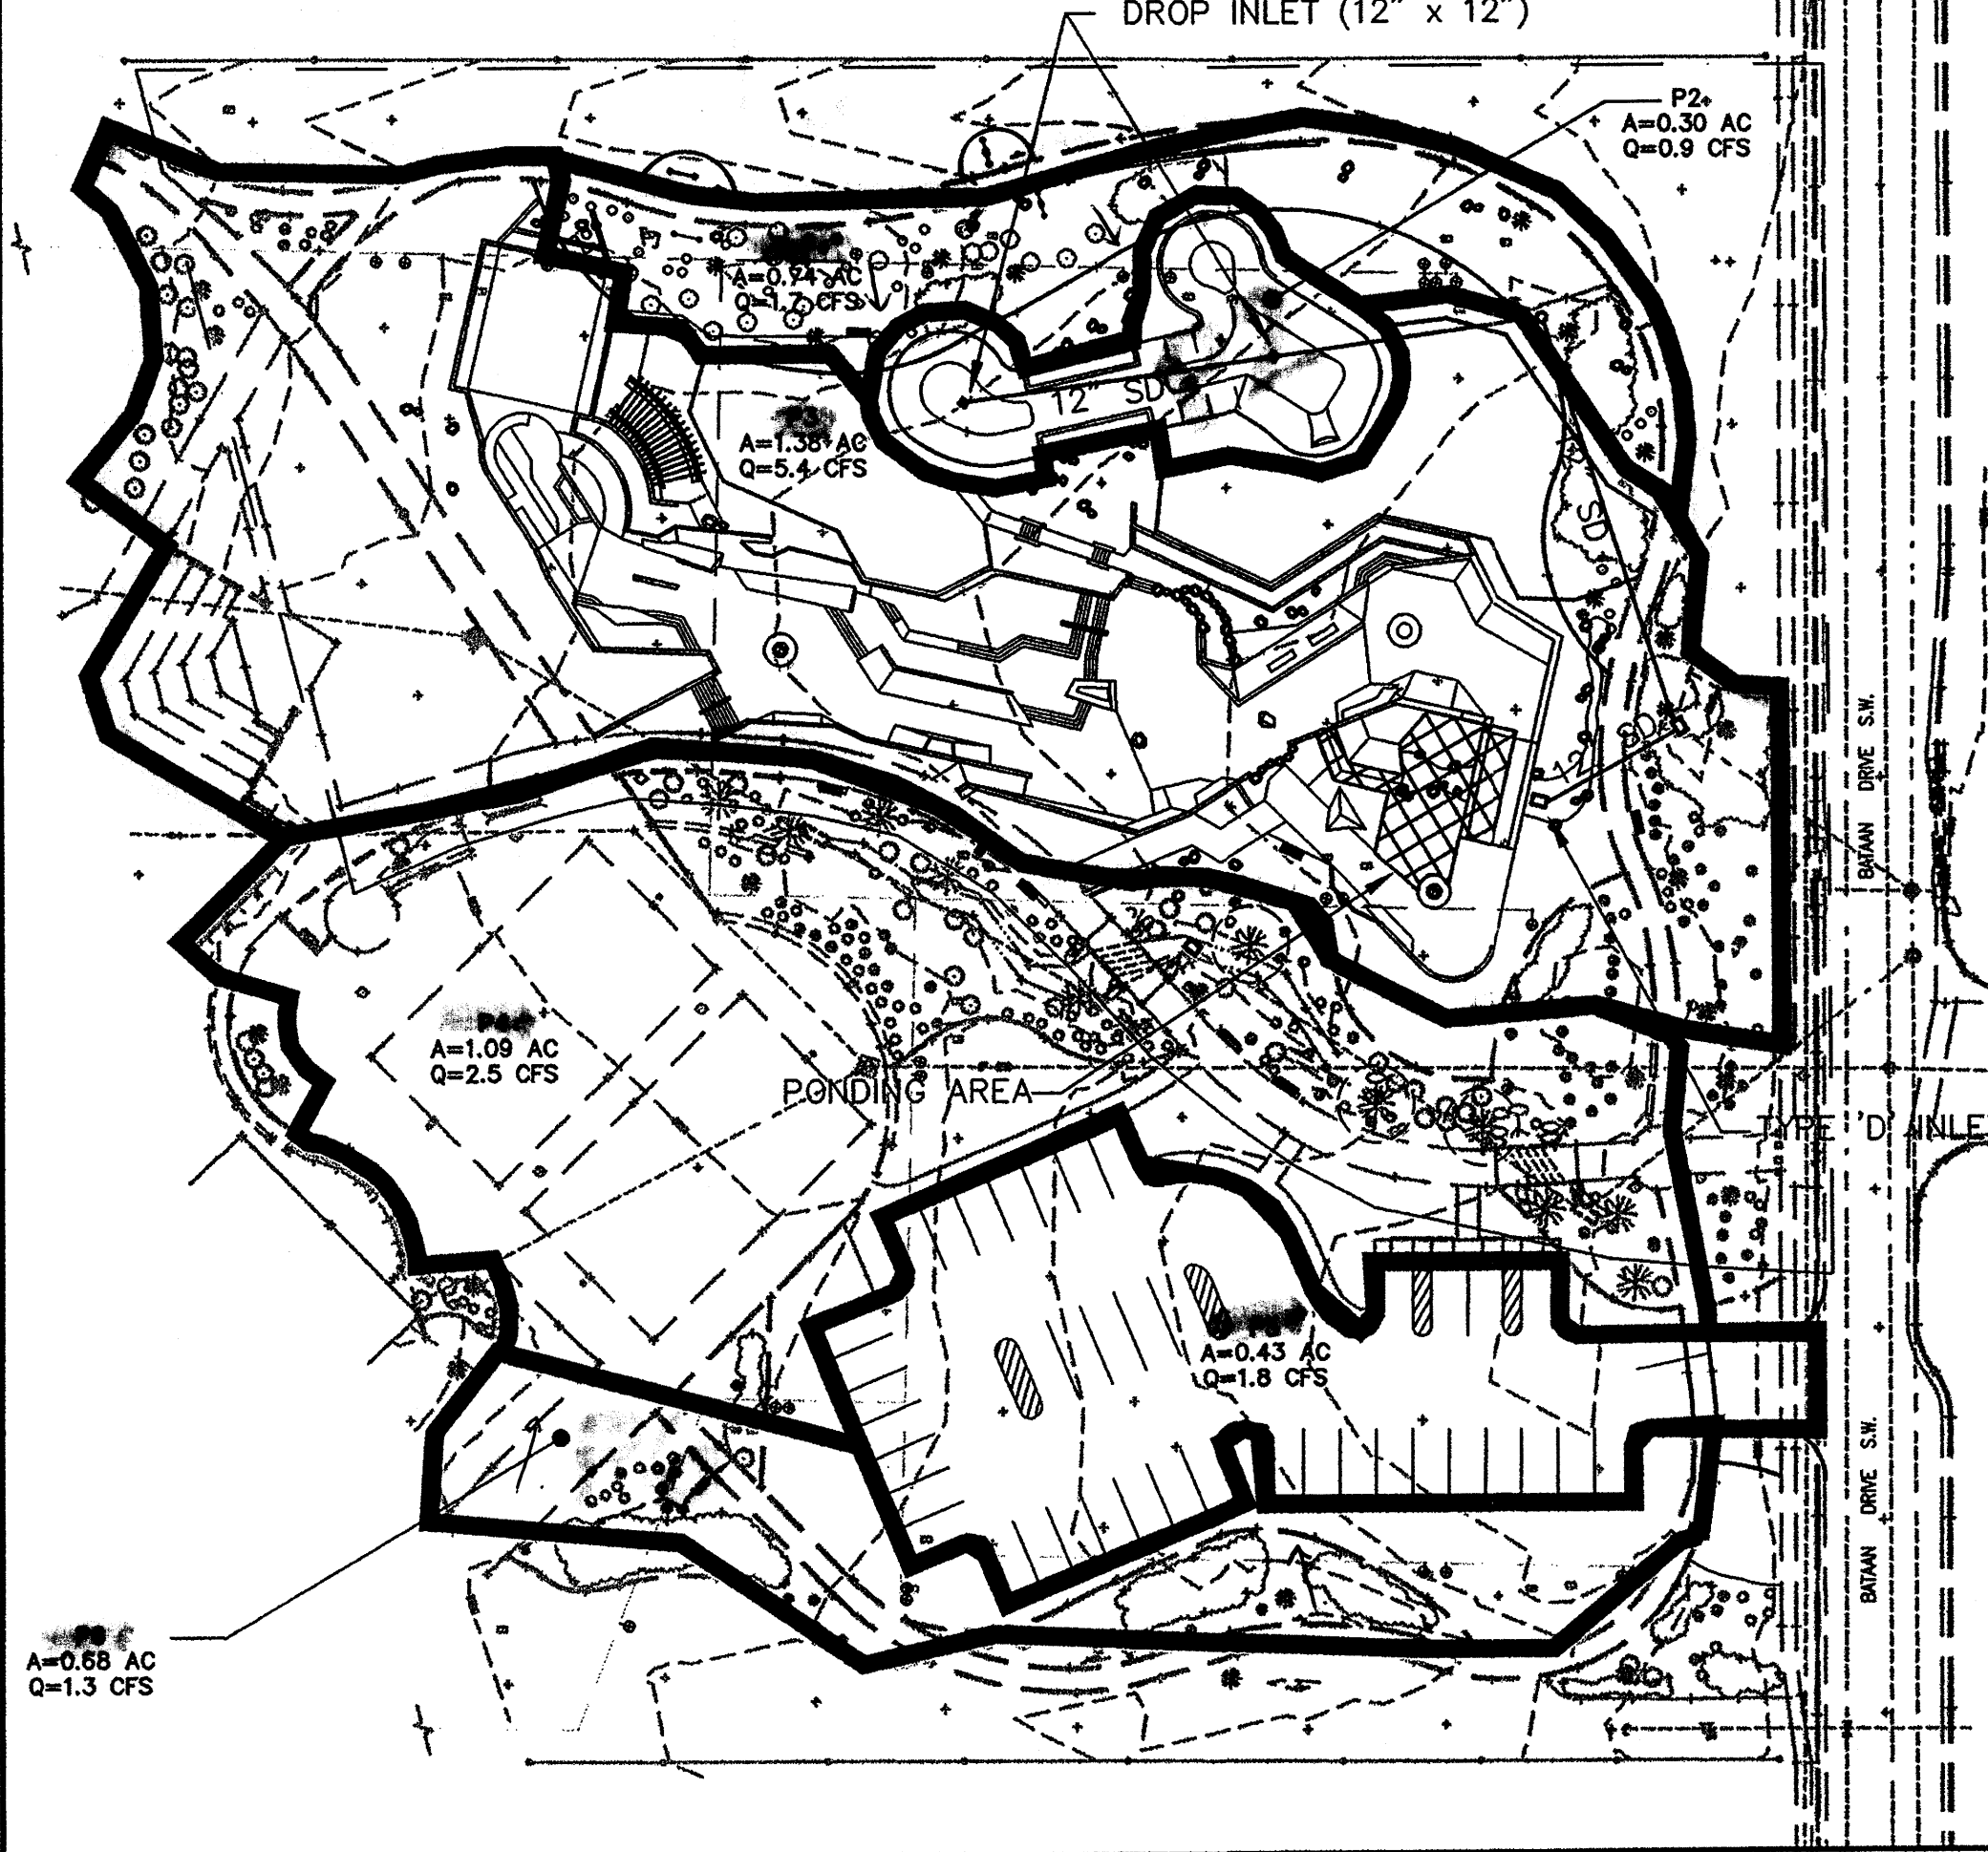

DRAINAGE REPORT

Site Location: The Alamosa Community Center and Skate Park is a 3.6 acre property located in southwest Albuquerque, NM, bordered by Coors Boulevard to the west, Gonzales Road to the north, Ivy Place to the south, and Bataan Drive to the east. This drainage report assumes full build of the skate park facility and accompanying landscaping improvements, however, actual construction of the project will occur in two phases. **Phase I will include the skate park and associated landscaping improvements, while Phase II will include the parking lot, concession facilities, and associated landscaping improvements.** This report seeks approval only for Phase I computations, though Phase II conditions and computations have been included for information.

Methodology: Section 22.2 of the City of Albuquerque DPM was followed to calculate design flows. The procedure in Part A, for 40 acre or smaller basins, was followed using the 100-year, 24-hour storm event frequency. All basins were delineated using AutoCAD software to determine areas. The site is located in Zone 1, west of the Rio Grande, as designated in Table A-1. The basis of this drainage report is the Alamosa Community Center Drainage Report (1995) by Jeff Mortenson and Associates (hereafter Reference 1).

Existing Conditions: The existing topography of the site is relatively flat with some areas of local ponding, sloping slightly to the east-southeast with slopes typically less than 1.5%. The site also contains concrete and asphalt site work from existing facilities. Runoff from existing infrastructure to the west discharges to an existing storm drain system, and existing slopes of the land are such that offsite flows do not enter the project site. **Onsite areas are currently drained by an existing 24" to 30" storm drain system with five (5) median drop inlets which convey flow into the 54" storm drain in Bataan Road.**

Hydrologic Analysis Basins X1 and X2 delineate the existing drainage boundary. It should be noted that Basin X2 does not contribute to Phase I improvements. The existing drainage boundary is approximately 3.6 acres and is made up of asphalt paving, concrete site work, and vegetated area with mature trees. Basin X1 at the north portion of the site drains via an existing swale to an existing drop inlet at the east portion of the site. Basin X2 drains to one of four (4) median drop inlets along a swale. Peak discharge rates for watersheds smaller than 40 acres may be computed using the Rational Method, $Q_P = C i A$ (ft³/s), where Q_P is the peak discharge, i is the 12-minute peak intensity, C is the rational coefficient, and A is the area in acres.

For Zone 1, values of C are 0.27 for land treatment A, 0.43 for land treatment B, 0.61 for land treatment C, and 0.93 for land treatment D. The value of i is 4.70 inches/hour. Pre-development peak discharge is computed as follows:
Basin X1 = $[(0.27)(4.70 \text{ in/hr})(0.85 \text{ acres}) + (0.43)(4.70 \text{ in/hr})(0.19 \text{ acres}) + (0.61)(4.70 \text{ in/hr})(.66 \text{ acres}) + (0.93)(4.70 \text{ in/hr})(0.19 \text{ acres})] = 4.2 \text{ ft}^3/\text{s}$
Basin X2 = $[(0.27)(4.70 \text{ in/hr})(0.51 \text{ acres}) + (0.43)(4.70 \text{ in/hr})(0.09 \text{ acres}) + (0.61)(4.70 \text{ in/hr})(0.09 \text{ acres}) + (0.93)(4.70 \text{ in/hr})(1.03 \text{ acres})] = 5.6 \text{ ft}^3/\text{s}$

Proposed Conditions: Under proposed conditions (both Phases) miscellaneous buildings, a skate park, and parking lot will be constructed at the site. Phase I improvements will consist of the skate park and associated landscaping improvements; Phase II will consist of the parking area, concession facilities, and associated landscaping improvements. **Runoff from the proposed site will continue to discharge to the existing storm drain system.** Existing flow patterns (existing swales, drop inlets, etc.) will be maintained to the extent possible, although additional drop inlets will be constructed to facilitate drainage. Additional storm drain inlets will tie into the existing system, either directly into existing inlets, or with new manholes. Per Reference 1, this drainage report assumes adequate capacity in the Bataan Drive storm drain system at full build per the Sunset Gardens Master Plan Drainage Study.

Hydrologic Analysis Basins P1 through P3 represent proposed conditions for Phase I. Basins P4 through P6 represent proposed conditions for Phase II. Basins P1 and P6, at the north and south portions of the site, will contain landscaping improvements only and will continue to discharge to existing infrastructure, as under existing conditions. Basin P2 is a skate park bowl structure, and will be predominately land treatment 'D'. Basin P3 will contain the remainder of the skate park structures with landscaping. Drainage will be facilitated by new drop inlets. Basin P4 will contain landscaping improvements only, and Basin P5 contains the parking area. Drainage improvements for Phase II basins, P4 through P6, have not been finalized at this point. Proposed flows are computed in the same manner as presented above. In addition, the values of C and i are unchanged.

Basin P1 = $[(0.27)(4.70 \text{ in/hr})(0.27 \text{ acres}) + (0.93)(4.70 \text{ in/hr})(0.01 \text{ acres})] = 0.4 \text{ ft}^3/\text{s}$
Basin P2 = $[(0.61)(4.70 \text{ in/hr})(0.01 \text{ acres})] + [(0.93)(4.70 \text{ in/hr})(0.14 \text{ acres})] = 0.6 \text{ ft}^3/\text{s}$
Basin P3 = $[(0.27)(4.70 \text{ in/hr})(0.29 \text{ acres}) + (0.61)(4.70 \text{ in/hr})(0.44 \text{ acres}) + (0.93)(4.70 \text{ in/hr})(0.74 \text{ acres})] = 4.9 \text{ ft}^3/\text{s}$
Basin P4 = $[(0.27)(4.70 \text{ in/hr})(0.54 \text{ acres}) + (0.93)(4.70 \text{ in/hr})(0.44 \text{ acres})] = 2.6 \text{ ft}^3/\text{s}$
Basin P5 = $[(0.61)(4.70 \text{ in/hr})(0.02 \text{ acres}) + (0.93)(4.70 \text{ in/hr})(0.39 \text{ acres})] = 1.8 \text{ ft}^3/\text{s}$
Basin P6 = $[(0.27)(4.70 \text{ in/hr})(0.25 \text{ acres}) + (0.43)(4.70 \text{ in/hr})(0.01 \text{ acres}) + (0.93)(4.70 \text{ in/hr})(0.03 \text{ acres})] = 0.5 \text{ ft}^3/\text{s}$

EXISTING BASIN SUMMARY

Basin	Total Area (Ac)	%	A	%	B	%	C	%	D	Peak Discharge (cfs)
X1	1.887	45	0.85	10	0.19	35	0.66	10	0.19	4.2 ✓
X2*	1.709	30	0.51	5	0.09	5	0.09	60	1.03	5.6 ✓
Σ=	3.596		1.36		0.27		0.75		1.21	9.8

PROPOSED BASIN SUMMARY

Basin	Total Area	%	A	%	B	%	C	%	D	Peak Discharge, Q
P1	0.282	95	0.27	0	0.00	0	0.00	5	0.01	0.4 ✓
P2	0.151	5	0.01	0	0.00	0	0.00	95	0.14	0.6 ✓
P3	1.471	20	0.29	0	0.00	30	0.44	50	0.74	4.9 ✓
P4*	0.985	55	0.54	0	0.00	0	0.00	45	0.44	2.6 ✓
P5*	0.413	0	0.00	0	0.00	5	0.02	95	0.39	1.8 ✓
P6*	0.294	85	0.25	5	0.01	0	0.00	10	0.03	0.5 ✓
Σ=	3.596		1.36		0.01		0.46		1.76	10.8
Phase I only:	1.904		0.57		0.00		0.44		0.89	5.9 ✓

*Denotes basins NOT associated with Phase I improvements

Detention Pond: The area upstream of the pedestrian bridge in Basin P3 will serve as a detention pond, and was sized following an assumed triangular inflow hydrograph and trapezoidal outflow hydrograph procedure. Values for excess precipitation, E , for the 100-year, 6-hour storm in Zone 1 are given in Table A-8. For the 100-year, 10-day storm, the required ponding area is approximately 0.0311 acre-ft. The ponding area is 1360 ft³ (0.0312 acre-ft) therefore, **water depth in the pond will be 1.0 ft.** Discharge will be limited to Qallowable, 3.2 cfs. Pond calculations are as follows:

Given: $AC = 1.471$ acres; $E = 1.37$ inches; $(Q_P)P3 = 4.9$ cfs; $(Q_P)X1 = 4.2$ cfs; $(Q_P)\text{proposed} = 5.9$ cfs
Find: Volumetric runoff for the 100-year, 6-hour storm, V360, and the 100-year, 10-day storm, V10day
Soln:


- Step 1, Compute V360 = Weighted $E \cdot A_{\text{total}} = (1.37 \cdot 1.471)/12 = 0.168$ acre-ft
- Step 2, Compute V10day = $V360 + (AD \cdot (P10\text{day} - P360))/12 = 0.168 + (0.74 \cdot (3.67 - 2.20))/12 = 0.2580$ acre-ft
- Step 3, Compute Qallowable = $(Q_P)P3 - [(Q_P)X1 - (Q_P)\text{proposed}] = [4.9 \text{ cfs} - (5.9 \text{ cfs} - 4.2 \text{ cfs})] = 3.2 \text{ cfs}$
- Step 4, Compute base, t_D , of triangular inflow hydrograph $\rightarrow V_t = \frac{1}{2} t_D \cdot Q_P \rightarrow t_D = (2 \cdot V_t)/Q_P = (2 \cdot 0.258 \text{ ac-ft})/4.9 \text{ cfs} = (0.0874 \text{ ac-ft/cfs}) \cdot [(43560 \text{ ft}^2/\text{acre})/(3600 \text{ sec/hr})] = 1.2742 \text{ hr}$
- Step 5, Compute slope of rising limb of hydrograph = $4.9 \text{ cfs}/0.6371 \text{ hr} = 7.691 \text{ cfs/hr}$
- Step 6, Compute intercepts at Qallowable (3.2 cfs)
 - a. $= 4.2/(7.691 \text{ cfs/hr}) = 0.42 \text{ hr}$
 - b. $= 1.2742 \text{ hr} - 0.42 \text{ hr} = 0.86 \text{ hr}$
- Step 7, Compute required storage = $\frac{1}{2} b h = \frac{1}{2} \cdot (4.9 - 3.2 \text{ cfs}) \cdot (0.86 - 0.42 \text{ hr}) \cdot (3600 \text{ sec/hr}) = 1353 \text{ ft}^3 = 0.0311 \text{ acre-ft}$

Drop Inlet & Hydraulics Computations: Three new drop inlets are proposed for Phase I improvements, including 2-12"x12" drop inlets at the skate park bowl structure (Basin P2), and 1-Type "D" area inlet near the pedestrian bridge (Basin P3). Drop inlet capacities assume orifice flow, 50% reduction in opening area due to bars, and 50% clogging. All proposed pipes were checked to verify a minimum velocity of 3 fps. Pipe computations were verified using FlowMaster software.

Per the orifice equation, $Q = c_o \cdot A \cdot (2gd)^{1/2}$
Where: c_o = orifice coefficient (0.67); A = opening area (ft²);
 g = gravitational constant (32.2 ft/sec²); d = ponding depth (ft)


12"x12" Grate Inlet: $Q = 0.67 \cdot 0.5 \cdot 0.5 \cdot (1 \text{ ft}^2)^{1/2} \cdot (2 \cdot 32.2 \text{ ft/sec}^2 \cdot 0.5 \text{ ft})^{1/2} = 0.95 \text{ cfs}$
Type "D" Grate Inlet: $Q = 0.67 \cdot 0.5 \cdot 0.5 \cdot (2 \text{ ft}^2)^{1/2} \cdot (2 \cdot 32.2 \text{ ft/sec}^2 \cdot 0.5 \text{ ft})^{1/2} = 5.7 \text{ cfs}$

Conclusion: This site has been inspected, and no grading, filling, or excavation has occurred since this plan was prepared. Analysis indicates that the proposed improvements to the existing storm drain system adequately convey storm runoff generated by the proposed improvements at the site. It should be noted that the proposed improvements will not appreciably increase discharge from the site (less than 0.1%); thus, there will be no change to the HGL in the Bataan Drive storm drain system.

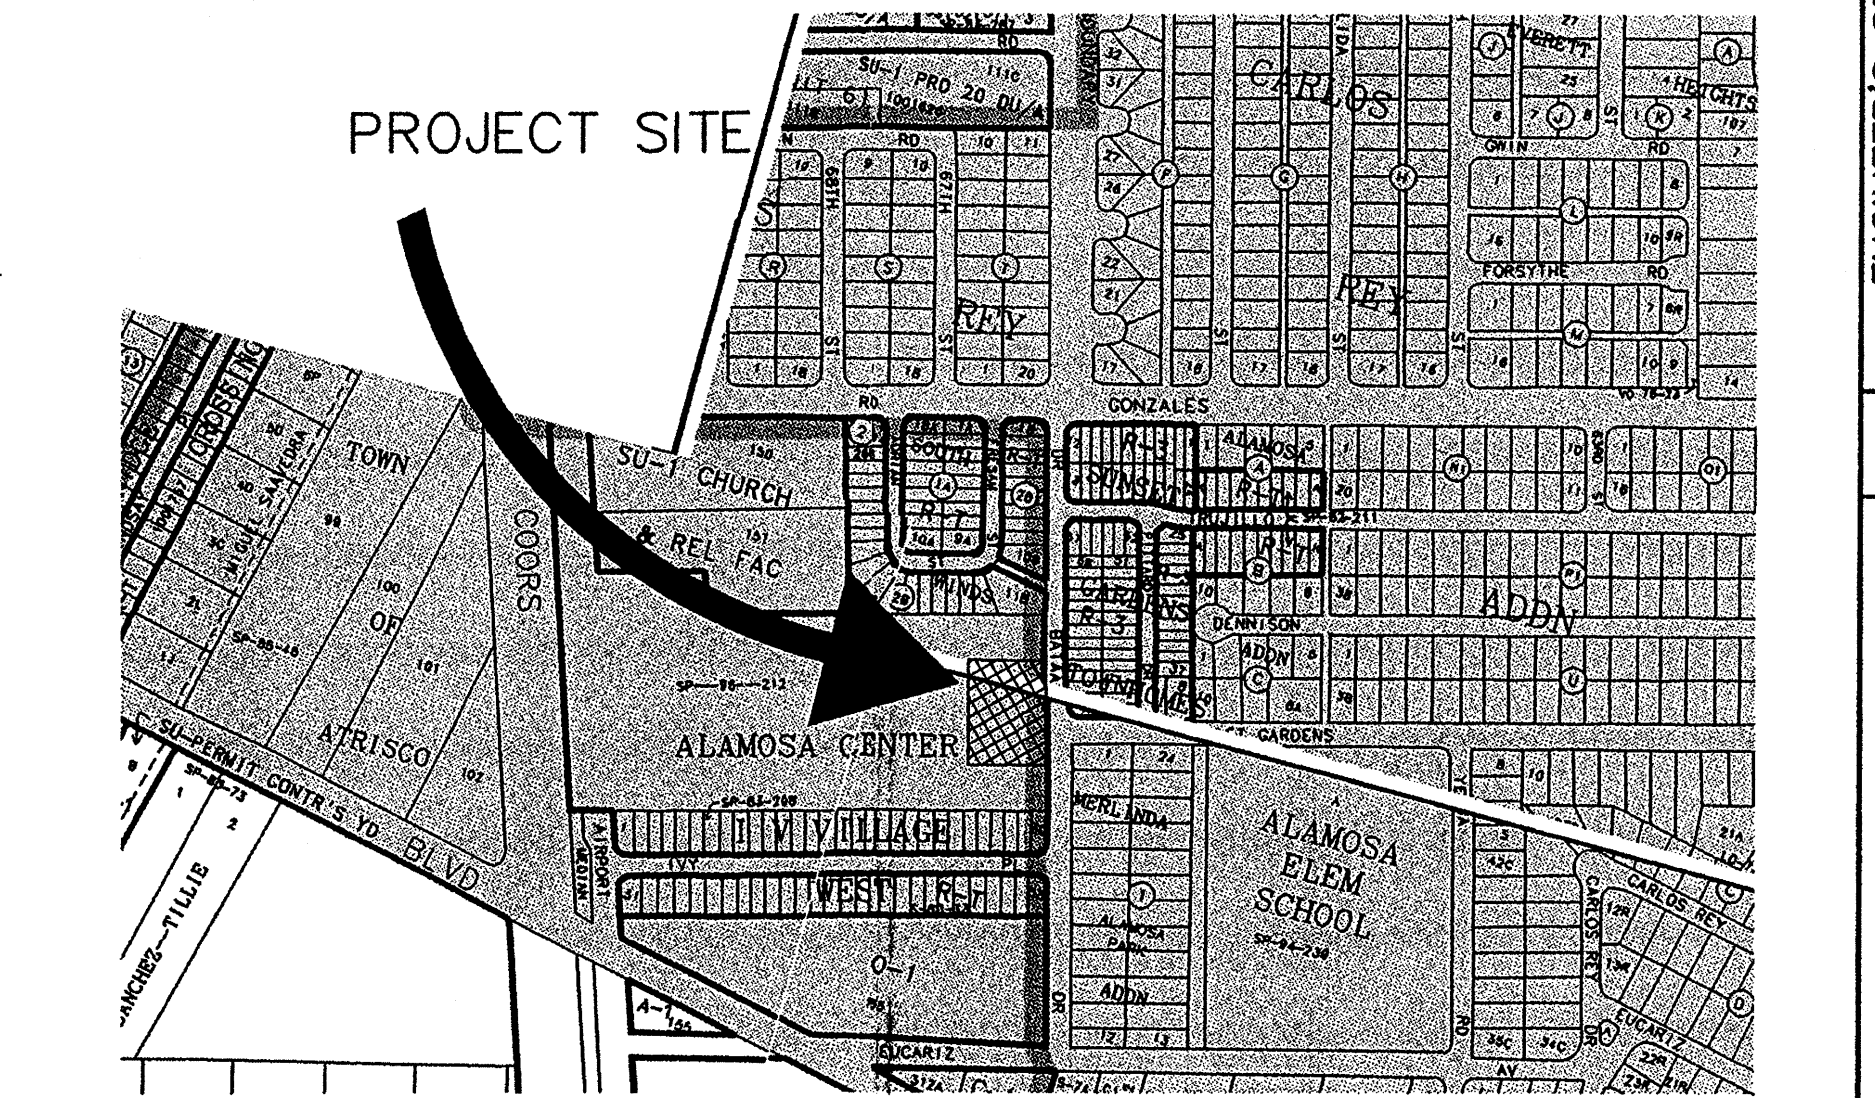

VICINITY MAP


GENERAL NOTES

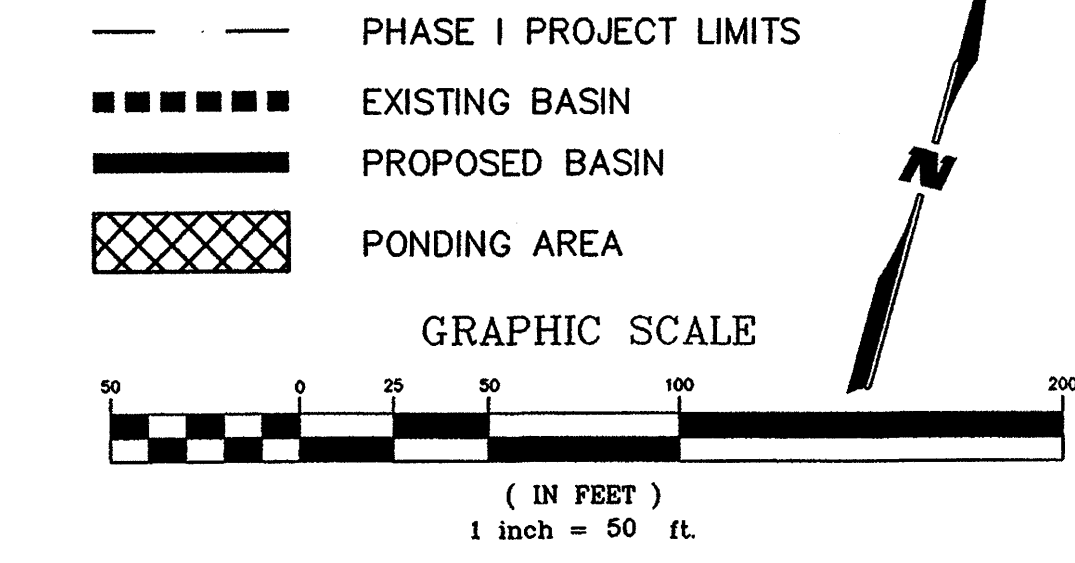


CITY OF ALBUQUERQUE PUBLIC WORKS DEPARTMENT ENGINEERING GROUP			
WESTSIDE SKATE PARK, PHASE I GRADING AND DRAINAGE			
Design Review Committee	City Engineer Approval	Last Design Update	Mo./Day/Yr.
City Project No.	Zone Map No.	Sheet	Of
XXXX.XX	K & L-11-Z	1	1

WILSON & COMPANY

R JUN 03 2005
HYDROLOGY SECTION

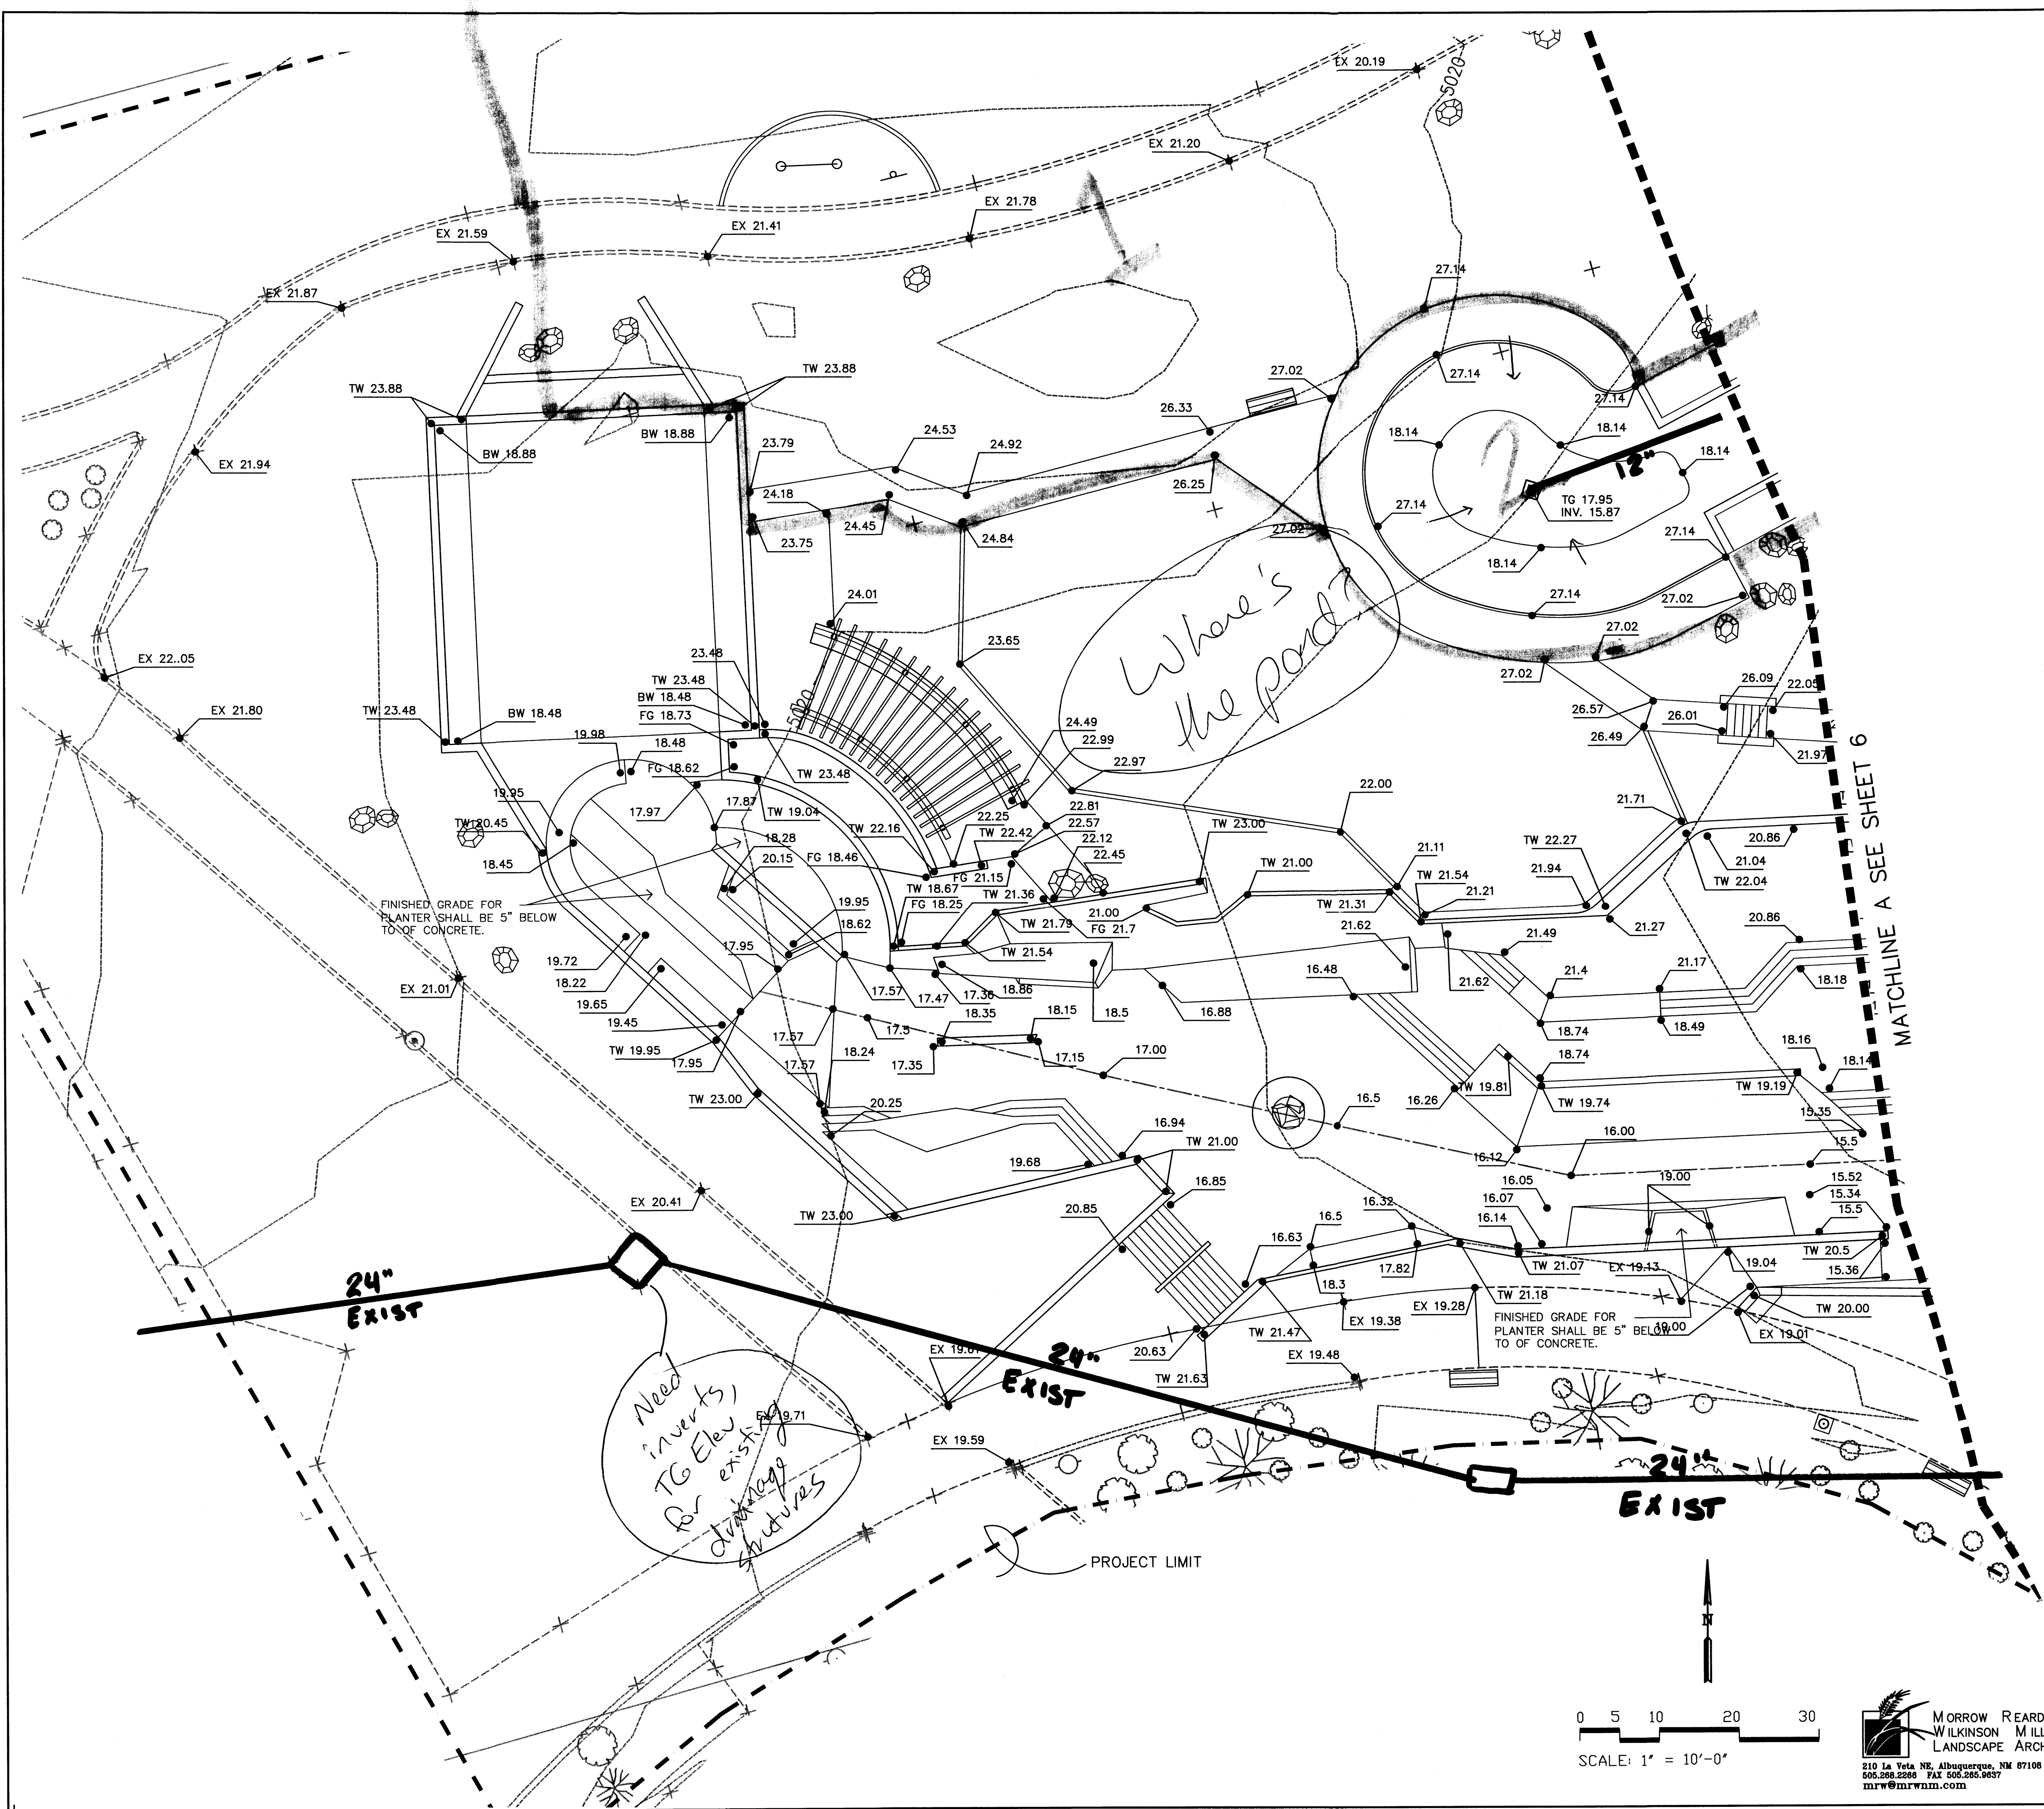

LEGEND	
KEY	DESCRIPTION
BW	BOTTOM OF WALL
EX	EXISTING ELEVATION
INV	INVERT
SD	EXISTING STORM DRAIN
SI	STORM INLET
TC	TOP OF CONCRETE
TG	TOP OF GRATE
TW	TOP OF WALL

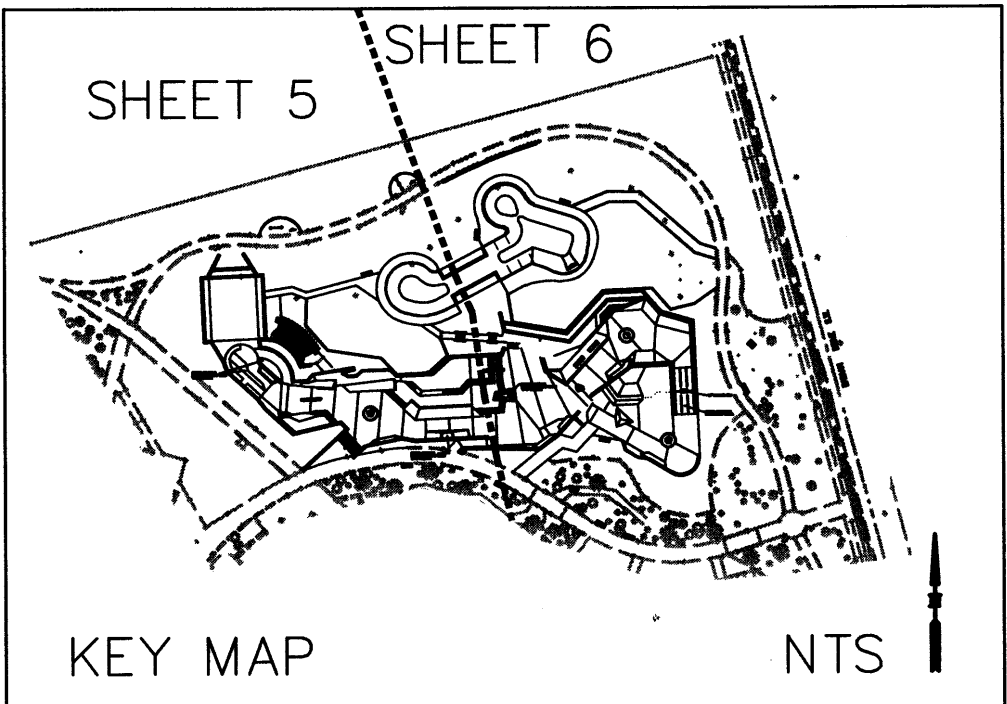


CITY OF ALBUQUERQUE DEPARTMENT OF MUNICIPAL DEVELOPMENT	
TITLE: WESTSIDE SKATE PARK - PHASE 1-A GRADING PLAN	
Design Review Committee	City Engineer Approval
City Project No. XXXXX	Sheet 5 of 11

AS-BUILT INFORMATION		BENCHMARK		SURVEY INFORMATION		SEAL		REVISIONS / REMARKS		BY		DATE	
CONTRACTOR	DATE:			FIELD NOTES									
WORK STAKED BY	DATE:			NO.	BY								
INSPECTOR'S APPROVAL	DATE:												
FIELD VERIFICATION BY	DATE:												
DRAWING CORRECTED BY	DATE:												
MICRO-FILM INFORMATION													
RECORDED BY	DATE:												
	NO.												

MORROW REARDON
WILKINSON MILLER, LTD.,
LANDSCAPE ARCHITECTS
210 La Veta NE, Albuquerque, NM 87108
505.268.2288 FAX 505.265.9537
mrw@mrwm.com

RECEIVED
MAY 27 2005
HYDROLOGY SECTION

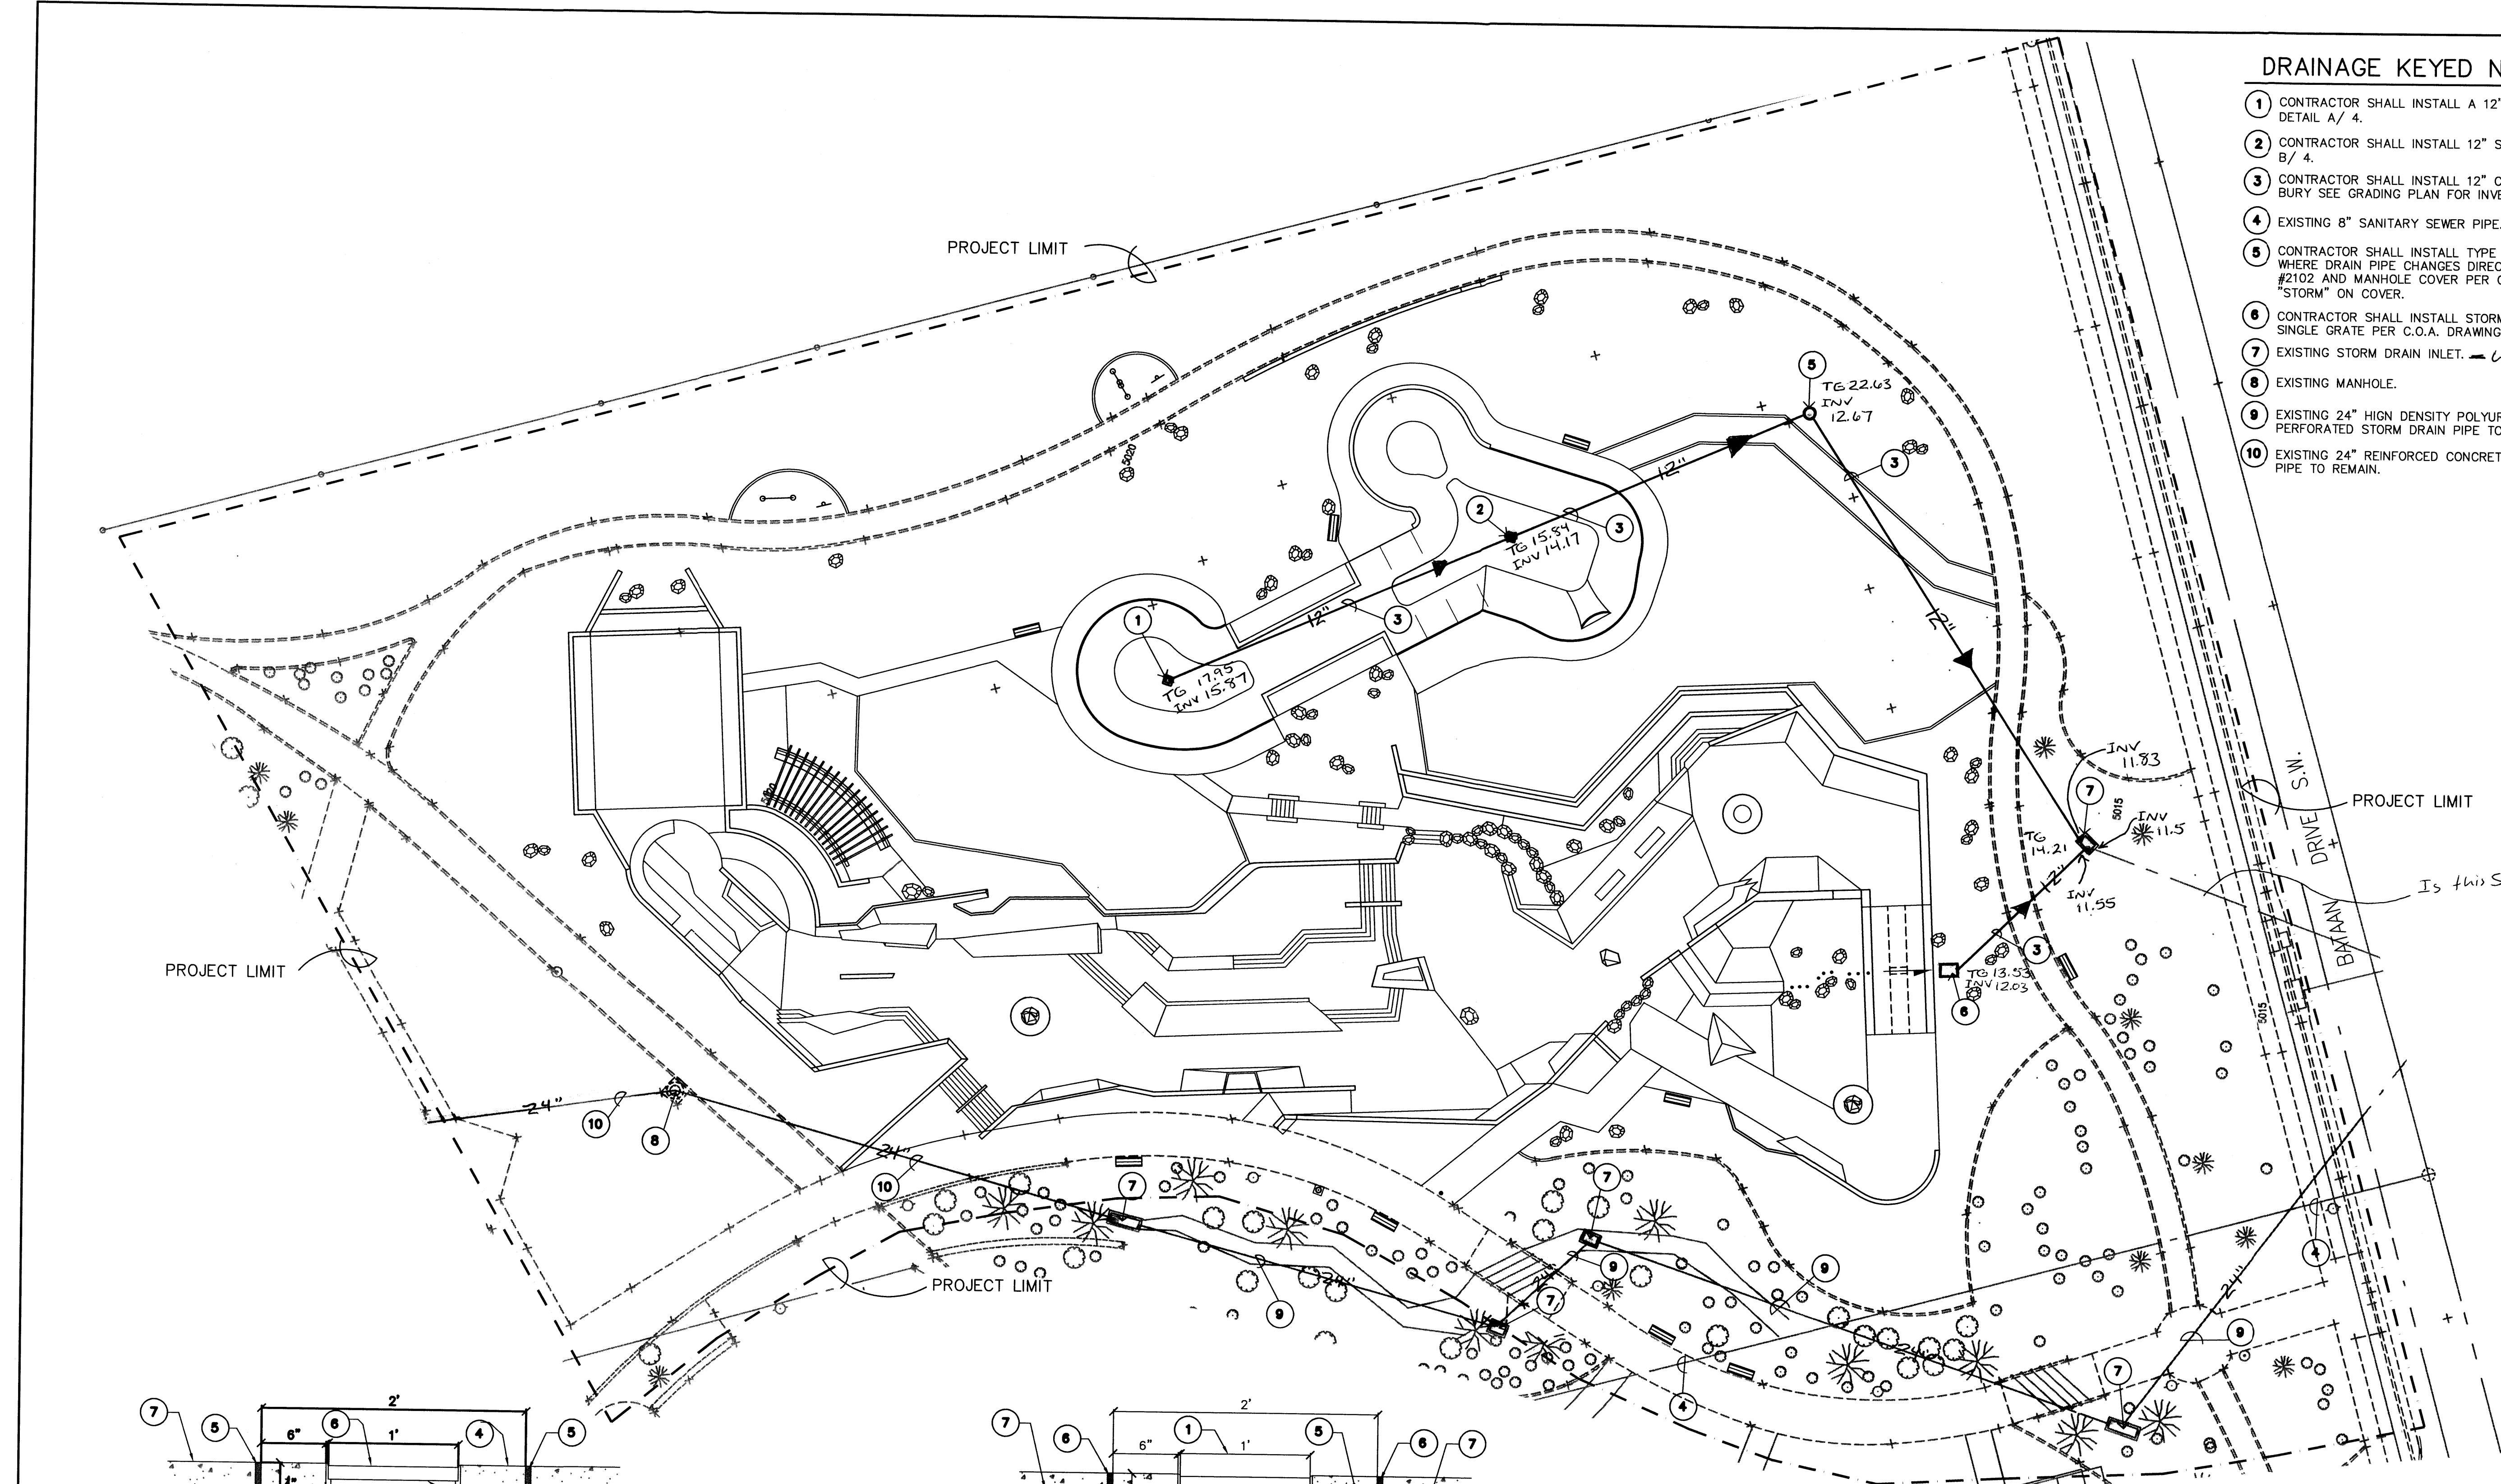

DRAINAGE KEYED NOTES

- CONTRACTOR SHALL INSTALL A 12" STORM DRAIN INLET PER DETAIL A/ 4.
- CONTRACTOR SHALL INSTALL 12" STORM DRAIN INLET PER DETAIL B/ 4.
- CONTRACTOR SHALL INSTALL 12" CORRUGATED PIPE. FOR DEPTH OF BURY SEE GRADING PLAN FOR INVERT ELEVATIONS.
- EXISTING 8" SANITARY SEWER PIPE.
- CONTRACTOR SHALL INSTALL TYPE "E" MANHOLE AT LOCATION WHERE DRAIN PIPE CHANGES DIRECTION PER C.O.A. DRAWING #2102 AND MANHOLE COVER PER C.O.A. DRAWING 2110 WITH "STORM" ON COVER.
- CONTRACTOR SHALL INSTALL STORM DRAIN INLET TYPE "D", WITH SINGLE GRATE PER C.O.A. DRAWING # 2206.
- EXISTING STORM DRAIN INLET. *using existing?*
- EXISTING MANHOLE.
- EXISTING 24" HDPE POLYURETHANE PIPE (HDPE) PERFORATED STORM DRAIN PIPE TO REMAIN.
- EXISTING 24" REINFORCED CONCRETE PIPE (RCP) STORM DRAIN PIPE TO REMAIN.

AS BUILT INFORMATION		BENCHMARK		SURVEY INFORMATION		SEAL		BY		REVISIONS / REMARKS		NO. DATE	
CONTRACTOR	DATE:	WORK STAKED BY	DATE:	FIELD NOTES	DATE								
		INSPECTOR'S APPROVAL	DATE:										
		FIELD VERIFICATION BY	DATE:										
		DRAWING CORRECTED BY	DATE:										
		MICRO-FILM INFORMATION	DATE:										
		RECORDED BY	DATE:										
		NO.											

- NDS 12" X 12" SQUARE, LOW PROFILE SPIGOT ADAPTOR, MODEL #1222. AVAILABLE FROM LOVING & ASSOCIATES (505) 299-1122.
- 8" CORRUGATED PIPE.
- 8" CORRUGATED ELBOW.
- 6" WIDE CONCRETE COLLAR AROUND DRAIN INLET.
- 1/2" WIDE MASTIC EXPANSION JOINT WITH PLASTIC CAPXX ON TOP. THE TOP OF CAP SHALL BE FLUSH WITH TOP OF CONCRETE.
- NDS 12" X 12" MANGANESE BRONZE SQUARE GRADE, MODEL #1214. AVAILABLE FROM LOVING & ASSOCIATES (505) 299-1122.
- CONCRETE SLAB. SEE CONSTRUCTION PLAN.

A 12" DRAIN INLET

12 INCH DRAIN INLET 4/29/05


1-1/2"=1'

- NDS 12" X 12" MANGANESE BRONZE SQUARE GRADE, MODEL #1214 AVAILABLE FROM LOVING & ASSOCIATES (505) 299-1122.
- NDS 12" X 12" SQUARE, LOW PROFILE SPIGOT ADAPTOR, MODEL #1222 AVAILABLE FROM LOVING & ASSOCIATES (505) 299-1122.
- 8" CORRUGATED PIPE.
- 8" "T" CORRUGATED PIPE CONNECTION.
- 6" WIDE CONCRETE COLLAR AROUND DRAIN INLET.
- 1/2" WIDE MASTIC EXPANSION JOINT WITH PLASTIC CAPXX ON TOP. THE TOP OF CAP SHALL BE FLUSH WITH TOP OF CONCRETE.
- CONCRETE SLAB. SEE CONSTRUCTION PLAN.

B 12" DRAIN INLET/"T"


DRAIN INLET 2.DWG 5/08/05

1-1/2"=1'


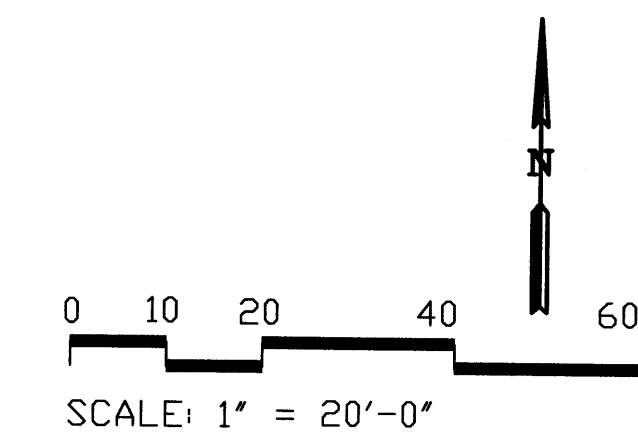


MORROW REARDON
WILKINSON MILLER, LTD.,
LANDSCAPE ARCHITECTS
210 La Veta NE, Albuquerque, NM 87108
505.268.2266 FAX 505.265.9637
mrw@mrwmn.com

CITY OF ALBUQUERQUE DEPARTMENT OF MUNICIPAL DEVELOPMENT	
TITLE: WESTSIDE SKATE PARK - PHASE 1-A DRAINAGE PLAN	
Design Review Committee	City Engineer Approval
City Project No. XXXXX	Zone Map No. K & L-10-7
Update	MO./DAY/YR.
Last Design	MO./DAY/YR.
Sheet	Of
MAY 27 2005	
HYDROLOGY SECTION	

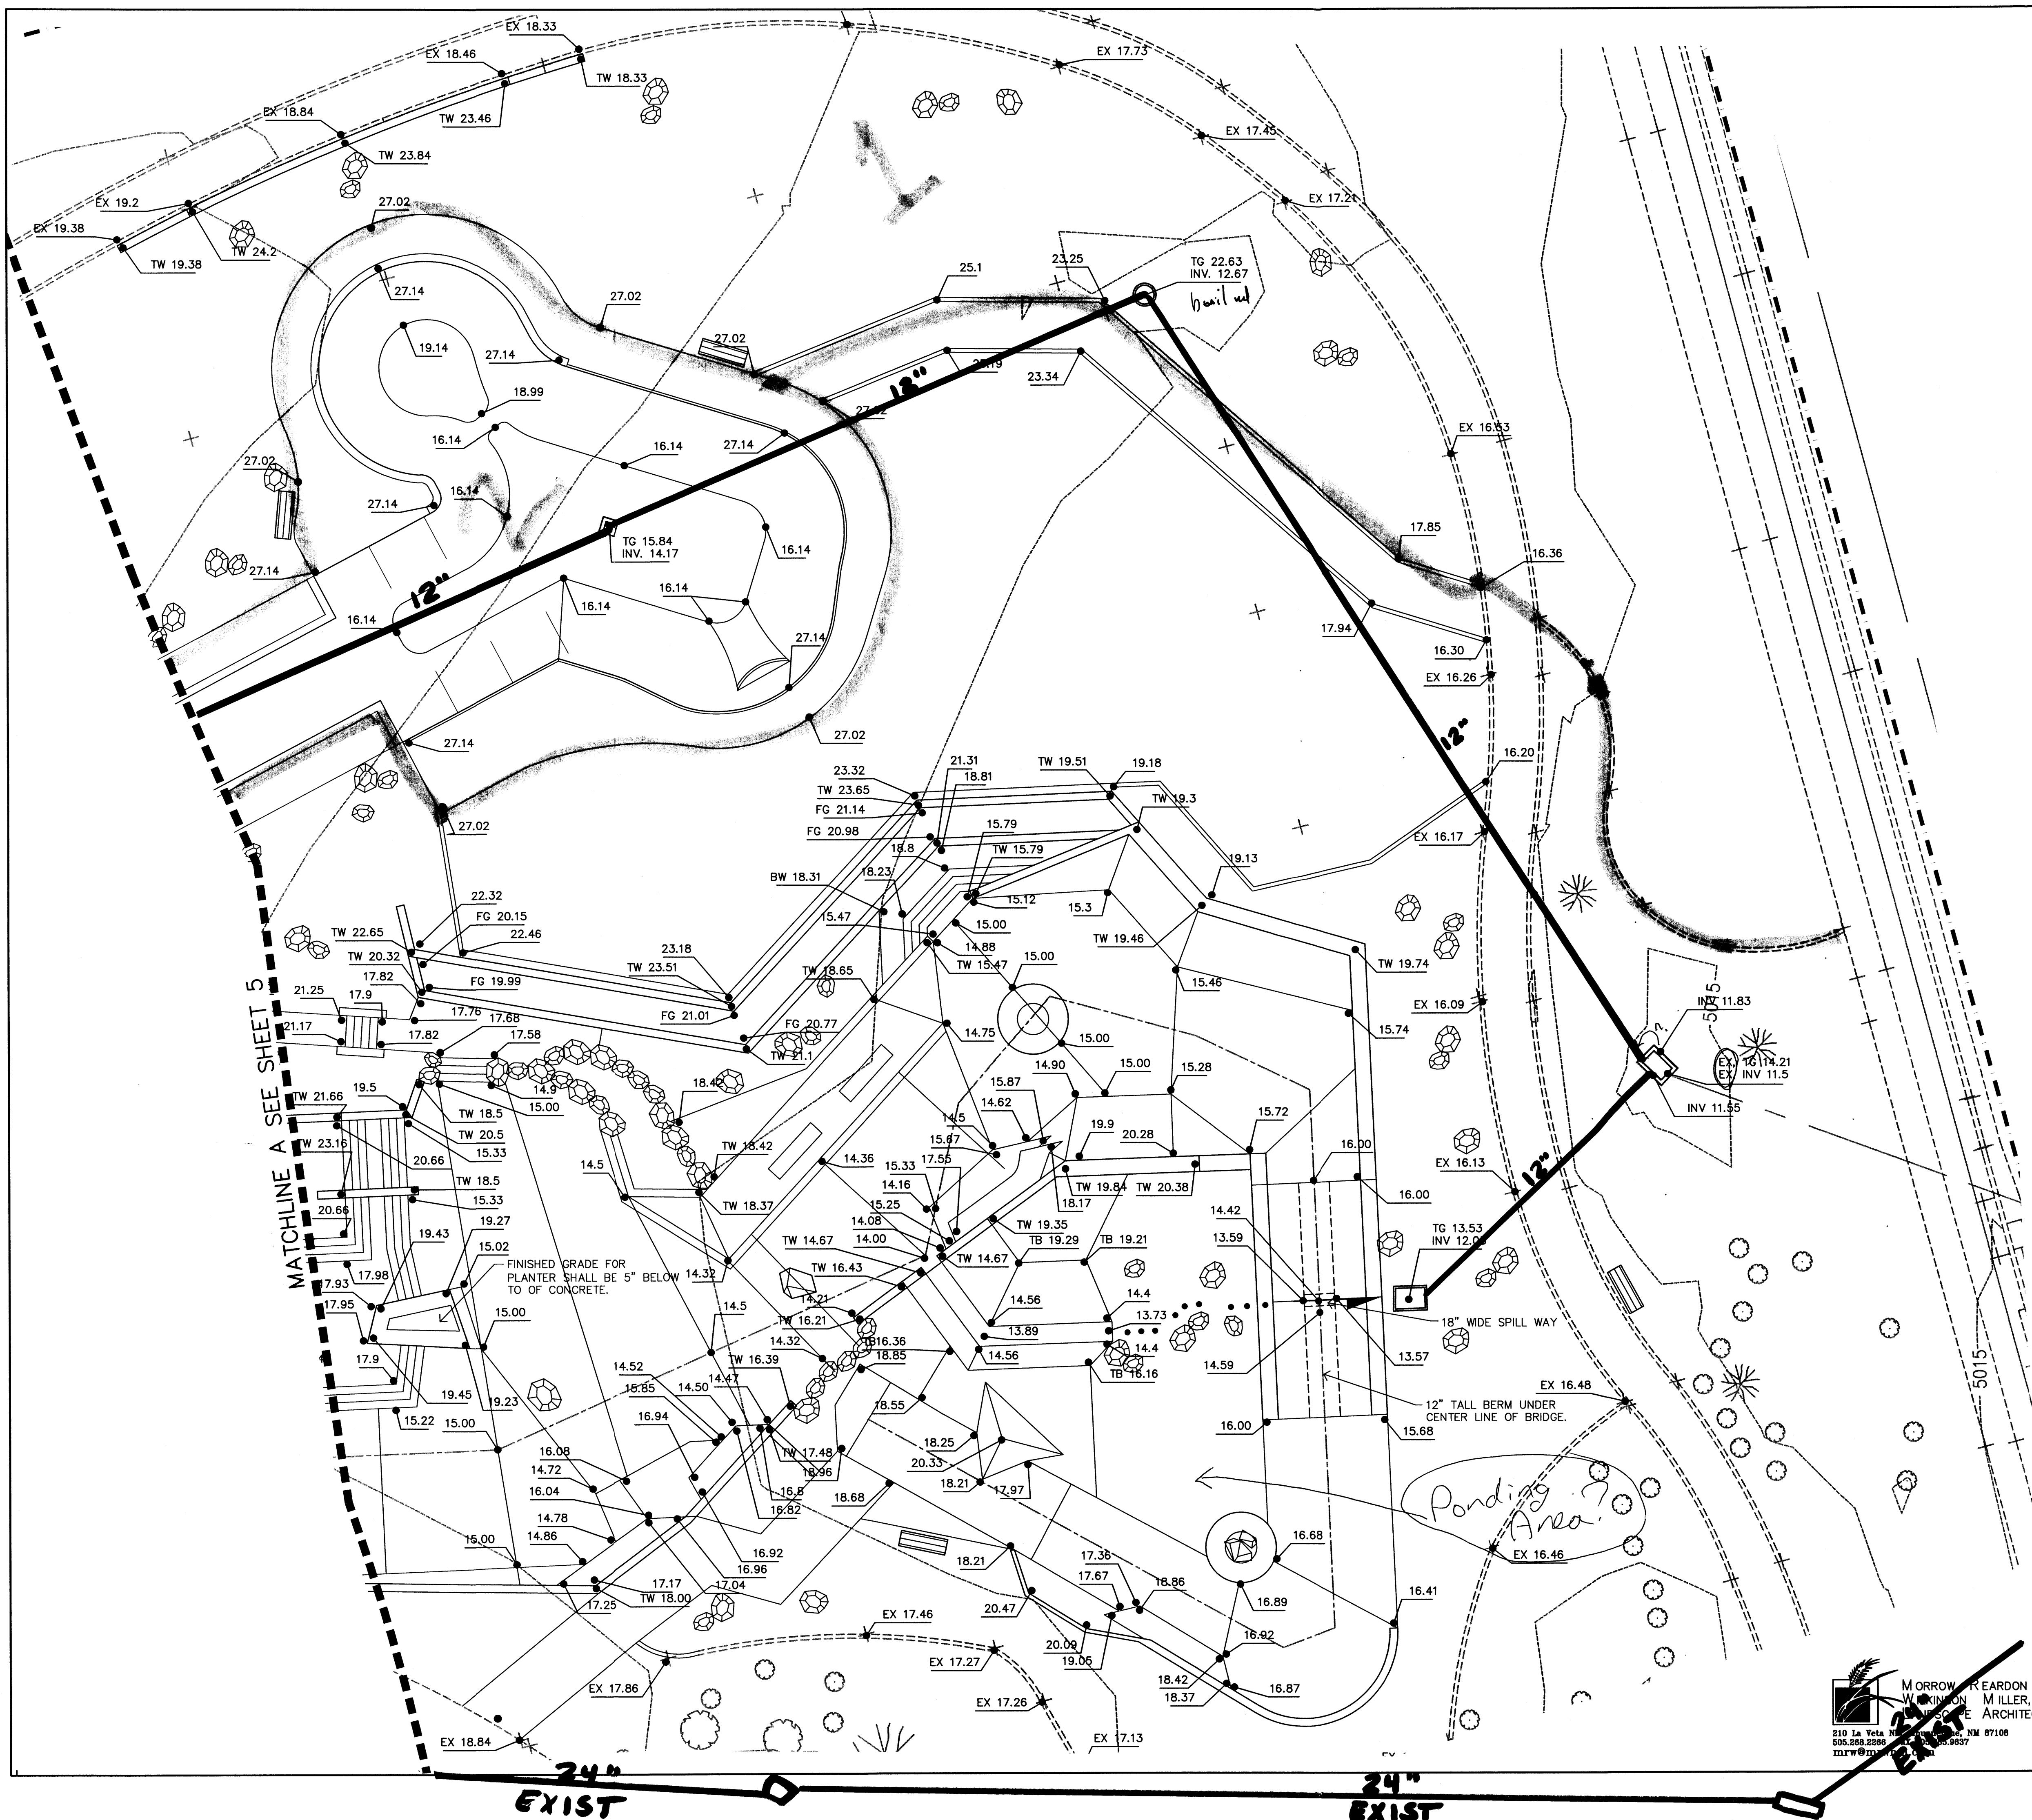

LEGEND	
KEY	DESCRIPTION
BW	BOTTOM OF WALL
EX	EXISTING ELEVATION
INV	INVERT
SD	EXISTING STORM DRAIN
SI	STORM INLET
TC	TOP OF CONCRETE
TG	TOP OF GRATE
TW	TOP OF WALL

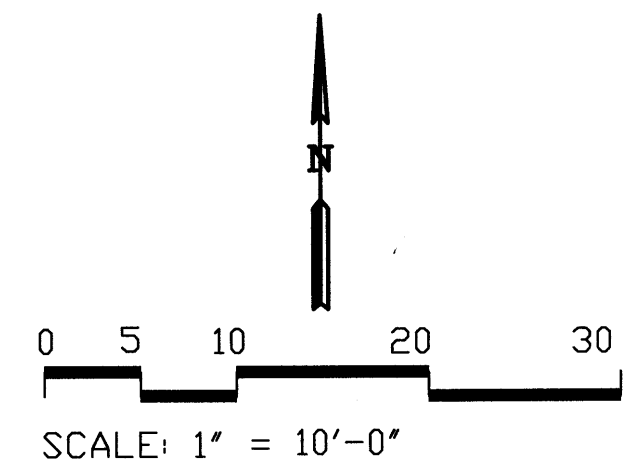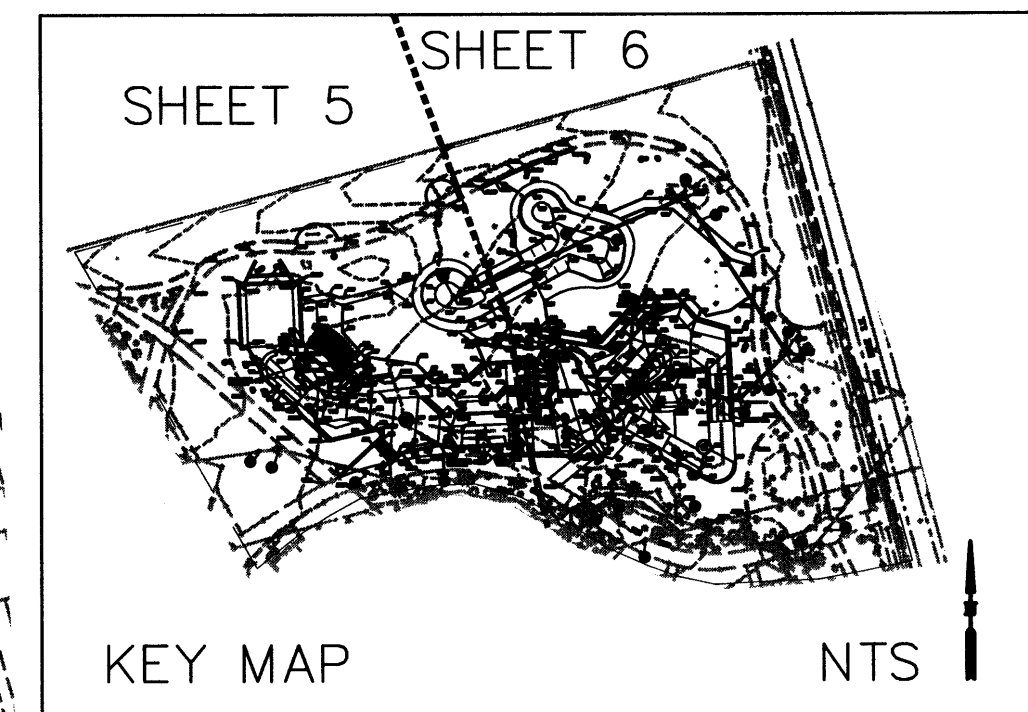

CITY OF ALBUQUERQUE DEPARTMENT OF MUNICIPAL DEVELOPMENT	
TITLE: WESTSIDE SKATE PARK - PHASE 1-A GRADING PLAN	
Design Review Committee	City Engineer Approval
City Project No. XXXXX	Zone Map No. K & L-11-Z
Sheet 6	Of 11

AS BUILT INFORMATION		BENCHMARK		SURVEY INFORMATION		SEAL		REVISIONS / REMARKS		BY		DATE	
CONTRACTOR	DATE:			FIELD NOTES									
WORK STAKED BY	DATE:			NO.	BY								
INSPECTOR'S APPROVAL	DATE:												
FIELD VERIFICATION BY	DATE:												
DRAWING CORRECTED BY	DATE:												
MICRO-FILM INFORMATION													
RECORDED BY	DATE:												
NO.													

MORROW, R. EARDON
WINSTON MILLER, LTD.,
SCAPE ARCHITECTS
210 La Jolla
505.268.2266
mrw@winmiller.com

RECEIVED
MAY 27 2005
HYDROLOGY SECTION