
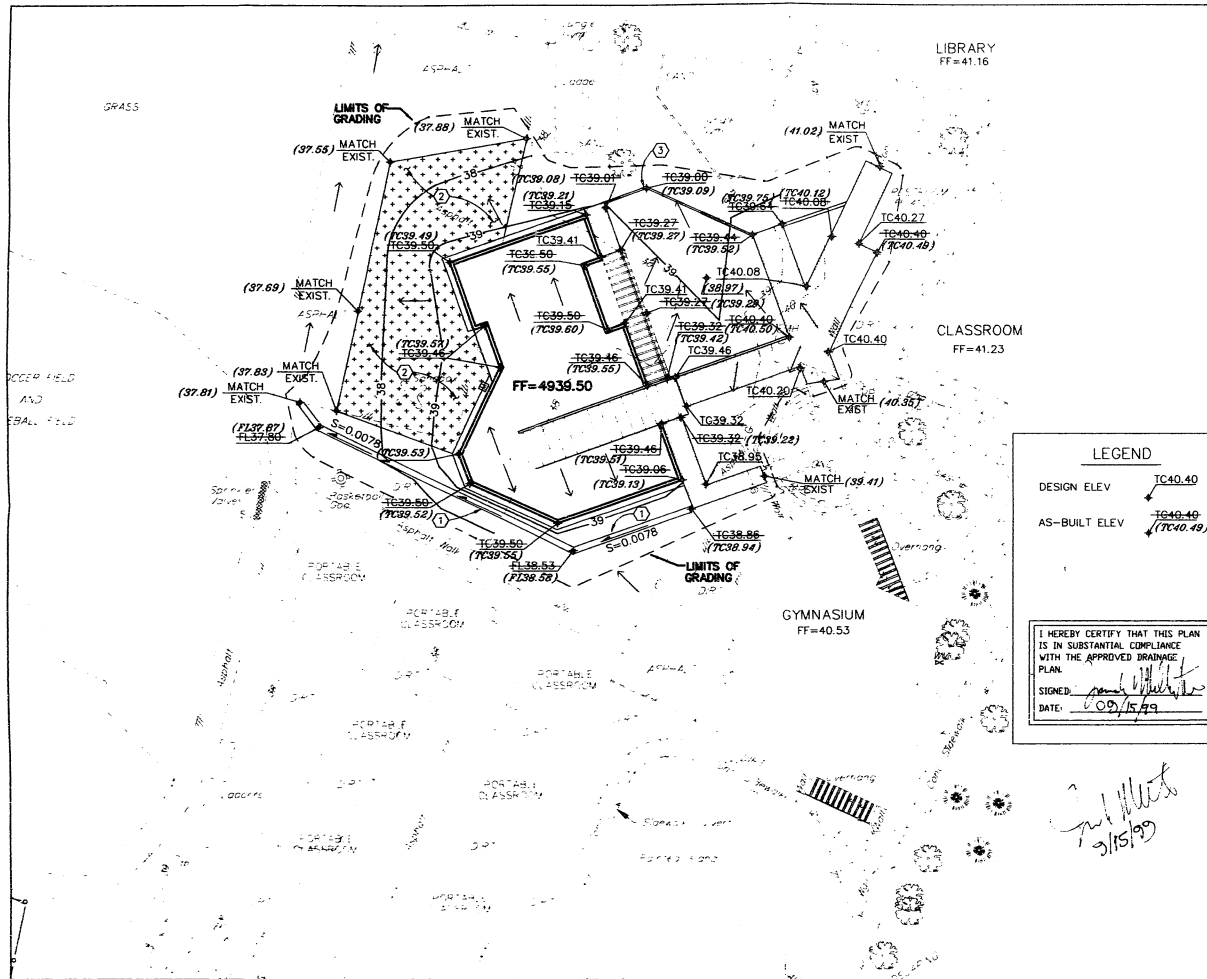


VICINITY MAP

L-11-Z

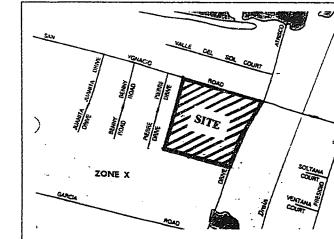

FEMA MAP

PANEL 329



OFFSITE TOPOGRAPHY

LEGEND

- DESIGN ELEV TC40.40
AS-BUILT ELEV TC40.40 (TC40.49)

I HEREBY CERTIFY THAT THIS PLAN IS IN SUBSTANTIAL COMPLIANCE WITH THE APPROVED DRAINAGE PLAN.
SIGNED: [Signature]
DATE: 09/15/99

BENCHMARK

A.C.S. CONTROL STATION "6-L11-R" LOCATED IN THE INTERSECTION OF ATRISCO ROAD SW. AND SAN YGNACIO ROAD SW. ELEVATION=+940.28

TEMPORARY BENCHMARK

RAILROAD SPIKE IN WOOD POWER POLE ON EAST SIDE OF BASKETBALL COURT ON NORTH SIDE OF PROPERTY. ELEVATION=+939.99

SURVEY INFORMATION

SURVEY BY GAYLE D. JEWELL, NMPS NO. 4071. DATED JANUARY 31, 1997.

KEYED NOTES

- 2" VALLEY GUTTER PER DETAIL 3/CB.
- REMOVE AND REPLACE EXISTING ASPHALT PER DETAIL 2/CB.
- INSTALL 1" CURB CUT.

SITE INSPECTION


THE EXISTING GRADES OF THE SITE AS DEPICTED IN THE DRAWING HAVE BEEN FIELD VERIFIED AND REPRESENT THE EXISTING CONDITIONS ACCURATELY.

ALBUQUERQUE PUBLIC SCHOOLS
ATRISCO ELEMENTARY SCHOOL
MEDIA CENTER AND COMPUTER LAB
ALBUQUERQUE, NEW MEXICO

DATE:
JULY 6, 1998
REVISIONS:
SEP 20 1999

SHEET
C6
49

GRADING AND DRAINAGE PLAN

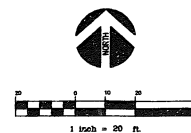

CITY OF ALBUQUERQUE