


ETHLYN AVENUE

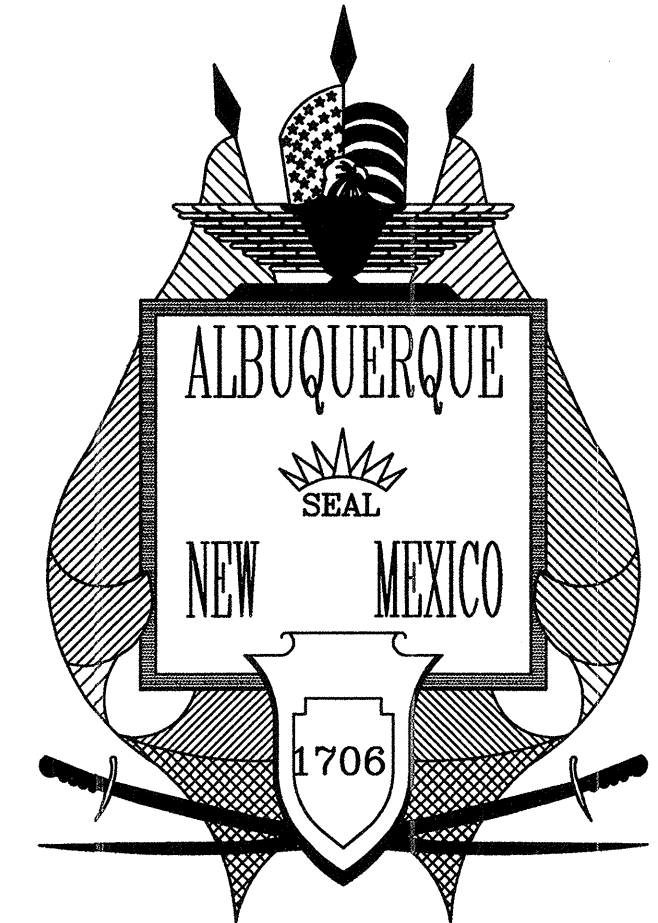


CITY OF ALBUQUERQUE PUBLIC WORKS DEPARTMENT PLANS FOR CONSTRUCTION

ETHLYN AVENUE IMPROVEMENTS

INDEX TO DRAWINGS

SHEET NO.	TITLE
1	TITLE SHEET, VICINITY MAP, SHEET INDEX
2	GENERAL NOTES, LEGEND, & SURVEY CONTROL
3	PLAN AND PROFILE - SYSTEM "B" STATION 10+00 TO STATION 14+00
4	PLAN AND PROFILE - SYSTEM "B" STATION 14+00 TO STATION 17+00
5	PLAN AND PROFILE - SYSTEM "A" STATION 10+00 TO STATION 14+00
6	PLAN AND PROFILE - ETHLYN AVENUE STATION 12+50 TO STATION 17+00
7	PLAN AND PROFILE OF TURNAROUND AND MISCELLANEOUS DETAILS
8	HORIZONTAL AND VERTICAL GEOMETRY PLAN FOR ETHLYN AVENUE
9	TYPICAL TRAFFIC CONTROL AND SIGNING EXAMPLES
10	SIGNING AND CONSTRUCTION TRAFFIC CONTROL STANDARDS

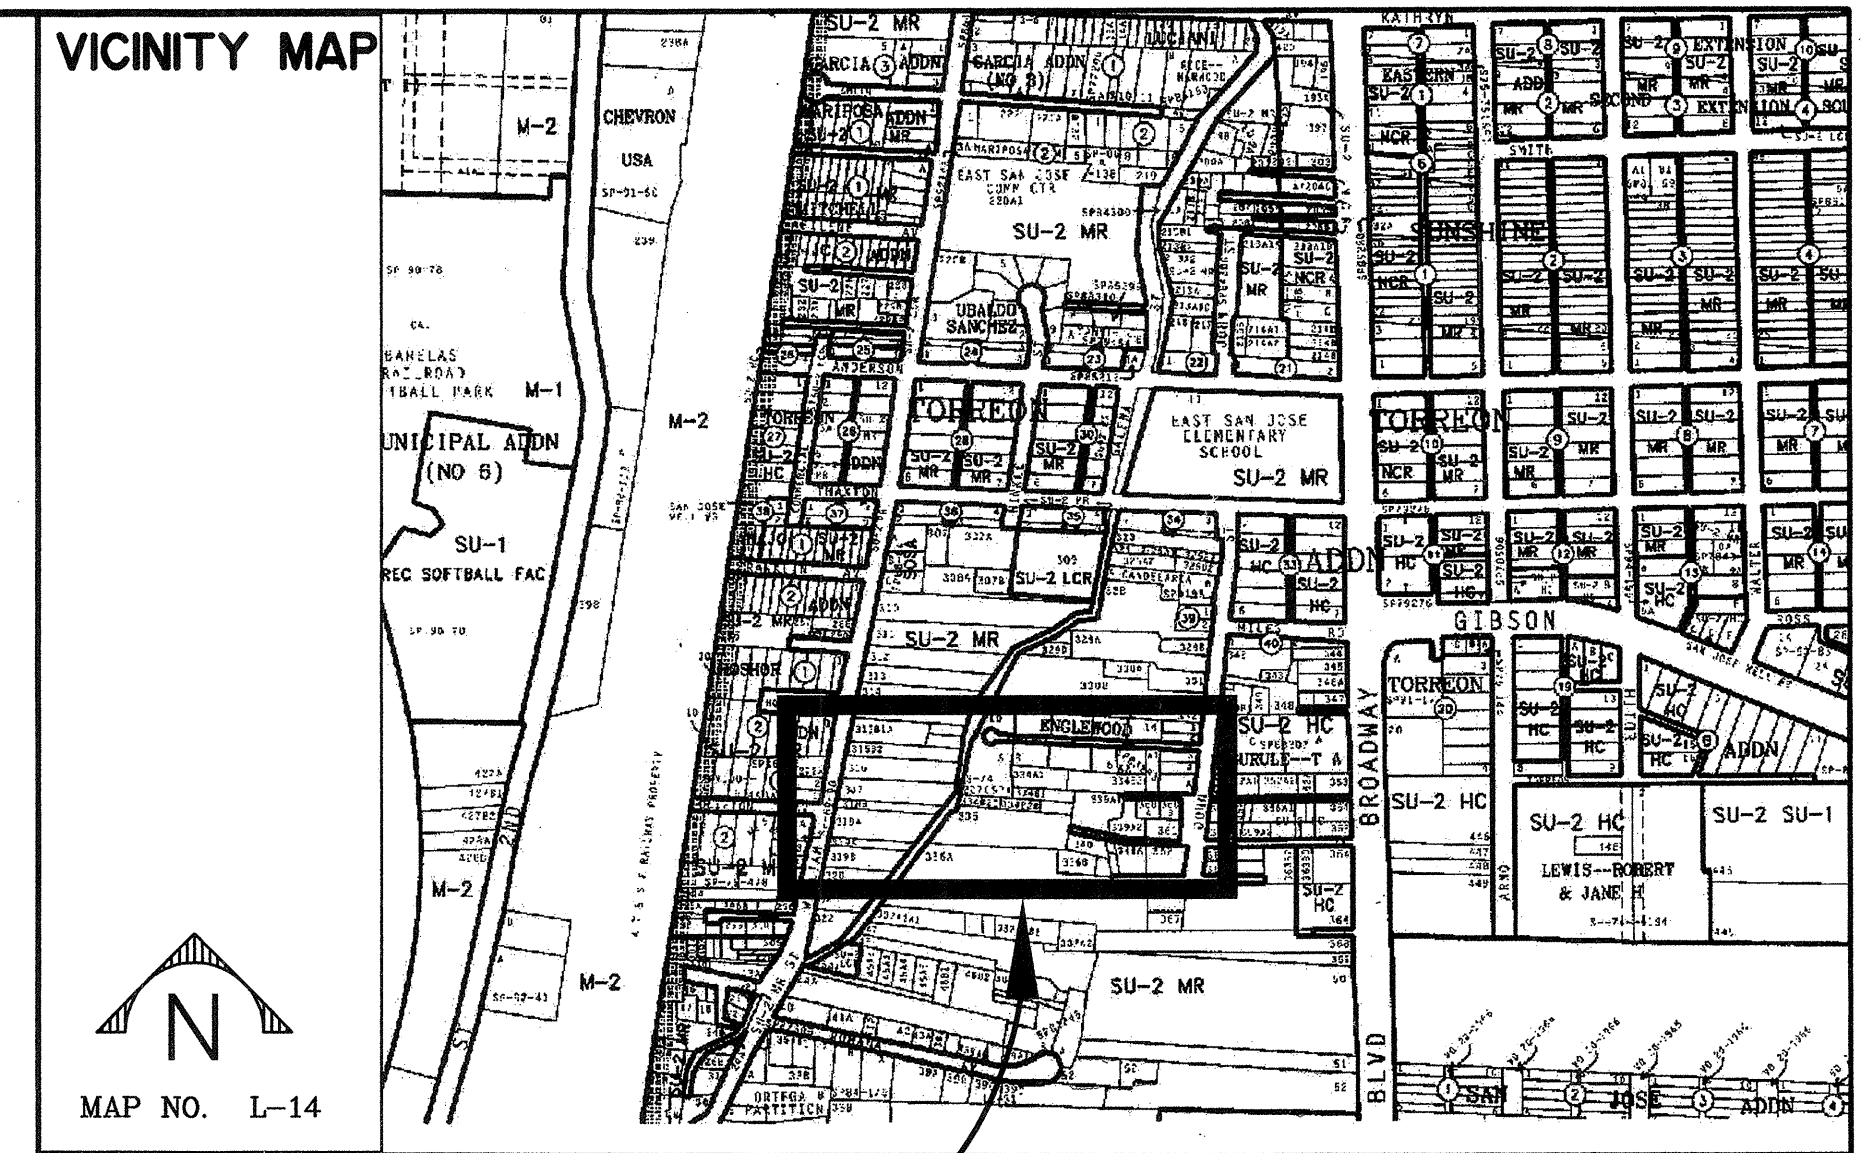

SITE

UTILITY COMPANY CONTACTS

- PNM**
JIM VANN
4201 Edith Blvd., NE
Albuquerque, New Mexico 87107
(505) 848-3426

AT&T
DAVID CROWEL
111 Third ST., NW
Albuquerque, New Mexico 87103
(505) 842-2890

US WEST COMMUNICATIONS
CATHY SCHNEIDER
(505) 245-6846 OR
DAVID MUELLER
(505) 245-8706
201 Third Street NW
Suite 700
Albuquerque, New Mexico 87102

E-SPIRE (ACSI)
STEVE BENJAMIN
505 Marquette NE
Suite 1605
Albuquerque, New Mexico 87102
(505) 842-2806

BROOKS/WORLD-COM/MCI
MCIWorldCom
CALVIN VANWAGNER
2250 Lakeside Blvd.
Richardson, TX 75082
Attn: Investigations
Dept. 2855 / 642
(972) 656-4574
- GAS CO.**
KELLY BOUSKA
4625 Edith Blvd., NE
Albuquerque, New Mexico 87107
(505) 241-7752

JONES INTERCABLE
KAREN SHORE
4611 Montbel Pl., NE
P.O. Box 27138
Albuquerque, New Mexico 87125-7138
(505) 761-6220

**CITY OF ALBUQUERQUE
(WATER & SEWER)**
GREG OLSEN
PWD/Utility Development
P.O. Box 1293
Albuquerque, New Mexico 87103
(505) 768-2719

**GST NEW MEXICO
LIGHTWAVE INC.**
ROYAL HARRISON
3830 Singer Blvd. NE
Suite 1000
Albuquerque, New Mexico 87109
(505) 938-7339

CALL BEFORE
YOU DIG!

STATEWIDE
1-800-321-ALERT

ALBUQUERQUE
260-1990

SEC JOB # 198683

Smith Engineering Company
A Full Service Engineering Company
4400 Olympic Boulevard, S.E. Suite 200 Albuquerque, New Mexico 87105







REV.	SHEETS	CITY ENGINEER	DATE	USER DEPARTMENT	DATE	USER DEPARTMENT	DATE
ENGINEERS STAMP & SIGNATURE		APPROVED	ENGINEER	DATE	APPROVED FOR CONSTRUCTION		
		DRC Chairman			CITY ENGINEER		
		Transportation					
		Water/Wastewater					
		Hydrology					
		C I P			DATE		
		Constr. Mngmt.					
PROJECT NUMBER				5744.90	SHEET 1 OF 10		

- 1
- THREE (3) WORKING DAYS PRIOR TO BEGINNING CONSTRUCTION, THE CONTRACTOR WILL SUBMIT A DETAILED CONSTRUCTION SCHEDULE TO THE CITY CONSTRUCTION COORDINATION DIVISION. TWO (2) DAYS PRIOR TO CONSTRUCTION, THE CONTRACTOR WILL OBTAIN A BARRICADING PERMIT FROM THE CONSTRUCTION COORDINATION DIVISION. CONTRACTOR SHALL NOTIFY BARRICADE ENGINEER (768-2551) PRIOR TO OCCUPYING AN INTERSECTION. REFER TO SECTION 19 OF THE CITY OF ALBUQUERQUE SPECIFICATIONS.
- 2
- THE CONTRACTOR WILL NOTIFY THE FIELD ENGINEER NOT LESS THAN SEVEN (7) DAYS PRIOR TO STARTING WORK, IN ORDER THAT THE FIELD ENGINEER MAY TAKE NECESSARY MEASURES TO INSURE THE PRESERVATION OF SURVEY MONUMENTS. THE CONTRACTOR WILL NOTIFY THE ENGINEER IF A MONUMENT IS DISTURBED. REPLACEMENT WILL BE DONE ONLY BY THE FIELD ENGINEER. WHEN A CHANGE IS MADE IN THE FINISHED ELEVATION OF THE PAVEMENT OF ANY ROADWAY IN WHICH A PERMANENT SURVEY MONUMENT IS LOCATED, CONTRACTOR WILL, AT HIS OWN EXPENSE, ADJUST THE MONUMENT COVER TO THE NEW GRADE UNLESS OTHERWISE SPECIFIED. REFER TO SECTION 4 OF THE CITY OF ALBUQUERQUE SPECIFICATIONS.
- 3
- THE SPECIFICATIONS USED FOR THIS PROJECT ARE THE CITY OF ALBUQUERQUE STANDARD SPECIFICATIONS FOR PUBLIC WORKS CONSTRUCTION, 1994 EDITION, UPDATE NO.6.
- 4
- ALL NEW MANHOLES SHALL BE TYPE "C" (COA DWG. 2107) UNLESS OTHERWISE NOTED ON THE PLANS.
- 5
- THE CONTRACTOR WILL BE RESPONSIBLE FOR DISPOSING OF ALL DEBRIS, INCLUDING, BUT NOT LIMITED TO HAZARDOUS WASTE AT DISPOSAL SITES APPROVED BY GOVERNMENTAL AGENCIES REGULATING THE DISPOSAL OF SUCH MATERIALS.
- 6
- ALL WATER VALVE BOXES AND MANHOLES IN THE STREET CONSTRUCTION ARE TO BE ADJUSTED TO FINISH GRADE AND WILL BE MEASURED AND PAID PER EACH.
- 7
- SUBGRADE PREPARATION UNDER SIDEWALKS AND DRIVE PADS, AND SUBGRADE AND SUBBASE PREPARATION UNDER CURB AND GUTTER IS CONSIDERED INCIDENTAL TO THE CONSTRUCTION OF SUCH, AND NO DIRECT PAYMENT SHALL BE MADE FOR THOSE ITEMS OF WORK.
- 8
- THE WATER SYSTEMS DIVISION (857-8200) WILL BE NOTIFIED BY THE CONTRACTOR FIVE (5) WORKING DAYS IN ADVANCE OF ANY WORK WHICH MAY AFFECT THE EXISTING PUBLIC WATER FACILITIES. REFER TO SECTION 18 OF THE CITY OF ALBUQUERQUE OF SPECIFICATIONS.
- 9
- ALL EXCAVATION WILL BE GOVERNED BY FEDERAL, STATE AND LOCAL LAWS, RULES, AND REGULATIONS CONCERNING CONSTRUCTION SAFETY AND HEALTH.
- 10
- ALL SIGNS AND CODING WILL BE IN ACCORDANCE WITH THE "MANUAL ON UNIFORM TRAFFIC CONTROL DEVICES FOR STREETS AND HIGHWAYS" CURRENT EDITION PUBLISHED BY THE U.S. DEPARTMENT OF TRANSPORTATION.
- 11
- THE CONTRACTOR IS TO EXERCISE CARE TO AVOID DISTURBING ANY EXISTING UNDERGROUND UTILITIES. IT WILL BE HIS RESPONSIBILITY TO COORDINATE WITH THE UTILITY COMPANIES IN ORDER TO PREVENT ANY SERVICE DISRUPTION. SEE SECTION 18 "UTILITIES", CITY OF ALBUQUERQUE, STANDARD SPECIFICATIONS FOR CONTRACTOR REQUIREMENTS.
- 12
- WHEN ABUTTING NEW PAVEMENT TO EXISTING INTERSECTING STREETS, SAW CUT EXISTING PAVEMENT TO A STRAIGHT LINE AND AT RIGHT ANGLES AND REMOVE ANY BROKEN OR CRACKED PAVEMENT. NO DIRECT PAYMENT WILL BE MADE FOR SAW CUTTING.
- 13
- ALL GAS VALVES, GAS MANHOLES, ELECTRICAL MANHOLES, TELEPHONE MANHOLES, AND UTILITY POLES WILL BE ADJUSTED TO GRADE BY EACH UTILITY COMPANY. CONTRACTOR WILL COORDINATE THROUGH CITY UTILITY COORDINATOR.
- 14
- WHEN REMOVAL OF EXISTING CURB AND GUTTER OR SIDEWALK IS REQUIRED, REMOVE BACK TO NEAREST SUITABLE JOINT UNLESS OTHERWISE DIRECTED BY THE CITY FIELD ENGINEER.
- 15
- THE CONTRACTOR WILL NOTIFY THE UTILITY COMPANIES BY CALLING NEW MEXICO ONE CALL SYSTEM 260-1990 TWO (2) WORKING DAYS PRIOR TO COMMENCING WORK IN NEW AREAS.
- 16
- CONTRACTOR WILL MAKE ALL WATER VALVES AND MANHOLES ACCESSIBLE TO THE CITY AT ALL TIMES.
- 17
- CONTRACTOR WILL PLACE BITUMINOUS MATERIAL WITH THE USE OF A LAYDOWN MACHINE WHERE PAVEMENT IS 8 FEET IN WIDTH OR WIDER.
- 18
- ALL SUBGRADE AND SUBBASE MATERIAL ENCOUNTERED IN PAVEMENT REMOVAL AND REPLACEMENT THAT IS DETERMINED BY THE FIELD ENGINEER TO MEET THE SPECIFICATIONS, CAN BE REUSED. HOWEVER, THE MATERIAL WILL BE PROCESSED AND COMPACTED TO MEET MOISTURE CONTENT AND PERCENT COMPACTING REQUIRED BY THE SPECIFICATIONS.
- 19
- CONTRACTOR WILL NOT PAVE OVER ANY SURFACE FEATURE, I.E., GAS VALVE, MANHOLE COVER, ETC. WITHOUT PRIOR APPROVAL FROM THE CITY FIELD ENGINEER.
- 20
- CONTRACTOR WILL CONFINE HIS WORK WITHIN THE CONSTRUCTION EASEMENT LIMITS AND/OR RIGHT-OF-WAY, OR PROVIDE COPIES OF AGREEMENTS WITH ADJACENT LANDOWNERS TO THE CITY OF ALBUQUERQUE.





- 21
- ALL WATER VALVES AND FIRE HYDRANTS REMOVED TO BE SALVAGED AND RETURNED TO THE CITY OF ALBUQUERQUE.
- 22
- MINIMUM BOTTOM WIDTH OF TRENCHES FOR RIGID PIPE SHALL BE EQUAL TO THE OUTSIDE DIAMETER PLUS 16 INCHES. BEDDING MATERIAL SHALL BE CLASS II, III, OR IV UNLESS OTHERWISE SPECIFICALLY NOTED ON THE PLANS.
- 23
- MINIMUM BOTTOM WIDTH OF TRENCHES FOR NON-RIGID PIPE SHALL BE EQUAL TO THE OUTSIDE DIAMETER PLUS 12 INCHES. BEDDING MATERIAL SHALL BE CLASS I, II, OR III.
- 24
- THE CONTRACTOR AGREES TO TAKE NECESSARY SAFETY PRECAUTIONS AS REQUIRED BY FEDERAL, STATE AND LOCAL AUTHORITIES TO PROTECT PEDESTRIAN AND VEHICULAR TRAFFIC IN THE CONSTRUCTION AREA, WHICH INCLUDE BUT ARE NOT LIMITED TO: MAINTAINING ADEQUATE WARNING SIGNS, BARRICADES, LIGHTS, GUARD FENCES, WALKS AND BRIDGES.
- 25
- ALL STRUCTURAL CONCRETE TO BE 4000 PSI UNLESS OTHERWISE NOTED ON PLANS.
- 26
- ALL REINFORCING STEEL TO BE GRADE 60.
- 27
- ALL EXPOSED EDGES ON CAST-IN-PLACE CONCRETE STRUCTURES WILL HAVE A 1" CHAMFER UNLESS OTHERWISE NOTED.
- 28
- ALL SPLICES IN REINFORCING STEEL TO BE 2-FOOT 6-INCH MINIMUM UNLESS OTHERWISE NOTED.
- 29
- PRIOR TO CONSTRUCTION, THE CONTRACTOR WILL EXCAVATE AND VERIFY THE HORIZONTAL AND VERTICAL LOCATIONS OF ALL POTENTIAL CONFLICTING UTILITIES. SHOULD A CONFLICT EXIST BETWEEN THE FIELD INFORMATION AND THE PLANS, THE CONTRACTOR WILL NOTIFY THE CITY FIELD ENGINEER SO THE CONFLICT CAN BE RESOLVED WITH MINIMUM AMOUNT OF DELAY.
- 30
- THE REPLACEMENT OF THE EXISTING UTILITIES AND THE INSTALLATION OF NEW UTILITY LINES WILL BE COMPLETED IN ADVANCE OF STARTING THE PAVEMENT WORK. TEMPORARY PAVEMENT WILL BE PLACED IN ALL TRENCHES REQUIRED FOR THE UTILITY REPLACEMENTS IN THOSE AREAS THAT MUST MAINTAIN TRAFFIC UNTIL THE FINAL PAVEMENT WORK STARTS IN EACH AREA. TEMPORARY STRIPING SHALL BE THE CONTRACTOR'S RESPONSIBILITY. MAINTENANCE OF THE TEMPORARY PAVING AND STRIPING WILL BE AT THE CONTRACTOR'S EXPENSE.
- 31
- TACK COAT FOR SURFACE COURSE REQUIREMENTS WILL BE DETERMINED BY THE CITY FIELD ENGINEER.
- 32
- THE CONTRACTOR WILL CONTACT THE CITY OF ALBUQUERQUE TRAFFIC DIVISION (764-1599), ONE (1) WEEK IN ADVANCE OF ANY CHANGES REQUIRED IN THE TRAFFIC SIGNALIZATION OF THIS PROJECT. ALL WORK ASSOCIATED WITH NEW TRAFFIC SIGNALIZATION SHALL BE THE RESPONSIBILITY OF THE CONTRACTOR.
- 33
- ALL NEW STREET PAVING, DRIVEWAYS, SIDEWALKS, AND CURB AND GUTTERS, ABUTTING EXISTING AREAS SHALL MATCH THE ELEVATION OF THOSE AREAS.
- 34
- PERMANENT PAVEMENT STRIPING AND MARKINGS WILL BE PLACED BY THE CONTRACTOR. ROAD SHALL NOT BE OPENED TO TRAFFIC UNTIL IT IS STRIPED. ALL STRIPING, PAVEMENT MARKINGS INCLUDING CROSSWALKS, ARROWS AND LINE MARKINGS ARE TO BE CONSTRUCTED OF HOT PLASTIC OR COLD PLASTIC IN ACCORDANCE WITH THE MANUAL OF UNIFORM TRAFFIC CONTROL DEVICES.
- 35
- ALL EXCAVATED MATERIAL THAT IS NOT REQUIRED TO BE REUSED MUST BE REMOVED FROM THE PROJECT AREA WITHIN FOUR DAYS OF EXCAVATION. SPOIL PILES WILL BE ALLOWED ONLY AS DIRECTED BY THE CITY FIELD ENGINEER.
- 36
- THE CONTRACTOR WILL COORDINATE THE CONSTRUCTION ACTIVITIES WITH ALL OTHER CONTRACTORS AND UTILITY COMPANIES WORKING IN THE SAME AREA. THE CONTRACTOR MAY BE REQUIRED TO RESCHEDULE THEIR ACTIVITIES TO ALLOW UTILITY CREWS TO PERFORM THEIR REQUIRED WORK. NO ADDITIONAL COMPENSATION WILL BE ALLOWED FOR DELAYS OR INCONVENIENCE CAUSED BY UTILITY COMPANY WORK CREWS. A CONTRACT EXTENSION MAY BE ALLOWED AS DELINEATED IN CITY OF ALBUQUERQUE STANDARD SPECIFICATIONS.
- 37
- ALL CONSTRUCTION EASEMENTS ON PRIVATE PROPERTY WILL BE OBTAINED BY THE CONTRACTOR PRIOR TO THE BEGINNING OF CONSTRUCTION.
- 38
- EXISTING MEDIAN CURB AND GUTTER AND STANDARD CURB AND GUTTER, NOT DISTURBED BY CONTRACTOR, BUT OUT OF ALIGNMENT, DISPLACED VERTICALLY, BADLY BROKEN AND/OR DETERIORATED, WILL BE REPLACED AS DIRECTED BY THE CITY FIELD ENGINEER AND PAID FOR AT CONTRACT UNIT PRICES.
- 39
- ALL TRAFFIC CONTROL DEVICES REQUIRED FOR DRIVEWAY CLOSURES, UTILITY CONSTRUCTION OR FOR OTHER REASONS AND NOT SHOWN ON THE SIGNING PLANS WILL BE FURNISHED BY THE CONTRACTOR. PRIOR TO PLACING THE TRAFFIC CONTROL DEVICES, THE CONTRACTOR WILL NOTIFY THE AFFECTED OWNERS IN ACCORDANCE WITH THE SPECIFICATIONS. CONTRACTOR MUST MAKE PROVISIONS TO PROVIDE ACCESS TO PROPERTIES. REFER TO SECTION 19 OF THE CITY OF ALBUQUERQUE SPECIFICATIONS.

- 40
- ALL UTILITY LINES WHICH ARE NOT SPECIFICALLY DESIGNATED TO BE REMOVED AND REPLACED ON THE PLANS, WILL BE MAINTAINED IN SERVICE. SHORING, SHEETING AND OTHER MEANS OF SUPPORT SHALL BE EMPLOYED BY THE CONTRACTOR TO PREVENT DAMAGE OR LOSS OF THESE EXISTING UTILITIES. BEAM AND CABLE OR OTHER ADEQUATE SUPPORTS WILL BE USED FOR TEMPORARY SUPPORT OF ALL UTILITY LINES WHICH CROSS THE TRENCH. ANY DAMAGE TO EXISTING UTILITIES WILL PROMPTLY BE REPAIRED AT THE CONTRACTOR'S EXPENSE. THE CONTRACTOR WILL NOTIFY THE ENGINEER IMMEDIATELY OF ANY SIGNIFICANT DEVIATION OF EXPOSED UTILITIES FROM THE LOCATIONS SHOWN ON THE PLANS SO THAT CONFLICTS CAN BE RESOLVED IN A TIMELY MANNER.
- 41
- THE CONTRACTOR WILL ASSUME RESPONSIBILITY FOR ANY DAMAGE TO EXISTING COA INFRASTRUCTURE (C & G, PAVING, ETC.) DURING CONSTRUCTION, APART FROM THOSE SECTIONS INDICATED FOR REMOVAL ON THE PLANS, AND WILL REPAIR OR REPLACE SAME AT HIS OWN EXPENSE. HE WILL SUITABLY PROTECT THE CURB AND GUTTER FROM INCIDENTAL SPLASHING DURING THE TACK COAT APPLICATION AND WILL BE RESPONSIBLE FOR CLEANING SAME AT HIS OWN COST SHOULD SPLASHING OCCUR.
- 42
- ALL INTERFERING PORTIONS OF ABANDONED UTILITY LINES WHICH ARE EXPOSED AS A RESULT OF CONSTRUCTION WILL BE REMOVED AND DISPOSED OF BY THE CONTRACTOR.
- 43
- STATIONS OF STORM DRAIN INLETS ARE TO THE CENTER OF GRATE UNLESS OTHERWISE NOTED ON THE PLANS.
- 44
- SHORING COSTS WILL BE CONSIDERED INCIDENTAL TO THE TRENCH AND BACKFILL COSTS.
- 45
- THE CONTRACTOR WILL BE RESPONSIBLE FOR SECURING NPDES PERMITS REQUIRED BY APPLICABLE CITY, STATE, AND FEDERAL REGULATIONS.
- 46
- ALL STORM DRAIN AND CONNECTOR PIPE WILL BE EITHER DUCTILE IRON, CLASS 250 OR HIGH DENSITY POLYETHYLENE PLASTIC PIPE. CONTRACTOR SHALL CONFORM TO ALL SPECIFICATIONS OF THE MANUFACTURER FOR THE INSTALLATION OF THE DUCTILE IRON OR PLASTIC STORM DRAIN PIPE. REFER TO SECTION 121 OF THE CITY OF ALBUQUERQUE STANDARDS FOR PLASTIC PIPE ANS SECTION 129 FOR THE DUCTILE IRON PIPE.
- 47
- THE TERM REMOVE USED IN THIS PLAN SET INCLUDES THE DISPOSAL OF SAID MATERIAL IN ACCORDANCE WITH CITY OF ALBUQUERQUE SPECIFICATIONS, LATEST EDITION.
- 48
- CONTRACTOR WILL SURVEY AND LOG EXISTING ELEVATIONS OF CURB-AND-GUTTER, SIDEWALK, AND PAVEMENT TO ELEVATIONS PRIOR TO REMOVAL UNLESS OTHERWISE INDICATED ON THE PLANS.
- 49
- CONTRACTOR WILL CONSTRUCT TEMPORARY ASPHALT PAVEMENT AS DIRECTED BY THE COA ENGINEER TO PROVIDE ACCESS TO LOCAL BUSINESS, ETC. TEMPORARY PAVEMENT SHALL BE REMOVED AND DISPOSED OF PRIOR TO PLACEMENT OF FULL WIDTH PAVEMENT SECTION. TEMPORARY PAVING SHALL BE PER COA STD. DWG. 2415 AND PAID FOR PER COA STD. SPECIFICATIONS.
- 50
- ALL CLASSES OF SEEDING SHALL BE DRY LAND MIX PLACED AT 1.5 LBS/1000 S.F. WITH FERTILIZER 21-12-12 PLACED AT 5 LBS/1000 S.F.
- 51
- PRE-WETTING OF THE EMBANKMENT FOUNDATION AND KEY TRENCH SHALL BE CONSIDERED INCIDENTAL TO THE CONSTRUCTION OF THE EMBANKMENT. NO ADDITIONAL PAYMENT WILL BE MADE FOR THIS WORK.
- 52
- ALL ASPHALTIC CONCRETE SHALL BE MINIMUM 1800 LB. STABILITY AND COMPACTED TO 95% MODIFIED MARSHALL DENSITY UNLESS OTHERWISE NOTED ON THE PLANS.
- 53
- ALL RIP-RAP MATERIAL USED ON THIS PROJECT SHALL BE A NATURAL ROCK MATERIAL CONFORMING TO THE SIZE AND MATERIAL PROPERTY REQUIREMENTS SET FORTH IN THE COA STANDARD SPECIFICATIONS. NO BROKEN CONCRETE OR RUBBLE WILL BE ACCEPTED.
- 54
- HIGH DENSITY POLYETHLENE PIPE SHALL BE INSTALLED IN ACCORDANCE WITH ASTM D2321 WITH THE EXCEPTION THAT THE MINIMUM COVER IN AREAS WITH VEHICULAR TRAFFIC SHALL BE ONE FOOT.

EXISTING FEATURES LEGEND:

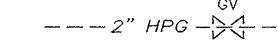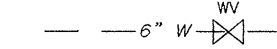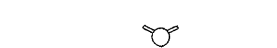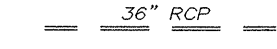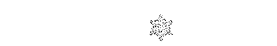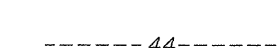-  EXISTING CHAIN-LINK FENCE
-  EXISTING GAS LINE W/ VALVE
-  EXISTING WATERLINE W/ VALVE
-  EXISTING WATERLINE METER
-  EXISTING FIRE HYDRANT
-  EXISTING SANITARY SEWER LINE W/ MANHOLE
-  EXISTING STROM DRAIN
-  EXISTING UTILITY POLE
-  EXISTING 1' CONTOUR
-  EXISTING 5' CONTOUR
-  EXISTING CURB & GUTTER
-  EXISTING CONCRETE
-  EXISTING BUILDING LINE
-  EXISTING EASEMENT LINE

NEW FEATURES LEGEND:

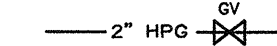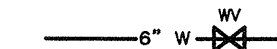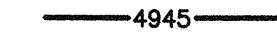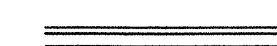-  CONSTRUCTION CENTERLINE
-  NEW CHAIN-LINK FENCE
-  NEW GAS LINE W/ VALVE
-  NEW WATERLINE W/ VALVE
-  NEW WATERLINE METER
-  NEW FIRE HYDRANT
-  NEW SANITARY SEWER LINE W/ MANHOLE
-  NEW STROM DRAIN
-  NEW UTILITY POLE
-  NEW 1' CONTOUR
-  NEW 5' CONTOUR
-  NEW CURB & GUTTER
-  NEW CONCRETE
-  NEW EASEMENT LINE
-  POT HOLE LOCATION W/ NO.
-  NEW EDGE OF PAVEMENT

POTHOLING INFORMATION

NO.	BURY TO TOP OF PIPE	DESCRIPTION		
		UTILITY	MATERIAL	DIAMETER
1	1'-10"	GAS	METALLIC	2"
2	1'-10"	GAS	METALLIC	2"
3	2'-5"	WATER	METAL	1 1/4"
4	11"	WATER	METAL	1"
5	4'-8"	SAS	CONCRETE	12"
6	3'-2"	WATER	PVC	6"
7	1'-10"	WATER	PVC	2"
8	2'-0"	WATER	PVC	2"
9	3'-0"	WATER	PVC	6"
10	11"	GAS	METAL	2"
10A	9"	GAS	METAL	1"
11	3'-8"	WATER	METAL	4"
11A	3'-4"	WATER	COPPER	1"
12	2'-5"	GAS	METAL	2"
12A	2'-3"	GAS	METAL	1"
13	3'-11"	WATER	COPPER	1/2"

SYSTEM 'A' CONSTRUCTION CENTERLINE SURVEY CONTROL INFORMATION

STATION	NORTHING	EASTING
10+00.00	1,477,637.04	380,835.14
13+06.40	1,477,609.32	381,140.29
15+24.66	1,477,534.28	381,345.25
17+14.64	1,477,522.80	381,534.88

SYSTEM 'B' CONSTRUCTION CENTERLINE SURVEY CONTROL INFORMATION

STATION	NORTHING	EASTING
10+00.00	1,477,538.02	380,511.37
12+31.17	1,477,519.08	380,741.76
13+81.61	1,477,637.04	380,835.14
14+18.93	1,477,666.30	380,858.30
15+96.27	1,477,839.82	380,894.87

LOCAL SURVEY CONTROL INFORMATION

POINT NUMBER	NORTHING	EASTING	ELEVATION	DESCRIPTION
CP-1	1,477,481.07	381,524.76	4958.02	MASONRY NAIL IN SIDEWALK JNT.
CP-2	1,477,589.63	381,218.12	4950.03	REBAR W/ CAP "NM 11599"
CP-3	1,477,839.49	380,892.98	4947.73	REBAR W/ CAP "NM 11599"
CP-4	1,477,636.12	380,844.18	4945.91	REBAR W/ CAP "NM 11599"
CP-5	1,477,526.86	380,749.72	4945.31	REBAR W/ CAP "NM 11599"
CP-6	1,477,530.65	380,509.97	4944.02	PK NAIL IN ASPHALT

 198683
Smith Engineering Company
A Full Service Engineering Company
6000 Uptown Boulevard, N.E. Suite 6000 Albuquerque, New Mexico 87120

CITY OF ALBUQUERQUE
PUBLIC WORKS DEPARTMENT
ENGINEERING DEVELOPMENT GROUP

TITLE: ETHLYN AVENUE IMPROVEMENTS
GENERAL NOTES, LEGEND, & SURVEY CONTROL

Design Review Committee

City Engineer Approval

Last Design Update

No. / Day / Yr.

No. / Day / Yr.

DESIGNED BY

DRAWN BY

CHECKED BY

MUR

MUR

CTB

DATE

DATE

DATE

1/00

1/00

1/00

City Project No.

Zone Map No.

Sheet

Of

5744.90

L-14

2

10

AS-BUILT INFORMATION

BENCH MARKS

SURVEY INFORMATION

ENGINEERS SEAL

CONTRACTOR
DATE
INSPECTOR'S
DATE
FIELD ENGINEER
DATE
VERIFICATION BY
DATE
CORRECTED BY
DATE
MICRO-FILM INFORMATION
RECORDED BY
DATE
NO.

NO. 1
BY STEVE TOLER
SURVEYING CONTROL INC.

REMARKS
DESIGN
DATE 1/00
DATE 1/00
DATE 1/00

OF 24" ROM TO IF FOR D TO E

14+00

15+00

NOT IN MODEL
MODEL DIA: N/A
AS-BUILT DIA: 24"

LINE TO REMAIN UNDISTURBED THROUGHOUT CONSTRUCTION

STA. 14+03.34, 3.51' LT.
EXISTING SANITARY SEWER MANHOLE
RIM EL. = 4945.60

CONSTRUCTION CENTERLINE
N 38°22'02" E

CP-4

8.03' RT.
Ø TYPE "C" MANHOLE
99

BARELAS DITCH

STA. 14+18.93, CL
PI CONST. CENTERLINE

24" HDPE PLASTIC PIPE

STA. 16+00.72, CL
CONSTRUCT 1-4" Ø TYPE "C" STORM DRAIN MANHOLE
RIM EL. = 4947.75
N 1,477,839.43
E 380,899.31

EXISTING FENCELINE TO REMAIN UNDISTURBED THROUGHOUT CONSTRUCTION

STA. 16+55.68, 0.24' LT.
EXISTING SANITARY SEWER MANHOLE
RIM EL. = 4947.02

15+00

LINE TO REMAIN UNDISTURBED THROUGHOUT CONSTRUCTION

EXISTING 8" VCP SANITARY SEWER LINE TO REMAIN UNDISTURBED THROUGHOUT CONSTRUCTION

CONSTRUCTION CENTERLINE
N 11°54'03" E

STA. 15+85.06, 0.58' LT.
EXISTING SANITARY SEWER MANHOLE
RIM EL. = 4947.65

CP-3

STA. 15+96.27, CL
PI CONST. CENTERLINE

CONSTRUCTION CENTERLINE
S 84°59'58" E

POTHOLE #11 & 11A

24" HDPE PLASTIC PIPE

4

5

1

2

3

7

ENGLEWOOD ST.

POTHOLE #12 & 12A

1" GAS

2" HDPE

STA. 16+55.68, 0.24' LT.
EXISTING SANITARY SEWER MANHOLE
RIM EL. = 4947.02

NOT IN MODEL
MODEL DIA: N/A
AS-BUILT DIA: 30"

SEE SHEET 5 FOR SYSTEM "A"

MATCHLINE
STATION 13+93.80
SEE SHEET 3

SYSTEM "B"

NOT IN MODEL
MODEL DIA: N/A
AS-BUILT DIA: 24"

NOT IN MODEL
MODEL DIA: N/A
AS-BUILT DIA: 30"

1. NO ENCASUREMENT REQUIRED AT THIS LOCATION. VERTICAL SEPARATION OF 24" IS ACCEPTABLE.
2. RELOCATE EXISTING 4" WATERLINE (IF REQUIRED) TO THE MAXIMUM LIMIT AVAILABLE WITHIN THE TRENCH FOR THE STORM DRAIN INSTALLATION.
3. APPROXIMATE LOCATION OF GASLINE STUB. CONTRACTOR SHALL VERIFY BEFORE CONSTRUCTION.
4. REMOVE AND REPLACE A MAXIMUM OF 10 LF OF CURB & GUTTER EXISTING DRIVEPAD SHALL REMAIN UNDISTURBED.
5. REMOVE AND RESTORE 25 LF OF EXISTING CHAIN-LINK FENCE AND GATE.
6. FILL TRENCH AND REGRADE TO A MINIMUM OF 1" OF COVER OVER NEW STORM DRAIN PIPE.
7. CONTRACTOR SHALL REMOVE ALL RESIDENTIAL PAVEMENT FROM THE PC OF THE CUL-DE-SAC AND REPLACE WITH THE SAME. REGRADE ENTIRE AREA TO SLOPE INTO THE NEW INLET. EXISTING CURB AND GUTTER SHALL REMAIN UNDISTURBED. CONTRACTOR SHALL PROVIDE ACCESS TO RESIDENTS THROUGHOUT CONSTRUCTION.

SURVEY INFORMATION			BENCH MARKS		AS BUILT INFORMATION	
NO.	FIELD NOTES	DATE				
1	STEVE TOLER, SURVEYING CONTROL INC.	5/99	ACS CONTROL STA. "13-L14" 3-1/4" AL CAP IN CURB NEW MEXICO STATE PLANE COORDINATES N=1,477,623.21 E=381,928.31 DELTA ALPHA = -001°3'36" GROUND TO GRID FACTOR = 0.9998679428 NWSF COORDINATES - CENTRAL ZONE, NAD 27		CONTRACTOR WORK STARTED BY ACCEPTANCE BY FIELD CATION BY DRAWINGS CORRECTED BY RECORDED BY NO.	
					MICRO-FILM INFORMATION	

X
MODEL INVERT:
DATUM: 4941.98 + 2.67 = 4944.65

X
MODEL INVERT:
DATUM: 4943.78 + 2.67 = 4946.45

204.11 LF @ S=0.0083 FT/FT
1-24" HDPE PLASTIC PIPE

Q 100 = 14.50 CFS
V 100 = 5.46 FT/S

59.50 LF @ S=0.0055 FT/FT
1-24" HDPE PLASTIC PIPE

Q 100 = 14.50 CFS
V 100 = 6.18 FT/S

FINISHED GRADE AT CL

EXISTING GRADE AT CL

HGL

EXISTING 8" VCP SANITARY SEWER LINE

MATCHLINE
STATION 13+93.80
SEE SHEET 3

STA. 13+93.80, 8.03' RT.
CONSTRUCT 1'-8" TYPE "C"
SEWER MANHOLE
INV. IN (E) = 4941.98
INV. OUT (S) = 4941.88

STA. 15+85.06, 0.58' LT.
EXISTING SANITARY
SEWER MANHOLE
INV. = 4940.25

STA. 15+85.06, 0.58' LT.
EXISTING SANITARY
SEWER MANHOLE
INV. = 4940.25

STA. 1586.49, CL
8" VCP SANITARY
SEWER CROSSING
OVER ROAD
8" SAS I.P. = 4941.40


STA. 16+00.72, CL
CONSTRUCT 1'-4" TYPE "C"
STORM DRAIN MANHOLE
INV. IN (E) = 4943.78
INV. OUT (S) = 4943.68

STA. 16+55.98, 0.24' LT.
EXISTING SANITARY
SEWER MANHOLE
INV. = 4940.92



STA. 16+59.87, 8.10' LT.
REMOVE EXISTING CATCH BASIN
CONSTRUCT SINGLE TYPE
CATCH BASIN
INV. OUT = 4944.11

14+00 15+00 16+00 17+00

X
MODEL INVERT:
DATUM: $4943.78 + 2.67 = 4946.45$

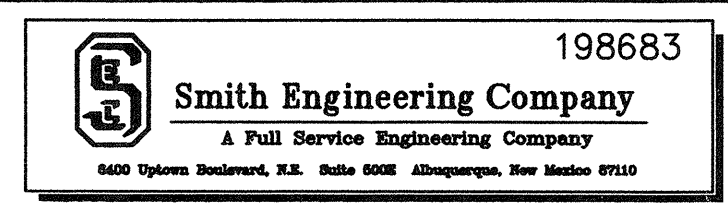



\\198683\OPTION1\04PnpB2.dwg Fri Jan 21 13:01:41 2000 Michael J. Riordan

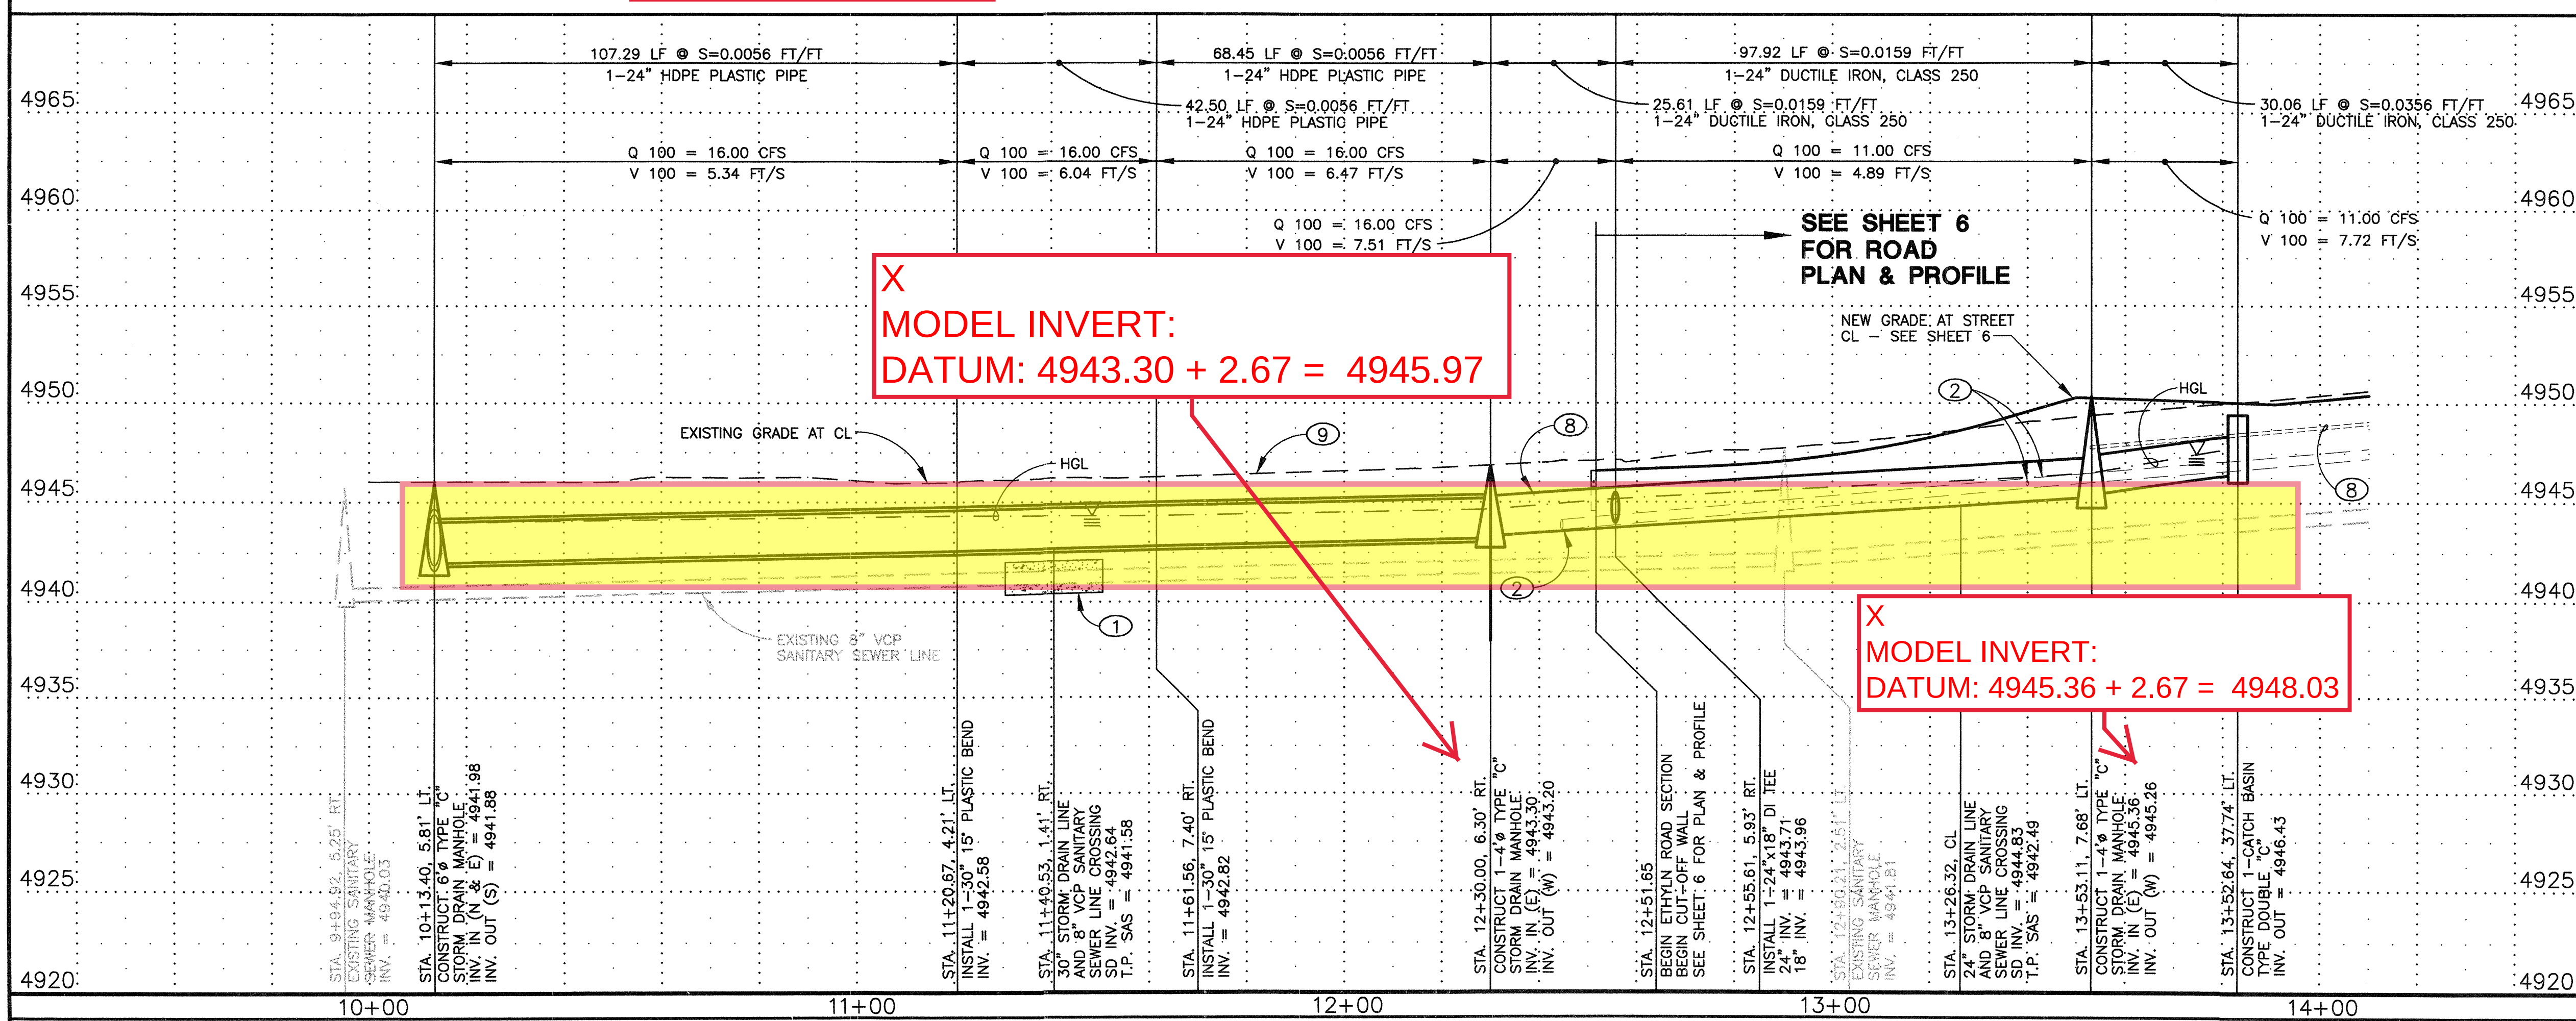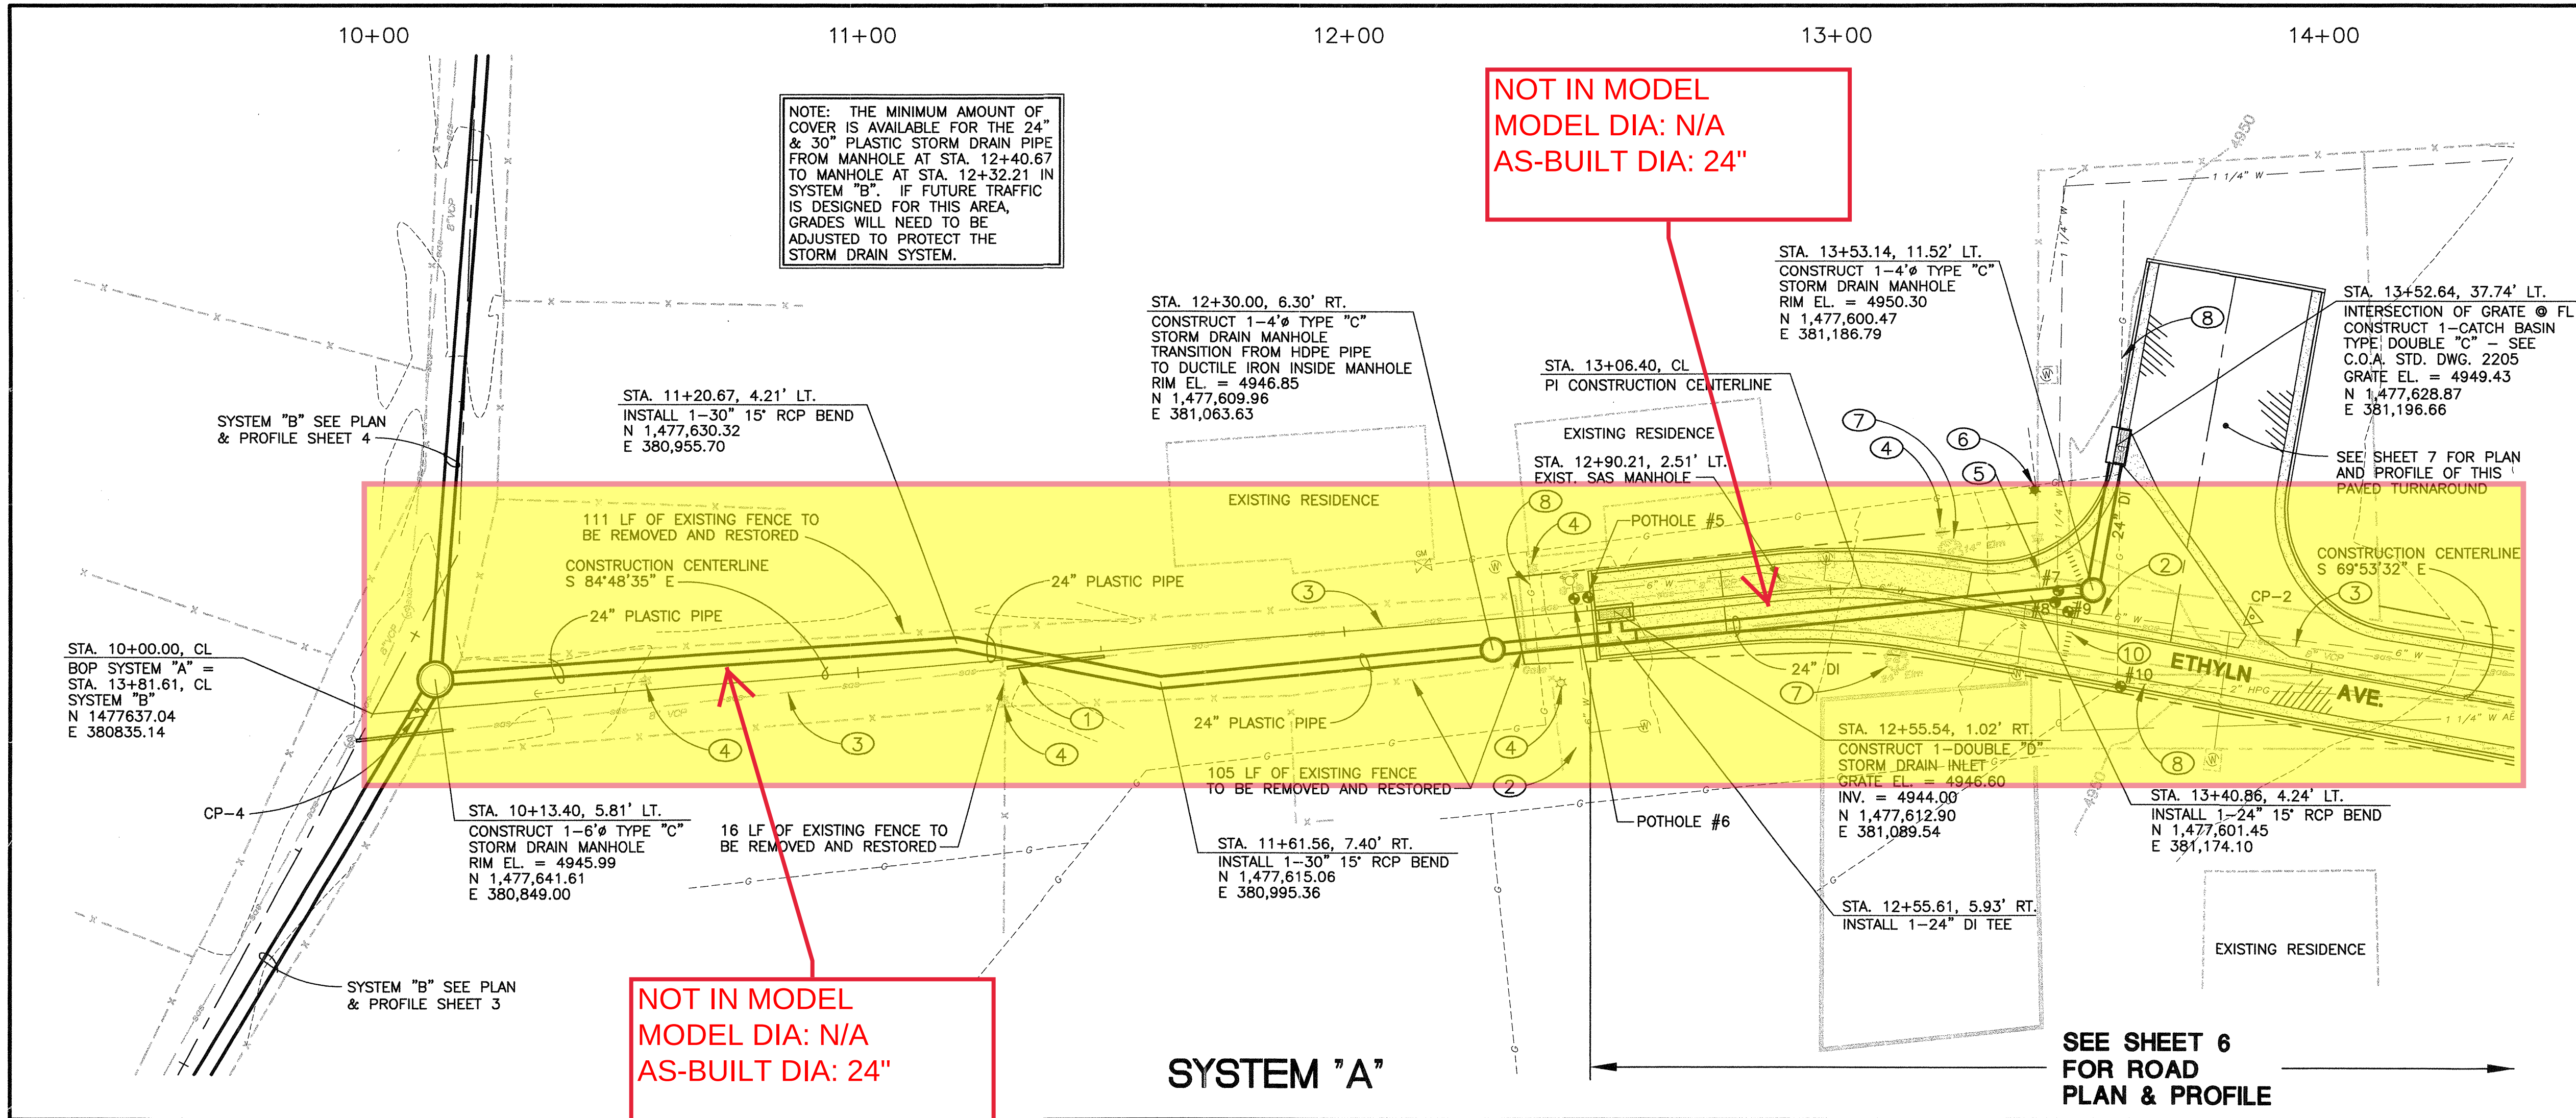

KEYED NOTES:

- ENCASE SANITARY SEWER LINE TO 10' LT. & RT. OF THE NEW STORM DRAIN CENTERLINE INTERSECTION.
- APPROXIMATE LOCATION OF EXISTING WATERLINE TO BE LOWERED, SEE DTL. ON SHT. 7.
- EXISTING 8" VCP SANITARY SEWER TO REMAIN UNDISTURBED THROUGHOUT CONSTRUCTION
- EXISTING POWER POLE & GUY WIRE TO REMAIN UNDISTURBED THROUGHOUT CONSTRUCTION
- EXISTING GUY WIRE TO BE REMOVED AFTER NEW UTILITY POLE IS IN PLACE. CONTRACTOR SHALL COORDINATE WITH WARREN ARTHUR FROM PNM ELECTRIC (241-3490).
- APPROXIMATE LOCATION OF NEW UTILITY POLE TO BE INSTALLED BY PNM.
- EXISTING TREE TO BE REMOVED.
- EXISTING 2" HP GASLINE SHALL BE LOWERED OR RELOCATED BY PNM GAS COMPANY DURING CONSTRUCTION.
- FILL TRENCH AND REGRADE TO A MINIMUM OF 1' OF COVER OVER NEW STORM DRAIN PIPE OR MATCH EXISTING GRADE IF IT IS GREATER.
- HIGH POINT RIDGE - SEE SHEET 8 FOR ELEVATIONS.

NOTE: LOCATION OF EXISTING UTILITIES SHOWN ON THIS PLAN SET ARE APPROXIMATE AND WERE OBTAINED FROM DESIGN SURVEY INFORMATION, AS-BUILTS AND POT HOLES. OTHER EXISTING UTILITIES MAY EXIST IN THE WORK AREAS. IT SHALL BE THE RESPONSIBILITY OF THE CONTRACTOR TO FIELD LOCATE ALL EXISTING UTILITIES SHOWN ON PLANS PRIOR TO CONSTRUCTION. ANY DAMAGE TO EXISTING UTILITIES SHOWN ON THE PLANS DURING CONSTRUCTION SHALL BE REPAIRED OR REPLACED BY CONTRACTOR AT NO ADDITIONAL COST TO THE OWNER. CONTRACTOR SHALL CONTACT ALL UTILITY COMPANIES LISTED ON SHEET 1 OF THIS PLAN SET PRIOR TO CONSTRUCTION FOR AID IN LOCATING ANY EXISTING UTILITIES.

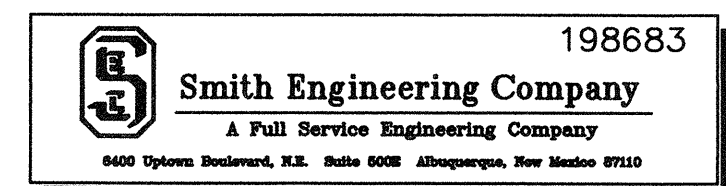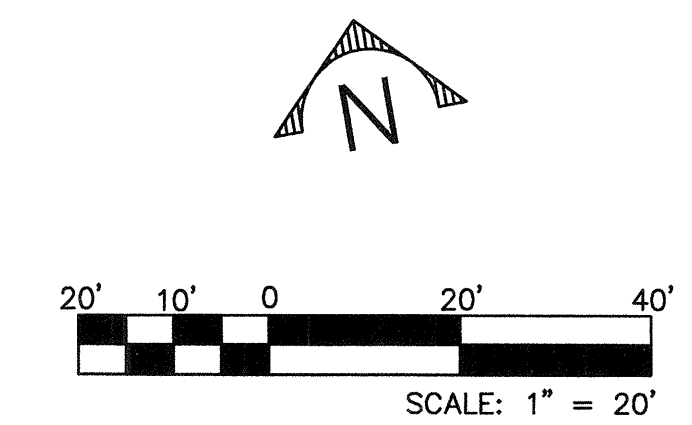

CITY OF ALBUQUERQUE PUBLIC WORKS DEPARTMENT ENGINEERING DEVELOPMENT GROUP	
TITLE: ETHLYN AVENUE IMPROVEMENTS PLAN & PROFILE: SYSTEM "A" STA. 10+00 TO 14+00	
Design Review Committee	City Engineer Approval
Last Design Update	
City Project No. 5744.90	Zone Map No. L-14
Sheet 5	Of 10

CONTRACTOR	DATE
WORK STARTED BY	DATE
INSPECTED BY	DATE
FIELD BY	DATE
DESIGNED BY	DATE
DRAWN BY	DATE
CHECKED BY	DATE

NO.	DATE	REMARKS	BY
1	5/99	STEVE TOLER, SURVEYING CONTROL	INC.

AS BUILT INFORMATION	
CONTRACTOR	DATE
WORK STARTED BY	DATE
INSPECTED BY	DATE
FIELD BY	DATE
DESIGNED BY	DATE
DRAWN BY	DATE
CHECKED BY	DATE



BENCH MARKS	
ACS CONTROL STA. "13-114"	DATE
3-1/4" AL CAP IN CURB	DATE
NEW MEXICO STATE PLANE COORDINATES	DATE
N=1,477,623.21	DATE
E=381,928.31	DATE
DELTA ALPHA = -001°36'	DATE
GROUND TO GRID FACTOR = 0.999679428	DATE
NMSP COORDINATES - CENTRAL ZONE, NAD 27	DATE

SURVEY INFORMATION	
FIELD NOTES	DATE
NO.	DATE
1	5/99

ENGINEER'S SEAL	
NO.	DATE
1	5/99

REVISIONS	
NO.	DATE
1	5/99

DESIGN	
DESIGNED BY	DATE
DRAWN BY	DATE
CHECKED BY	DATE

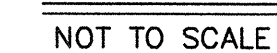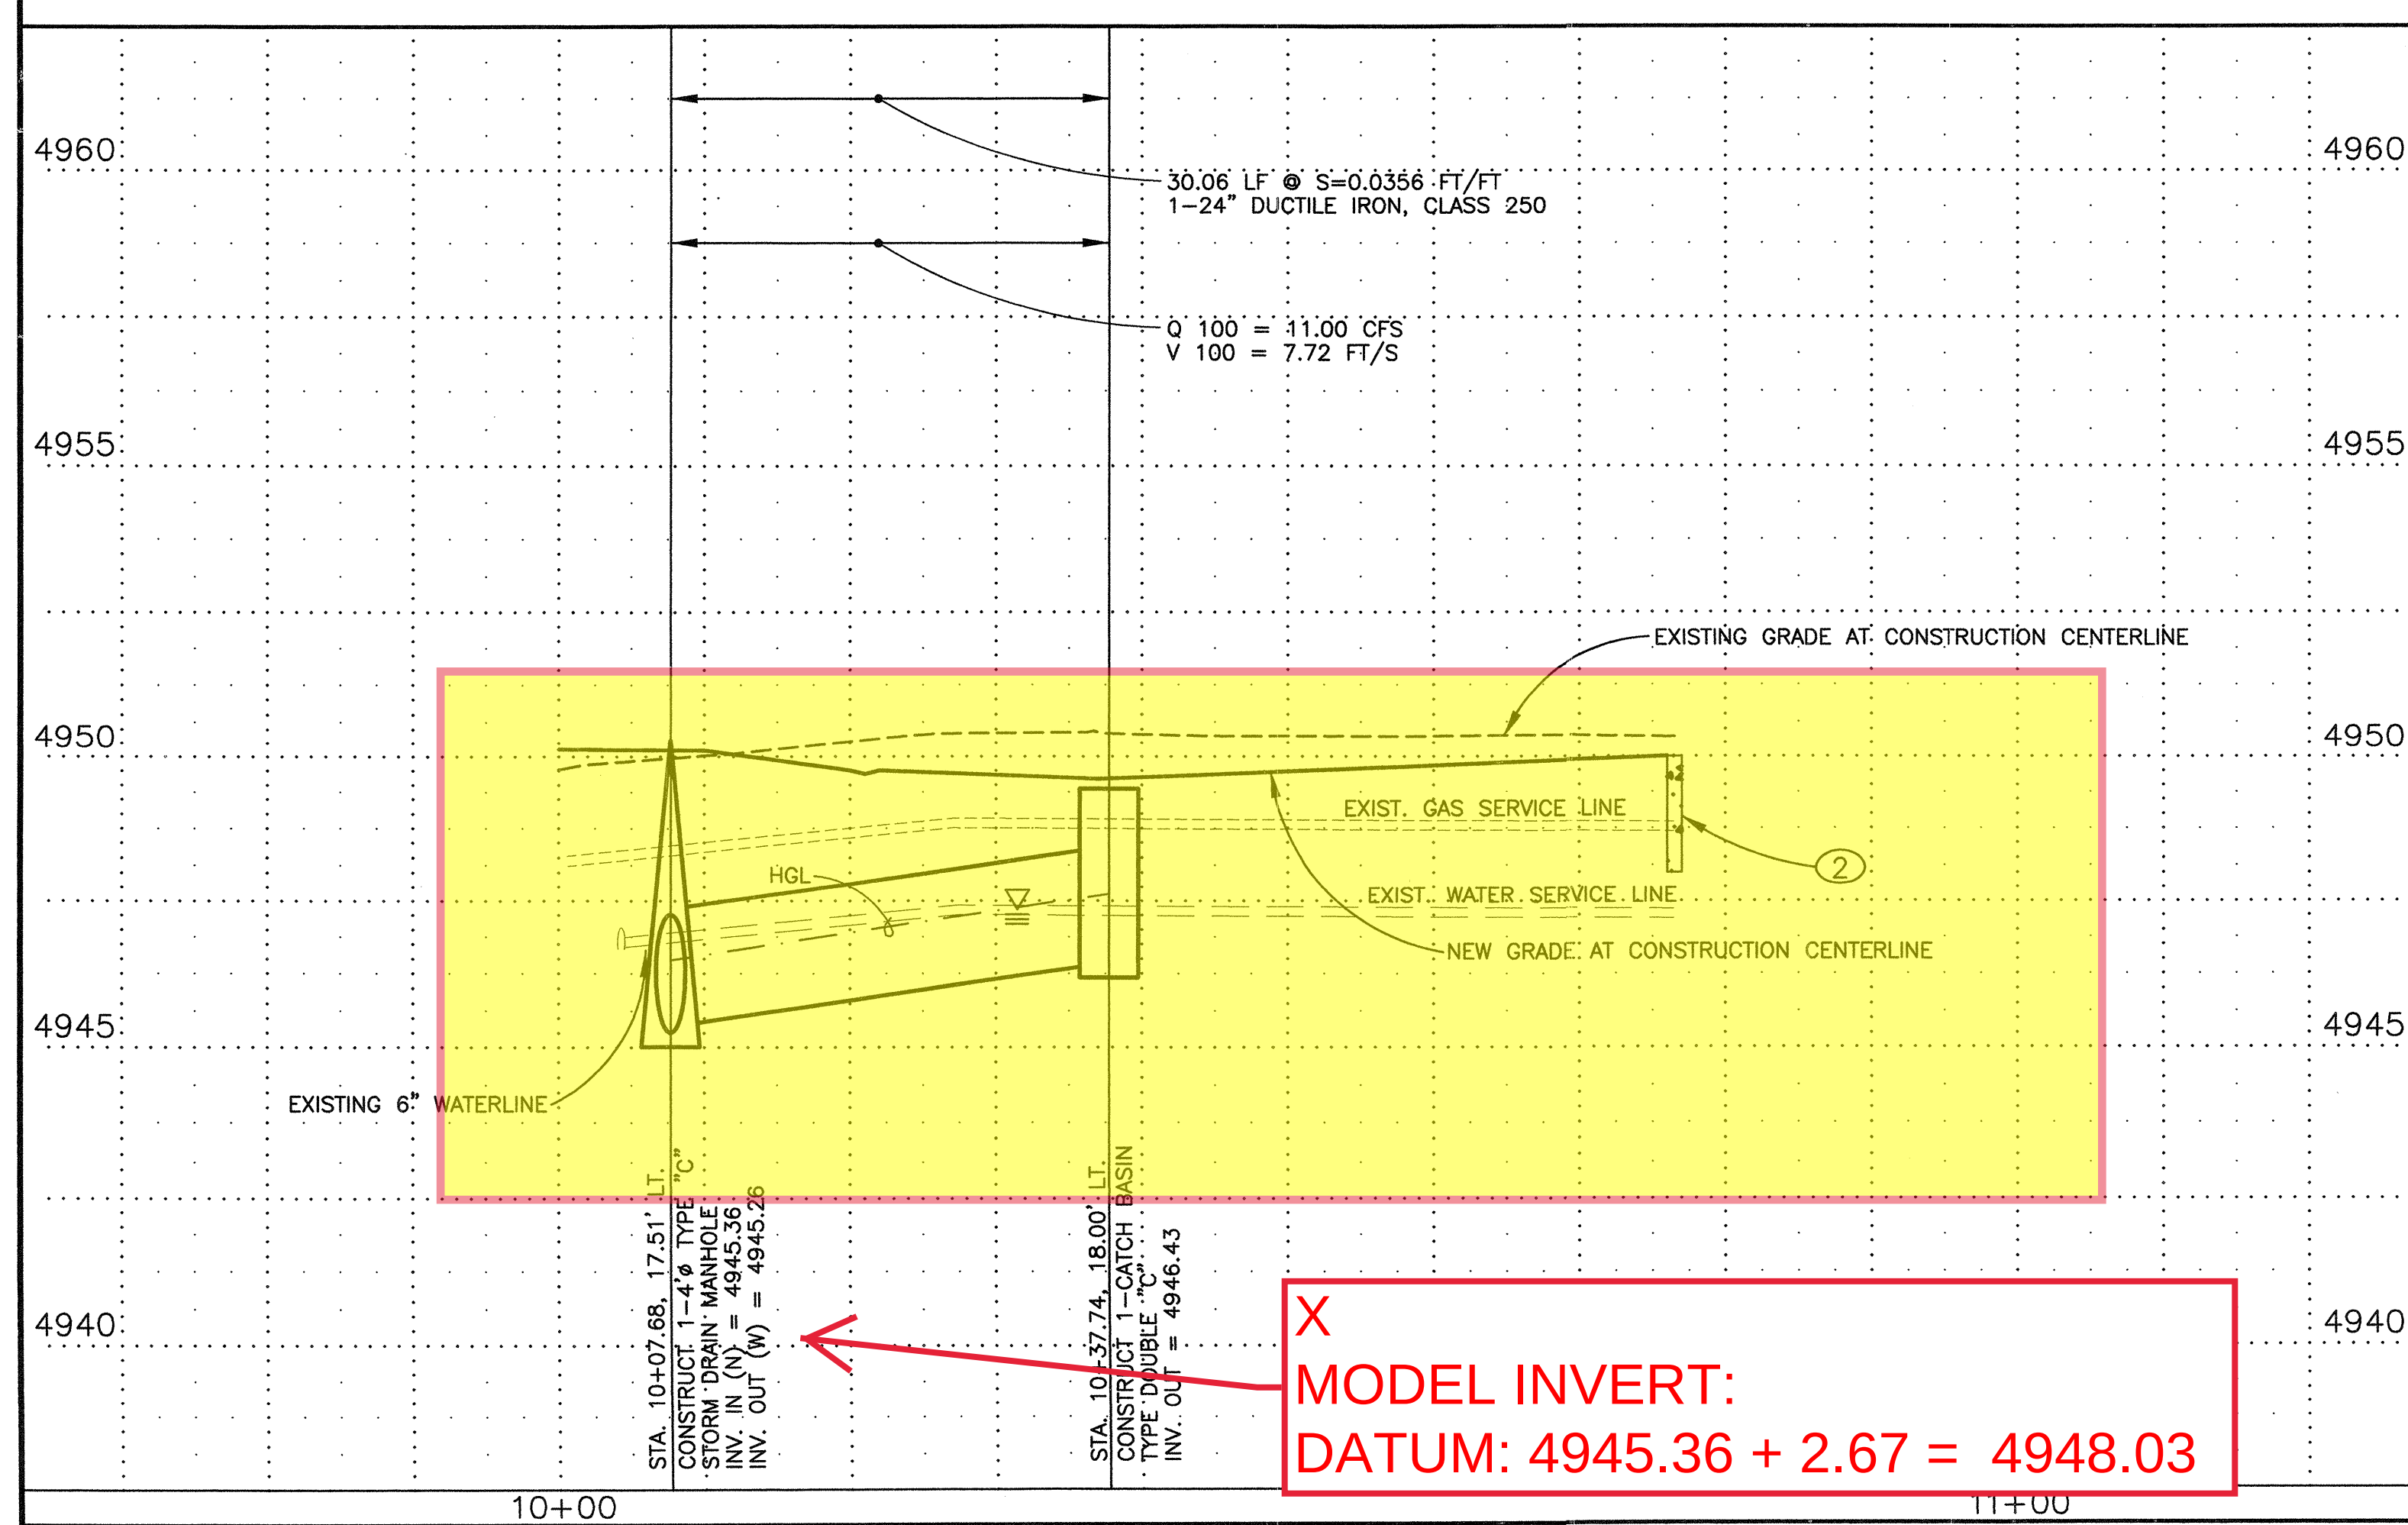

PROJECT ELEMENTS										J EMENT GROUP										
										ENGINEERS SEAL		SURVEY INFORMATION			BENCH MARKS		AS BUILT INFORMATION			
												FIELD NOTES			ACS CONTROL STA. "13-L14"		CONTRACTOR			
												NO.			DATE			WORK ORDER BY DATE		
												1			STEVE TOLER,			STAMPED BY DATE		
															SURVEYING CONTROL			ACCEPTANCE BY DATE		
															INC.			VERIFICATION BY DATE		
															E=381.928.31			DRAWINGS CHECKED BY DATE		
															DELTA ALPHA = -00°13'36"			MICRO-FILM INFORMATION		
															GROUND TO GRID FACTOR = 0.998679428			RECORDED BY DATE		
															NMSP COORDINATES - CENTRAL ZONE, NAD 27			NO.		


17+00

1. HIGH POINT RIDGE
2. SEE SHEET 2 FOR CONTROL POINT INFORMATION.










* NOTE: THESE ELEVATIONS WILL BE DETERMINED BY USING THE EXISTING JOHN ST. ELEVATIONS PLUS A 2.0% SLOPE FOR FOUR (4) FEET PER ADA STANDARDS.

NO.	DELTA ANGLE	RADIUS	LEN.	TAN.	CHORD BEARING	L.C.
1	15°09'43"	159.13	42.11	21.18	S 78°23'17" E	41.95
2	16°05'09"	151.00	42.39	21.34	S 77°55'34" E	42.28
3	16°05'09"	149.00	41.83	21.05	S 77°55'34" E	41.61
4	16°05'09"	140.88	39.55	19.91	S 77°55'34" E	39.48
5	11°05'02"	108.38	20.97	10.52	S 76°20'57" E	20.95
6	12°00'28"	119.00	24.94	12.52	S 75°53'14" E	24.88
7	12°00'28"	121.00	25.36	12.73	S 75°53'14" E	25.37
8	12°00'28"	132.62	27.79	13.95	S 75°53'14" E	27.78
9	04°38'39"	107.37	8.70	4.35	S 84°12'47" E	8.70
10	04°38'39"	119.00	9.65	4.83	S 84°12'47" E	9.64
11	04°38'39"	121.00	9.81	4.91	S 84°12'47" E	9.81
12	04°38'39"	132.63	10.75	5.38	S 84°12'47" E	10.75
13	89°04'34"	24.38	37.90	23.99	N 64°39'17" E	34.18
14	90°55'26"	24.38	38.68	24.77	S 25°20'43" E	34.18

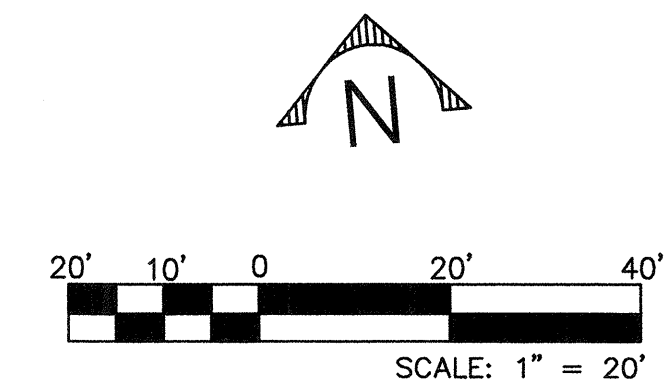

		198683								NO. DATE		DESIGNED BY DRAWN BY CHECKED BY	
Smith Engineering Company A Full Service Engineering Company 8400 Uptown Boulevard, N.E. Suite 5008 Albuquerque, New Mexico 87110													
CITY OF ALBUQUERQUE PUBLIC WORKS DEPARTMENT ENGINEERING DEVELOPMENT GROUP													
TITLE: ETHLYN AVENUE IMPROVEMENTS HORIZONTAL & VERTICAL GEOMETRY PLAN													
Design Review Committee				City Engineer Approval				Last Design Update		No. / Day / Yr.		No. / Day / Yr.	
City Project No. 5744.90				Zone Map No. L-14				Sheet 8		Of 10			

[illegible]

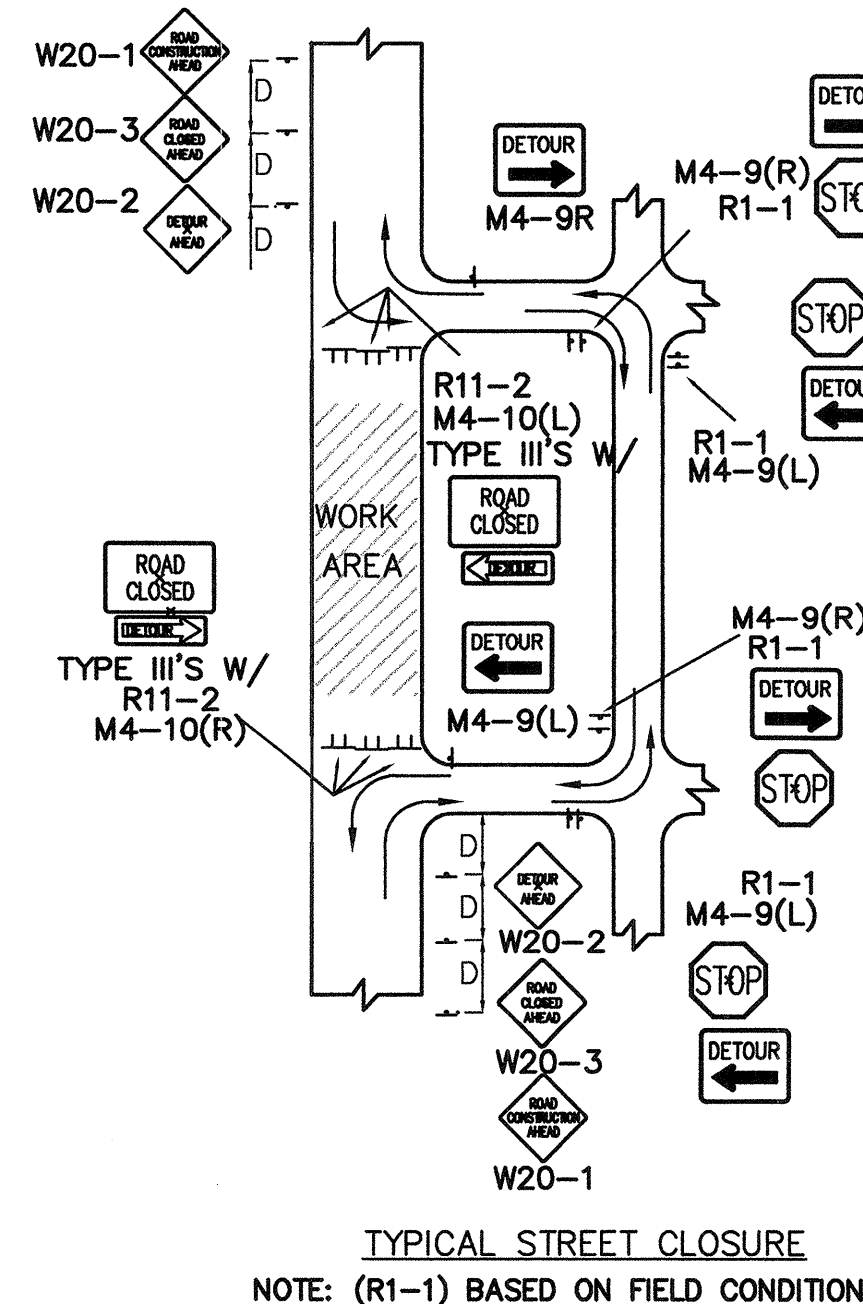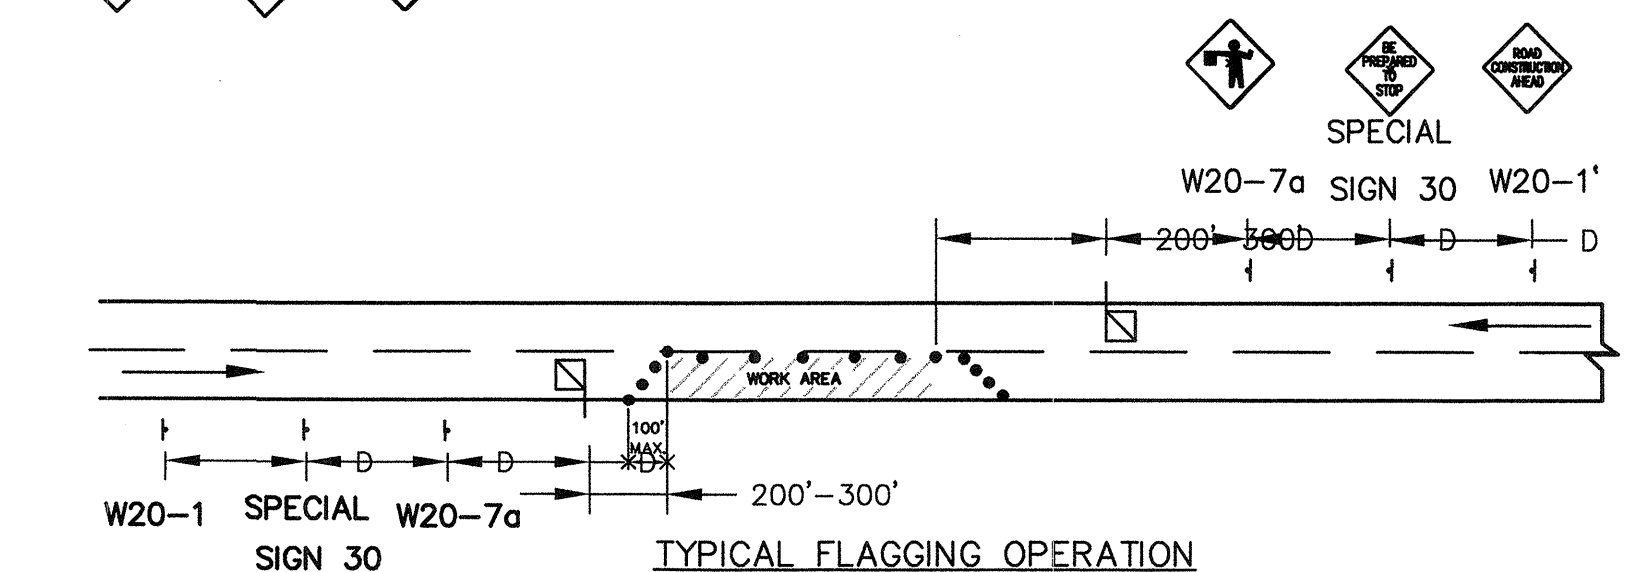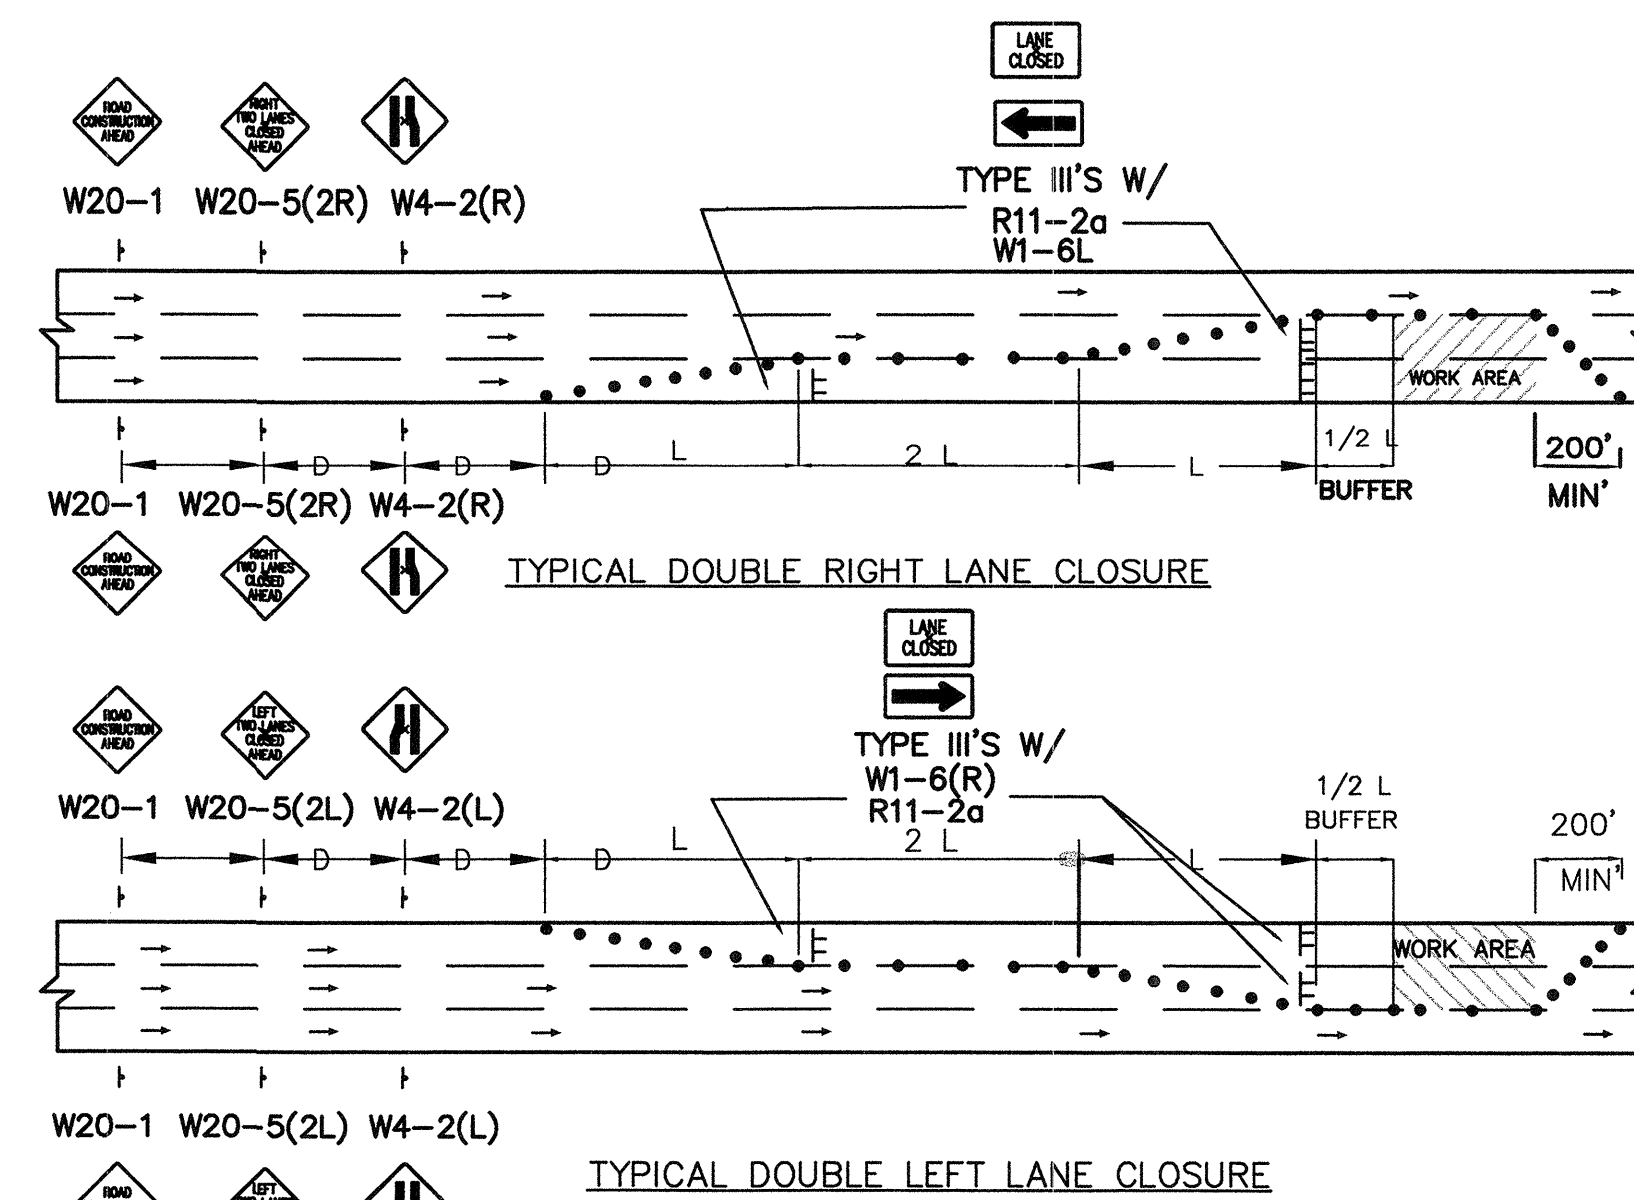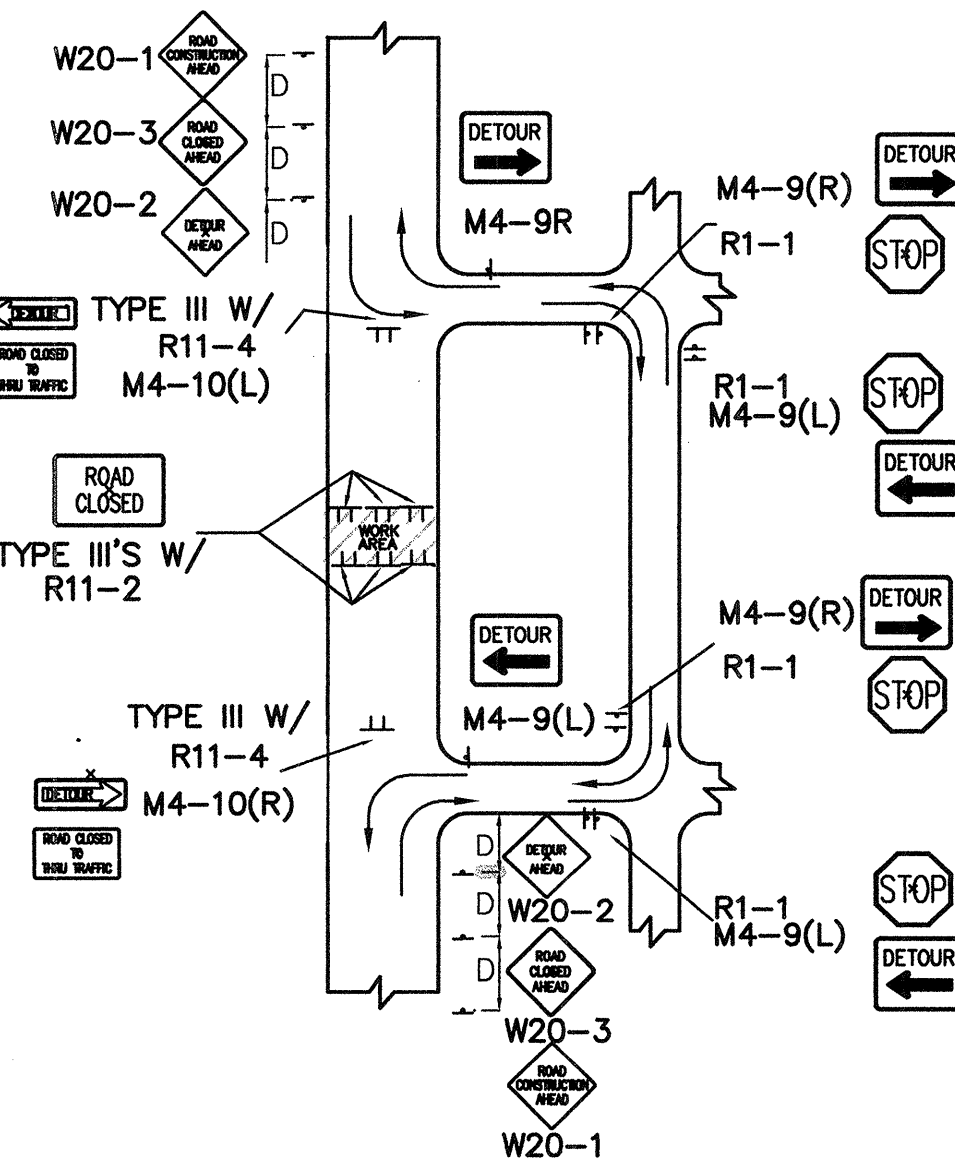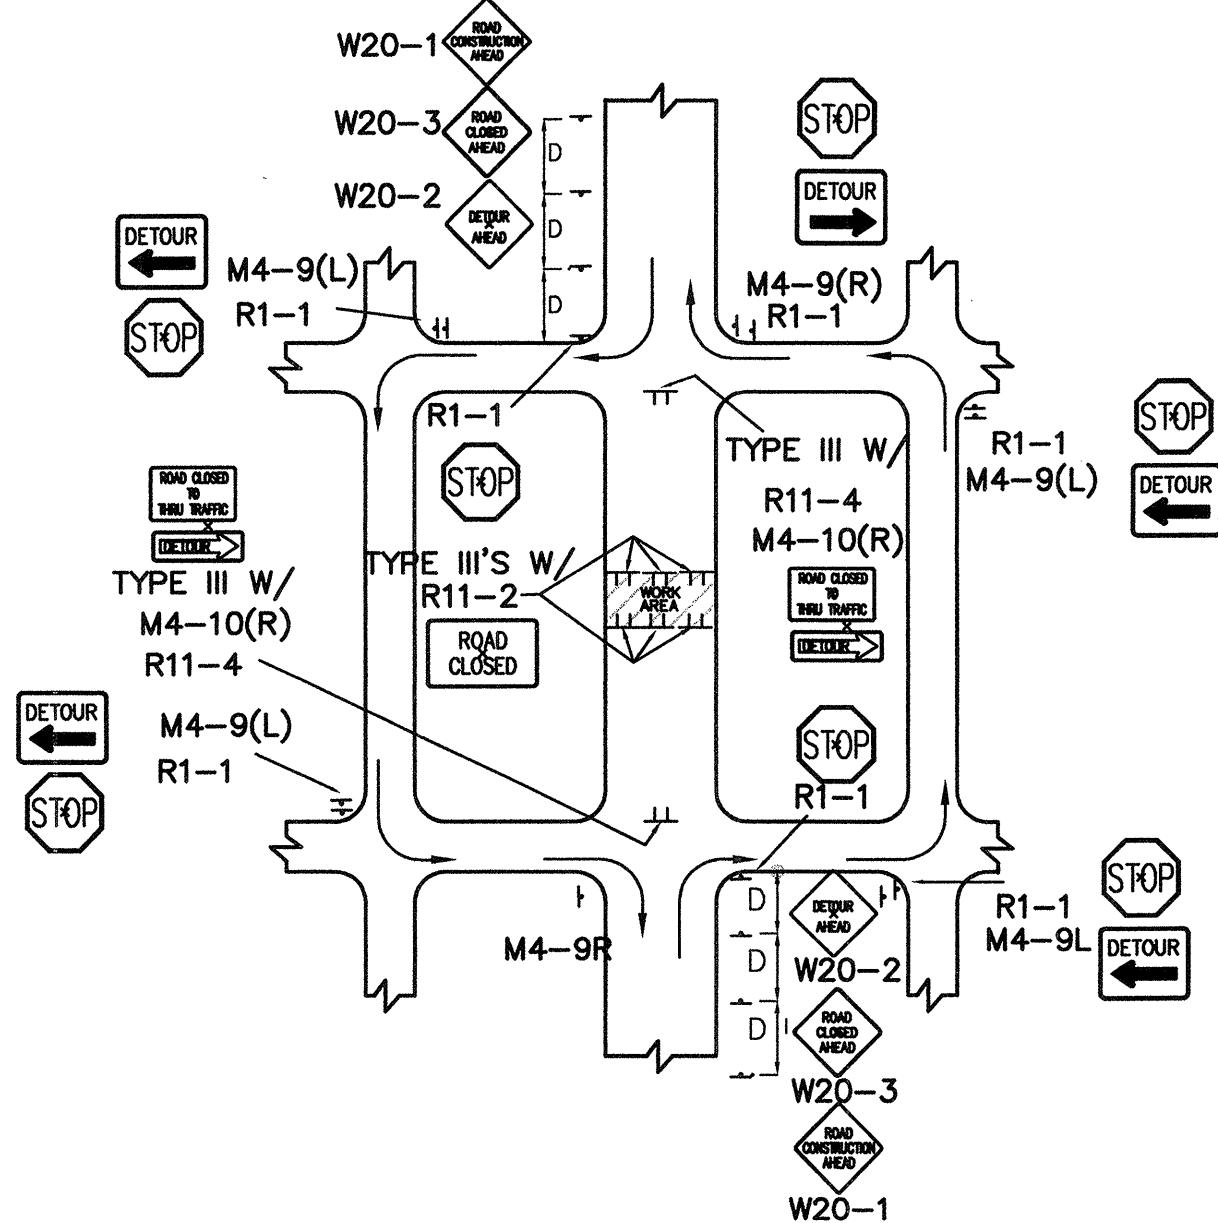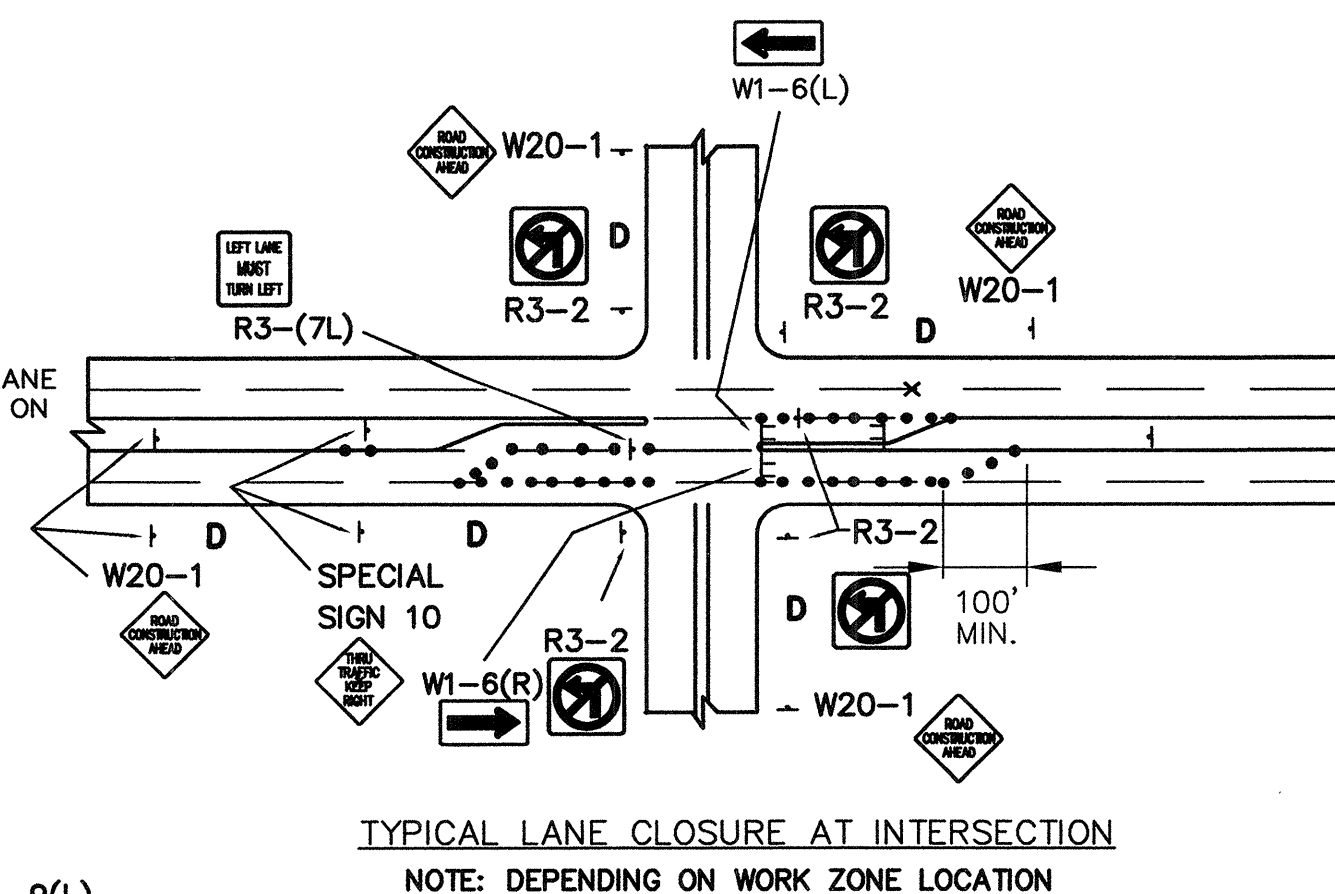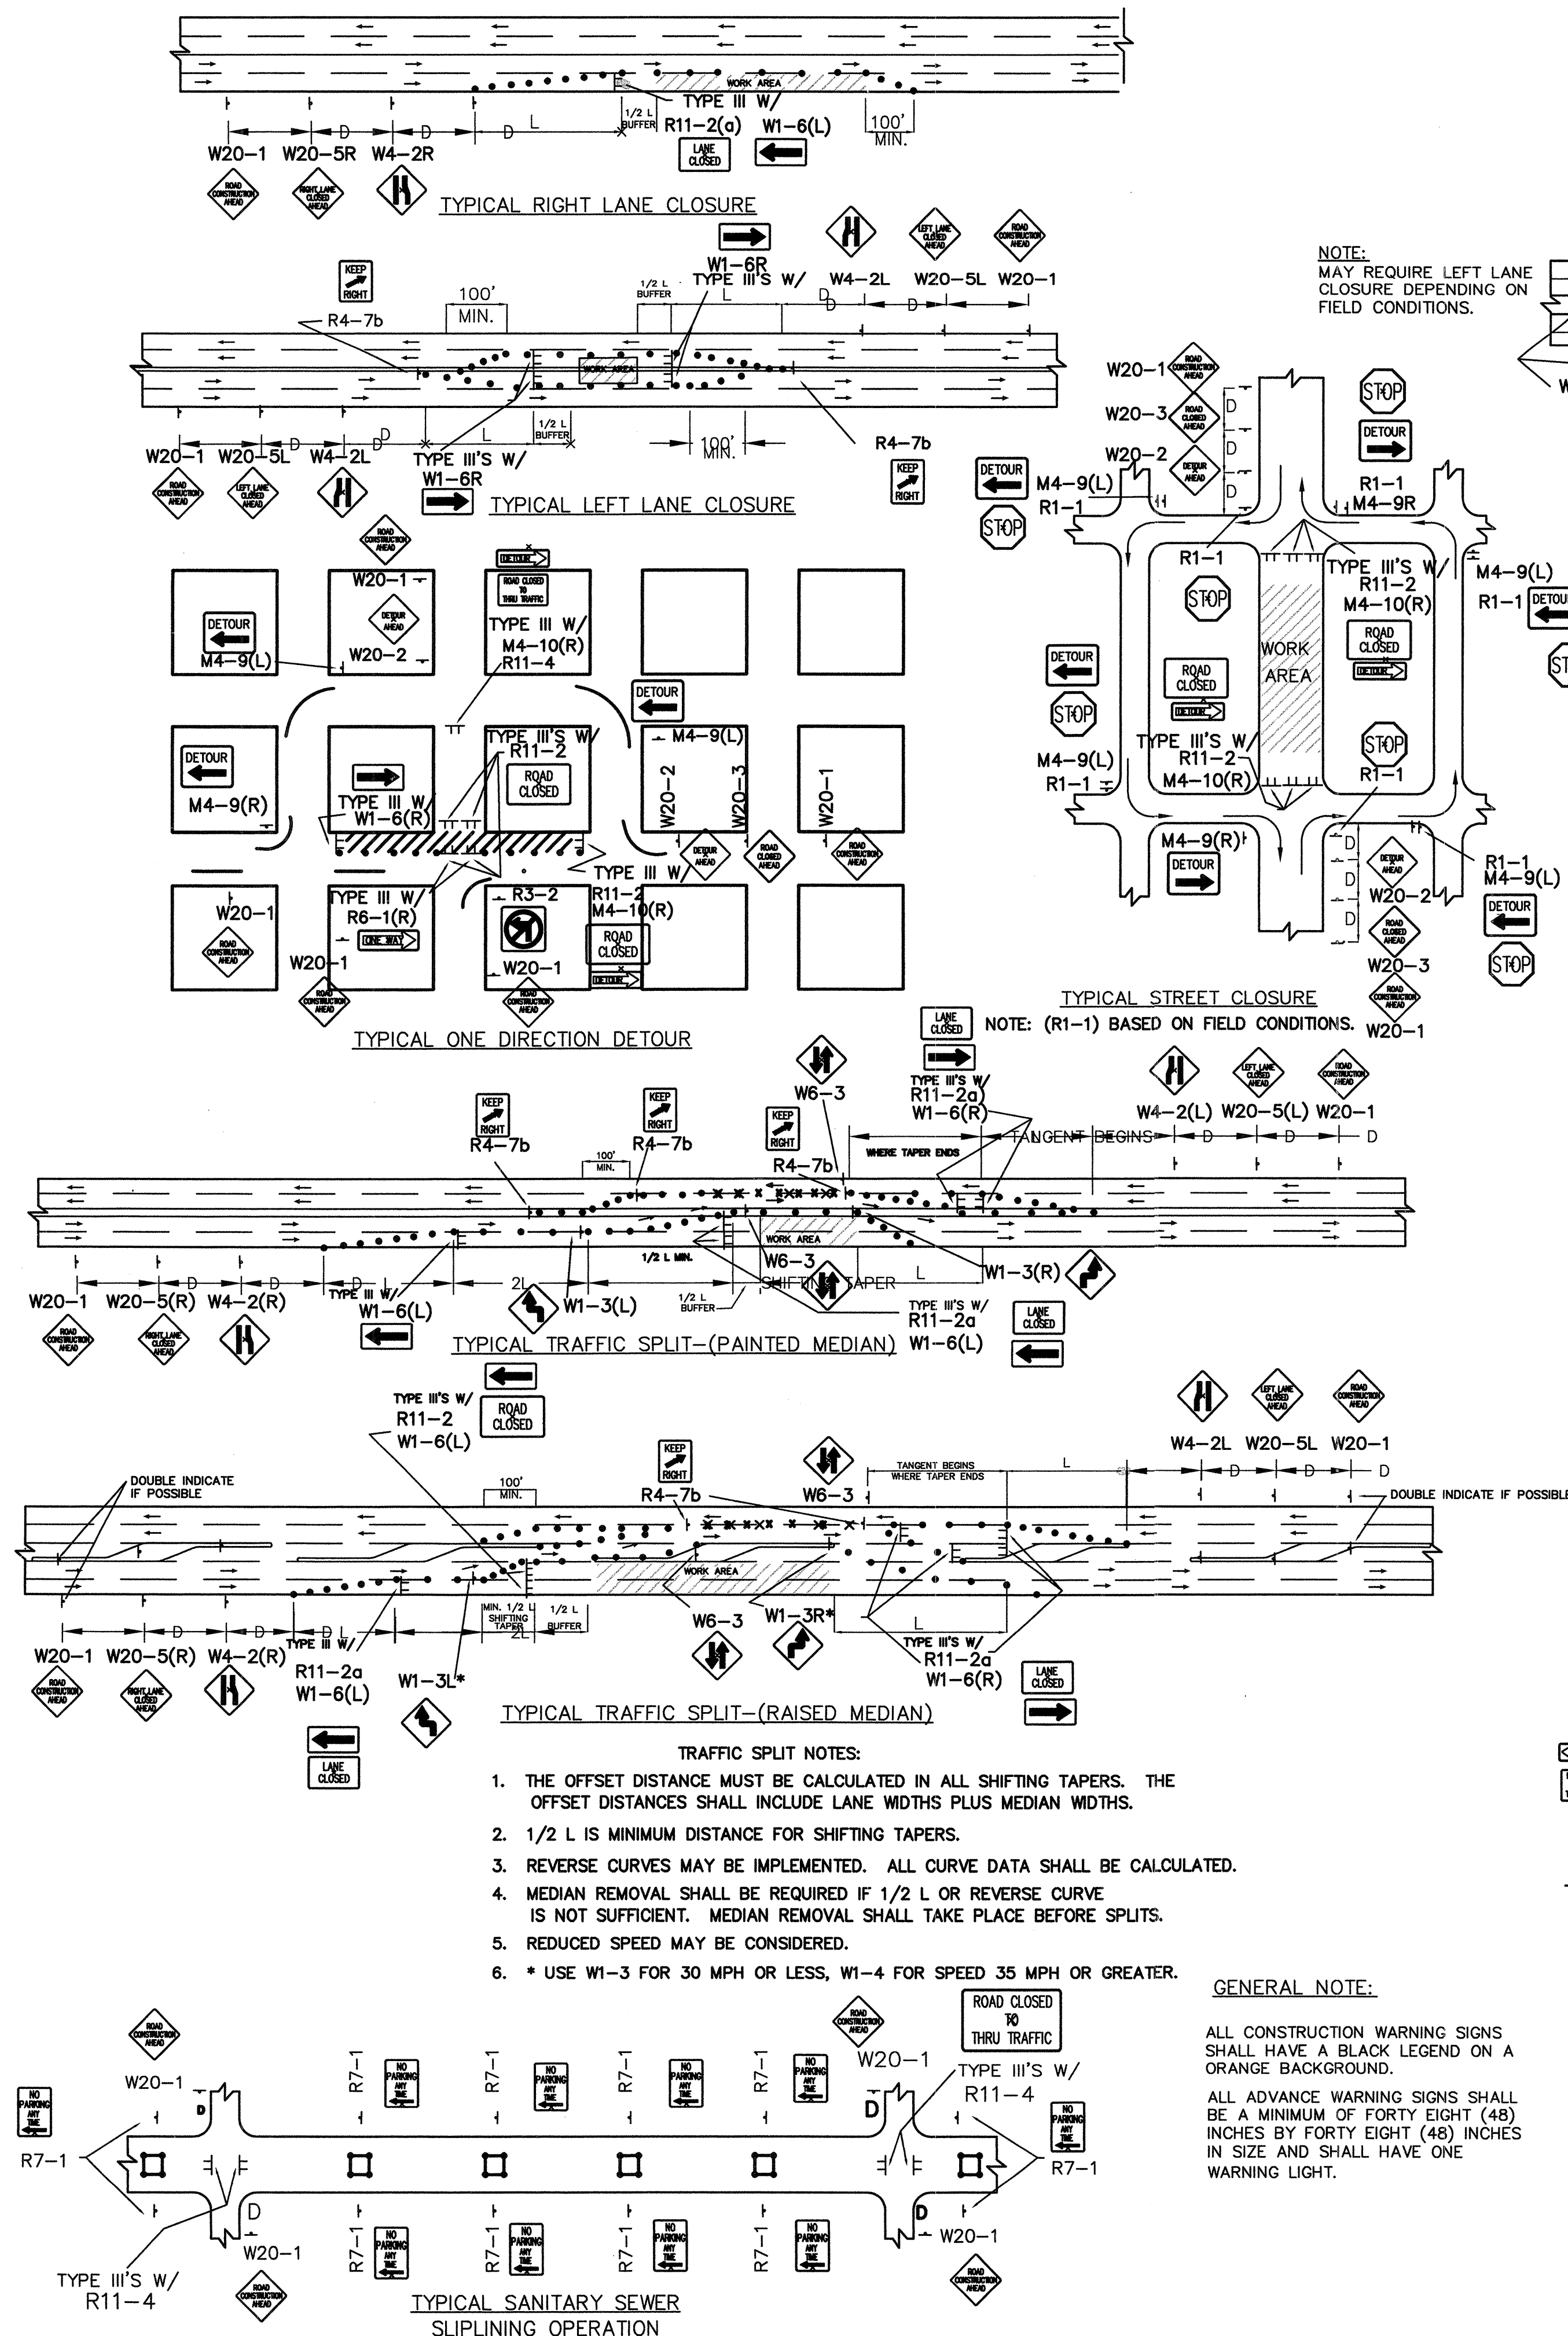

	<u>Smith Engineering Company</u> A Full Service Engineering Company 6600 Opalen Boulevard, N.E., Suite 500E Albuquerque, New Mexico 87110					NO.	DATE		DESIGNED BY	DRAWN BY	
CITY OF ALBUQUERQUE											
PUBLIC WORKS DEPARTMENT											
ENGINEERING DEVELOPMENT GROUP											
TITLE:											
ETHLYN AVENUE IMPROVEMENTS											
TYPICAL TRAFFIC CONTROL AND SIGNING EXAMPLES											
Design Review Committee	City Engineer Approval	Last Design Update	No. / Day / Yr.	No. / Day / Yr.							
City Project No. 5744.90			Zone Map No. L-14			Sheet		Of			
						9		10			

CONSTRUCTION TRAFFIC CONTROL GENERAL NOTES

1. CONTRACTOR MUST OBTAIN FROM CONSTRUCTION COORDINATION AN EXCAVATION/BARRICADING PERMIT BEFORE ENGAGING IN ANY CONSTRUCTION, MAINTENANCE OR REPAIR WORK IN ANY OF THE CITY OF ALBUQUERQUE'S RIGHTS-OF-WAY. EMERGENCY WORK THAT WOULD PRESERVE LIFE OR PROPERTY IS EXCLUDED WITH THE UNDERSTANDING, THAT A PERMIT SHALL BE OBTAINED WITHIN 24 TO 48 HOURS.

2. CONTRACTOR SHALL AT THE TIME OF PERMIT REQUEST, SUBMIT FOR APPROVAL BY CONSTRUCTION COORDINATION, A TRAFFIC CONTROL PLAN DETAILING ALL EXISTING TOPOGRAPHY SUCH AS LANE WIDTHS, DRIVEWAYS, AND BUSINESS/RESIDENTIAL ACCESSES. THE TRAFFIC CONTROL PLAN SHALL INCLUDE ALL PHASES OF WORK AND SCHEDULES INVOLVED IN THE CONSTRUCTION PROJECT. ANY SEPARATE PHASES OF A CONSTRUCTION PROJECT SHALL BE GIVEN AN INDIVIDUAL PERMIT EACH. BLANKET PERMITS WILL NOT BE ISSUED.

3. THESE TYPICAL TRAFFIC CONTROL PLANS DO NOT REFLECT THE EXISTING TOPOGRAPHY SUCH AS DRIVEWAYS, LANE WIDTHS, AND BUSINESS/RESIDENTIAL ACCESSES. EVERY LOCATION THAT REQUIRES CONSTRUCTION TRAFFIC CONTROL SHALL HAVE A DETAILED TRAFFIC CONTROL PLAN SHOWING ALL EXISTING TOPOGRAPHY.

4. CONSTRUCTION SHALL NOT BEGIN UNLESS A TRAFFIC CONTROL PLAN HAS BEEN APPROVED AND VERIFIED BY CONSTRUCTION COORDINATION.

5. CONSTRUCTION COORDINATION SHALL BE NOTIFIED 48 HOURS PRIOR TO ANY TRAFFIC CONTROL CHANGES NEEDED BY CONTRACTOR, THAT WERE NOT PREVIOUSLY APPROVED. THESE TRAFFIC CONTROL CHANGES SHALL BE REQUESTED IN WRITING ACCOMPANIED WITH A TRAFFIC CONTROL PLAN REFLECTING SUCH CHANGES.

6. ALL CONSTRUCTION TRAFFIC CONTROL DEVICES SHALL COMPLY TO THE MANUAL ON UNIFORM TRAFFIC CONTROL DEVICES (MUTCD), LATEST EDITION. IT IS THE RESPONSIBILITY OF THE CONTRACTOR TO INSTALL, SERVICE AND MAINTAIN ALL TRAFFIC CONTROL DEVICES. TRAFFIC CONTROL DEVICES SHALL NOT BE REMOVED OR ALTERED IN ANY WAY WITHOUT THE APPROVAL OF CONSTRUCTION COORDINATION, PER SECTION 6A-4 OF THE MUTCD, LATEST EDITION.

7. THE CONSTRUCTION TRAFFIC CONTROL INITIAL SET-UP SHALL BE BY AN AMERICAN TRAFFIC SAFETY SERVICES ASSOCIATION (ATSSA) CERTIFIED WORKSITE TRAFFIC SUPERVISOR. THE MAINTENANCE AND SERVICING SHALL ALSO BE DONE BY AN ATSSA CERTIFIED WORKSITE TRAFFIC SUPERVISOR OR EQUIVALENT.

8. CONTRACTOR IS RESPONSIBLE TO MAINTAIN AND SERVICE ALL TRAFFIC CONTROL DEVICES 24 HOURS A DAY, 7 DAYS A WEEK THROUGHOUT LENGTH OF PROJECT. CONTRACTOR IS RESPONSIBLE THAT ALL TRAFFIC CONTROL DEVICES COMPLY WITH THE MUTCD, LATEST EDITION.

9. ALL ADVANCE WARNING SIGNS SHALL BE DOUBLE INDICATED WHENEVER THERE ARE MULTI-LANE TRAFFIC IN ANY ONE GIVEN DIRECTION AND THERE IS SUFFICIENT MEDIAN SPACE.

10. ALL BARRICADES IN ALL TAPERS AND TANGENTS SHALL BE PLACED APART, A DISTANCE MEASURED IN FEET, EQUAL TO THAT OF THE POSTED SPEED LIMIT. NO EXCEPTIONS UNLESS APPROVED BY CONSTRUCTION COORDINATION PER MUTCD SECTION 6A-4.

11. ALL WORK IN ARTERIAL ROADWAYS SHALL BE ON A CONTINUOUS 24-HOUR PER DAY BASIS UNTIL COMPLETED.

12. CONTRACTOR IS RESPONSIBLE TO PROVIDE CONSTRUCTION COORDINATION, A WEEKLY LOG OF DAILY INSPECTIONS OF BARRICADE AND MAINTENANCE SCHEDULES ON PROJECTS THAT ARE OVER ONE WEEK DURATION.

13. EQUIPMENT OR MATERIALS SHALL NOT BE STORED WITHIN 15 FEET OF A TRAVELLED TRAFFIC LANE DURING NON-WORKING HOURS WITHOUT THE APPROVAL OF CONSTRUCTION COORDINATION.

14. CONTRACTOR SHALL PROVIDE AND MAINTAIN A SAFE AND ADEQUATE MEANS OF CHANNELIZING PEDESTRIAN TRAFFIC AROUND AND THROUGH THE CONSTRUCTION AREA.

15. CONTRACTOR IS RESPONSIBLE FOR OBLITERATION OF ANY CONFLICTING STRIPING AND RESPONSIBLE FOR ALL TEMPORARY STRIPING.

16. CONTRACTOR SHALL MAINTAIN ACCESS TO ALL FACILITIES, BUSINESSES AND/OR RESIDENTS AT ALL TIMES.

17. CONTRACTOR SHALL PROVIDE ACCESS SIGNS FOR BUSINESSES LOCATED WITHIN THE CONSTRUCTION AREA UNDER THE SUPERVISION OF CONSTRUCTION COORDINATION. EACH ACCESS SIGN SHALL HAVE 5 INCH, WHITE OPAQUE LETTERING ON BLUE REFLECTORIZED BACKGROUND. ACCESS SIGNS SHALL BE CONSIDERED INCIDENTAL TO THE BID AND NOT PART OF THE CONTRACT UNLESS OTHERWISE STATED. NO MORE THAN 3 BUSINESSES SHALL BE LISTED ON A ACCESS SIGN. SHOPPING CENTERS AND MALLS SHALL BE LISTED AS SUCH.

18. ALL ADVANCE WARNING SIGNS SHALL MEET THE MINIMUM REFLECTIVE INTENSITY REQUIREMENTS SET FORTH BY THE CITY OF ALBUQUERQUE. CONSTRUCTION COORDINATION SHALL DETERMINE ALL REQUIREMENTS AND APPROVE OR DISAPPROVE ANY ADVANCE WARNING SIGN PER SECTION 6A-4 OF THE MUTCD, LATEST EDITION.

19. 48-HOURS PRIOR TO OCCUPYING OR CLOSING OF A RIGHT-OF-WAY, CONTRACTOR SHALL NOTIFY: POLICE, FIRE DEPARTMENT, SCHOOLS, HOSPITALS, TRANSIT AUTHORITY, BUSINESSES AND/OR RESIDENTS THAT WILL BE AFFECTED BY THE CONSTRUCTION.

20. ANY FIELD ADJUSTMENTS SHALL BE APPROVED BY CONSTRUCTION COORDINATION.

21. EXCAVATIONS SHALL BE PLATED, TEMPORARILY PATCHED OR RESURFACED PRIOR TO OPENING OF TRAFFIC. A MINIMUM OF 11 FEET SHALL BE PROVIDED FOR TRAFFIC IN ANY GIVEN DIRECTION. CONTRACTOR IS RESPONSIBLE FOR ANY WORK INVOLVED IN SATISFYING THESE REQUIREMENTS.

22. CONTRACTOR SHALL AT ALL TIMES COMPLY WITH THE FOLLOWING:
1. STANDARDS AND REQUIREMENTS SET FORTH IN THE MANUAL ON UNIFORM TRAFFIC CONTROL DEVICES, LATEST EDITION.
2. THE CITY OF ALBUQUERQUE TRAFFIC CODE, LATEST EDITION.
3. SECTION 19 OF THE CITY OF ALBUQUERQUE'S STANDARD SPECIFICATIONS FOR PUBLIC WORK CONSTRUCTION, AS WELL AS OTHER SECTIONS.

23. FAILURE TO COMPLY WITH ANY OF THE ABOVE MENTIONED, WILL BE ADEQUATE CAUSE TO CEASE ALL WORK ON ANY CONSTRUCTION PROJECT. WORK WILL NOT RESUME UNTIL ALL REQUIREMENTS ARE ADDRESSED AND APPROVED BY CONSTRUCTION COORDINATION.


24. ALL TRAFFIC CONTROL DEVICES SHALL BE KEPT IN NEW-CLEAN CONDITION. WASHING OF EQUIPMENT IS INCIDENTAL TO ITS PLACEMENT AND MAINTENANCE.

25. TRAFFIC CONTROL STANDARDS APPLY ONLY WHERE THE CONSTRUCTION TRAFFIC CONTROL PLANS ARE NOT SPECIFIC.


26. ADVANCE WARNING SIGNS SHALL BE 36"x36" WITH SUPER ENGINEERING GRADE SHEETING OR BETTER. MOUNTING HEIGHT AT TOP OF SIGN SHALL BE THE SAME AS FOR A 48-INCH SIGN AS INDICATED IN THE MUTCD.

27. CONTRACTOR SHALL MAINTAIN A GRAFFITI-FREE WORK SITE. CONTRACTOR SHALL PROMPTLY REMOVE ANY AND ALL GRAFFITI FROM ALL EQUIPMENT, WHETHER PERMANENT OR TEMPORARY.

28. CONSTRUCTION COORDINATION DIVISION RESERVES THE RIGHT TO WITHHOLD BARRICADE AND EXCAVATION PERMITS IN ORDER TO ELIMINATE CONFLICTS WITH OTHER ON-GOING PROJECTS IN THE VICINITY OF OTHER SPECIAL EVENTS. BARRICADING PERMITS EFFECTING LANES OF TRAFFIC ON EITHER GOLF COURSE ROAD OR IRVING BOULEVARD WILL NOT BE ISSUED FOR THE PERIOD BETWEEN DECEMBER 8, 1997 UNTIL DECEMBER 28, 1997.

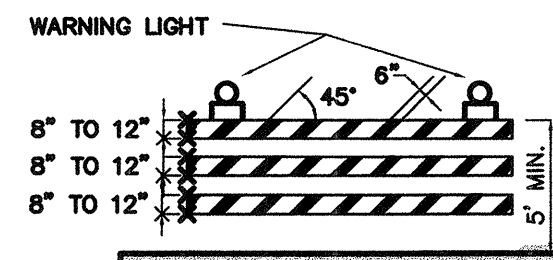


TYPE III BARRICADE

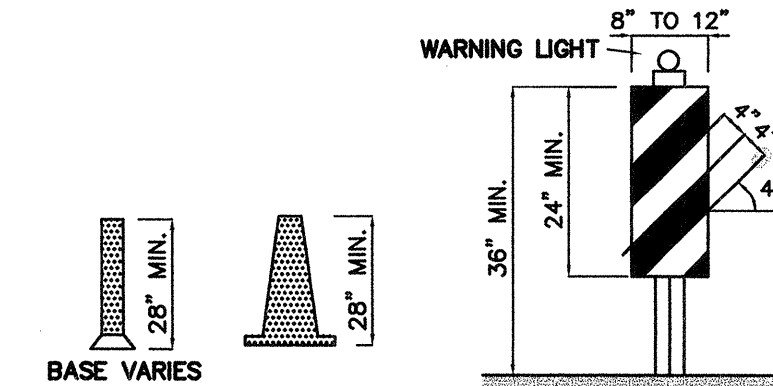


VERTICAL PANEL



CONES

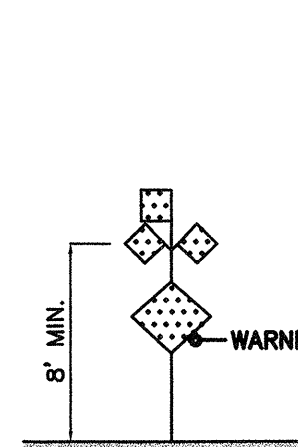

HIGH LEVEL WARNING DEVICE

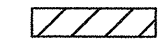

WORK AREA

BARRICADE - TYPE I, TYPE II, OR BARREL

BARRICADE - TYPE III

VERTICAL PANEL

WARNING SIGN

DISTANCE BETWEEN SIGNS - A DISTANCE MEASURED IN FEET EQUAL TO A VALUE OF TEN TIMES THE SPEED LIMIT OF THE STREET

FLAGMAN POSITION

SPACING BETWEEN BARRICADES- A DISTANCE MEASURED IN FEET EQUAL TO THE SPEED LIMIT OF THE STREET

TAPER LENGTH - SEE CHART BELOW

THE TANGENT LENGTH IS EQUAL TO THE TAPER LENGTH FOR A GIVEN STREET.

TAPER REQUIREMENTS

SPEED LIMIT (MPH)	TAPER LENGTH (L) (FEET)			MINIMUM NUMBER OF DEVICES FOR TAPER	MAXIMUM DEVICE SPACING IN FEET	
	10' LANE	11' LANE	12' LANE		ALONG TAPER	AFTER TAPER
20	70	75	80	5	20	20
25	105	115	125	6	25	25
30	150	165	180	7	30	30
35	205	225	245	8	35	35
40	270	295	320	9	40	40
45	450	495	540	13	45	45
50	500	550	600	13	50	50
55	550	605	660	13	55	55

RECOMMENDED SIGN SPACING(D) FOR ADVANCE WARNING SIGN SERIES

SPEED LIMIT (MPH)	MINIMUM DISTANCE IN FEET	
	BETWEEN SIGNS	FROM LAST SIGN TO TAPER
0-20	10 X SPEED LIMIT	10 X SPEED LIMIT
25-30	10 X SPEED LIMIT	10 X SPEED LIMIT
30-35	10 X SPEED LIMIT	10 X SPEED LIMIT
40-45	10 X SPEED LIMIT	10 X SPEED LIMIT
50-60	10 X SPEED LIMIT	10 X SPEED LIMIT

TAPER CRITERIA


TYPE OF TAPER	TAPER LENGTH
UPSTREAM TAPER:	
MERGING TAPER	L MINIMUM
SHIFTING TAPER	1/2 L MINIMUM
SHOULDER TAPER	1/2 L MINIMUM
TWO-WAY TRAFFIC TAPER	100 FEET MAXIMUM
DOWNSTREAM TAPERS	100 FEET PER LANE

TAPER LENGTH COMPUTATION


SPEED LIMIT	L = WS ² / 60
40 MPH OR LESS	L = WS ² / 60
45 MPH OR GREATER	L = W x S

L = TAPER LENGTH
W = WIDTH OF OFFSET IN FEET
S = POSTED SPEED OR OFF-PEAK 85-PERCENTILE SPEED IN MPH

SIGN FACE DETAILS

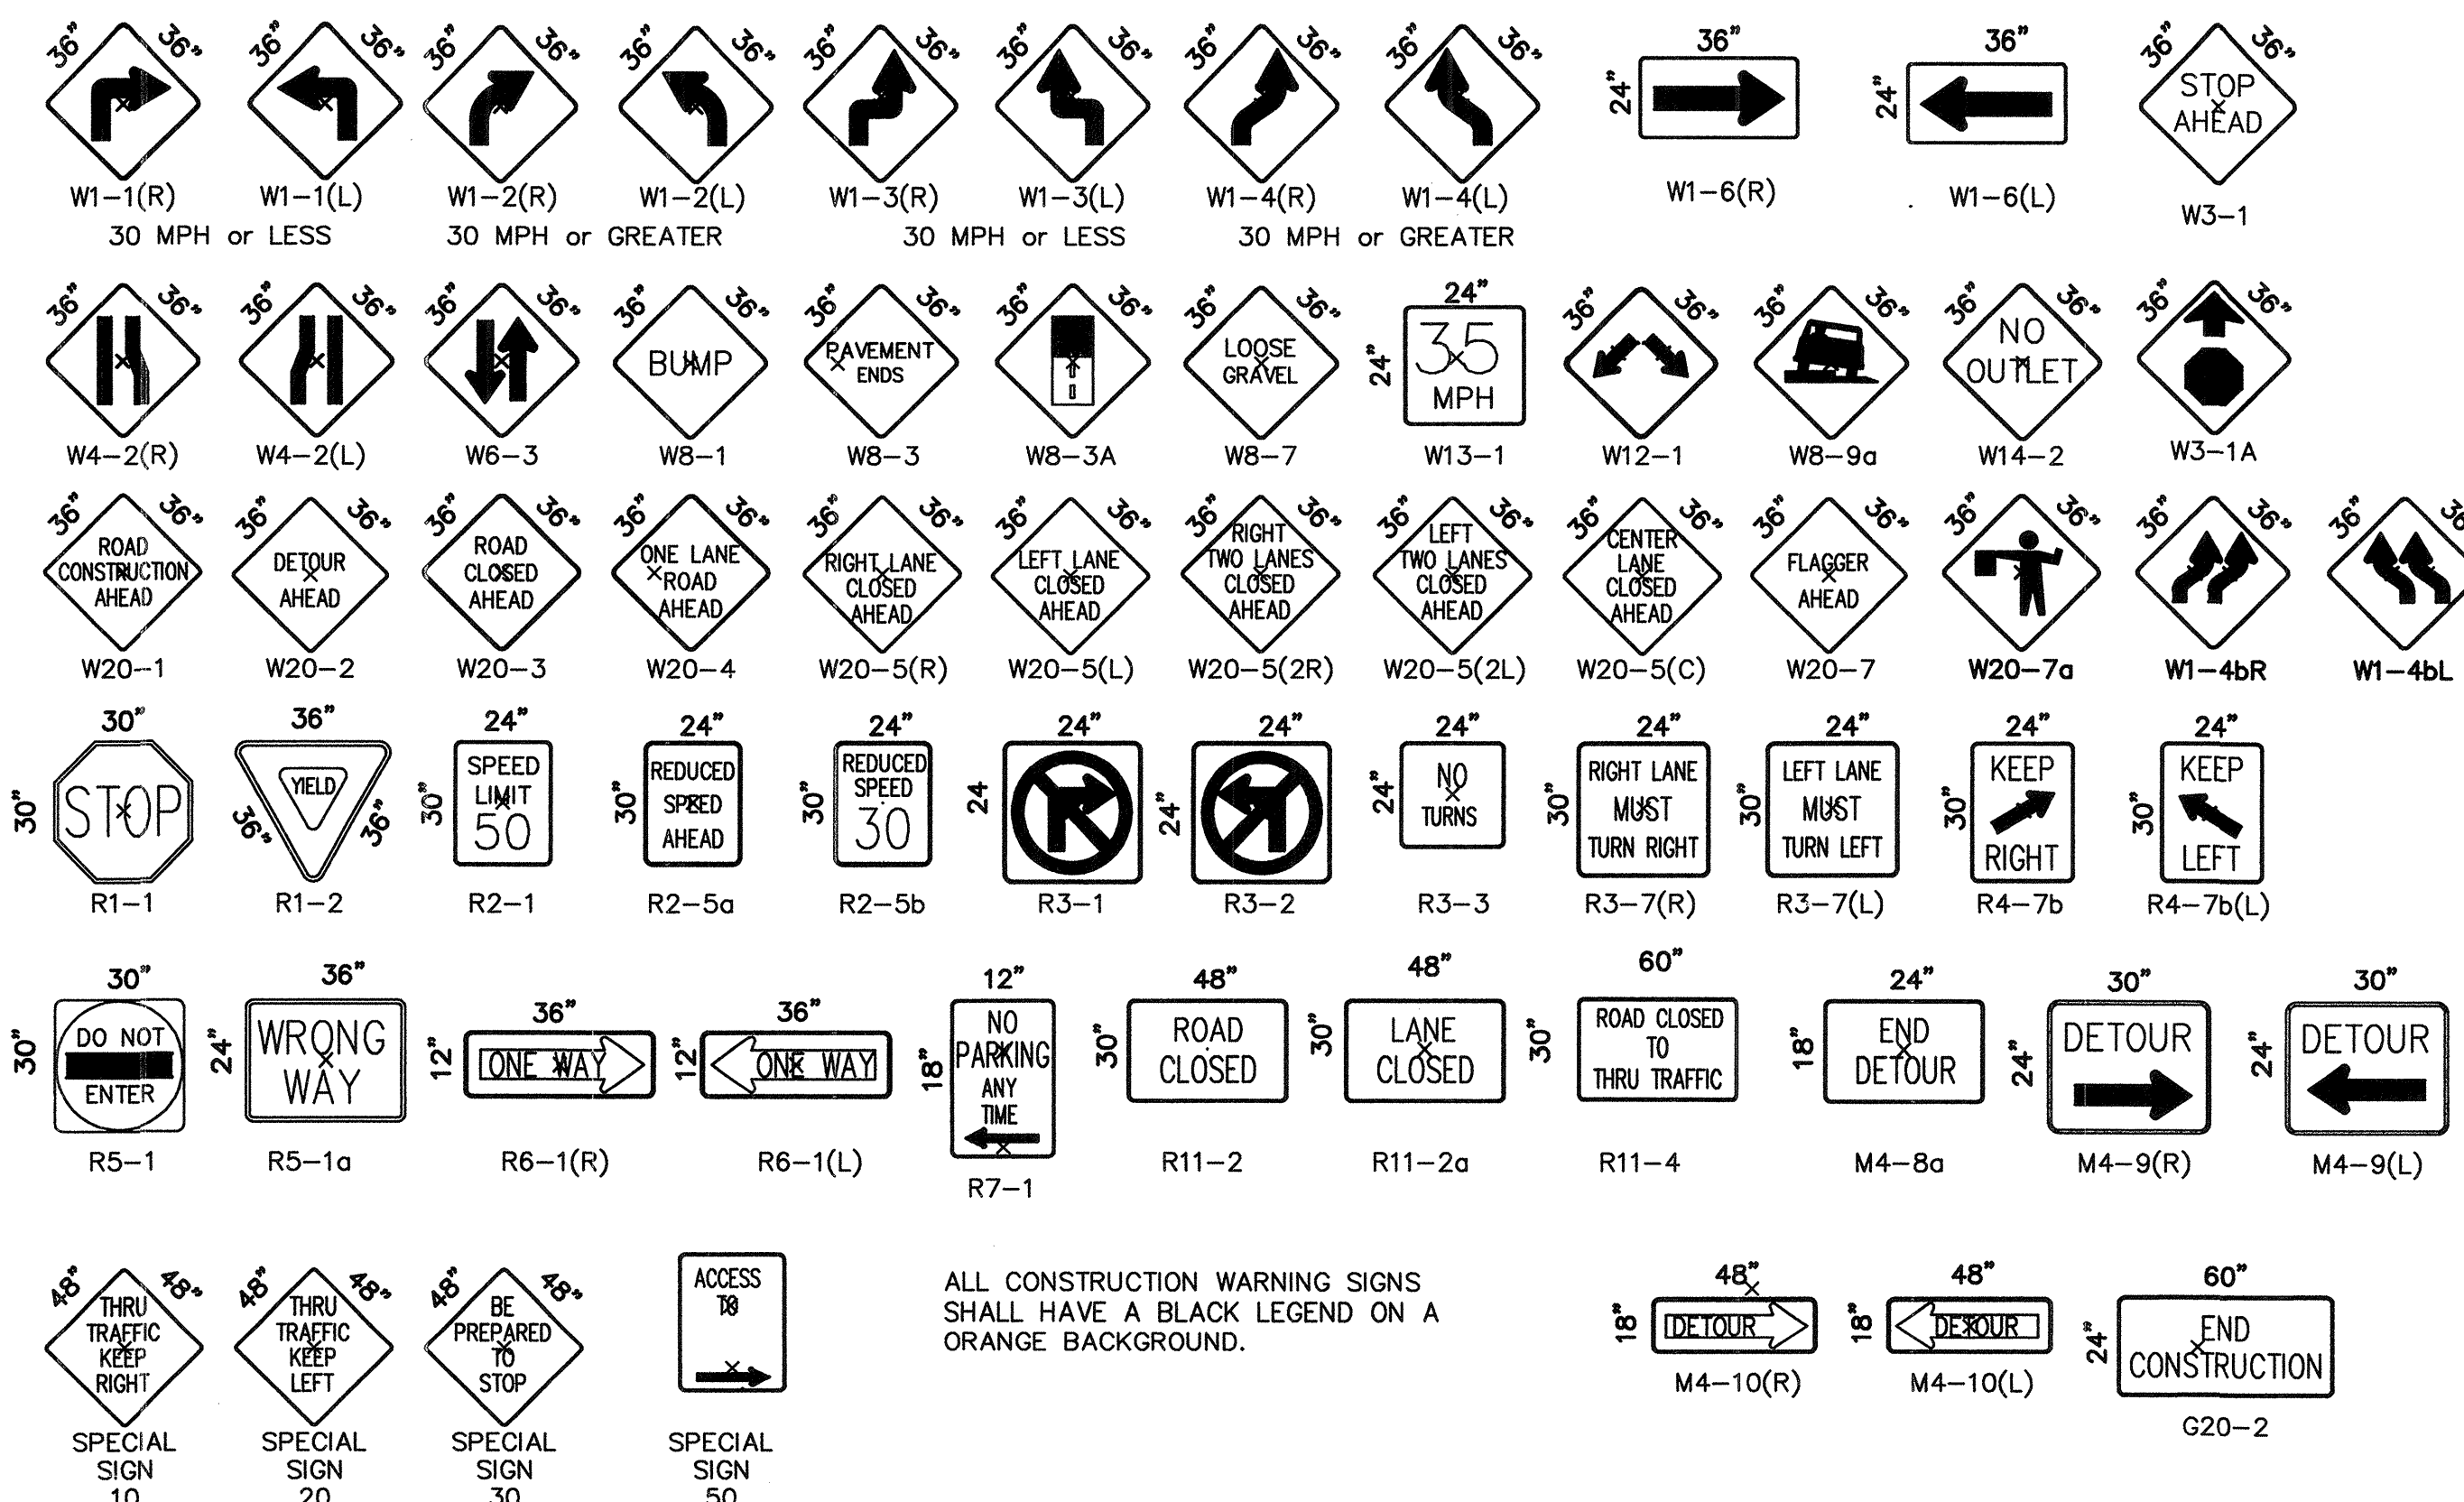

ALL CONSTRUCTION WARNING SIGNS SHALL HAVE A BLACK LEGEND ON A ORANGE BACKGROUND.

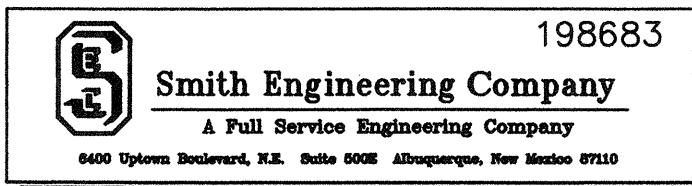

CITY OF ALBUQUERQUE PUBLIC WORKS DEPARTMENT ENGINEERING DEVELOPMENT GROUP			
TITLE: ETHLYN AVENUE IMPROVEMENTS SIGNING AND CONSTRUCTION TRAFFIC CONTROL STANDARDS			
Design Review Committee	City Engineer Approval	Last Design Update	
City Project No. 5744.90		Zone Map No. L-14	Sheet 10 Of 10