


CITY OF ALBUQUERQUE

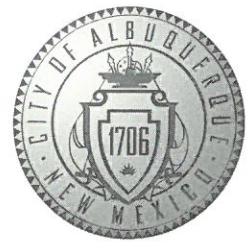

December 21, 2017

Mark Goodwin, P.E.
Mark Goodwin & Associates
PO Box 90606
Albuquerque, NM 87199

**RE: Family Dollar
1400 Gibson Blvd SE
Grading Plan
Engineers Stamp Date: 12/12/17 (L15D049)**

Dear Mr. Goodwin:

Based on the information provided in your submittal received on 12/13/17, the Grading Plan cannot be approved for Building Permit until the following are addressed:

1. The property lines do not appear to match the Bernalillo County parcels. Please provide a current ALTA Survey and clearly show property lines on the grading plan.
2. This site must demonstrate downstream capacity before any increase in runoff can be approved.
3. Stormwater quality ponds need to be located where they can intercept all flows from the impervious areas.
4. It is unclear what is being built with this project. Is all of the paving being completed with this phase, leaving only building pads for phase 2? Or, is only enough paving to serve the Family Dollar being completed?
5. Work along the southern boundary needs to be clarified. Extend the section view to show existing and proposed grades and the existing walls. If a new wall straddling the property line is required, written permission from the adjoining landowners will need to be obtained.
6. The stormwater quality ponds will need private facility drainage covenants.

If you have any questions, please contact me at 924-3695 or dpeterson@cabq.gov.

Sincerely,

Dana Peterson, P.E.
Senior Engineer, Planning Dept.
Development Review Services



City of Albuquerque

Planning Department

Development & Building Services Division

DRAINAGE AND TRANSPORTATION INFORMATION SHEET (REV 09/2015)

Project Title: _____ **Building Permit #:** _____ **City Drainage #:** _____

DRB#: _____ **EPC#:** _____ **Work Order#:** _____

Legal Description: _____

City Address: _____

Engineering Firm: _____ **Contact:** _____

Address: _____

Phone#: _____ **Fax#:** _____ **E-mail:** _____

Owner: _____ **Contact:** _____

Address: _____

Phone#: _____ **Fax#:** _____ **E-mail:** _____

Architect: _____ **Contact:** _____

Address: _____

Phone#: _____ **Fax#:** _____ **E-mail:** _____

Other Contact: _____ **Contact:** _____

Address: _____

Phone#: _____ **Fax#:** _____ **E-mail:** _____

Check all that Apply:

DEPARTMENT:

- ☐ HYDROLOGY/ DRAINAGE
☐ TRAFFIC/ TRANSPORTATION
☐ MS4/ EROSION & SEDIMENT CONTROL

TYPE OF SUBMITTAL:

- ☐ ENGINEER/ ARCHITECT CERTIFICATION
- ☐ CONCEPTUAL G & D PLAN
☐ GRADING PLAN
☐ DRAINAGE MASTER PLAN
☐ DRAINAGE REPORT
☐ CLOMR/LOMR
- ☐ TRAFFIC CIRCULATION LAYOUT (TCL)
☐ TRAFFIC IMPACT STUDY (TIS)
☐ EROSION & SEDIMENT CONTROL PLAN (ESC)
- ☐ OTHER (SPECIFY) _____

CHECK TYPE OF APPROVAL/ACCEPTANCE SOUGHT:

- ☐ BUILDING PERMIT APPROVAL
☐ CERTIFICATE OF OCCUPANCY
- ☐ PRELIMINARY PLAT APPROVAL
☐ SITE PLAN FOR SUB'D APPROVAL
☐ SITE PLAN FOR BLDG. PERMIT APPROVAL
☐ FINAL PLAT APPROVAL
☐ SIA/ RELEASE OF FINANCIAL GUARANTEE
☐ FOUNDATION PERMIT APPROVAL
☐ GRADING PERMIT APPROVAL
☐ SO-19 APPROVAL
☐ PAVING PERMIT APPROVAL
☐ GRADING/ PAD CERTIFICATION
☐ WORK ORDER APPROVAL
☐ CLOMR/LOMR
- ☐ PRE-DESIGN MEETING
☐ OTHER (SPECIFY) _____

IS THIS A RESUBMITTAL?: ☐ Yes ☐ No

DATE SUBMITTED: _____ **By:** _____

COA STAFF: _____ ELECTRONIC SUBMITTAL RECEIVED: _____

HYDROLOGY NOTES

THE TOTAL SITE IS BOUNDED BY GIBSON BLVD LANE SW TO THE NORTH, AND EXISTING RESIDENTIAL DEVELOPMENT TO THE SOUTH. THE PROJECT SITE IS A COMMERCIAL PROPERTY WITH 3 PROPOSED BUILDINGS.

THE PROJECT SITE CONSISTS OF 1.6354 ACRES. NO OFFSITE FLOWS ENTER THIS SITE. THE SITE IS NOT IN A 100YR FLOOD ZONE.

THE DEVELOPED FLOW FOR THIS ENTIRE SITE IS 6.76CFS. THE HYDROLOGY WAS CALCULATED PER COA DPM USING AHMO. $P_{max}=2.61"$ FROM NOAA 14. THE RESULTS ARE SUMMARIZED IN THE HYDROLOGY TABLE ON THIS SHEET.

THE DRAINAGE BASIN FROM THE DEVELOPED AREA WILL NOT BE CHANGED. ALL RUNOFF WILL BE COLLECTED BY PROPOSED ROAD GRADES TO A TYPE "D" INLET IN A SUMP CONDITION. THE FLOW WILL THEN BE CONVEYED BY A 18" RCP AT A VELOCITY OF 3.83 FT/S TO AN EXISTING MANHOLE IN GIBSON BLVD.

BASIN DATA

BASIN ID	% D	% C	AREA	Q(100)	VOLUME
100	75	25	1.6354 AC.	6.76 cfs	.2813 AC-FT

FIRST FLUSH

THE "FIRST FLUSH" IS BEING ACCOMPLISHED THROUGH CURB OPENINGS TO 1' DEPRESSED LANDSCAPED MEDIANS ONSITE.

REQUIRED VOLUME = $0.34" \times$ IMPERVIOUS AREA
= $0.34" / 12 \times (53532 \text{ SF})$
= 1516.74 CF

VOLUME PROVIDED = 1730 CF


DEPTH = 8" (SEE DETAILS THIS SHEET)
AREA = 2582 SF
VOLUME = 1729.94 CF

NOTES

- CONTRACTOR MUST OBTAIN A TOPSOIL DISTURBANCE PERMIT FROM THE ENVIRONMENTAL HEALTH DIVISION PRIOR TO CONSTRUCTION.
- CITY OF ALBUQUERQUE STANDARD SPECIFICATIONS FOR PUBLIC WORKS CONSTRUCTION, LATEST EDITION SHALL GOVERN ALL WORK.
- THE CONTRACTOR SHALL CONFORM TO ALL CITY, COUNTY, STATE AND FEDERAL DUST CONTROL MEASURES AND REQUIREMENTS AND WILL BE RESPONSIBLE FOR PREPARING AND OBTAINING ALL NECESSARY APPLICATIONS AND APPROVALS.
- THE CONTRACTOR SHALL ENSURE THAT NO SOIL ERODES FROM THE LOTS INTO PUBLIC RIGHT-OF-WAY. THIS CAN BE ACHIEVED BY CONSTRUCTING TEMPORARY BERMS AND WETTING THE SOIL TO KEEP IT FROM BLOWING.
- THE EARTHWORK CONTRACTOR SHALL STOCKPILE ENOUGH MATERIAL ADJACENT TO RETAINING WALL LOCATIONS TO BE UTILIZED FOR WALL BACKFILL.

LEGEND

—5065—	CONTOUR (MAJOR)	—>	ANCHOR
- - -	CONTOUR (MINOR)	⊗	WATER VALVE
==	CURB AND GUTTER	⊕	FIRE HYDRANT
▒	CONCRETE	⊙	WATER METER
---	WALL	⊞	WATER MANHOLE
—○—	FENCE - CHAIN LINK	⊠	IRRIGATION CONTROL
TC=	TOP CURB / FLOW LINE	⊡	TRAFFIC PULL BOX
FL=	SPOT ELEVATION	⊢	PULLBOX
⊙	SANITARY SEWER MANHOLE	⊣	LIGHT POLE
⊕	STORM DRAIN MANHOLE	⊤	SIGN
⊞	CATCH BASIN/DROP INLET	⊥	BOLLARD
==	CMP/PVC DRAIN PIPE	⊥	DEPRESSED LANDSCAPE
—E—	OVERHEAD ELECTRIC/UTILITY LINE		
○	POLE		

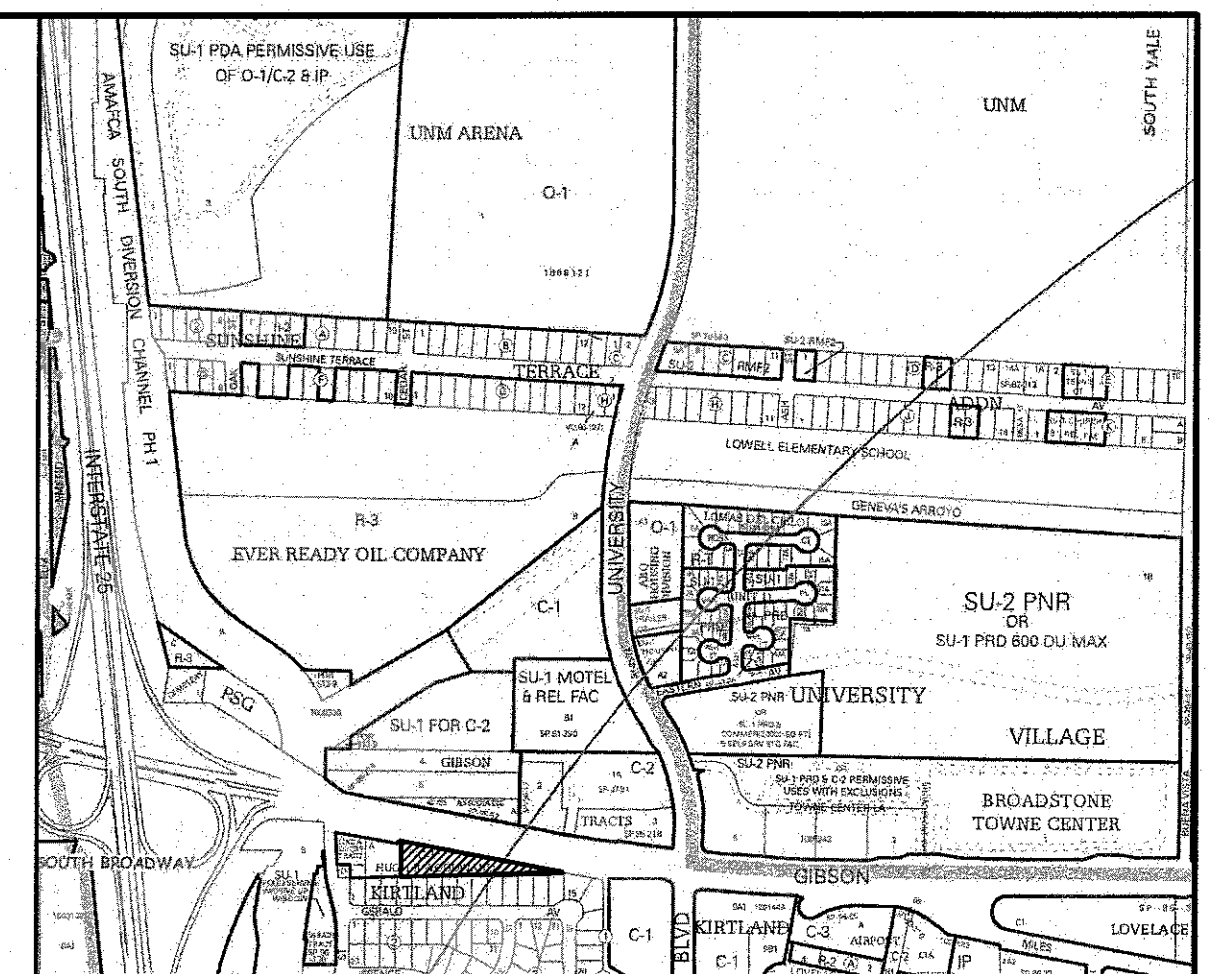

VICINITY MAP ZONE MAP: L-15-Z

LEGAL DESCRIPTION


PORTION OF TRACT B, GIBSON AND MILES AREA, WITHIN THE TOWN OF ALBUQUERQUE, GRANT, PROJECTED SECTION 28, TOWNSHIP 10 NORTH, RANGE 3 EAST, N.M.P.M., CITY OF ALBUQUERQUE, NEW MEXICO

ACS BENCHMARK

BENCHMARK FOR THIS SITE IS AN AGRS BRASS CAP STAMPED "SDC-13-4", GEOGRAPHIC POSITION, IN FEET (NAD83), NEW MEXICO STATE PLANE COORDINATES (CENTRAL ZONE), N=1477145.578, E=1525011.494, G-G=0.999677909, DA=001317.49, ELEVATION, IN FEET (NAVD88) = 5043.390


UNDERGROUND UTILITIES CAUTION:

NOTE THAT ALL EXISTING UTILITIES MAY NOT BE SHOWN. ALL EXISTING SERVICE CONNECTIONS ARE NOT SHOWN. ANY EXISTING UTILITIES THAT ARE SHOWN ARE APPROXIMATE LOCATION ONLY. IT SHALL BE THE SOLE RESPONSIBILITY OF THE CONTRACTOR TO CONTACT ALL THE UTILITY OWNERS AND TO CONDUCT ALL NECESSARY FIELD INVESTIGATIONS PRIOR TO ANY EXCAVATIONS TO DETERMINE THE ACTUAL LOCATION OF UTILITIES AND OTHER IMPROVEMENTS.

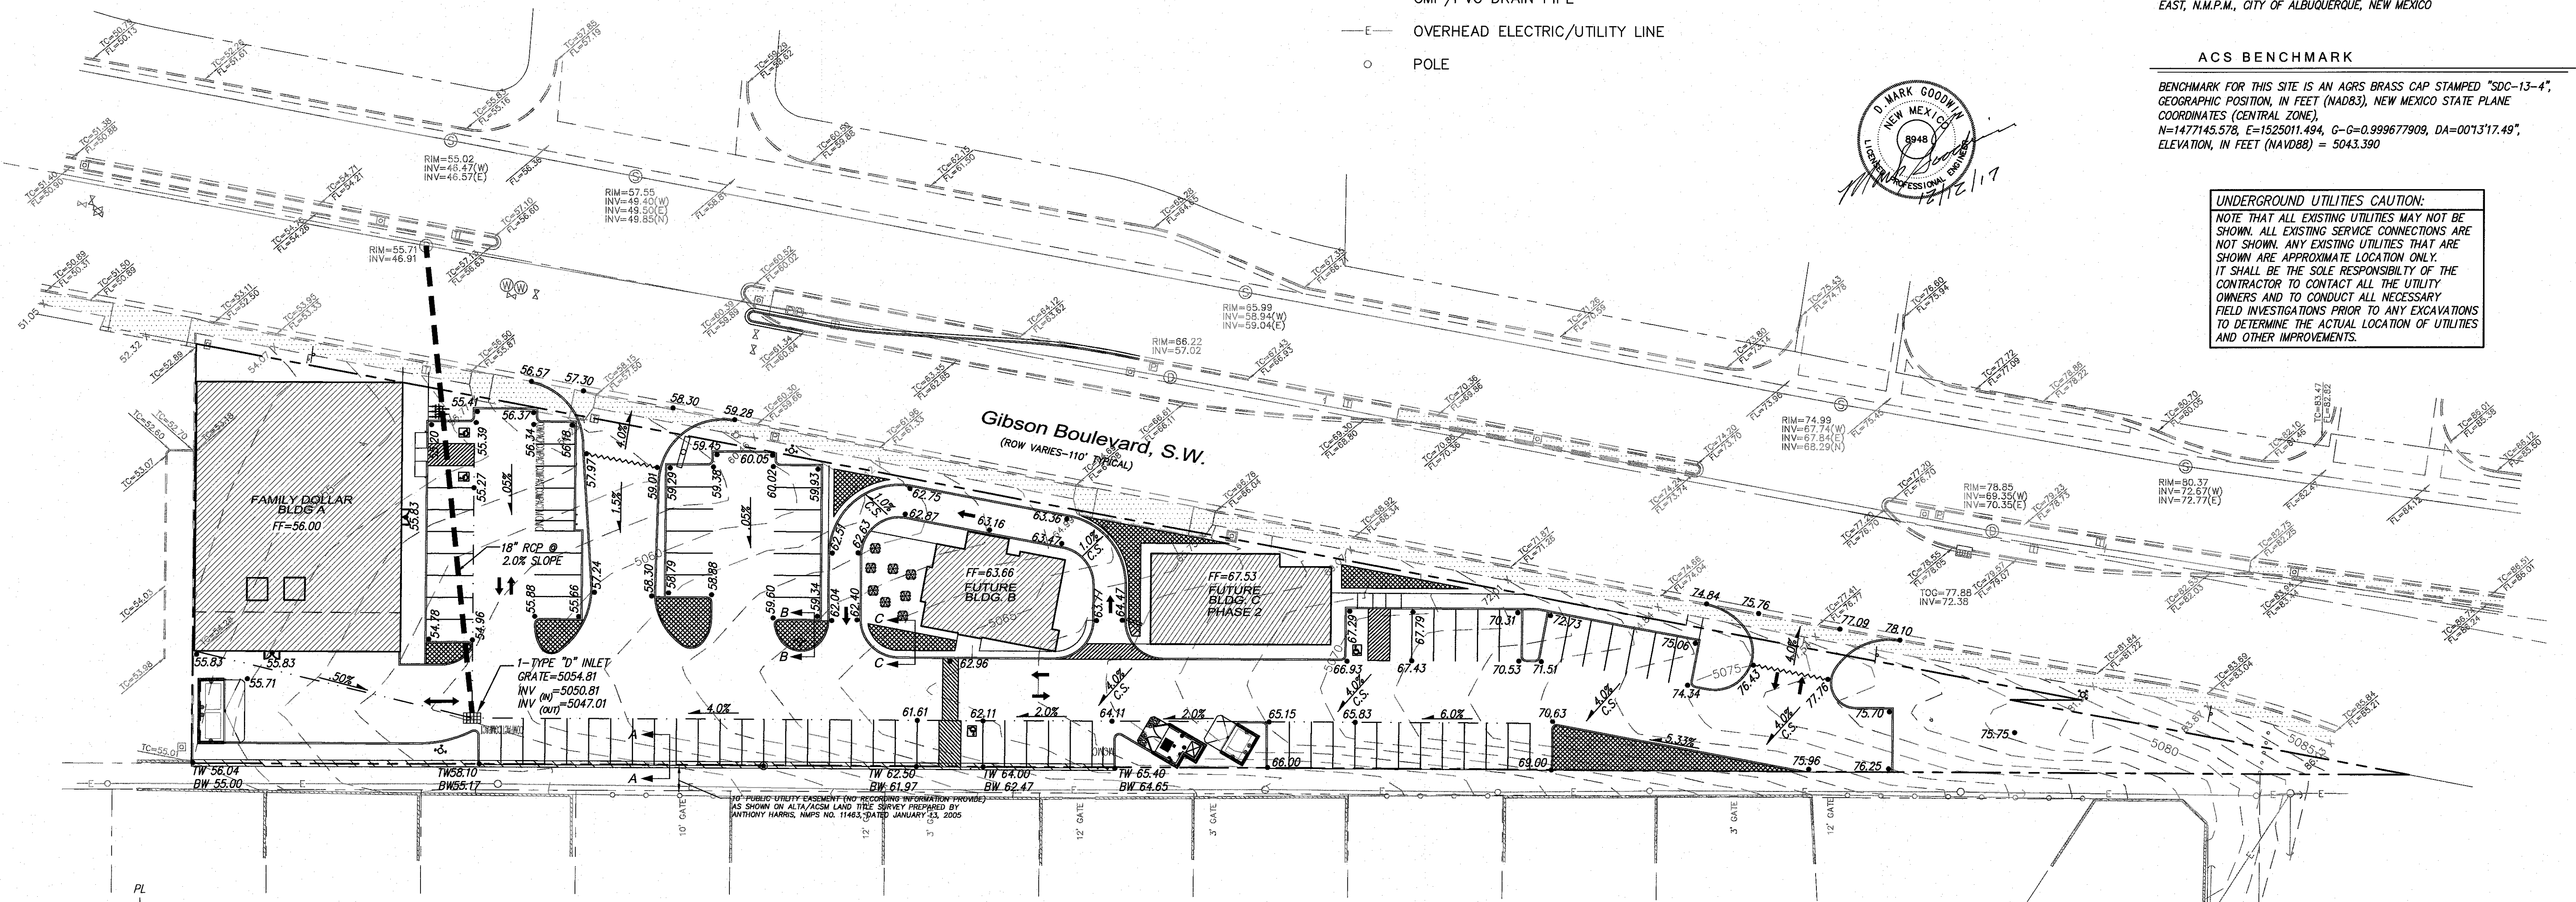

LANDSCAPE BUFFER NOTES:

- Swale to be 6" deep when the distance between back of curb and the sidewalk is 5 feet.
- Swale to be 1" deeper than the distance in feet between the back of curb and the sidewalk for landscape buffers different than 5 feet wide.
- For wide landscape buffers, greater than 10 feet, the maximum depth is 10 inches.
- Final grade of dirt to be 1 to 2 inches below top of curb and top of sidewalk grade.
- Surface between back of curb and sidewalk to be covered with gravel mulch (minimum 3/4"), cobbles or rip-rap. Do not fill entire swale.
- A check dam will be required for swales on steeper longitudinal slopes and longer sections. The engineer will determine the location.
- Landscape fabric is recommended, but not required, between the dirt and the stone. If landscape fabric is to be used it is to be permeable.
- Detail is to be built for all new construction. In the case where the sidewalk is existing and the landscape buffer is improved with landscaping and/or some form of erosion protection, this requirement does not apply.

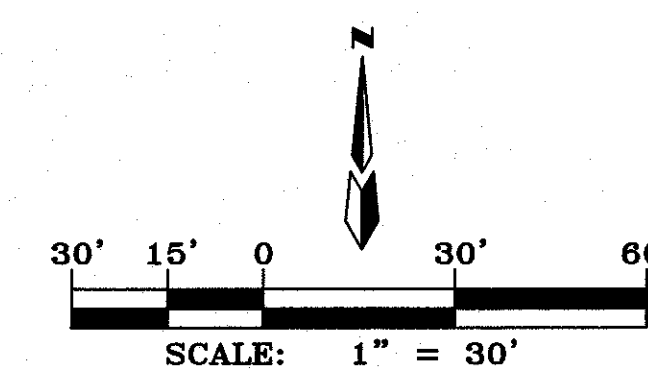

SECTION A-A

N.T.S. RETAINING WALL DETAIL (TYP.)

SECTION B-B

N.T.S. DEPRESSED LANDSCAPED DETAIL (TYP.)

SECTION C-C

N.T.S. DEPRESSED LANDSCAPED DETAIL (TYP.)

FAMILY DOLLAR STORE
GRADING & DRAINAGE PLAN

MARK GOODWIN & ASSOCIATES, P.A.
CONSULTING ENGINEERS

P.O. BOX 90606
ALBUQUERQUE, NEW MEXICO 87199
(505)828-2200, FAX (505)797-9539

Designed: DMG	Drawn: DER	Checked: DMG	Sheet 1 of 1
Scale: 1" = 30'	Date: 11/10/17	Job: A16075	