


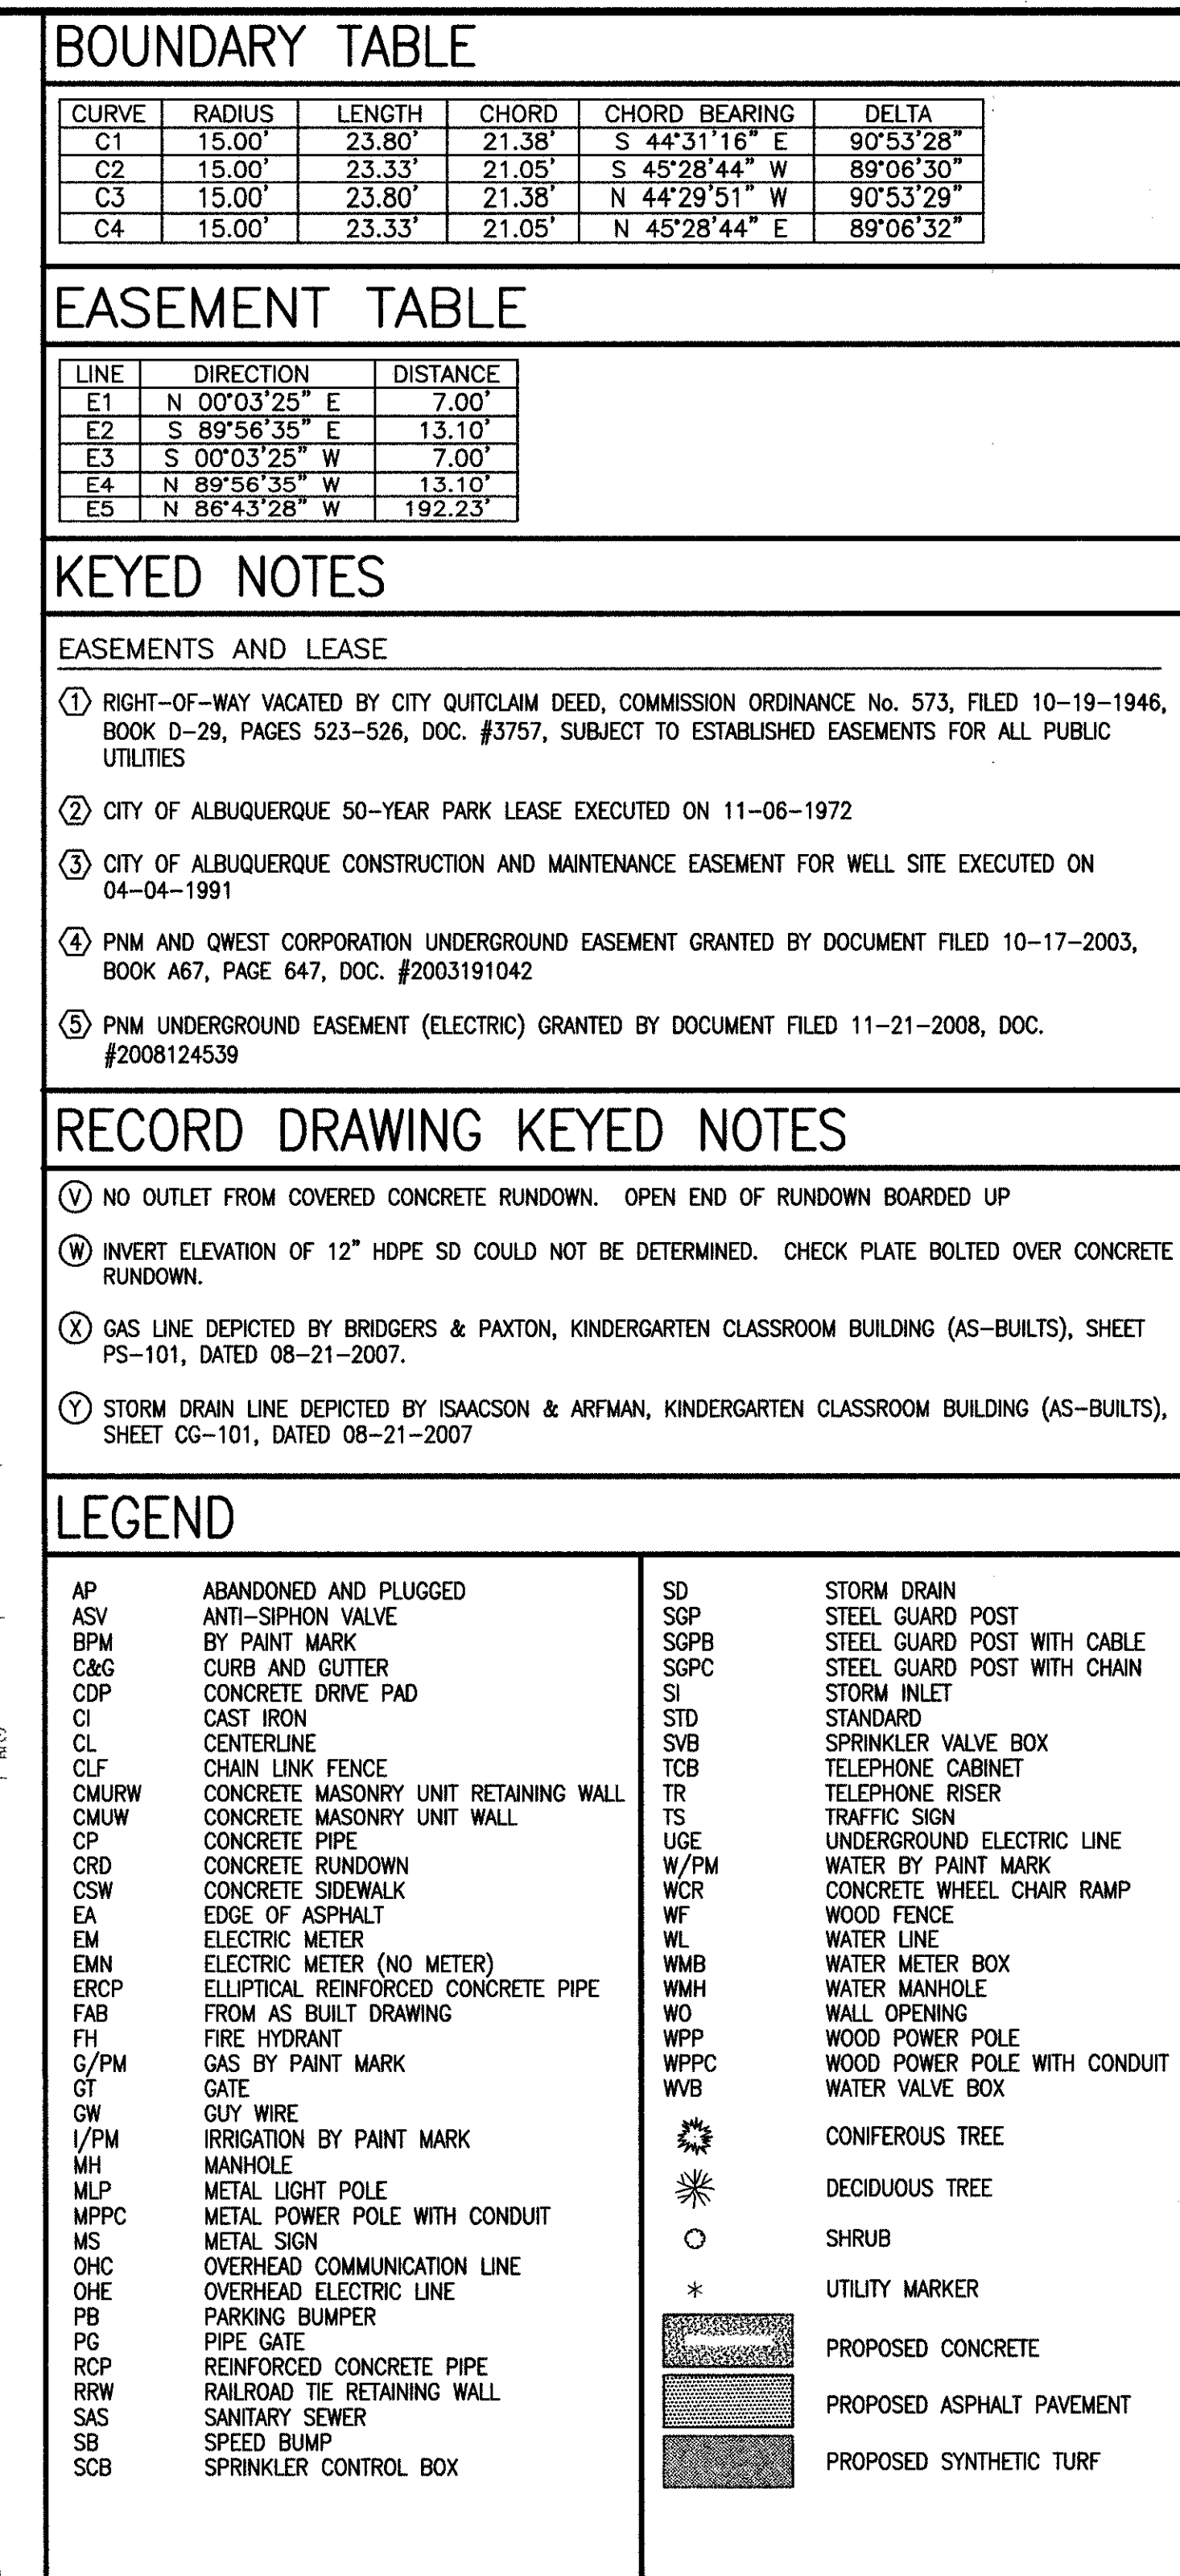


File Path: P:\DATA\2010.183.1\ENG\R6\	Plot Date: 08-08-2013
File Name: 101831_SH1_R6.DWG	Plot Time: 07:30 am

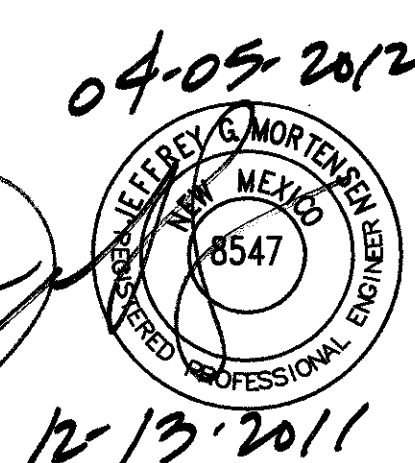


DESIGNED BY	J.G.M.	NO.	DATE	BY	REVISIONS	JOB NO.
		1A	08/12	J.G.M.	RECORD DRAWING	2010.183.1
DRAWN BY	E.J.S.					DATE
						10-2011
APPROVED BY	J.G.M.					SHEET
						12 OF 12

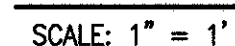


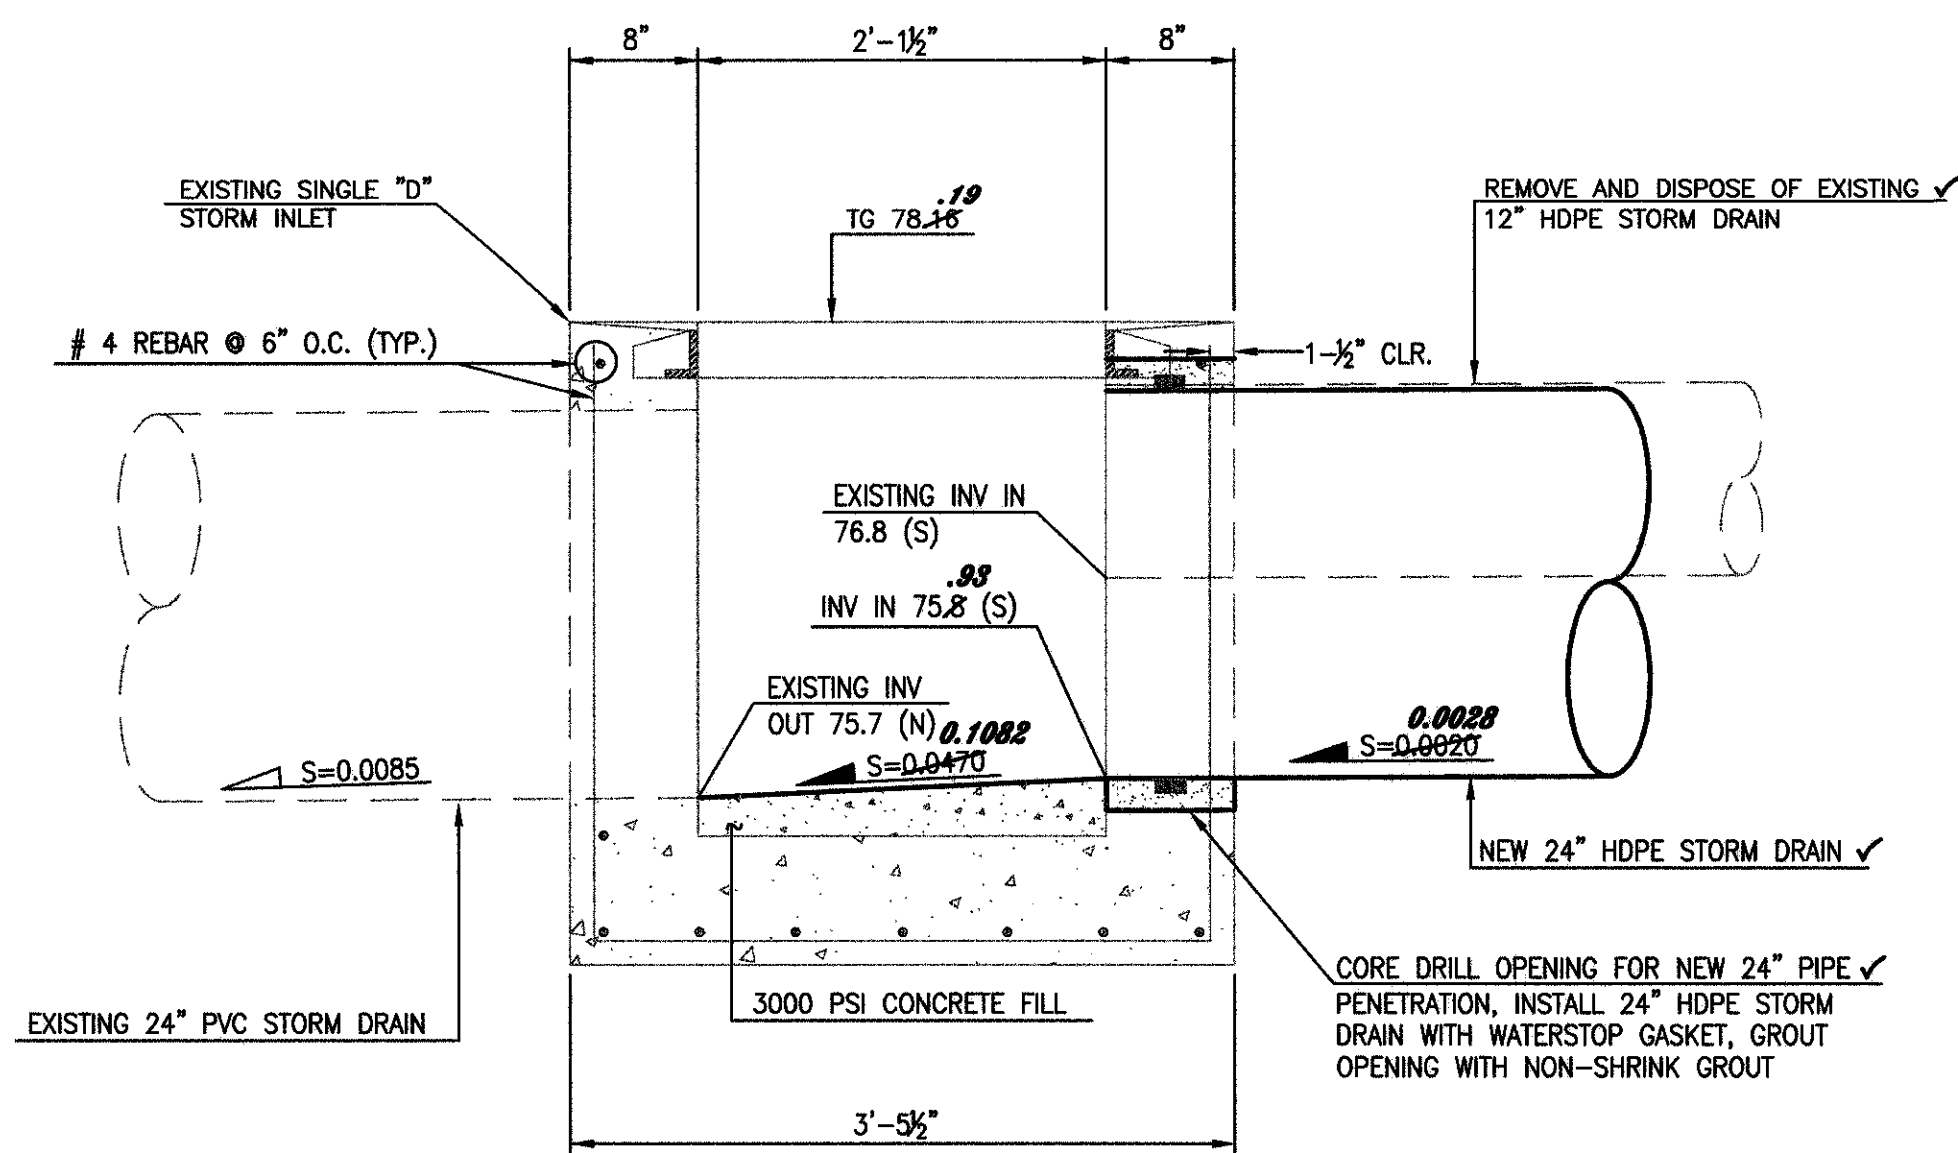


D1 EXISTING INLET PIPE PENETRATION SECTION
SCALE: 1" = 1'-0"

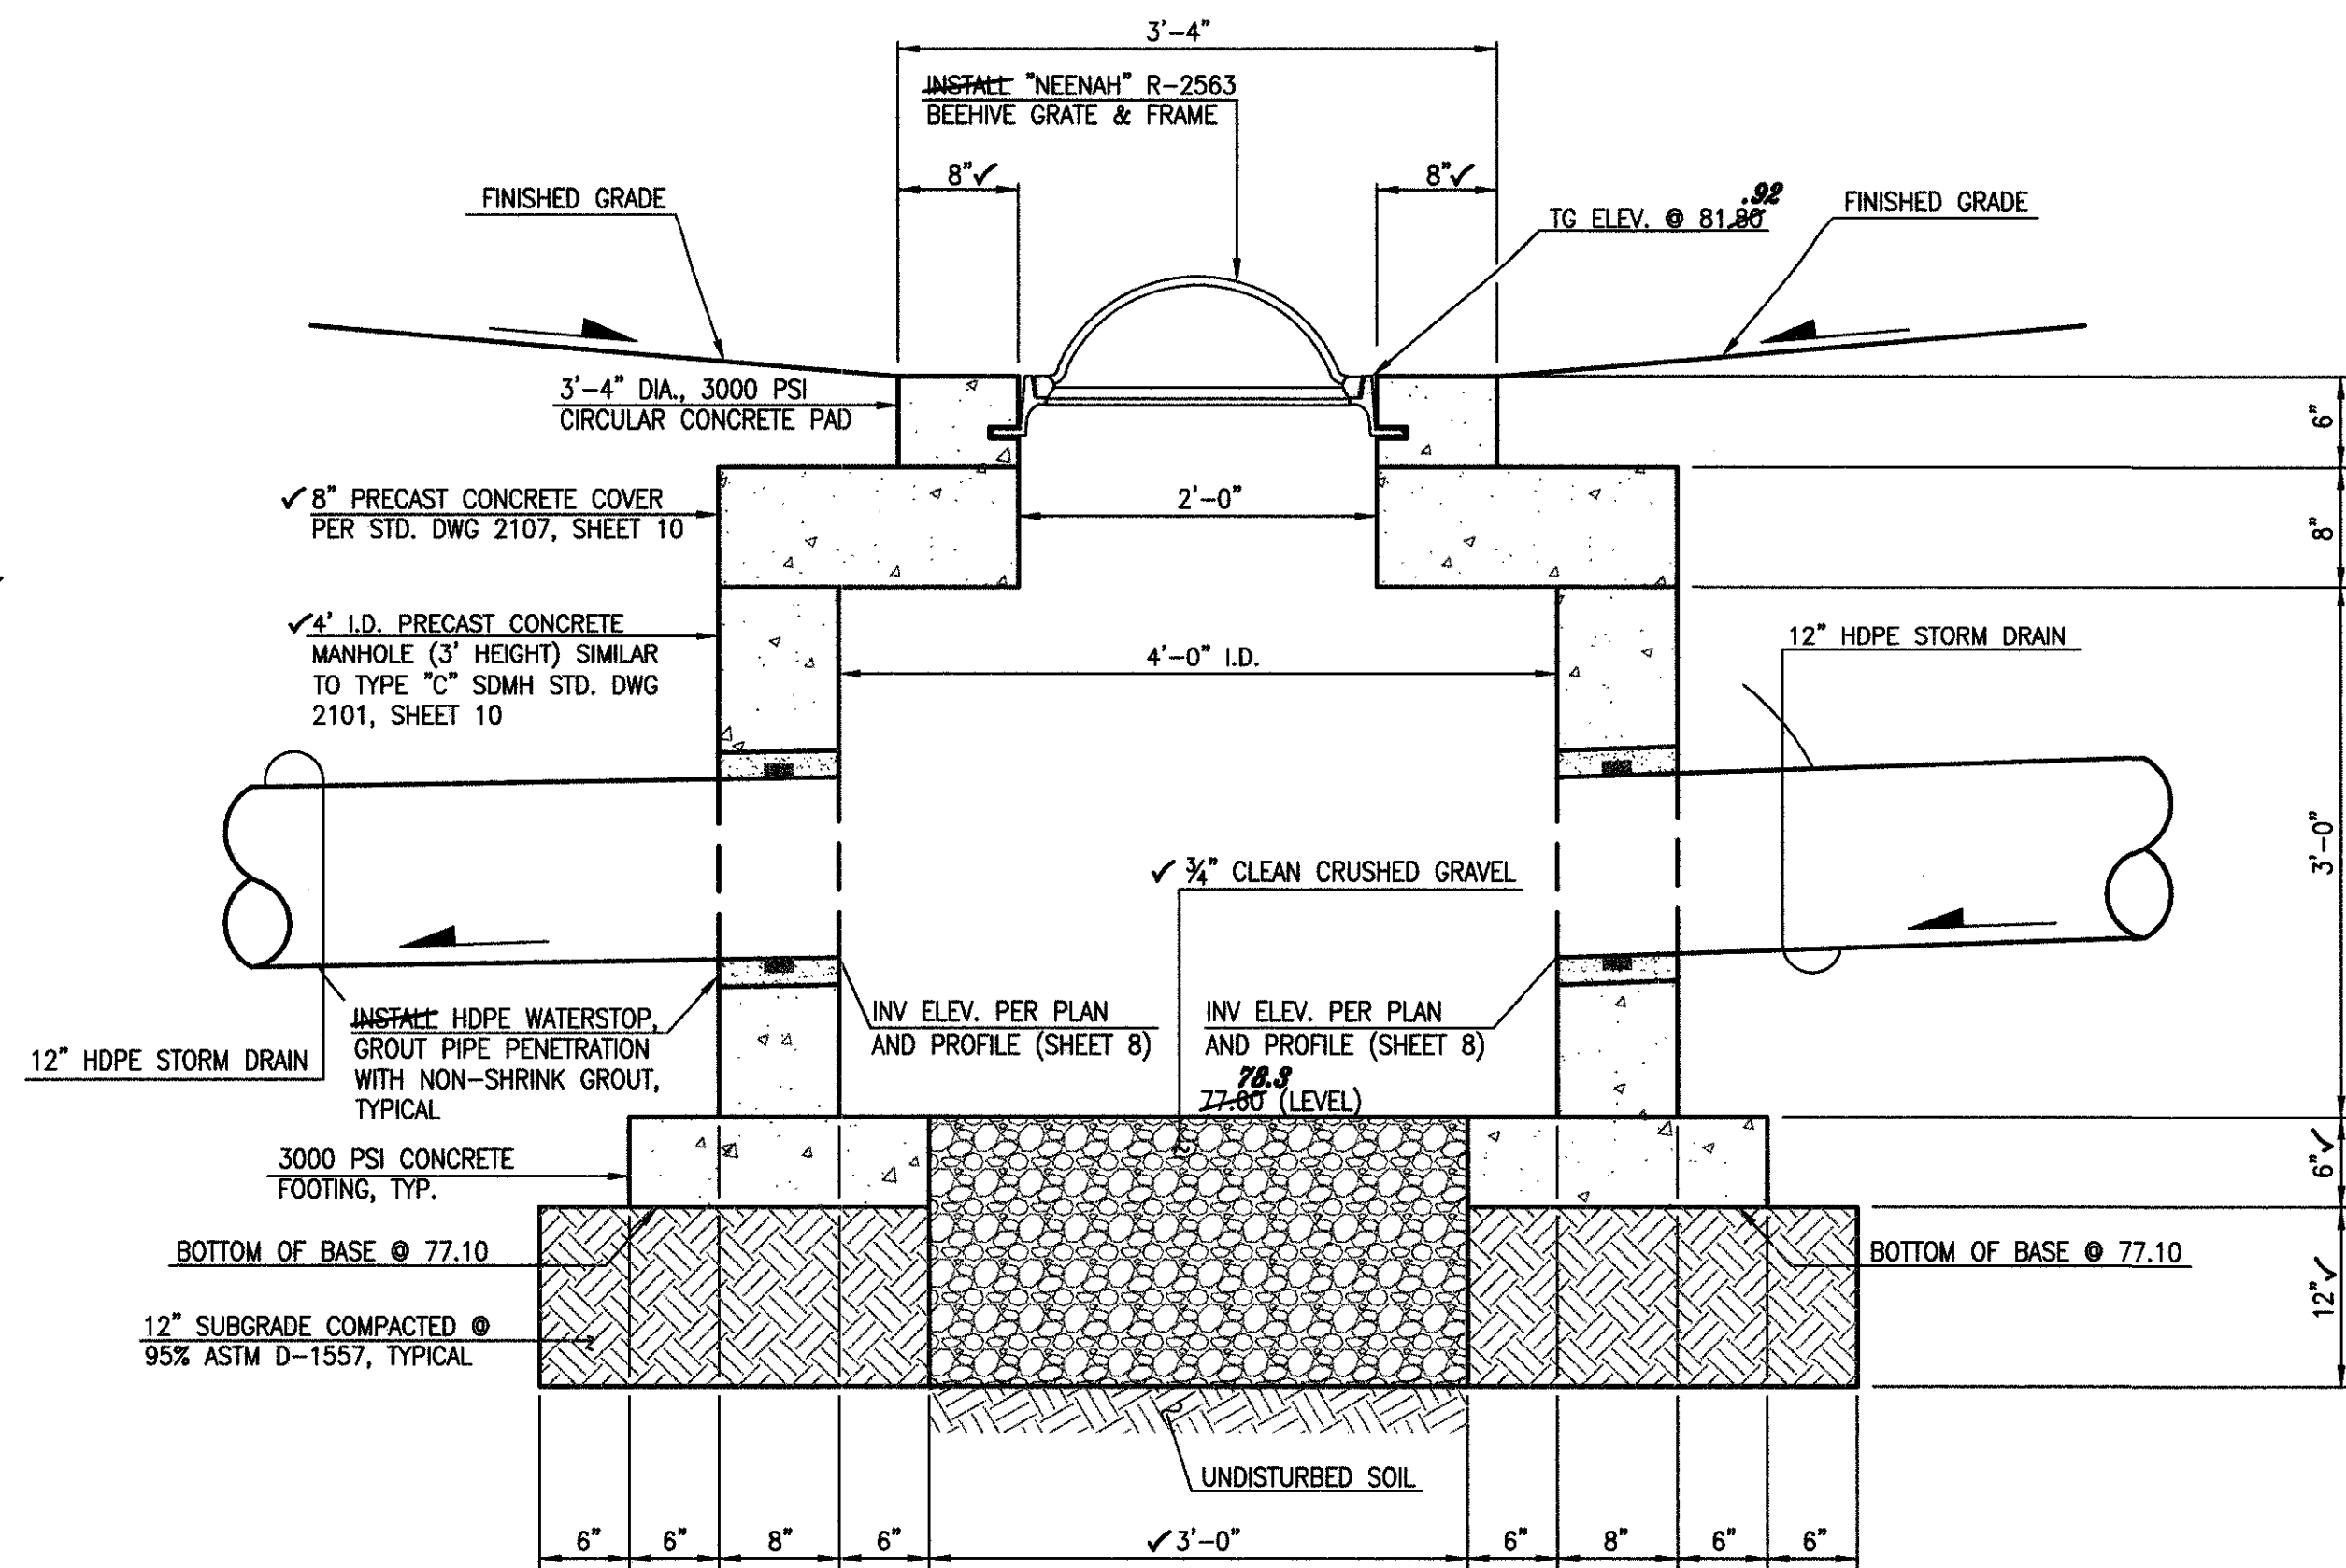


D3 FRENCH DRAIN INLET SECTION
SCALE: 1" = 1'-0"

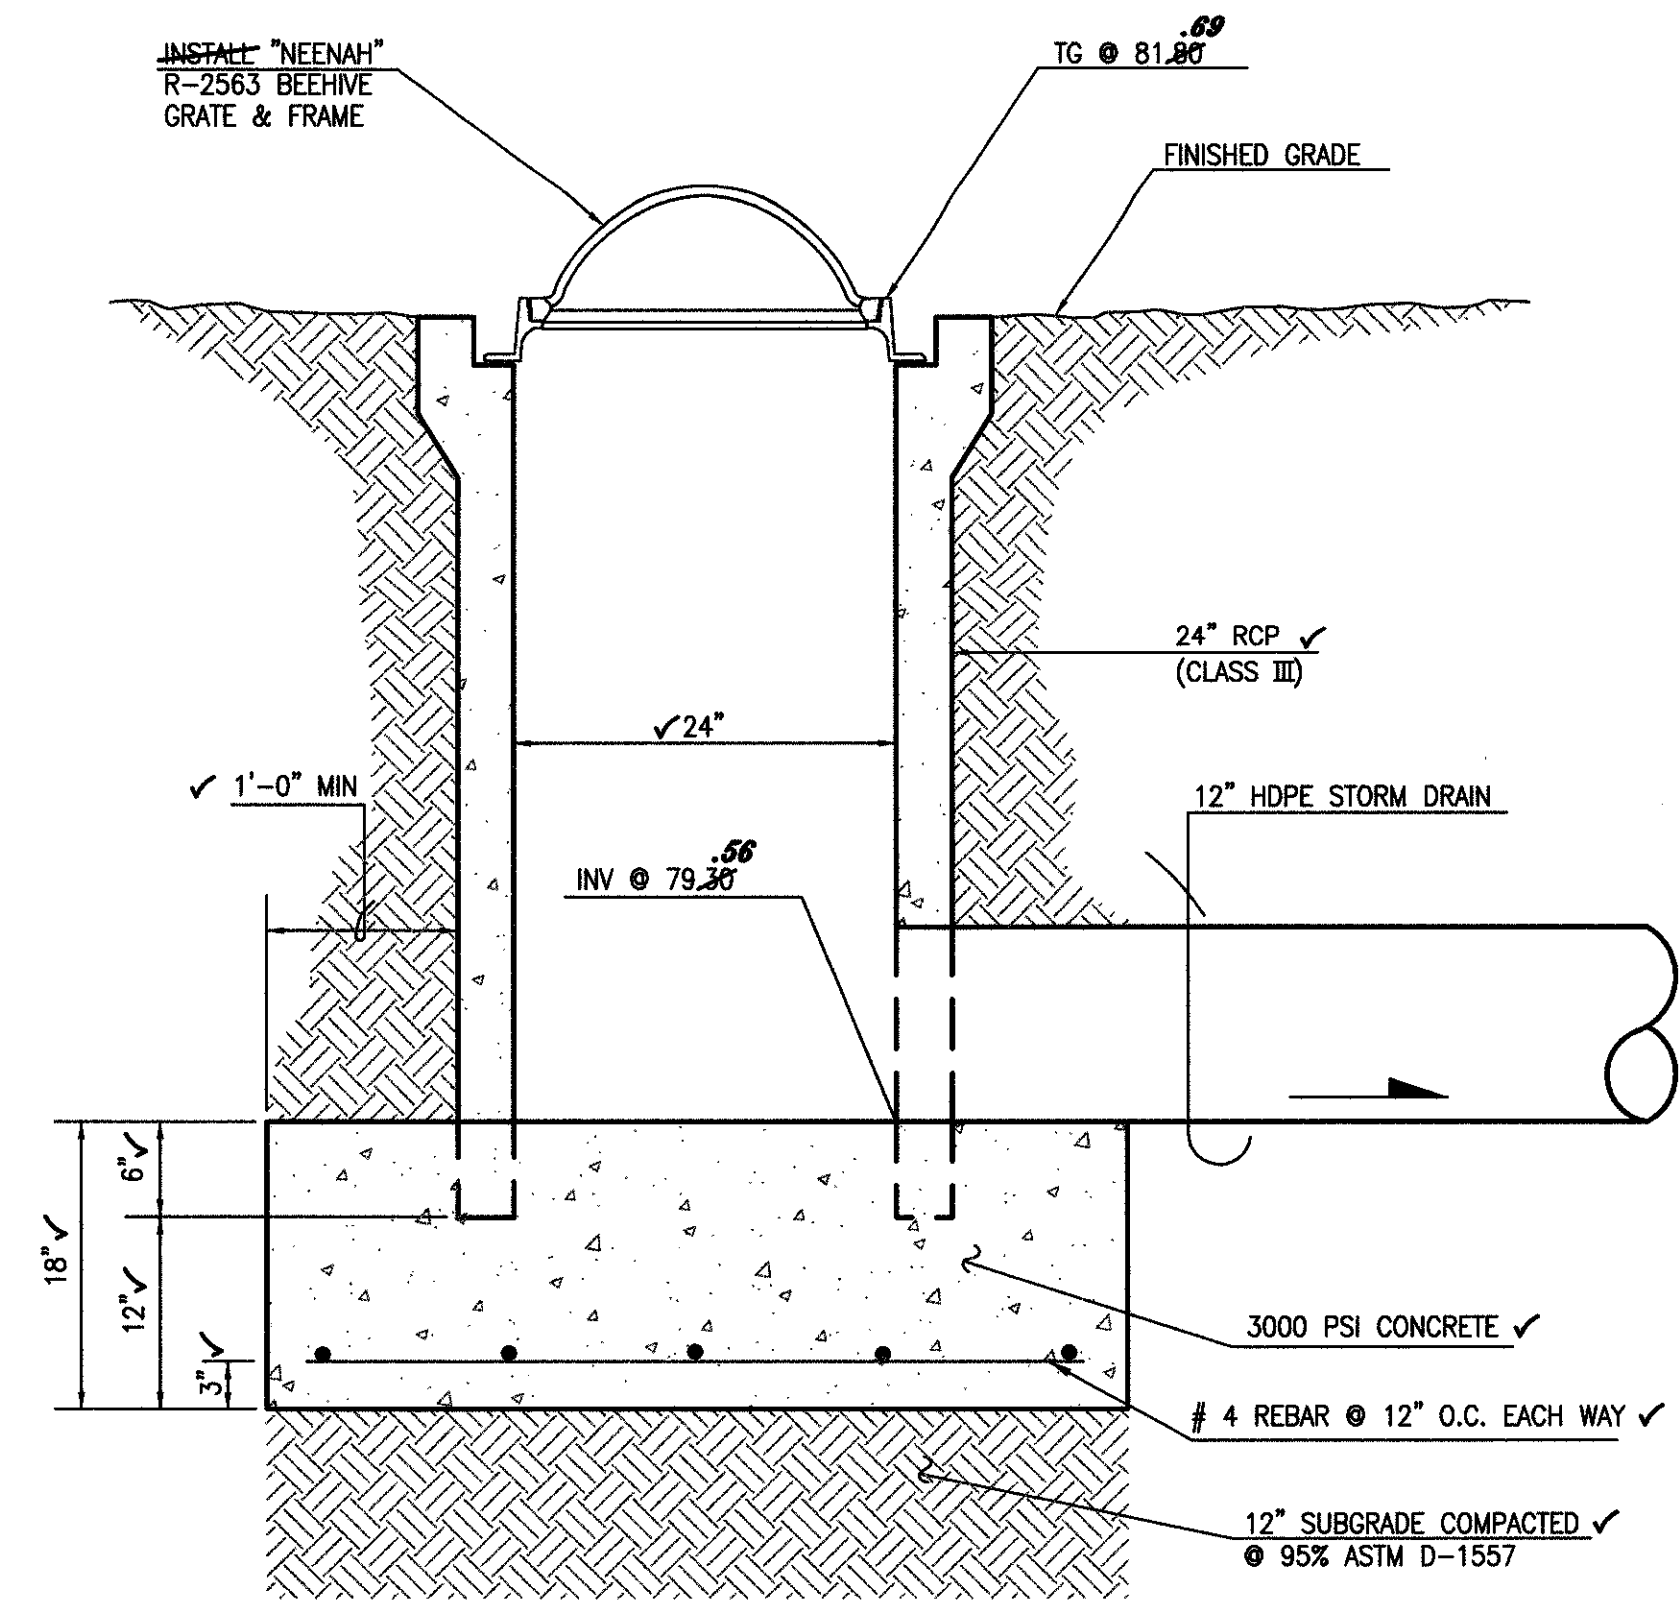


D5 BEEHIVE INLET SECTION
SCALE: 1" = 1'-0"

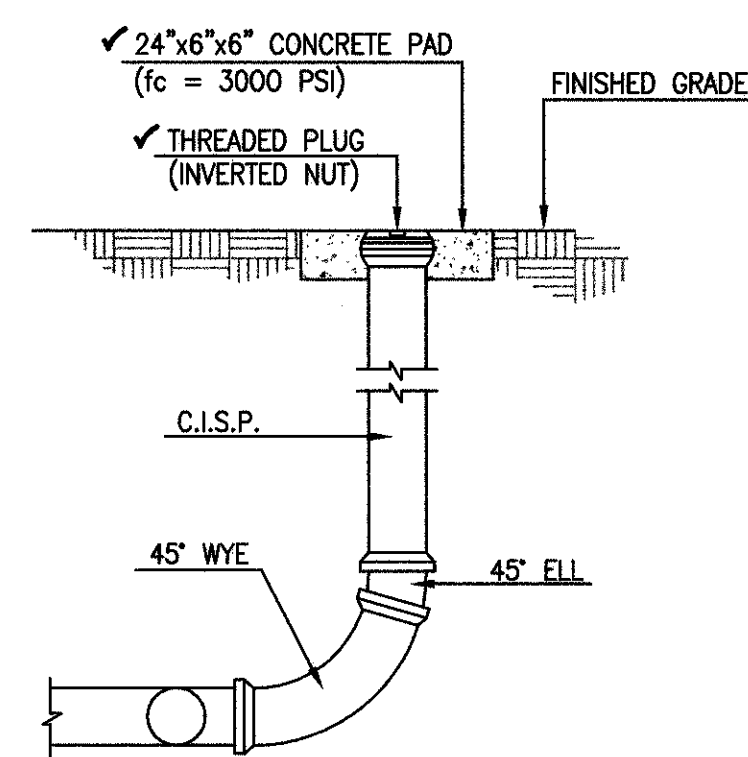

A1 TYPICAL SINGLE CLEANOUT SECTION
NOT TO SCALE

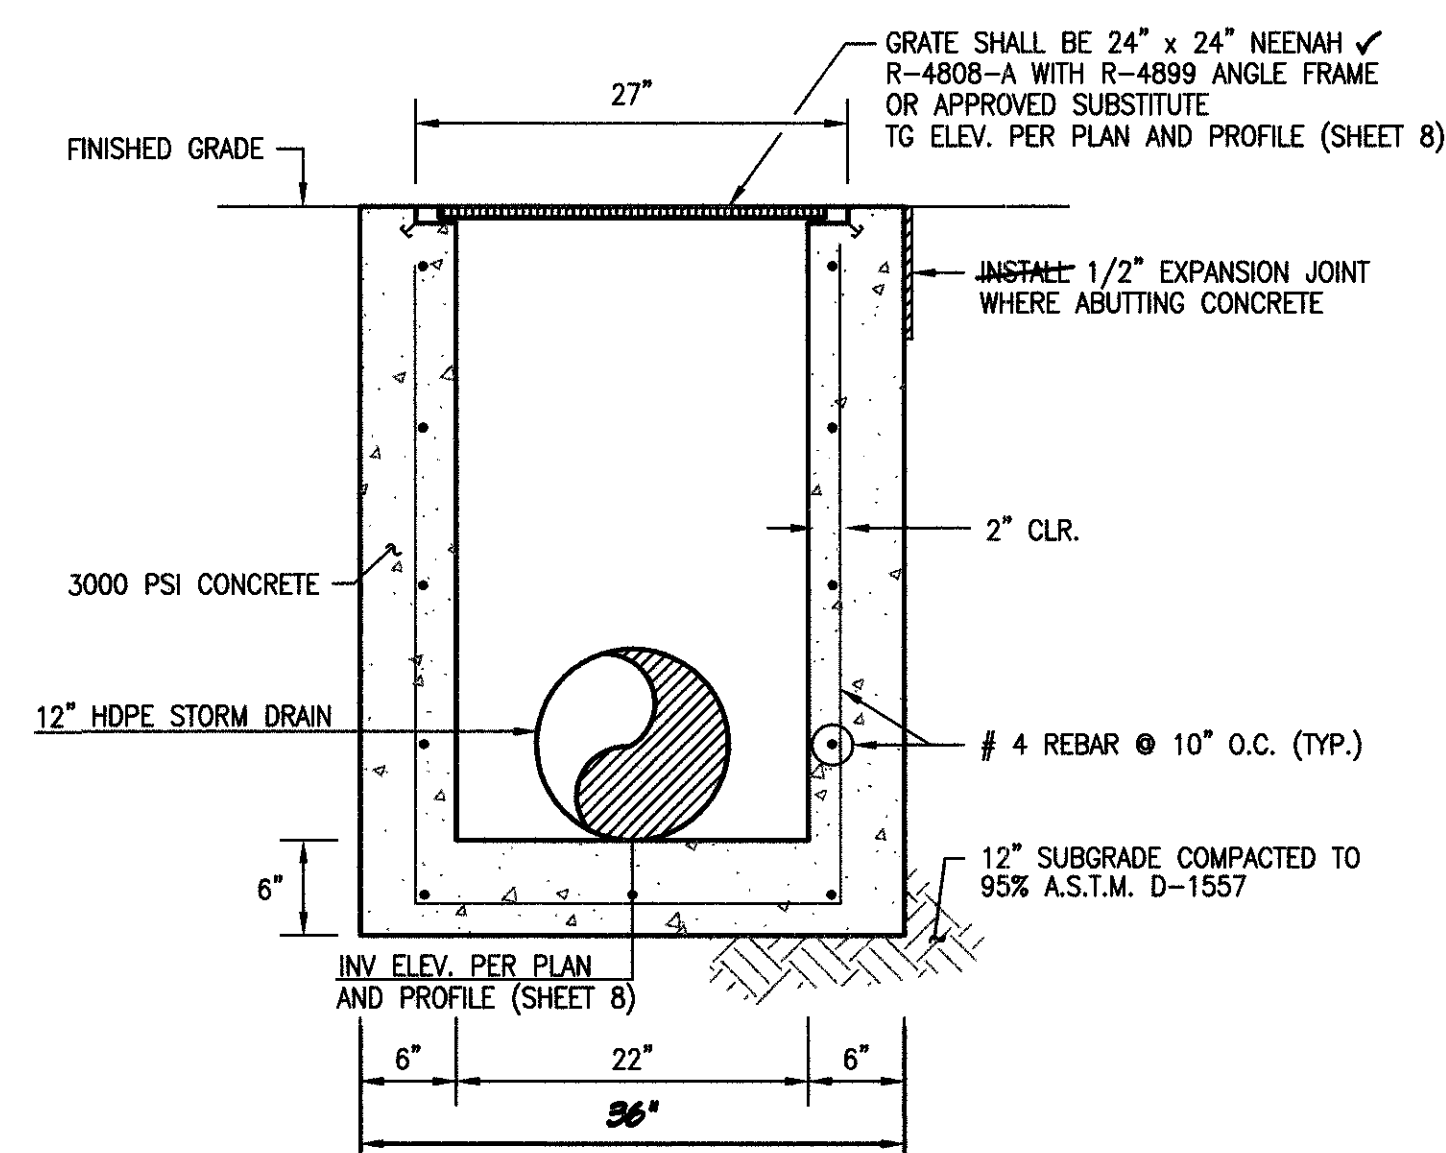


A3 TYPICAL 24"X24" STORM INLET SECTION
SCALE: 1" = 1'-0"

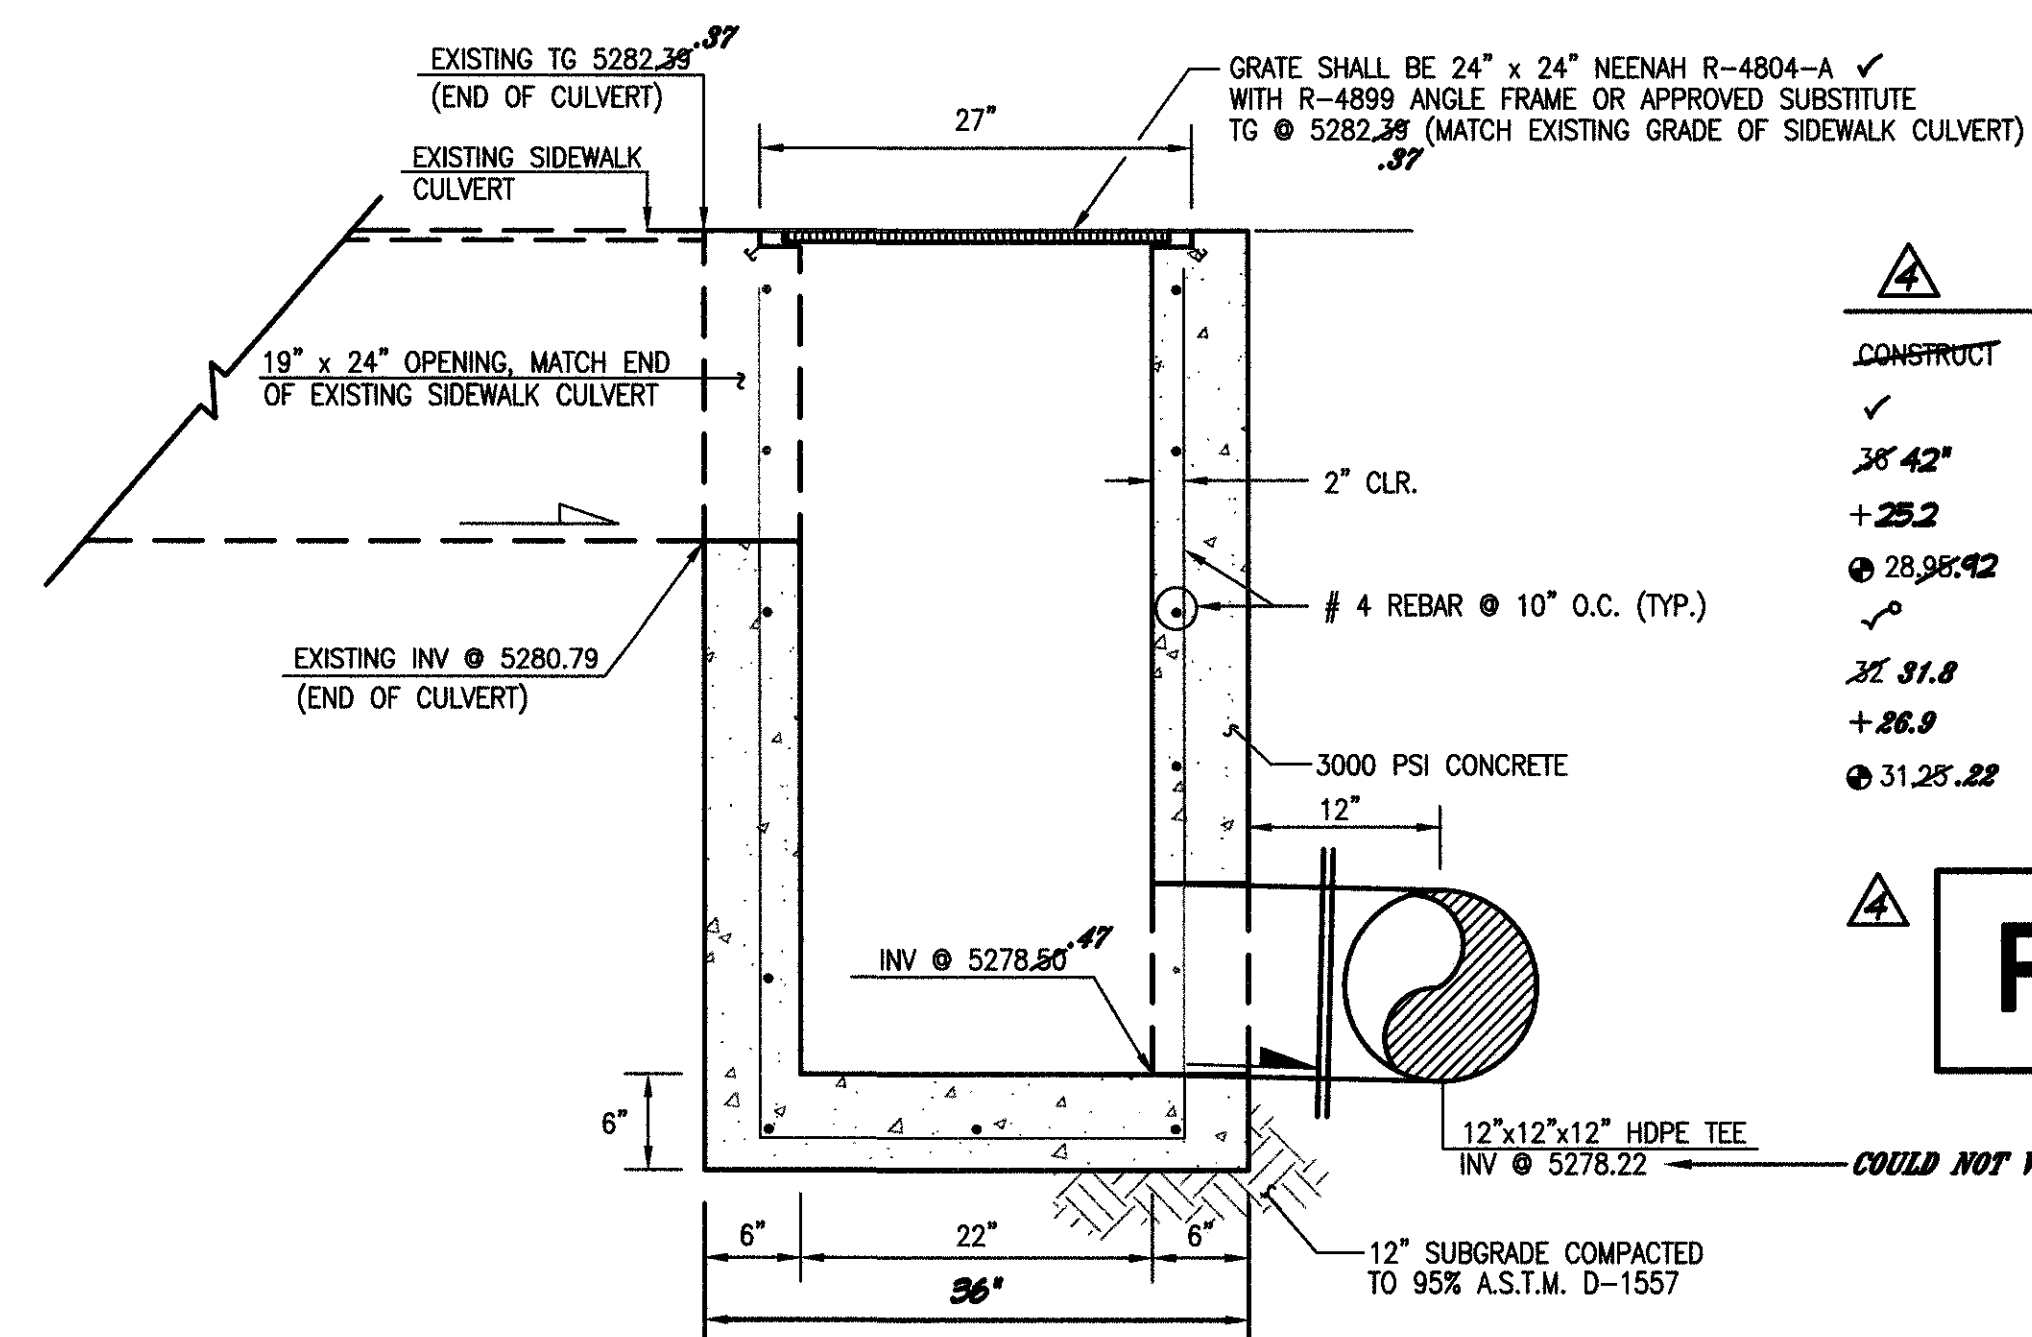

A5 24"X24" STORM INLET SECTION @ SIDEWALK CULVERT
SCALE: 1" = 1'-0"


CONSTRUCT	RECORD INFORMATION (VERIFIED BY ENGINEER)
✓	AS-CONSTRUCTED = AS-DESIGNED (VERIFIED BY ENGINEER)
38' 42"	RECORD INFORMATION (VERIFIED BY ENGINEER)
+25.2	RECORD INFORMATION (VERIFIED BY ENGINEER)
28.96' 42"	RECORD INFORMATION (VERIFIED BY ENGINEER)
✓	AS-CONSTRUCTED = AS-DESIGNED (VERIFIED BY AS-BUILT SURVEY)
31' 31.8"	RECORD INFORMATION FROM AS-BUILT SURVEY
+26.9	RECORD INFORMATION FROM AS-BUILT SURVEY
31.25' 22"	RECORD INFORMATION FROM AS-BUILT SURVEY

RECORD DRAWING

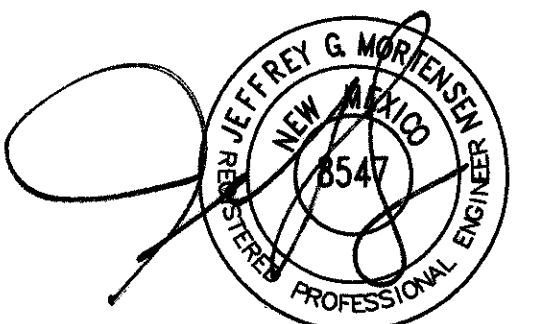

07.26.2011
04.05.2012

DESIGNED BY	DATE	BY	REVISIONS	JOB NO.
J.G.M./J.D.S.	02/12	B.E.E.	RECORD DRAWING	2010.183.1
DRAWN BY	DATE	BY	REVISIONS	JOB NO.
C.L.T./E.J.S.				07-2011
APPROVED BY	DATE	BY	REVISIONS	JOB NO.
J.G.M.				9 OF 1210

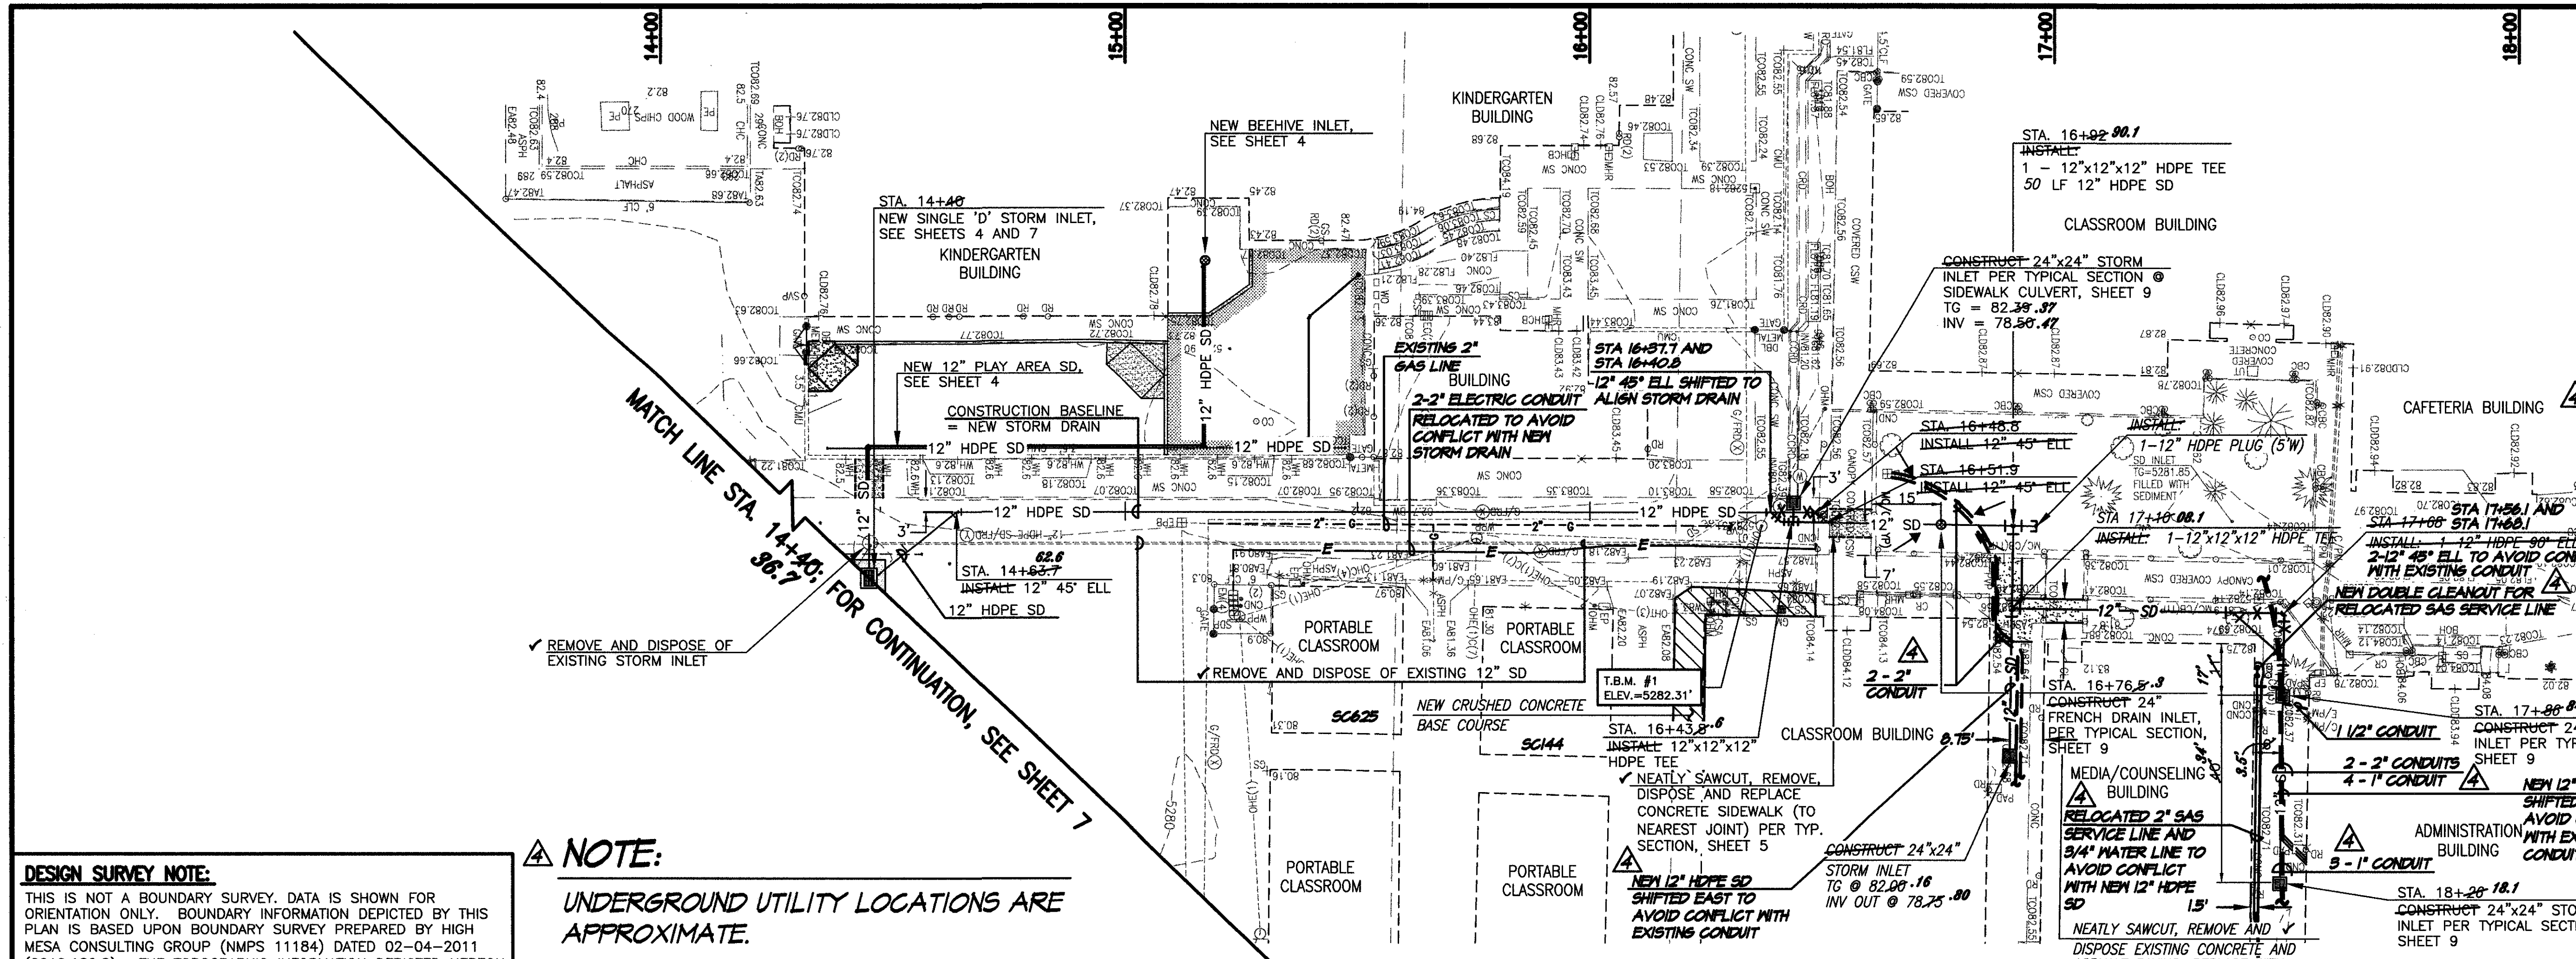

- STORM DRAIN NOTES:**
- ALL STORM DRAIN TO BE HIGH DENSITY POLYURETHANE PIPE (HDPE) UNLESS OTHERWISE NOTED.
 - ALL MANHOLES SHALL BE 6' DIAMETER TYPE 'C' PER C.O.A. STANDARD DRAWING 2101 UNLESS OTHERWISE NOTED.
 - ALL STATIONING SHOWN HEREON IS BASED ON PIPE CENTERLINE UNLESS OTHERWISE NOTED. SLOPES ARE BASED ON TRUE LENGTH OF PIPE.
 - THE CONTRACTOR SHALL BE RESPONSIBLE FOR SELECTING APPROPRIATE MEANS AND METHODS TO EXCAVATE AND TRENCH AND INSTALL PIPE SO AS TO NOT EXCEED RIGHT-OF-WAY OR EASEMENT LIMITS, AND SO AS NOT TO INTERFERE WITH OTHER UTILITIES. THIS SHALL BE CONSIDERED INCIDENTAL TO TRENCHING, THEREFORE, NO SEPARATE PAYMENT WILL BE MADE.
 - THE CONTRACTOR SHALL BE RESPONSIBLE FOR PROTECTING, SUPPORTING AND REPLACING, IF DAMAGED, ALL OTHER UTILITIES ENCOUNTERED DURING CONSTRUCTION. THIS SHALL BE CONSIDERED INCIDENTAL TO TRENCHING, THEREFORE, NO SEPARATE PAYMENT WILL BE MADE.

**RECORD DRAWING
FOR CERTIFICATION, SEE SHEET 1**


RECORD DRAWINGS LEGEND

CONSTRUCT	RECORD INFORMATION (VERIFIED BY ENGINEER)
✓	AS-CONSTRUCTED = AS-DESIGNED (VERIFIED BY ENGINEER)
38' 42"	RECORD INFORMATION (VERIFIED BY ENGINEER)
+25.2	RECORD INFORMATION (VERIFIED BY ENGINEER)
28.98' 42"	RECORD INFORMATION (VERIFIED BY ENGINEER)
✓	AS-CONSTRUCTED = AS-DESIGNED (VERIFIED BY AS-BUILT SURVEY)
31' 51.8"	RECORD INFORMATION FROM AS-BUILT SURVEY
+26.9	RECORD INFORMATION FROM AS-BUILT SURVEY
31.25' 22"	RECORD INFORMATION FROM AS-BUILT SURVEY

DESIGN SURVEY NOTE:
THIS IS NOT A BOUNDARY SURVEY. DATA IS SHOWN FOR ORIENTATION ONLY. BOUNDARY INFORMATION DEPICTED BY THIS PLAN IS BASED UPON BOUNDARY SURVEY PREPARED BY HIGH MESA CONSULTING GROUP (NMPS 11184) DATED 02-04-2011 (2010.182.8). THE TOPOGRAPHIC INFORMATION DEPICTED HEREON IS BASED UPON PARTIAL TOPOGRAPHIC AND UTILITY SURVEY PREPARED BY HIGH MESA CONSULTING GROUP (NMPS 11184) DATED 02-04-2011 (2010.182.8).


NOTE:
UNDERGROUND UTILITY LOCATIONS ARE APPROXIMATE.

PRIVATE STORM DRAIN EXTENSION

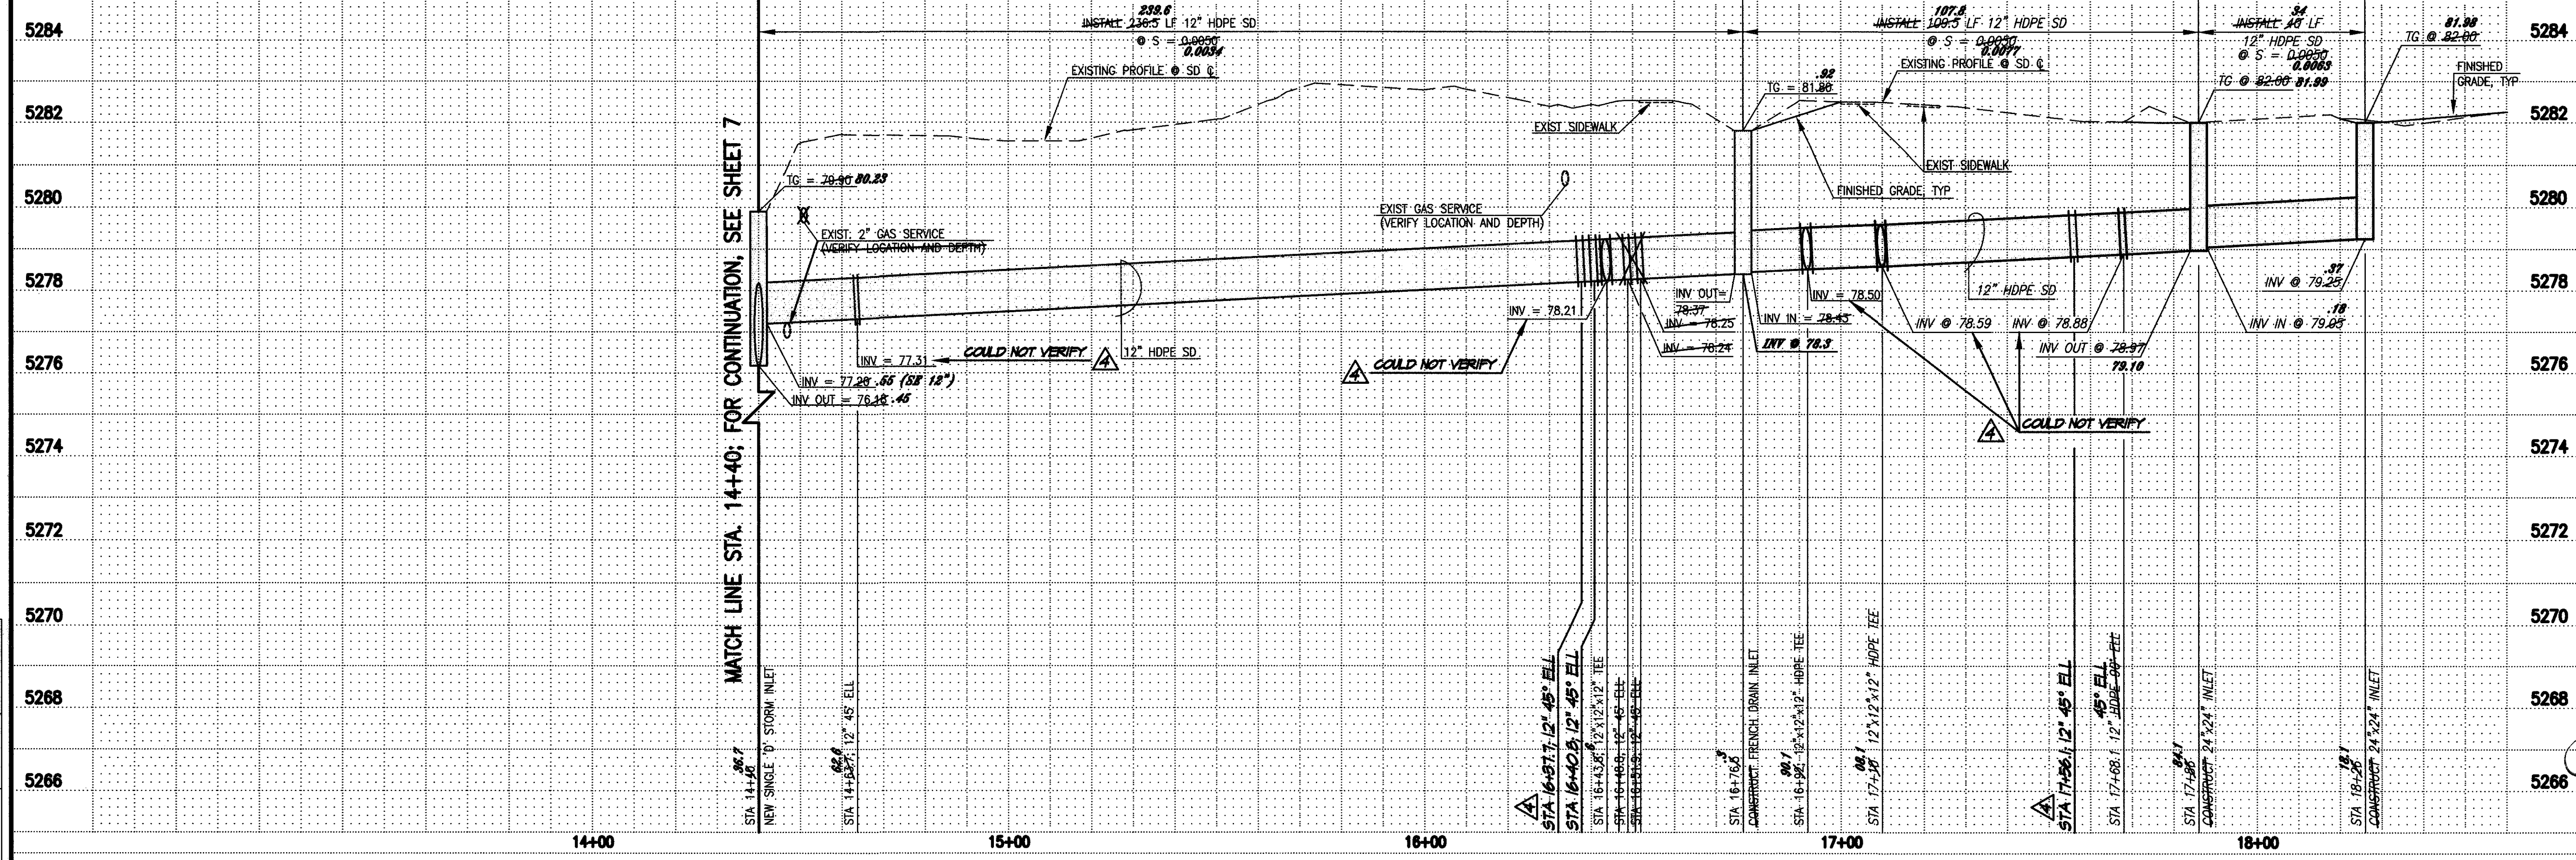

SCALE:
1" = 20' HORIZONTAL
1" = 2' VERTICAL


04-05-2012
07-25-2011
11-03-2011

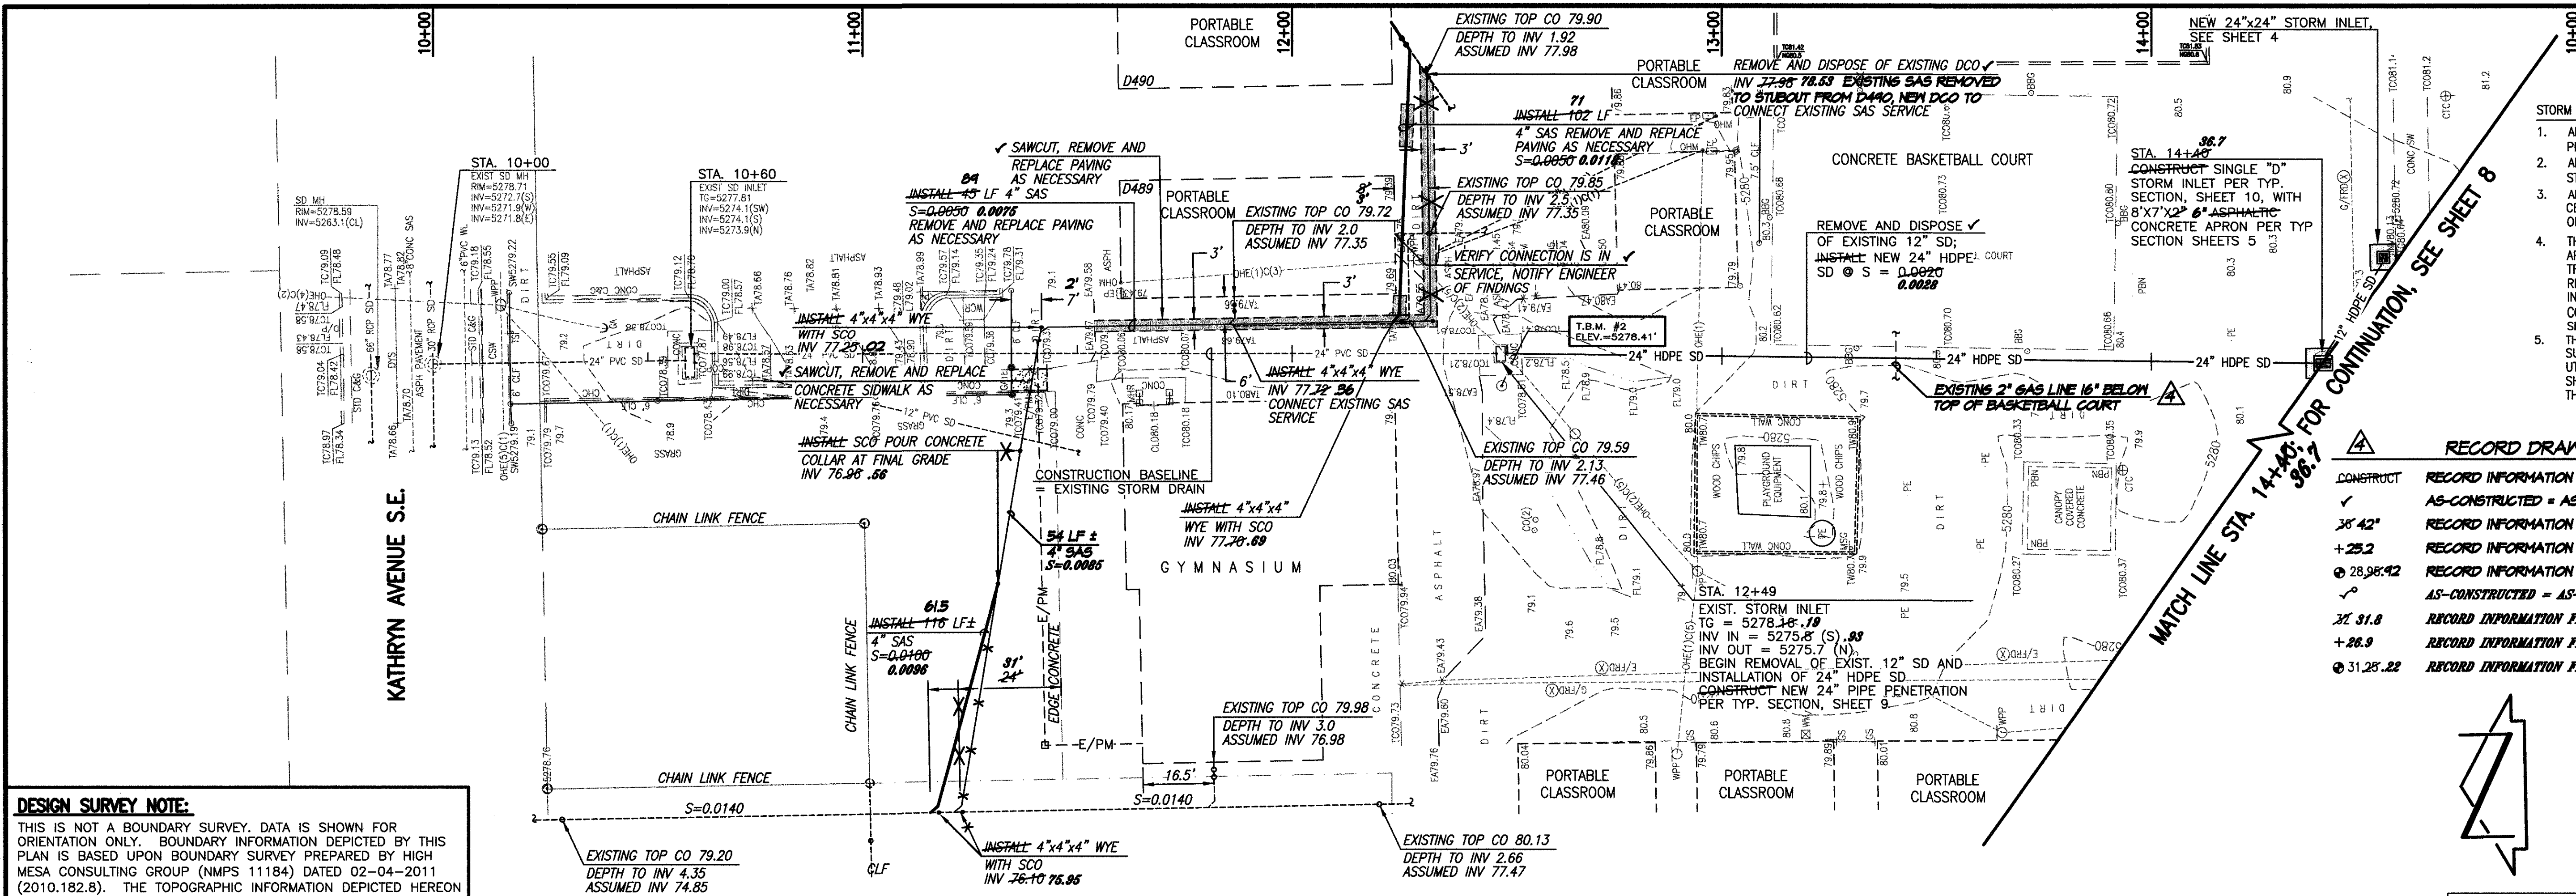

- STORM DRAIN NOTES:**
1. ALL STORM DRAIN TO BE HIGH DENSITY POLYURETHANE PIPE (HDPE) UNLESS OTHERWISE NOTED.
 2. ALL MANHOLES SHALL BE 6' DIAMETER TYPE 'C' PER C.O.A. STANDARD DRAWING 2101 UNLESS OTHERWISE NOTED.
 3. ALL STATIONING SHOWN HEREON IS BASED ON PIPE CENTERLINE UNLESS OTHERWISE NOTED. SLOPES ARE BASED ON TRUE LENGTH OF PIPE.
 4. THE CONTRACTOR SHALL BE RESPONSIBLE FOR SELECTING APPROPRIATE MEANS AND METHODS TO EXCAVATE AND TRENCH AND INSTALL PIPE SO AS TO NOT EXCEED RIGHT-OF-WAY OR EASEMENT LIMITS, AND SO AS NOT TO INTERFERE WITH OTHER UTILITIES. THIS SHALL BE CONSIDERED INCIDENTAL TO TRENCHING, THEREFORE, NO SEPARATE PAYMENT WILL BE MADE.
 5. THE CONTRACTOR SHALL BE RESPONSIBLE FOR PROTECTING, SUPPORTING AND REPLACING, IF DAMAGED, ALL OTHER UTILITIES ENCOUNTERED DURING CONSTRUCTION. THIS SHALL BE CONSIDERED INCIDENTAL TO TRENCHING, THEREFORE, NO SEPARATE PAYMENT WILL BE MADE.


RECORD DRAWING LEGEND

CONSTRUCT	RECORD INFORMATION (VERIFIED BY ENGINEER)
✓	AS-CONSTRUCTED = AS-DESIGNED (VERIFIED BY ENGINEER)
38' 42"	RECORD INFORMATION (VERIFIED BY ENGINEER)
+25.2	RECORD INFORMATION (VERIFIED BY ENGINEER)
28.98' 42"	RECORD INFORMATION (VERIFIED BY ENGINEER)
✓	AS-CONSTRUCTED = AS-DESIGNED (VERIFIED BY AS-BUILT SURVEY)
31' 51.8"	RECORD INFORMATION FROM AS-BUILT SURVEY
+26.9	RECORD INFORMATION FROM AS-BUILT SURVEY
31.28' 22"	RECORD INFORMATION FROM AS-BUILT SURVEY

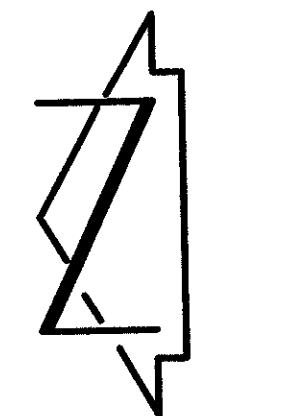

SCALE:
1" = 20' HORIZONTAL
1" = 2' VERTICAL



DESIGN SURVEY NOTE:
THIS IS NOT A BOUNDARY SURVEY. DATA IS SHOWN FOR ORIENTATION ONLY. BOUNDARY INFORMATION DEPICTED BY THIS PLAN IS BASED UPON BOUNDARY SURVEY PREPARED BY HIGH MESA CONSULTING GROUP (NMPS 11184) DATED 02-04-2011 (2010.182.8). THE TOPOGRAPHIC INFORMATION DEPICTED HEREON IS BASED UPON PARTIAL TOPOGRAPHIC AND UTILITY SURVEY PREPARED BY HIGH MESA CONSULTING GROUP (NMPS 11184) DATED 02-04-2011 (2010.182.8).

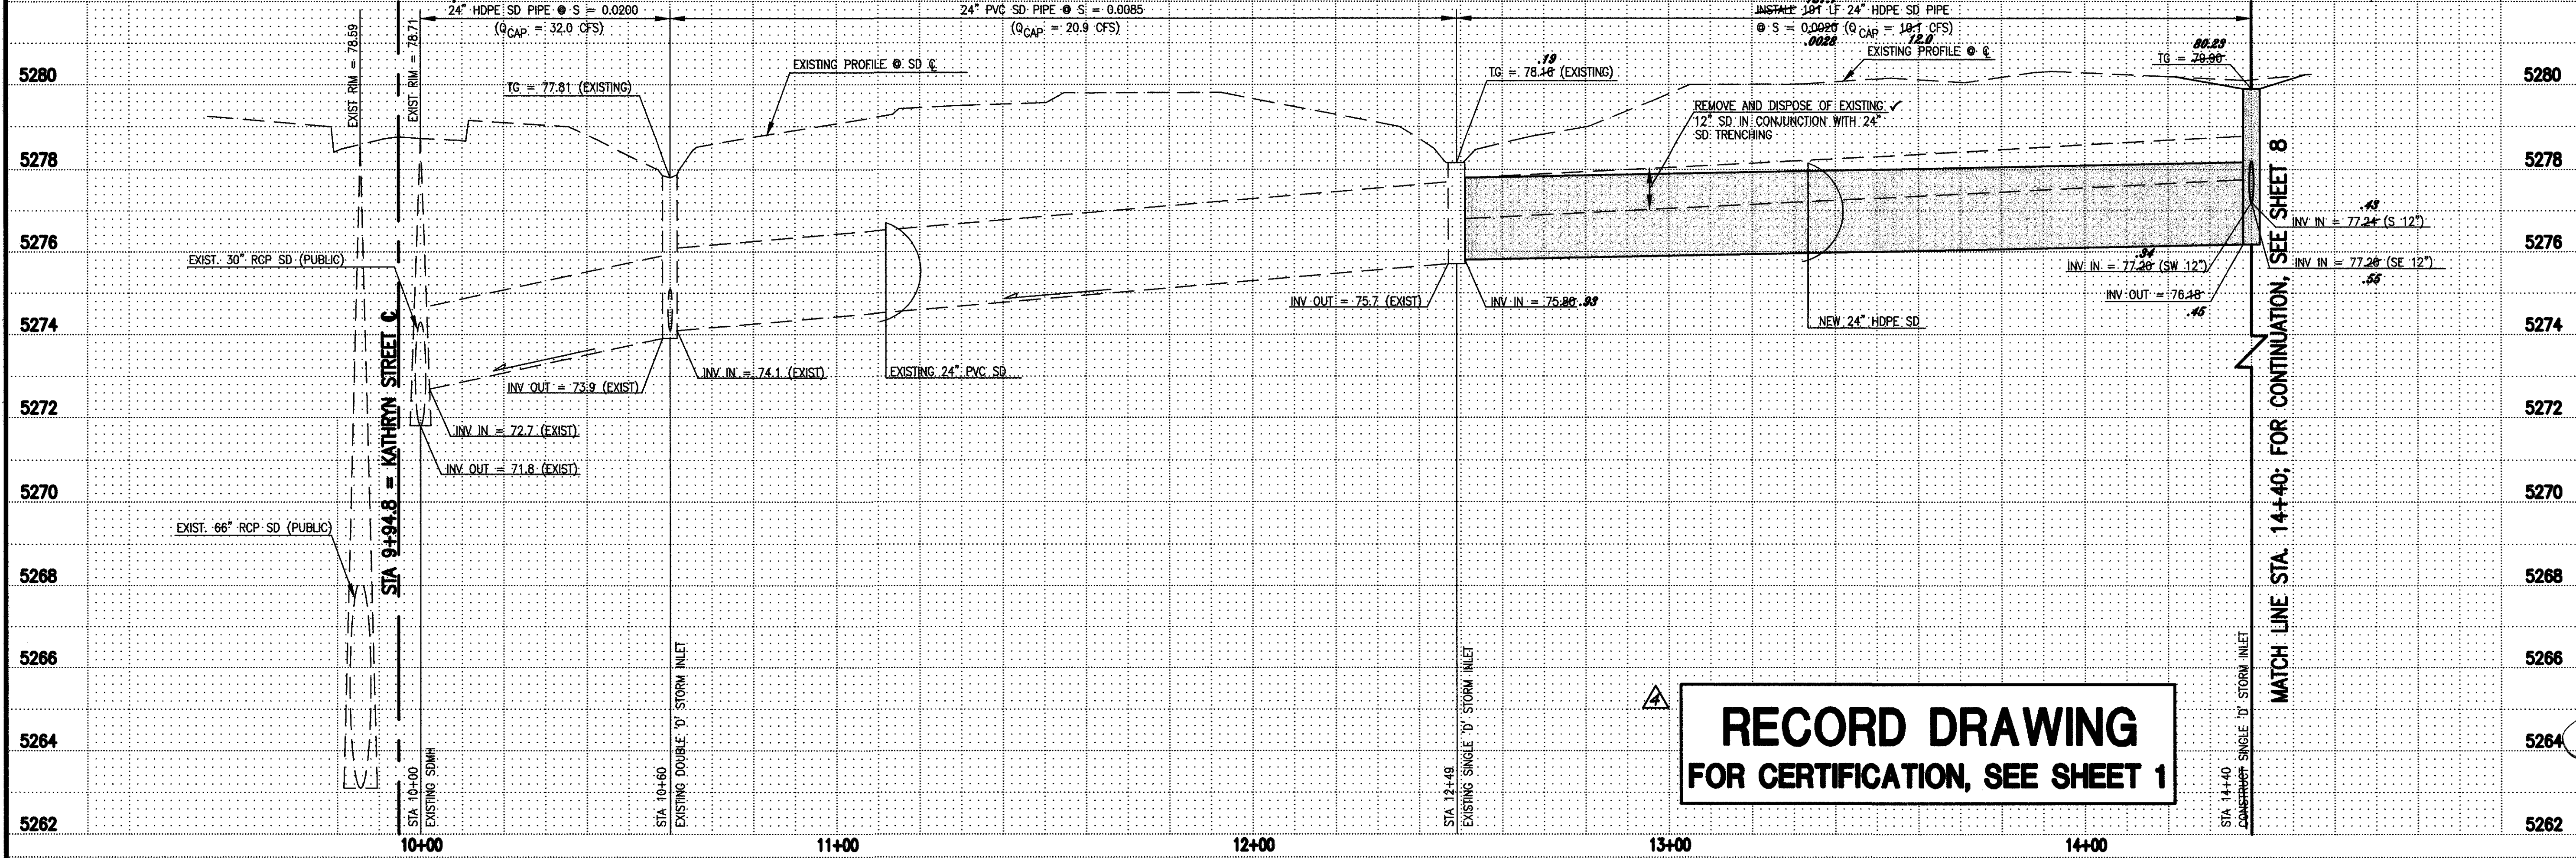

**RECORD DRAWING
FOR CERTIFICATION, SEE SHEET 1**


07-28-2011
11-30-2011
04-05-2012

File Path: P:\JUN2010\183.1\DWG\183.1.DWG
File Name: 101831-SH7AB.DWG
Plot Date: 04-02-2012
Plot Time: 07:19 am

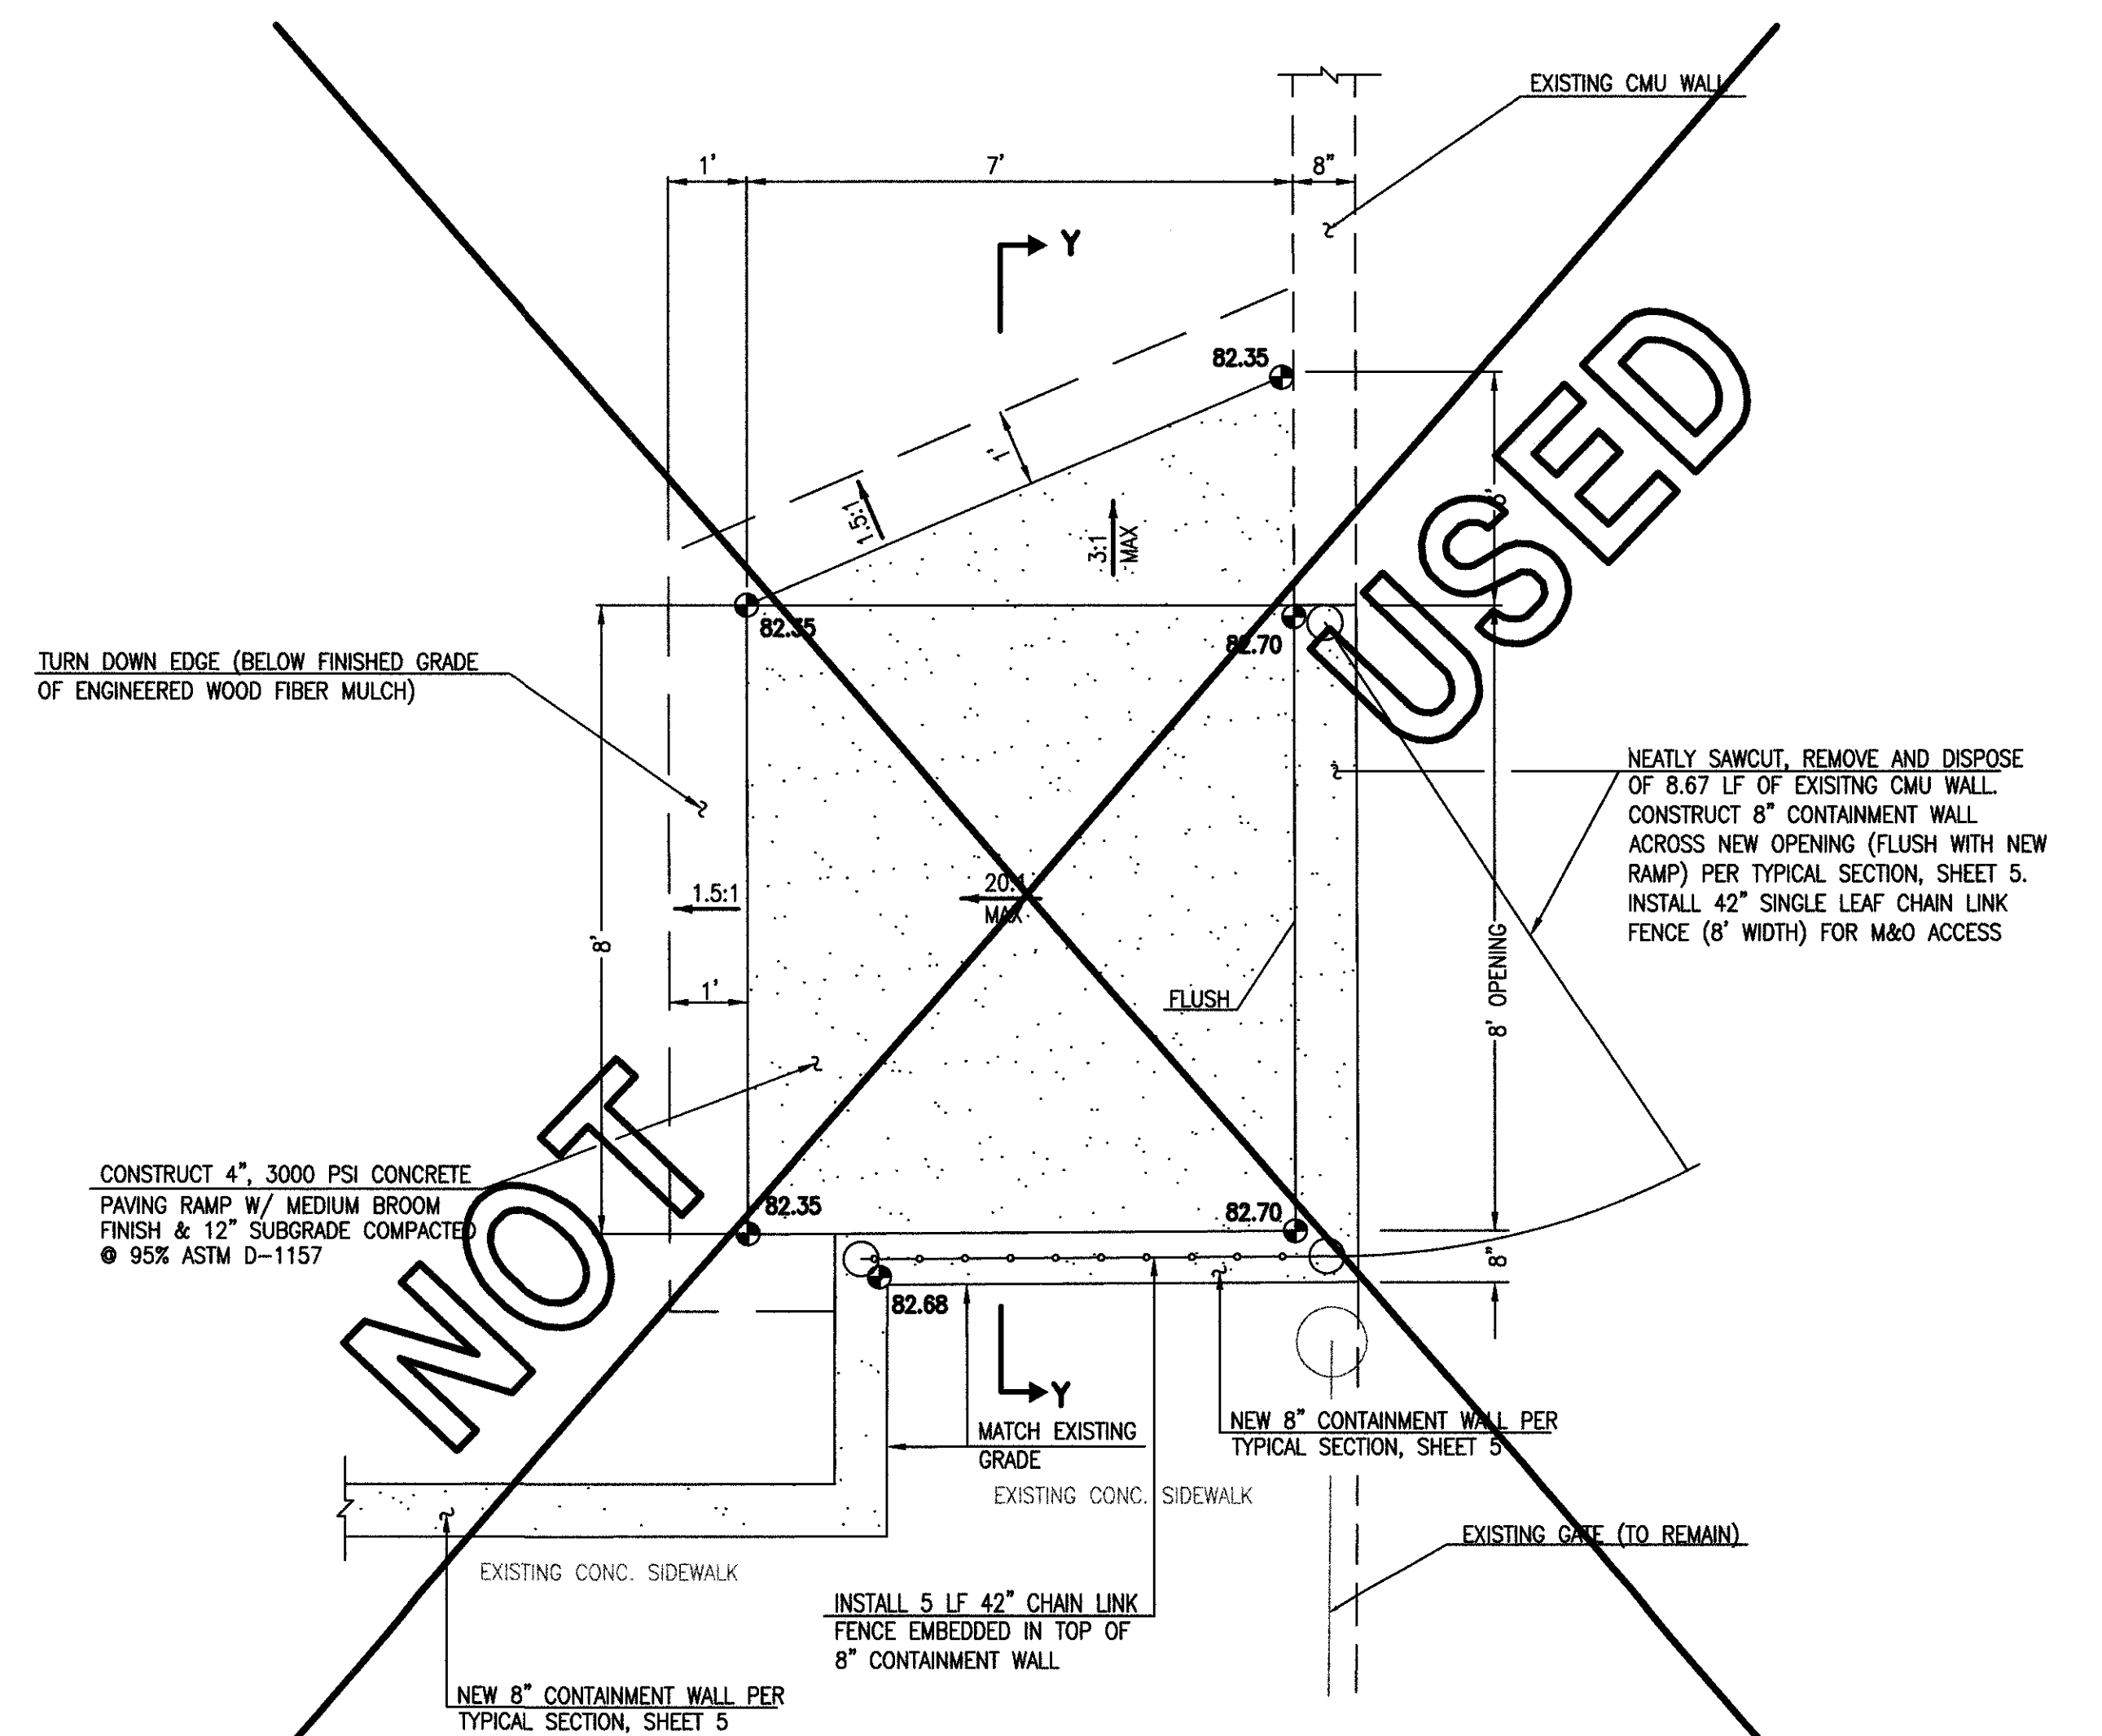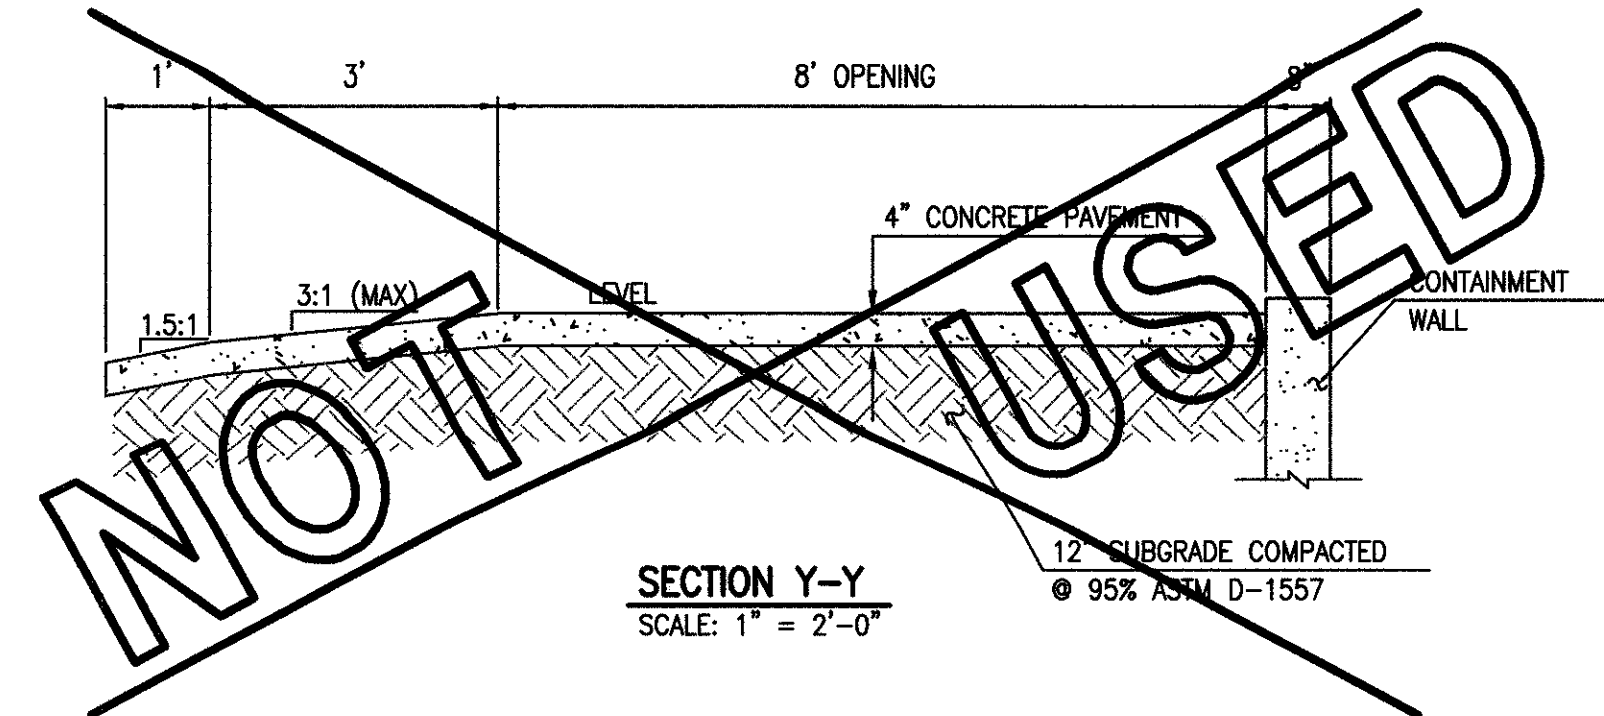


M&O ACCESS RAMP DETAIL
SCALE: 1" = 2'-0"
SEE SHEET 4 FOR ALTERNATE CONFIGURATION


RECORD DRAWING
FOR CERTIFICATION, SEE SHEET 1

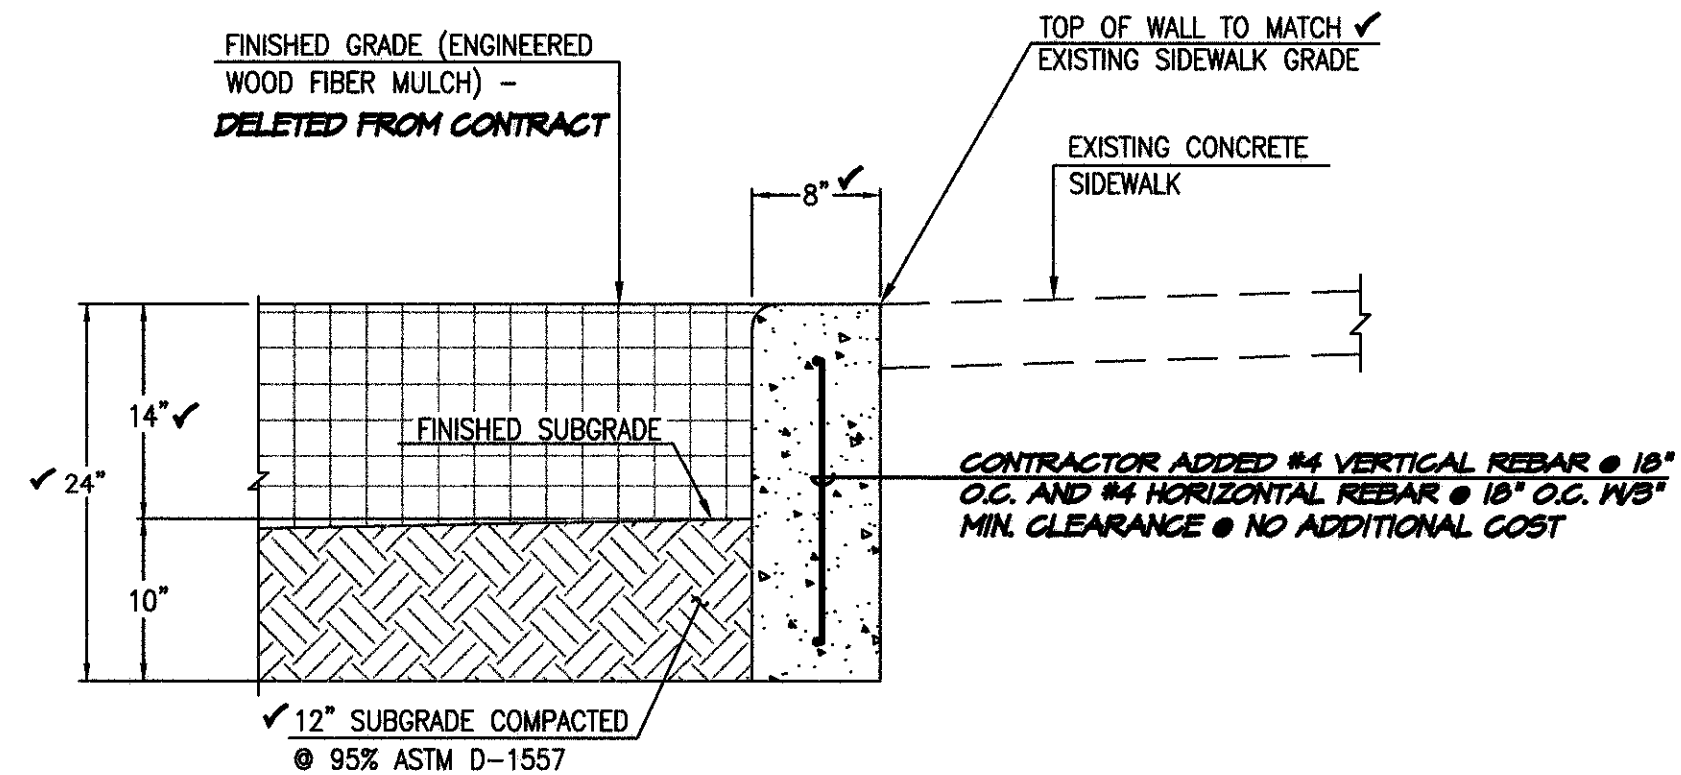


E1 TYPICAL CONTAINMENT WALL
SCALE: 1" = 1'-0"

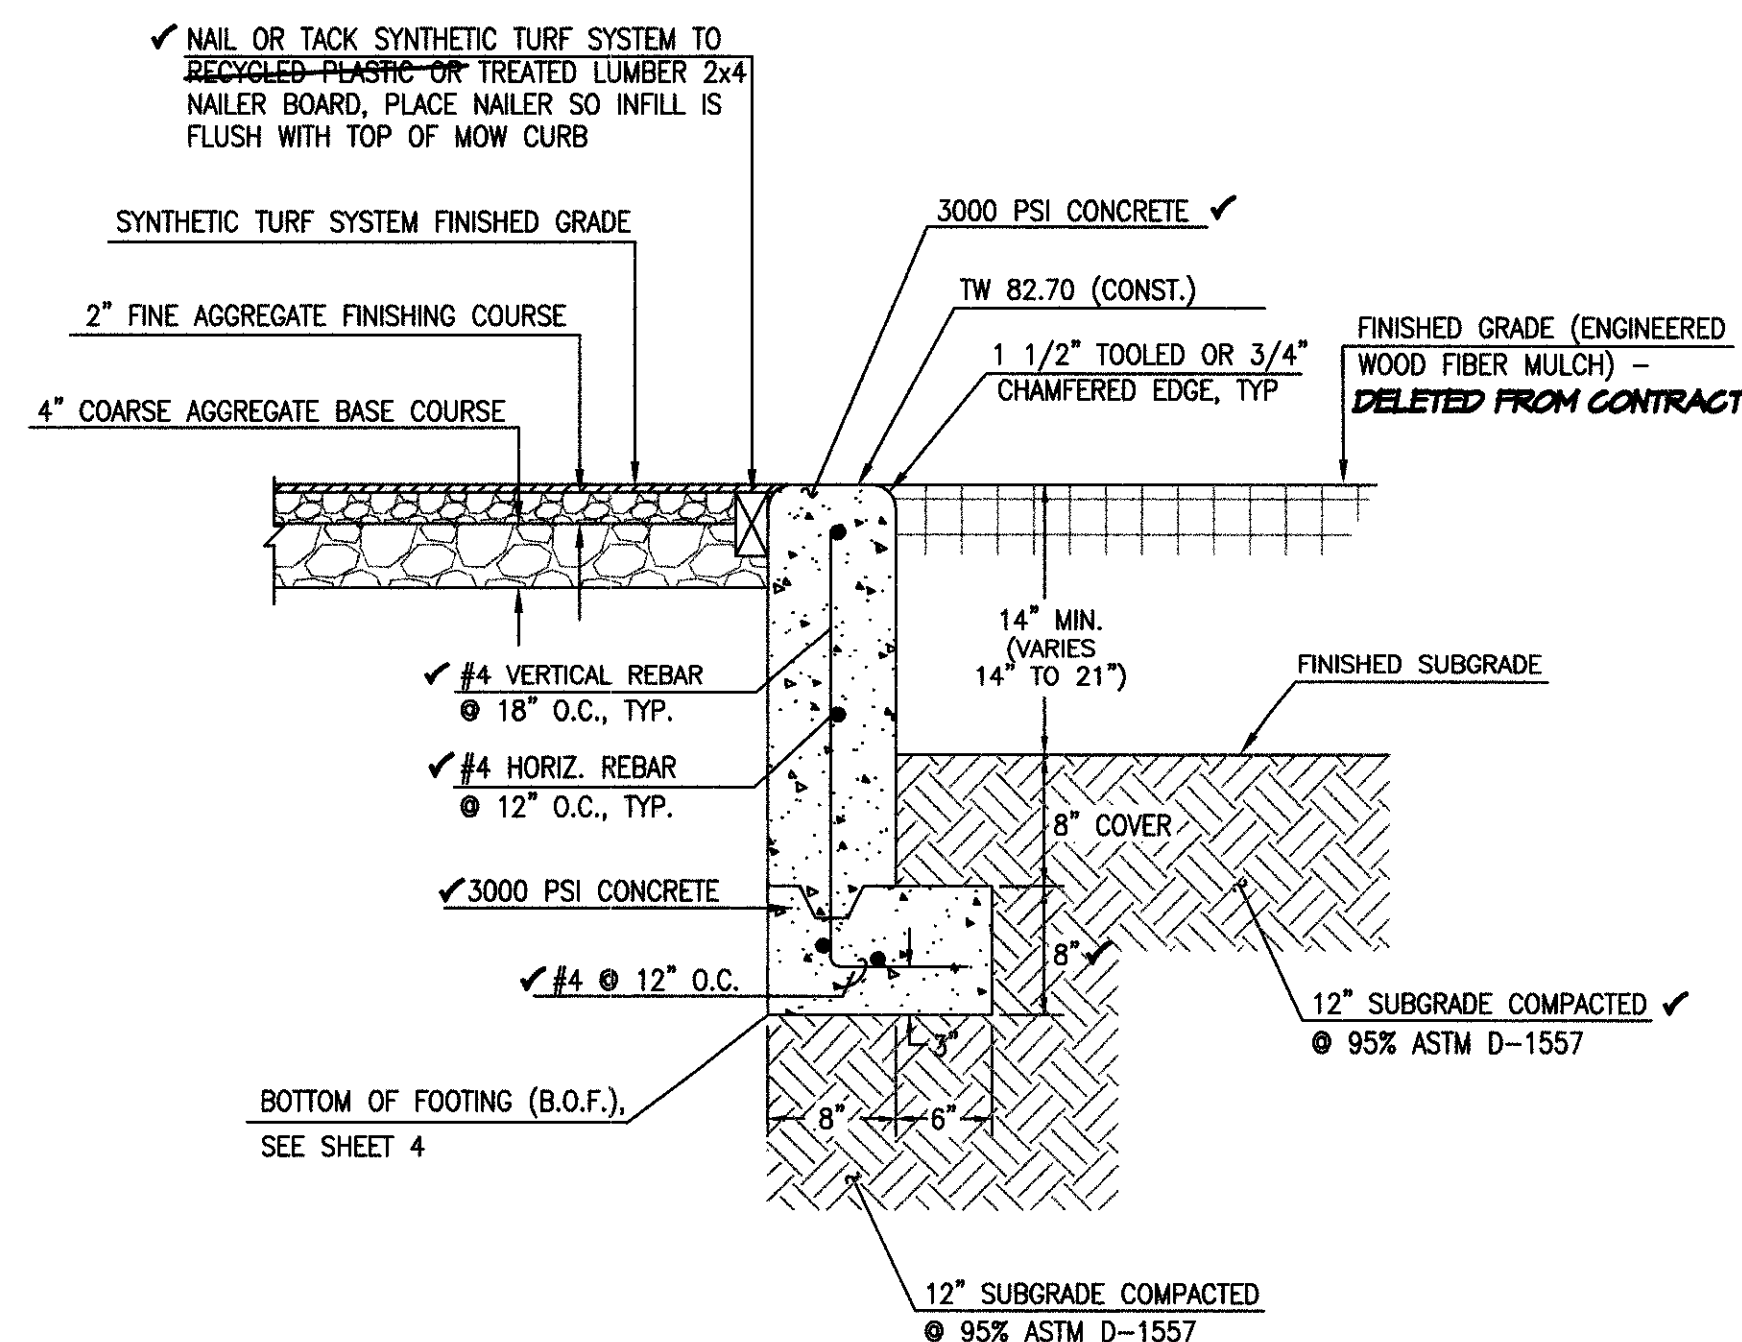

D4 TYPICAL CONTAINMENT WALL WITH FOOTING
SCALE: 1" = 1'-0"

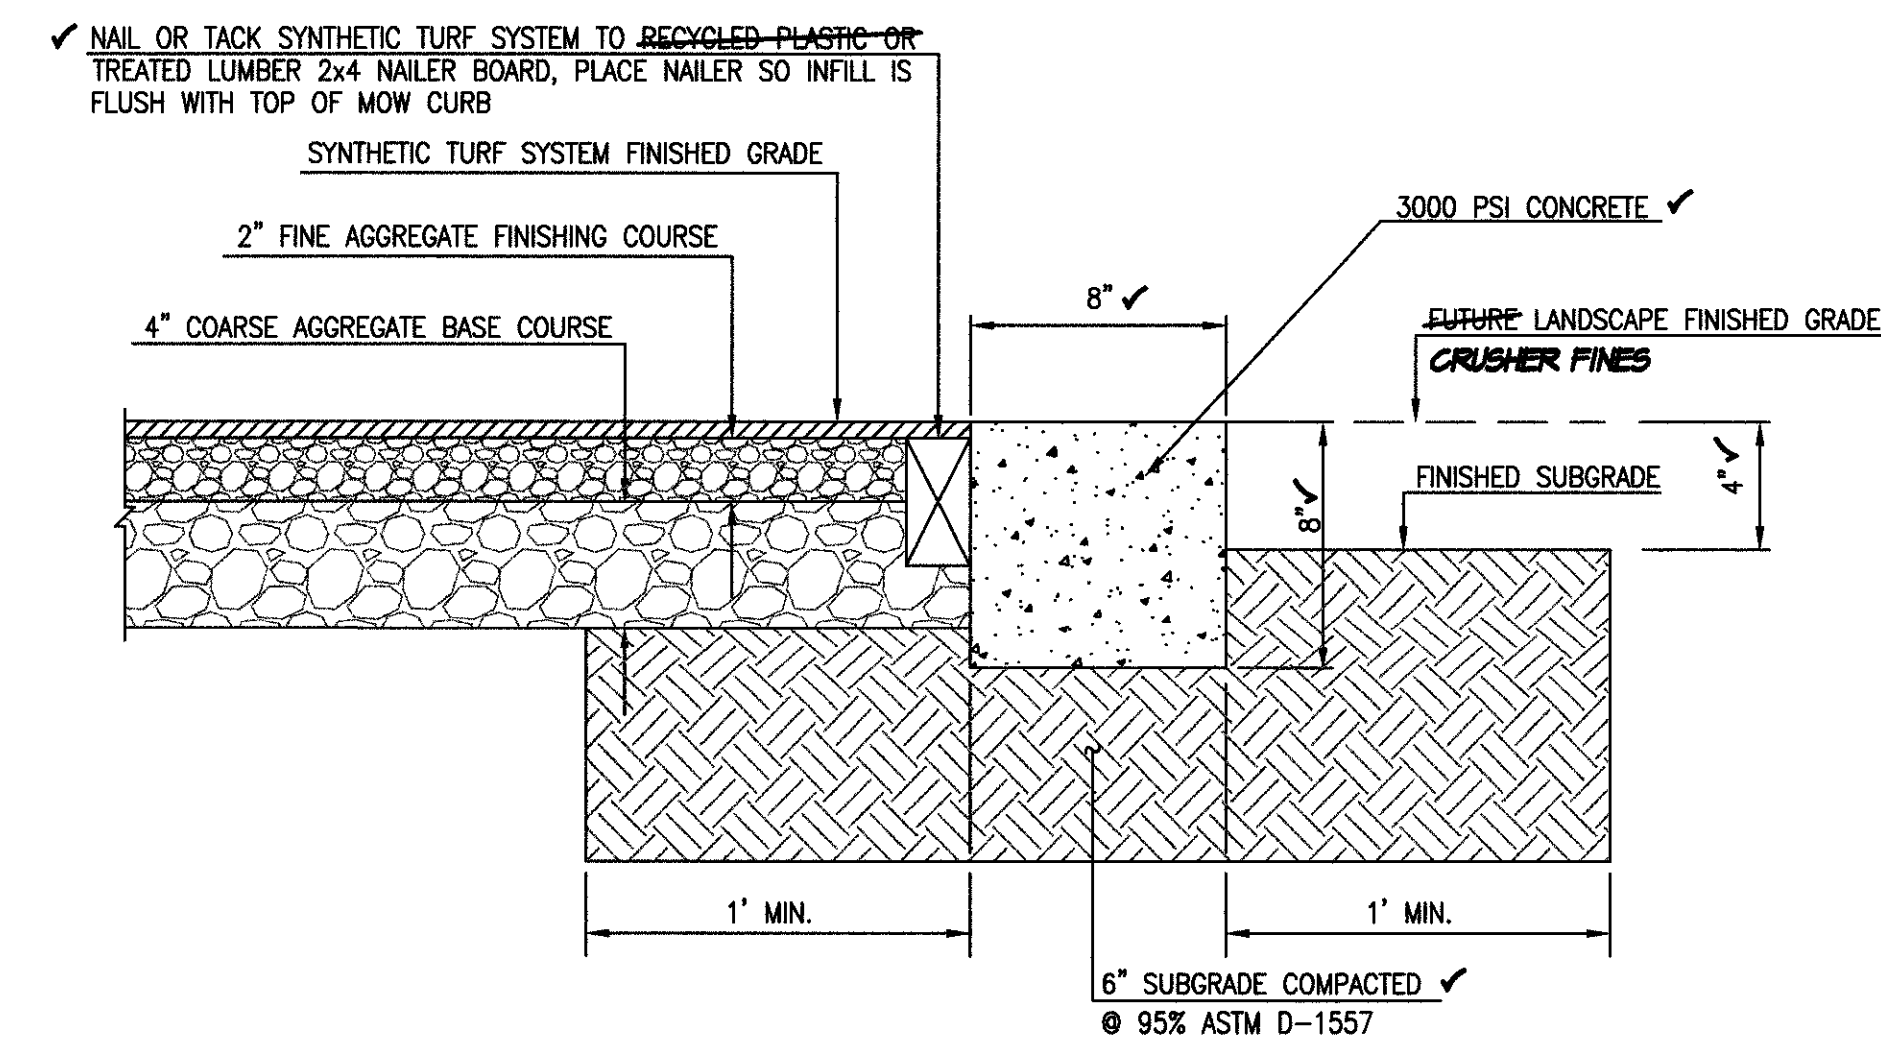


E5 TYPICAL MOW CURB SECTION
SCALE: 1" = 0'-6"

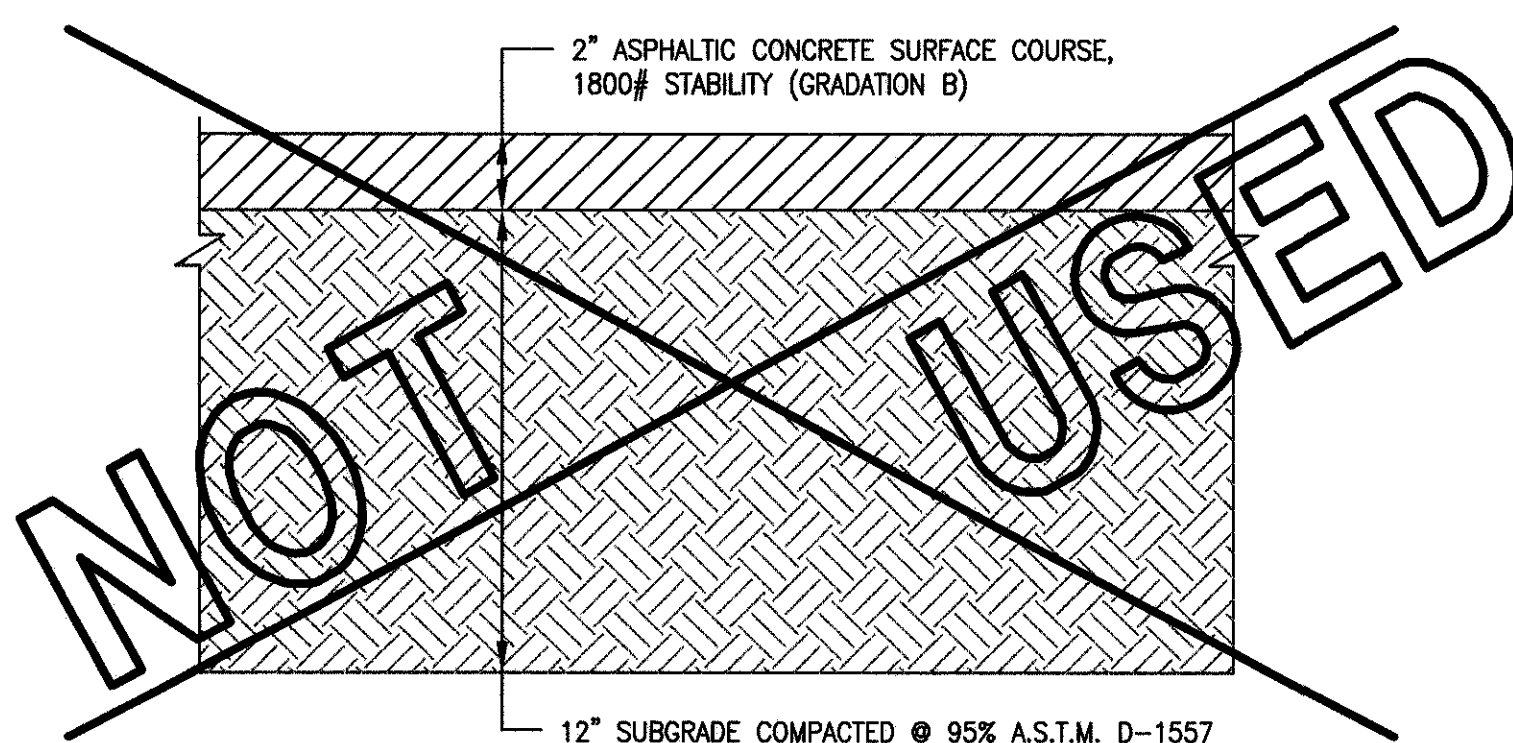


C1 TYPICAL ASPHALTIC CONCRETE APRON SECTION
SCALE: 1" = 0'-5"


RECORD DRAWING LEGEND	
CONSTRUCT	RECORD INFORMATION (VERIFIED BY ENGINEER)
✓	AS-CONSTRUCTED = AS-DESIGNED (VERIFIED BY ENGINEER)
38' 42"	RECORD INFORMATION (VERIFIED BY ENGINEER)
+25.2	RECORD INFORMATION (VERIFIED BY ENGINEER)
28.98' 42"	RECORD INFORMATION (VERIFIED BY ENGINEER)
✓	AS-CONSTRUCTED = AS-DESIGNED (VERIFIED BY AS-BUILT SURVEY)
31' 91.8"	RECORD INFORMATION FROM AS-BUILT SURVEY
+26.9	RECORD INFORMATION FROM AS-BUILT SURVEY
31.25' 22"	RECORD INFORMATION FROM AS-BUILT SURVEY

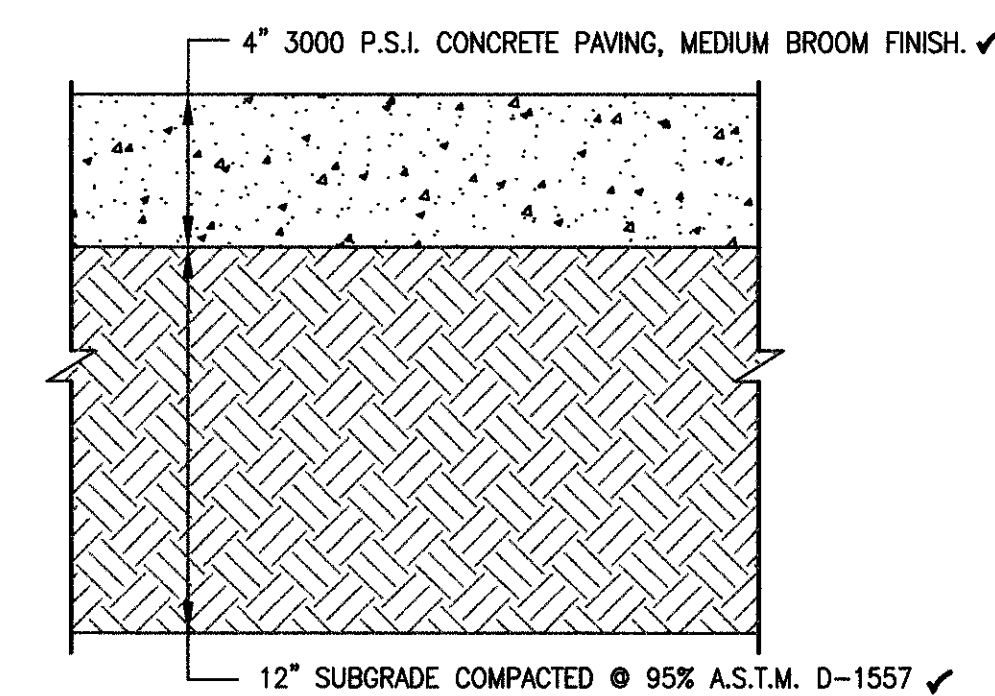

C5 TYPICAL CONCRETE SIDEWALK SECTION
SCALE: 1" = 0'-6"

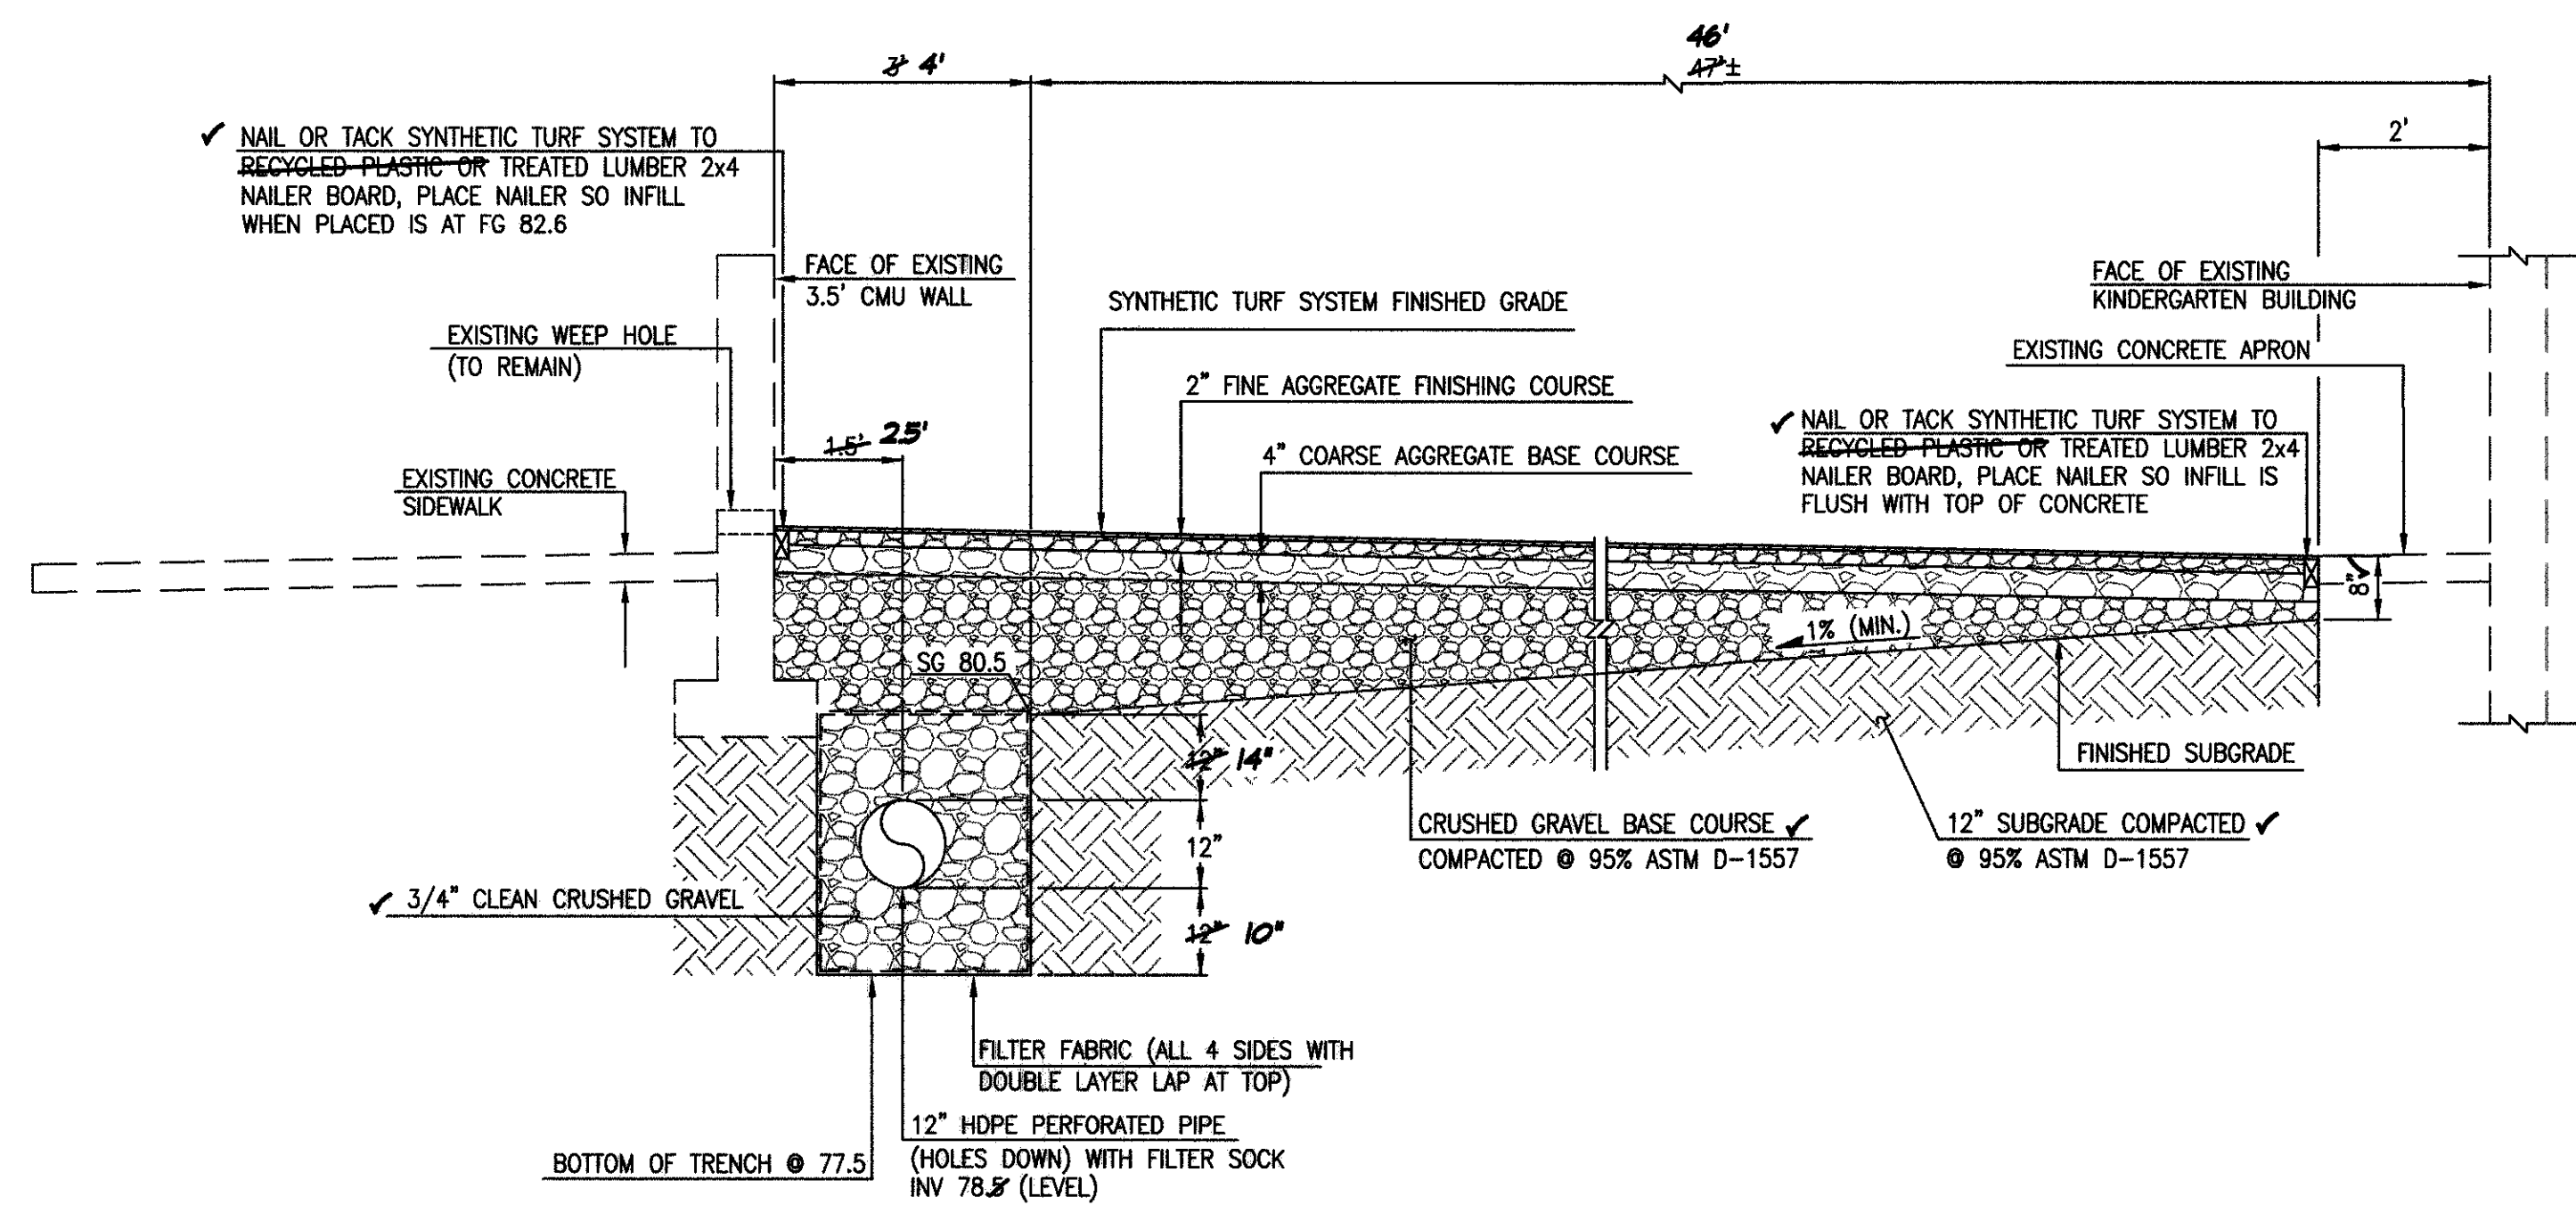

B2 SECTION A-A
SCALE: 1" = 2'-0"

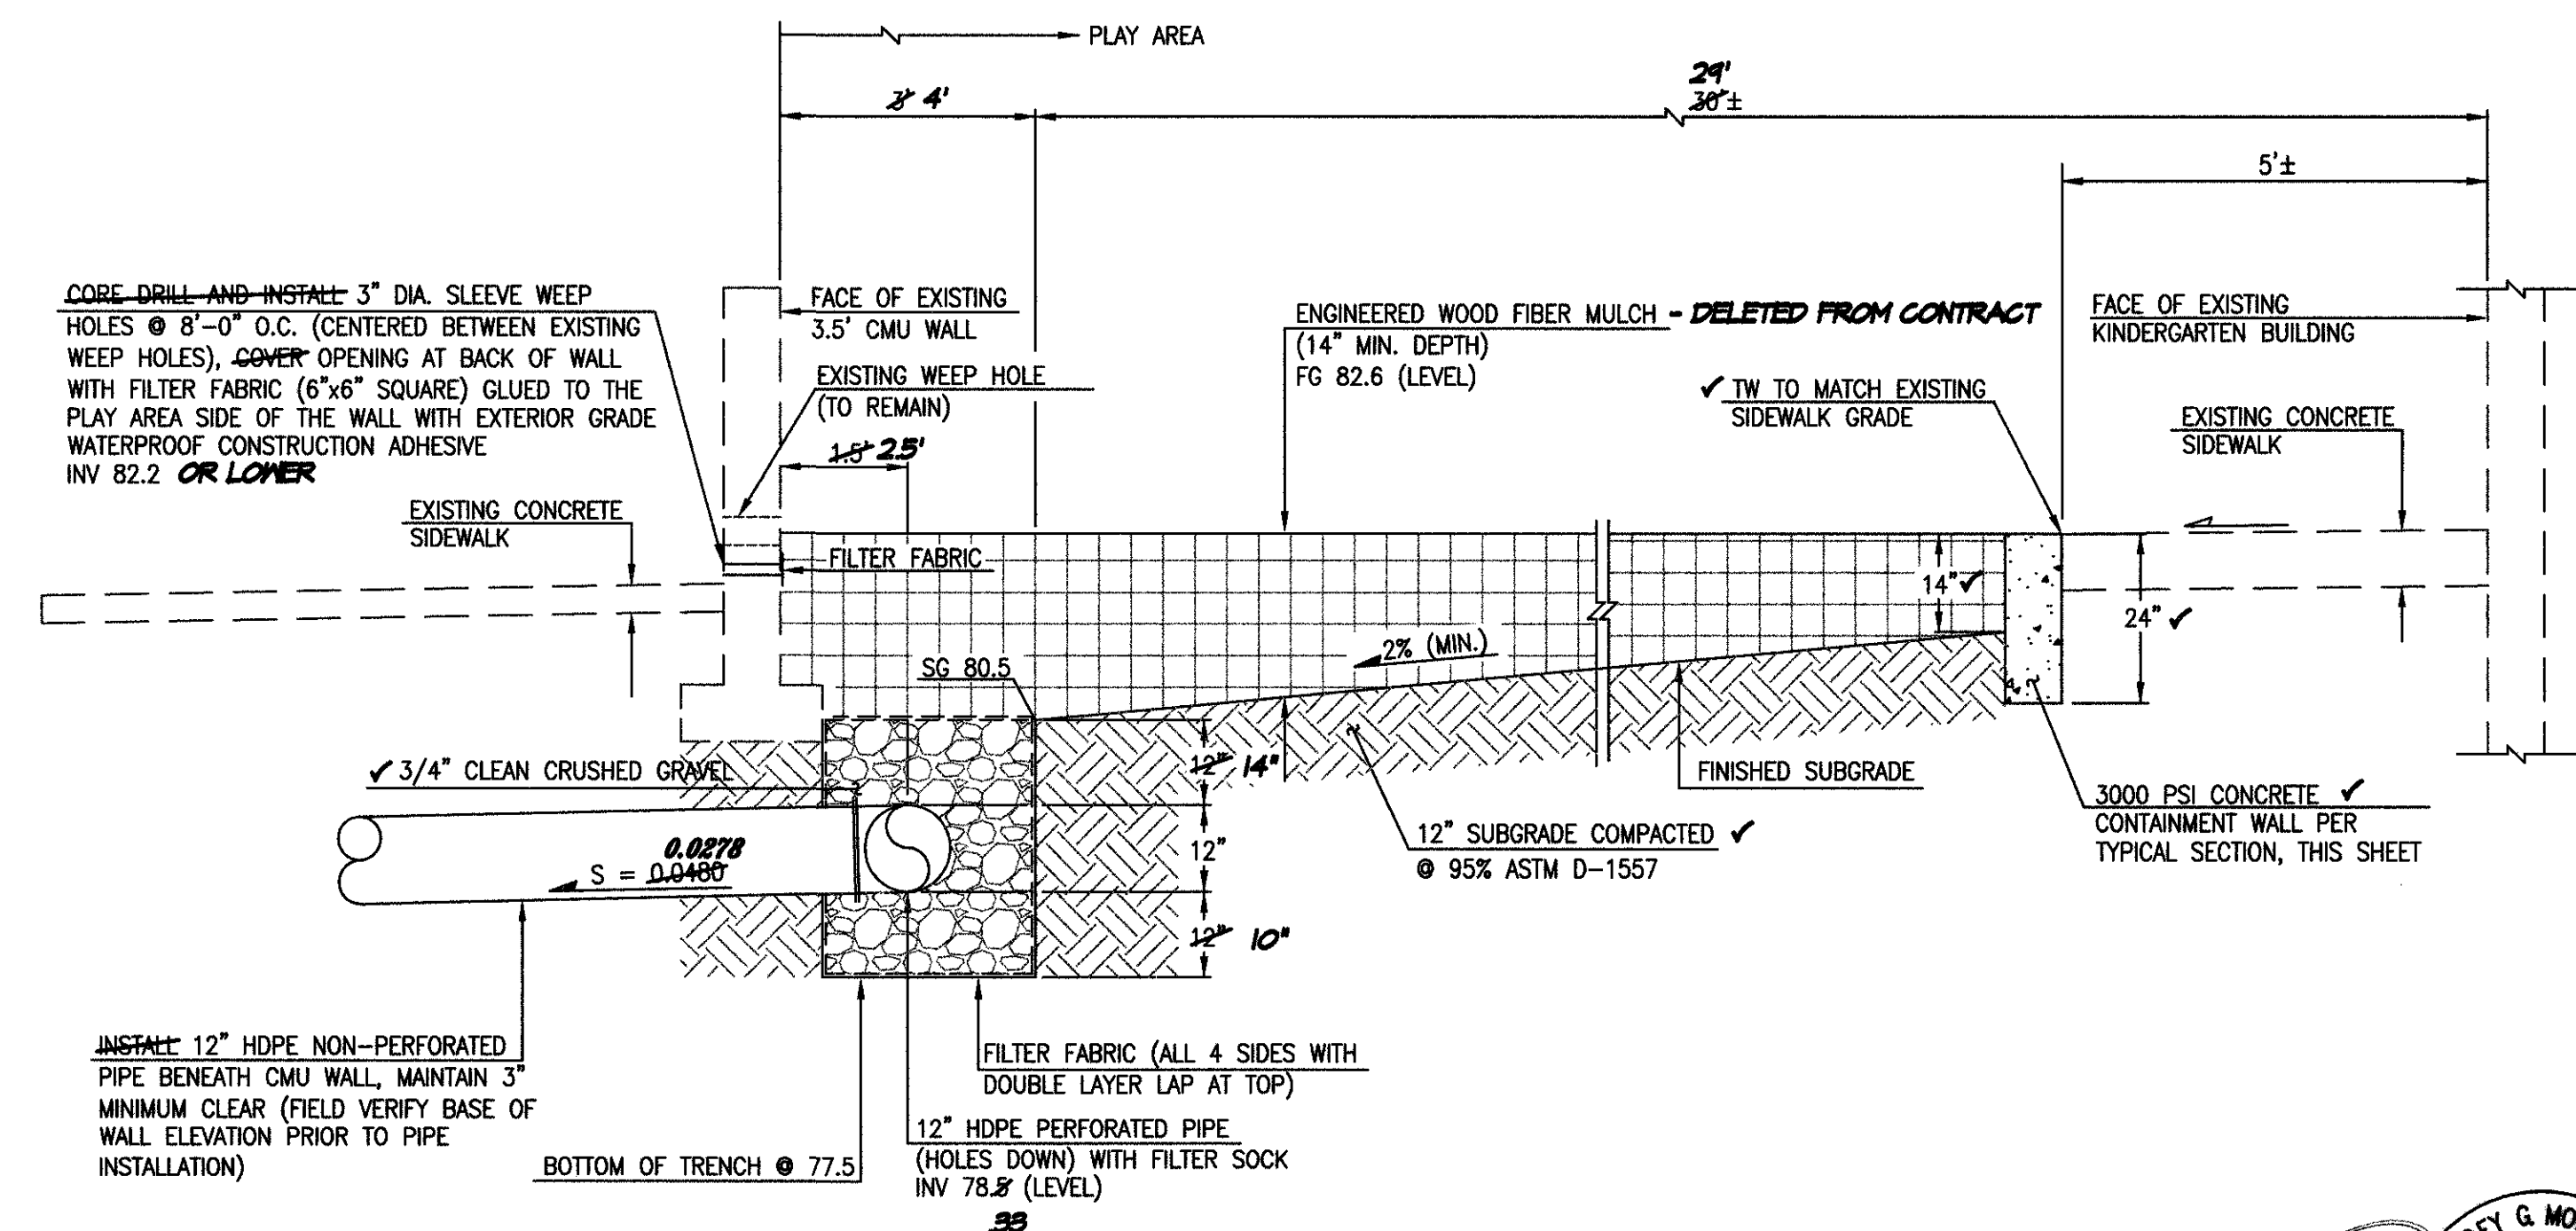

B5 SECTION B-B
SCALE: 1" = 2'-0"

**RECORD DRAWING
FOR CERTIFICATION, SEE SHEET 1**

07-28-2011
04-05-2012

HIGH MESA Consulting Group

6010-B MIDWAY PARK BLVD. NE • ALBUQUERQUE, NEW MEXICO 87109
PHONE: 505.345.4250 • FAX: 505.345.4254 • www.highmesacg.com

PAVING SECTIONS AND DETAILS
KINDERGARTEN PLAYGROUND AND DRAINAGE IMPROVEMENTS
WHITTIER ELEMENTARY SCHOOL

DESIGNED BY	DATE	BY	REVISIONS	JOB NO.
J.G.M./J.D.S.	02/12	B.E.E.	RECORD DRAWING AND CERTIFICATION	2010.183.1
DRAWN BY	DATE	BY	REVISIONS	JOB NO.
C.L.T./E.J.S.				07-2011
APPROVED BY	DATE	BY	REVISIONS	JOB NO.
J.G.M.				5 OF 1218

File Path: P:\Mesa\2010.183.1\DWG\KINDERGARTEN.DWG Plot Date: 04-02-2012
File Name: 101831_SH448.DWG Plot Time: 07:08 am

DESIGN SURVEY NOTE:

THIS IS NOT A BOUNDARY SURVEY. DATA IS SHOWN FOR ORIENTATION ONLY. BOUNDARY INFORMATION DEPICTED BY THIS PLAN IS BASED UPON BOUNDARY SURVEY PREPARED BY HIGH MESA CONSULTING GROUP (NMPS 11184) DATED 02-04-2011 (2010.182.8). THE TOPOGRAPHIC INFORMATION DEPICTED HEREON IS BASED UPON PARTIAL TOPOGRAPHIC AND UTILITY SURVEY PREPARED BY HIGH MESA CONSULTING GROUP (NMPS 11184) DATED 02-04-2011 (2010.182.8).

HIGH MESA Consulting Group


6010-B MIDWAY PARK BLVD. NE • ALBUQUERQUE, NEW MEXICO 87109
PHONE: 505.345.4250 • FAX: 505.345.4254 • www.highmesacg.com

KINDERGARTEN PLAYGROUND PLAN KINDERGARTEN PLAYGROUND AND DRAINAGE IMPROVEMENTS WHITTIER ELEMENTARY SCHOOL

RECORD DRAWING LEGEND
CONSTRUCT
✓ RECORD INFORMATION (VERIFIED BY ENGINEER)
AS-CONSTRUCTED = AS-DESIGNED (VERIFIED BY ENGINEER)
38' 42" RECORD INFORMATION (VERIFIED BY ENGINEER)
+25.2 RECORD INFORMATION (VERIFIED BY ENGINEER)
28.98' 42" RECORD INFORMATION (VERIFIED BY ENGINEER)
✓ AS-CONSTRUCTED = AS-DESIGNED (VERIFIED BY AS-BUILT SURVEY)
31.8 RECORD INFORMATION FROM AS-BUILT SURVEY
26.9 RECORD INFORMATION FROM AS-BUILT SURVEY
31.28' 22" RECORD INFORMATION FROM AS-BUILT SURVEY


NOTE: ENGINEERED WOOD FIBER MULCH
DELETED FROM THIS CONTRACT AND
TRANSFERRED TO PLAY EQUIPMENT
INSTALLATION BY SEPRATE CONTRACT.

LEGEND	
	PROPOSED CONCRETE PAVEMENT
	PROPOSED ASPHALT PAVEMENT
	PROPOSED SYNTHETIC TURF

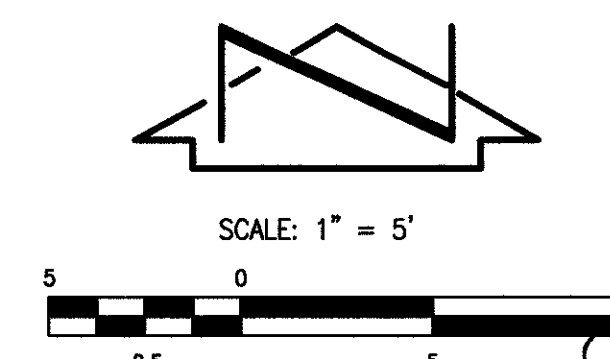

04-05-2012
07-28-2011
11-03-2011
NEW MEXICO
REGISTERED PROFESSIONAL ENGINEER
18547

REVISIONS				JOB NO.
DESIGNED BY	J.G.M./J.D.S.	NO.	DATE	BY
DRAWN BY	C.L.T./E.J.S.	10/11	J.G.M.	MODIFY GATE AND RAMP
APPROVED BY	J.G.M.	02/12	B.E.E.	RECORD DRAWING AND CERTIFICATION
				DATE
				2010.183.1
				07-2011
				SHEET
				4 OF 1218

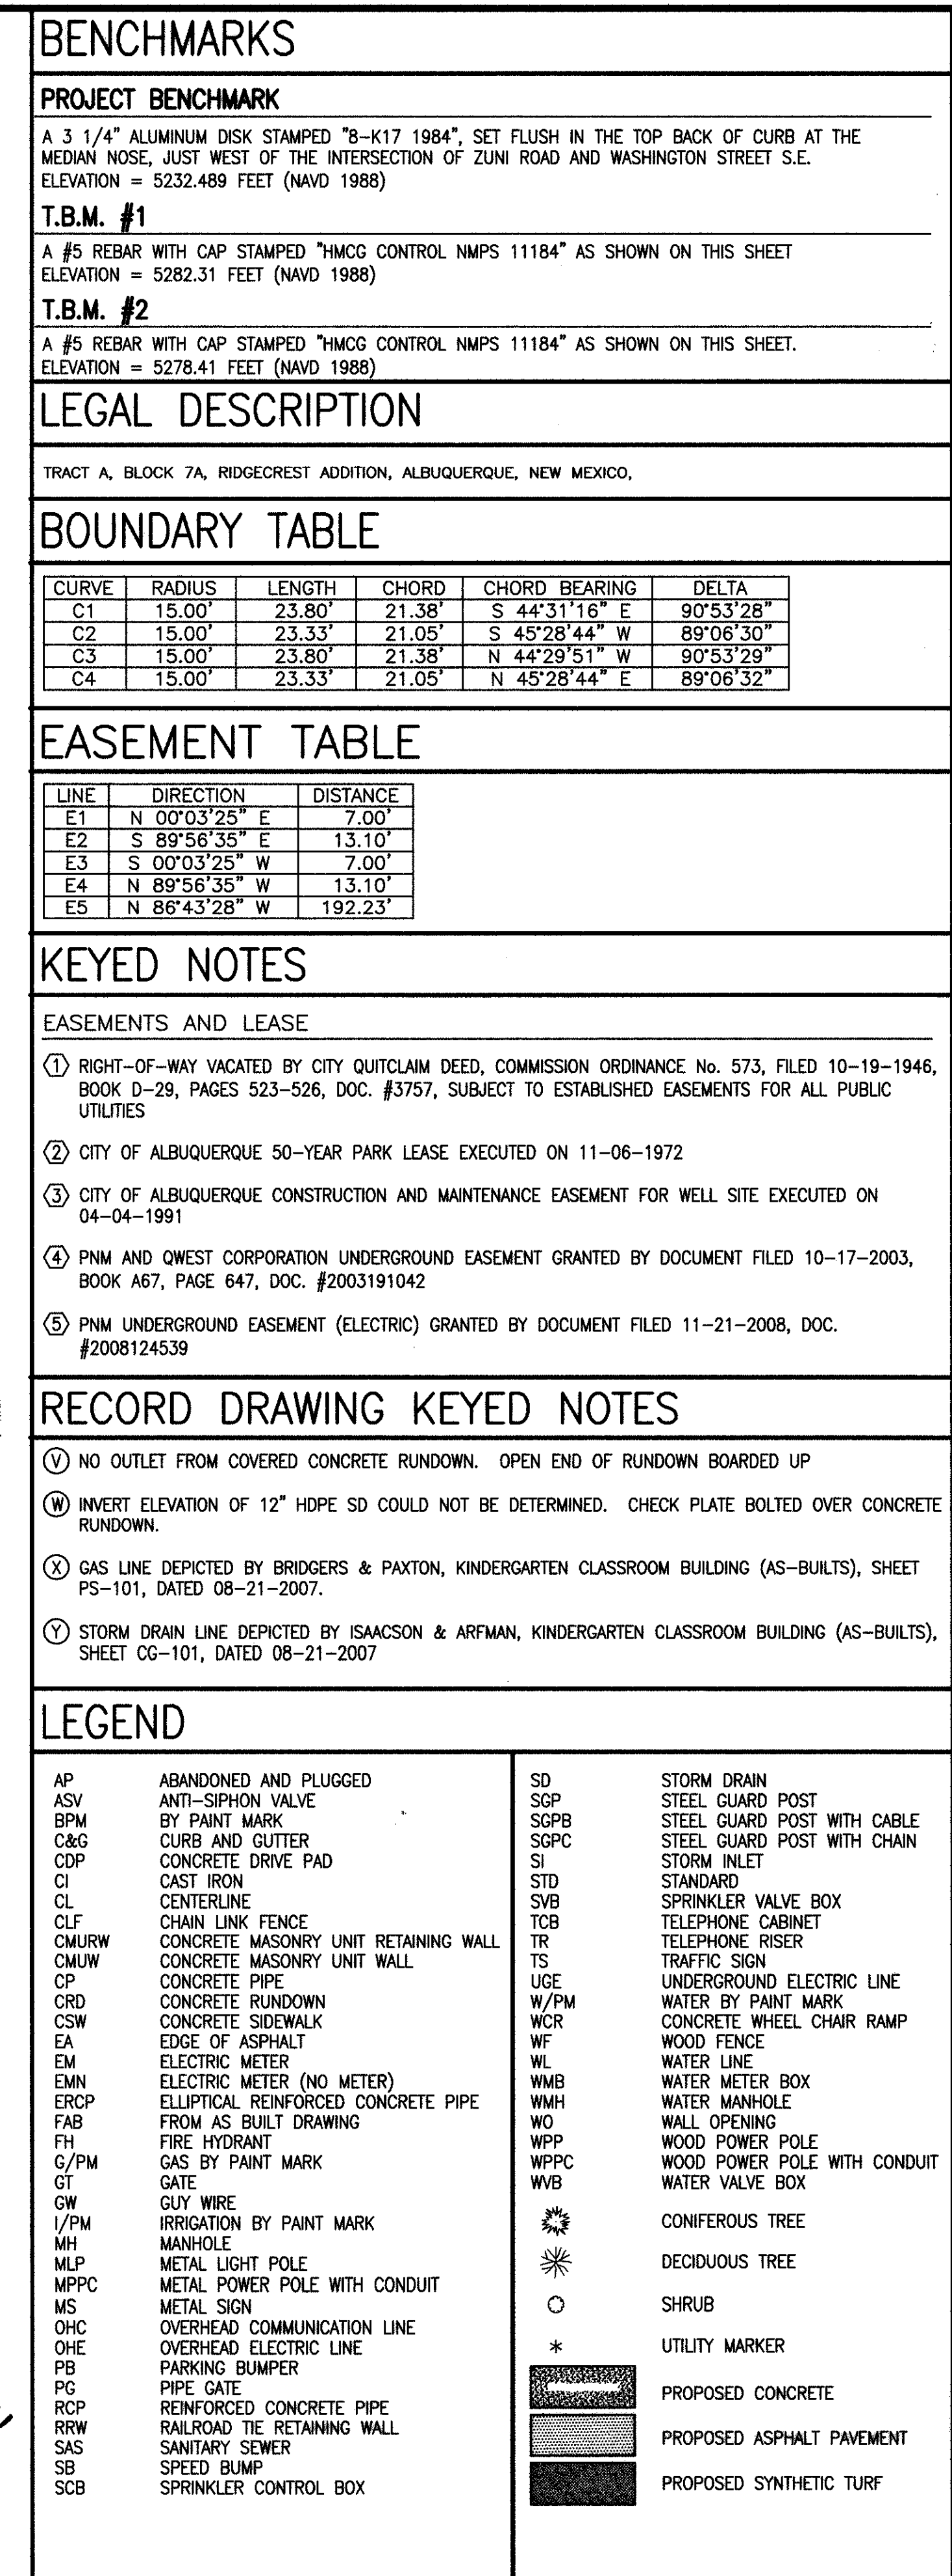

DESIGNED BY		J.G.M./J.D.S.	NO. DATE BY REVISIONS 1/ 10/11 J.G.M. EXPAND PROJECT SCOPE 2/ 02/12 B.E.F. RECORD DRAWING 3/ 03/12 J.G.M. PHASE TWO		JOB NO. 2010.183.1
DRAWN BY		C.L.T./E.J.S.			DATE 07-2011
APPROVED BY		J.G.M.			SHEET 2 OF 1210