

# CITY OF ALBUQUERQUE

Planning Department  
Brennon Williams, Director



Mayor Timothy M. Keller

December 20, 2019

Richard Dourte, P.E.  
RHD Engineering, LLC  
4305 Purple Sage Ave NW  
Albuquerque, NM 87120

**RE: Burger King  
5101 Gibson Blvd SE  
Permanent C.O. - Accepted  
Engineer's Certification Date: 12/20/19  
Engineer's Stamp Date: 09/26/18  
Hydrology File: L18D084**

PO Box 1293

Dear Mr. Dourte:

Albuquerque

Based on the Certification received 12/19/19 and site visit on 12/20/19, this certification is approved in support of Permanent Release of Occupancy by Hydrology.

If you have any questions, please contact me at 924-3995 or [rbrissette@cabq.gov](mailto:rbrissette@cabq.gov).

NM 87103

Sincerely,

www.cabq.gov

Renée C. Brissette, P.E. CFM  
Senior Engineer, Hydrology  
Planning Department



# City of Albuquerque

Planning Department  
Development & Building Services Division

## DRAINAGE AND TRANSPORTATION INFORMATION SHEET (REV 6/2018)

**Project Title:** Burger King Restruant Building Permit #: \_\_\_\_\_ Hydrology File #: L18D084  
DRB#: \_\_\_\_\_ EPC#: \_\_\_\_\_ Work Order#: \_\_\_\_\_  
Legal Description: Lot 2, Block 26, Virginia Place Addition  
City Address: 5101 Gibson Blvd. SE

**Applicant:** RHD Engineering, LLC Contact: Richard Dourte  
Address: 4305 Purple Sage Ave. NW, Alb. NM, 87120  
Phone#: 505.288.1621 Fax#: \_\_\_\_\_ E-mail: rhengineering@outlook.com

**Other Contact:** Simons Architecture PC Contact: Joe Simons  
Address: \_\_\_\_\_  
Phone#: \_\_\_\_\_ Fax#: \_\_\_\_\_ E-mail: joe@simonsarchitecture.com

**TYPE OF DEVELOPMENT:** \_\_\_\_\_ PLAT (# of lots) \_\_\_\_\_ RESIDENCE \_\_\_\_\_ DRB SITE  ADMIN SITE

IS THIS A RESUBMITTAL? \_\_\_\_\_ Yes  No

**DEPARTMENT** \_\_\_\_\_ TRANSPORTATION  HYDROLOGY/DRAINAGE

Check all that Apply:

**TYPE OF SUBMITTAL:**

- ENGINEER/ARCHITECT CERTIFICATION
- \_\_\_\_\_ PAD CERTIFICATION
- \_\_\_\_\_ CONCEPTUAL G & D PLAN
- \_\_\_\_\_ GRADING PLAN
- \_\_\_\_\_ DRAINAGE REPORT
- \_\_\_\_\_ DRAINAGE MASTER PLAN
- \_\_\_\_\_ FLOODPLAIN DEVELOPMENT PERMIT APPLIC
- \_\_\_\_\_ ELEVATION CERTIFICATE
- \_\_\_\_\_ CLOMR/LOMR
- \_\_\_\_\_ TRAFFIC CIRCULATION LAYOUT (TCL)
- \_\_\_\_\_ TRAFFIC IMPACT STUDY (TIS)
- \_\_\_\_\_ STREET LIGHT LAYOUT
- \_\_\_\_\_ OTHER (SPECIFY) \_\_\_\_\_
- PRE-DESIGN MEETING?

**TYPE OF APPROVAL/ACCEPTANCE SOUGHT:**

- \_\_\_\_\_ BUILDING PERMIT APPROVAL
- CERTIFICATE OF OCCUPANCY
- \_\_\_\_\_ PRELIMINARY PLAT APPROVAL
- \_\_\_\_\_ SITE PLAN FOR SUB'D APPROVAL
- \_\_\_\_\_ SITE PLAN FOR BLDG. PERMIT APPROVAL
- \_\_\_\_\_ FINAL PLAT APPROVAL
- \_\_\_\_\_ SIA/ RELEASE OF FINANCIAL GUARANTEE
- \_\_\_\_\_ FOUNDATION PERMIT APPROVAL
- \_\_\_\_\_ GRADING PERMIT APPROVAL
- \_\_\_\_\_ SO-19 APPROVAL
- \_\_\_\_\_ PAVING PERMIT APPROVAL
- \_\_\_\_\_ GRADING/ PAD CERTIFICATION
- \_\_\_\_\_ WORK ORDER APPROVAL
- \_\_\_\_\_ CLOMR/LOMR
- \_\_\_\_\_ FLOODPLAIN DEVELOPMENT PERMIT
- \_\_\_\_\_ OTHER (SPECIFY) \_\_\_\_\_

DATE SUBMITTED: 12/20/19 By: Richard Dourte

COA STAFF: \_\_\_\_\_

ELECTRONIC SUBMITTAL RECEIVED: \_\_\_\_\_

FEE PAID: \_\_\_\_\_

**DRAINAGE NARRATIVE:**

1. THIS SITE IS LOCATED WITHIN AN X FLOOD PLAIN. REFER TO THE FEMA EXCERPT THIS SHEET.
2. THIS SITE IS IN A FREE DISCHARGE AREA.
3. LANDSCAPED AREA = 12%  
IMPERVIOUS AREA = 81%
4. THE VOLUME OF WATER GENERATED BY THIS SITE FOR THE 100YR 6HR RAIN FALL EVENT IS 6400CF.
5. THE FIRST FLUSH PONDING REQUIREMENT IS 798CF. THE PONDING PROVIDED IS 1259CF, THUS THE PONDING PROVIDED IS GREATER THAN THE REQUIRED PONDING.

**GENERAL NOTES:**


1. THIS SITE IS LOCATED IN A ZONE X, FEMA FLOOD HAZARD ZONE (REFER TO THE FIRM MAP 35001C0362H, EXCERPT ATTACHED) EFFECTIVE DATE 8/16/2012.
2. RHD ENGINEERING, LLC RECOMMENDS THAT THE OWNER OBTAIN A GEOTECHNICAL REPORT PRIOR TO DESIGN OF BUILDING FOOTING/FOUNDATION.
3. ALL SWPPP REQUIREMENTS SHALL BE ADHERED TO.
4. ALL WORK ON THIS PLAN SHALL BE DONE IN ACCORDANCE WITH CITY OF ALBUQUERQUE STANDARDS. ALL APPLICABLE PERMITS SHALL BE OBTAINED PRIOR TO WORK COMMENCING.
5. ALL WORK IN THE RIGHT-OF-WAY SHALL BE DONE IN ACCORDANCE WITH CITY OF ALBUQUERQUE STANDARDS.
6. THE SURVEY INFORMATION WAS PROVIDED BY CONSTRUCTION SURVEY TECHNOLOGIES, INC.
7. FOR SITE DIMENSIONS, BUILDING AND INFRASTRUCTURE LOCATION REFER TO THE SITE PLAN.
8. BUILD 2'X2' INLET WITH GRATE (EL=10.15) AND CONNECT TO GREASE TRAP THEN TO SAS SEWER SERVICE LINE, IN ACCORDANCE WITH APPLICABLE ABCWUA AND CITY OF ALBUQUERQUE CODES, STANDARDS AND REQUIREMENTS.
9. CONSTRUCT 1-2' SIDEWALK CULVERT PER STD DWG. 2236 (SO-19 REQUIRED, SEE NOTES ON SHEET 2) INV. IN = 8.25, INV. OUT = 8.04; MATCH EXST. EXTEND STEEL COVER PLATE 1' PAST PROPERTY LINE, TACK WELD TIE DOWN BOLTS. 8.43±

**EROSION CONTROL NOTES:**

1. CONTRACTOR IS RESPONSIBLE FOR OBTAINING A TOPSOIL DISTURBANCE PERMIT PRIOR TO BEGINNING WORK.
2. CONTRACTOR IS RESPONSIBLE FOR MAINTAINING RUN-OFF ON SITE DURING CONSTRUCTION.
3. CONTRACTOR IS RESPONSIBLE FOR CLEANING ALL SEDIMENT THAT GETS INTO EXISTING RIGHT-OF-WAY.
4. REPAIR OF DAMAGED FACILITIES AND CLEANUP OF SEDIMENT ACCUMULATIONS ON ADJACENT PROPERTIES AND IN PUBLIC FACILITIES IS THE RESPONSIBILITY OF THE CONTRACTOR.
5. ALL EXPOSED EARTH SURFACES MUST BE PROTECTED FROM WIND AND WATER EROSION PRIOR TO FINAL ACCEPTANCE OF ANY PROJECT.

**CAUTION:**

EXISTING UTILITIES ARE NOT SHOWN. IT SHALL BE THE SOLE RESPONSIBILITY OF THE CONTRACTOR TO CONDUCT ALL NECESSARY FIELD INVESTIGATIONS PRIOR TO ANY EXCAVATION TO DETERMINE THE ACTUAL LOCATION OF UTILITIES & OTHER IMPROVEMENTS.

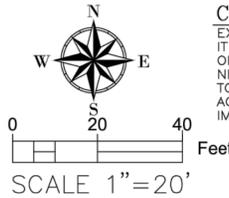

VICINITY MAP: L-18-Z



FIRM MAP: 35001C0362H


**LEGAL DESCRIPTION:**

LOT 2, BLOCK 26, VIRGINIA PLACE ADDITION, CITY OF ALBUQUERQUE, BERNALILLO COUNTY, NEW MEXICO

**NOTES:**


1. ALL SPOT ELEVATIONS REPRESENT FLOWLINE ELEVATION UNLESS OTHERWISE NOTED.
2. RETAIN THE FIRST 46" OF STORM RUNOFF FROM ENTIRE DEVELOPMENT TO CONFORM TO THE WATER QUALITY REQUIREMENTS

**LEGEND**

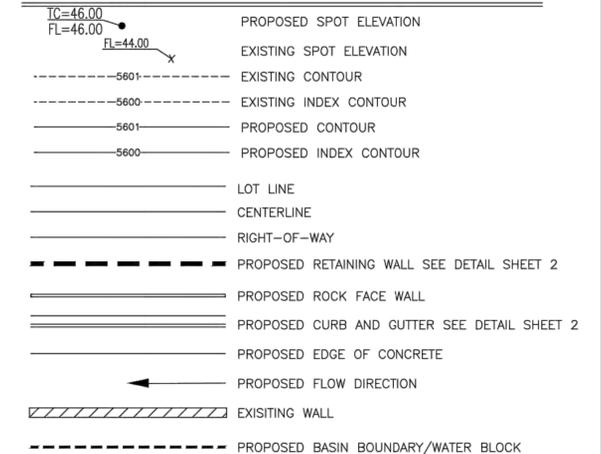

I HAVE PERSONALLY INSPECTED THE PROPERTY ON 7-17-18. NO EARTHWORK HAS BEEN PERFORMED AND THE SITE IS CONSISTENT WITH THE TOPO SHOWN.  
Richard Dourte  
Richard Dourte P.E. #10854

ENGINEER'S SEAL RICHARD H. DOURTE NEW MEXICO REGISTERED PROFESSIONAL ENGINEER 10854	Title: BURGER KING 5101 GIBSON BLVD SE GRADING AND DRAINAGE PLAN	DRAWN BY DATE SHEET # 1 of 2 JOB #
Richard Dourte P.E. #10854	RHD Engineering, LLC 4305 Purple Sage Ave. NW ALBUQUERQUE, NM 87120 (505) 288-1621	9/26/18

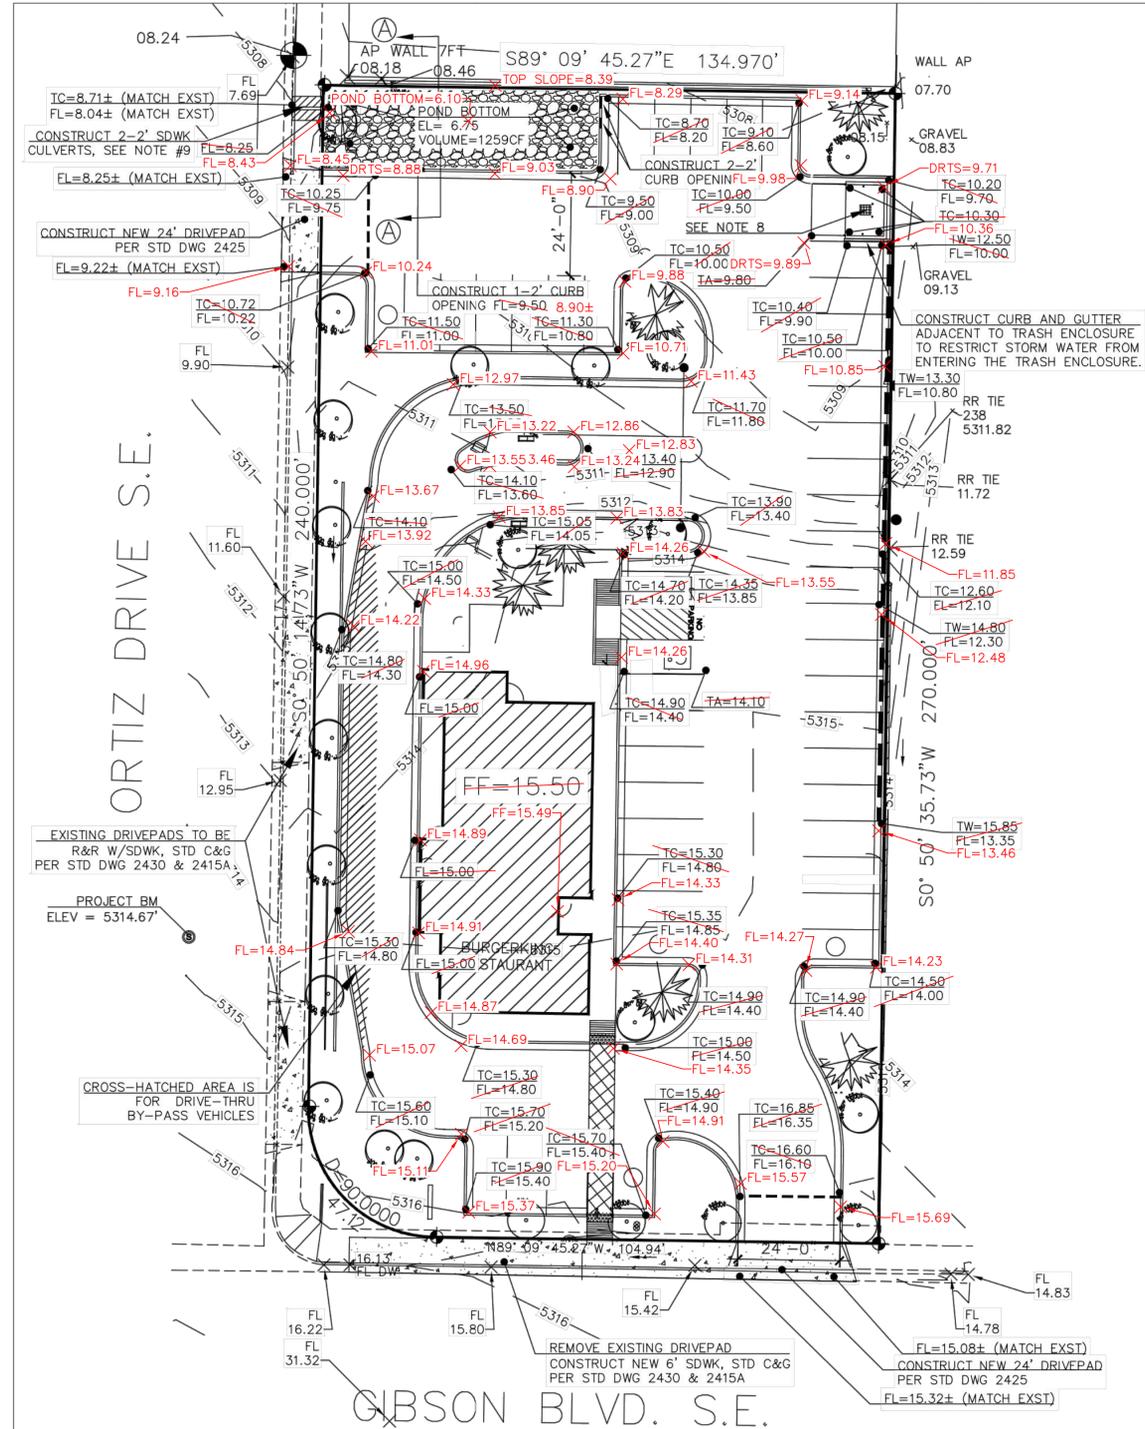

Project: BURGER KING - 5101 GIBSON BLVD SE																																					
Drainage Calculations - Zone 2																																					
<table border="1"> <thead> <tr> <th colspan="6">Depth (inches) at 100yr Storm</th> </tr> <tr> <th>Zone</th> <th>P50</th> <th>P500</th> <th>P1440</th> <th>P5days</th> <th>P10days</th> </tr> </thead> <tbody> <tr> <td>1</td> <td>1.87</td> <td>2.20</td> <td>2.66</td> <td>3.12</td> <td>3.67</td> </tr> <tr> <td>2</td> <td>2.01</td> <td>2.35</td> <td>2.75</td> <td>3.30</td> <td>3.95</td> </tr> <tr> <td>3</td> <td>2.14</td> <td>2.60</td> <td>3.10</td> <td>3.95</td> <td>4.90</td> </tr> <tr> <td>4</td> <td>2.23</td> <td>2.90</td> <td>3.65</td> <td>4.70</td> <td>5.95</td> </tr> </tbody> </table>		Depth (inches) at 100yr Storm						Zone	P50	P500	P1440	P5days	P10days	1	1.87	2.20	2.66	3.12	3.67	2	2.01	2.35	2.75	3.30	3.95	3	2.14	2.60	3.10	3.95	4.90	4	2.23	2.90	3.65	4.70	5.95
Depth (inches) at 100yr Storm																																					
Zone	P50	P500	P1440	P5days	P10days																																
1	1.87	2.20	2.66	3.12	3.67																																
2	2.01	2.35	2.75	3.30	3.95																																
3	2.14	2.60	3.10	3.95	4.90																																
4	2.23	2.90	3.65	4.70	5.95																																
<table border="1"> <thead> <tr> <th colspan="5">Excess Precipitation, E (inches) - 6 HR</th> </tr> <tr> <th>Zone</th> <th>A</th> <th>B</th> <th>C</th> <th>D</th> </tr> </thead> <tbody> <tr> <td>1</td> <td>0.44</td> <td>0.67</td> <td>0.99</td> <td>1.97</td> </tr> <tr> <td>2</td> <td>0.53</td> <td>0.78</td> <td>1.13</td> <td>2.12</td> </tr> <tr> <td>3</td> <td>0.66</td> <td>0.92</td> <td>1.29</td> <td>2.36</td> </tr> <tr> <td>4</td> <td>0.80</td> <td>1.08</td> <td>1.46</td> <td>2.64</td> </tr> </tbody> </table>		Excess Precipitation, E (inches) - 6 HR					Zone	A	B	C	D	1	0.44	0.67	0.99	1.97	2	0.53	0.78	1.13	2.12	3	0.66	0.92	1.29	2.36	4	0.80	1.08	1.46	2.64						
Excess Precipitation, E (inches) - 6 HR																																					
Zone	A	B	C	D																																	
1	0.44	0.67	0.99	1.97																																	
2	0.53	0.78	1.13	2.12																																	
3	0.66	0.92	1.29	2.36																																	
4	0.80	1.08	1.46	2.64																																	
<table border="1"> <thead> <tr> <th colspan="5">Peak Discharge (CFS/ACRE) 100 YR</th> </tr> <tr> <th>Zone</th> <th>A</th> <th>B</th> <th>C</th> <th>D</th> </tr> </thead> <tbody> <tr> <td>1</td> <td>1.29</td> <td>2.03</td> <td>2.87</td> <td>4.37</td> </tr> <tr> <td>2</td> <td>1.56</td> <td>2.28</td> <td>3.14</td> <td>4.70</td> </tr> <tr> <td>3</td> <td>1.87</td> <td>2.60</td> <td>3.45</td> <td>5.02</td> </tr> <tr> <td>4</td> <td>2.20</td> <td>2.92</td> <td>3.73</td> <td>5.25</td> </tr> </tbody> </table>		Peak Discharge (CFS/ACRE) 100 YR					Zone	A	B	C	D	1	1.29	2.03	2.87	4.37	2	1.56	2.28	3.14	4.70	3	1.87	2.60	3.45	5.02	4	2.20	2.92	3.73	5.25						
Peak Discharge (CFS/ACRE) 100 YR																																					
Zone	A	B	C	D																																	
1	1.29	2.03	2.87	4.37																																	
2	1.56	2.28	3.14	4.70																																	
3	1.87	2.60	3.45	5.02																																	
4	2.20	2.92	3.73	5.25																																	
<table border="1"> <thead> <tr> <th colspan="5">Weighted E = ((Ea*AA)+(Eb*Ab)+(Ec*Ac)+(Ed*Ad))/(Aa+Ab+Ac+Ad)</th> </tr> <tr> <th>V500</th> <th>V1440</th> <th>V5days</th> <th>V10days</th> <th></th> </tr> </thead> <tbody> <tr> <td>5823</td> <td>6727</td> <td>8262</td> <td>9979</td> <td></td> </tr> <tr> <td>0.13</td> <td>0.15</td> <td>0.19</td> <td>0.23</td> <td></td> </tr> </tbody> </table>		Weighted E = ((Ea*AA)+(Eb*Ab)+(Ec*Ac)+(Ed*Ad))/(Aa+Ab+Ac+Ad)					V500	V1440	V5days	V10days		5823	6727	8262	9979		0.13	0.15	0.19	0.23																	
Weighted E = ((Ea*AA)+(Eb*Ab)+(Ec*Ac)+(Ed*Ad))/(Aa+Ab+Ac+Ad)																																					
V500	V1440	V5days	V10days																																		
5823	6727	8262	9979																																		
0.13	0.15	0.19	0.23																																		
<table border="1"> <thead> <tr> <th colspan="5">Design Flows (100YR)</th> </tr> <tr> <th>Area</th> <th>SQ. FT</th> <th>Acres</th> <th>Peak Discharge (CFS)</th> <th></th> </tr> </thead> <tbody> <tr> <td>A=</td> <td>0</td> <td>0.000</td> <td>0.00</td> <td></td> </tr> <tr> <td>B=</td> <td>0</td> <td>0.000</td> <td>0.00</td> <td></td> </tr> <tr> <td>C=</td> <td>14500</td> <td>0.333</td> <td>1.15</td> <td></td> </tr> <tr> <td>D=</td> <td>21683</td> <td>0.498</td> <td>2.50</td> <td></td> </tr> <tr> <td>Total</td> <td>36183</td> <td>0.831</td> <td>3.65</td> <td></td> </tr> </tbody> </table>		Design Flows (100YR)					Area	SQ. FT	Acres	Peak Discharge (CFS)		A=	0	0.000	0.00		B=	0	0.000	0.00		C=	14500	0.333	1.15		D=	21683	0.498	2.50		Total	36183	0.831	3.65		
Design Flows (100YR)																																					
Area	SQ. FT	Acres	Peak Discharge (CFS)																																		
A=	0	0.000	0.00																																		
B=	0	0.000	0.00																																		
C=	14500	0.333	1.15																																		
D=	21683	0.498	2.50																																		
Total	36183	0.831	3.65																																		
<table border="1"> <thead> <tr> <th colspan="5">Design Flows (100YR)</th> </tr> <tr> <th>Area</th> <th>SQ. FT</th> <th>Acres</th> <th>Peak Discharge (CFS)</th> <th></th> </tr> </thead> <tbody> <tr> <td>A=</td> <td>0</td> <td>0.000</td> <td>0.00</td> <td></td> </tr> <tr> <td>B=</td> <td>0</td> <td>0.000</td> <td>0.00</td> <td></td> </tr> <tr> <td>C=</td> <td>8030</td> <td>0.184</td> <td>0.64</td> <td></td> </tr> <tr> <td>D=</td> <td>28153</td> <td>0.646</td> <td>3.24</td> <td></td> </tr> <tr> <td>Total</td> <td>36183</td> <td>0.831</td> <td>3.88</td> <td></td> </tr> </tbody> </table>		Design Flows (100YR)					Area	SQ. FT	Acres	Peak Discharge (CFS)		A=	0	0.000	0.00		B=	0	0.000	0.00		C=	8030	0.184	0.64		D=	28153	0.646	3.24		Total	36183	0.831	3.88		
Design Flows (100YR)																																					
Area	SQ. FT	Acres	Peak Discharge (CFS)																																		
A=	0	0.000	0.00																																		
B=	0	0.000	0.00																																		
C=	8030	0.184	0.64																																		
D=	28153	0.646	3.24																																		
Total	36183	0.831	3.88																																		
<table border="1"> <thead> <tr> <th colspan="5">The 100 year peak flows for this developed site is 3.9 CFS and the existing flows are 3.6 CFS for an increase of 0.3 CFS. The 100 year 6 hr volume increase is 6400-5823 = 577CF.</th> </tr> <tr> <th>V50</th> <th>V1440</th> <th>V5days</th> <th>V10days</th> <th></th> </tr> </thead> <tbody> <tr> <td>6400</td> <td>7573</td> <td>9567</td> <td>11796</td> <td></td> </tr> <tr> <td>0.15</td> <td>0.17</td> <td>0.22</td> <td>0.27</td> <td></td> </tr> </tbody> </table>		The 100 year peak flows for this developed site is 3.9 CFS and the existing flows are 3.6 CFS for an increase of 0.3 CFS. The 100 year 6 hr volume increase is 6400-5823 = 577CF.					V50	V1440	V5days	V10days		6400	7573	9567	11796		0.15	0.17	0.22	0.27																	
The 100 year peak flows for this developed site is 3.9 CFS and the existing flows are 3.6 CFS for an increase of 0.3 CFS. The 100 year 6 hr volume increase is 6400-5823 = 577CF.																																					
V50	V1440	V5days	V10days																																		
6400	7573	9567	11796																																		
0.15	0.17	0.22	0.27																																		
<table border="1"> <thead> <tr> <th colspan="5">First Flush Ponding Requirement = Ao * 0.34 in/12in/ft = 798 CF</th> </tr> </thead> </table>		First Flush Ponding Requirement = Ao * 0.34 in/12in/ft = 798 CF																																			
First Flush Ponding Requirement = Ao * 0.34 in/12in/ft = 798 CF																																					

**BENCH MARK INFORMATION:**  
SAS MANHOLE RIM IN ORTIZ DRIVE, ELEVATION= 5314.67.

DRAINAGE CERTIFICATION WITH SURVEY WORK BY PROFESSIONAL SURVEYOR  
DRAINAGE CERTIFICATION  
I, Richard Dourte, NMPE 10854 OF THE FIRM RHD Engineering, LLC HEREBY CERTIFY THAT THIS PROJECT HAS BEEN GRADED AND WILL DRAIN IN SUBSTANTIAL COMPLIANCE WITH THE DESIGN INTENT OF THE APPROVED PLAN DATED 9/26/18. THE RECORD INFORMATION EDITED ONTO THE ORIGINAL DESIGN DOCUMENTATION HAS BEEN OBTAINED BY DAVID ACOSTA, NMPS 21082 OF THE FIRM CONSTRUCTION SURVEY TECHNOLOGIES, INC. I FURTHER CERTIFY THAT I HAVE PERSONALLY VISITED THE PROJECT SITE ON 12/20/19 AND HAVE DETERMINED BY VISUAL INSPECTION THAT THE SURVEY DATA PROVIDED IS REPRESENTATIVE OF ACTUAL SITE CONDITIONS AND IS TRUE AND CORRECT TO THE BEST OF MY KNOWLEDGE AND BELIEF. THIS CERTIFICATION IS SUBMITTED IN SUPPORT OF THE REQUEST FOR BUILDING CERTIFICATE OF OCCUPANCY.  
(DESCRIBE ANY EXCEPTIONS AND /OR QUALIFICATIONS HERE IN A SEPARATE PARAGRAPH.)  
1. ASBUILT GRADES ARE IN RED.  
2.

THE RECORD INFORMATION PRESENTED HEREON IS NOT NECESSARILY COMPLETE AND INTENDED ONLY TO VERIFY SUBSTANTIAL COMPLIANCE OF THE GRADING AND DRAINAGE ASPECTS OF THIS PROJECT. THOSE RELYING ON THIS RECORD DOCUMENTATION ARE ADVISED TO OBTAIN INDEPENDENT VERIFICATION OF ITS ACCURACY BEFORE USING IT FOR ANY OTHER PURPOSE.

Richard Dourte  
Richard Dourte, NMPE 10854  
NEW MEXICO  
REGISTERED PROFESSIONAL ENGINEER  
10854  
12/20/19  
Date