

# KEYED NOTES:

1. NEW ASPHALT PAVEMENT.
2. NEW 6" CONCRETE CURB.
3. 6" WIDE CONCRETE SIDEWALK.
4. ROOF SLOPE.
5. 4' x 4' CONCRETE STOOP.
6. OVERHEAD DOOR.
7. REFUSE ENCLOSURE.
8. EXIST. STD. CURB & GUTTER.
9. EDGE EXIST. ASPHALT PVM'NT.
10. DRAINAGE SWALE.
11. 2' - 0" SIDEWALK CULVERT PER C.O.A. STD. DWG. 2236.
12. 1' - 0" CURB OPENING FOR DRAINAGE.
13. 1' - 6" DRAINAGE CHANNEL (SEE DETAIL).
14. 2' - 0" DRAINAGE CHANNEL (SEE DETAIL).
15. SEDIMENTATION BASIN AND POND OUTFALL STRUCTURE. (SEE DETAIL, SHEET 2).
16. 4" PIPE THROUGH CURB PER C.O.A. STD. DWG. 2235.
17. DOWNSPOUT (TYP. OF 4 EACH SIDE).
18. 2' x 6' CONCRETE SPLASH PAD.
19. CMU CUTOFF WALL. TOP WALL EL. = 52.50

## GENERAL NOTES:


1. ADD 5400 TO SPOT ELEVATIONS TO SHOW TRUE ELEVATION.
2. CONTOUR INTERVAL IS ONE (1) FOOT.
3. ELEVATIONS SHOWN ARE BASED ON ACS STATION "SUSAN", WITH AN ELEVATION OF 5444.49.

## LEGAL DESCRIPTION:

LOT NUMBERED TEN-A (10-A) IN BLOCK NUMBERED FIFTY-TWO AND FIFTY THREE (52 & 53) SKYLINE HEIGHTS SUBDIVISION, CITY OF ALBUQUERQUE, BERNALILLO COUNTY, NEW MEXICO.


## NOTE:

UTILITIES SHOWN HEREON ARE IN THEIR APPROXIMATE LOCATION BASED ONLY ON ABOVE GROUND EVIDENCE FOUND IN THE FIELD AND AS-BUILT INFORMATION PROVIDED BY THE CLIENT. UTILITIES SHOWN HEREON, WHETHER INDICATED AS ABANDONED OR NOT, SHALL BE VERIFIED BY OTHERS FOR EXACT LOCATION AND/OR DEPTH PRIOR TO EXCAVATION OR DESIGN CONSIDERATIONS.

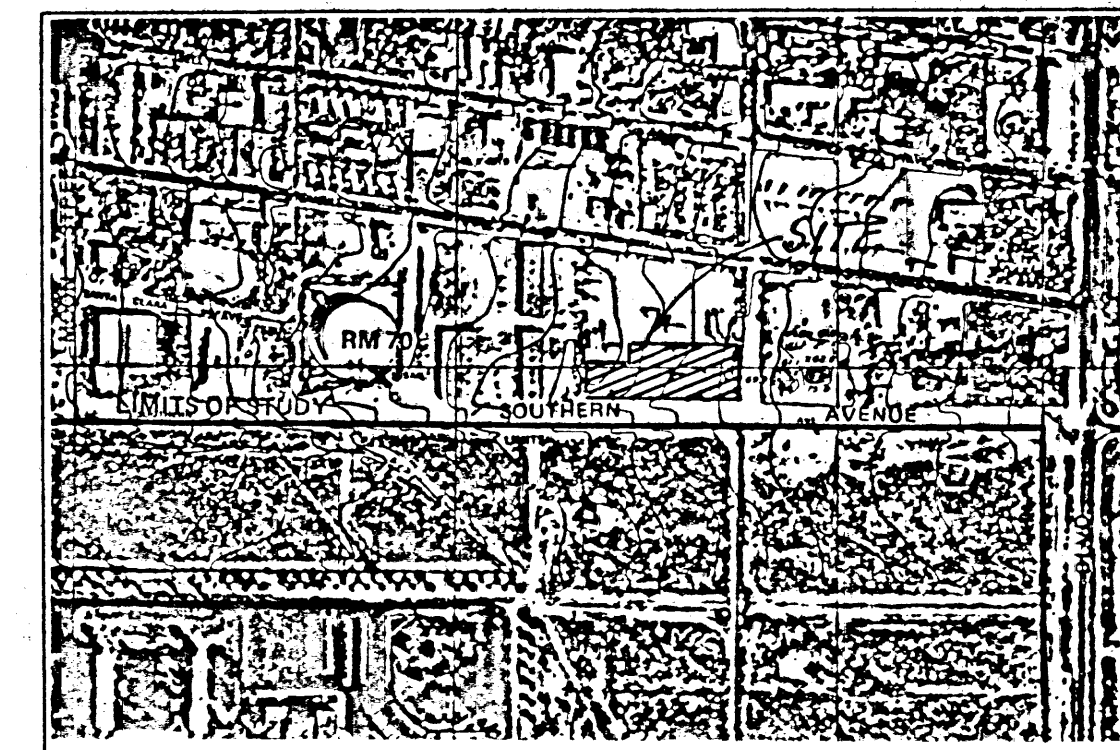

FLOODWAY MAP

PANEL 36 OF 50

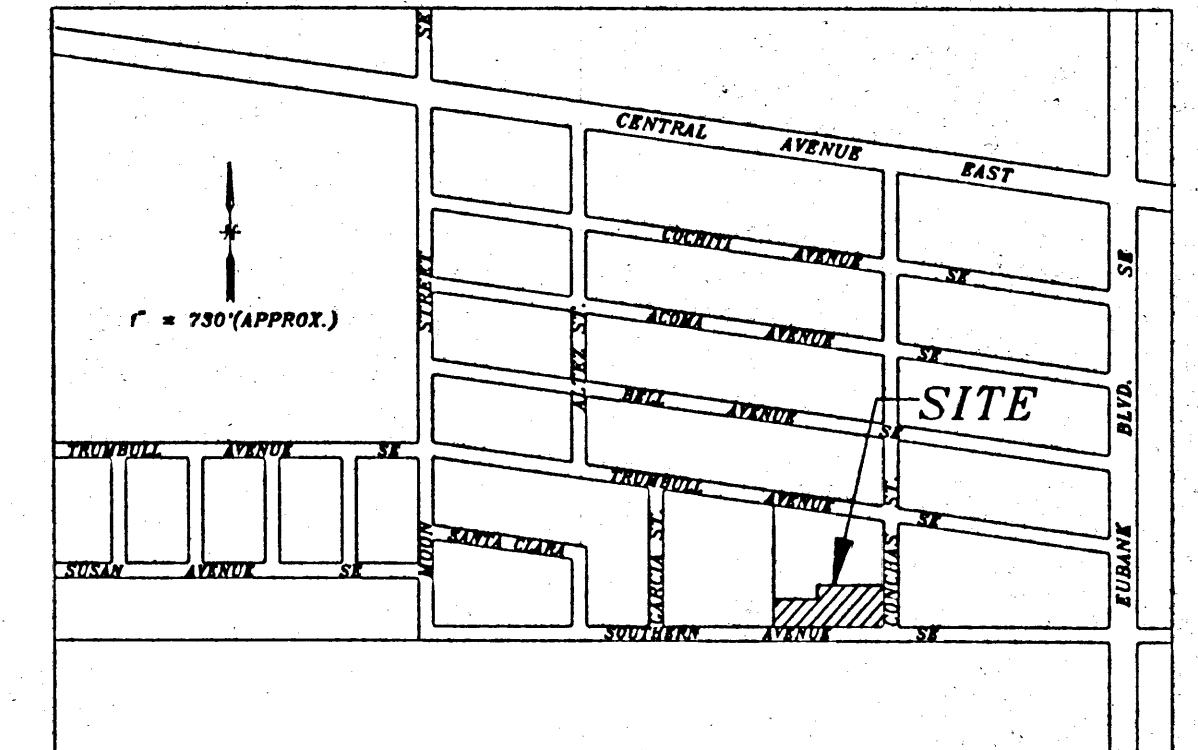





VICINITY MAP

ZONE ATLAS NO. L-20-2

## LEGEND:

- 53.31 EXISTING SPOT ELEVATION
- 50.0 NEW SPOT ELEVATION
- 5452 EXISTING CONTOUR
- 51 NEW CONTOUR
- (FL56.28\*) AS-CONSTRUCTED SPOT ELEV.

SCALE: 1" = 20'

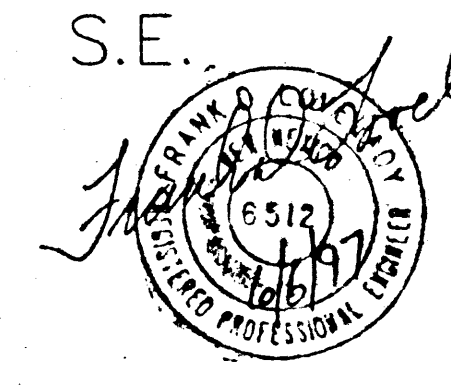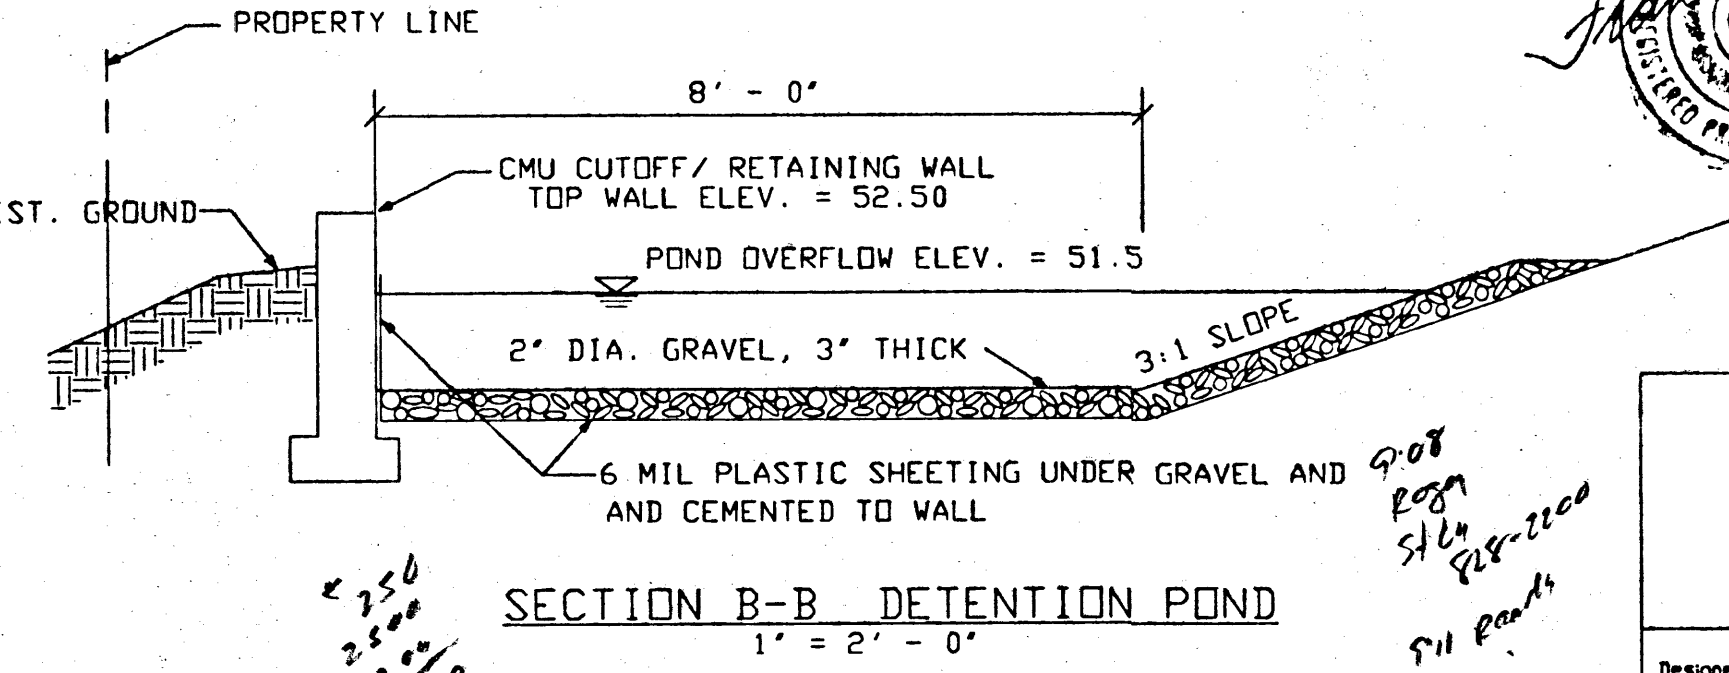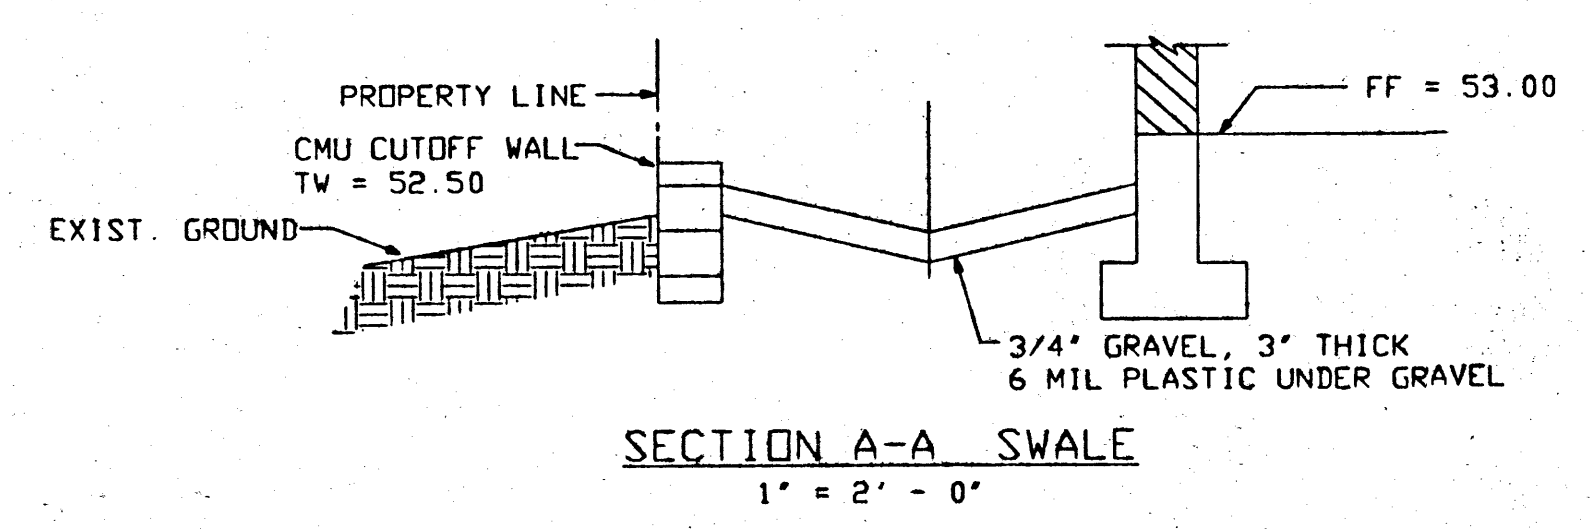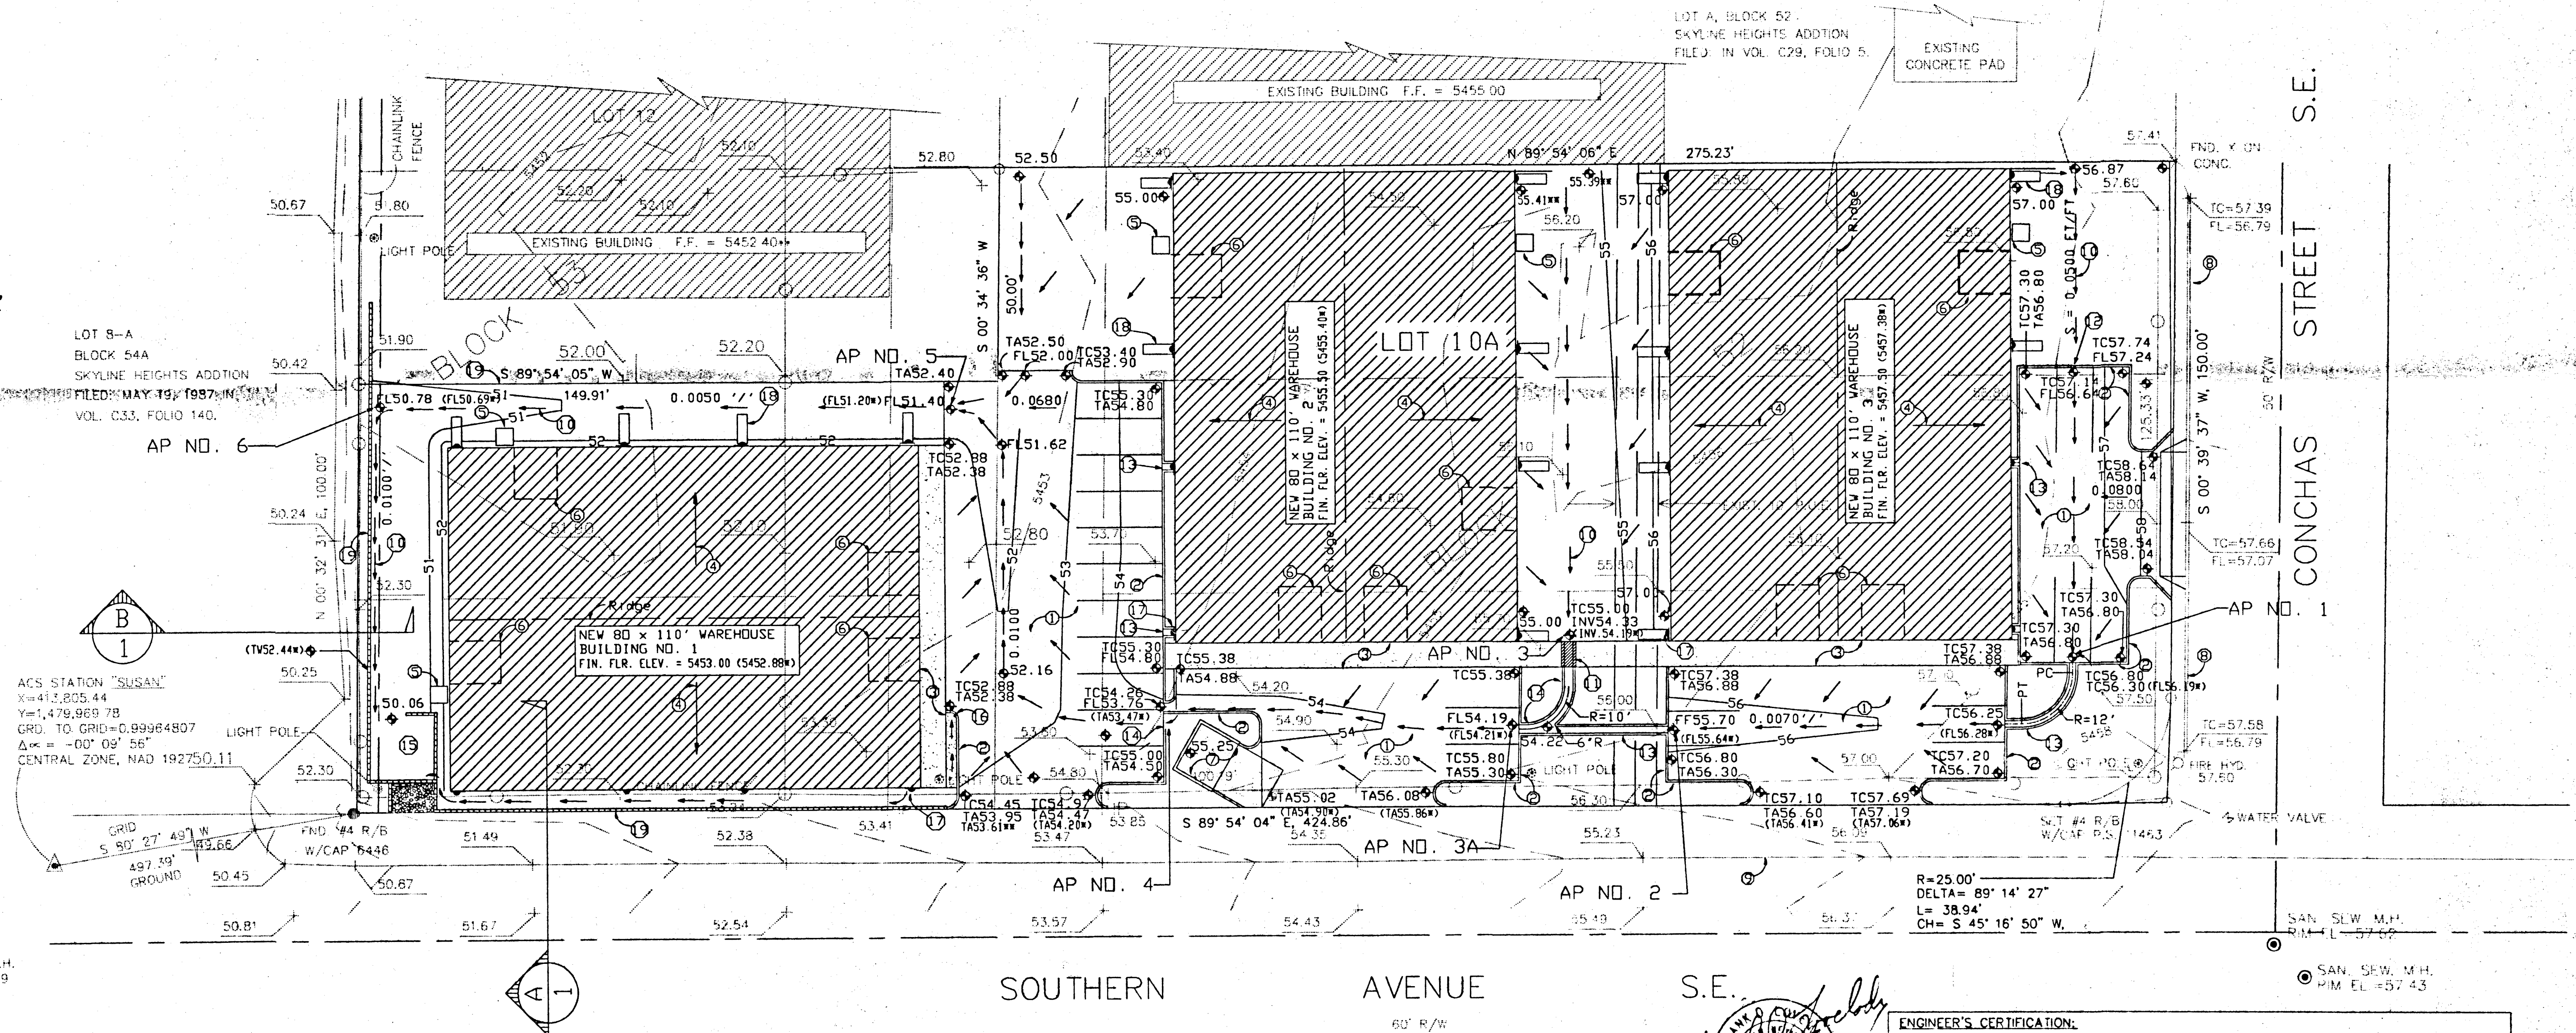

ENGINEER'S CERTIFICATION:

Having field-inspected the site upon completion of paving and all drainage facilities, and having shot finish floor elevations of all buildings and other critical spot elevations, I hereby certify that the as-constructed facility is in substantial conformance with the with the approved grading and drainage plan with Engineer's stamp dated 8/30/96.

*Frank D. Lovelady* 6/6/97 Date  
 Frank D. Lovelady, N.M.P.E. 6512

RECEIVED JUN 06 1997 HYDROLOGY SECTION

<b>FRANK D. LOVLADY, P.E.</b> 300 ALAMOSA ROAD NW ALBUQUERQUE, NEW MEXICO 87107 (505)345-2267				AS - CONSTRUCTED GRADING AND DRAINAGE PLAN 3 UNIT WAREHOUSING LOT 10A, BLOCK 52 & 53 SKYLINE HEIGHTS SUBDIVISION ALBUQUERQUE, NEW MEXICO			
Designed	FDL	Drawn	FDL	Checked	FDL	Scale	1" = 20'
Date	JUNE, 1997	Job No.	529	SHEET 1 OF 2			

BUZCERT1.DWG(6/4/97)

TOPOGRAPHIC SURVEY PREPARED BY:  
 WESLEY SURVEYING, INC.  
 10000 ALBUQUERQUE, NEW MEXICO 87110  
 PHONE: (505) 889-0000  
 FAX: (505) 889-0040



EXISTING CONDITIONS:

The site is located at the N.W. corner of the intersection of Southern Avenue and Conchas Street. Conchas Street is paved with standard curb and gutter. Southern Avenue is paved but without curb and gutter. Southern Avenue is in the corridor for Gibson Boulevard extension. Property north and west of the site is developed. The property to the north is developed as warehousing and property to the west is mini warehouse units with asphalt parking. The property slopes from east to west at an average slope of approximately 1.5 percent.

PROPOSED CONDITIONS:

It is proposed to construct warehouses and asphalt parking on the site as shown. Due to the future construction of Gibson Boulevard, construction of curb and gutter on Southern Boulevard is not recommended at this time by Traffic Engineering. Due to downstream storm drainage improvements, and due to the fact that the site is an infill site, unrestricted discharge would otherwise be acceptable except for Southern Avenue being without curb and gutter. A detention pond is proposed to reduce developed discharge to the existing rate.

DRAINAGE CRITERIA:

The calculations shown on this plan were prepared in accordance with Section 22.2, Hydrology, of the Development Process Manual, Volume 2, Design Criteria, for the City of Albuquerque, in cooperation with Bernalillo County, New Mexico and the Albuquerque Metropolitan Arroyo Flood Control Authority, January, 1993.

PRECIPITATION ZONE:

The site is west of the Eubank Boulevard and is, therefore, in Precipitation Zone 3.

LAND TREATMENT	q(cfs/acre)		E (in)		Existing Site Areas			Developed Site Areas		
	100-yr.	10-yr.	100-yr.	10-yr.	%	Sq. Ft.	Acres	%	Sq. Ft.	Acres
A	1.87	0.58	0.66	0.19	0.0	0	0.00	0.0	0	0.0000
B	2.60	1.19	0.92	0.36	00.0	0	0.0000	8.0	4,458	0.1023
C	3.45	2.00	1.29	0.62	100.0	56,123	1.2884	20.0	11,241	0.2581
D	5.02	3.39	2.36	1.50	00.0	0	0.0000	72.0	40,424	0.9280
Totals					100.0	56,123	1.2884	100.0	56,123	1.2884

PEAK DISCHARGE:

EXISTING CONDITIONS:

Q100 = 1.2884 \* 3.45 = 4.45 cfs  
Q10 = 1.2884 \* 2.00 = 2.58 cfs

DEVELOPED CONDITIONS:

Q100 = 0.1023 \* 2.60 + 0.2581 \* 3.45 + 0.9280 \* 5.02 = 5.81 cfs  
Q10 = 0.1023 \* 1.19 + 0.2581 \* 2.00 + 0.9280 \* 3.39 = 3.78 cfs

VOLUME 100-YEAR, 6-HOUR:

EXISTING CONDITIONS:

V100 = (56,123 \* 1.29)/12 = 6,033 CF  
V10 = (56,123 \* 0.62)/12 = 2,900 CF

DEVELOPED CONDITIONS:

V100 = (4,458 \* 0.92 + 11,241 \* 1.29 + 40,424 \* 2.36)/12 = 9,500 CF  
V10 = (4,458 \* 0.36 + 11,241 \* 0.62 + 40,424 \* 1.50)/12 = 5,768 CF

SUMMARY OF VOLUMES AND PEAK DISCHARGE RATES:

	V100	V10	Q100	Q10
EXISTING	6,033	2,900	4.45	2.58
DEVELOPED	9,500	5,768	5.81	3.78
INCREASE	3,467	2,868	1.36	1.20

OFF-SITE FLOW:

There is no off-site flow associated with this site. The property to the north is graded to drain to Trumbull Avenue, SE.

DOWNSTREAM CAPACITY:

THE SITE WILL DRAIN INTO SOUTHERN AVENUE WHICH IS PAVED BUT DOES NOT HAVE CURB AND GUTTER. THE SITE DISCHARGE WILL ENTER SOUTHERN AVENUE AND BE CONVEYED BY THE ROADSIDE DITCHES TO MOON AVENUE WHICH DOES HAVE CURB AND GUTTER AND A STORM DRAINAGE SYSTEM. THERE IS A FLOOD ZONE IN MOON STREET BEGINNING NORTH OF TRUMBULL AVENUE. A 54" RCP STORM DRAIN LINE HAS BEEN INSTALLED IN MOON STREET PARALLEL TO THE EXISTING 36" RCP STORM DRAIN LINE AND THE TWO LINES ARE INTERCONNECTED AT MANHOLES. THE NEW LINE IS A "WASH" LINE FOR THE CITY RESERVOIRS AT GARCIA AND TRUMBULL. IT IS IMPORTANT THAT THE DISCHARGE FROM THE DEVELOPED SITE NOT BE INCREASED SIGNIFICANTLY OVER THE EXISTING PEAK DISCHARGE. THE EXISTING PEAK DISCHARGE IS 4.45 CFS. DEVELOPED RUNOFF IS 5.81 CFS AND THE INCREASE IS 1.36 CFS. IN ORDER TO LIMIT SITE DISCHARGE TO THE EXISTING 4.45 CFS, IT IS PROPOSED TO HAVE A DETENTION POND WEST OF BUILDING NO. 1 WITH SPILLWAY AND POSITIVE DISCHARGE PIPES. THE AREA AVAILABLE IS LIMITED BUT IT WILL BE POSSIBLE TO LIMIT THE FLOW TO THE EXISTING 100-YEAR PEAK DISCHARGE. IT WILL ALSO BE NECESSARY TO LINE THE POND BOTTOM WITH AN IMPERVIOUS POND LINER SINCE THE POND WILL BE CLOSER THAN 15 FEET FROM THE BUILDING AND THE PROPERTY LINE.

EROSION CONTROL REQUIREMENTS:

The Contractor shall be responsible for compliance with the following:


- No sediment-bearing water shall be allowed to discharge from the site during construction.
- During grading operations and until the project has been completed, all adjacent property rights-of-way, and easements shall be protected from flooding by runoff from the site.
- Should the contractor fail to prevent sediment-bearing water from entering public right-of-way, he shall promptly remove from the public right-of-way any and all sedimentation originating from the site.
- Control of sediment-bearing waters will be accomplished by use of a compacted earth berm of adequate height. The berm shall be located along the downstream perimeter of the property.

DRAINAGE CALCULATIONS:

POND CALCULATIONS

HYDROGRAPH FOR SMALL WATERSHEDS:

$t_B = (2.107 * E * A_T / Q_P) - (0.25 A_D / A_T)$   
 $E = 0.08 * 0.92 + 0.20 * 1.29 + 0.72 * 2.36 = 2.03$  in.  
 $A_T = 1.2884$  AC  $A_D = 0.9280$  AC  $Q_P = 5.81$  CFS  
 $t_B = (2.107 * 2.03 * 1.2884 / 5.81) - (0.25 * 0.9280 / 1.2884) = 0.77$  HR.  
 $t_P = (0.7 * t_B) + ((1/6 - (A_D / A_T)) / 12)$   
 $t_P = (0.7 * 0.77) + ((1/6 - (0.9280 / 1.2884)) / 12) = 0.21$  HR.  
Continue the Peak  $0.25 (A_D / A_T) = 0.25 (0.9280 / 1.2884) = 0.18$  HR.

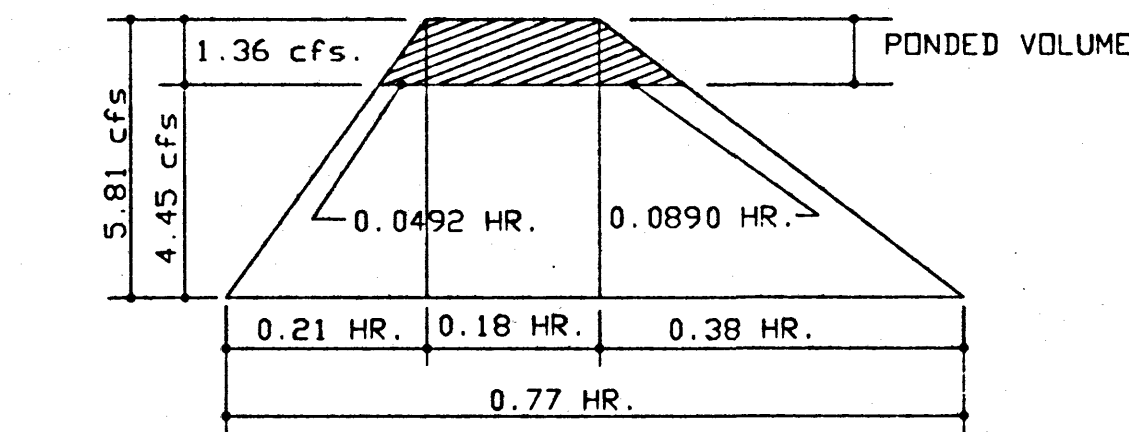


POND VOLUME:  $V = [(0.0492 * 1.36) / 2 + (0.18 * 1.36) + (0.0890 * 1.36) / 2] * 3600$   
 $V = 1,220$  CF

ACTUAL POND VOLUME:


Ponding will take place along the west and north sides of Building No. 1 and in the silting basin.

North side of Building No. 1: Use Pyramid Equation,  $V = BH/3$  B = Surface Area = 216 sf.  
 $H$  = Depth at west end = 51.4 - 50.8 = 0.6 ft.  
 $V = (216 * 0.6) / 3 = 43$  CF

West side of Building No. 1: Use Average End Area Method.

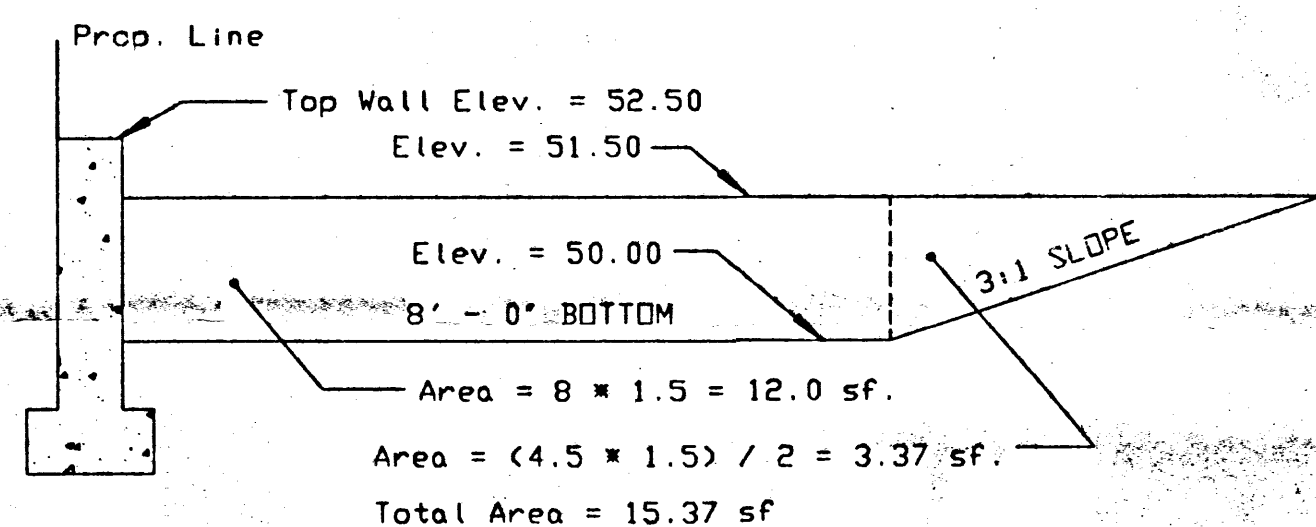


Average Area = 10.35 sf  
Distance between sections = 85'  
Volume = 10.35 X 85 = 880 CF

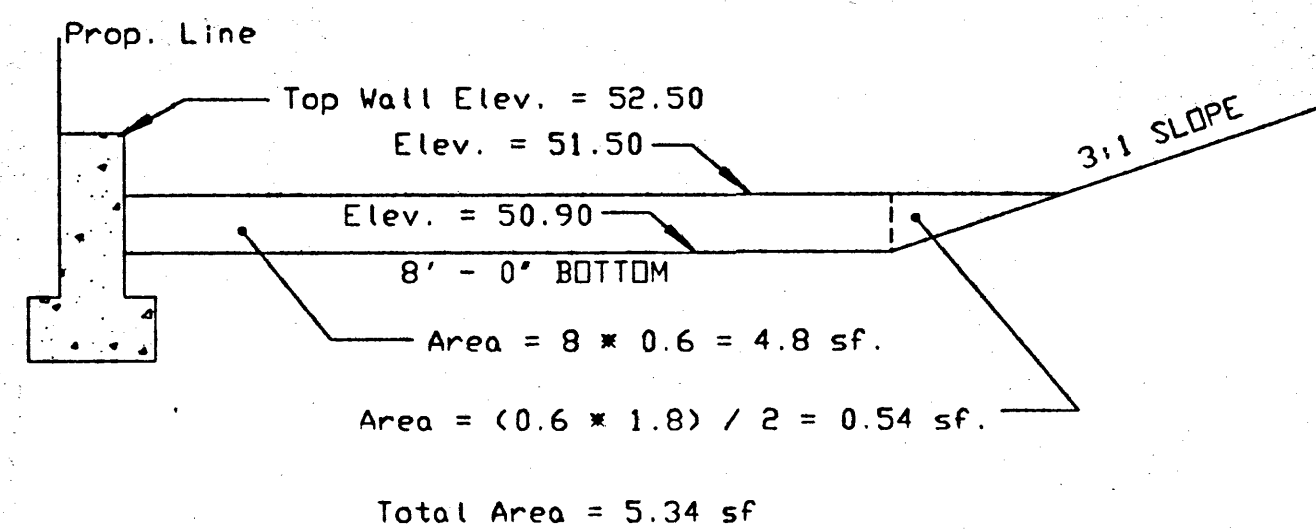

Sedimentation Basin.

Area = 15 \* 15 \* 1.5 = 337 CF.

TOTAL ACTUAL POND VOLUME:  $V = 43 + 880 + 337 = 1260$  CF > 1220 CF.

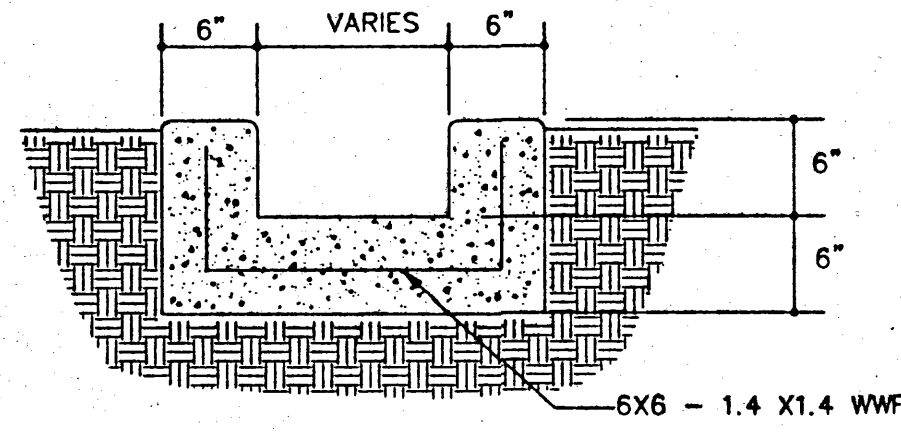

CONCRETE CHANNEL DETAIL  
1" = 1'-0"

POND POSITIVE DISCHARGE:

Design  $Q = 4.45$  cfs. It is desirable to use a number of small diameter pipes rather than one large one. Use Orifice Equation,  $Q = CA(2GH)^{1/2}$   $C = 0.6$   $A = 0.0855$  sf for 4" dia. PVC.  
 $H = 1.17'$  (Vert. dist. between spillway and center of pipe).

$Q = 0.6 * 0.0855 * (2 * 32.16 * 1.17)^{1/2} = 0.445$  cfs.

Use 10 each 4" PVC pipes through concrete cutoff wall.

POND OVERFLOW SPILLWAY:

Use Weir Equation,  $Q = CLH^{3/2}$   $C = 3.0$   $L = 10.0'$   $H = 0.34'$  or approx. 4"

$Q = 3.0 * 10.0 * 0.34^{3/2} = 5.95$  cfs > 5.81 cfs.

FLOW AT ANALYSIS POINTS:

East side of Building No. 3 and East Parking Lot. (ANALYSIS POINT 1)

Treat. B = 0.0197 ac. Treat C = 0.0302 ac. Treat D = 0.1469 ac.

$Q = (0.0197 * 2.60 + 0.0302 * 3.45 + 0.1469 * 5.02) = 0.84$  cfs

Area South of Building No. 3: (ANALYSIS POINT 2)

Treat. B = 0.0241 ac. Treat D = 0.0478 ac.

$Q = (0.0241 * 2.60 + 0.0478 * 5.02) = 0.30$  cfs (Accum. Sum = 1.14 cfs.)

Area Between Ridges of Building No. 2 and Building No. 3: (ANALYSIS POINT 3)

Treat C = 0.0909 ac. Treat D = 0.2020 ac.

$Q = (0.0909 * 3.45 + 0.2020 * 5.02) = 1.33$  cfs If the landscaped area S. of the sidewalk is included,  $Q = 1.43$  cfs. (ANALYSIS POINT 3A) (Accum. Sum = 2.57 cfs)

Area in front of Building No. 2: (ANALYSIS POINT 4)

Treat. B = 0.0069 ac. Treat D = 0.0647 ac.

$Q = (0.0069 * 2.60 + 0.0647 * 5.02) = 0.34$  cfs (Accum. Sum = 2.91 cfs)

Area between Buildings No. 1 and No. 2 and W half of Building No. 2: (ANALYSIS POINT 5)

Treat C = 0.0559 ac. Treat D = 0.2515 ac

$Q = (0.0559 * 3.45 + 0.2515 * 5.02) = 1.46$  cfs (Accum. Sum = 4.37 cfs)

Area north of Building No. 1: (ANALYSIS POINT 6)

Treat C = 0.0379 ac. Treat D = 0.1010 ac

$Q = (0.0379 * 3.45 + 0.1010 * 5.02) = 0.64$  cfs (Accum. Sum = 5.01 cfs)

Area west of Building No. 1: (ANALYSIS POINT IS POND)

Treat C = 0.0725 ac.  $Q = 0.0725 * 3.45 = 0.25$  cfs

Area South of Building No. 1: (ANALYSIS POINT IS POND)

Treat. C = 0.0126 ac. Treat D = 0.1010 ac.

$Q = (0.0126 * 3.45 + 0.1010 * 5.02) = 0.55$  cfs (Accum. Sum = 5.81 cfs)

CHANNEL FLOW:

CHANNEL NO. 1 Channel at SE corner of Building No. 3

$Q = 0.84$  (Design Flow)  $Q = CLH^{3/2}$   $L = 2 / (CH^{3/2})$   $C = 3.0$

$H = 0.4'$   $L = 0.84 / (3.0 * 0.4^{3/2}) = 1.10$  Use 1.5'

Check Capacity by Manning's Equation.  $Q = A(1.486/N)R^{2/3}S^{1/2}$

$N = 0.013$   $S = 0.0020$  ft/ft  $A = 0.4 * 1.5 = 0.6$  sf.  $P = 2.3'$

$R = A/P = 0.26$   $Q = 0.6(1.486/0.013)(0.26)^{2/3}(0.002)^{1/2} = 1.25$  cfs.

CHANNEL NO. 2:

Channel between Building No. 2 and Building No. 3, east end.

$Q = 1.23$  cfs Based on calcs for Channel No. 1, 1.5' is adequate.

CHANNEL NO. 3:

Channel between Building No. 2 and Building No. 3, w/ SW culvert.

$Q = 1.33$  cfs Based on calcs for Channel No. 1, 2.0' is adequate.

CHANNEL NO. 4:

Channel between Building No. 2 and Building No. 3, West of Junction.

$Q = 2.57$  cfs Use Manning's Equation. Try 2.0' Channel,

Flow Depth = 0.45  $A = 0.9$  sf  $P = 2.9'$   $R = 0.31$

$Q = 0.9(1.486 / 0.013)(0.31)^{2/3}(0.005)^{1/2} = 3.33$  cfs (Adequate).

CHANNEL NO. 5:

Channel near SW corner of Building No. 2.  $Q = 2.91$  cfs.

Based on Calcs. for Channel No. 4, 2.0' Channel is Adequate.


CHANNEL NO. 6:

North side of Building No. 1.  $Q = 5.01$  cfs.  $D = 0.9'$


Use Manning's Equation. V-shaped Channel with 3:1 side slopes.

$A = 2.43$   $P = 5.69'$   $R = 0.43$   $N = 0.023$  (Gravel).


$Q = 2.43(1.486 / 0.023)(0.43)^{2/3}(0.0050)^{1/2} = 6.32$  cfs > 5.01 cfs.

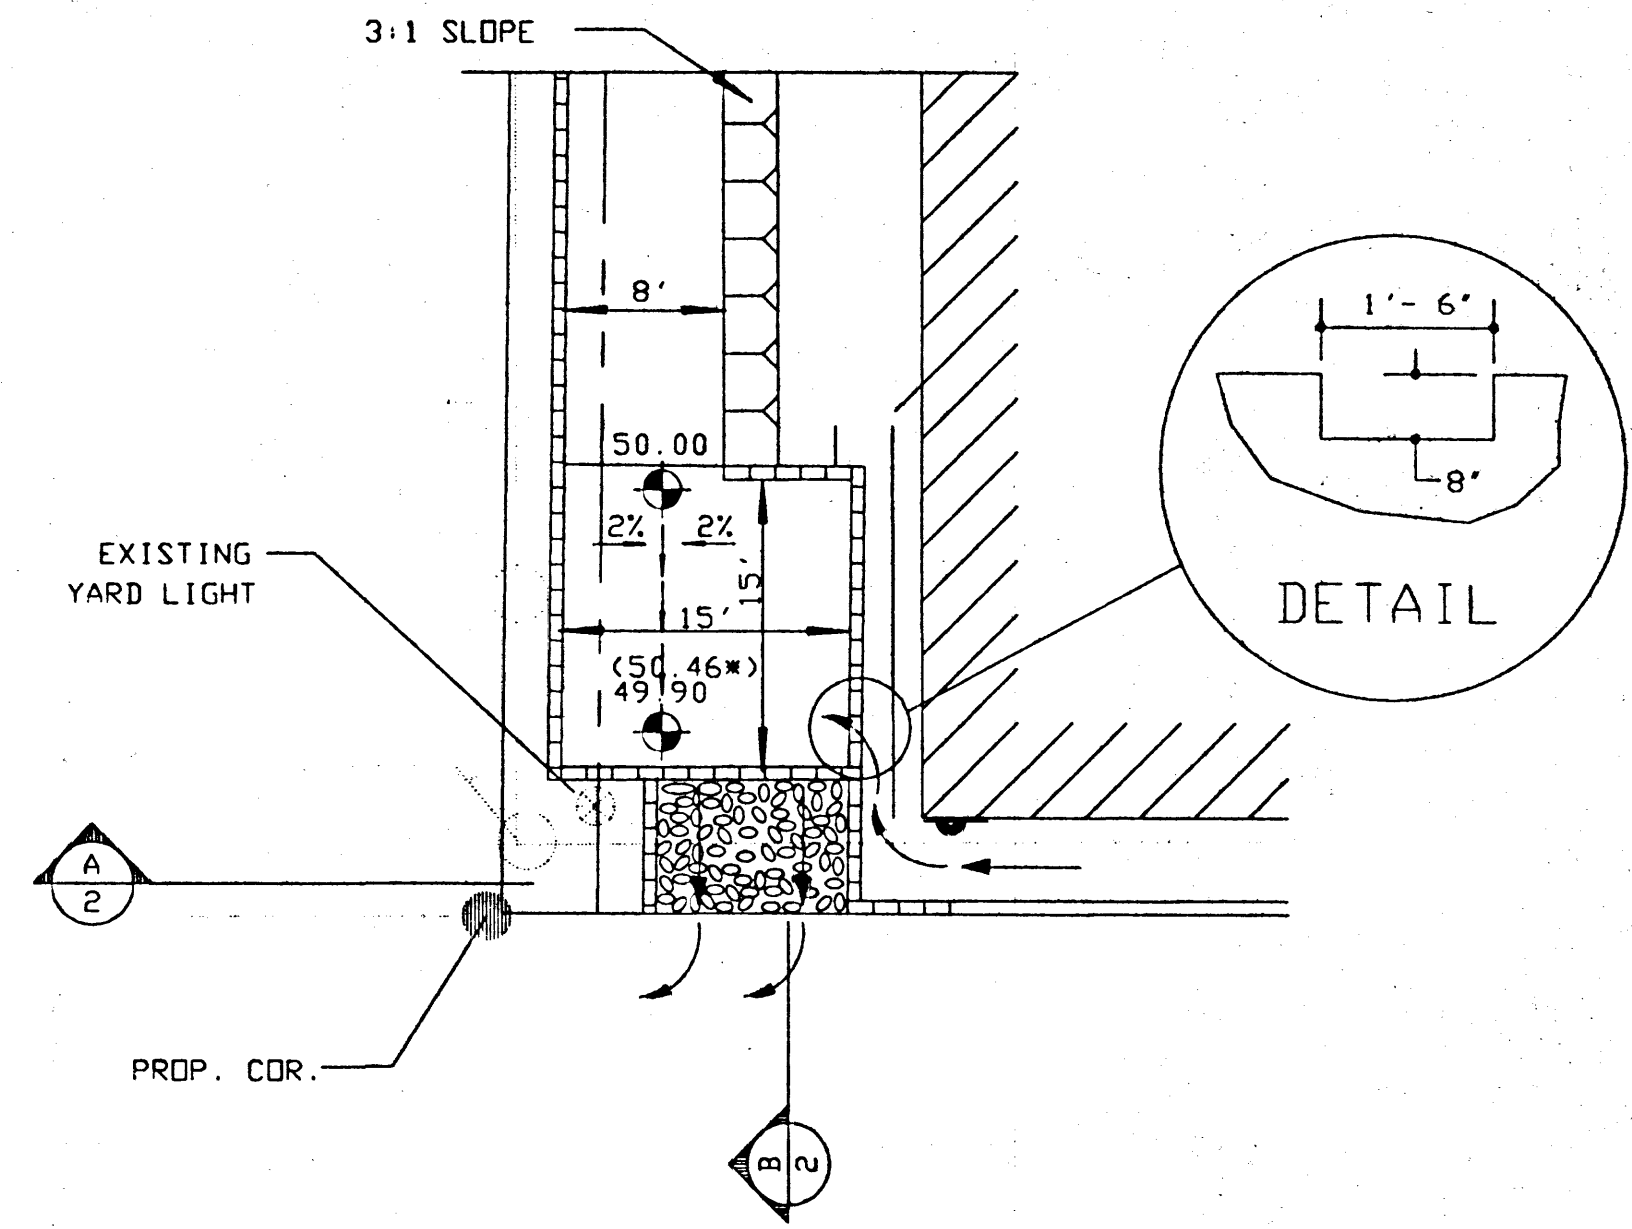

SEDIMENTATION BASIN AND POND DISCHARGE STRUCTURE DETAIL

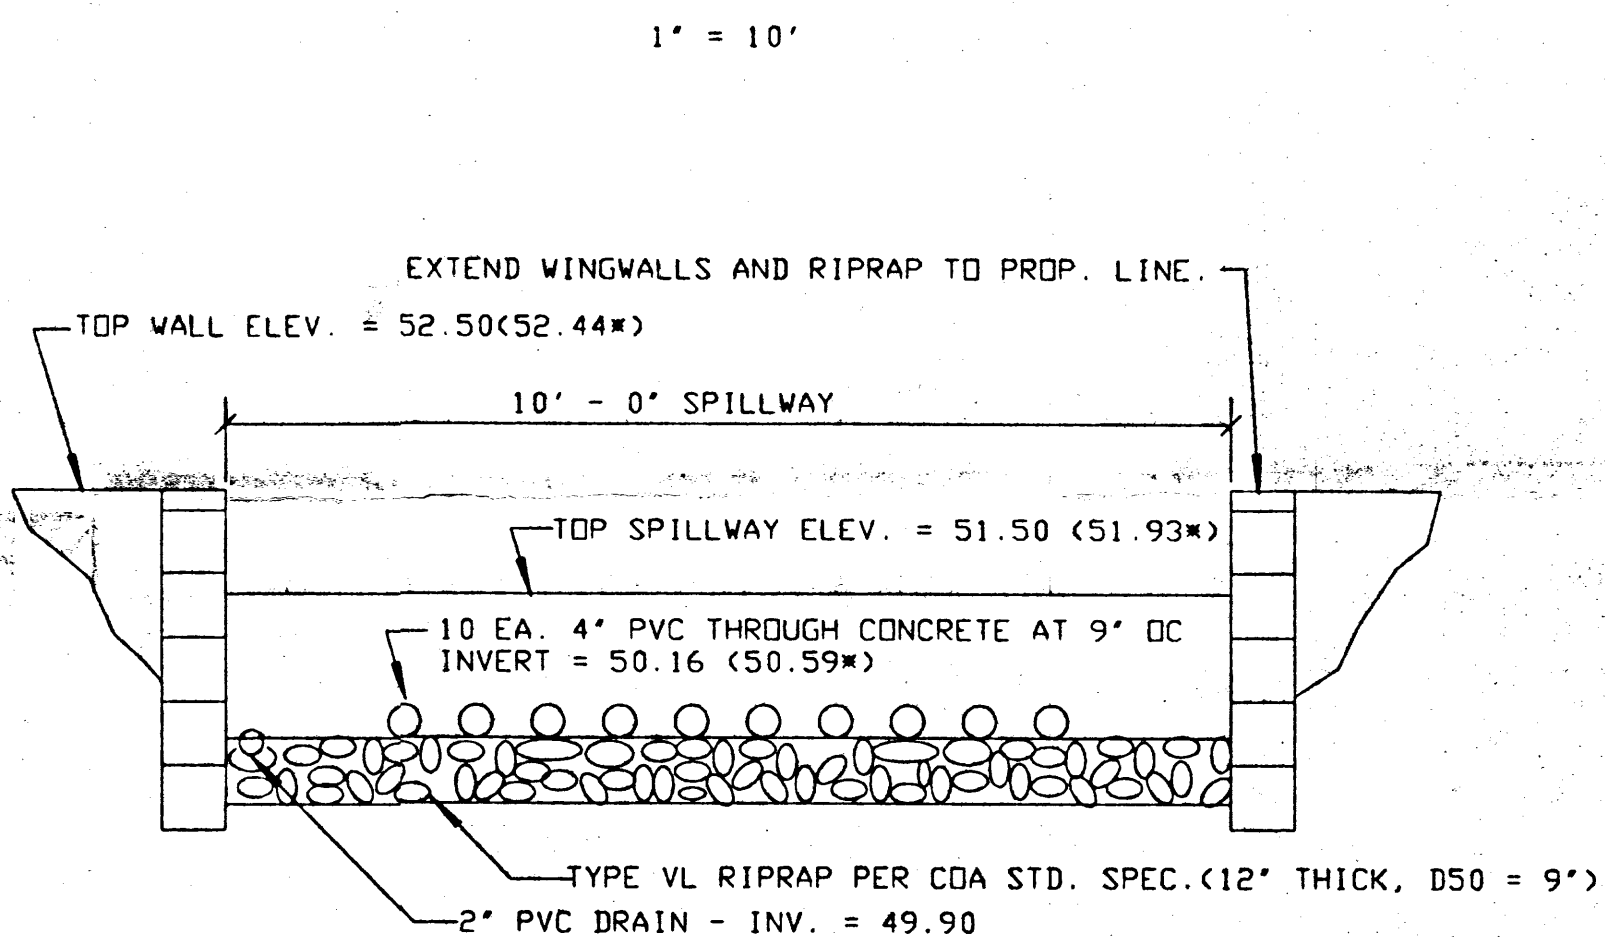

SECTION A - A SPILLWAY ELEVATION

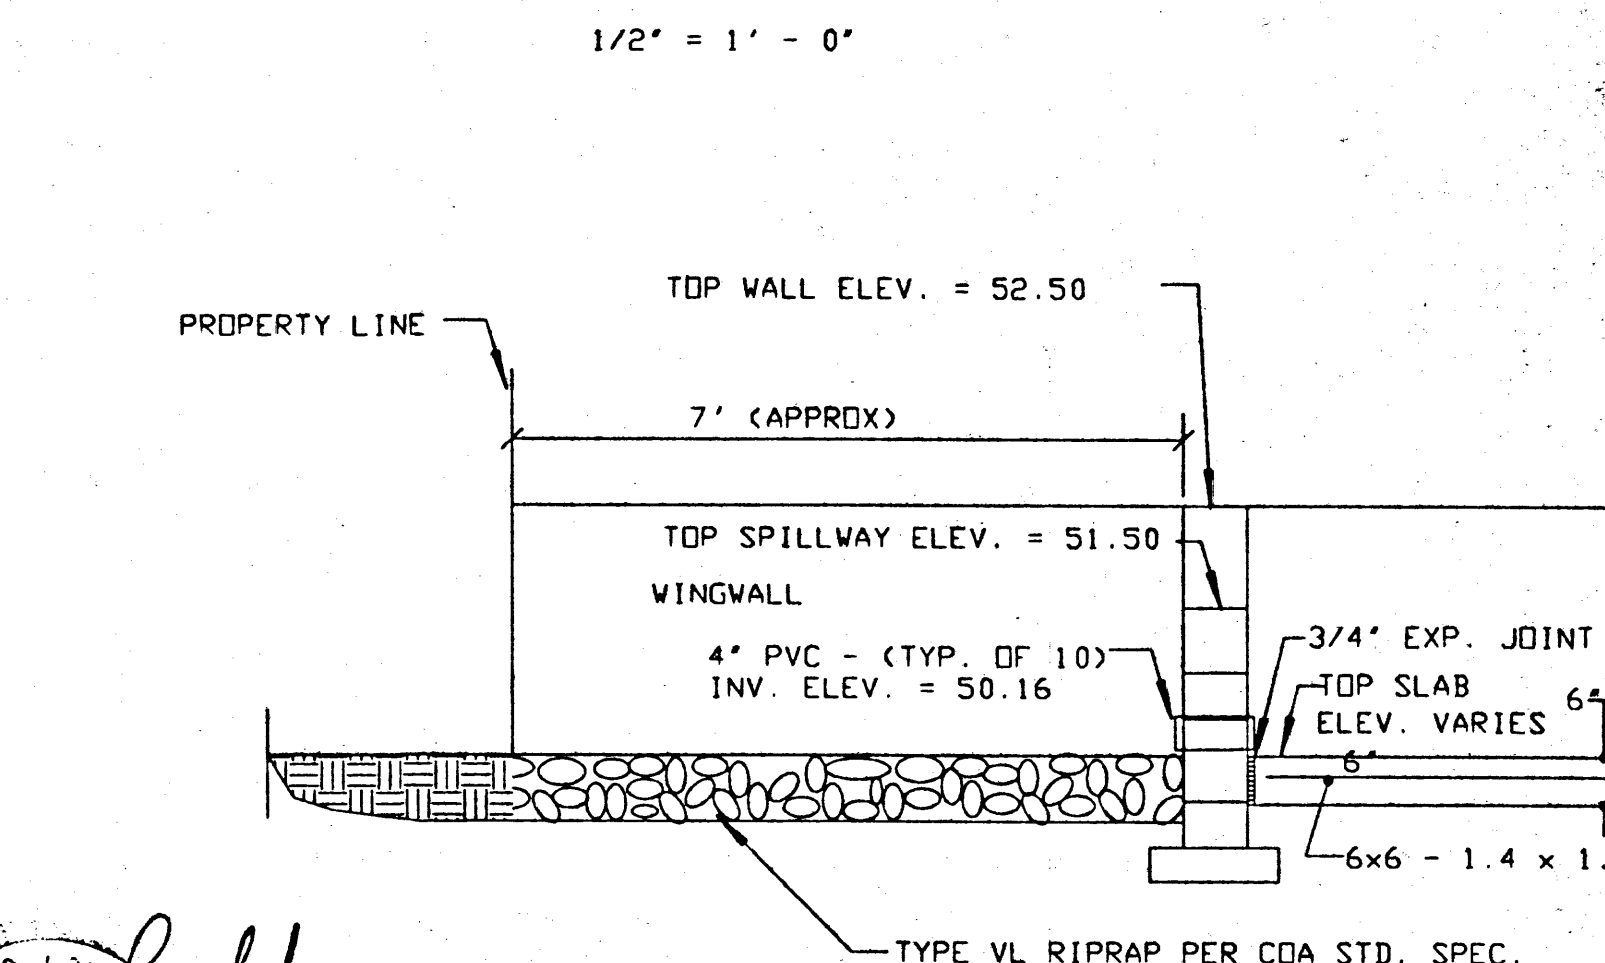

SECTION B - B SPILLWAY SECTION

FRANK D. LOVELADY, P.E.  
300 ALAMOSA ROAD NW  
ALBUQUERQUE, NEW MEXICO 87107  
(505)345-2267

Designed	FDL	Drawn	FDL	Checked	FDL	Scale	1" = 20'	Date	JUNE, 1997	Job No.	529	SHEET	2
												OF	2



# KEYED NOTES:

1. NEW ASPHALT PAVEMENT.
2. NEW 6" CONCRETE CURB.
3. 6' WIDE CONCRETE SIDEWALK.
4. ROOF SLOPE.
5. 4' x 4' CONCRETE STOOP.
6. OVERHEAD DOOR.
7. REFUSE ENCLOSURE.
8. EXIST. STD. CURB & GUTTER.
9. EDGE EXIST. ASPHALT PVM'NT.
10. DRAINAGE SWALE.
11. 2' - 0" SIDEWALK CULVERT PER C.D.A. STD. DWG. 2236.
12. 1' - 0" CURB OPENING FOR DRAINAGE.
13. 1' - 6" DRAINAGE CHANNEL (SEE DETAIL).
14. 2' - 0" DRAINAGE CHANNEL (SEE DETAIL).
15. SEDIMENTATION BASIN AND POND OUTFALL STRUCTURE. (SEE DETAIL, SHEET 2).
16. 4" PIPE THROUGH CURB PER C.D.A. STD. DWG. 2235.
17. DOWNSPOUT (TYP. OF 4 EACH SIDE).
18. 2' x 6' CONCRETE SPLASH PAD.
19. CMU CUTOFF WALL. TOP WALL EL. = 52.50

## GENERAL NOTES:


1. ADD 5400 TO SPOT ELEVATIONS TO SHOW TRUE ELEVATION.
2. CONTOUR INTERVAL IS ONE (1) FOOT.
3. ELEVATIONS SHOWN ARE BASED ON ACS STATION "SUSAN", WITH AN ELEVATION OF 5444.49.

## LEGAL DESCRIPTION:

LOT NUMBERED TEN-A (10-A) IN BLOCK NUMBERED FIFTY-TWO AND FIFTY THREE (52 & 53) SKYLINE HEIGHTS SUBDIVISION, CITY OF ALBUQUERQUE, BERNALILLO COUNTY, NEW MEXICO.


## NOTE:

UTILITIES SHOWN HEREON ARE IN THEIR APPROXIMATE LOCATION BASED ONLY ON ABOVE GROUND EVIDENCE FOUND IN THE FIELD AND AS-BUILT INFORMATION PROVIDED BY THE CLIENT. UTILITIES SHOWN HEREON, WHETHER INDICATED AS ABANDONED OR NOT, SHALL BE VERIFIED BY OTHERS FOR EXACT LOCATION AND/OR DEPTH PRIOR TO EXCAVATION OR DESIGN CONSIDERATIONS.

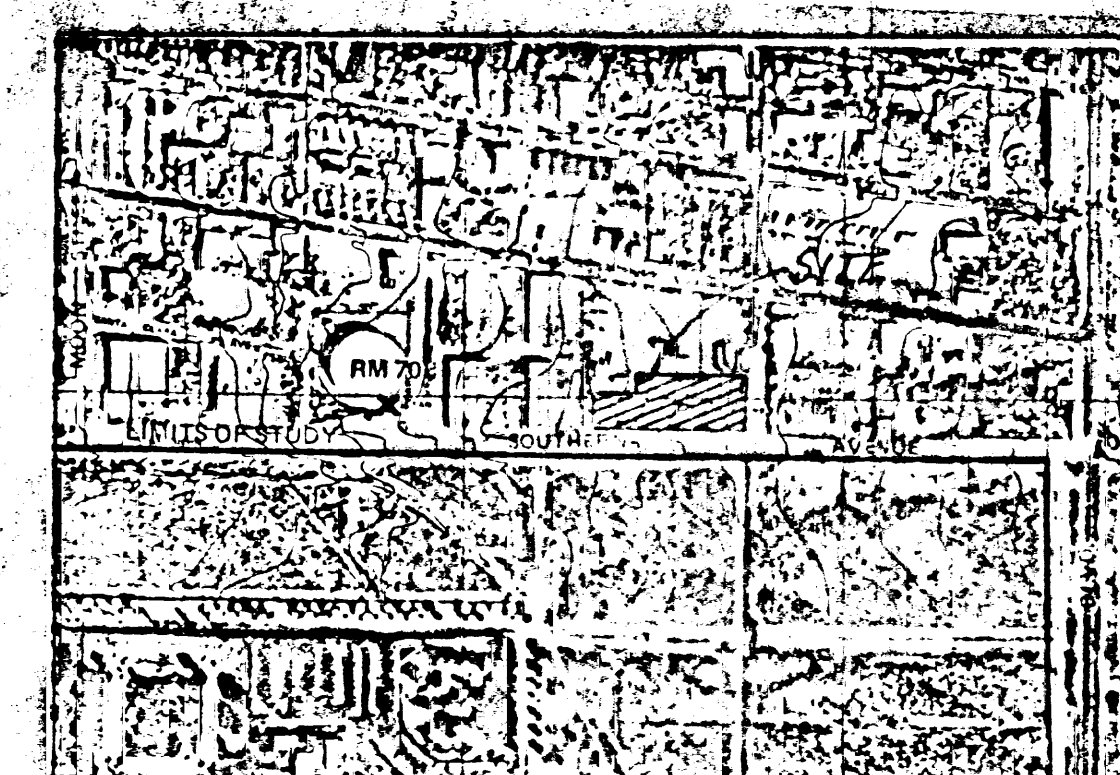

FLOODWAY MAP

PANEL 36 OF 50

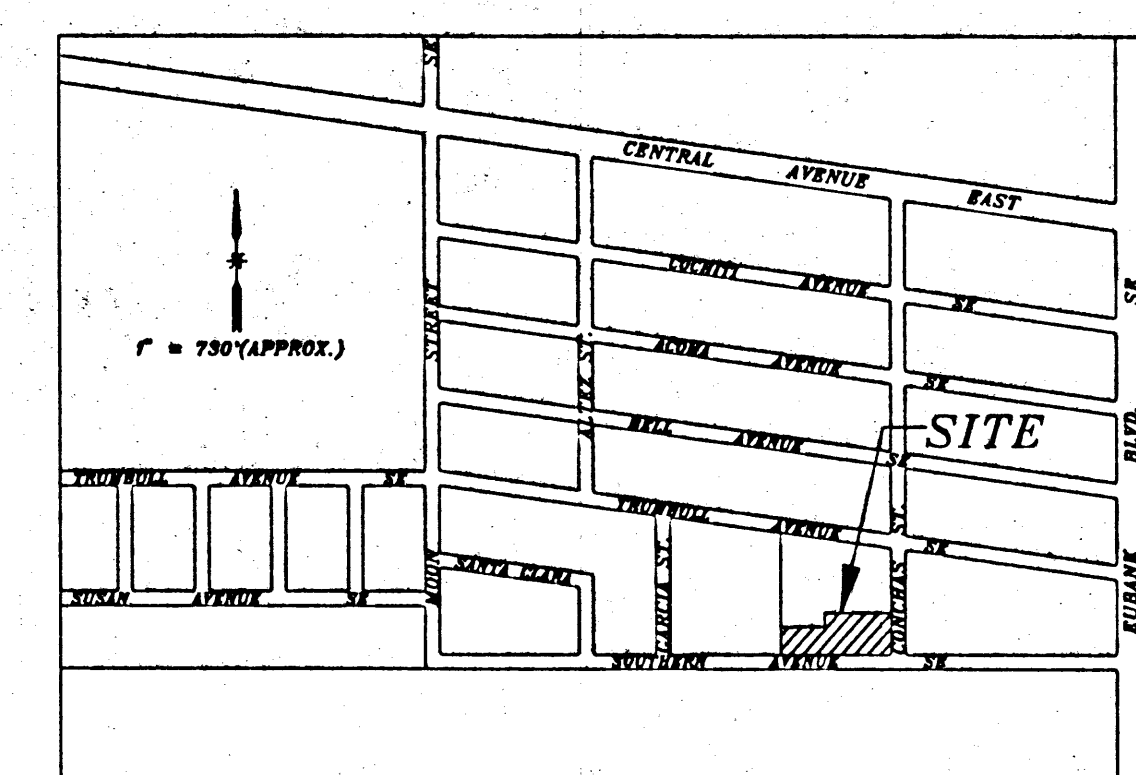



VICINITY MAP

ZONE ATLAS NO. L-20-Z


## LEGEND:

- 51.31 EXISTING SPOT ELEVATION
- 50.0 NEW SPOT ELEVATION
- 5452 EXISTING CONTOUR
- 51 NEW CONTOUR

SCALE: 1" = 20'

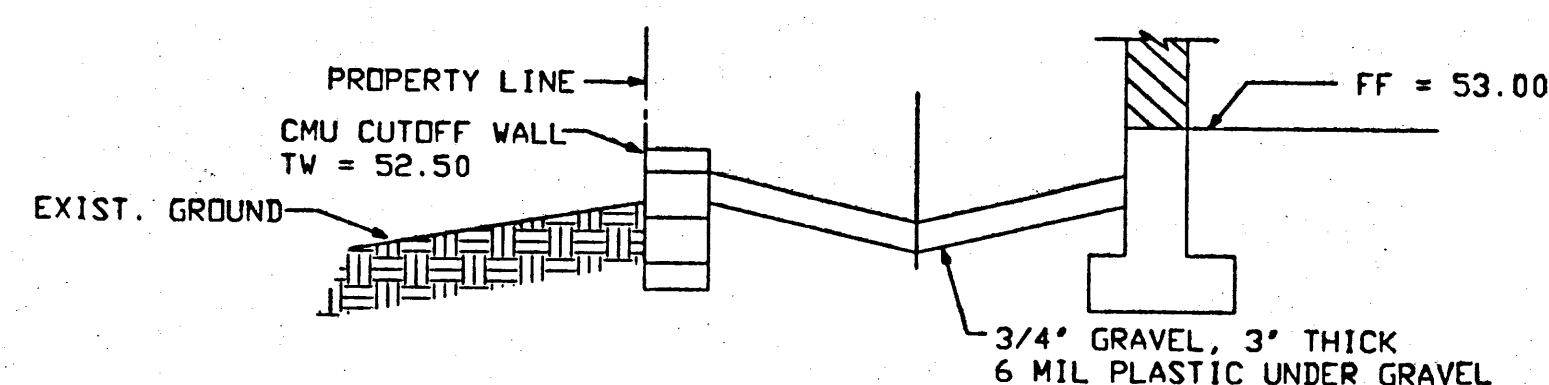
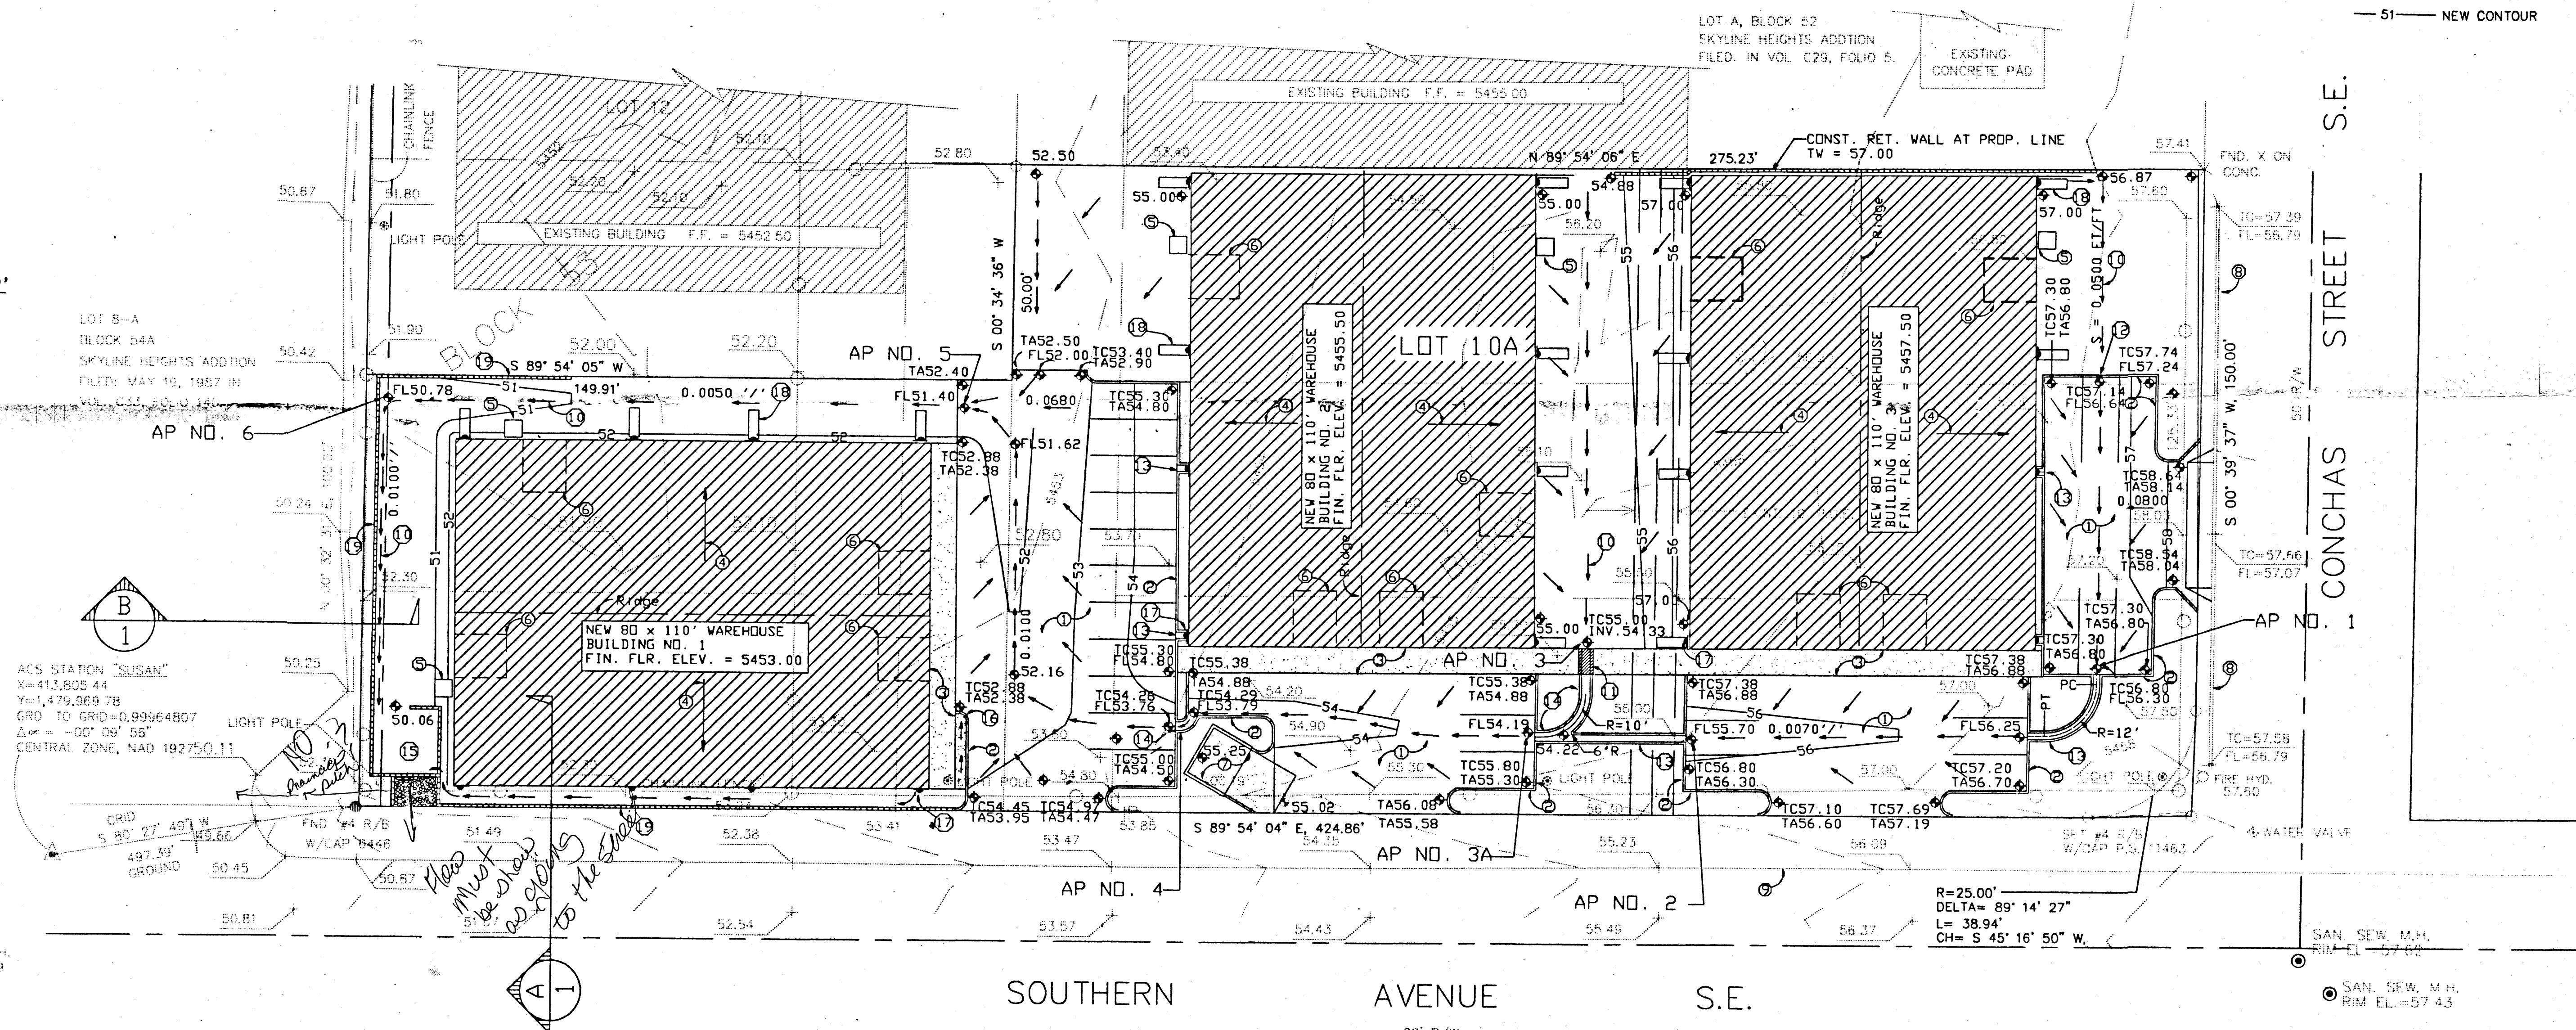


SECTION A-A SWALE  
1" = 2' - 0"

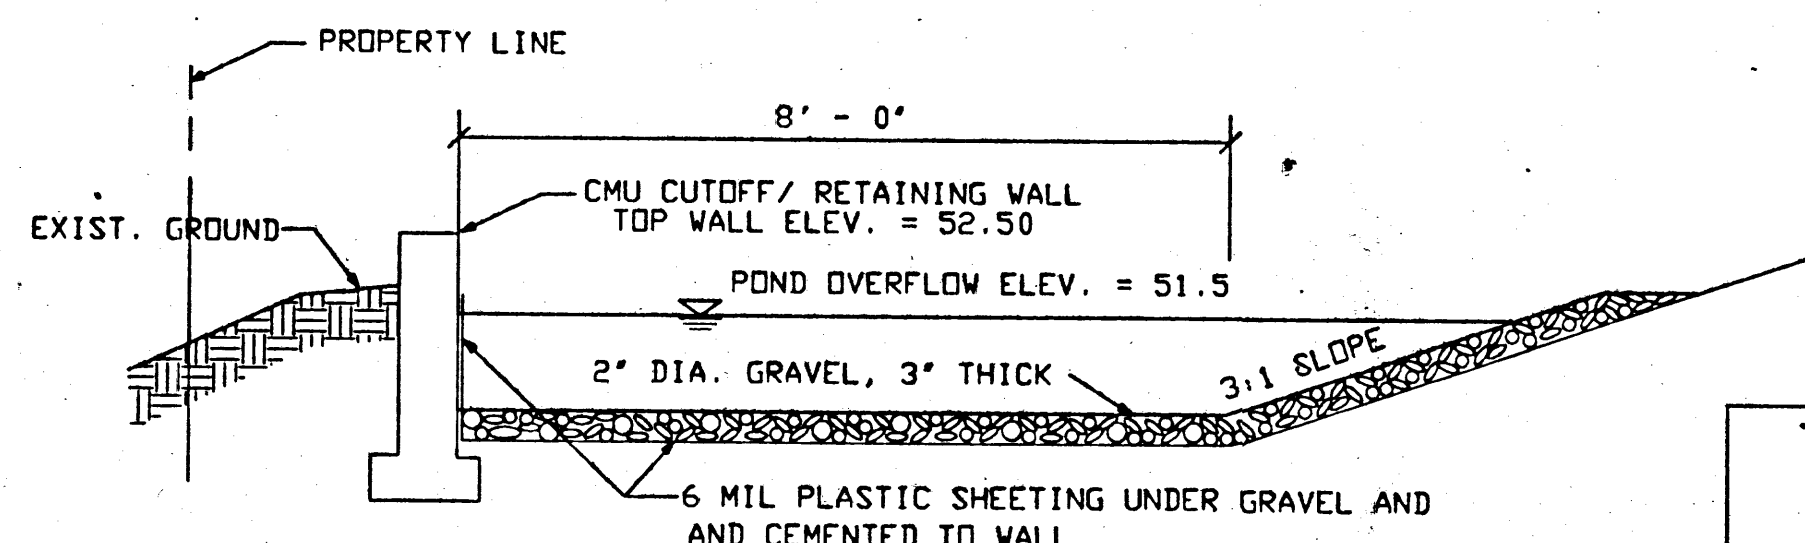

SECTION B-B DETENTION POND  
1" = 2' - 0"

<b>FRANK D. LOVELADY, P.E.</b> 300 ALAMOSA ROAD NW ALBUQUERQUE, NEW MEXICO 87107 (505)345-2267			GRADING AND DRAINAGE PLAN 3 UNIT WAREHOUSING LOT 10A, BLOCK 52 & 53 SKYLINE HEIGHTS SUBDIVISION ALBUQUERQUE, NEW MEXICO		
Designed	FDL	Drawn	FDL	Checked	FDL
Scale	1" = 20'	Date	AUGUST, 1996	Job No.	529

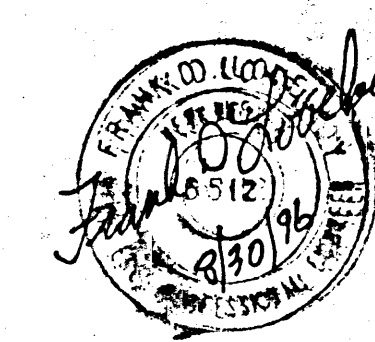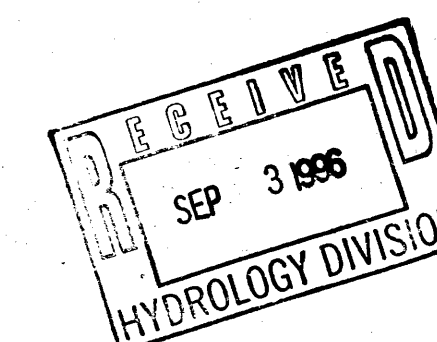


BUZZARDI.DWG(8/30/96)

TOPOGRAPHIC SURVEY PREPARED BY:  
**WES** SURVEYING, INC.  
 11219 BURTON STREET, N.E.  
 ALBUQUERQUE, NEW MEXICO 87111  
 PHONE: (505) 889-0058  
 FAX: (505) 889-0055



TRUMBULL

AVENUE S.E.

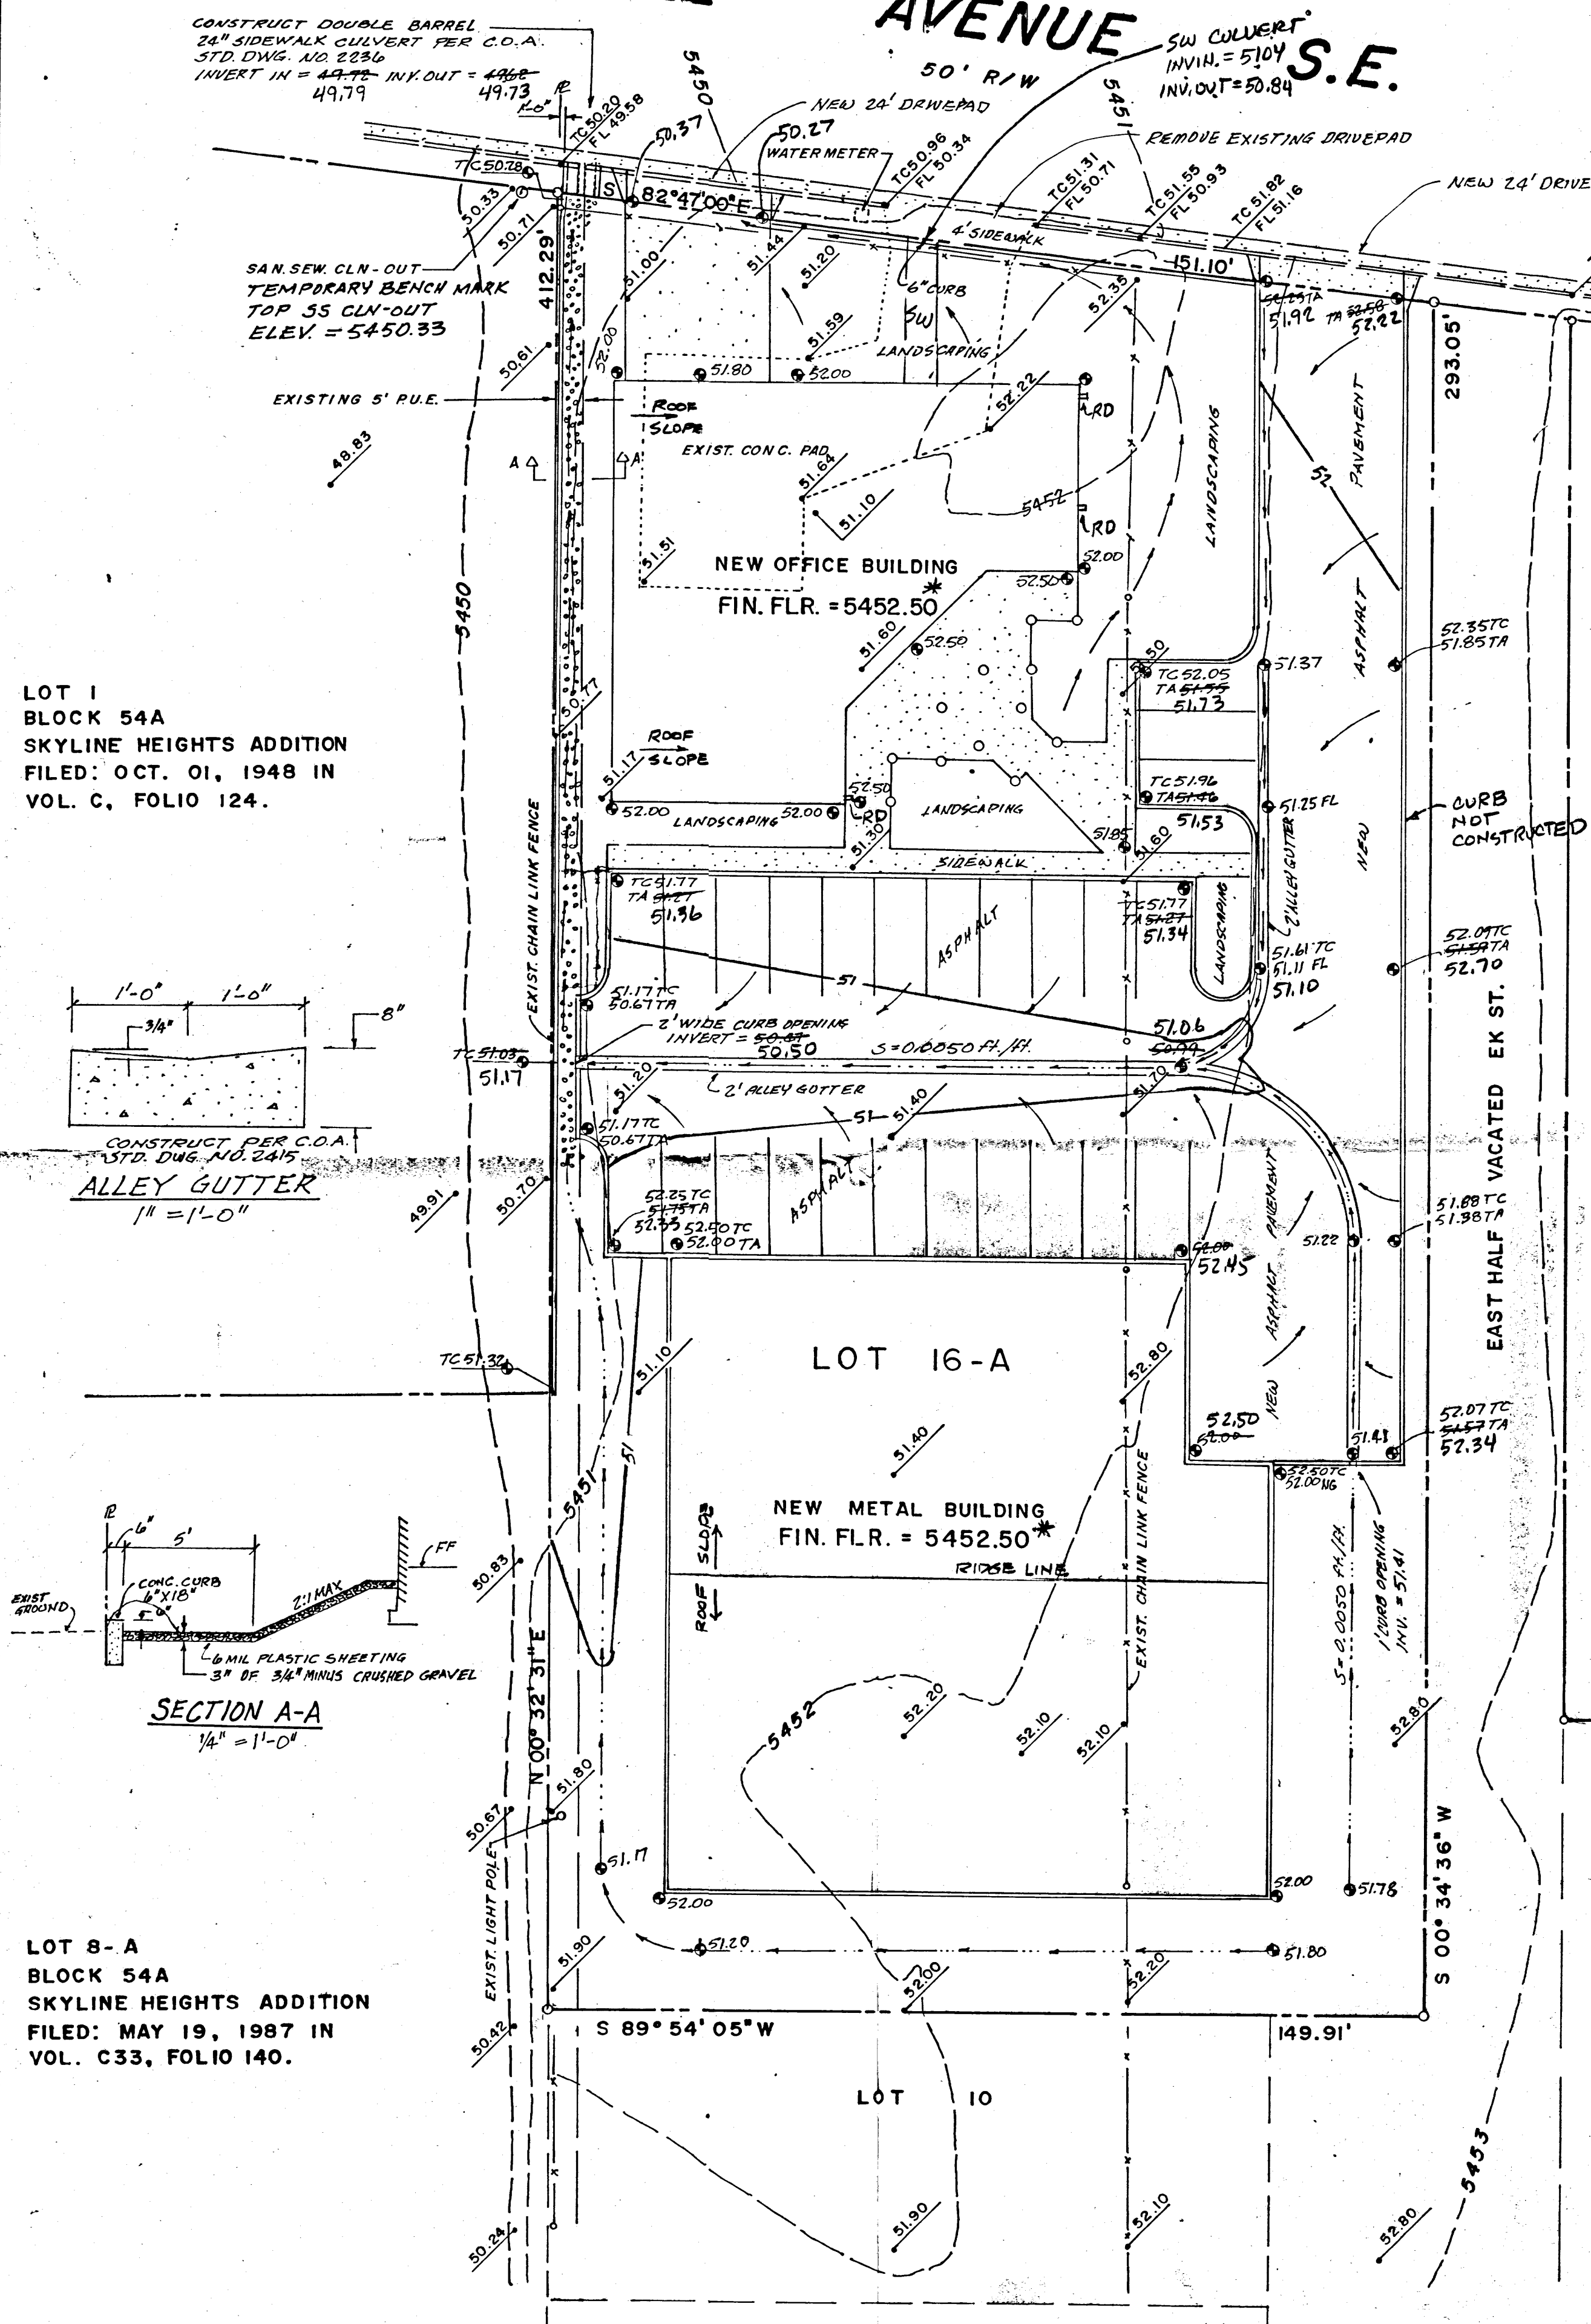

LEGEND

SYMBOL	DESCRIPTION
52.23	EXISTING SPOT ELEVATION
52.23	AS CONSTRUCTED SPOT ELEV SHOWN THUS
5452	EXISTING CONTOUR
52	NEW CONTOUR
---	PROPERTY LINE
---	SWALE
---	SHEET FLOW
TC	TOP OF CURB
TA	TOP OF ASPHALT
*	FIN. FLR. GRADE VERIFIED

CITY OF ALBUQUERQUE  
DRAINAGE FACILITIES WITHIN CITY RIGHT-OF-WAY (S.O. 19)  
NOTICE TO CONTRACTORS

- AN EXCAVATION/CONSTRUCTION PERMIT WILL BE REQUIRED BEFORE BEGINNING ANY WORK WITHIN CITY RIGHT-OF-WAY. AN APPROVED COPY OF THESE PLANS MUST BE SUBMITTED AT THE TIME OF APPLICATION FOR THIS PERMIT.
- ALL WORK DETAILED ON THIS PLAN TO BE PERFORMED UNDER CONTRACT, EXCEPT AS STATED OR PROVIDED FOR HEREON, SHALL BE CONSTRUCTED IN ACCORDANCE WITH STANDARD SPECIFICATIONS FOR PUBLIC WORKS CONSTRUCTION, 1988, AS REVISED.
- TWO (2) WORKING DAYS PRIOR TO ANY EXCAVATION, CONTRACTOR MUST CONTACT NEW MEXICO ONE CALL SYSTEM, INC., 280-1990, FOR LOCATION OF EXISTING UTILITIES.
- PRIOR TO CONSTRUCTION, THE CONTRACTOR SHALL EXCAVATE AND VERIFY THE HORIZONTAL AND VERTICAL LOCATIONS OF ALL OBSTRUCTIONS. SHOULD A CONFLICT EXIST, THE CONTRACTOR SHALL NOTIFY THE ENGINEER SO THAT THE CONFLICT CAN BE RESOLVED WITH A MINIMUM AMOUNT OF DELAY.
- BACKFILL COMPACTION SHALL BE ACCORDING TO RESIDENTIAL STREET USE.
- MAINTENANCE OF THESE FACILITIES SHALL BE THE RESPONSIBILITY OF THE OWNER OF THE PROPERTY SERVED.
- THE ADDRESS OF THE PROPERTY SERVED IS TRUMBULL AVENUE, N.E.



APPROVALS:			
HYDROLOGY	NAME	DATE	
INSPECTOR	NAME	DATE	
CONSTRUCTION	NAME	DATE	

ENGINEER'S CERTIFICATION:

Having performed an on-site inspection of the as-constructed facilities, and having made revisions including as-constructed elevations based on actual survey data provided by Harris Surveying Company, Inc., I hereby certify that the as-constructed facilities are in substantial conformance with the approved grading and drainage plan, Engineer's stamp dated 9/29/95, and revised 10/18/95.

Frank D. Lovelady, N.M.P.E. 6512

3-11-97 (Date)

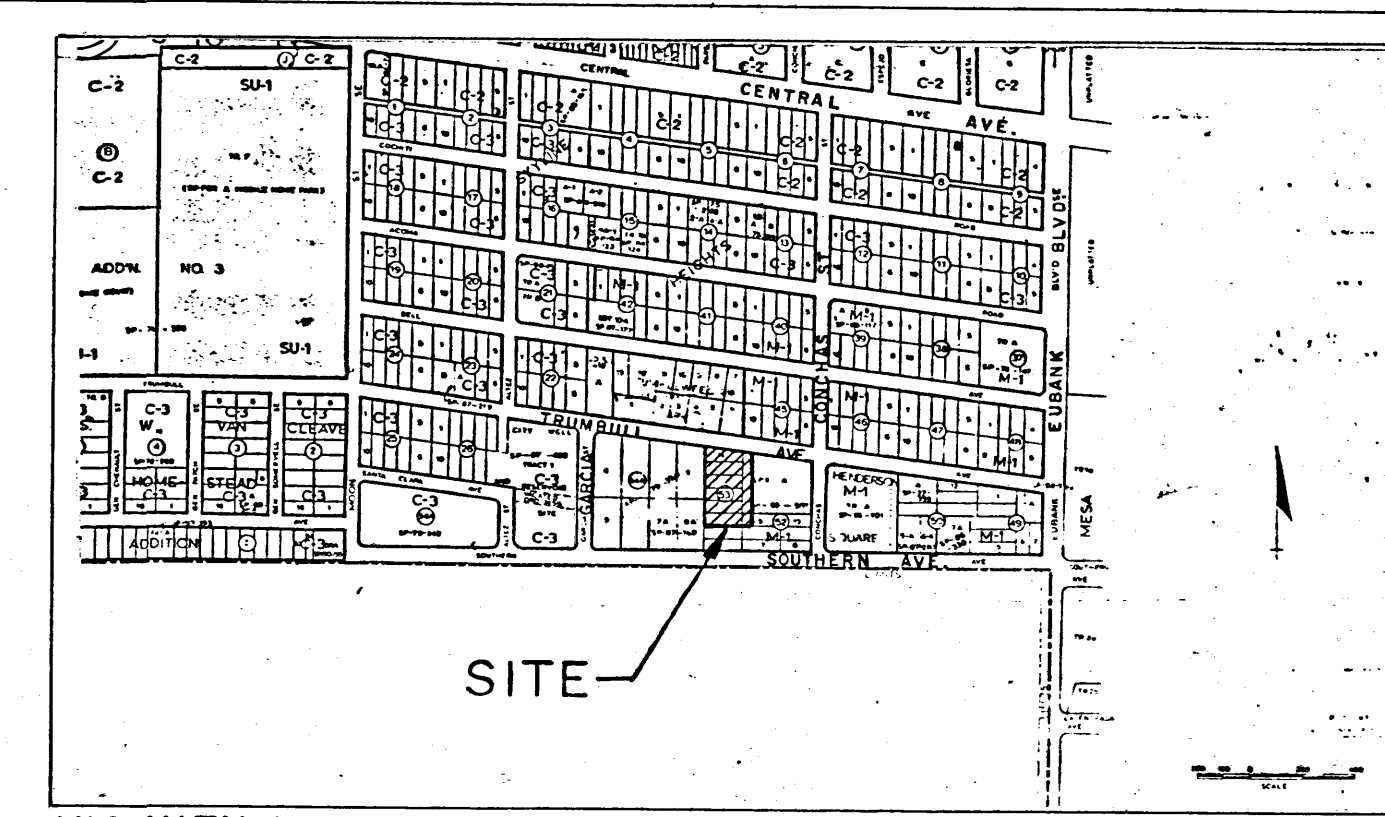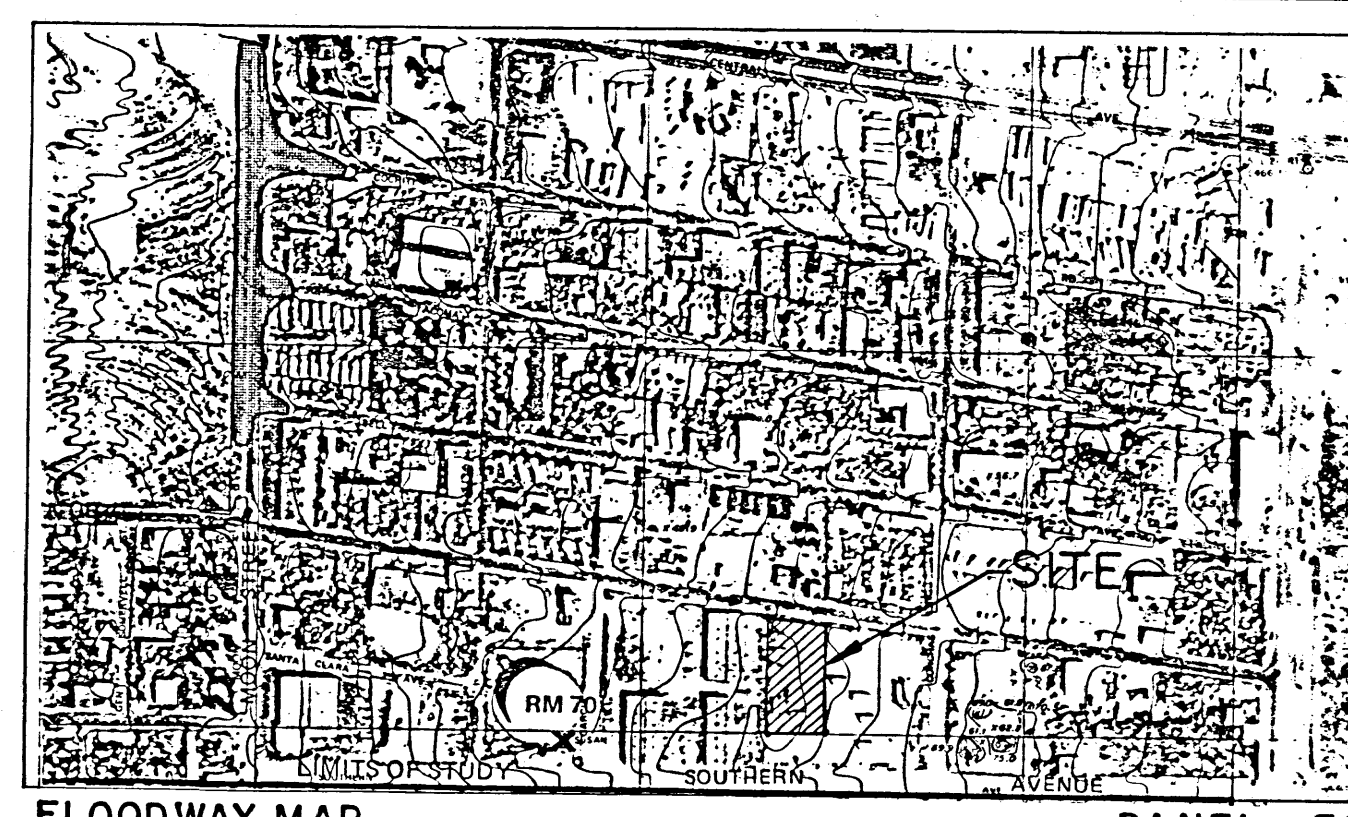

EXISTING CONDITIONS:

The site is located on Trumbull Avenue 1,200 feet west of Eubank Boulevard, S.E. The area in which the site is located is presently developed as light industrial. The terrain slopes gently from east to west. Trumbull Avenue is paved with standard curb and gutter. The lot to the east, Lot A, Block 52, is developed with all runoff leaving the lot by a 4" PVC pipe through the curb into Trumbull Avenue, so there is no off-site flow from this lot. The site does not lie within a designated flood hazard zone. There is, however, a flood zone downstream from the site which is a result of an inadequately sized storm drain line in Moon Street. A parallel 54" diameter wash line was constructed to drain the City of Albuquerque reservoir at Garcia and Southern. This line also has inlets in Moon Street which increases the capacity of the Moon Street storm drain. However, no map revision has been done so the flood hazard area in Moon Street is still considered to exist.

PROPOSED CONDITIONS:

It is proposed to develop the site as shown on the grading plan.

DRAINAGE CRITERIA:

The calculations shown on this plan were prepared in accordance with Section 22.2, Hydrology, of the Development Process Manual, Volume 2, Design Criteria, for the City of Albuquerque in cooperation with Bernalillo County, New Mexico and the Albuquerque Metropolitan Arroyo Flood Control Authority, January 1993.

PRECIPITATION ZONE:

The site is east of S Mateo Boulevard but west of Eubank Boulevard and is, therefore, in Precipitation Zone 3.

PEAK DISCHARGE PER ACRE, EXCESS PRECIPITATION AND AREAS:

Treatment	100-yr	10-yr	100-yr	10-yr	%	Ex. Site Areas	%	Devel. Site Areas	%	Land	%
A	1.87	0.58	0.66	0.19	0.0	0.0	0.0	0.0	0.0	0.0	0.0
B	2.60	1.19	0.92	0.36	0.0	0.0	12.9	5.813	0.133		
C	3.45	2.00	1.29	0.62	95.4	43.007	0.987	18.5	8.344	0.192	
D	5.02	3.39	2.39	1.50	4.6	2.075	0.048	68.6	30.925	0.710	
Totals					100.0	45.082	1.035	100.0	45.082	1.035	

WEIGHTED UNIT PEAK DISCHARGE VALUES:

Existing	Q <sub>W100</sub> = 0.954 X 3.45 + 0.046 X 5.02 = 3.52 cfs/acre
	Q <sub>W10</sub> = 0.954 X 2.00 + 0.046 X 3.39 = 2.06 cfs/acre
Developed	Q <sub>W100</sub> = 0.129 X 2.60 + 0.185 X 3.45 + 0.686 X 5.02 = 4.42 cfs/acre
	Q <sub>W10</sub> = 0.129 X 1.19 + 0.185 X 2.00 + 0.686 X 3.39 = 2.85 cfs/acre

CONSTRUCTION NOTES:

- THIS PLAN SHOWS ELEVATIONS AND DISPOSITION OF STORM WATER RUNOFF ONLY. NO DIMENSIONS ARE SHOWN ON THE PLAN. FOR DIMENSIONS OF BUILDING AND PARKING LAYOUT, SEE ARCHITECTURAL SITE PLAN.
- PRIOR TO CONSTRUCTION, THE CONTRACTOR SHALL EXCAVATE AND VERIFY THE HORIZONTAL AND VERTICAL LOCATION OF ALL POTENTIAL OBSTRUCTIONS. SHOULD A CONFLICT EXIST, THE CONTRACTOR SHALL NOTIFY THE ENGINEER SO THAT THE CONFLICT CAN BE RESOLVED WITH A MINIMUM AMOUNT OF DELAY.
- ALL WORK ON THIS PROJECT SHALL BE PERFORMED IN ACCORDANCE WITH APPLICABLE FEDERAL, STATE AND LOCAL LAWS, RULES AND REGULATIONS CONCERNING CONSTRUCTION SAFETY AND HEALTH.

LEGAL DESCRIPTION:

Present Legal Description:  
All of Lots 11 through 16, Block 53 of Skyline Heights Addition together with the west half (W 1/2) of vacated EK Street per quit claim deed filed March 04, 1960 in book D530, Page 551

Legal Description Upon Completion of Replat:  
Lot 16-A, Block 53 of Skyline Heights Addition

Revised 9/14/96 Revised 3/11/97

FRANK D. LOVELADY, P.E.  
300 ALAMOSA ROAD N.W.  
ALBUQUERQUE, N.M. 87107  
(505) 345-2267

Designed: F.D.L. Drawn: STAFF Checked: F.D.L. Scale: 1"=20' Date: 9/95 Job No. 500

WEIGHTED EXCESS PRECIPITATION:

Existing	E <sub>W100</sub> = 0.959 X 1.29 + 0.046 X 2.36 = 1.34 in.
	E <sub>W10</sub> = 0.959 X 0.62 + 0.046 X 1.50 = 0.66 in.
Developed	E <sub>W100</sub> = 0.129 X 0.92 + 0.185 X 1.29 + 0.686 X 2.36 = 1.98 in.
	E <sub>W10</sub> = 0.129 X 0.36 + 0.185 X 0.62 + 0.686 X 1.50 = 1.19 in.

SUMMARY OF VOLUMES AND PEAK DISCHARGE RATES

	V100	V10	Q100	Q10
EXISTING	5,034	2,480	3.84	2.13
DEVELOPED	7,439	4,471	4.57	2.95
INCREASE	2,405	1,991	0.93	0.82

DOWNSTREAM CAPACITY:

The site will drain into Trumbull Avenue. Approximately 750' west of that point, at Altez Street, there are inlets on both sides of Trumbull Avenue. The inlet on the south side of the street will intercept flow from the site. Any flow passing these inlets will continue down Trumbull Avenue to Moon Street where there are 6 inlets in the intersection. This intersection is not actually in the Moon Street flood zone which begins just south of Bell Street. A 54" RCP storm drain line has been installed in Moon Street parallel to the existing 36" RCP storm drain line and the two lines are interconnected at manholes. The new line is a "wash" line for the City Reservoirs at Garcia and Trumbull. The distance from Altez Street to Eubank Boulevard is roughly 2,100 feet. The site is, therefore, in the lower 1/3 of the watershed and runoff from the site will have entered the storm sewer and passed the flood zone before peak flows arrive. Any continuation of the watershed east of Eubank Boulevard that may have existed will now be eliminated by the storm drain under construction in Eubank Blvd. The site is an infill site. For these reasons, unrestricted discharge is warranted for this site.

OFF-SITE FLOW:

The property south of the site is almost flat but does have some slope in a northwesterly direction. However, it appears to pass south of the SW corner of the site. Lot A to the east drains to Trumbull Street. An area of approximately 45' X 180' = 8,100 sq. ft. or 0.186 acres, may drain into the site just north of the SE corner. It is assumed that the peak discharge per acre is the same as was used for this site, or 4.42 cfs / acre. Q<sub>100</sub> = 4.42 X 0.186 = 0.82 cfs.

DRAINAGE CHANNEL CAPACITY:

Design Q = 4.57 cfs + 0.82 cfs - 0.45 cfs = 4.94 cfs (0.45 cfs drains directly to the street through the driveway. Use gravel-lined channel, 5.0' wide flat bottom with a concrete containment curb on the west side and a 2:1 gravel-lined side slope on the east side. Depth of flow = 5" A = 5.0 X 0.41 + (0.41 X 0.82)/2 = 2.22 sf P = 0.41 + 5.0 + (0.41^2 + 0.82^2)/2 = 6.33 ft. R^2 = A/P = 2.22 / 6.33 = 0.3507 N = 0.012 for concrete and 0.023 for gravel N<sub>w</sub> = (0.41 X 0.013 + 5.92 X 0.023)/6.33 = 0.022 V = (1.486 / 0.022) (0.3507)^0.58 (0.0050)^1/2 = 2.37 fps Q = AV = 2.22 X 2.37 = 5.26 cfs 5.26 cfs > 4.94 cfs (Adequate)

SIDEWALK CULVERT CAPACITY:

Design Q = 4.94 cfs Use 2 ea 2'-0" sidewalk culverts. Use Weir Equation Q = CLH^0.5 C = 3.0 L = 4 H = 0.58 (7") Q = 3.0 X 4 X (0.58)^3/2 = 5.30 cfs > 4.94 cfs (Adequate).



EROSION CONTROL REQUIREMENTS:

The contractor shall be responsible for compliance with the following:

- No sediment-bearing water shall be allowed to discharge from the site during construction.
- During grading operations and until the project has been completed, all adjacent property, rights-of-way, and easements shall be protected from flooding by runoff from the site.
- Should the contractor fail to prevent sediment-bearing water from entering public right-of-way, he shall promptly remove from the public right-of-way any and all sedimentation originating from the site.
- Control of sediment-bearing waters will be accomplished by use of a compacted earth berm of adequate height. The berm shall be located along the downstream perimeter of the property.

BENCH MARK:

Elevations shown are based on ACS Station 5444.49 Feet.

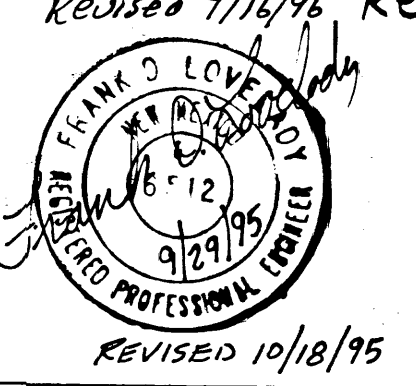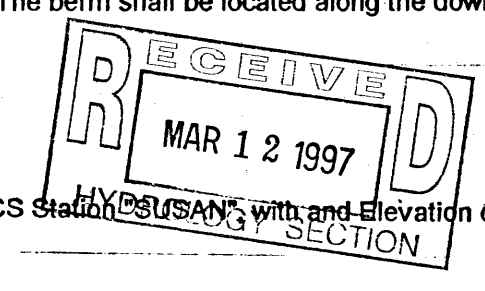

GRADING AND DRAINAGE PLAN  
OFFICE / WAREHOUSE COMPLEX FOR  
ALL-AMERICAN FOAM

SHEET  
OF  
1



# EXISTING CONDITIONS:

The site is located at the N.W. corner of the intersection of Southern Avenue and Conchas Street. Conchas Street is paved with standard curb and gutter. Southern Avenue is paved but without curb and gutter. Southern Avenue is in the corridor for Gibson Boulevard extension. Property north and west of the site is developed. The property to the north is developed as warehousing and property to the west is mini warehouse units with asphalt parking. The property slopes from east to west at an average slope of approximately 1.5 percent.

# PROPOSED CONDITIONS:

It is proposed to construct warehouses and asphalt parking on the site as shown. Due to the future construction of Gibson Boulevard, construction of curb and gutter on Southern Boulevard is not recommended at this time by Traffic Engineering. Due to downstream storm drainage improvements, and due to the fact that the site is an infill site, unrestricted discharge would otherwise be acceptable except for Southern Avenue being without curb and gutter. A detention pond is proposed to reduce developed discharge to the existing rate.

# DRAINAGE CRITERIA:

The calculations shown on this plan were prepared in accordance with Section 22.2, Hydrology, of the Development Process Manual, Volume 2, Design Criteria, for the City of Albuquerque, in cooperation with Bernalillo County, New Mexico and the Albuquerque Metropolitan Arroyo Flood Control Authority, January, 1993.

# PRECIPITATION ZONE:

The site is west of the Eubank Boulevard and is, therefore, in Precipitation Zone 3.

LAND TREATMENT	q(CFs/ac)		E (in)		Existing Site Areas		Developed Site Areas	
	100-yr.	10-yr.	100-yr.	10-yr.	%	Sa.Ft. Acres	%	Sa.Ft. Acres
A	1.87	0.58	0.66	0.19	0	0 0.0	0	0 0.0000
B	2.60	1.19	0.92	0.36	00.0	0 0.0000	8.0	4,458 0.1023
C	3.45	2.00	1.29	0.62	100.0	56,123 1.2884	20.0	11,241 0.2581
D	5.02	3.39	2.36	1.50	0.0	0 0.0000	72.0	40,424 0.9280
Totals					100.0	58,123 1.2884	100.0	56,123 1.2884

# PEAK DISCHARGE:

# EXISTING CONDITIONS:

Q100 = 1.2884 \* 3.45 = 4.45 cfs  
Q10 = 1.2884 \* 2.00 = 2.58 cfs

# DEVELOPED CONDITIONS:

Q100 = 0.1023 \* 2.60 + 0.2581 \* 3.45 + 0.9280 \* 5.02 = 5.81 cfs  
Q10 = 0.1023 \* 1.19 + 0.2581 \* 2.00 + 0.9280 \* 3.39 = 3.78 cfs

# VOLUME 100-YEAR, 6-HOUR:

# EXISTING CONDITIONS:

V100 = (56,123 \* 1.29)/12 = 6,033 CF  
V10 = (56,123 \* 0.62)/12 = 2,900 CF

# DEVELOPED CONDITIONS:

V100 = (4,458 \* 0.92 + 11,241 \* 1.29 + 40,424 \* 2.36)/12 = 9,500 CF  
V10 = (4,458 \* 0.36 + 11,241 \* 0.62 + 40,424 \* 1.50)/12 = 5,768 CF

# SUMMARY OF VOLUMES AND PEAK DISCHARGE RATES:

	V100	V10	Q100	Q10
EXISTING	6,033	2,900	4.45	2.58
DEVELOPED	9,500	5,768	5.81	3.78
INCREASE	3,467	2,868	1.36	1.20

# OFF-SITE FLOW:

There is no off-site flow associated with this site. The property to the north is graded to drain to Trumbull Avenue, SE.

# DOWNSTREAM CAPACITY:

THE SITE WILL DRAIN INTO SOUTHERN AVENUE WHICH IS PAVED BUT DOES NOT HAVE CURB AND GUTTER. THE SITE DISCHARGE WILL ENTER SOUTHERN AVENUE AND BE CONVEYED BY THE ROADSIDE DITCHES TO MOON AVENUE WHICH DOES HAVE CURB AND GUTTER AND A STORM DRAINAGE SYSTEM. THERE IS A FLOOD ZONE IN MOON STREET BEGINNING NORTH OF TRUMBULL AVENUE. A 54" RCP STORM DRAIN LINE HAS BEEN INSTALLED IN MOON STREET PARALLEL TO THE EXISTING 36" RCP STORM DRAIN LINE AND THE TWO LINES ARE INTERCONNECTED AT MANHOLES. THE NEW LINE IS A "WASH" LINE FOR THE CITY RESERVOIRS AT GARCIA AND TRUMBULL. IT IS IMPORTANT THAT THE DISCHARGE FROM THE DEVELOPED SITE NOT BE INCREASED SIGNIFICANTLY OVER THE EXISTING PEAK DISCHARGE. THE EXISTING PEAK DISCHARGE IS 4.45 CFS. DEVELOPED RUNOFF IS 5.81 CFS AND THE INCREASE IS 1.36 CFS. IN ORDER TO LIMIT SITE DISCHARGE TO THE EXISTING 4.45 CFS, IT IS PROPOSED TO HAVE A DETENTION POND WEST OF BUILDING NO. 1 WITH SPILLWAY AND POSITIVE DISCHARGE PIPES. THE AREA AVAILABLE IS LIMITED BUT IT WILL BE POSSIBLE TO LIMIT THE FLOW TO THE EXISTING 100-YEAR PEAK DISCHARGE. IT WILL ALSO BE NECESSARY TO LINE THE POND BOTTOM WITH AN IMPERVIOUS POND LINER SINCE THE POND WILL BE CLOSER THAN 15 FEET FROM THE BUILDING AND THE PROPERTY LINE.

# EROSION CONTROL REQUIREMENTS:

The Contractor shall be responsible for compliance with the following:


1. No sediment-bearing water shall be allowed to discharge from the site during construction.
2. During grading operations and until the project has been completed, all adjacent property rights-of-way, and easements shall be protected from flooding by runoff from the site.
3. Should the contractor fail to prevent sediment-bearing water from entering public right-of-way, he shall promptly remove from the public right-of-way any and all sedimentation originating from the site.
4. Control of sediment-bearing waters will be accomplished by use of a compacted earth berm of adequate height. The berm shall be located along the downstream perimeter of the property.

# DRAINAGE CALCULATIONS:

# POND CALCULATIONS

# HYDROGRAPH FOR SMALL WATERSHEDS:

$t_B = (2.107 * E * A_T / Q_P) - (0.25 A_D / A_T)$   
 $E = 0.08 * 0.92 + 0.20 * 1.29 + 0.72 * 2.36 = 2.03$  in.  
 $A_T = 1.2884$  AC  $A_D = 0.9280$  AC  $Q_P = 5.81$  CFS  
 $t_B = (2.107 * 2.03 * 1.2884 / 5.81) - (0.25 * 0.9280 / 1.2884) = 0.77$  HR.  
 $t_P = (0.7 * t_C) + ((1/6 - (A_D / A_T)) / 12)$   
 $t_P = (0.7 * 0.2) + ((1/6 - (0.9280 / 1.2884)) / 12) = 0.21$  HR.  
Continue the Peak  $0.25 (A_D / A_T) = 0.25 (0.9280 / 1.2884) = 0.18$  HR.

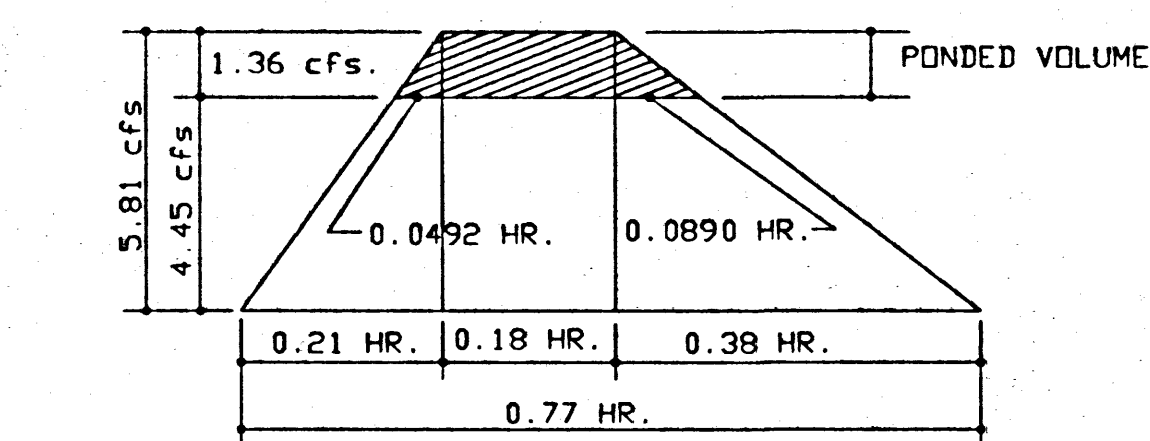



POND VOLUME:  $V = [(0.0492 * 1.36) / 2 + (0.18 * 1.36) + (0.0890 * 1.36) / 2] * 3600$   
 $V = 1,220$  CF

# ACTUAL POND VOLUME:

Ponding will take place along the west and north sides of Building No. 1 and in the silting basin.

North side of Building No. 1: Use Pyramid Equation,  $V = BM^3$  B = Surface Area = 216 sf.  
 $H$  = Depth at west end = 51.4 - 50.8 = 0.6 ft.  
 $V = (216 * 0.6) / 3 = 43$  cf


West side of Building No. 1: Use Average End Area Method.

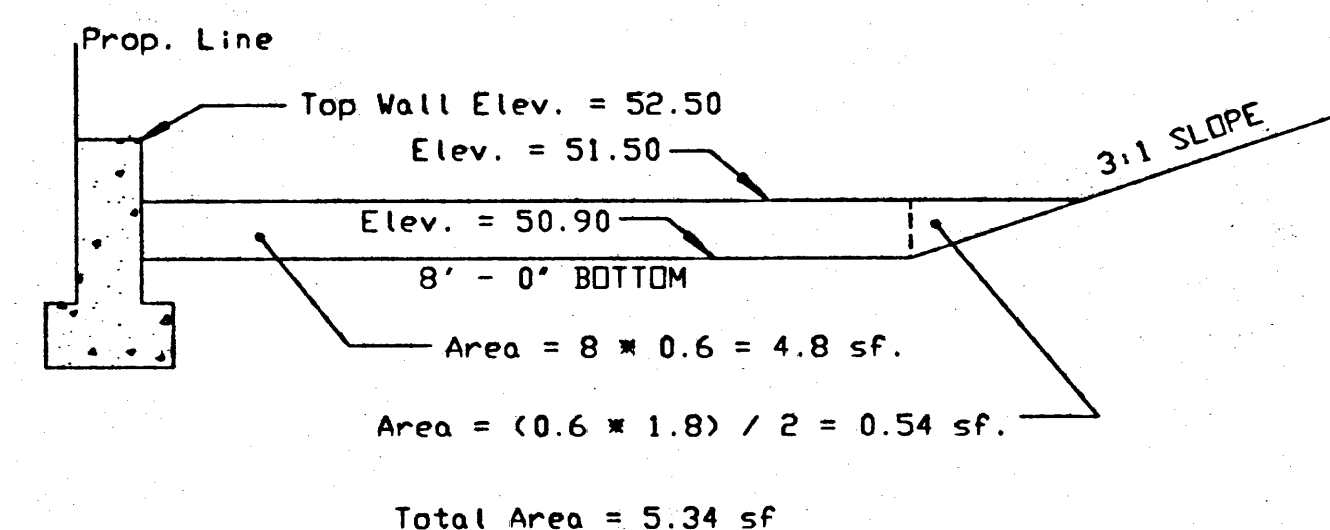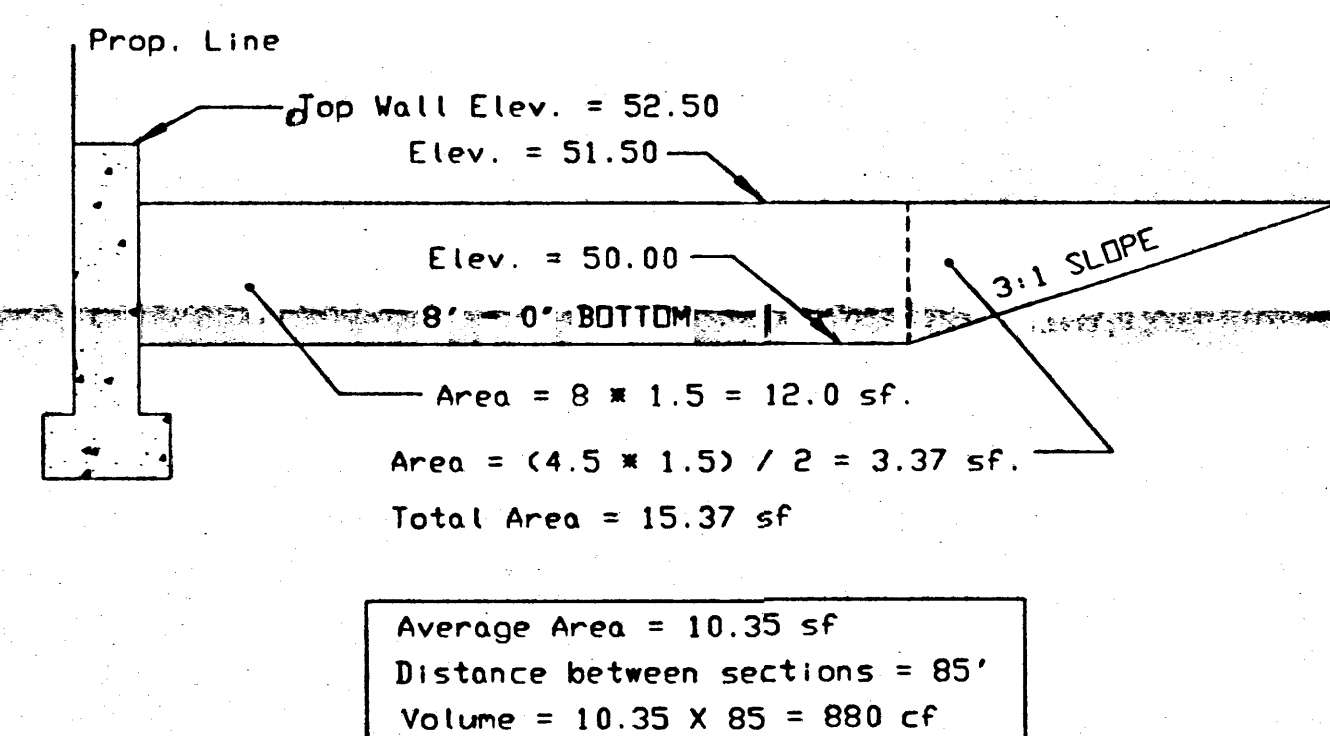

# Sedimentation Basin.

Area = 15 \* 15 \* 1.5 = 337 cf.

TOTAL ACTUAL POND VOLUME:  $V = 43 + 880 + 337 = 1260$  CF > 1220 CF.

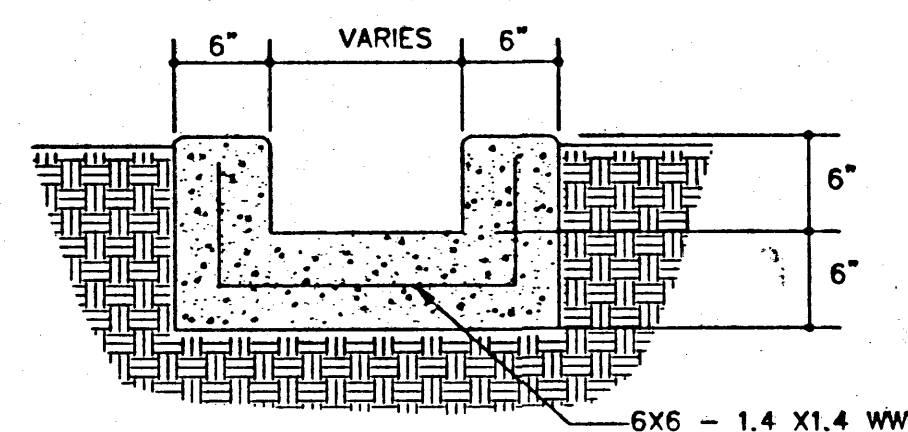

# CONCRETE CHANNEL DETAIL

1" = 1'-0"

# POND POSITIVE DISCHARGE:

Design  $Q = 4.45$  cfs. It is desirable to use a number of small diameter pipes rather than one large one. Use Orifice Equation,  $Q = CA(2GH)^{1/2}$   $C = 0.6$   $A = 0.0855$  sf for 4" dia. PVC.  
 $H = 1.17'$  (Vert. dist. between spillway and center of pipe).

$Q = 0.6 * 0.0855 * (2 * 32.16 * 1.17)^{1/2} = 0.445$  cfs.

Use 10 each 4" PVC pipes through concrete cutoff wall.

# POND OVERFLOW SPILLWAY:

Use Weir Equation,  $Q = CLH^{3/2}$   $C = 3.0$   $L = 10.0'$   $H = 0.34'$  or approx. 4"

$Q = 3.0 * 10.0 * 0.34^{3/2} = 5.95$  cfs > 5.81 cfs.

# FLOW AT ANALYSIS POINTS:

East side of Building No. 3 and East Parking Lot. (ANALYSIS POINT 1)  
Treat. B = 0.0197 ac. Treat C = 0.0302 ac. Treat. D = 0.1469 ac.  
 $Q = (0.0197 * 2.60 + 0.0302 * 3.45 + 0.1469 * 5.02) = 0.84$  cfs

Area South of Building No. 3: (ANALYSIS POINT 2)

Treat. B = 0.0241 ac. Treat D = 0.0478 ac.  
 $Q = (0.0241 * 2.60 + 0.0478 * 5.02) = 0.30$  cfs (Accum. Sum = 1.14 cfs.)

Area Between Ridges of Building No. 2 and Building No. 3: (ANALYSIS POINT 3)

Treat C = 0.0909 ac. Treat. D = 0.2020 ac.  
 $Q = (0.0909 * 3.45 + 0.2020 * 5.02) = 1.33$  cfs If the landscaped area S. of the sidewalk is included,  $Q = 1.43$  cfs. (ANALYSIS POINT 3A) (Accum. Sum = 2.57 cfs)

Area in front of Building No. 2: (ANALYSIS POINT 4)

Treat. B = 0.0069 ac. Treat D = 0.0647 ac.  
 $Q = (0.0069 * 2.60 + 0.0647 * 5.02) = 0.34$  cfs (Accum. Sum = 2.91 cfs)

Area between Buildings No. 1 and No. 2 and V. half of Building No. 2: (ANALYSIS POINT 5)

Treat C = 0.0559 ac. Treat. D = 0.2515 ac.  
 $Q = (0.0559 * 3.45 + 0.2515 * 5.02) = 1.46$  cfs (Accum. Sum = 4.37 cfs)

Area north of Building No. 1: (ANALYSIS POINT 6)

Treat C = 0.0379 ac. Treat. D = 0.1010 ac.  
 $Q = (0.0379 * 3.45 + 0.1010 * 5.02) = 0.64$  cfs (Accum. Sum = 5.01 cfs)

Area west of Building No. 1: (ANALYSIS POINT IS POND)

Treat C = 0.0725 ac.  $Q = 0.0725 * 3.45 = 0.25$  cfs

Area South of Building No. 1: (ANALYSIS POINT IS POND)

Treat. C = 0.0126 ac. Treat D = 0.1010 ac.

$Q = (0.0126 * 3.45 + 0.1010 * 5.02) = 0.55$  cfs (Accum. Sum = 5.81 cfs)

# CHANNEL FLOW:

CHANNEL NO. 1 Channel at SE corner of Building No. 3.

$Q = 0.84$  (Design Flow)  $Q = CLH^{3/2}$   $L = Q / (CH^{3/2})$   $C = 3.0$   
 $H = 0.4'$   $L = 0.84 / (3.0 * 0.4^{3/2}) = 1.10'$  Use 1.5'  
Check Capacity by Manning's Equation.  $Q = A(1.486/N)R^{2/3}S^{1/2}$   
 $N = 0.013$   $S = 0.0020$  ft/ft  $A = 0.4 * 1.5 = 0.6$  sf.  $P = 2.3'$   
 $R = A/P = 0.26$   $Q = 0.6(1.486/0.013)(0.26)^{2/3}(0.002)^{1/2} = 1.25$  cfs.

CHANNEL NO. 2:

Channel between Building No. 2 and Building No. 3, east end.  
 $Q = 1.23$  cfs Based on calcs for Channel No. 1, 1.5' is adequate.

CHANNEL NO. 3:

Channel between Building No. 2 and Building No. 3, w/ SW culvert.  
 $Q = 1.33$  cfs Based on calcs for Channel No. 1, 2.0' is adequate.

CHANNEL NO. 4:


Channel between Building No. 2 and Building No. 3, West of Junction.  
 $Q = 2.57$  cfs Use Manning's Equation. Try 2.0' Channel.  
Flow Depth = 0.45  $A = 0.9$  sf  $P = 2.9'$   $R = 0.31$   
 $Q = 0.9(1.486/0.013)(0.31)^{2/3}(0.005)^{1/2} = 3.33$  cfs (Adequate).

CHANNEL NO. 5:

Channel near SW corner of Building No. 2.  $Q = 2.91$  cfs.  
Based on Calcs. for Channel No. 4, 2.0' Channel is Adequate.


CHANNEL NO. 6:

North side of Building No. 1.  $Q = 5.01$  cfs.  $D = 0.9'$   
Use Manning's Equation. V-shaped Channel with 3:1 side slopes.  
 $A = 2.43$   $P = 5.69'$   $R = 0.43$   $N = 0.023$  (Gravel).  
 $Q = 2.43(1.486/0.023)(0.43)^{2/3}(0.0050)^{1/2} = 6.32$  cfs > 5.01 cfs.

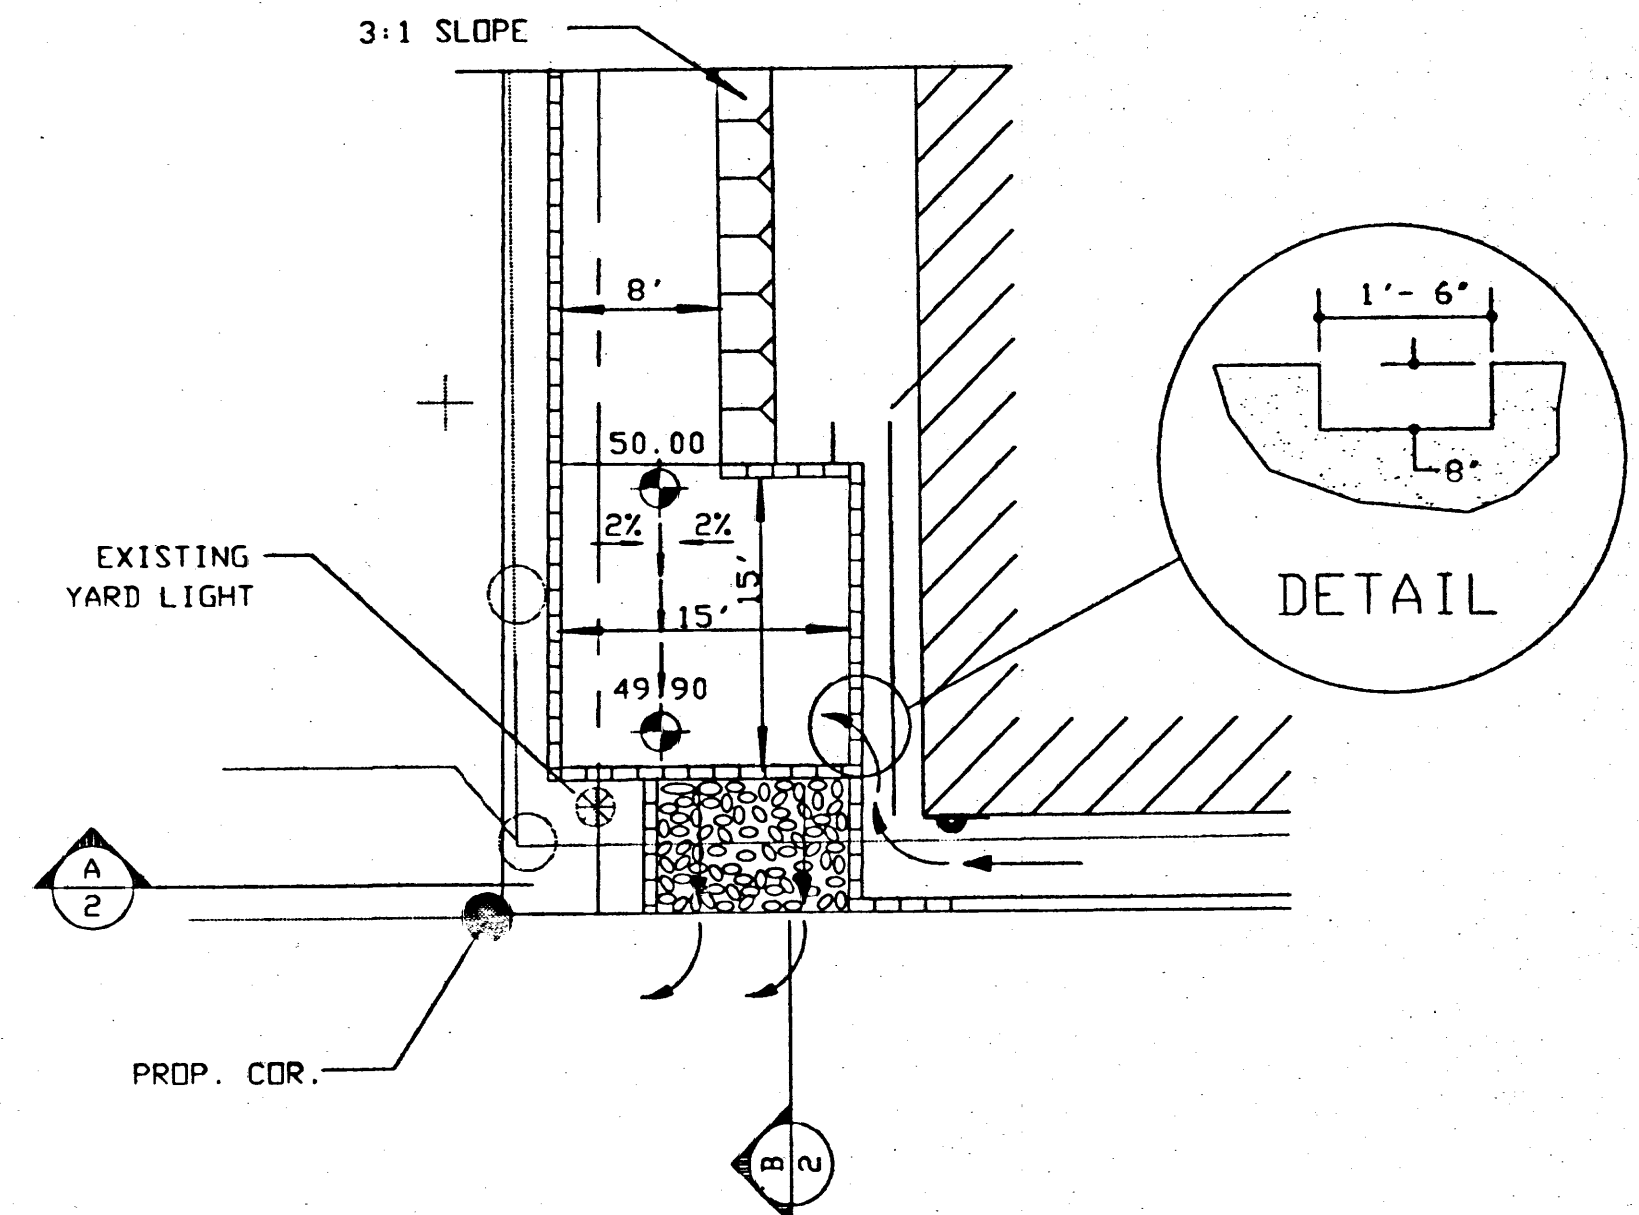


# SEDIMENTATION BASIN AND POND DISCHARGE STRUCTURE DETAIL

1" = 10'

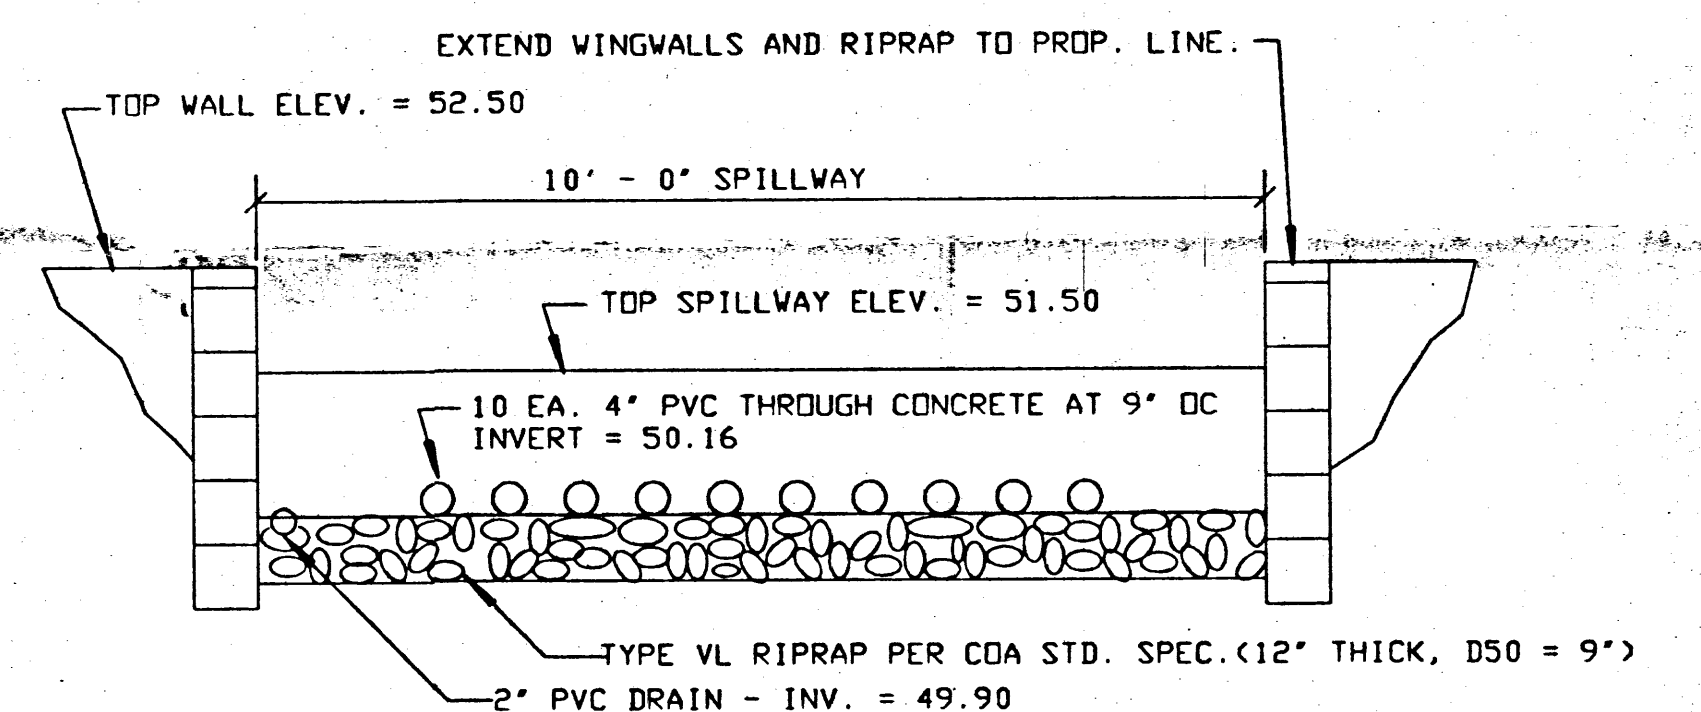

# SECTION A - A SPILLWAY ELEVATION

1/2" = 1' - 0"

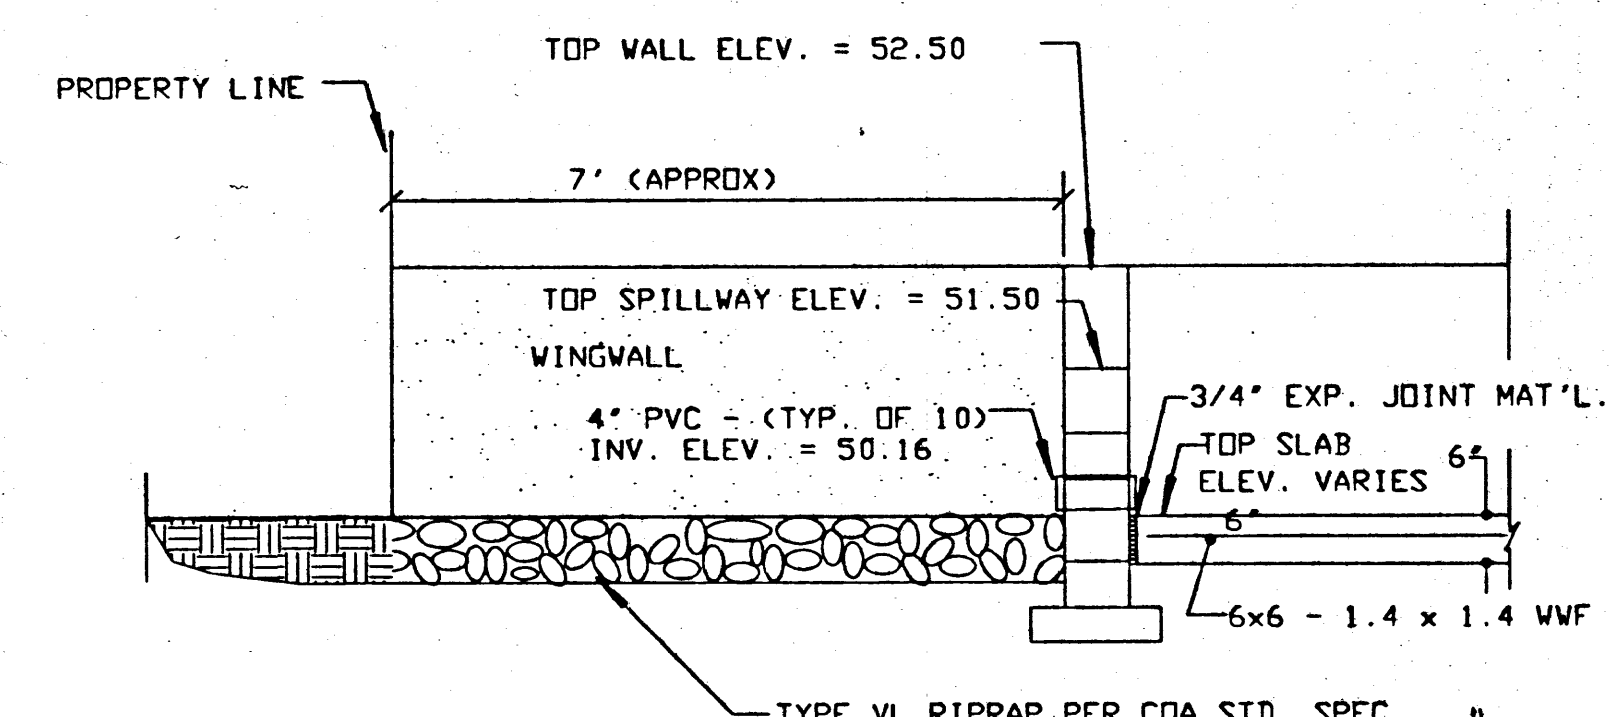

# SECTION B - B SPILLWAY SECTION

1/2" = 1' - 0"



FRANK D. LOVELADY, P.E.  
300 ALAMOSA ROAD NW  
ALBUQUERQUE, NEW MEXICO 87107  
(505)345-2267

DRAINAGE CALCULATIONS  
3 UNIT WAREHOUSING  
LOT 10A, BLOCK 52 & 53  
SKYLINE HEIGHTS SUBDIVISION  
ALBUQUERQUE, NEW MEXICO

SHEET  
OF  
2  
2



Designed FDL Drawn FDL Checked FDL Scale 1" = 20' Date AUGUST, 1996 Job No. 529

BUZZARD2.DWG(8/30/96)



# TRUMBULL

# AVENUE S.E.

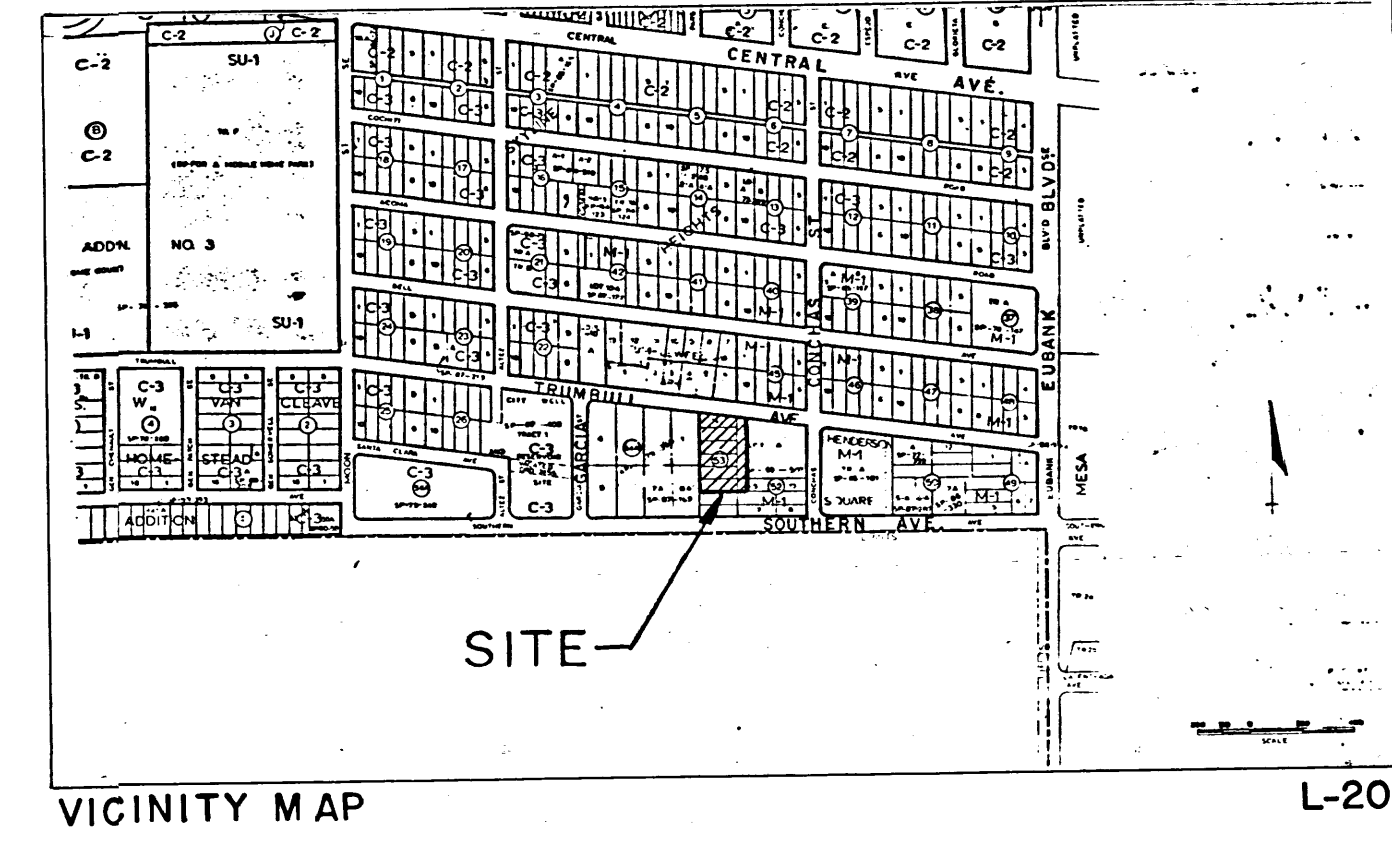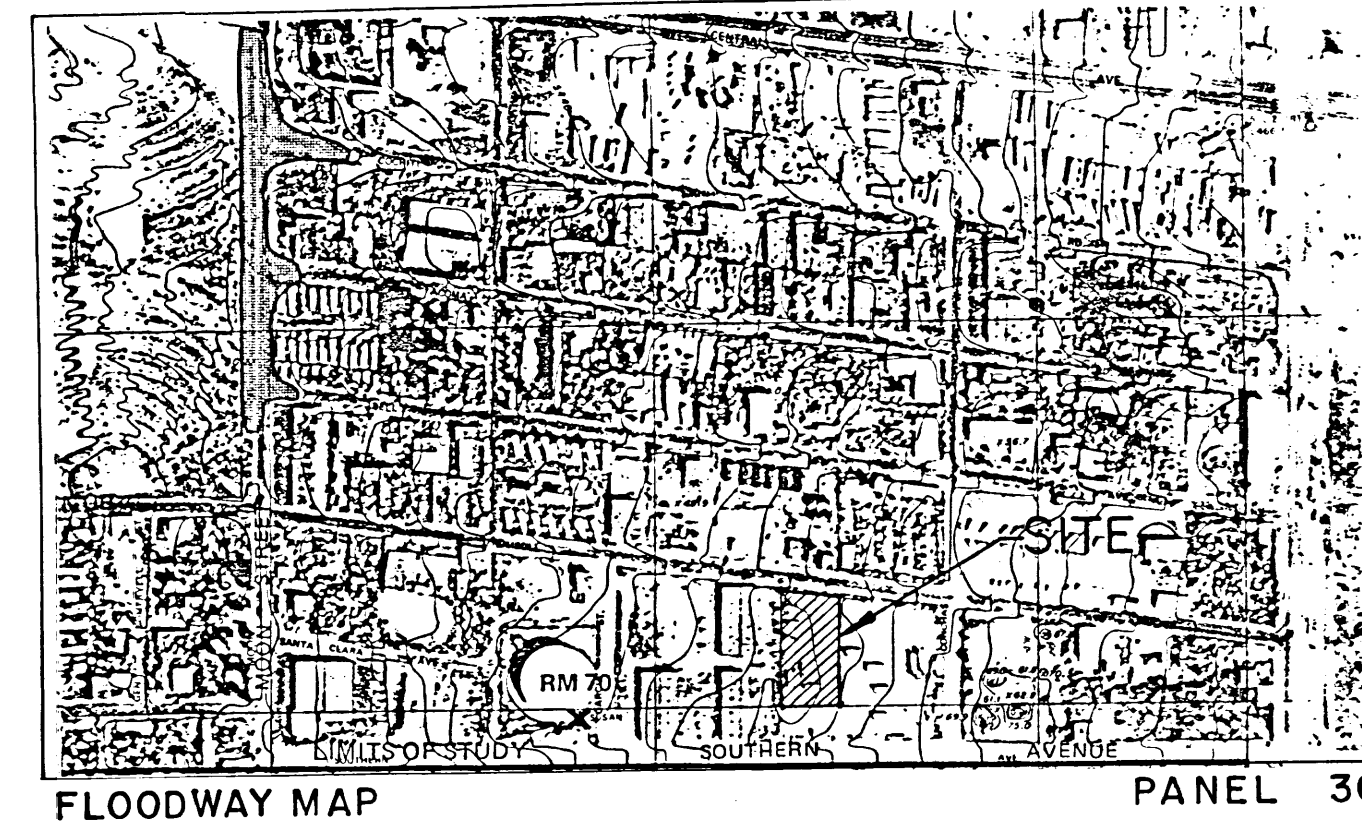


LOT 1  
BLOCK 54A  
SKYLINE HEIGHTS ADDITION  
FILED: OCT. 01, 1948 IN  
VOL. C, FOLIO 124.

CONSTRUCT PER C.O.A.  
STD. DWG. NO. 2236  
INVERT IN = 49.73 INK OUT = 49.73  
ELEV. = 5450.33

SECTION A-A  
1/4" = 1'-0"

LOT 8-A  
BLOCK 54A  
SKYLINE HEIGHTS ADDITION  
FILED: MAY 19, 1987 IN  
VOL. C33, FOLIO 140.

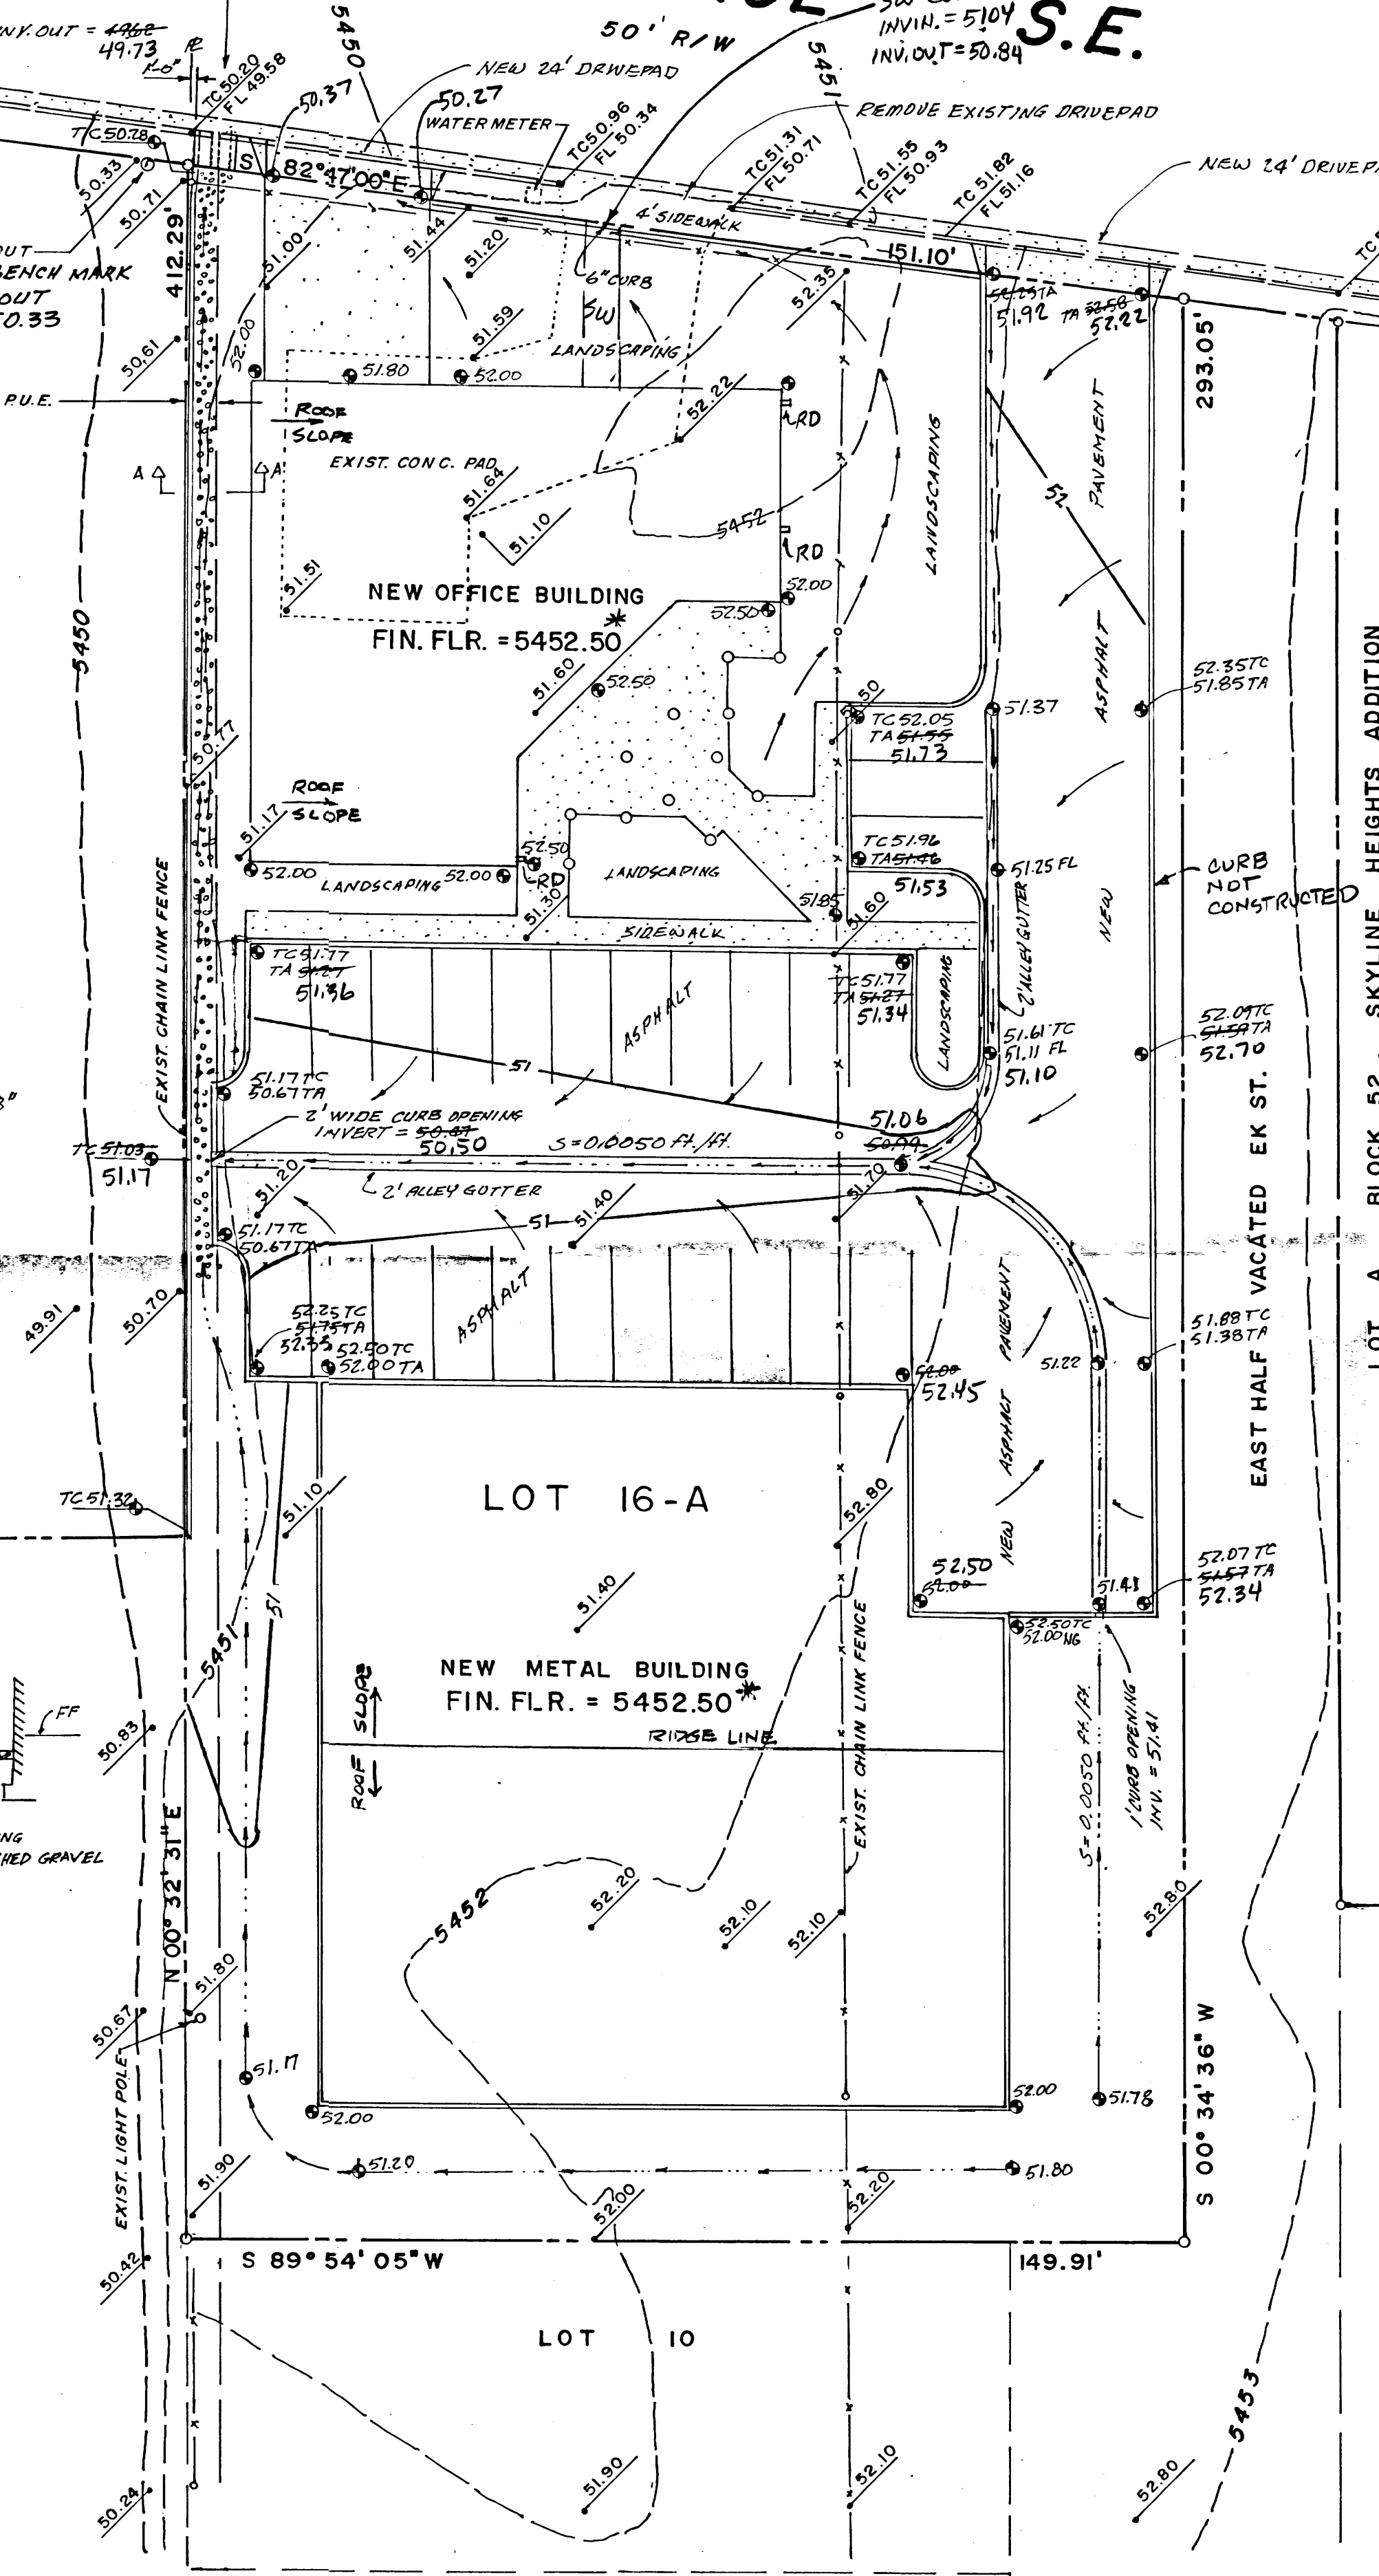

SCALE 1" = 20'

### LEGEND

SYMBOL	DESCRIPTION
52.23	EXISTING SPOT ELEVATION
52.23	NEW SPOT ELEVATION
5452	EXISTING CONTOUR
52	NEW CONTOUR
---	PROPERTY LINE
---	SWALE
---	SHEET FLOW
TC	TOP OF CURB
TA	TOP OF ASPHALT
*	FIN. FLR. GRADE VERIFIED

### CITY OF ALBUQUERQUE DRAINAGE FACILITIES WITHIN CITY RIGHT-OF-WAY (S.O. 19) NOTICE TO CONTRACTORS

- AN EXCAVATION/CONSTRUCTION PERMIT WILL BE REQUIRED BEFORE BEGINNING ANY WORK WITHIN CITY RIGHT-OF-WAY. AN APPROVED COPY OF THESE PLANS MUST BE SUBMITTED AT THE TIME OF APPLICATION FOR THIS PERMIT.
- ALL WORK DETAILED ON THIS PLAN TO BE PERFORMED UNDER CONTRACT, EXCEPT AS STATED OR PROVIDED FOR HEREON, SHALL BE CONSTRUCTED IN ACCORDANCE WITH STANDARD SPECIFICATIONS FOR PUBLIC WORKS CONSTRUCTION, 1988, AS REVISED.
- TWO (2) WORKING DAYS PRIOR TO ANY EXCAVATION, CONTRACTOR MUST CONTACT NEW MEXICO ONE CALL SYSTEM, INC., 260-1990, FOR LOCATION OF EXISTING UTILITIES.
- PRIOR TO CONSTRUCTION, THE CONTRACTOR SHALL EXCAVATE AND VERIFY THE HORIZONTAL AND VERTICAL LOCATIONS OF ALL OBSTRUCTIONS. SHOULD A CONFLICT EXIST, THE CONTRACTOR SHALL NOTIFY THE ENGINEER SO THAT THE CONFLICT CAN BE RESOLVED WITH A MINIMUM AMOUNT OF DELAY.
- BACKFILL COMPACTION SHALL BE ACCORDING TO RESIDENTIAL STREET USE.
- MAINTENANCE OF THESE FACILITIES SHALL BE THE RESPONSIBILITY OF THE OWNER OF THE PROPERTY SERVED.
- THE ADDRESS OF THE PROPERTY SERVED IS TRUMBULL AVENUE, N.E.

APPROVALS:

HYDROLOGY	NAME	DATE
INSPECTOR	NAME	DATE
CONSTRUCTION	NAME	DATE

### EXISTING CONDITIONS:

The site is located on Trumbull Avenue 1,200 feet west of Eubank Boulevard, S.E. The area in which the site is located is presently developed as light industrial. The terrain slopes gently from east to west. Trumbull Avenue is paved with standard curb and gutter. The lot to the east, Lot A, Block 52, is developed with all runoff leaving the lot by a 4" PVC pipe through the curb into Trumbull Avenue, so there is no off-site flow from this lot. The site does not lie within a designated flood hazard zone. There is, however, a flood zone downstream from the site which is a result of an inadequately-sized storm drain line in Moon Street. A parallel 54" diameter wash line was constructed to drain the City of Albuquerque reservoir at Garcia and Southern. This line also has inlets in Moon Street which increases the capacity of the Moon Street storm drain. However, no map revision has been done so the flood hazard area in Moon Street is still considered to exist.

### PROPOSED CONDITIONS:

It is proposed to develop the site as shown on the grading plan.

### DRAINAGE CRITERIA:

The calculations shown on this plan were prepared in accordance with Section 22.2, Hydrology, of the Development Process Manual, Volume 2, Design Criteria, for the City of Albuquerque in cooperation with Bernalillo County, New Mexico and the Albuquerque Metropolitan Arroyo Flood Control Authority, January 1993.

### PRECIPITATION ZONE:

The site is east of San Mateo Boulevard but west of Eubank Boulevard and is, therefore, in Precipitation Zone 3.

### PEAK DISCHARGE PER ACRE, EXCESS PRECIPITATION AND AREAS:

The existing site is in an industrial area and has been graded at one time. It is considered to be Land Treatment "C". The developed land treatment areas are shown in the following table:

Land Treatment	100-yr	10-yr	10-yr	10-yr	Existing Site Areas	Developed Site Areas
	100-yr	10-yr	10-yr	10-yr	% Sq. Ft.	% Sq. Ft.
A	1.87	0.58	0.66	0.19	0.0	0.0
B	2.60	1.19	0.92	0.36	0.0	0.0
C	3.45	2.00	1.29	0.62	95.4	43,007
D	5.02	3.39	2.36	1.50	4.6	2,075
Totals					100.0	45,082

### WEIGHTED UNIT PEAK DISCHARGE VALUES:

Existing	Q <sub>W100</sub> = 0.954 X 3.45 + 0.046 X 5.02 = 3.52 cfs/acre
	Q <sub>W10</sub> = 0.954 X 2.00 + 0.046 X 3.39 = 2.06 cfs/acre
Developed	Q <sub>W100</sub> = 0.129 X 2.60 + 0.185 X 3.45 + 0.686 X 5.02 = 4.42 cfs/acre
	Q <sub>W10</sub> = 0.129 X 1.19 + 0.185 X 2.00 + 0.686 X 3.39 = 2.85 cfs/acre

### CONSTRUCTION NOTES:

- THIS PLAN SHOWS ELEVATIONS AND DISPOSITION OF STORM WATER RUNOFF ONLY. NO DIMENSIONS ARE SHOWN ON THE PLAN. FOR DIMENSIONS OF BUILDING AND PARKING LAYOUT, SEE ARCHITECTURAL SITE PLAN.
- PRIOR TO CONSTRUCTION, THE CONTRACTOR SHALL EXCAVATE AND VERIFY THE HORIZONTAL AND VERTICAL LOCATION OF ALL POTENTIAL OBSTRUCTIONS. SHOULD A CONFLICT EXIST, THE CONTRACTOR SHALL NOTIFY THE ENGINEER SO THAT THE CONFLICT CAN BE RESOLVED WITH A MINIMUM AMOUNT OF DELAY.
- ALL WORK ON THIS PROJECT SHALL BE PERFORMED IN ACCORDANCE WITH APPLICABLE FEDERAL, STATE AND LOCAL LAWS, RULES AND REGULATIONS CONCERNING CONSTRUCTION SAFETY AND HEALTH.

### LEGAL DESCRIPTION:

Present Legal Description:  
All of Lots 11 through 16, Block 53 of Skyline Heights Addition together with the west half (W 1/2) of vacated EK Street per quit claim deed filed March 04, 1960 in book D530, Page 551

Legal Description Upon Completion of Replat:  
Lot 16-A, Block 53 of Skyline Heights Addition

### ENGINEER'S CERTIFICATION:

Having performed an on-site inspection of the as-constructed facilities, and having made revisions including as-constructed elevations based on actual survey data provided by Harris Surveying Company, Inc., I hereby certify that the as-constructed facilities are in substantial conformance with the approved grading and drainage plan, Engineer's stamp dated 9/29/95, and revised 10/18/95.

Frank D. Lovelady, N.M.P.E. 6512

3-11-97 (Date)



FRANK D. LOVELADY, P.E. 300 ALAMOSA ROAD N.W. ALBUQUERQUE, N.M. 87107 (505) 345-2267		GRADING AND DRAINAGE PLAN OFFICE/WAREHOUSE COMPLEX FOR ALL-AMERICAN FOAM		SHEET OF
Designed: F.D.L.	Drawn: STAFF	Checked: F.D.L.	Scale: 1" = 20'	
Date: 9/95		Job No. 500		

### WEIGHTED EXCESS PRECIPITATION:

Existing	E <sub>W100</sub> = 0.959 X 1.29 + 0.046 X 2.36 = 1.34 in.
	E <sub>W10</sub> = 0.959 X 0.62 + 0.046 X 1.50 = 0.66 in.
Developed	E <sub>W100</sub> = 0.129 X 0.92 + 0.185 X 1.29 + 0.686 X 2.36 = 1.98 in.
	E <sub>W10</sub> = 0.129 X 0.36 + 0.185 X 0.62 + 0.686 X 1.50 = 1.19 in.

### SUMMARY OF VOLUMES AND PEAK DISCHARGE RATES

	V100	V10	Q100	Q10
EXISTING	5,034	2,480	3.64	2.13
DEVELOPED	7,439	4,471	4.57	2.95
INCREASE	2,405	1,991	0.93	0.82

### DOWNSTREAM CAPACITY:

The site will drain into Trumbull Avenue. Approximately 750' west of that point, at Altez Street, there are inlets on both sides of Trumbull Avenue. The inlet on the south side of the street will intercept flow from the site. Any flow passing these inlets will continue down Trumbull Avenue to Moon Street where there are 6 inlets in the intersection. This intersection is not actually in the Moon Street flood zone which begins just south of Bell Street. A 54" RCP storm drain line has been installed in Moon Street parallel to the existing 36" RCP storm drain line and the two lines are interconnected at manholes. The new line is a "wash" line for the City Reservoirs at Garcia and Trumbull. The distance from Altez Street to Eubank Boulevard is roughly 2,100 feet. The site is, therefore, in the lower 1/3 of the watershed and runoff from the site will have entered the storm sewer and passed the flood zone before peak flows arrive. Any continuation of the watershed east of Eubank Boulevard that may have existed will now be eliminated by the storm drain under construction in Eubank Blvd. The site is an infill site. For these reasons, unrestricted discharge is warranted for this site.

### OFF-SITE FLOW:

The property south of the site is almost flat but does have some slope in a northwesterly direction. However, it appears to pass south of the SW corner of the site. Lot A to the east drains to Trumbull Street. An area of approximately 45' X 180' = 8,100 sf, or 0.186 acre, may drain into the site just north of the SE corner. It is assumed that the peak discharge per acre is the same Q<sub>W</sub> as was used for this site, or 4.42 cfs/acre. Q<sub>100</sub> = 4.42 X 0.186 = 0.82 cfs.

### DRAINAGE CHANNEL CAPACITY:

Design Q = 4.57 cfs + 0.82 cfs = 5.39 cfs = 4.94 cfs (0.45cfs drains directly to the street through the driveway. Use gravel-lined channel, 5.0' wide flat bottom with a concrete containment curb on the west side and a 2:1 gravel-lined side slope on the east side. Depth of flow = 5" A = 5.0 X 0.41 + (0.41 X 0.82)/2 = 2.22 sf P = 0.41 + 5.0 + (0.41^2 + 0.82^2)/2 = 6.33 ft. R = A/P = 2.22 / 6.33 = 0.3507 N = 0.012 for concrete and 0.023 for gravel N<sub>w</sub> = (0.41 X 0.013 + 5.92 X 0.023)/6.33 = 0.022 V = (1.486 / 0.022) (0.3507)^2/3 (0.0050)^1/2 = 2.37 fps Q = AV = 2.22 X 2.37 = 5.28 cfs 5.28 cfs > 4.94 cfs (Adequate)

### SIDEWALK CULVERT CAPACITY:

Design Q = 4.94 cfs Use 2 ea 2'-0" sidewalk culverts. Use Weir Equation Q = CLH^2/2 C = 3.0 L = 4 H = 0.58' (7") Q = 3.0 X 4 X (0.58)^3/2 = 5.30 cfs > 4.94 cfs (Adequate)

### EROSION CONTROL REQUIREMENTS:

- The contractor shall be responsible for compliance with the following:
- No sediment-bearing water shall be allowed to discharge from the site during construction.
  - During grading operations and until the project has been completed, all adjacent property, rights-of-way, and easements shall be protected from flooding by runoff from the site.
  - Should the contractor fail to prevent sediment-bearing water from entering public right-of-way, he shall promptly remove from the public right-of-way any and all sedimentation originating from the site.
  - Control of sediment-bearing waters will be accomplished by use of a compacted earth berm of adequate height. The berm shall be located along the downstream perimeter of the property.

### BENCH MARK:

Elevations shown are based on ACS Station "SUSAN", with an elevation of 5449.99 feet.

