CITY OF ALBUQUERQUE

Planning Department
David Campbell, Director



November 30, 2018

David Soule, P.E. Rio Grande Engineering P.O. Box 93924 Albuquerque, NM, 87199

RE: Innova Plaza Phase 2

401 Eubank Blvd SE

Permanent C.O. - Accepted Engineer's Stamp Date: 12/11/17

Engineer's Certification Date: 11/27/18

Hydrology File: L20D067

PO Box 1293 Dear Mr. Soule:

Based on the Certification received 11/27/18 and site visit on 11/29/18, this certification is approved in support of Permanent Release of Occupancy by Hydrology.

Albuquerque

NM 87103

As a reminder, if the project total area of disturbance (including the staging area and any work within the adjacent Right-of-Way) is 1 acre or more, then an Erosion and Sediment Control (ESC) Plan and Owner's certified Notice of Intent (NOI) is required to be submitted to the Stormwater Quality Engineer (Curtis Cherne, PE, ccherne@cabq.gov, 924-3420) 14 days prior to

any earth disturbance.

www.cabq.gov

If you have any questions, please contact me at 924-3995 or rbrissette@cabq.gov .

Renée C. Brissette

Renée C. Brissette, P.E. CFM Senior Engineer, Hydrology

Planning Department



City of Albuquerque

Planning Department


Development & Building Services Division

DRAINAGE AND TRANSPORTATION INFORMATION SHEET (REV 6/2018)

Project Title: INNOVA PLAZA PHASE2Building Permit #:				
DRB#:		Work C	Order#:	
Legal Description: 10t 1A BLCOK 48	SKYLINE HEIGHTS	,		
City Address: 401 EUBANK SE				
Address:				
Phone#:	Fax#:	E-mail: _		
Other Contact: RIO GRANDE ENGINEE Address: PO BOX 93924 ALB NM 8	ERING	Contact:	DAVID SOULE	
Phone#: 505.321.9099	Y	F-mail· ^{da}	avid@riograndeengineering.com	
TYPE OF DEVELOPMENT:PLAT				
Check all that Apply:			ADMIN SILL	
DEPARTMENT: × HYDROLOGY/ DRAINAGE			TANCE SOUGHT:	
TRAFFIC/ TRANSPORTATION		NG PERMIT APPR		
TYPE OF SUBMITTAL:	CERTIFI	CATE OF OCCUP	ANCY	
ENGINEER/ARCHITECT CERTIFICATION	PRELIM	INARY PLAT API	PROVAI	
PAD CERTIFICATION		AN FOR SUB'D A		
CONCEPTUAL G & D PLAN			ERMIT APPROVAL	
GRADING PLAN		LAT APPROVAL		
DRAINAGE REPORT	1	211 211110 1112	•	
DRAINAGE MASTER PLAN	SIA/ RFI	FASE OF FINAN	CIAL GUARANTEE	
		SIA/ RELEASE OF FINANCIAL GUARANTEE FOUNDATION PERMIT APPROVAL		
ELEVATION CERTIFICATE		GRADING PERMIT APPROVAL		
CLOMR/LOMR		SO-19 APPROVAL		
TRAFFIC CIRCULATION LAYOUT (TCL)		PERMIT APPRO	VAT	
TRAFFIC IMPACT STUDY (TIS)		GRADING/ PAD CERTIFICATION		
STREET LIGHT LAYOUT		RDER APPROVAL		
OTHER (SPECIFY)	CLOMR/			
PRE-DESIGN MEETING?		LAIN DEVELOPN	MENT PERMIT	
IS THIS A RESUBMITTAL?: X Yes No		(SPECIFY)		
DATE SUBMITTED:				
COA STAFF:	ELECTRONIC SUBMITTAL RECEIVE	ED:		
FEE PAID:				

CAUTION: EXISTING UTILITIES ARE NOT SHOWN. IT SHALL BE THE SOLE RESPONSIBILITY OF THE CONTRACTOR TO CONDUCT ALL NECESSARY FIELD INVESTIGATIONS PRIOR TO ANY EXCAVATION TO DETERMINE THE ACTUAL LOCATION OF UTILITIES & OTHER IMPROVEMENTS. I <u>David Soule</u>, NMPE 14522, of the firm <u>Rio Grande Engineering</u>, hereby certify that this project has been graded and will drain in substantial compliance with and in accordance with the design intend of the approved plan dated 12/11/17. The record information edited on the original design document has performed by me or under my direct supervision and is true and correct to the best of my knowledge and belief. The asbuilt survey was provided by THOMAS PATRICK NMPS 12651. The certification is submitted in support of a request for PERMANENT CERTIFICATE OF OCCUPANCY. The record information presented heron is not necessarily complete and intended only to verify substantial compliance of the grading and drainage aspects of this project. Those relying on this record document are advised to obtain independent verification of its accuracy before using it for any other purpose

11/27/18

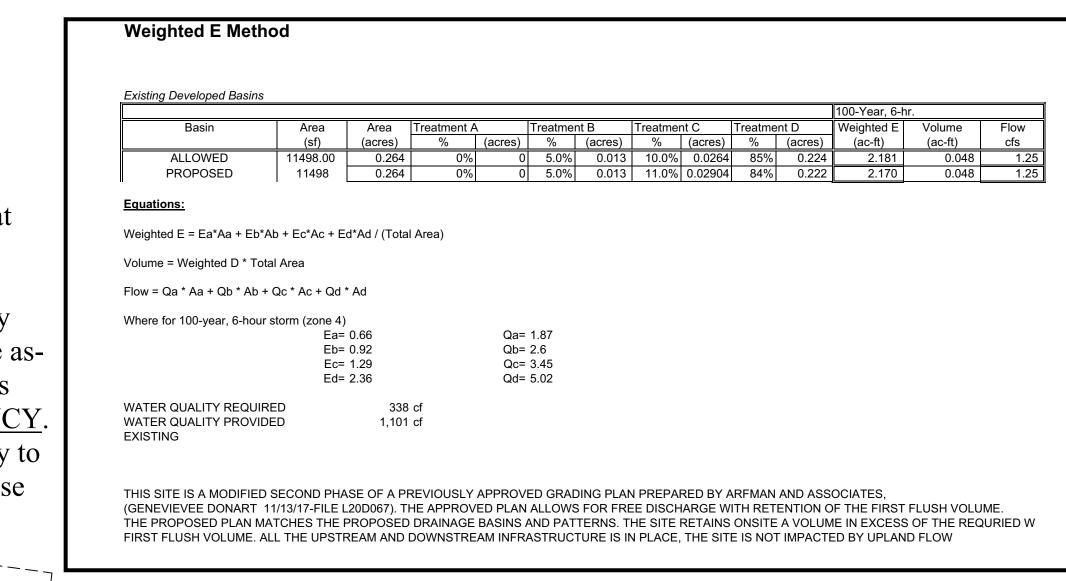


EROSION CONTROL NOTES:

CONTRACTOR IS RESPONSIBLE FOR OBTAINING A TOPSOIL DISTURBANCE

3. CONTRACTOR IS RESPONSIBLE FOR CLEANING ALL SEDIMENT THAT GETS

4. REPAIR OF DAMAGED FACILITIES AND CLEANUP OF SEDIMENT ACCUMULATIONS ON ADJACENT PROPERTIES AND IN PUBLIC FACILITIES IS T RESPONSIBILITY OF THE CONTRACTOR

5. ALL EXPOSED EARTH SURFACES MUST BE PROTECTED FROM WIND AND WATER EROSION PRIOR TO FINAL ACCEPTANCE OF ANY PROJECT.

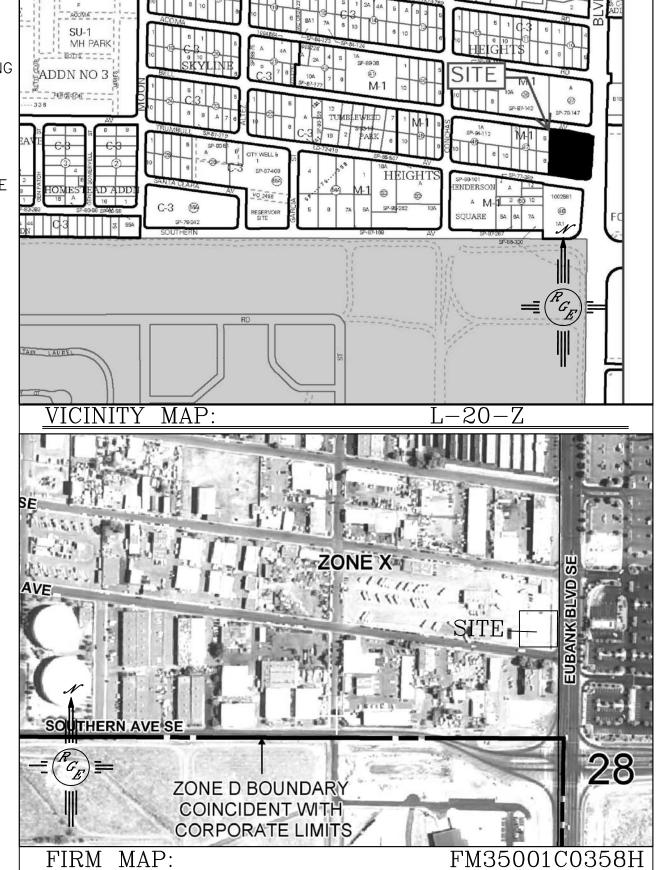

LEGAL DESCRIPTION:

1. ALL SPOT ELEVATIONS REPRESENT FLOWLINE ELEVATION UNLESS OTHERWISE

2. ALL CURB AND GUTTER TO 6" HEADER UNLESS OTHERWISE

3. ALL RETAINING WALL DESIGN SHALL BE BY OTHERS.

4. ALL NEW PAVING SHALL BE 6" PCC OVER 8" SUBGRADE PREPARATION IN CONFORMANCE TO ACI 330R-08. UNLESS OTHERWISE NOTED.

5. ANY CURBS OR PAVEMENT NEGATIVELY IMPACTED BY CONSTRUCTION ACTIVITY SHALL BE REPLACED TO MATCH EXISTING CONDITIONS.

6. ALL SITE WORK SHALL CONFORM TO CITY OF ALBUQUERQUE STANDARDS FOR PUBLIC WORKS CONSTRUCTION EDITION 9

LEGEND

P.E. #14522

GRAPHIC SCALE

SCALE: 1"=20'

