
CITY OF ALBUQUERQUE

Planning Department Alan Varela, Director

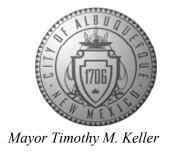

October 4, 2022

Jeffrey T. Wooten, PE Wooten Engineering PO Box 15814 Rio Rancho, NM 87174

RE: Presidential Cultivation 9910 Acoma Rd SE Grading and Drainage Plan Engineer's Stamp Date: 5/12/2022 Hydrology File: L20D076

Dear Mr. Wooten:

PO Box 1293


Based upon the information provided in your resubmittal received 9/17/2022, the Grading & Drainage Plan **is not** approved for Grading Permit. The following comments need to be addressed for approval of the above referenced project:

Albuquerque

General Notes

NM 87103

- 1. Please provide details of the culvert including the entrance to assure ADA is met.
- 2. Add city standard DWG number for the entrances.
- 3. Please address the following comments regarding the details shown below:
 - a. There is a discrepancy between the drawing and the title. The drawing shows a 3 foot clear width concrete flume whereas the title is 2 foot of concrete flume
 - b. Flume width and wall opening must be the same as sidewalk culvert.

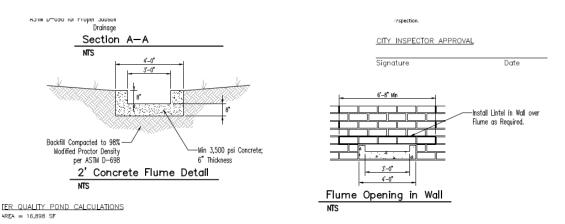

www.cabq.gov

CITY OF ALBUQUERQUE

Planning Department Alan Varela, Director

Sincerely,



If you have any questions, please contact me at 924-3999 or sbiazar@cabq.gov.

Shahab Biazar, P.E. CFM City Engineer Development Review Services Planning Department

PO Box 1293

Albuquerque

NM 87103

www.cabq.gov



City of Albuquerque


Planning Department

Development & Building Services Division

DRAINAGE AND TRANSPORTATION INFORMATION SHEET (REV 11/2018)

Project Title: Presidential Cultivation	Building Permit #:	Hydrology File #:
DRB#:	EPC#:	Work Order#:
Legal Description: Lots 4 & 5, Block 42		
City Address: 9910 Acoma Rd SE, Albu	querque, NM 87123	
Applicant: Wooten Engineering Address: PO BOX 15814, Rio Rancho, N		Contact: Jeffrey T. Wooten, P.E.
		E-mail: jeffwooten.pe@gmail.com
		Contact:
Address:Phone#:		E-mail:
TYPE OF SUBMITTAL: PLAT (# IS THIS A RESUBMITTAL?: X DEPARTMENT: TRAFFIC/ TRANSP	YesNo	
Check all that Apply: TYPE OF SUBMITTAL: ENGINEER/ARCHITECT CERTIFICATION PAD CERTIFICATION CONCEPTUAL G & D PLAN X GRADING PLAN DRAINAGE MASTER PLAN DRAINAGE REPORT FLOODPLAIN DEVELOPMENT PERMIT APPLIC ELEVATION CERTIFICATE CLOMR/LOMR TRAFFIC CIRCULATION LAYOUT (TCL) TRAFFIC IMPACT STUDY (TIS) OTHER (SPECIFY) PTYPE OF APPROVAL/ACCEPTANCE SOUGHT: X BUILDING PERMIT APPROVAL CERTIFICATE OF OCCUPANCY PRELIMINARY PLAT APPROVAL SITE PLAN FOR SUB'D APPROVAL SITE PLAN FOR BLDG. PERMIT APPROVAL SIA/ RELEASE OF FINANCIAL GUARANTEE FOUNDATION PERMIT APPROVAL X SO-19 APPROVAL PAVING PERMIT APPROVAL GRADING/ PAD CERTIFICATION WORK ORDER APPROVAL CLOMR/LOMR FLOODPLAIN DEVELOPMENT PERMIT OTHER (SPECIFY)		
DATE SUBMITTED: September 17, 20	By: Jeffrey T. Wo	oten, P.E.
COA STAFF:	ELECTRONIC SUBMITTA	L RECEIVED:

FEE PAID:_____

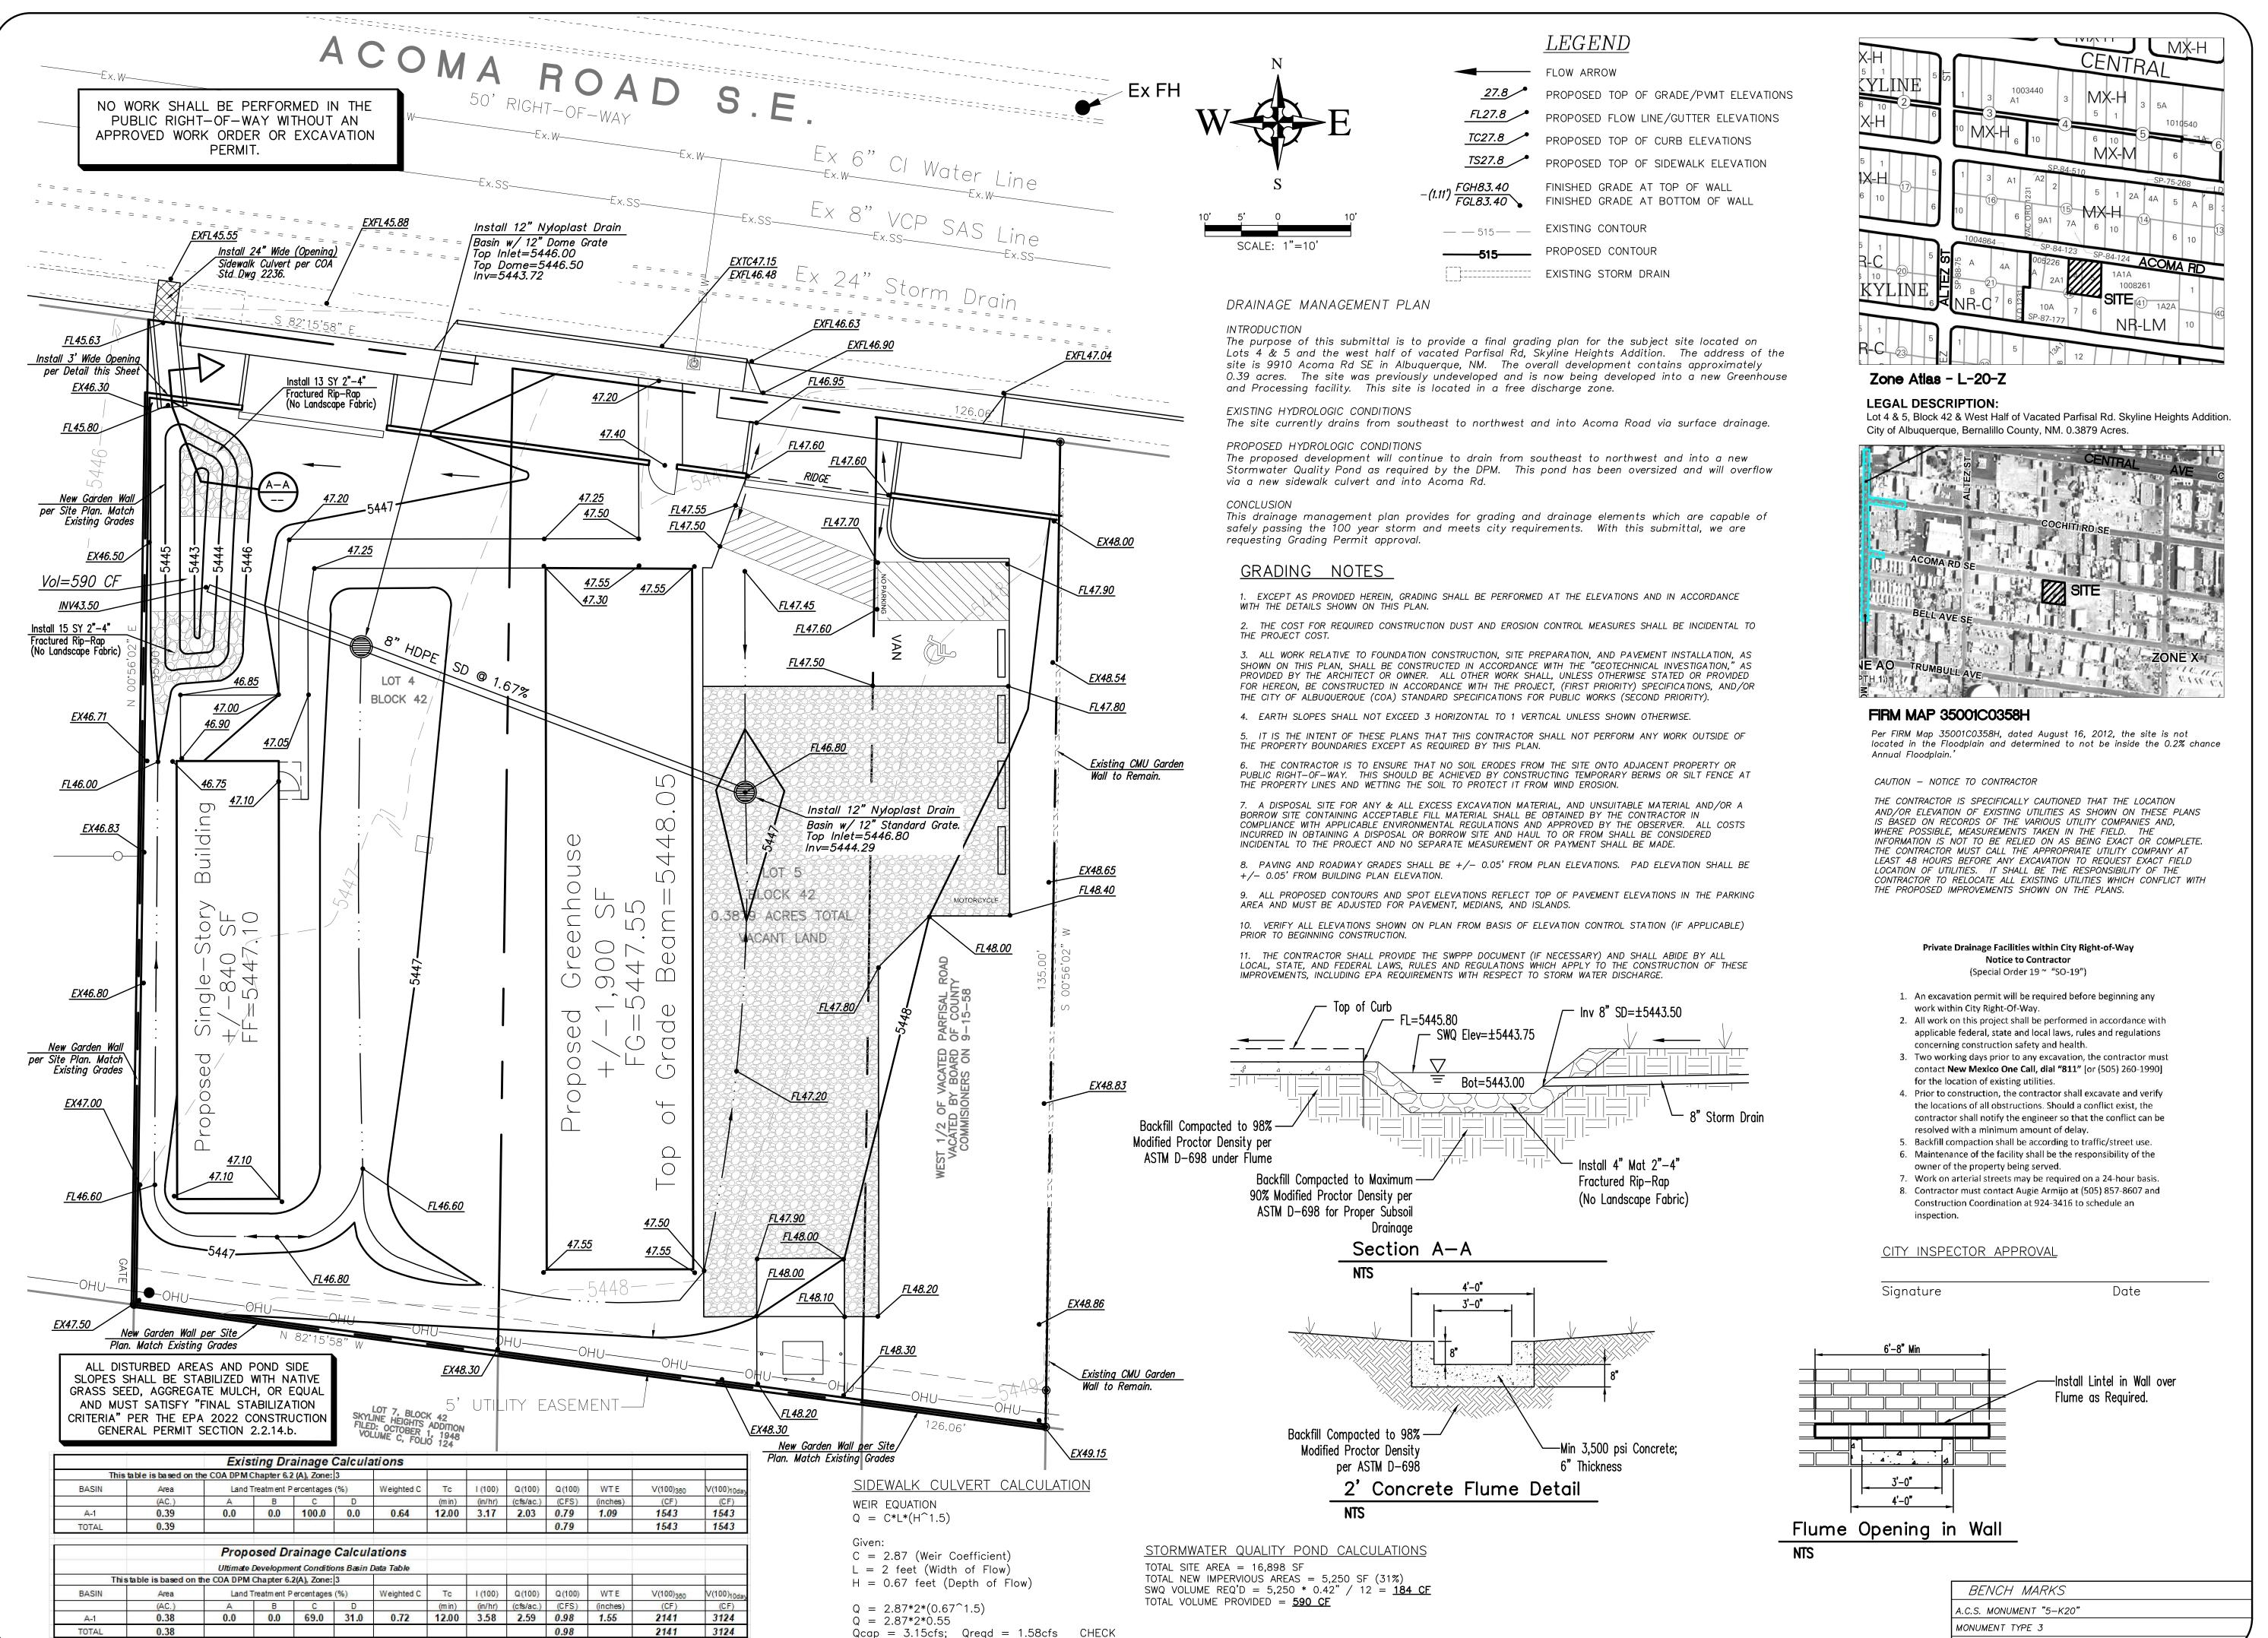

PUB. EL=5429.995 NAVD 1988

 \Box

Cul

sid

Д

 ∞

Φ

dn

0 dr

dent 991 Albu

87174 -3560

an

Q

din

D

9