

# CITY OF ALBUQUERQUE

*Planning Department*  
Alan Varela, Director



*Mayor Timothy M. Keller*

March 21, 2022

Fred Arfman, P.E.  
Isaacson & Arfman, Inc.  
128 Monroe St. NE  
Albuquerque, NM 87108

**RE: Luminaria Senior Community**  
**10600 Central Ave. SE**  
**Permanent C.O. - Approved**  
**Engineer's Certification Date: 3/11/22**  
**Engineer's Stamp Date: 10/1/20**  
**Hydrology File: ~~A11D011H~~ L21D045C**

Dear Mr. Arfman:

PO Box 1293

Based on the revised certification received 3/21/22 and a site visit on 3/17/21, this certification is approved for Permanent Certificate of Occupancy by Hydrology.

Albuquerque

If you have any questions, please contact me at 924-3986 or [earmijo@cabq.gov](mailto:earmijo@cabq.gov).

NM 87103

Sincerely,

[www.cabq.gov](http://www.cabq.gov)

Ernest Armijo, P.E.  
Principal Engineer, Planning Dept.  
Development Review Services



# City of Albuquerque

Planning Department  
Development & Building Services Division

## DRAINAGE AND TRANSPORTATION INFORMATION SHEET (REV 11/2018)

Project Title: Luminaria Senior Community Building Permit #: \_\_\_\_\_ Hydrology File #: L-21D023  
DRB#: \_\_\_\_\_ EPC#: \_\_\_\_\_ Work Order#: \_\_\_\_\_  
Legal Description: Tract 'C' Video Addition, Albuquerque, Bernalillo County, New Mexico  
City Address: \_\_\_\_\_

Applicant: Isaacson & Arfman, Inc. Contact: Fred C. Arfman or  
Bryan J. Bobrick  
Address: 128 Monroe Street NE - Albuquerque, NM 87108  
Phone#: (505) 268-8828 Fax#: \_\_\_\_\_ E-mail: freda@iacivil.com  
bryanb@iacivil.com  
Owner: \_\_\_\_\_ Contact: \_\_\_\_\_  
Address: \_\_\_\_\_  
Phone#: \_\_\_\_\_ Fax#: \_\_\_\_\_ E-mail: \_\_\_\_\_

TYPE OF SUBMITTAL: \_\_\_\_\_ PLAT ( \_\_\_\_\_ # OF LOTS) \_\_\_\_\_ RESIDENCE \_\_\_\_\_ DRB SITE ☒ ADMIN SITE

IS THIS A RESUBMITTAL?: \_\_\_\_\_ Yes ☒ No

DEPARTMENT: \_\_\_\_\_ TRAFFIC/ TRANSPORTATION ☒ HYDROLOGY/ DRAINAGE

Check all that Apply:

### TYPE OF SUBMITTAL:

☒ ENGINEER/ARCHITECT CERTIFICATION  
\_\_\_\_ PAD CERTIFICATION  
\_\_\_\_ CONCEPTUAL G & D PLAN  
\_\_\_\_ GRADING PLAN  
\_\_\_\_ DRAINAGE MASTER PLAN  
\_\_\_\_ DRAINAGE REPORT  
\_\_\_\_ FLOODPLAIN DEVELOPMENT PERMIT APPLIC  
\_\_\_\_ ELEVATION CERTIFICATE  
\_\_\_\_ CLOMR/LOMR  
\_\_\_\_ TRAFFIC CIRCULATION LAYOUT (TCL)  
\_\_\_\_ TRAFFIC IMPACT STUDY (TIS)  
\_\_\_\_ OTHER (SPECIFY) \_\_\_\_\_  
\_\_\_\_ PRE-DESIGN MEETING?

### TYPE OF APPROVAL/ACCEPTANCE SOUGHT:

\_\_\_\_ BUILDING PERMIT APPROVAL  
☒ CERTIFICATE OF OCCUPANCY  
\_\_\_\_ PRELIMINARY PLAT APPROVAL  
\_\_\_\_ SITE PLAN FOR SUB'D APPROVAL  
\_\_\_\_ SITE PLAN FOR BLDG. PERMIT APPROVAL  
\_\_\_\_ FINAL PLAT APPROVAL  
\_\_\_\_ SIA/ RELEASE OF FINANCIAL GUARANTEE  
\_\_\_\_ FOUNDATION PERMIT APPROVAL  
\_\_\_\_ GRADING PERMIT APPROVAL  
\_\_\_\_ SO-19 APPROVAL  
\_\_\_\_ PAVING PERMIT APPROVAL  
\_\_\_\_ GRADING/ PAD CERTIFICATION  
\_\_\_\_ WORK ORDER APPROVAL  
\_\_\_\_ CLOMR/LOMR  
\_\_\_\_ FLOODPLAIN DEVELOPMENT PERMIT  
\_\_\_\_ OTHER (SPECIFY) \_\_\_\_\_


DATE SUBMITTED: March 11, 2022 By: Fred C. Arfman

COA STAFF:

ELECTRONIC SUBMITTAL RECEIVED: \_\_\_\_\_

FEE PAID: \_\_\_\_\_



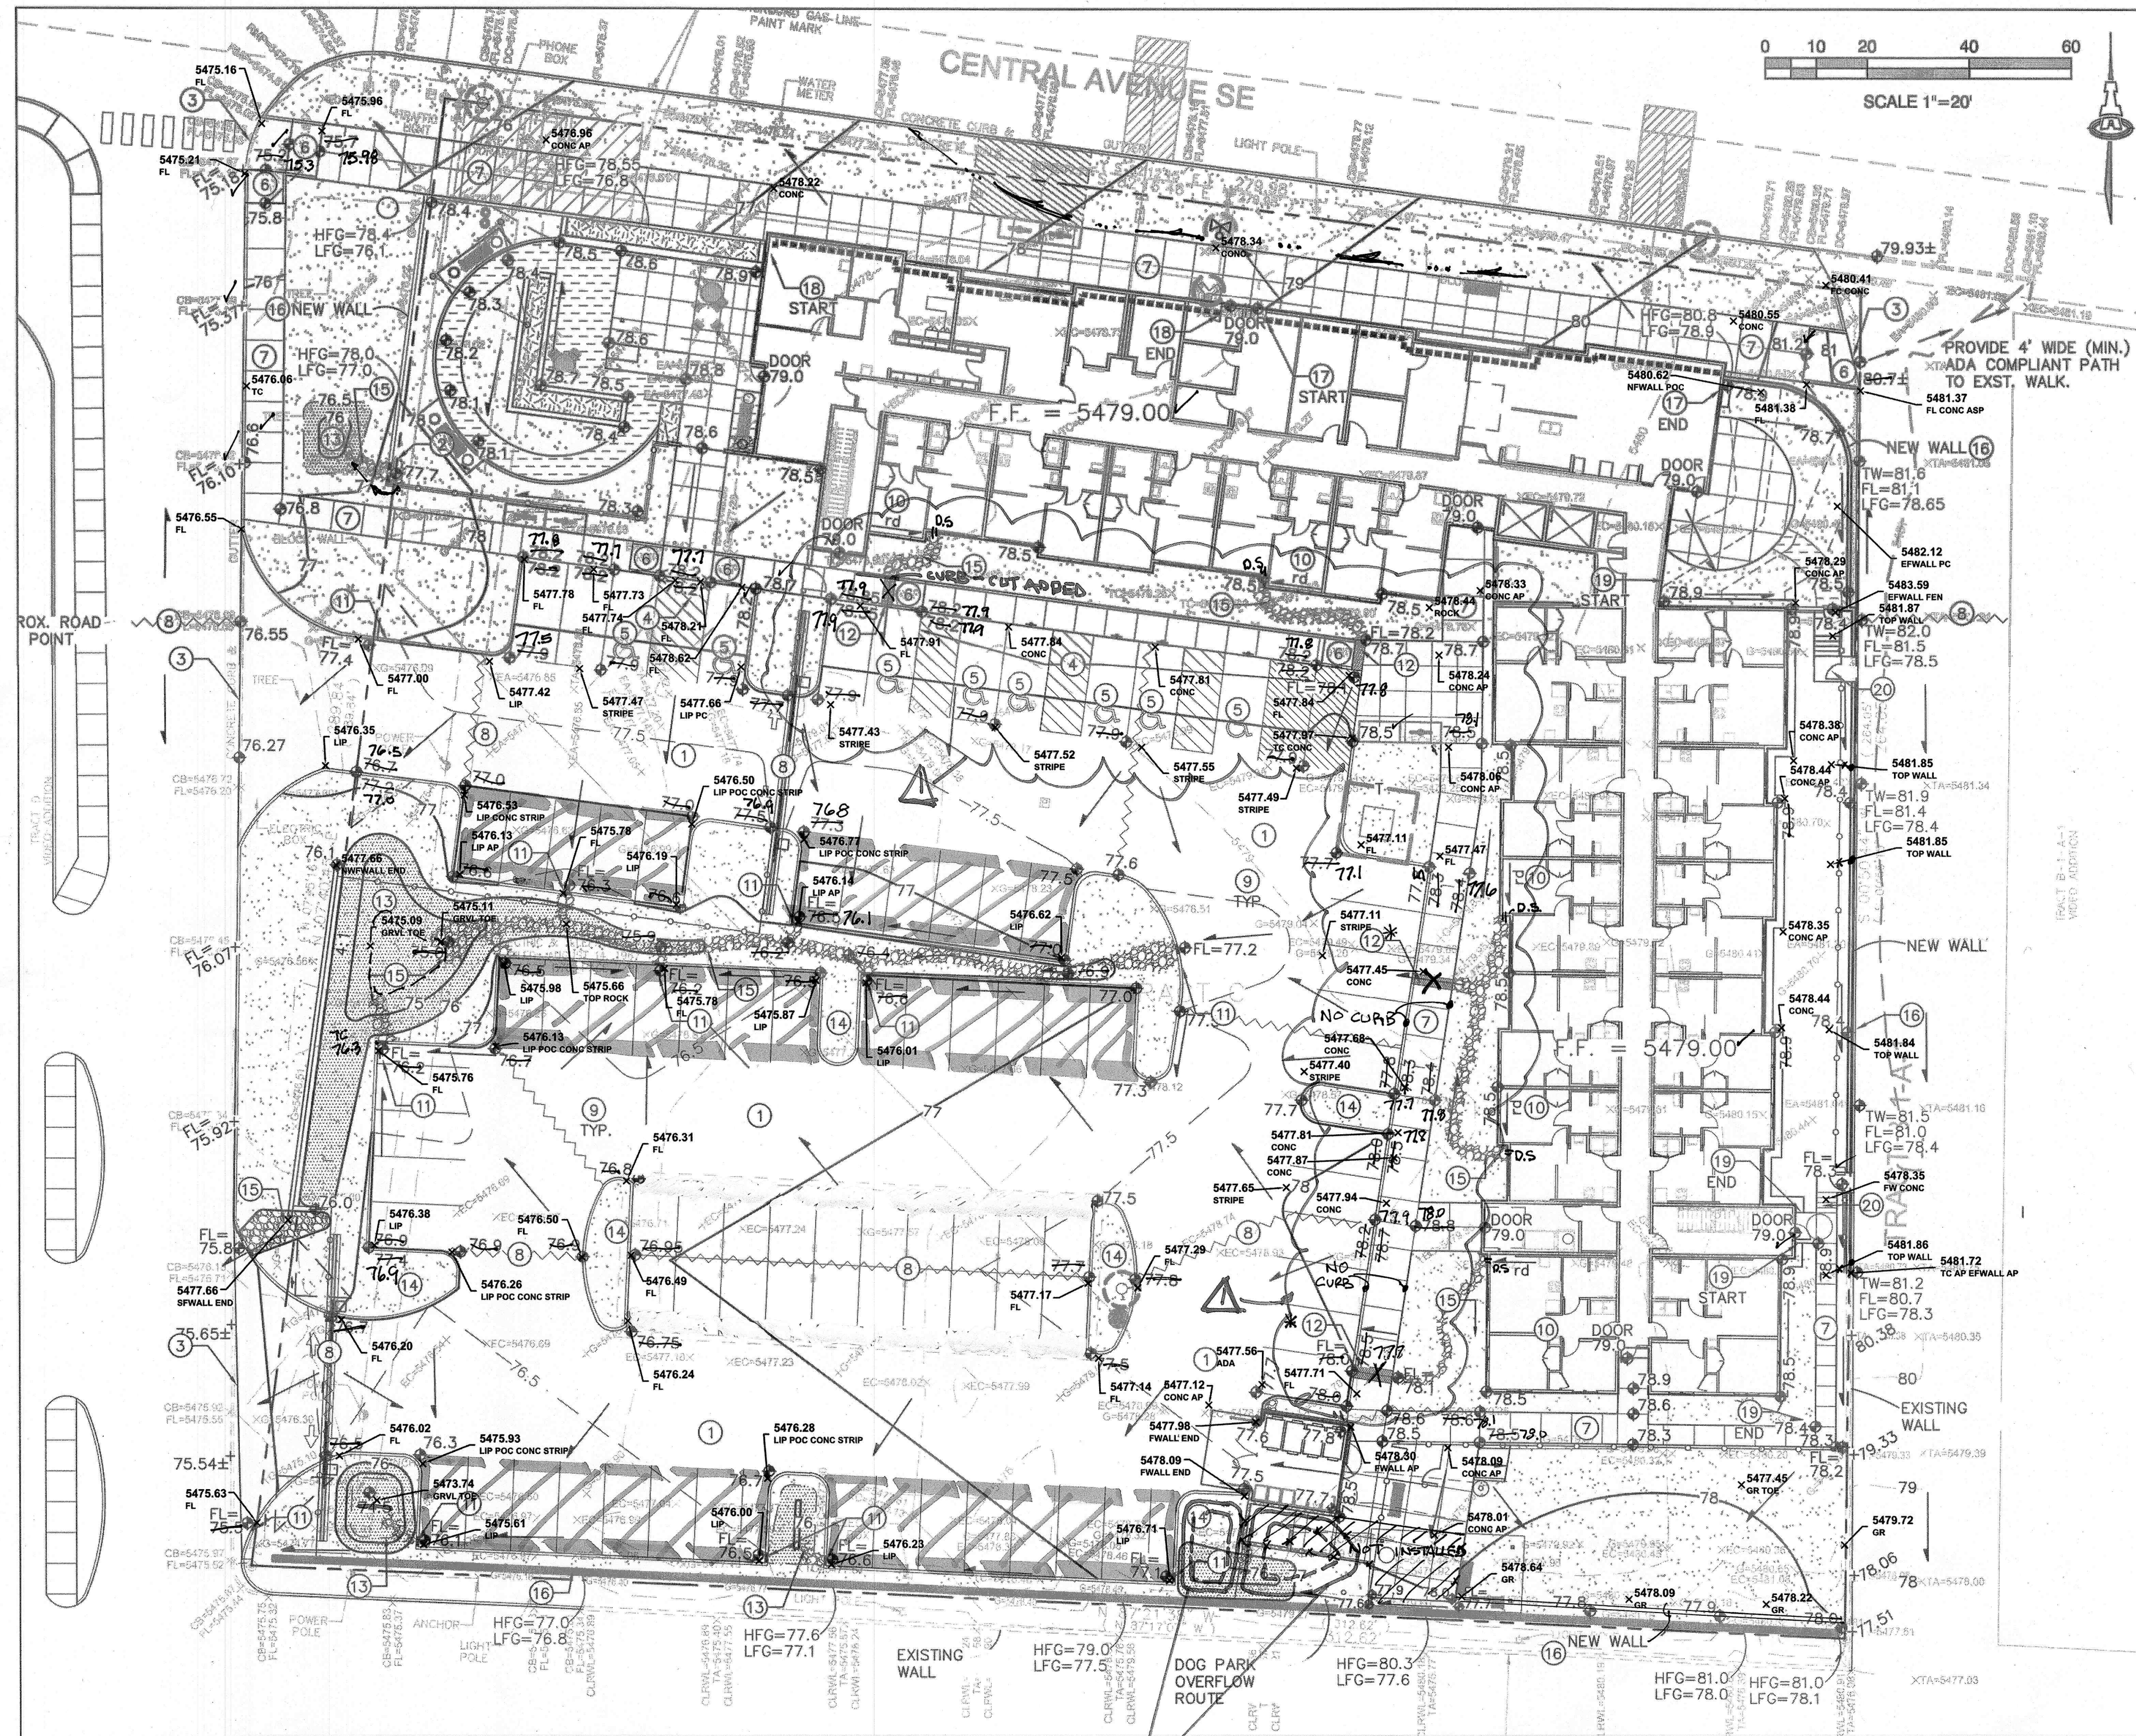

### KEYED NOTES

- NEW PAVING AT ELEVATIONS SHOWN. SEE PAVING PLAN FOR MATERIAL, EXTENTS, JOINTS AND PAVING SECTIONS.
- TWO 1' WIDE X 6" HIGH WALL OPENINGS AT FLOWLINE ELEVATION SHOWN.
- PROVIDE SMOOTH TRANSITION TO EXISTING PAVEMENT.
- TOP OF ASPHALT TO BE FLUSH WITH TOP OF CONCRETE WALK THIS AREA FOR ADA ACCESS.
- ADA COMPLIANT PARKING AREA.
- CONSTRUCT ADA COMPLIANT 1:12 MAX. SLOPE ADA COMPLIANT ACCESS RAMP.
- CONSTRUCT ADA COMPLIANT PEDESTRIAN WALK AT ELEVATIONS SHOWN.
- HIGH POINT / GRADE BREAK LOCATION.
- 0.5' DESIGN CONTOURS ARE SHOWN DASHED WHERE NECESSARY TO CLARIFY GRADING CONCEPT.
- CONCENTRATED ROOF DISCHARGE DIRECTION.
- PROVIDE 24" WIDE OPENING IN CURB TO PASS FLOW.
- CONSTRUCT 18" WIDE COVERED CONCRETE SIDEWALK CULVERT PER COA STD. DWG. 2236.
- CONSTRUCT 18" MAX. DEPTH STORMWATER QUALITY RETENTION POND AT ELEVATIONS SHOWN. STORMWATER QUALITY PONDING VOLUMES MAY BE VERIFIED AS PART OF AS-BUILT CERTIFICATION. PONDING WHICH DO NOT PROVIDE THE REQUIRED VOLUME WILL BE CORRECTED AT CONTRACTOR'S EXPENSE.
- DEPRESS LANDSCAPING IN FOR GENERAL WATER HARVESTING. NOTE: NO WATER HARVESTING SHALL OCCUR WITHIN 10' OF ANY BUILDING.
- INSTALL ANGULAR ROCK EROSION PROTECTION TO LIMITS HATCHED.
- CONSTRUCT GARDEN RETAINING WALL(S) (RETAINING < 36") TO ACHIEVE GRADE DIFFERENCE SHOWN. HFG = GRADE ON HIGH SIDE OF WALL; LFG = GRADE ON LOW SIDE OF WALL. STRUCTURAL DESIGN TO BE PROVIDED BY WALL CONTRACTOR.
- BUILDING RETAINING STEMWALL REQUIRED TO ACHIEVE GRADES SHOWN. SEE ARCHITECTURAL / STRUCTURAL PLANS.
- BUILDING EXTENDED STEMWALL REQUIRED TO ACHIEVE GRADES SHOWN. SEE ARCHITECTURAL / STRUCTURAL PLANS.
- CONSTRUCT CONCRETE APRON PER DETAIL ON CG-501.
- METAL FIRE ACCESS STEPS - OPEN BELOW FOR DRAINAGE. SEE ARCHITECTURAL.

**LEGEND**

- 5475.21 EXISTING CONTOUR
- 5478.21 EXISTING SPOT ELEVATION
- 77 PROPOSED 1.0' CONTOUR
- 77.5 PROPOSED 0.5' CONTOUR
- 77.0 PROPOSED SPOT ELEVATION
- FF = 5479.00 FLOW DIRECTION
- FF = 5479.00 FINISH FLOOR ELEVATION
- rd ROOF DISCHARGE DIRECTION
- High Point / Grade Break

**CRUSHER FINES INSTALLED INSTEAD OF THE LIGHT-DUTY HOT MIX ASPHALT**

**NOT INSTALLED DUE TO FLUSH ADA WALK**

**NOTE: AS-BUILT SURVEY SHOTS SHOWN IN THE SMALLER, FULL TONE FONT**

### VICINITY MAP L-21

### PROJECT DATA

**PROPERTY:** THE SITE IS FULLY DEVELOPED COMMERCIAL PROPERTY LOCATED WITHIN COA VICINITY MAP B-13. THE SITE IS BOUND TO THE EAST, SOUTH AND WEST BY COMMERCIAL PROPERTY (HOME DEPOT), AND TO THE NORTH BY CENTRAL AVE. NE.

**PROPOSED IMPROVEMENTS:** THE PROPERTY WAS PREVIOUSLY A MOBILE HOME PARK WITH COMMUNITY CENTER, PAVED PARKING AND ASSOCIATED SITE IMPROVEMENTS. THE PROPOSED IMPROVEMENTS INCLUDE CONSTRUCTION OF MULTI-FAMILY HOUSING WITH ASSOCIATED ASPHALT PAVED ACCESS, PARKING, AND LANDSCAPING.

**LEGAL:** TRACT "C" VIDEO ADDITION, ALBUQUERQUE, BERNALILLO COUNTY, NEW MEXICO

**BENCHMARK:** ELEVATIONS ARE BASED ON CITY OF ALBUQUERQUE STATION No. 5-K20, HAVING AN ELEVATION OF 5429.99, NAVD 1988.

**OFF-SITE:** MINOR OFF-SITE DRAINAGE FROM THE EAST DRIVE WILL BE REDIRECTED SOUTH.

**FLOOD HAZARD:** PER F.E.M.A. FLOOD MAP #35001C0359G, EFF: 9/26/2008, THE SITE IS LOCATED WITHIN FLOODZONE "X" DESIGNATED AS AREAS DETERMINED TO BE OUTSIDE 500-YEAR FLOODPLAIN.

**DRAINAGE PLAN CONCEPT:**

THIS PROPERTY IS INCLUDED AS 'PHASE III' IN THE APPROVED HOME DEPOT DRAINAGE REPORT DATED APRIL 28, 1994 (L21/D45) PREPARED BY TERRA WEST. THE TRACT FALLS WITHIN DRAINAGE BASIN B DESIGNATED TO DRAIN TO THE EXISTING HOME DEPOT PARKING LOT DETENTION POND #1 WITH ORIFICE CONTROLLED DISCHARGE TO THE PUBLIC STORM DRAIN SYSTEM IN EUBANK BLVD. THE TOTAL PROPERTY (16.38 ACRES) HAS A FULLY DEVELOPED RUNOFF OF 78.16 CFS OR 4.77 CFS/ACRE.

TRACT C IS 1.879 ACRES \* 4.77 CFS/ACRE = 9.0 CFS ALLOWABLE DISCHARGE. BASED ON CONCEPTUAL CALCULATIONS, THE PROPERTY WITH ANTICIPATED LAND TREATMENT RATIO OF 0.6A, 10.0B, 10.0C, 8.0D WILL GENERATE 8.7 CFS DURING THE 100-YEAR 6-HOUR DESIGN STORM < 9.0 CFS ALLOWABLE.

POND #1 WATER SURFACE ELEVATION = 5467.75 (1929 DATUM) = APPROX. 5470.45 BASED ON 2.7' ADJUSTMENT TO 1988 DATUM.

THE PLAT INCLUDES THE FOLLOWING REGARDING CROSS-LOT DRAINAGE: "THE OWNER OF TRACT B1 AND THE OWNER OF TRACTS C AND D EACH GRANT TO THE OTHER RECIPROCAL EASEMENTS FOR STORM DRAINAGE FLOWS ON AND OVER TRACT B1 FOR THE BENEFIT OF TRACTS C AND D AND ON AND OVER TRACTS C AND D FOR THE BENEFIT OF TRACT B1."

**SURVEYOR:** ANTHONY L. HARRIS, N.M.P.S.#11463  
THE SURVEY OFFICE, LLC  
333 LOMAS BOULEVARD N.E.  
ALBUQUERQUE, NM, 87102  
(505) 998-0303

**ENGINEER:** FRED C. ARFMAN, N.M.P.E. #7322  
ISAACSON & ARFMAN, INC.  
128 MONROE N.E.  
ALBUQUERQUE, NM, 87108  
(505) 268-8828

### 100% CONSTRUCTION DOCUMENTS

PROJECT STATUS:	90% CONSTRUCTION DOCUMENTS	PROJECT NUMBER:	19-0058	IA PROJECT NUMBER:	2374	DRAWN BY:	BUB	FOCA	10/1/2020
REVISIONS	No	Date							

### SHEET TITLE

## Grading & Drainage Plan

### ADA COMPLIANCE

SIDEWALK(S) AND RAMP(S): TARGET CROSS SLOPE = 1% TO 1.5%. CROSS SLOPE SHALL NOT EXCEED 2%

ACCESSIBLE RAMP(S): TARGET LONGITUDINAL SLOPE = 7% LONGITUDINAL SLOPE SHALL NOT EXCEED 12:1 (8.3%).

ACCESSIBLE PARKING: TARGET SLOPE = 1% TO 1.5% SLOPE SHALL NOT EXCEED 2% SLOPE IN ANY DIRECTION

### SHEET NUMBER

## CG-101

**Isaacson & Arfman, Inc.**  
Civil Engineering Consultants  
128 Monroe Street NE  
Albuquerque, NM 87108  
505-268-8828 | www.isa-arf.com

**FRED C. ARFMAN**  
7322  
NEW MEXICO  
REGISTERED PROFESSIONAL ENGINEER  
10/01/20

**LUMINARIA SENIOR COMMUNITY**  
10600 CENTRAL AVE SE  
ALBUQUERQUE, NM 87123

### DRAINAGE CERTIFICATION


I, Fred C. Arfman, NMPE 7322, of the firm Isaacson & Arfman, Inc., hereby certify that this project has been graded and will drain in substantial compliance with and in accordance with the design intent of the approved plan (M10/D021 dated 10/01/2020). The record information edited onto the original design document has been obtained by Russ Hugg, NMLS 9750, of the firm Surv-Tek, Inc. I further certify that I have personally visited the project site on 03-07-2022 and have determined by visual inspection that the survey data provided is representative of actual site conditions and is true and correct to the best of my knowledge and belief. This certification is submitted in support of a request for Permanent Certificate of Occupancy.

The record information presented hereon is not necessarily complete and intended only to verify substantial compliance of the grading and drainage aspects of this project. Those relying on this record document are advised to obtain independent verification of its accuracy before using it for any other purpose.

**Fred C. Arfman, PE**  
Date: 03-11-2022  
NMPE 7322

**NOTED AREA MODIFIED FROM ORIGINAL DESIGN TO ADD ADDITIONAL ADA PARKING SPACES. DID NOT AFFECT DRAINAGE CHARACTERISTICS.**



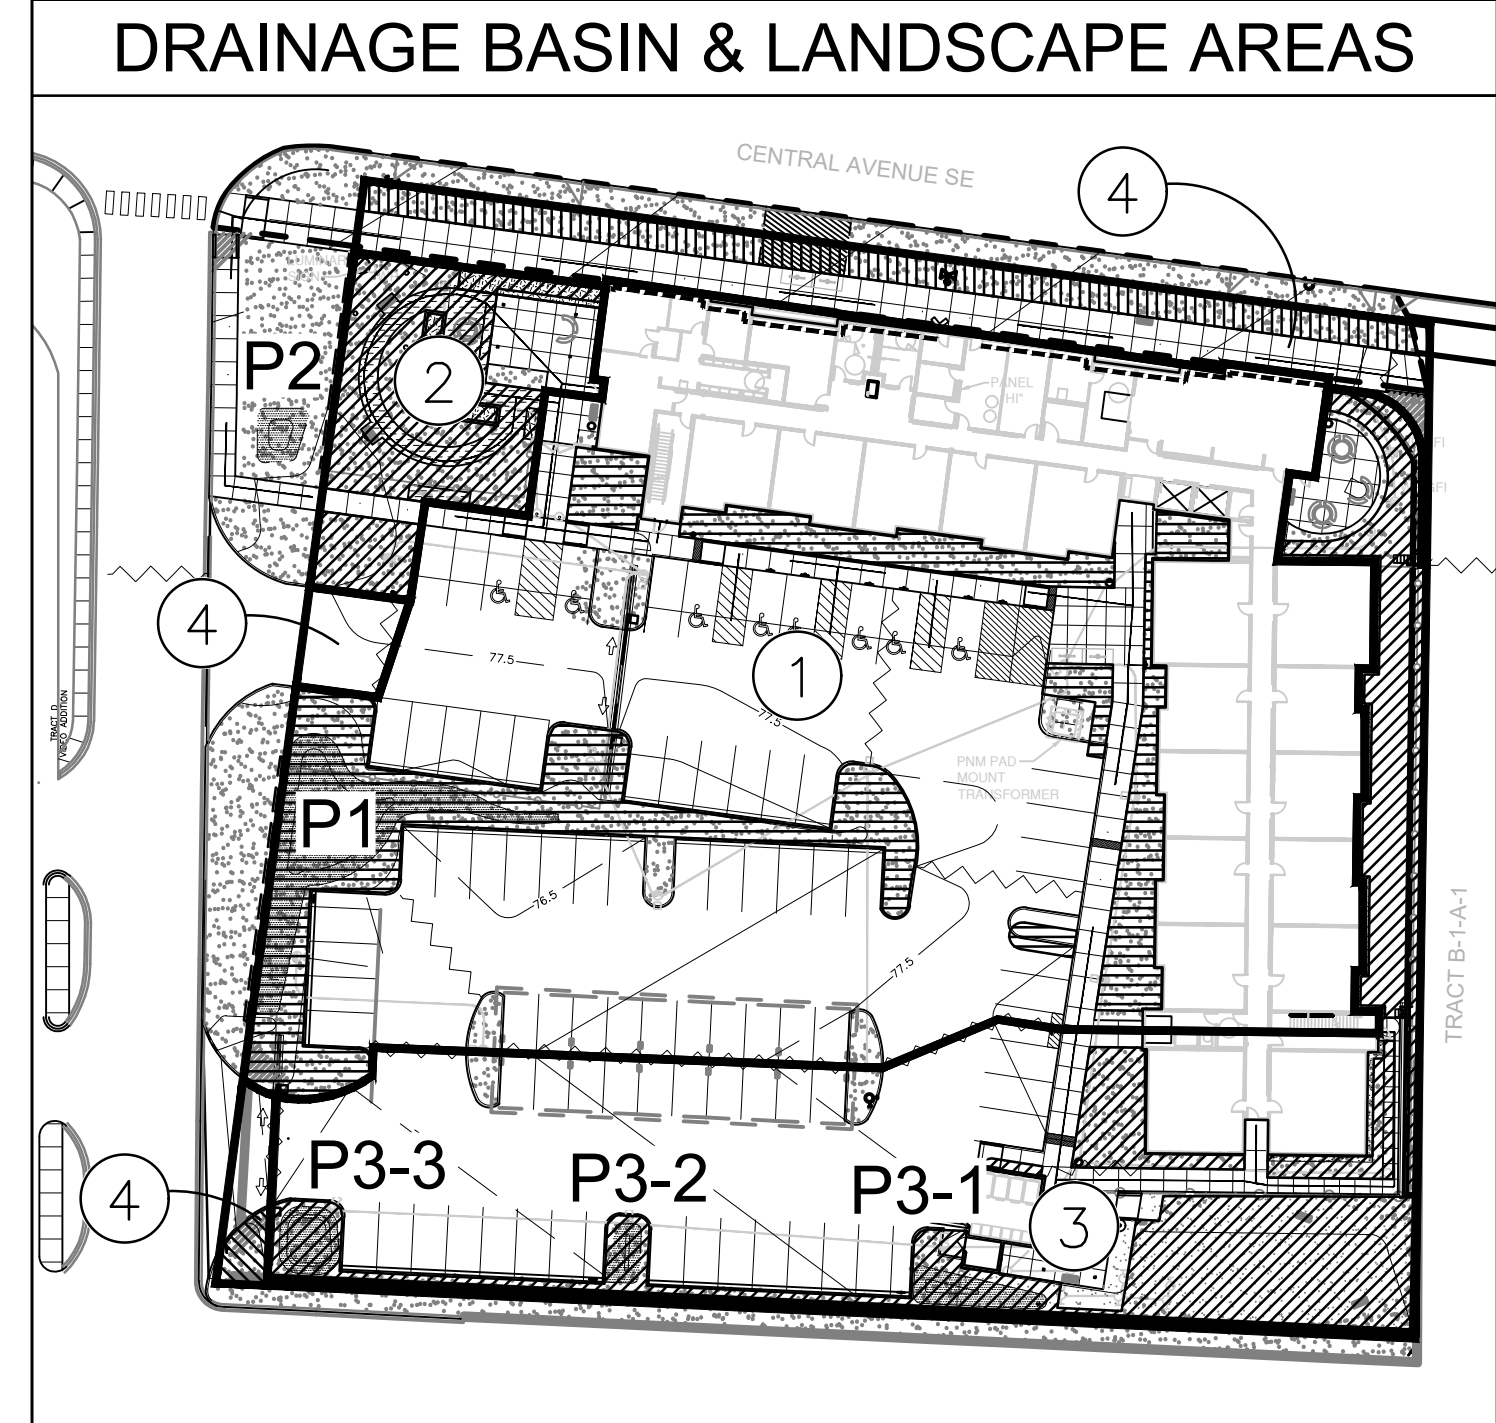

CALCULATIONS: Luminaria Senior Living : 23-Sep-2020									
Based on City of Albuquerque DMP, Article 6-2 Hydrology dated June 26, 2020									
100-YEAR, 6-HOUR CALCULATIONS									
AREA OF SITE:		81829		SF		=		1.8785 ACRE	
100-year, 6-hour									
HISTORIC FLOWS:		DEVELOPED FLOWS:				EXCESS PRECIP:			
	Treatment SF	%		Treatment SF	%		Precip. Zone	3	
Area A	=	0	0%	Area A	=	0	0%	E <sub>A</sub>	= 0.67
Area B	=	4091	5%	Area B	=	16366	20%	E <sub>B</sub>	= 0.86
Area C	=	45006	55%	Area C	=	0	0%	E <sub>C</sub>	= 1.09
Area D	=	32732	40%	Area D	=	65463	80%	E <sub>D</sub>	= 2.58
Total Area	=	81829	100%	Total Area	=	81829	100%		
On-Site Weighted Excess Precipitation (100-Year, 6-Hour Storm)									
Weighted E =		$E_A A_A + E_B A_B + E_C A_C + E_D A_D$							
		$A_A + A_B + A_C + A_D$							
Historic E	=	1.67 in.		Developed E	=	2.24 in.			
On-Site Volume of Runoff: V <sub>360</sub> = E*A / 12									
Historic V <sub>360</sub>	=	11419 CF		Developed V <sub>360</sub>	=	15247 CF			
On-Site Peak Discharge Rate: Q <sub>p</sub> = Q <sub>pA</sub> A <sub>A</sub> +Q <sub>pB</sub> A <sub>B</sub> +Q <sub>pC</sub> A <sub>C</sub> +Q <sub>pD</sub> A <sub>D</sub> / 43,560									
For Precipitation Zone 3									
Q <sub>pA</sub>		= 1.84		Q <sub>pC</sub>		= 3.17			
Q <sub>pB</sub>		= 2.49		Q <sub>pD</sub>		= 4.49			
Historic Q <sub>p</sub>	=	6.9 CFS		Developed Q <sub>p</sub>	=	7.7 CFS			

BASIN NO.	1	DESCRIPTION	Drains to SQ Pond P1
Area of basin flows =	47350	SF	= 1.09
The following calculations are based on Treatment %'s as shown in table to the right			
Sub-basin Weighted Excess Precipitation:		LAND TREATMENT	
Weighted E	=	2.33 in.	A = 0%
Sub-basin Volume of Runoff:			B = 14.7%
V <sub>360</sub>	=	9180	C = 0%
Sub-basin Peak Discharge Rate:			D = 85.3%
Q <sub>p</sub>	=	4.6	Stormwater Quality Volume
			875 CF
BASIN NO.	2	DESCRIPTION	Drains to SQ Pond P2
Area of basin flows =	4399	SF	= 0.10
The following calcatic:			
Sub-basin Weighted Excess Precipitation:		LAND TREATMENT	
Weighted E	=	1.05 in.	A = 0%
Sub-basin Volume of Runoff:			B = 89%
V <sub>360</sub>	=	385	C = 0%
Sub-basin Peak Discharge Rate:			D = 11%
Q <sub>p</sub>	=	0.3	Stormwater Quality Volume
			10 CF
BASIN NO.	3	DESCRIPTION	Drains to SQ Pond P3
Area of basin flows =	23081	SF	= 0.53
The following calculations are based on Treatment %'s as shown in table to the right			
Sub-basin Weighted Excess Precipitation:		LAND TREATMENT	
Weighted E	=	2.04 in.	A = 0%
Sub-basin Volume of Runoff:			B = 31.4%
V <sub>360</sub>	=	3924	C = 0%
Sub-basin Peak Discharge Rate:			D = 68.6%
Q <sub>p</sub>	=	2.0	Stormwater Quality Volume
			343 CF
BASIN NO.	4	DESCRIPTION	Free Discharge - No SQ Pond
Area of basin flows =	6999	SF	= 0.16
The following calculations are based on Treatment %'s as shown in table to the right			
Sub-basin Weighted Excess Precipitation:		LAND TREATMENT	
Weighted E	=	1.87 in.	A = 0%
Sub-basin Volume of Runoff:			B = 41.4%
V <sub>360</sub>	=	1089	C = 0%
Sub-basin Peak Discharge Rate:			D = 59%
Q <sub>p</sub>	=	0.6	Stormwater Quality Volume
			89 CF

STORMWATER QUALITY

STORMWATER QUALITY (SQ) CONTROL MEASURES ARE REQUIRED TO PROVIDE MANAGEMENT OF 'FIRST FLUSH'.

BECAUSE THIS PROPERTY WAS PREVIOUSLY FULLY DEVELOPED, THE REQUIRED FIRST FLUSH RETENTION VOLUME = 0.26" \* TYPE 'D' AREA: 0.26/12 \* (60,799 SF) = 1,317 CF. .

THE BASIN CALCULATIONS AT LEFT PROVIDE THE IMPERVIOUS AREA, REQUIRED STORMWATER QUALITY (SQ) VOLUME TO BE PONDED AS FOLLOWS:

BASIN 1 875 CF REQUIRED — DRAINS TO POND P1  
937 CF PROVIDED


BASIN 2 10 CF REQUIRED — DRAINS TO POND P2  
50 CF PROVIDED

BASIN 3 343 CF REQUIRED — DRAINS TO PONDS P3-1, P3-2, P3-3  
443 CF PROVIDED

BASIN 4 89 CF REQUIRED — REQUEST IN-LIEU-OF PAYMENT

A DRAINAGE COVENANT WILL BE REQUIRED FOR THE STORMWATER QUALITY FIRST FLUSH PONDS PRIOR TO CERTIFICATE OF OCCUPANCY APPROVAL.



STORMWATER QUALITY P1			STORMWATER QUALITY P3-1		
Contour	Area	Volume	Contour	Area	Volume
5476.0	1383		5377.1	220	
5475.0	480	937 CF	5376.0	45	146 CF
POND VOLUME = 937 CF			POND VOLUME = 146 CF		
STORMWATER QUALITY P2			STORMWATER QUALITY P3-2		
Contour	Area	Volume	Contour	Area	Volume
5476.5	160		5476.5	120	
5476.0	40	50 CF	5476.0	9	32 CF
POND VOLUME = 50 CF			POND VOLUME = 32 CF		
STORMWATER QUALITY P3-3			STORMWATER QUALITY P3-3		
Contour	Area	Volume	Contour	Area	Volume
5476.0	240		5476.0	240	
5474.5	100	255 CF	5474.5	100	255 CF
POND VOLUME = 255 CF			POND VOLUME = 255 CF		

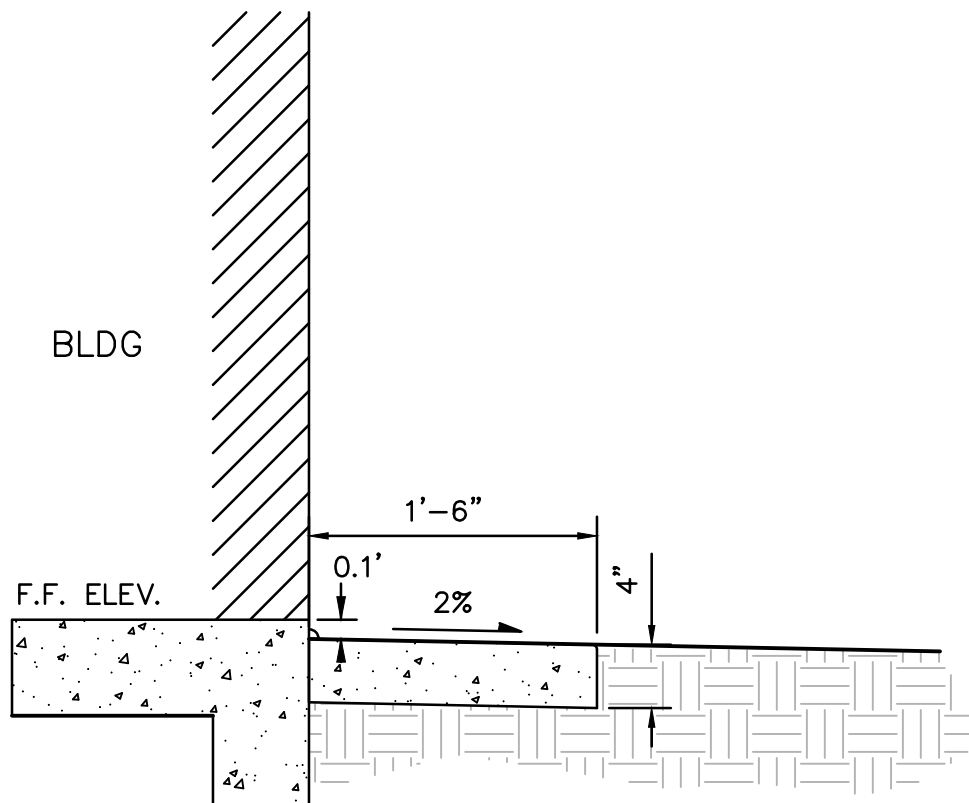

- GENERAL NOTES
- SEALED CONTRACTION / CONTROL JOINTS @ 6' MAX.
  - 1/2" SEALED EXPANSION JOINTS 36" O.C.
  - 3/8" RADII AT ALL EXPOSED EDGES.
  - PROVIDE 1/2" EXPANSION JOINT MATERIAL (FULL DEPTH) WITH SEALANT AT SURFACE BETWEEN BLDG. AND CONCRETE APRON.

CONCRETE APRON AT BUILDING

SCALE: N.T.S.

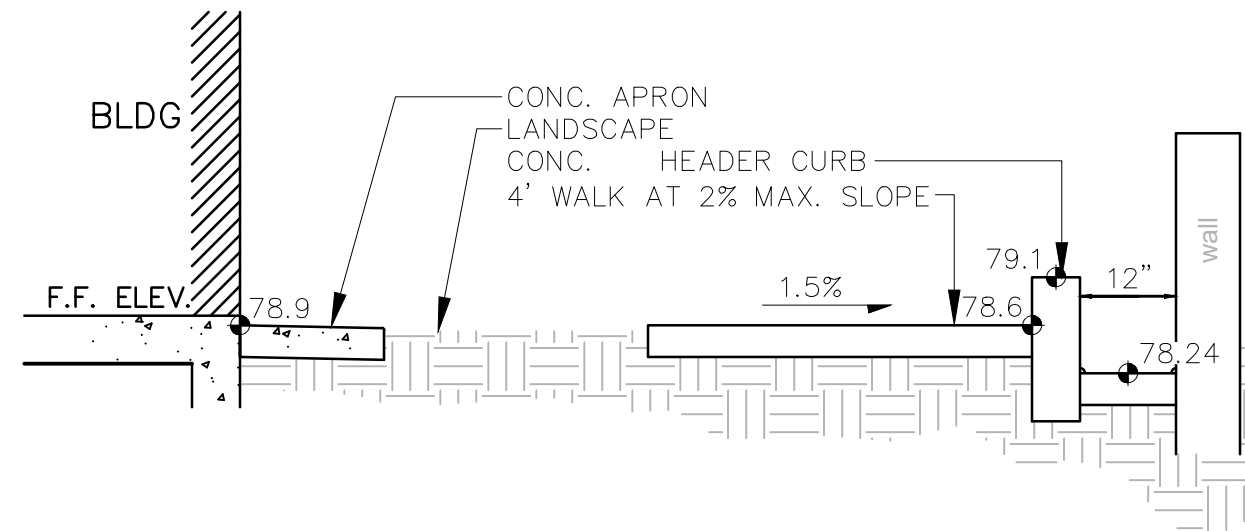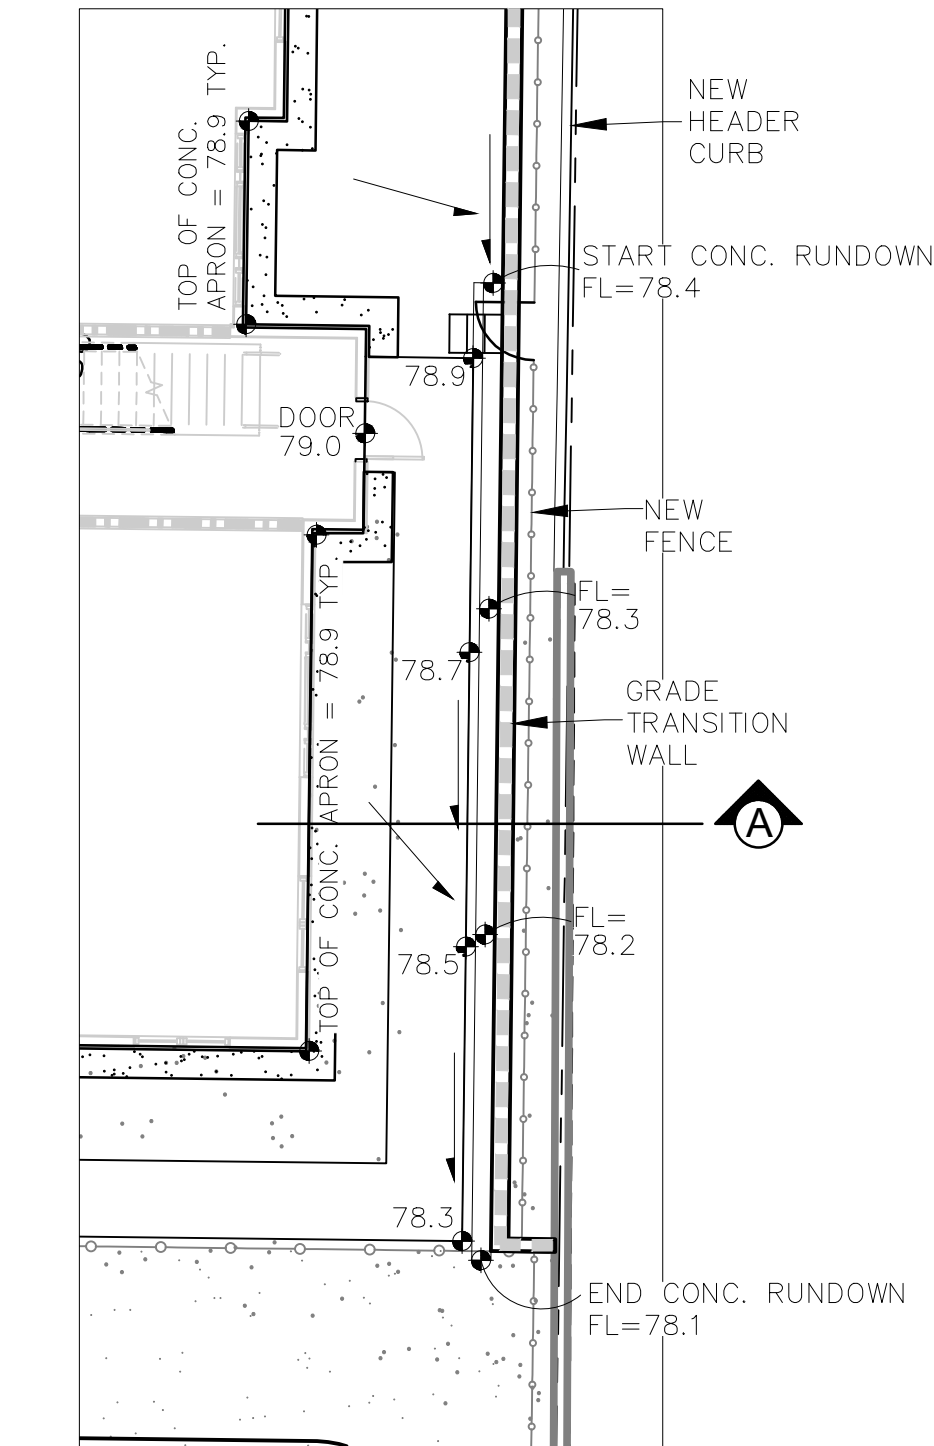

- SEALED CONTRACTION / CONTROL JOINTS @ 6' MAX.
- 1/2" SEALED EXPANSION JOINTS 36" O.C.
- 3/8" RADII AT ALL EXPOSED EDGES.
- PROVIDE 1/2" EXPANSION JOINT MATERIAL (FULL DEPTH) WITH SEALANT ALONG WALL AND CURB..

CONCRETE RUNDOWN

SCALE: N.T.S.

Isaacson & Arman, Inc.  
Civil Engineering Consultants

128 Monroe Street NE  
Albuquerque, NM 87108  
505-266-8828 | www.iacivil.com

2374 CG-101  
10/27/2020

FRED C. ARMAN  
NEW MEXICO  
7321  
LICENSED PROFESSIONAL ENGINEER

Engineer

LUMINARIA SENIOR COMMUNITY  
10600 CENTRAL AVE SE  
ALBUQUERQUE, NM 87123

100%  
CONSTRUCTION  
DOCUMENTS

PROJECT STATUS: 90% CONSTRUCTION DOCUMENTS  
PROJECT NUMBER: 19-0058  
IA PROJECT NUMBER: 2374  
DRAWN BY: BJB  
CHECKED BY: FCA  
DATE: 10/1/2020

REVISIONS

No.	Date	ADDENDUM 001
1	10/23/2020	

SHEET TITLE

Grading & Drainage Details & Calculations

SHEET NUMBER

CG-501