
# CITY OF ALBUQUERQUE

Planning Department
Brennon Williams, Director

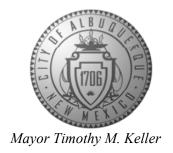

October 22, 2021

Scott McGee, PE Scott M. McGee PE, LLC 9700 Tanoan Dr. NE Albuquerque, NM 87111

**Re:** Singing Arrow Community Center

13200 Wenonah Ave. SE

Request for Certificate of Occupancy - Permanent Grading and Drainage Plan Stamp Date: 10/30/19

Certification dated: 10/15/21 Drainage File: L22D055

Dear Mr. McGee,

PO Box 1293 Based on the submittal received 10/18/21 and inspection on 10/22/21 this certification is approved

for Permanent Certificate of Occupancy by Hydrology.

Albuquerque If you have any questions, you can contact me at 924-3986 or earmijo@cabq.gov.

Sincerely,

NM 87103

Ernest Armijo, P.E.

www.cabq.gov Principal Engineer, Planning Dept.

**Development Review Services** 



## City of Albuquerque

# Planning Department Development & Building Services Division

#### DRAINAGE AND TRANSPORTATION INFORMATION SHEET (REV 11/2018)


Project Title: Building I		Permit #:	Hydrology File #:		
DRB#:	EPC#:		Work Order#:		
Legal Description:					
City Address:					
Applicant:			Contact:		
Address:					
			E-mail:		
Owner:			Contact:		
Address:					
			E-mail:		
TYPE OF SUBMITTAL:PLA	Γ (# OF LOTS)	RESIDENCE	_ DRB SITE ADMIN SITE		
IS THIS A RESUBMITTAL?:	Yes	No			
DEPARTMENT: TRAFFIC/ T	RANSPORTATION _	HYDROLOG	Y/ DRAINAGE		
Check all that Apply:  TYPE OF SUBMITTAL:  ENGINEER/ARCHITECT CERTON  CONCEPTUAL G & D PLAN  GRADING PLAN  DRAINAGE MASTER PLAN  DRAINAGE REPORT  FLOODPLAIN DEVELOPMENTON  ELEVATION CERTIFICATE  CLOMR/LOMR  TRAFFIC CIRCULATION LAY  TRAFFIC IMPACT STUDY (TIEST)  OTHER (SPECIFY)  PRE-DESIGN MEETING?	PERMIT APPLIC OUT (TCL)	TYPE OF APPROVAL/ACCEPTANCE SOUGHT:  BUILDING PERMIT APPROVAL  CERTIFICATE OF OCCUPANCY  PRELIMINARY PLAT APPROVAL  SITE PLAN FOR SUB'D APPROVAL  SITE PLAN FOR BLDG. PERMIT APPROVAL  FINAL PLAT APPROVAL  SIA/ RELEASE OF FINANCIAL GUARANTEE  FOUNDATION PERMIT APPROVAL  GRADING PERMIT APPROVAL  SO-19 APPROVAL  PAVING PERMIT APPROVAL  GRADING/ PAD CERTIFICATION  WORK ORDER APPROVAL  CLOMR/LOMR  FLOODPLAIN DEVELOPMENT PERMIT  OTHER (SPECIFY)			
DATE SUBMITTED:	By:				

COA STAFF: ELECTRONIC SUBMITTAL RECEIVED:\_\_\_\_

FEE PAID:

TRENCH DRAIN

N.T.S.

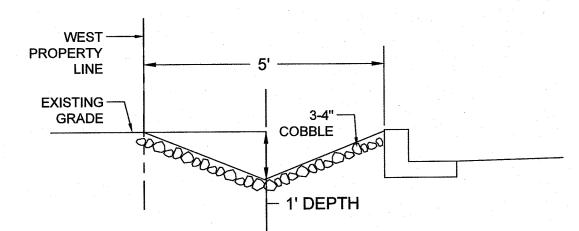


SWALE SLOPE = 1'/65' = 1.5% MANNING: Q = (1.49/.025)(2.5)(0.6)(.12) = 10.7 CFS

## **COBBLE SWALE SECTION 'A'**

N.T.S.

NOTE: SWALE TO EXTEND ENTIRE LENGTH OF NEW PARKING LOT.

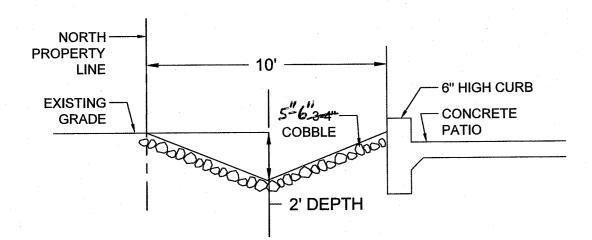


SWALE SLOPE = 1'/65' = 1.5% MANNING: Q = (1.49/.025)(2.5)(0.6)(.12) = 10.7 CFS

### **COBBLE SWALE SECTION 'B'**

N.T.S.

NOTE: SWALE SECTION TO EXTEND ENTIRE LENGTH OF CONCRETE PATIO

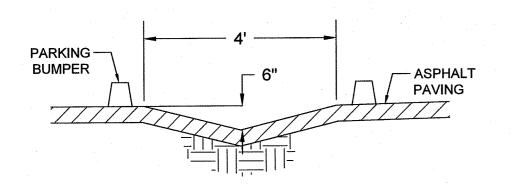

**ASPHALT SWALE SECTION** 

N.T.S.

POND VOLUMES							
ELEVATION	AREA (SF)	VOLUME (CF)					
25	1248	0					
26	1954	1601					
27	3076	4116					
28	4595	7951					

## **X** KEYED NOTES

4' CURBY (-40-)

OPENING 40,0

TC 38.2

FL 37.7

- EXISTING DRIVEPAD

TO REMAIN

FL 38.54

FL 36.5

A. BUILD ASPHALT 'VEE' SWALE BETWEEN MEDIANS (4' WIDE BY 6" DEEP) PER SECTION TO CONVEY FLOW SOUTH.

FL 41.0

FL 40.15

FL 39.0 V

FL 38.816

TC 38.0 FL 37.5




	SWQV								
DRAINAGE BASIN ID	AREA	%		AREA	x0.26"/12	SWQV			
	(SF)	% 'C'	% 'D'	'D' (SF)	(x0.0217)	REQ'D	PLAN		
1	4675	60	40	1850	x0.0217	40	50		
2	5410	66	34	1840	x0.0217	40	75		
3	4250	18	82	3485	x0.0217	75	90		
4	4860	15	85	4130	x0.0217	90	90		
5	12600	24	76	9580	x0.0217	208	250		
6	17055	23	77	13140	x0.0217	284	320		
7	11480	13	87	10000	x0.0217	<u>217</u>	300		
TOTAL	60,330			44025		954			


#### DRAINAGE CERTIFICATION


I, SCOTT M MCGEE, NMPE 10519, OF THE FIRM SCOTT M MCGEE PE, LLC, HEREBY CERTIFY THAT THIS SURVEY DATA PROVIDED IS REPRESENTATIVE OF ACTUAL SITE CONDITIONS AND IS TRUE AND SUPPORT OF A REQUEST FOR A PERMANENT CERTIFICATE OF OCCUPANCY.

TO VERIFY SUBSTANTIAL COMPLIANCE OF THE GRADING/ DRAINAGE ASPECTS OF THIS PROJECT. THOSE RELYING ON THIS RECORD DOCUMENT ARE ADVISED TO OBTAIN INDEPENDENT ACCURACY

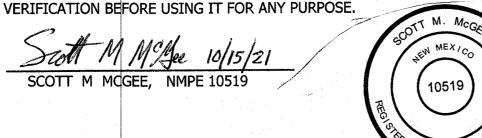

1" = 30'

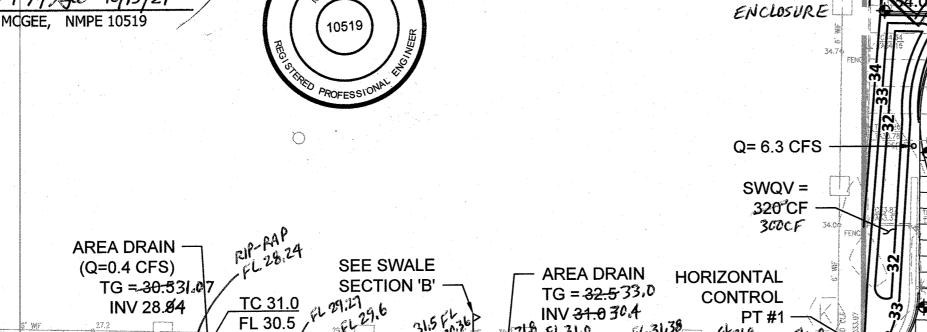

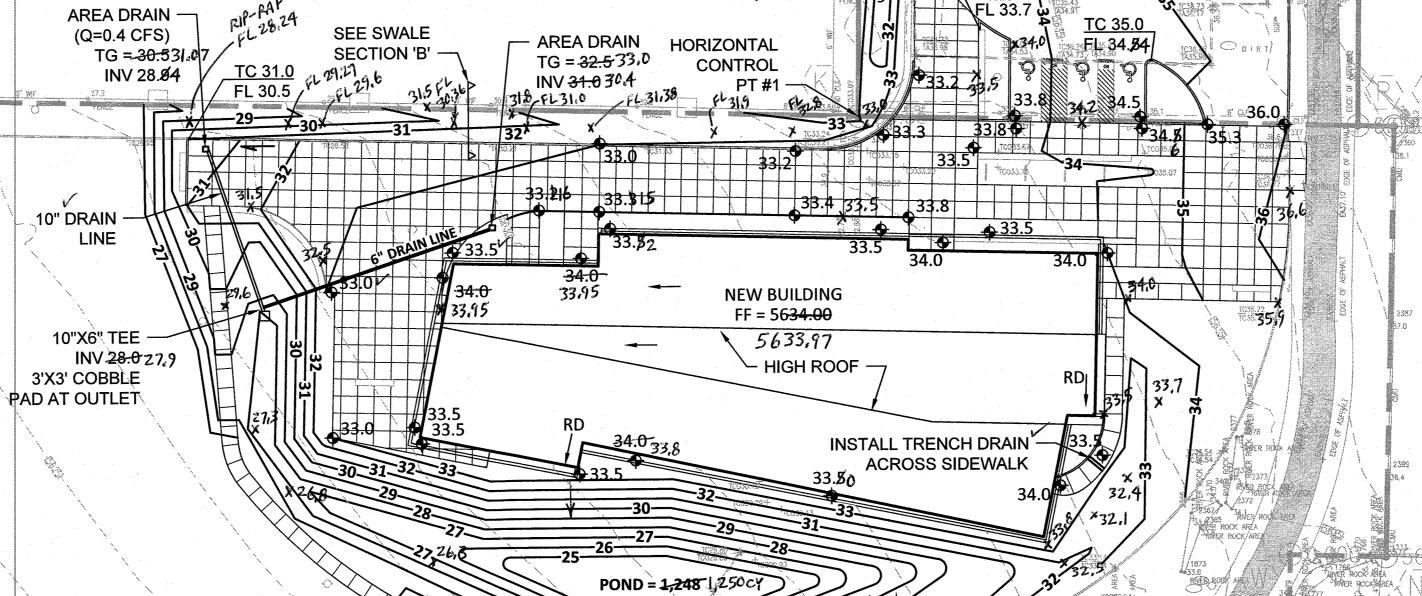

= 90 CF

**OPENING** 


Q= 3.0 CFS

**SWQV** 

RELOCATED

REFUSE

**GRADING & DRAINAGE PLAN** 

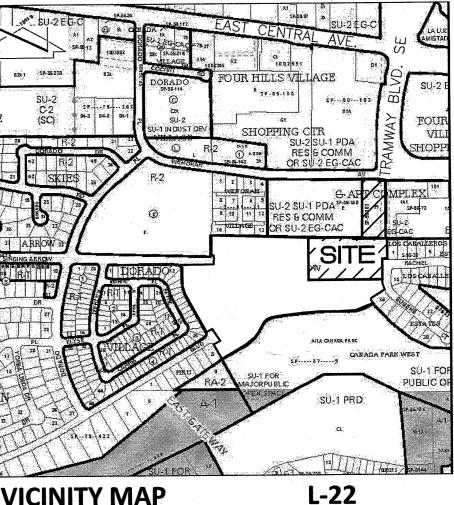

**VICINITY MAP NOT TO SCALE** 

**LEGEND** 

**EXISTING CONTOUR LINE NEW CONTOUR LINE** TW # BW # TOP OF WALL & BOTTOM OF WALL AT NEW RETAINING WALL FINISH FLOOR ELEVATION FF = 5634.00**4** 18.9 **NEW SPOT ELEVATION** TOP OF CURB FL 18.5 FLOW LINE **ROOF DRAIN DRAINAGE BASIN ID's** 

> DRAINAGE BASIN LINE AS-BUILT ELEVATION

**DRAINAGE ANALYSIS** 

LEGAL: A portion of TRACT A SINGING ARROW PARK and TRACT F-1 FOUR HILLS VILLAGE SHOPPING CENTER AND APARTMENT COMPLEX

AREA: Tract F-1 is 1.385 acres and the portion of Tract A (park area) is 1.045 acres for a total project area of 2.43 acres.

SURVEYOR: High Mesa Consulting Group NMPLS # 15075, dated December 2016. All elevations based on COA BM '2 L22 ACS', a brass disk in concrete curb on the center median curb west of the intersection of Central Avenue and Tramway Blvd NE. ELEV=5662.682 (NAVD88).

TEMPORARY BENCHMARK (TBM): A mag nail in the asphalt near the south end of the parking lot as shown. ELEVATION = 5636.62 (NAVD 1988)

FLOOD HAZARD: From FEMA Map 35001C 0378G (9/26/2008), the park site is within Zone 'X' which is determined to be outside the 1% annual chance floodplain.

EXISTING CONDITIONS: Both the existing parking lot and the developed park site slope down from northeast to southwest. Existing slopes vary from 3 - 4%. The existing parking lot drains southwest to the park site. The park site also drains by sheet flow to the southwest.

PROPOSED IMPROVEMENTS: The proposed improvements include a 14,600 SF community building. The existing parking lot is proposed to be re-built in the same location. Water harvesting will be used to direct runoff to depressed landscape areas along the west side of Tract F-1 to retain runoff onsite.

OFFSITE DRAINAGE: No offsite flow is accepted by this site. Wenonah Avenue runs along the north side of the site and Rachel Road SE abuts the east side of the site. Both existing streets carry runoff around the park.

DRAINAGE APPROACH: The proposed drainage plan follows historic drainage patterns. The existing parking lot will continue to have free discharge to the Singing Arrow Park. The park site discharges runoff to the southwest. Roof runoff is routed to depressed landscaped areas on the south side of the building. Any excess runoff then discharges overland to the park surface.

LAND TREATMENT--Per the DPM, this site is Precipitation Zone 3 and the land treatment is basically unchanged for Tract F-1 which is as follows: Tr F-1: 5% B, 22% C, 73% D Q= (4.55 CFS/AC)(1.385)= 6.3 CFS Tr F-1 SWQV = 44,025(0.26/12) = 954 CF The portion of the park is land treatment as follows: Q = (2.77)(1.045) = 2.9 CFSEXISTING: 93% B 7% D

DEVELOPED: 22% B, 31% C, and 47% D Q= (4.00)(1.045) = 4.2 CFS DEVELOPED V=[(.22)(.077)+(.31)(.108)(.47)(.197)](45300)=6,480 CF  $1^{St}$  Flush V = (21395)(0.34/12) = 606 CF [7,950 CF provided--OK] Runoff will be mitigated through retaining storm water volume within the park.





C100