

REPLAT & CORRECTION PLAT OF
"REVISED" CORRECTED & AMENDED PLAT OF
NORTH FOUR HILLS SUBDIVISION
ALBUQUERQUE, BERNALILLO COUNTY, NEW MEXICO
FEBRUARY, 1986

08723030

PURPOSE

- The purpose of this plat is:
1. To correct computational errors along the Frontage Road on Tracts A, D, and E, and to correct acreages to match dimensions on all lots.
 2. To dedicate additional drainage easements on Tract J, Lot 8A through 19A of Block 2, and Lots 13A, and 14A of Block 1, and to change the corresponding lots numbers.
 3. To eliminate the duplication of street names by changing the street names used on this plat.

LEGAL DESCRIPTION

A certain tract of land situate within Bernalillo County, New Mexico being further described as the "REVISED CORRECTED & AMENDED PLAT OF North Four Hills", within Section 26, Township 10 North, Range 4 East NMPM, Bernalillo County, New Mexico as the same is shown and designated on said plat, filed in the office of the County Clerk, Bernalillo County, New Mexico on June 15, 1984, and being more particularly described as follows:

Beginning at the Southwest corner of the tract herein described, from whence the Southwest corner of said Section 26 bears S 00 deg 30 min 00 sec E, 1141.00 feet;

thence S 89 deg 22 min 30 sec W, 1282.01 feet, and running from the point of beginning;

thence, N 00 deg 33 min 23 sec W, 1569.60 feet;

thence, N 00 deg 32 min 39 sec W, 854.75 feet to the Northwest corner, being a point on the Southerly Right of Way line of I-40 South Frontage Road;

thence, following said Southerly Right of Way line, following a curve to the right, whose radius is 7465.00 feet and whose long chord bears S 71 deg 22 min 03 sec E, 1401.73 feet, through an arc of 1403.81 feet to the Northeast corner;

thence, leaving said Southerly Right of Way line, S 01 deg 12 min 14 sec E 1951.34 feet the Southeast corner;

thence, N 79 deg 22 min 38 sec W, 524.48 feet;

thence, N 83 deg 45 min 00 sec W, 130.50 feet;

thence, S 66 deg 53 min 27 sec W, 411.95 feet;

thence, N 85 deg 30 min 00 sec W, 322.79 feet, to the point of beginning and containing 66.4487 acres by this survey.

NOTES:

1. Zone Atlas L-23-Z
2. Prior to development water and sanitary sewer service to these properties must be verified and coordinated with the City of Albuquerque Water Resources Department.

OWNER'S CERTIFICATE

The subdivision shown hereon, the dedication of right-of-way, and the grants of easement hereby is with the free consent and in accordance with the desires of the undersigned owner's and/or proprietors thereof.

The undersigned owner's and/or proprietors do hereby freely consent to all the foregoing and do hereby represent that we are authorized to so act.

Cyrus Varan
Mortera Jafari, owner
Cyrus Varan, owner
State of New Mexico)
County of Bernalillo) SS


The foregoing instrument was acknowledged before me this 6th day of March, 1986 by Mortera Jafari and Cyrus Varan.

My comm. expires 4-1-89

Notary Public

DEDICATION NOTES:

1. Tract I is city park and drainage right-of-way.
2. Tracts L and M are privately owned open space with drainage easements over the entire tract.

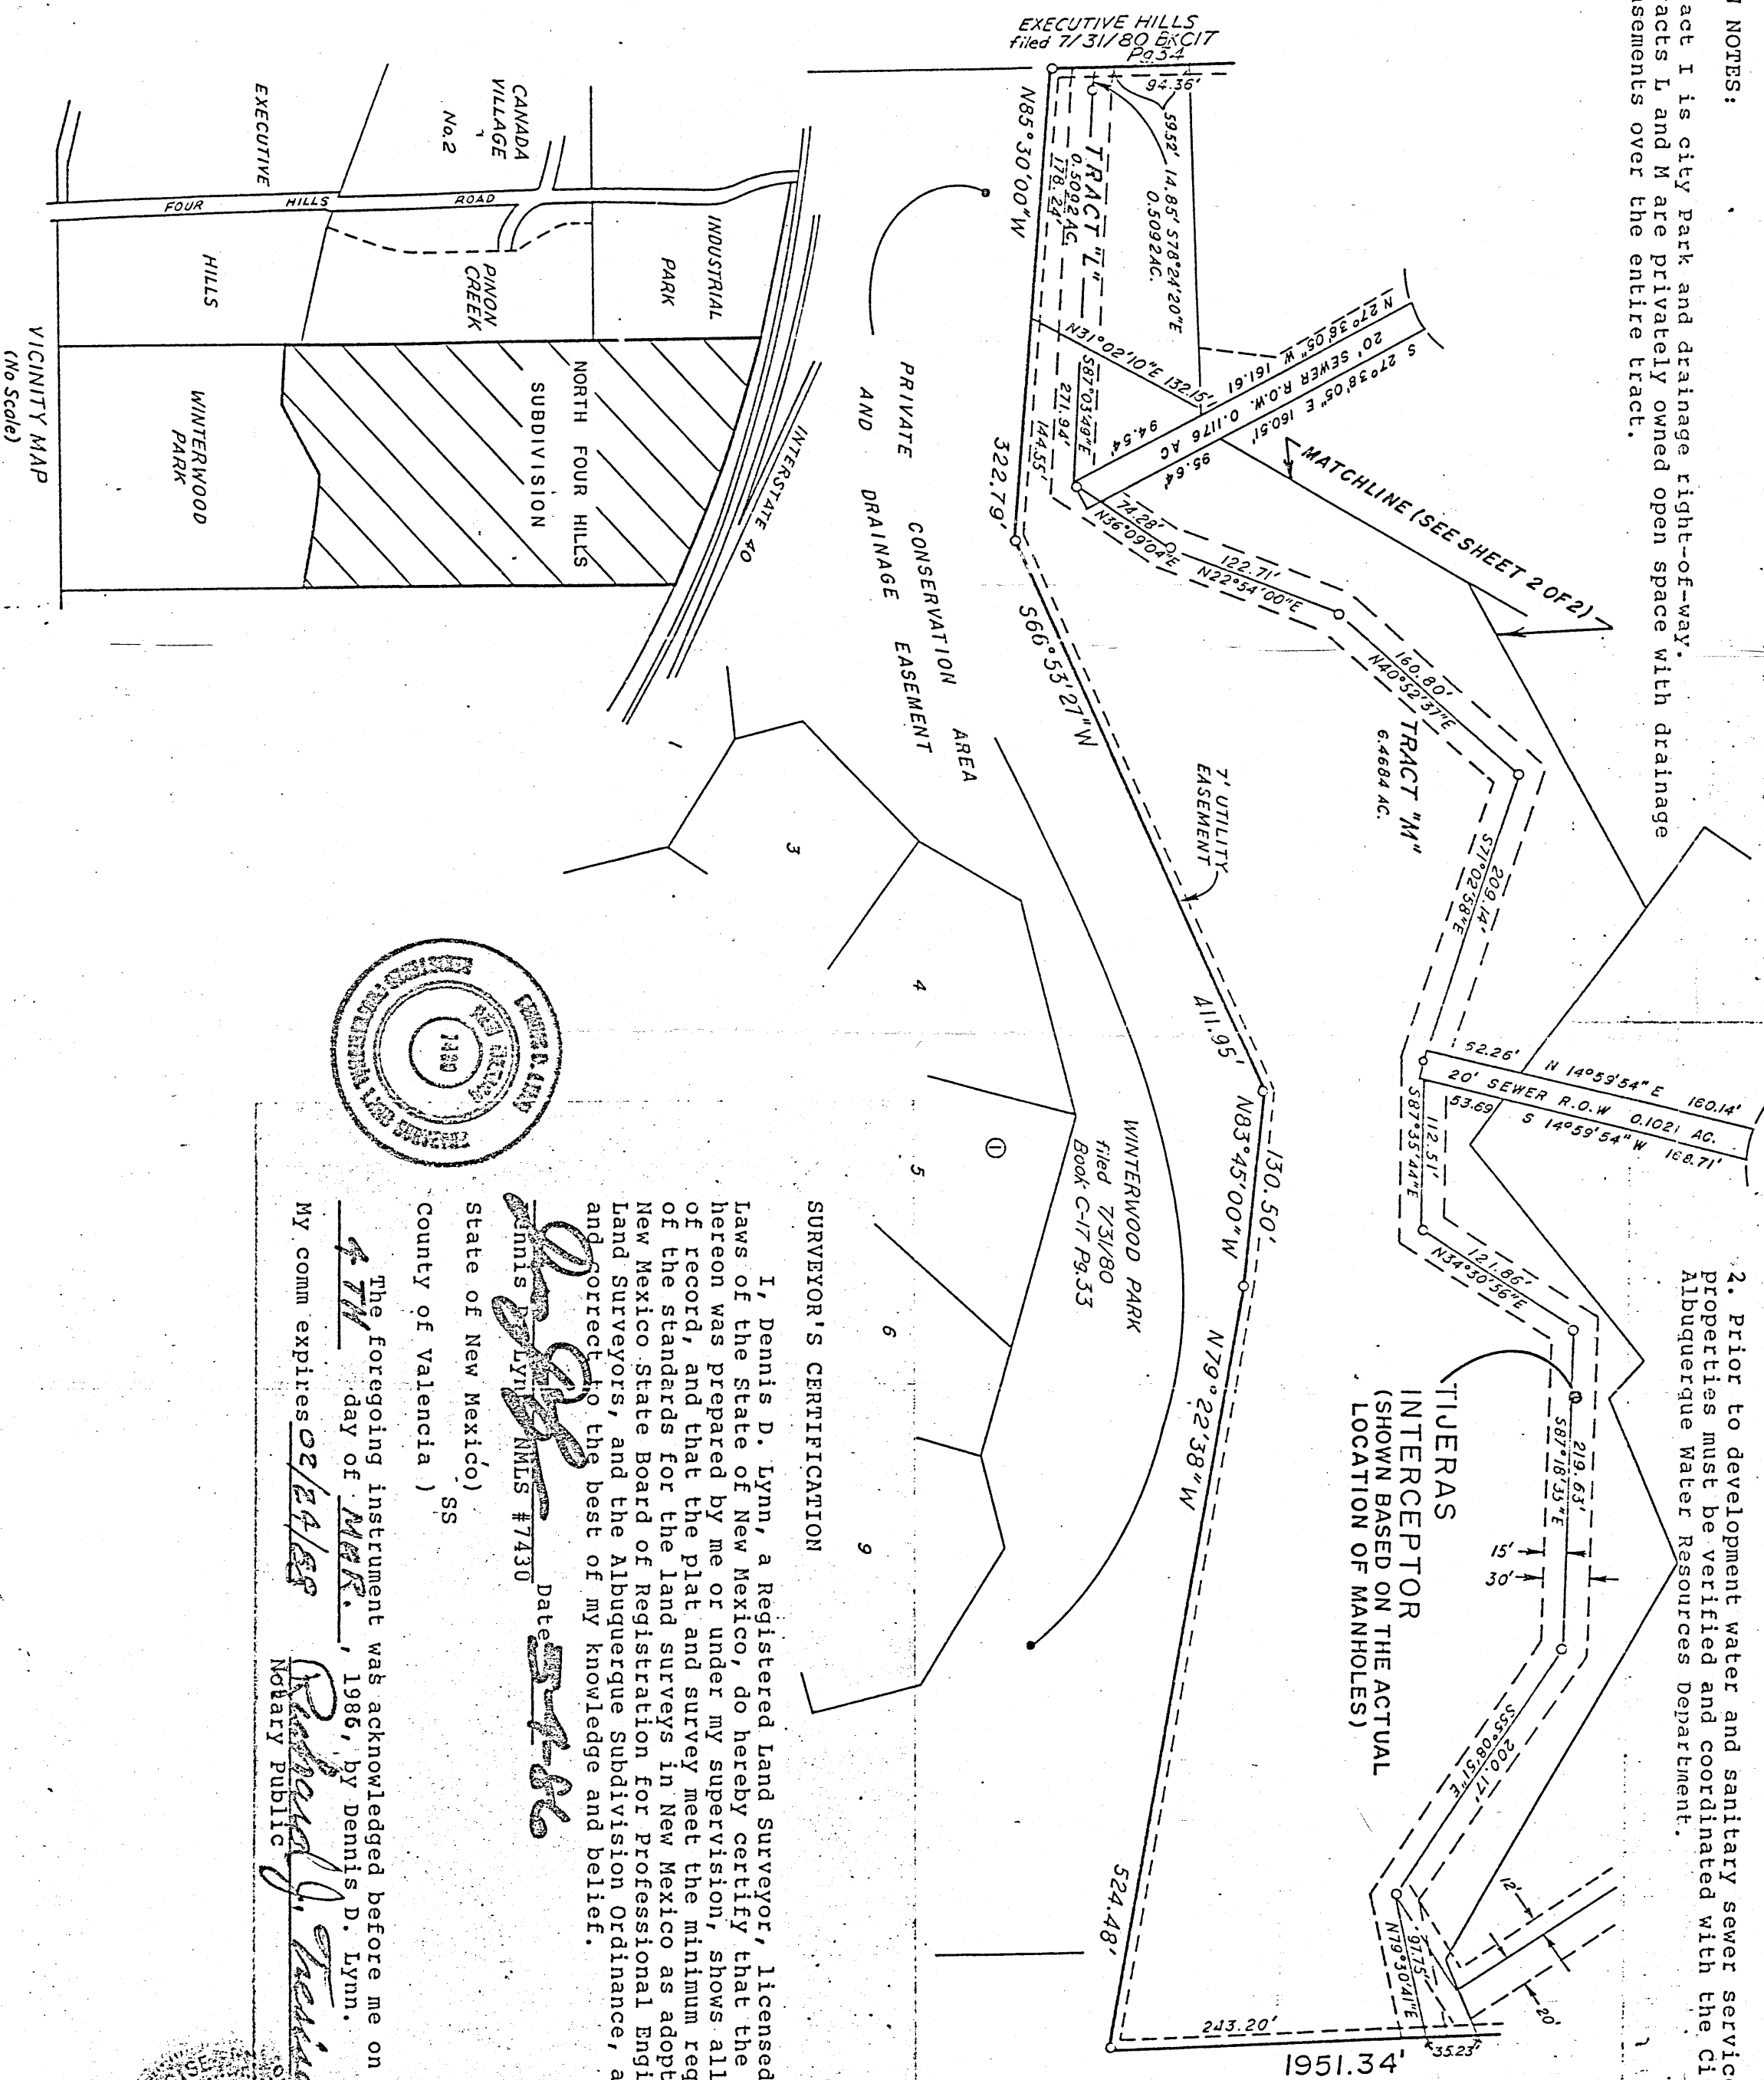


SURVEYOR'S CERTIFICATION

I, Dennis D. Lynn, a Registered Land Surveyor, licensed under the laws of the State of New Mexico, do hereby certify that the plat shown hereon was prepared by me or under my supervision, shows all easements of record, and that the plat and survey meet the minimum requirements of the standards for the land surveys in New Mexico as adopted by the New Mexico State Board of Registration for Professional Engineers and Land Surveyors, and the Albuquerque Subdivision Ordinance, and is true and correct to the best of my knowledge and belief.

Dennis D. Lynn Date 2-4-86
Surveyor
State of New Mexico)
County of Valencia) SS


The foregoing instrument was acknowledged before me on this 4th day of MAR., 1986, by Dennis D. Lynn.
My comm. expires 02/24/88
Richard J. Lewis
Notary Public

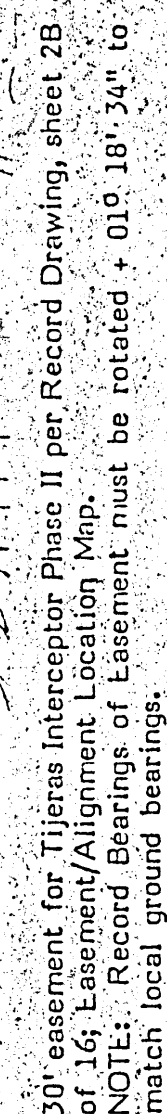

NOTES

1. ALL CUT AND FILL SLOPES ARE 3H:1V OR AS INDICATED WITH EROSION CONTROLS.
2. FOR FLOOD PLAIN EASEMENT AND DRAINAGE EASEMENT DETAILS, SEE ACCOMPANYING REPORT.
3. TEMPORARY CONSTRUCTION EASEMENTS OF 250' WIDTH ON CENTER LINE OF PUBLIC STREETS WILL BE PROVIDED.
4. UTILITY EASEMENTS WILL BE PROVIDED AROUND THE PROPERTY BOUNDARIES AND ALONG ALL PUBLIC AND PRIVATE STREET FRONTAGE.

CITY OF ALBUQUERQUE					
MUNICIPAL DEVELOPMENT DEPARTMENT					
ENGINEERING DIVISION					
TITLE: NORTH FOUR HILLS DRAINAGE AND GRADING PLAN					
APPROVALS	ENGINEER	DATE	APPROVALS	ENGINEER	DATE
City Engineer			Liquid Waste		
A C E - Design			Traffic		
A C E - Hydrology			Water		
DRAWING NO.		MAP NO.		SHEET 1 OF 1	

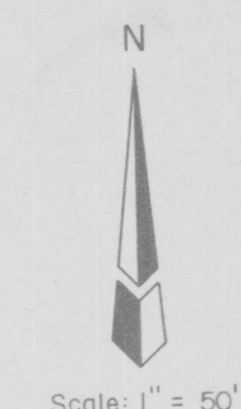

RECORD DRAWING

I hereby certify that the information contained on this drawing has been revised in accordance with information furnished by the Contractor, MJB Enterprises and by the Surveyor, D. Mark Goodwin and Associates, and reflects the construction as actually accomplished. This plan as constructed is in dose compliance with the Approved Plan, particularly with respect to the backslips and ponding areas.

Mark Goodwin 5/1/93
Mark Goodwin, NMPE 8948

LEGEND

- 5560 — EXISTING CONTOUR
- 100 — PROPOSED CONTOUR
- - - - - SUBDIVISION BOUNDARY
- - - - - EDGE OF ARROYO

LEGAL DESCRIPTION

Lot 11A, Block One, and Lots 7A, 9A and 10A, Block Two, North Four Hills Subdivision, Albuquerque, Bernalillo County, New Mexico.

ACS BENCHMARK


The station in a standard ACS brass tablet stamped "TOM - 1978", set in a concrete post projecting 2" above ground. To reach the station from the intersection of I-40 and Tramway Blvd. SE, go south on Tramway 0.1 miles to the frontage road. Turn left, go east to the intersection of the frontage road and Waterfall Dr. Turn right, go south on Waterfall Dr. for 0.14 miles. The station is located approximately 250 feet east of Waterfall Dr.

"TOM 1978" EL. = 5711.67'

NOTES

- 1 ALL DISTURBED AREAS ARE TO BE RECOMPACTED THEN SEEDED PER CITY OF ALBUQUERQUE STANDARD SPECIFICATIONS FOR PUBLIC WORKS CONSTRUCTION, SECTION 1011, AS MODIFIED.
- 2 LOCATION OF TEMPORARY HAUL ROAD IS APPROXIMATE. CONTRACTOR IS TO PLACE ROAD SUCH THAT NO DAMAGE TO EXISTING VEGETATION OCCURS. UPON COMPLETION OF CONSTRUCTION, ROAD IS TO BE OBLITERATED. SEEDING WILL NOT BE NECESSARY.
- 3 ALL RUBBLE REMOVED FROM SLOPED IS TO BE DISPOSED OF IN AN ACCEPTABLE MANNER. UNDER NO CIRCUMSTANCES IS RUBBLE TO BE DISPOSED OF ON SITE OR IN ADJACENT ARROYOS OR STRUCTURES.
- 4 WHEREVER CONTRACTOR CROSSES THE TIJERAS INTERCEPTOR, ADEQUATE PROTECTION IS TO BE PROVIDED.
- 5 FOR FINISHED LINES AND GRADES, SHEET 2.
- 6 LIMITS OF RUBBLE AND TOPOGRAPHY ACQUIRED BY FIELD SURVEY 9/90.
- 7 SLOPE COMPACTION IS TO BE ACCOMPLISHED BY TRACKED VEHICLE EQUIVALENT TO A D-4 OR HEAVIER.


FIELD VERIFICATION SURVEY PERFORMED 1/93.

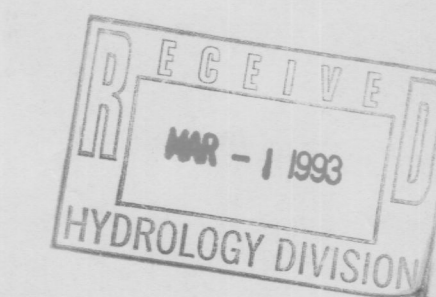


NORTH FOUR HILLS SUBDIVISION FLOOD PLAIN RECLAMATION

dmg D. MARK GOODWIN & ASSOCIATES, P.A.
CONSULTING ENGINEERS & SURVEYORS
P.O. BOX 90606
ALBUQUERQUE, NEW MEXICO 87199
(505) 828-2200


Designed: DMG Drawn: MLM Checked: DMG Sheet 1 of 2
Scale: 1" = 50' Date: 9/90 Job: 90-40

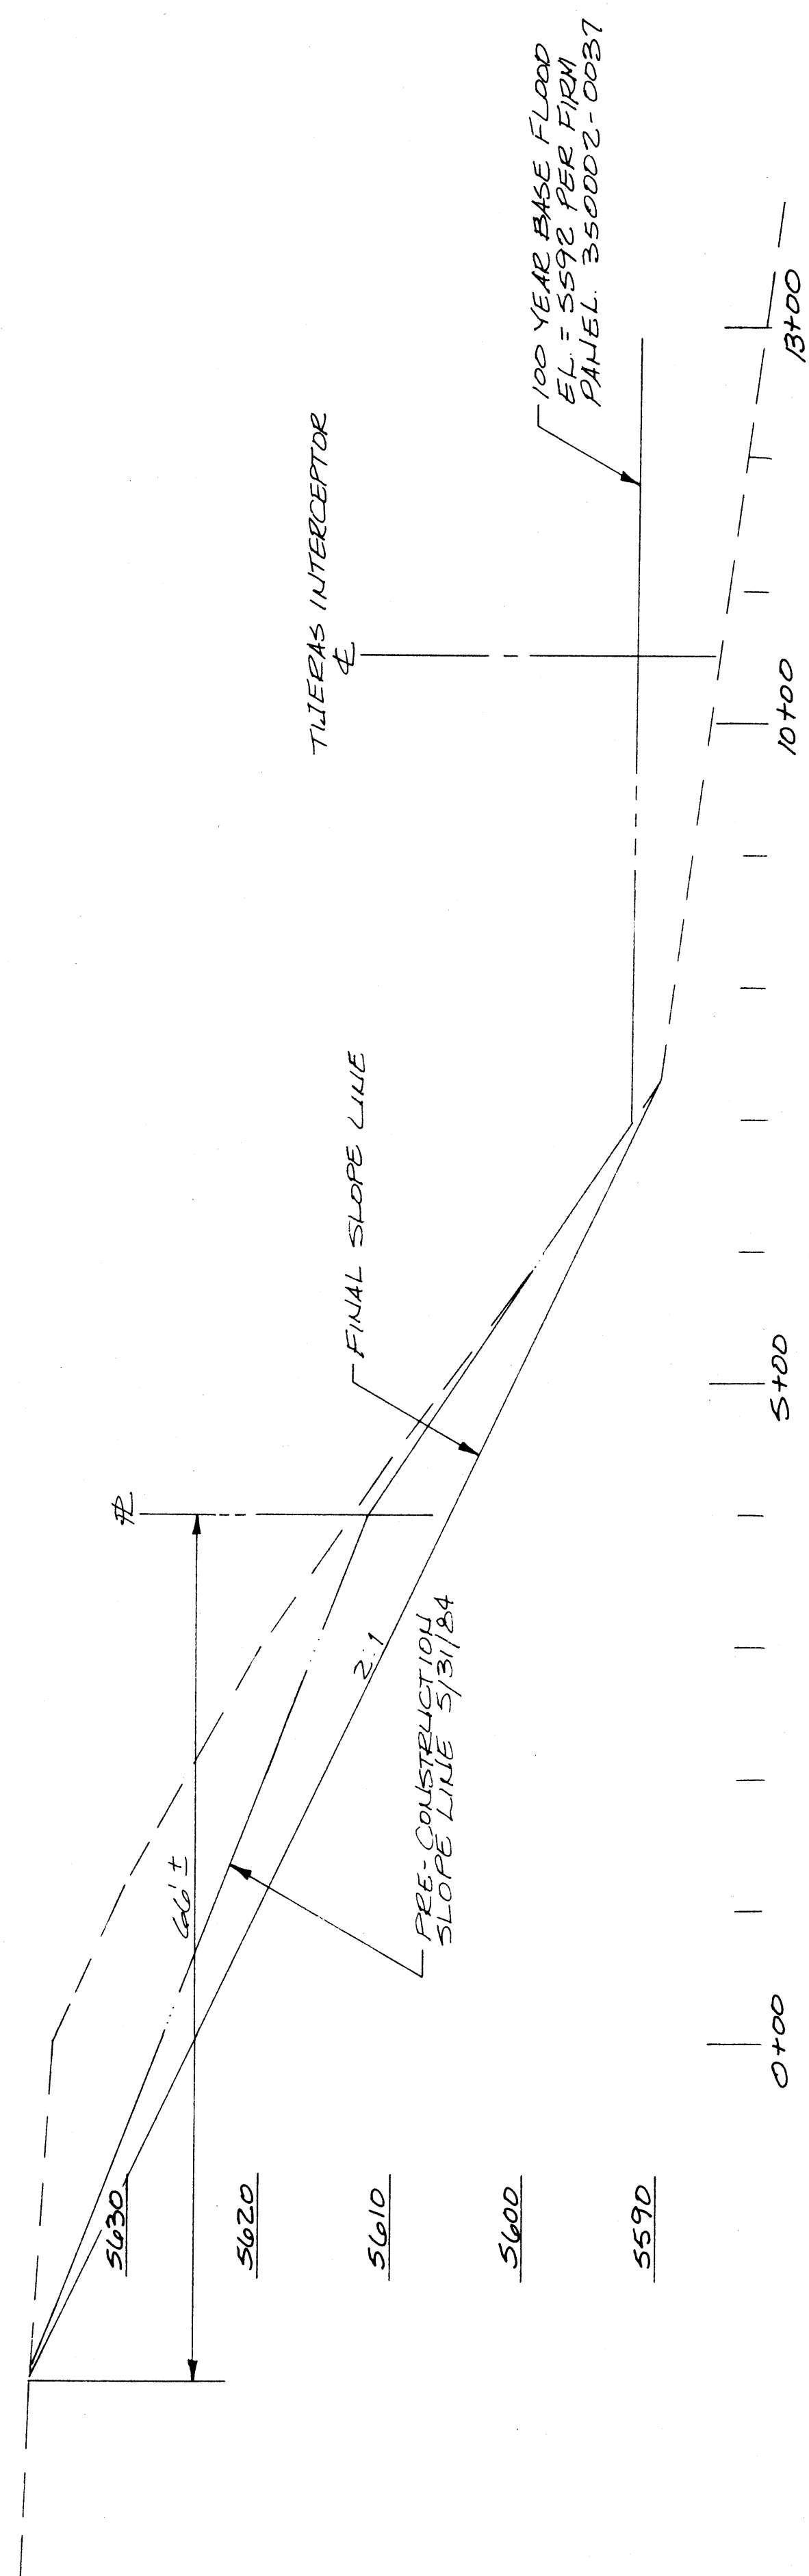


SECTION 11

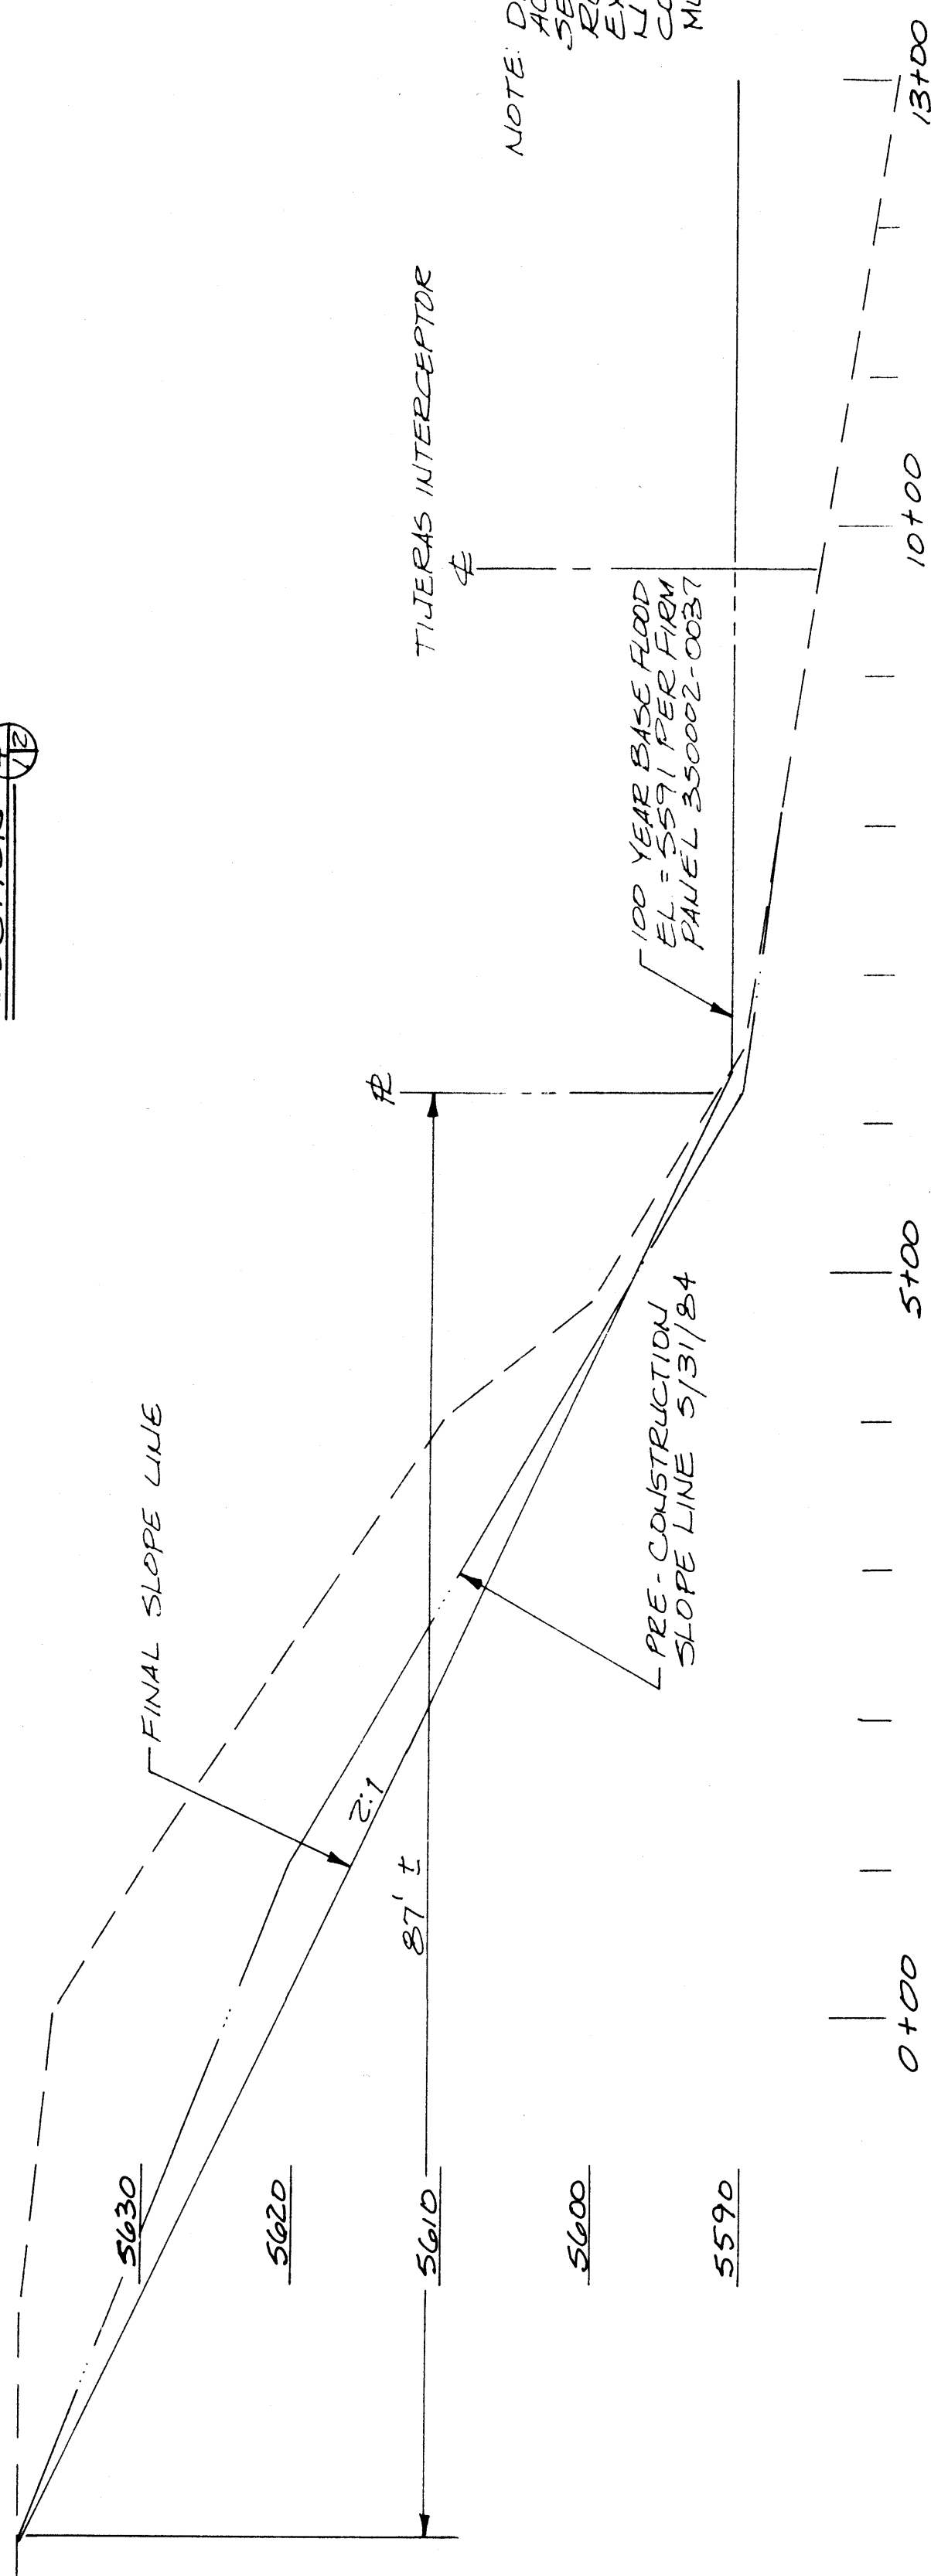

SECTION 12

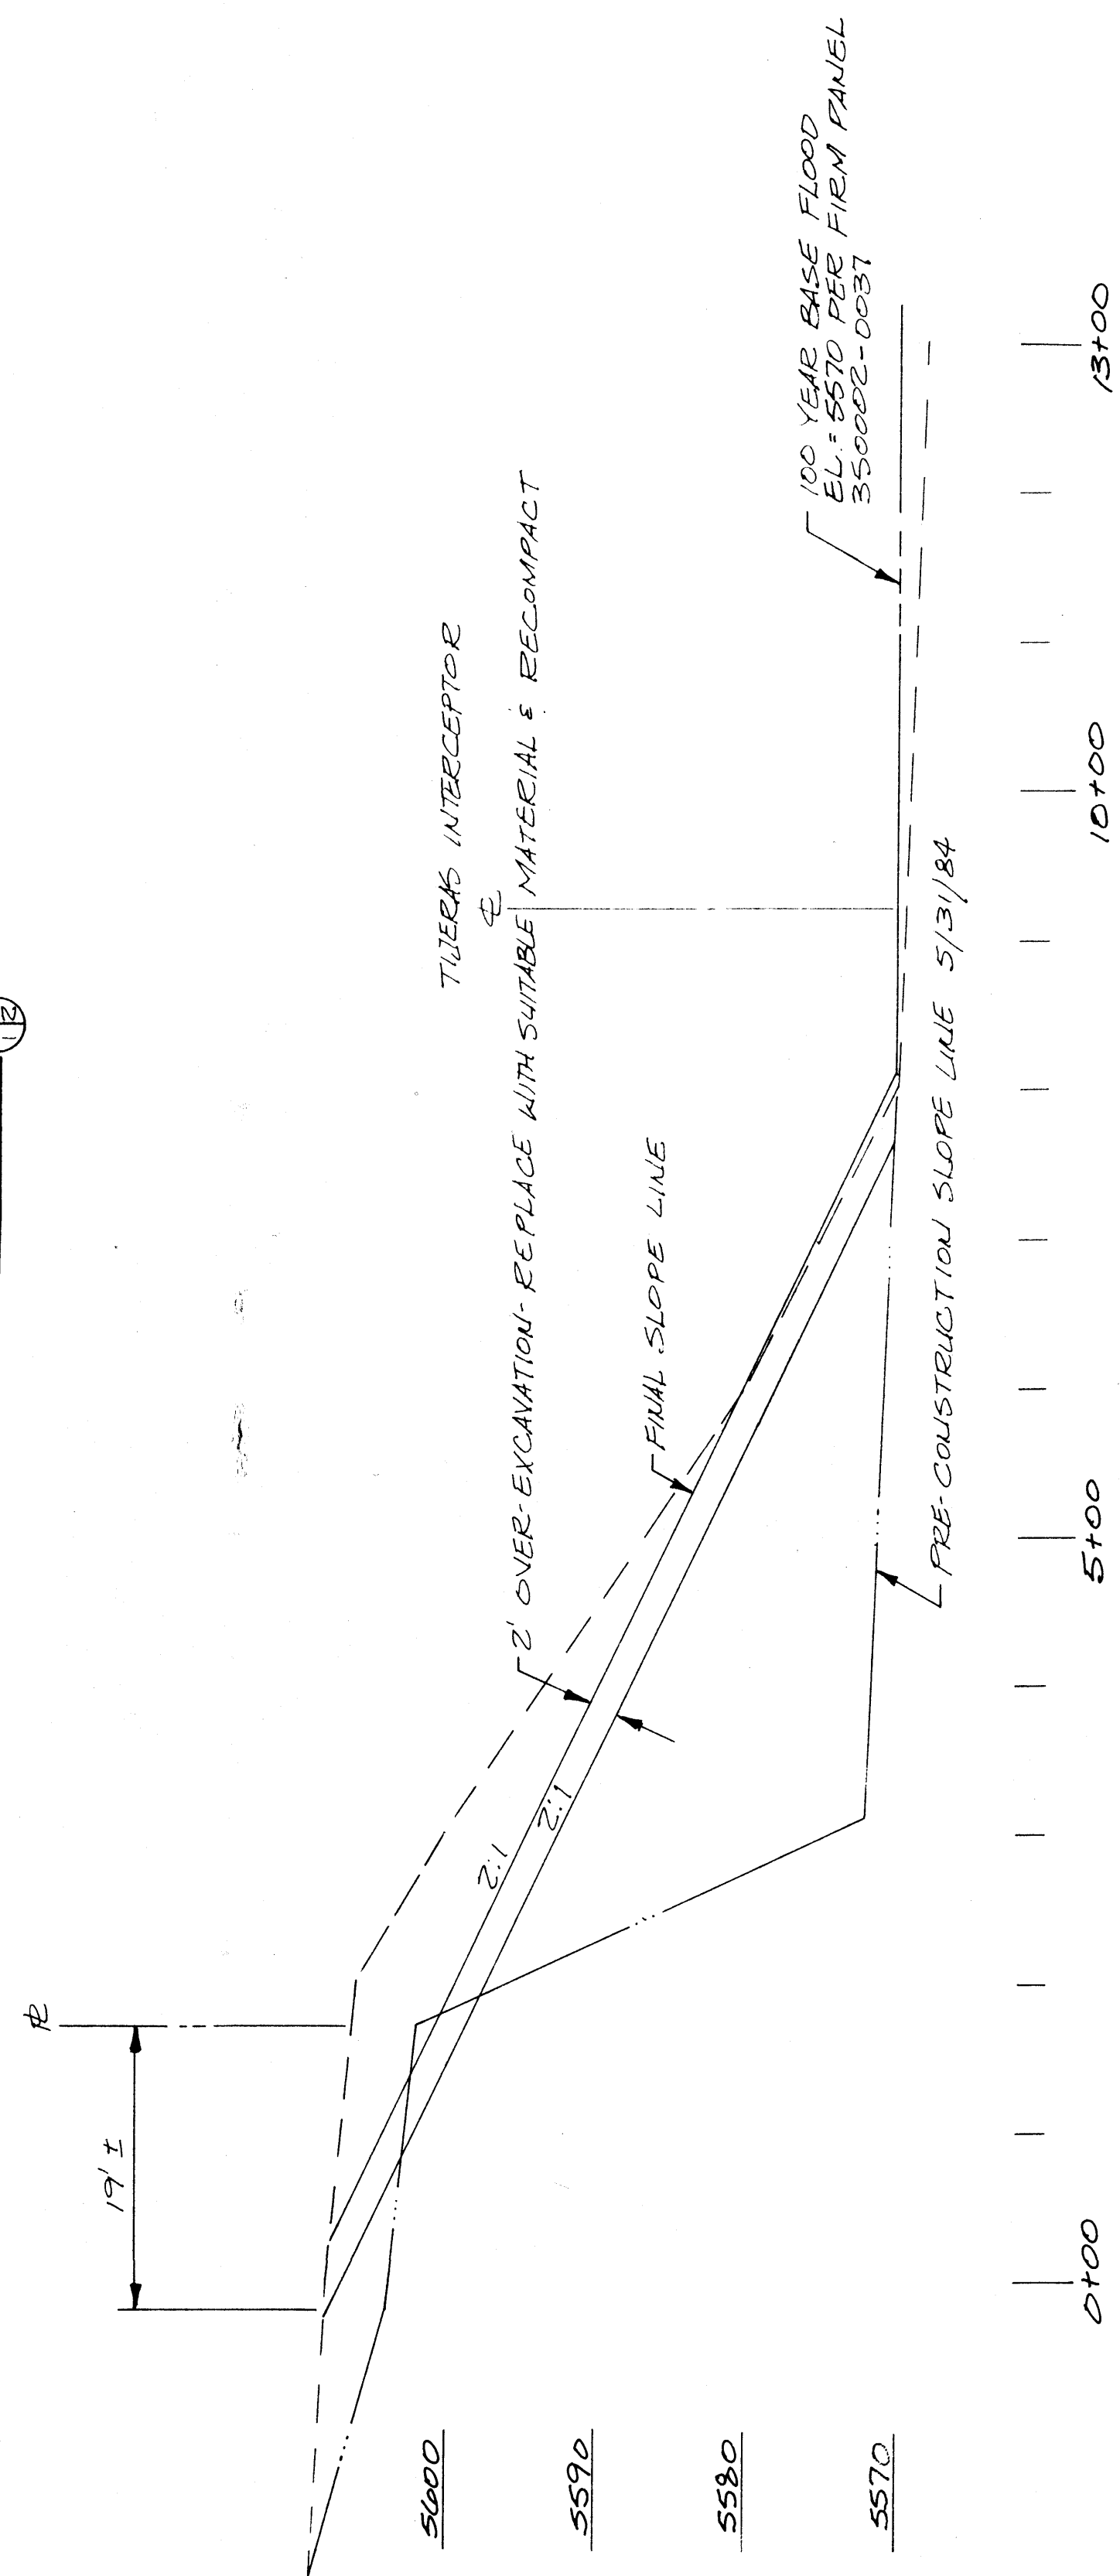

SECTION 13

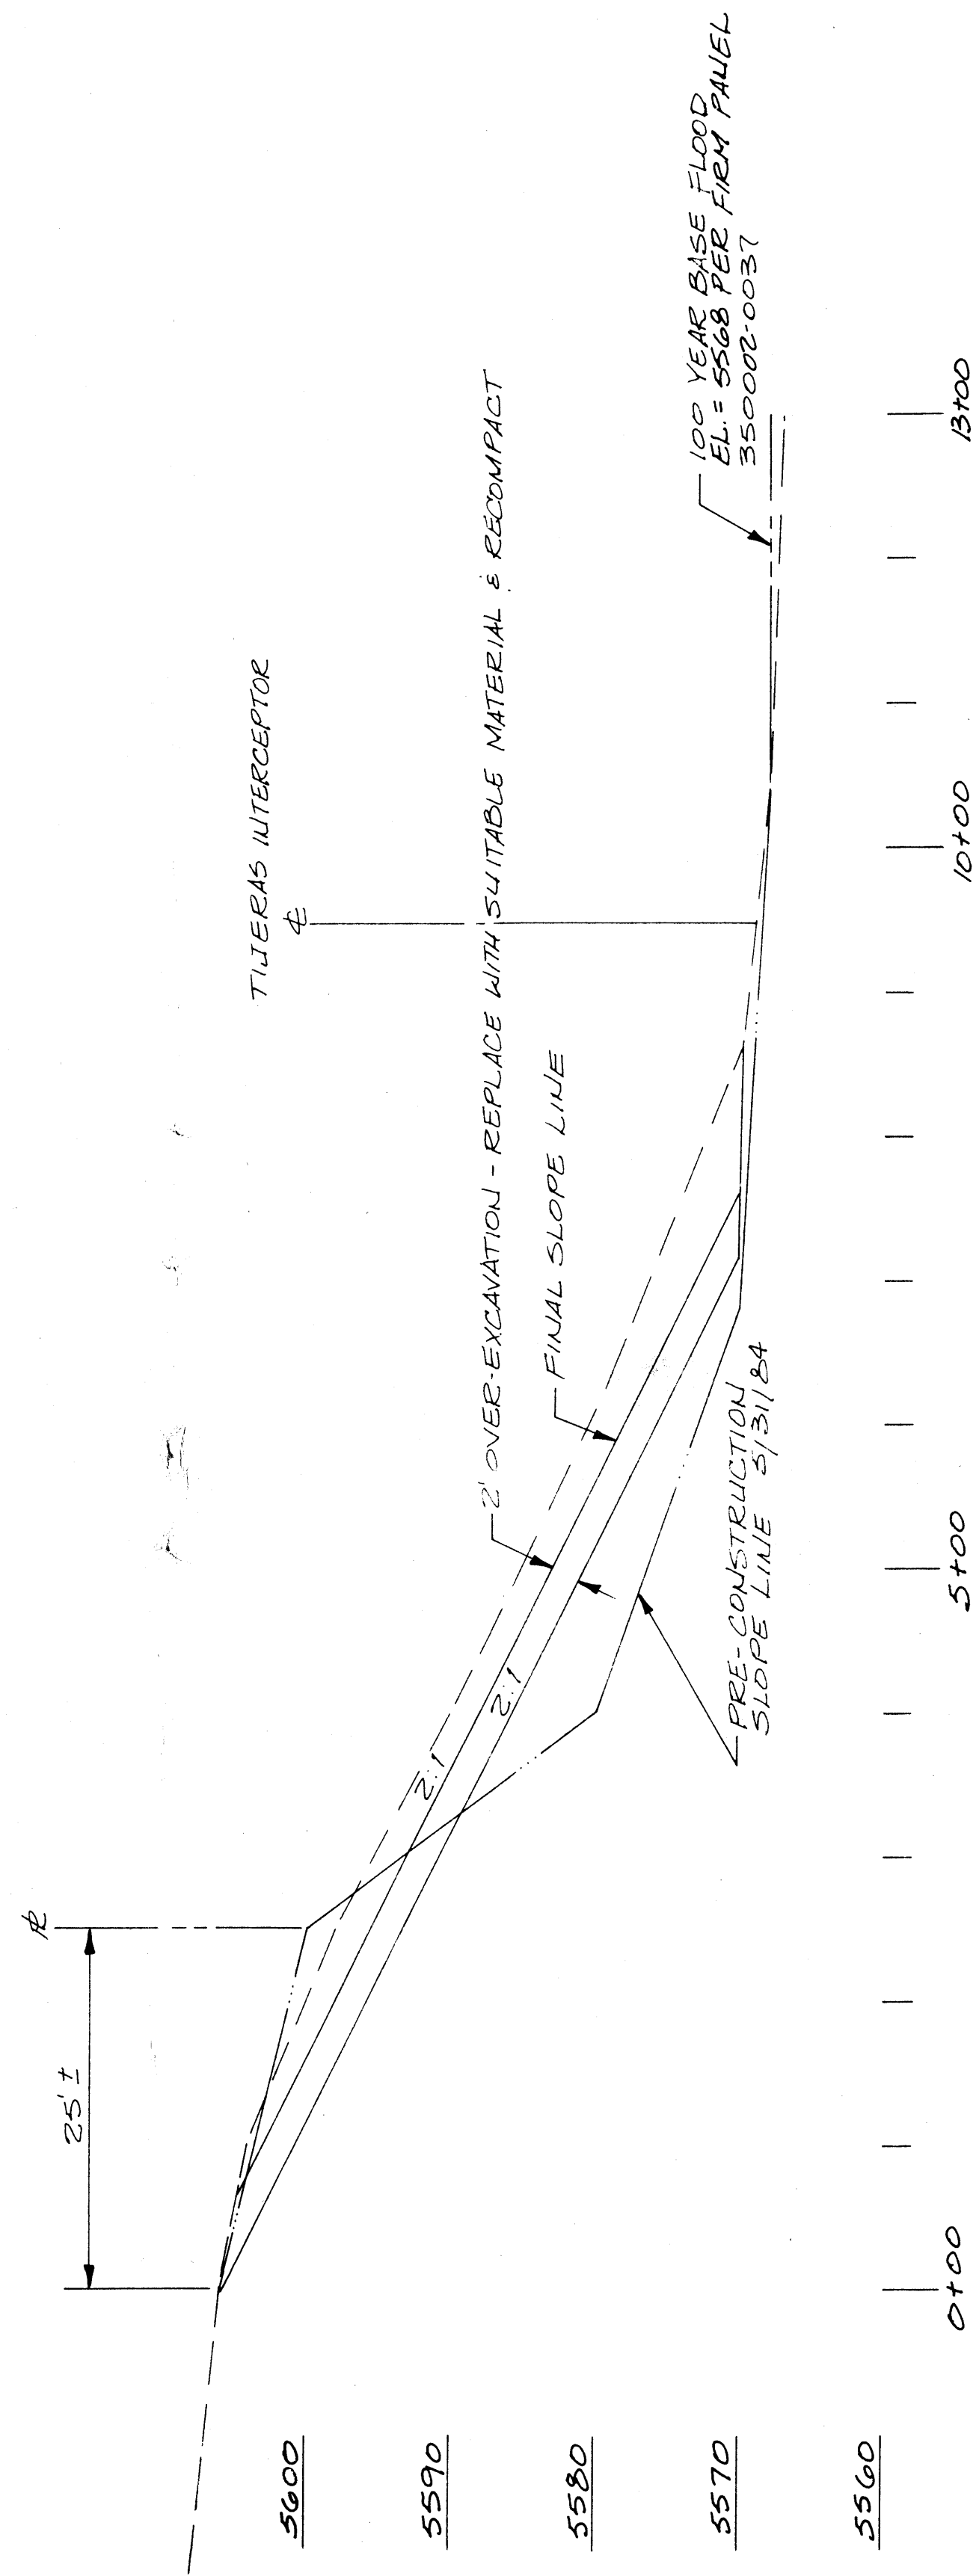

SECTION 14

SCALES:
HORIZ 1" = 10'
VERT 1" = 10'

RECORD DRAWING


I hereby certify that the information contained on this drawing has been revised in accordance with information furnished by the Contractor, MJB Enterprises and by the Surveyor, D. Mark Goodwin and Associates, and reflects the construction as actually accomplished. This plan as constructed is in close compliance with the Approved Plan, particularly with respect to the backslopes and ponding areas.


Mark Goodwin, NMPE 8948

NORTH FOUR HILLS SUBDIVISION FLOOD PLAIN RECLAMATION


dmg D. MARK GOODWIN & ASSOCIATES, P.A.
CONSULTING ENGINEERS & SURVEYORS
P.O. BOX 90606
ALBUQUERQUE, NEW MEXICO 87199
(505) 828-2200

Designed: DMG	Drawn: RJA	Checked: DMG	Sheet 2 of 2
Scale: NONE	Date: 9/90	Job: 90-40	

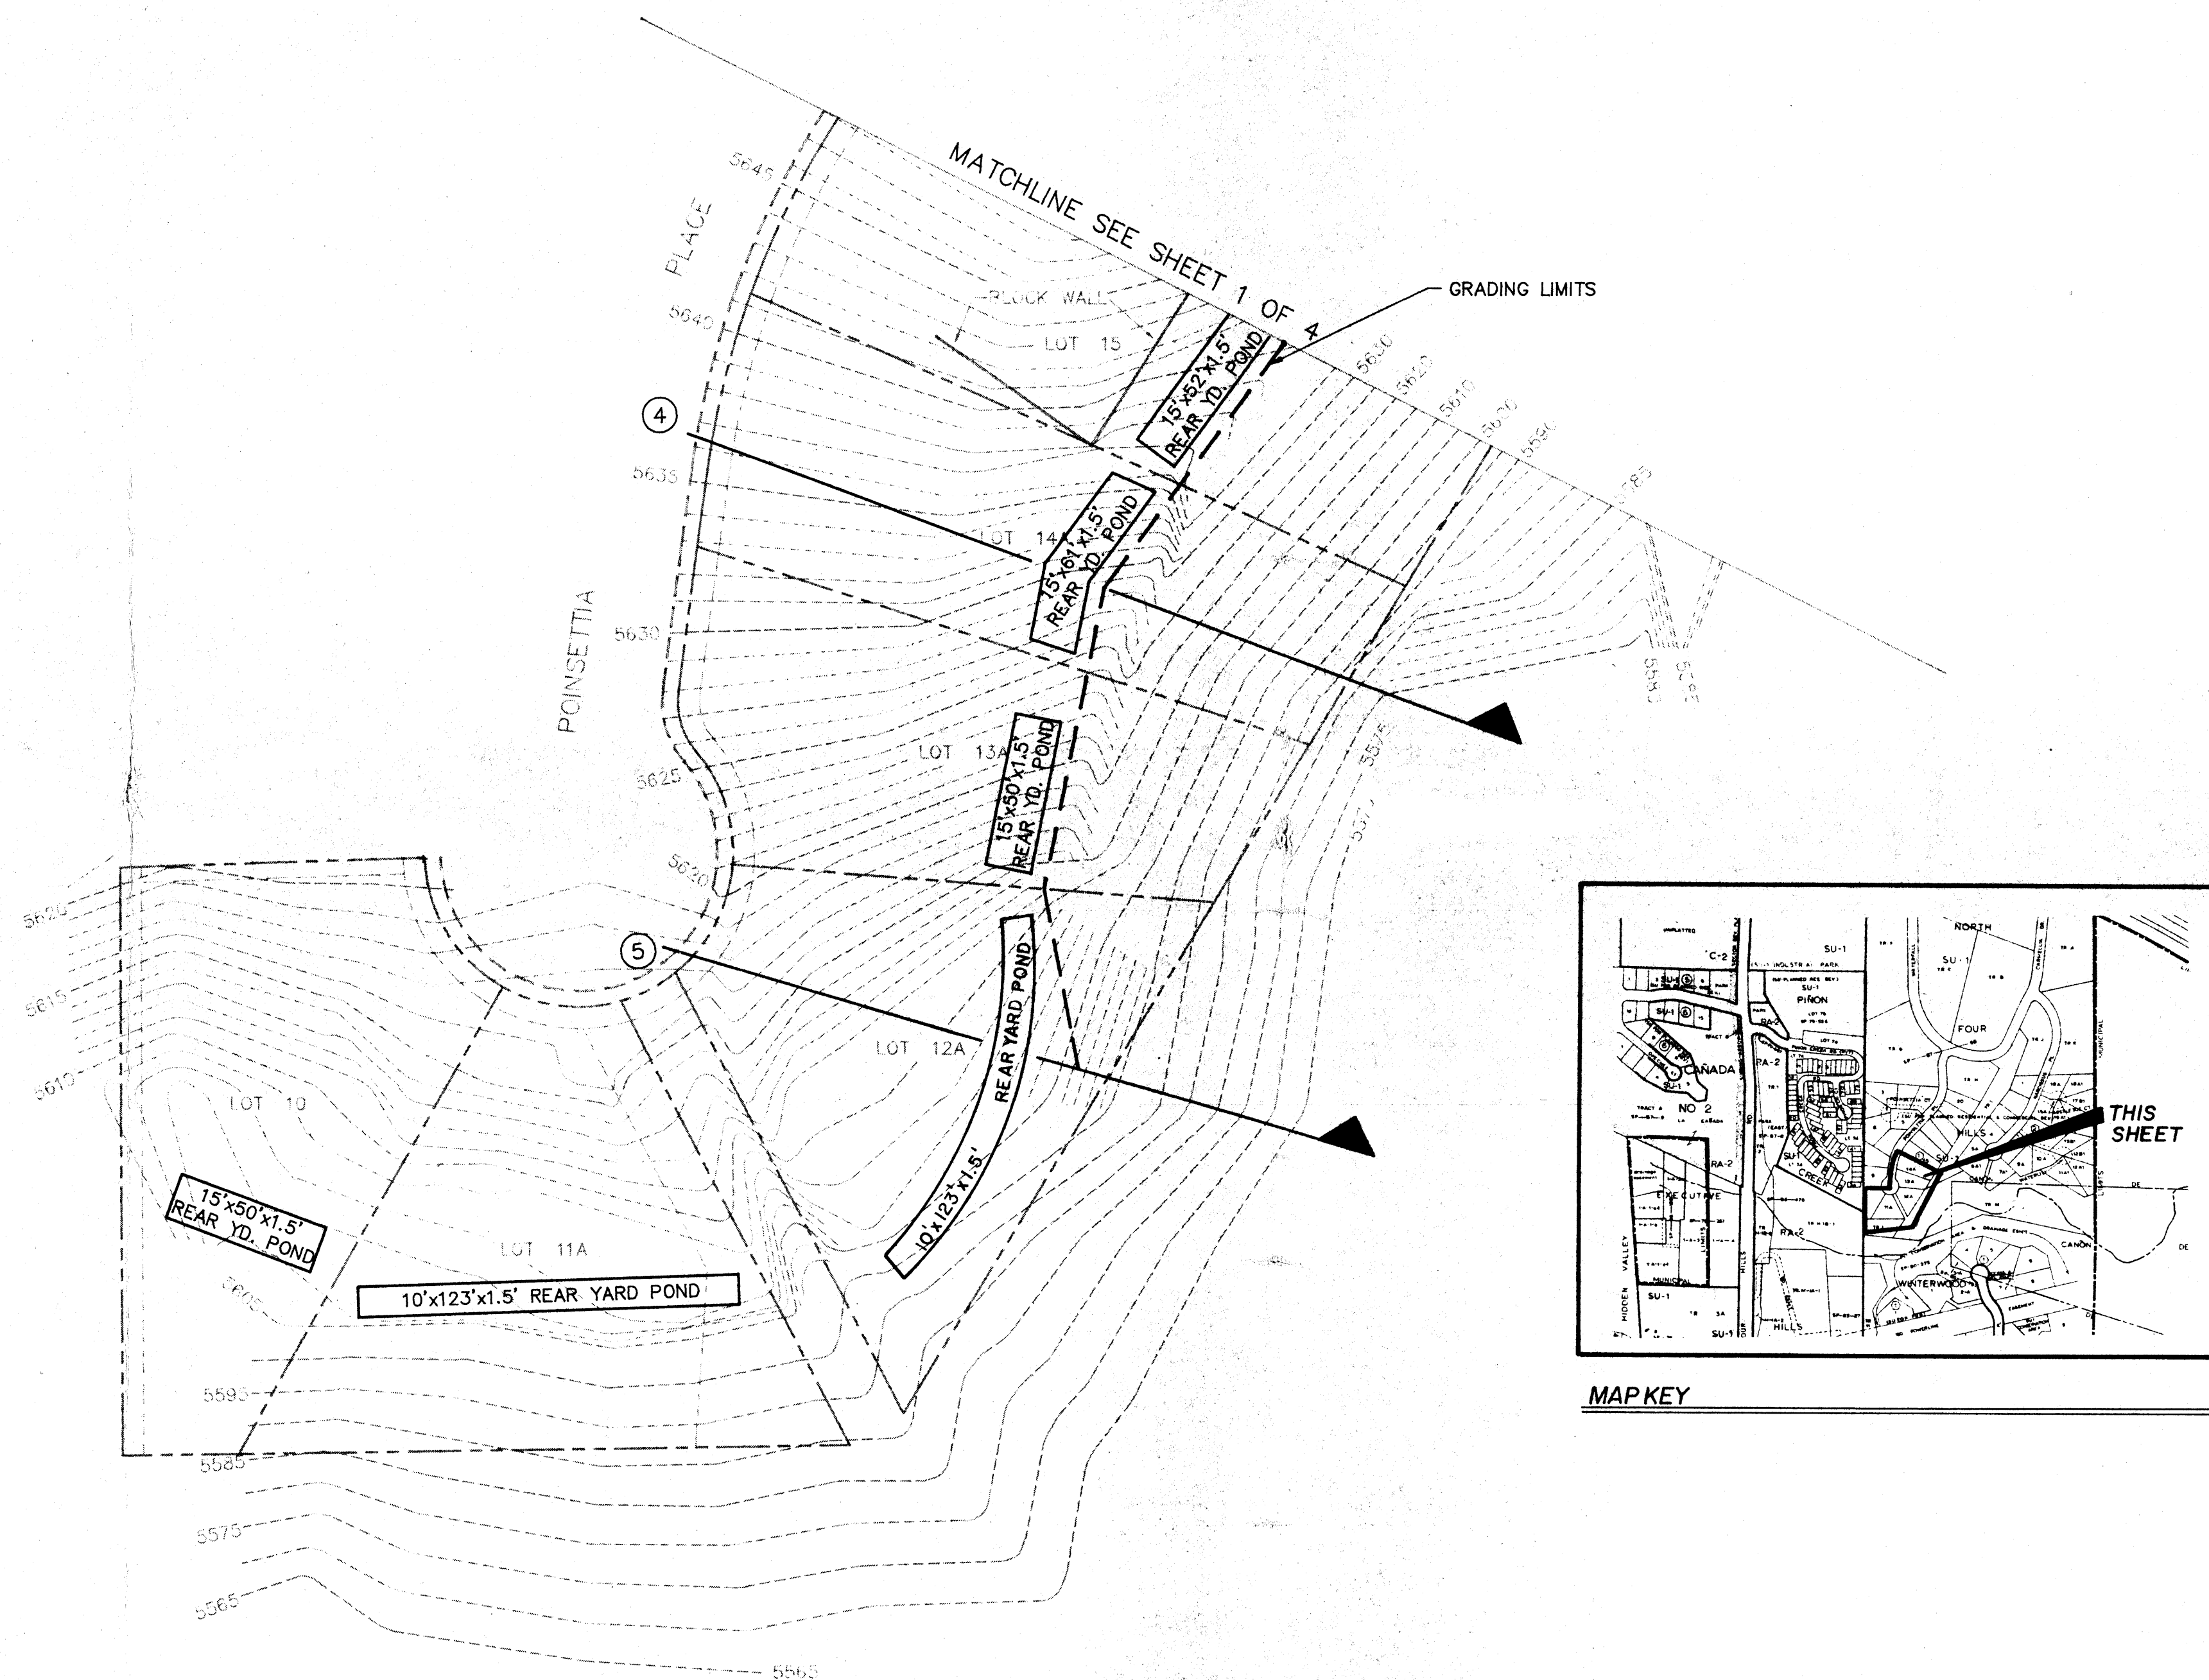

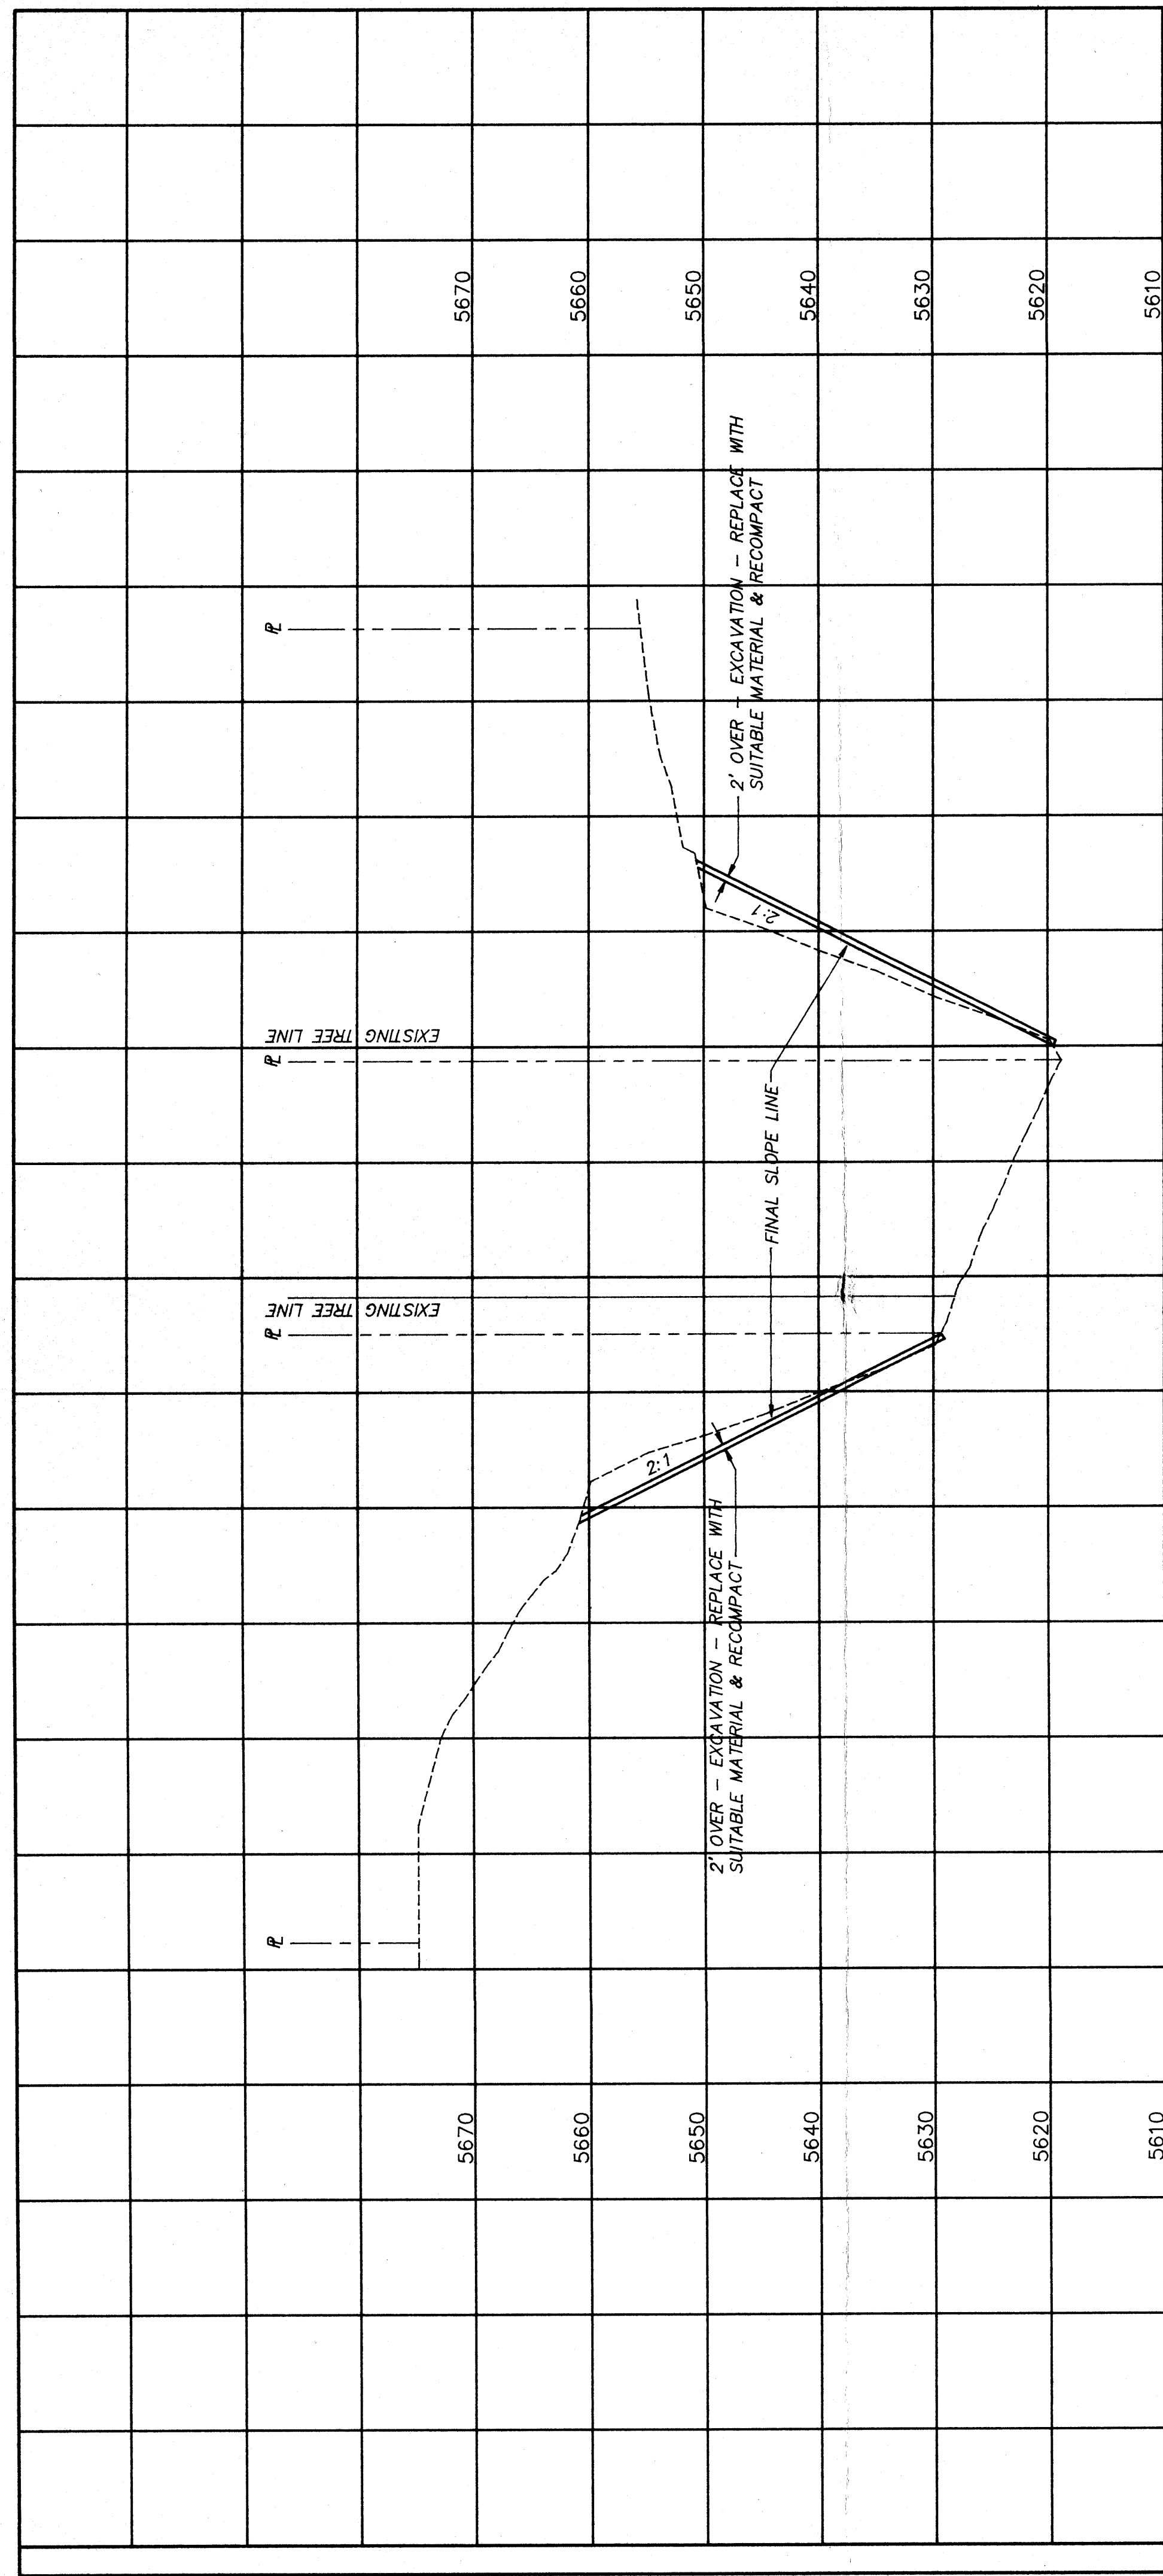

CROSS-SECTION 1
SCALE: HORIZ. 1"=40'
VERT. 1"=10'

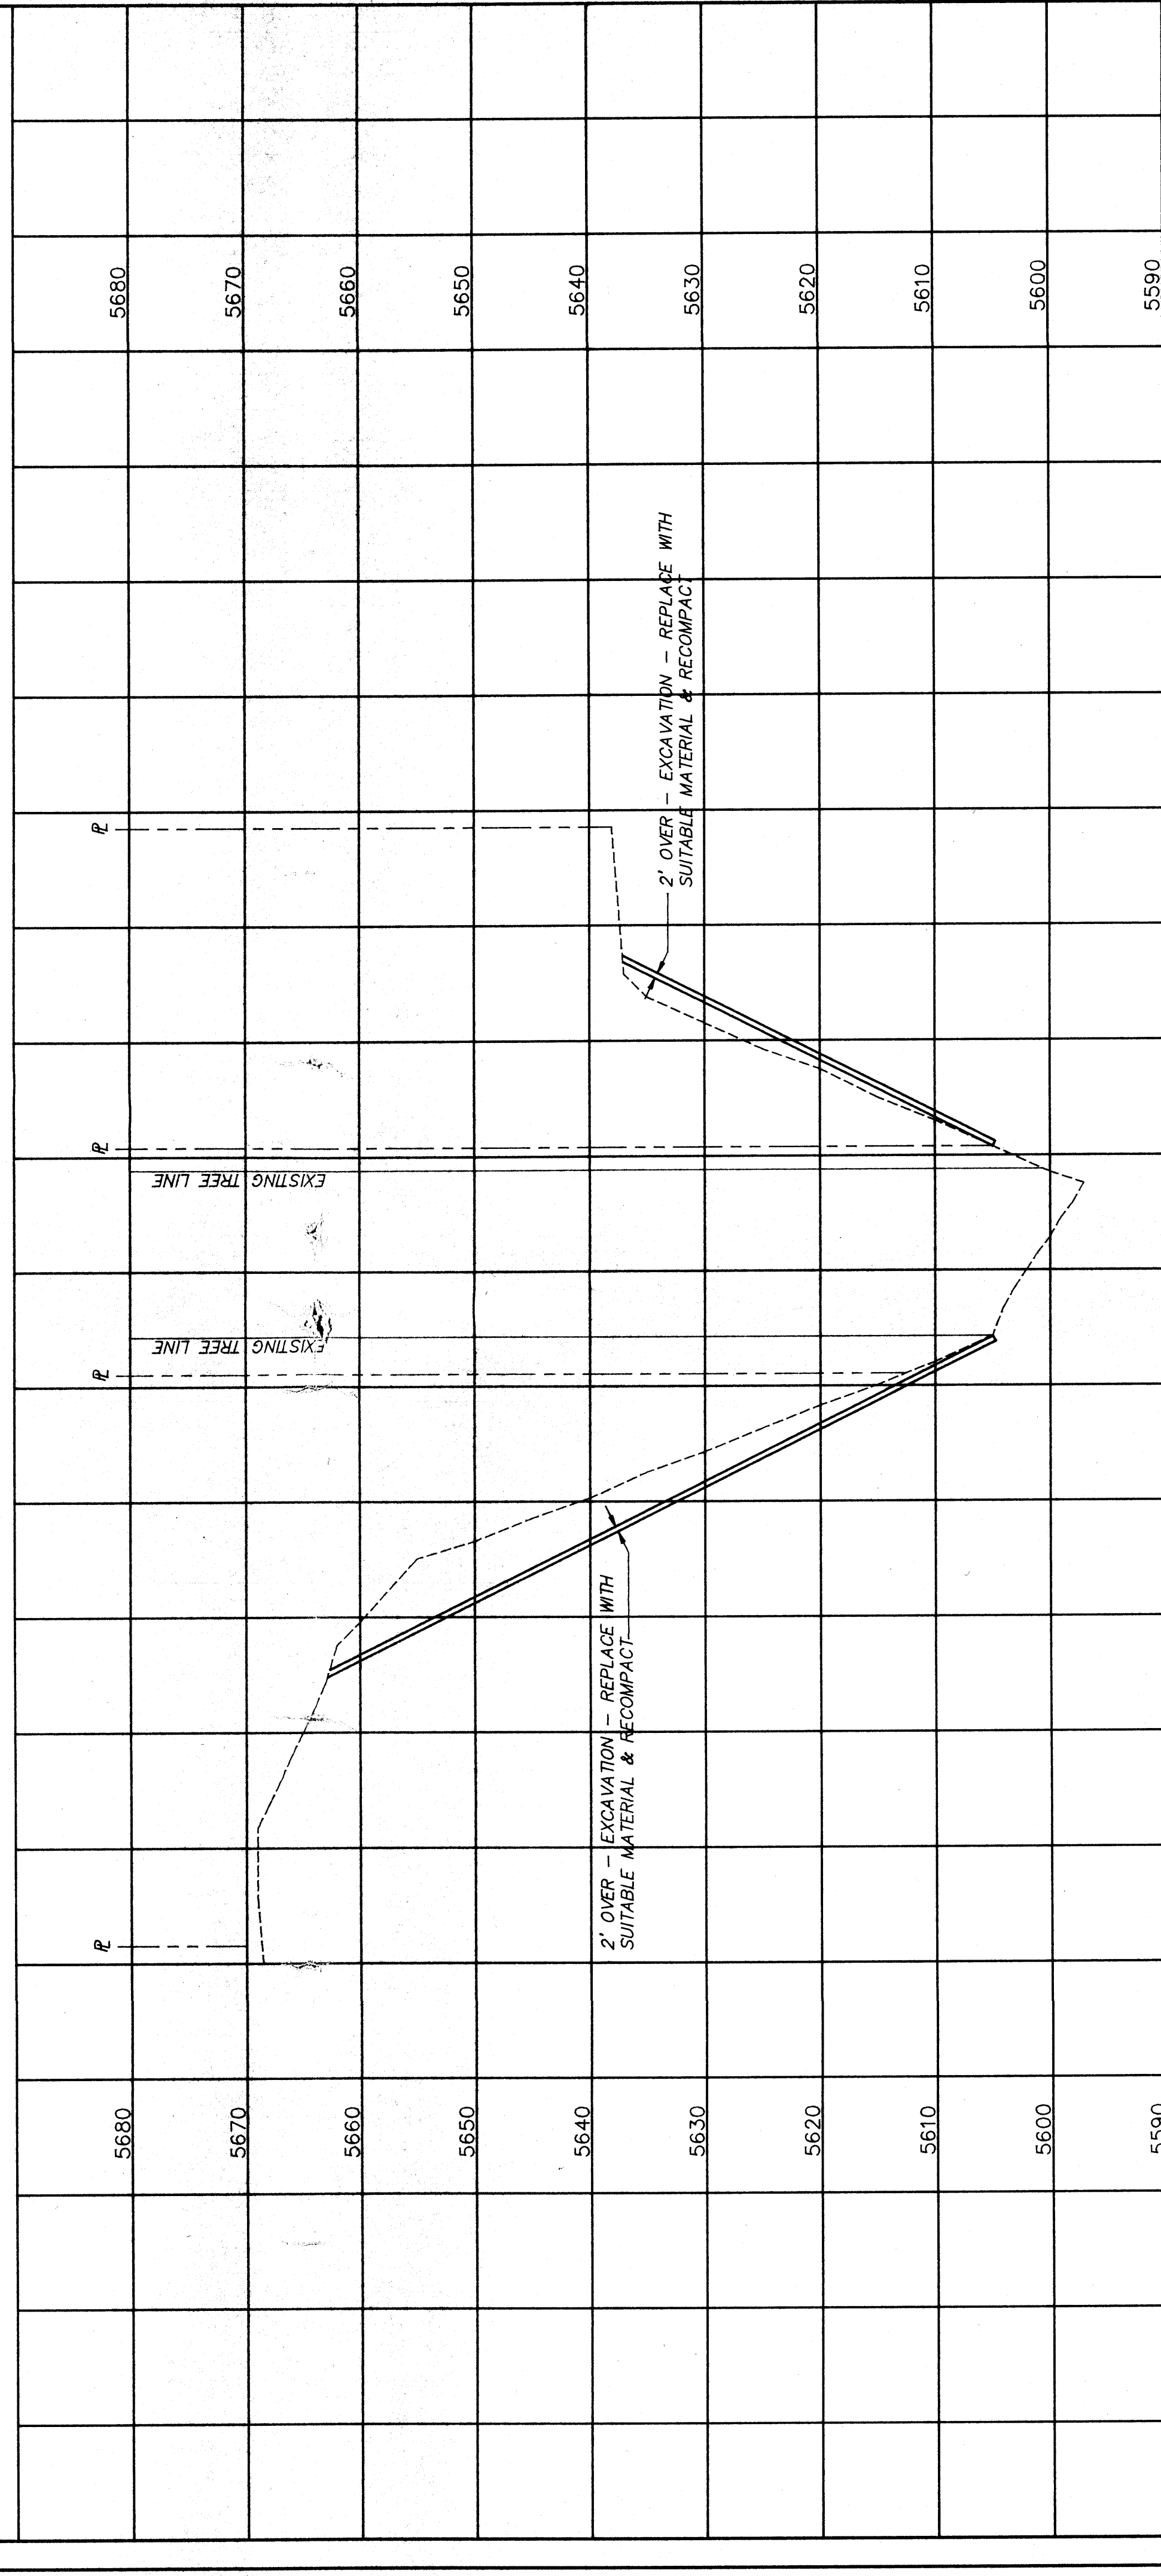

CROSS-SECTION 2
SCALE: HORIZ. 1"=40'
VERT. 1"=10'

- NOTES
1. Suitable Material as called for in this plan shall conform to the requirements of the City of Albuquerque's standard specifications for Public Works Construction, Section 204, Fill Construction. Minimum compaction shall be 90% ASTM D 1557.
 2. Prior to construction, the construction limits at the toe of slope shall be set. These limits as set are not to be disturbed.

RECORD DRAWING

I hereby certify that the information contained on this drawing has been revised in accordance with information furnished by the Contractor, MJB Enterprises and by the Surveyor, D. Mark Goodwin and Associates, and reflects the construction as actually accomplished. This plan as constructed is in close compliance with the Approved Plan, particularly with respect to the back slopes and ponding areas.


Mark Goodwin 3/1/92
Mark Goodwin, NMPE 8948




NORTH FOUR HILLS SUBDIVISION
RECLAMATION PLAN

dmg D. MARK GOODWIN & ASSOCIATES, P.A.
CONSULTING ENGINEERS & SURVEYORS
P.O. BOX 90606
ALBUQUERQUE, NEW MEXICO 87199
(505) 828-2200


Designed: <i>DMG</i>	Drawn: <i>JMB</i>	Checked: <i>DMG</i>	Sheet 3 of 4
Scale: HORIZ. 1"=40' VERT. 1"=10'	Date: 3/92	Job: 9216	

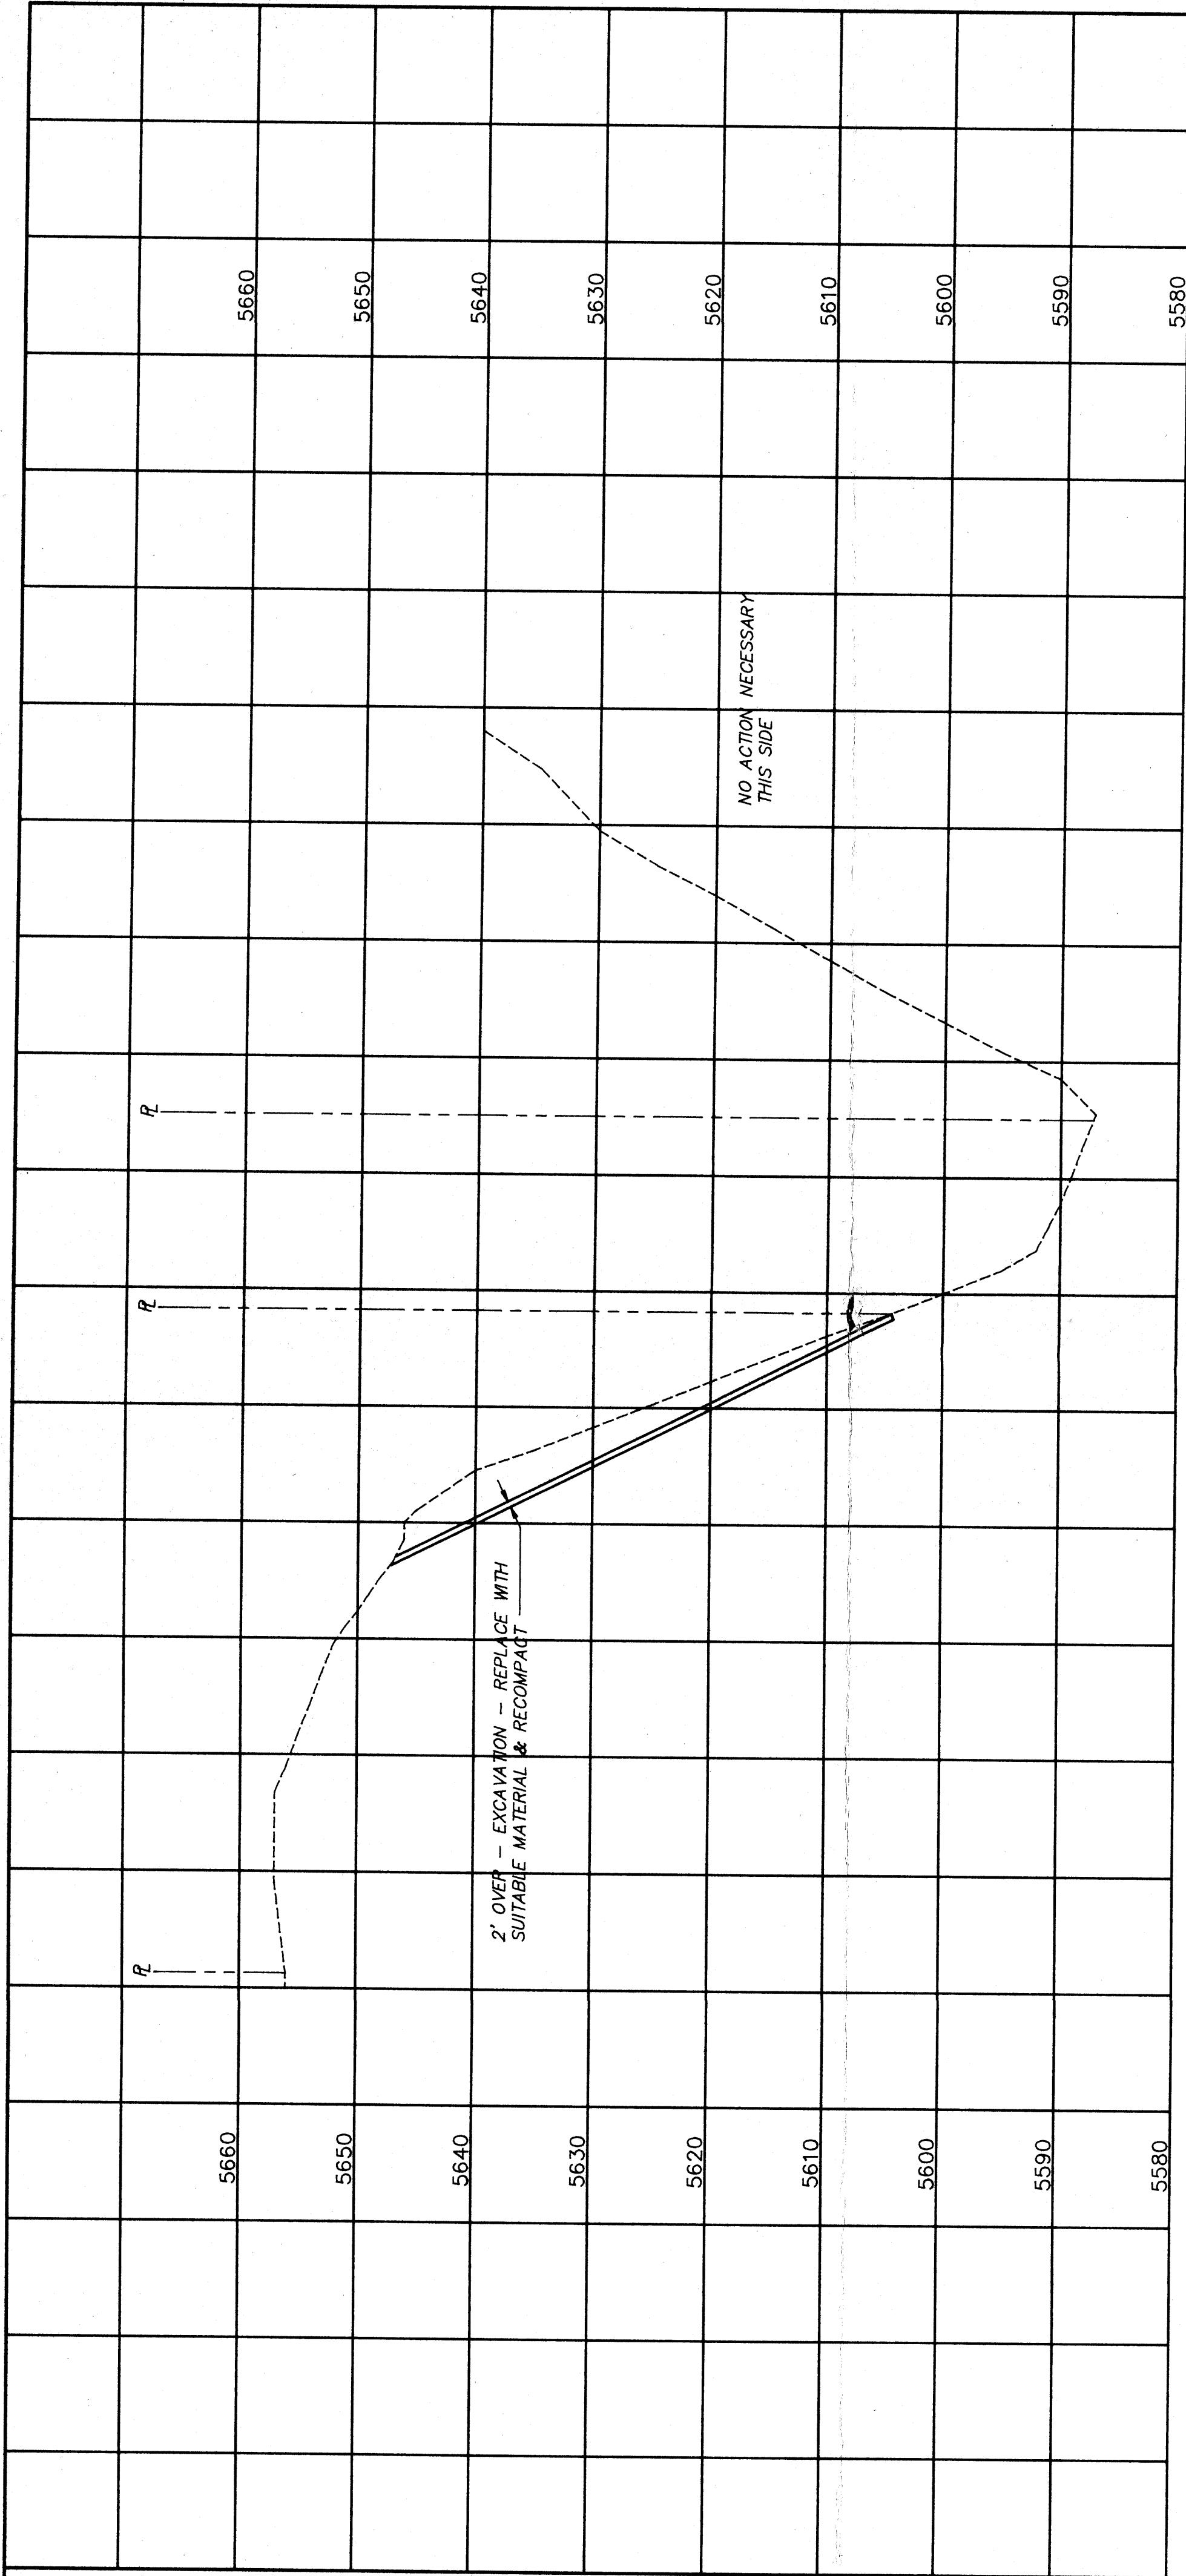

CROSS-SECTION 3
SCALE: HORIZ. 1"=40'
VERT. 1"=10'

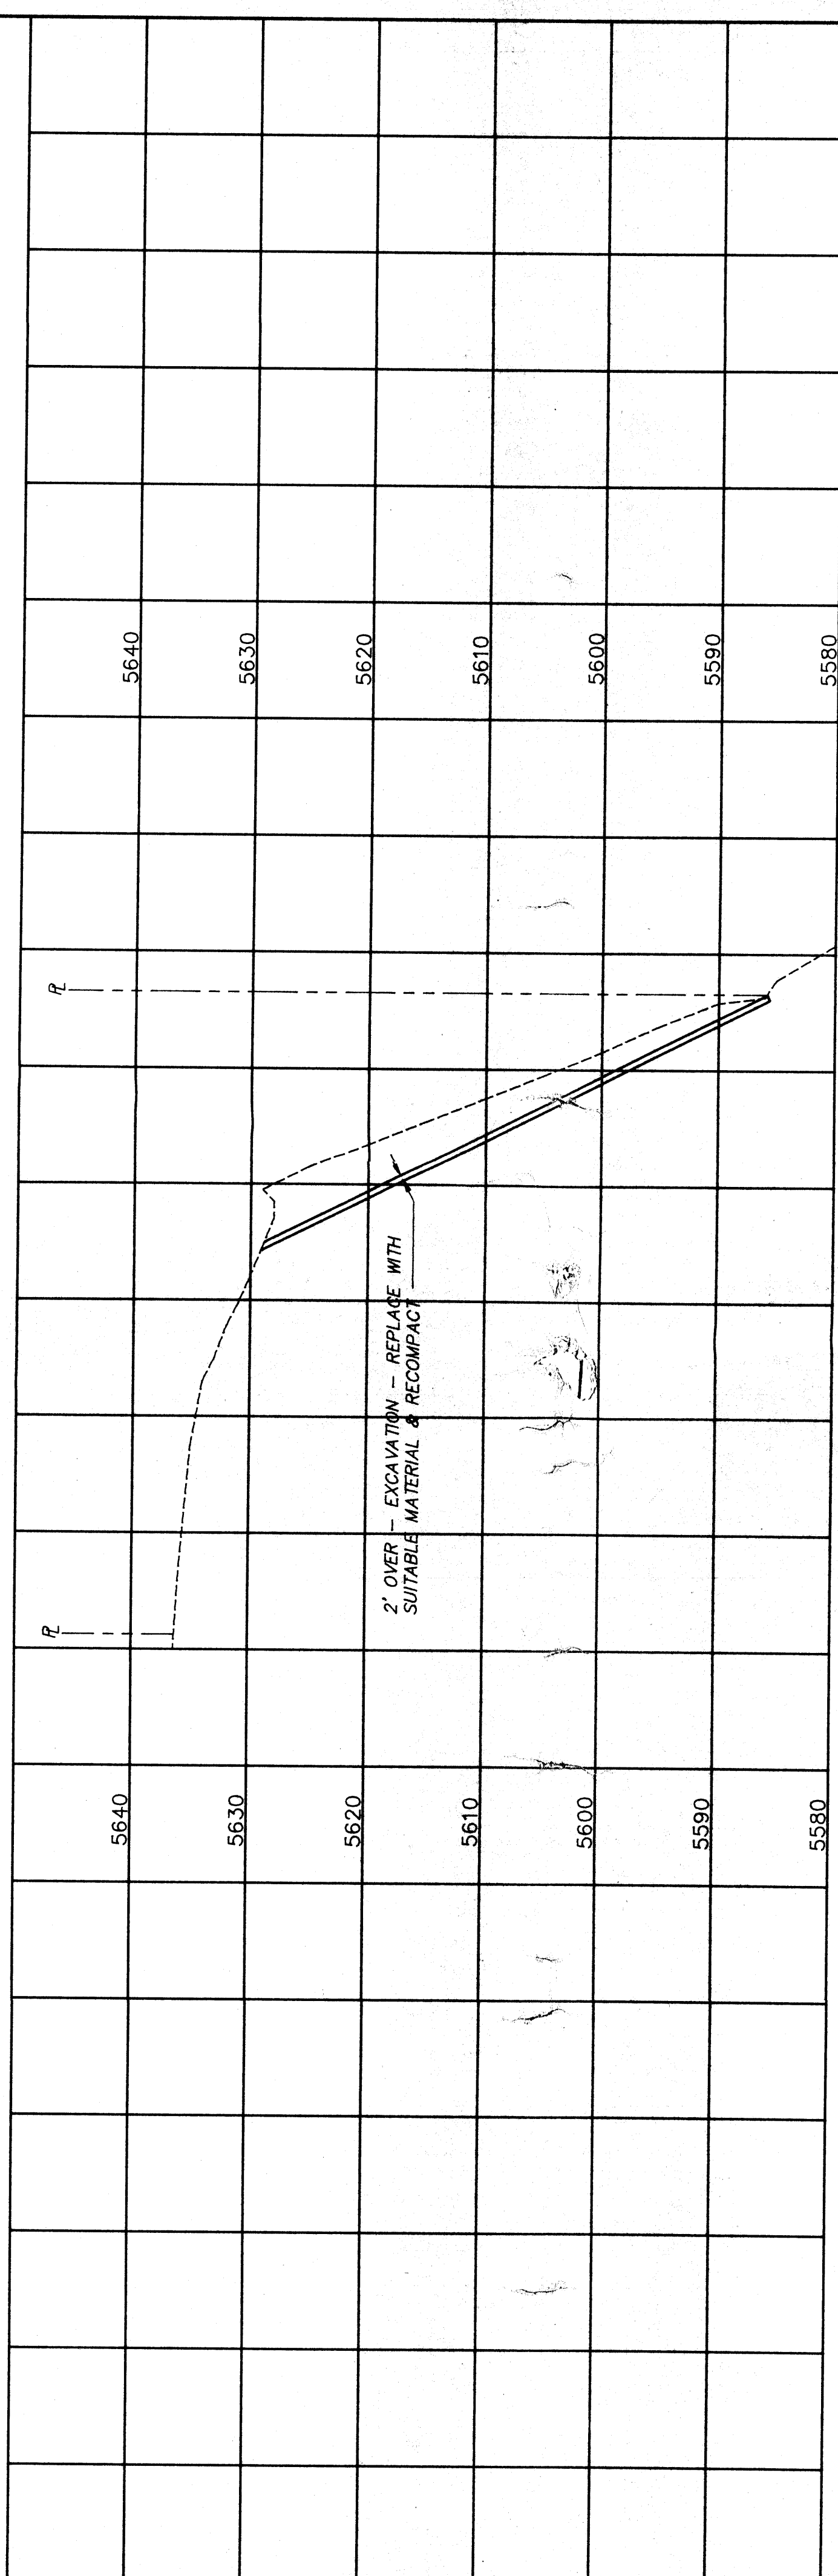

CROSS-SECTION 4
SCALE: HORIZ. 1"=40'
VERT. 1"=10'

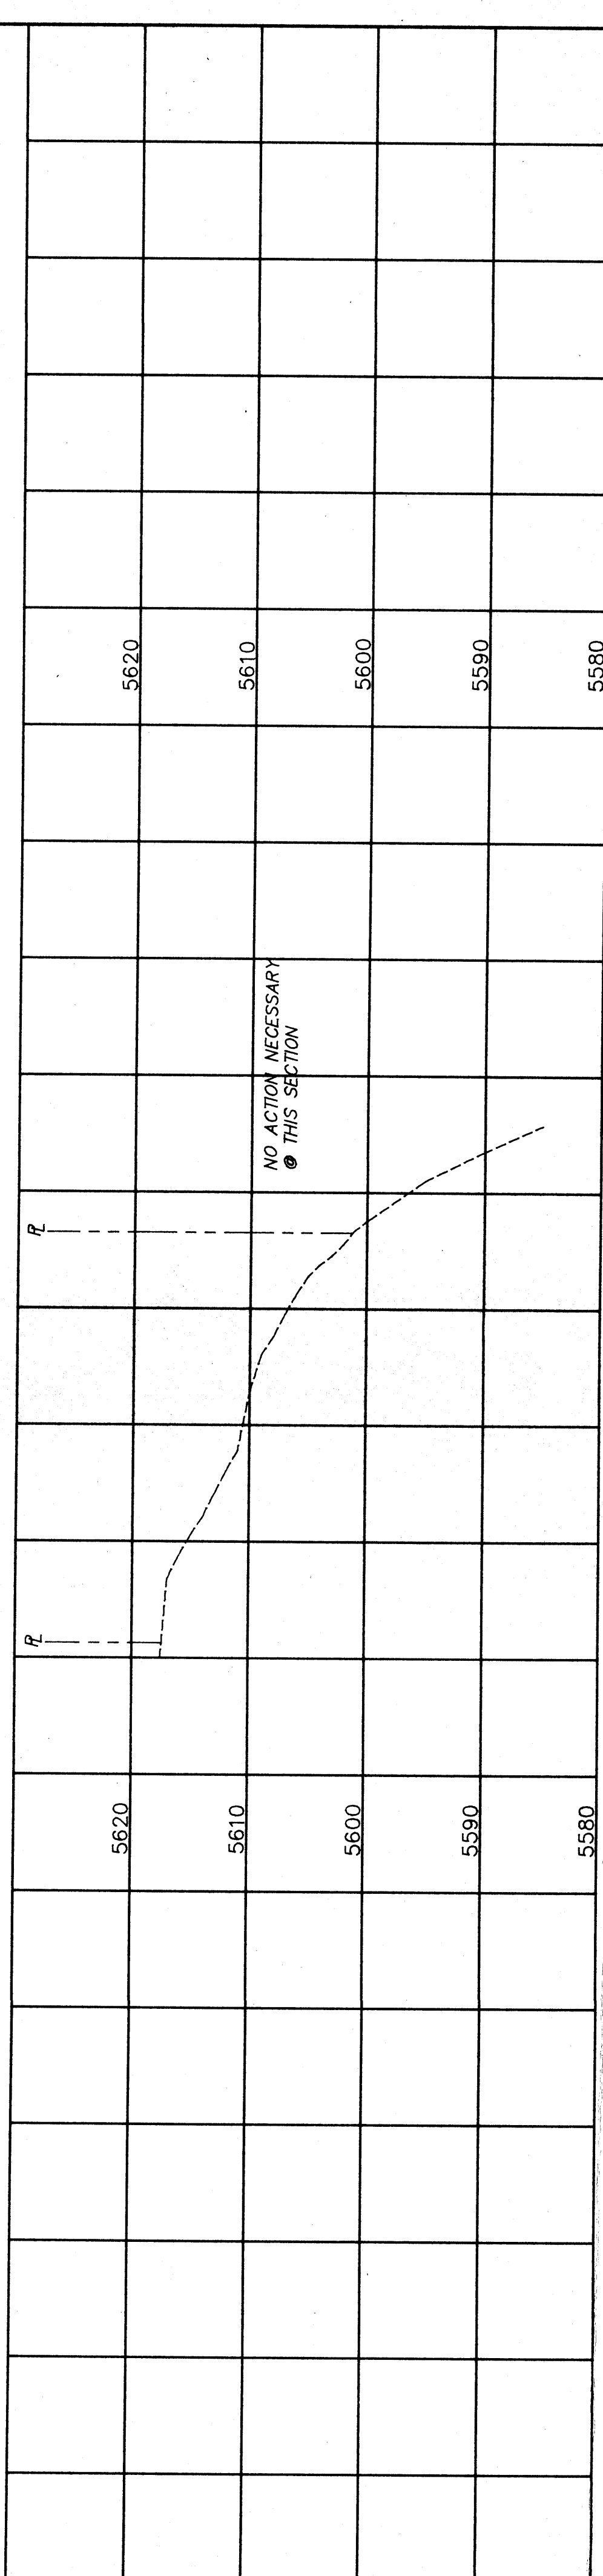


CROSS-SECTION 5
SCALE: HORIZ. 1"=40'
VERT. 1"=10'

RECORD DRAWING

I hereby certify that the information contained on this drawing has been revised in accordance with information furnished by the Contractor, MJB Enterprises and by the Surveyor, D. Mark Goodwin and Associates, and reflects the construction as actually accomplished. This plan as constructed is in close compliance with the Approved Plan, particularly with respect to the back slopes and ponding areas.

Mark Goodwin, NMPE 8948




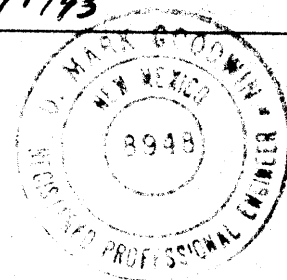


4/2/92



NORTH FOUR HILLS SUBDIVISION
RECLAMATION PLAN

dmg D. MARK GOODWIN & ASSOCIATES, P.A.
CONSULTING ENGINEERS & SURVEYORS
P.O. BOX 90606
ALBUQUERQUE, NEW MEXICO 87199
(505) 828-2200

Designed: DMG Drawn: JMB Checked: DMG
Scale: HORIZ. 1"=40' Date: 3/92 Job: 9216
VERT. 1"=10'

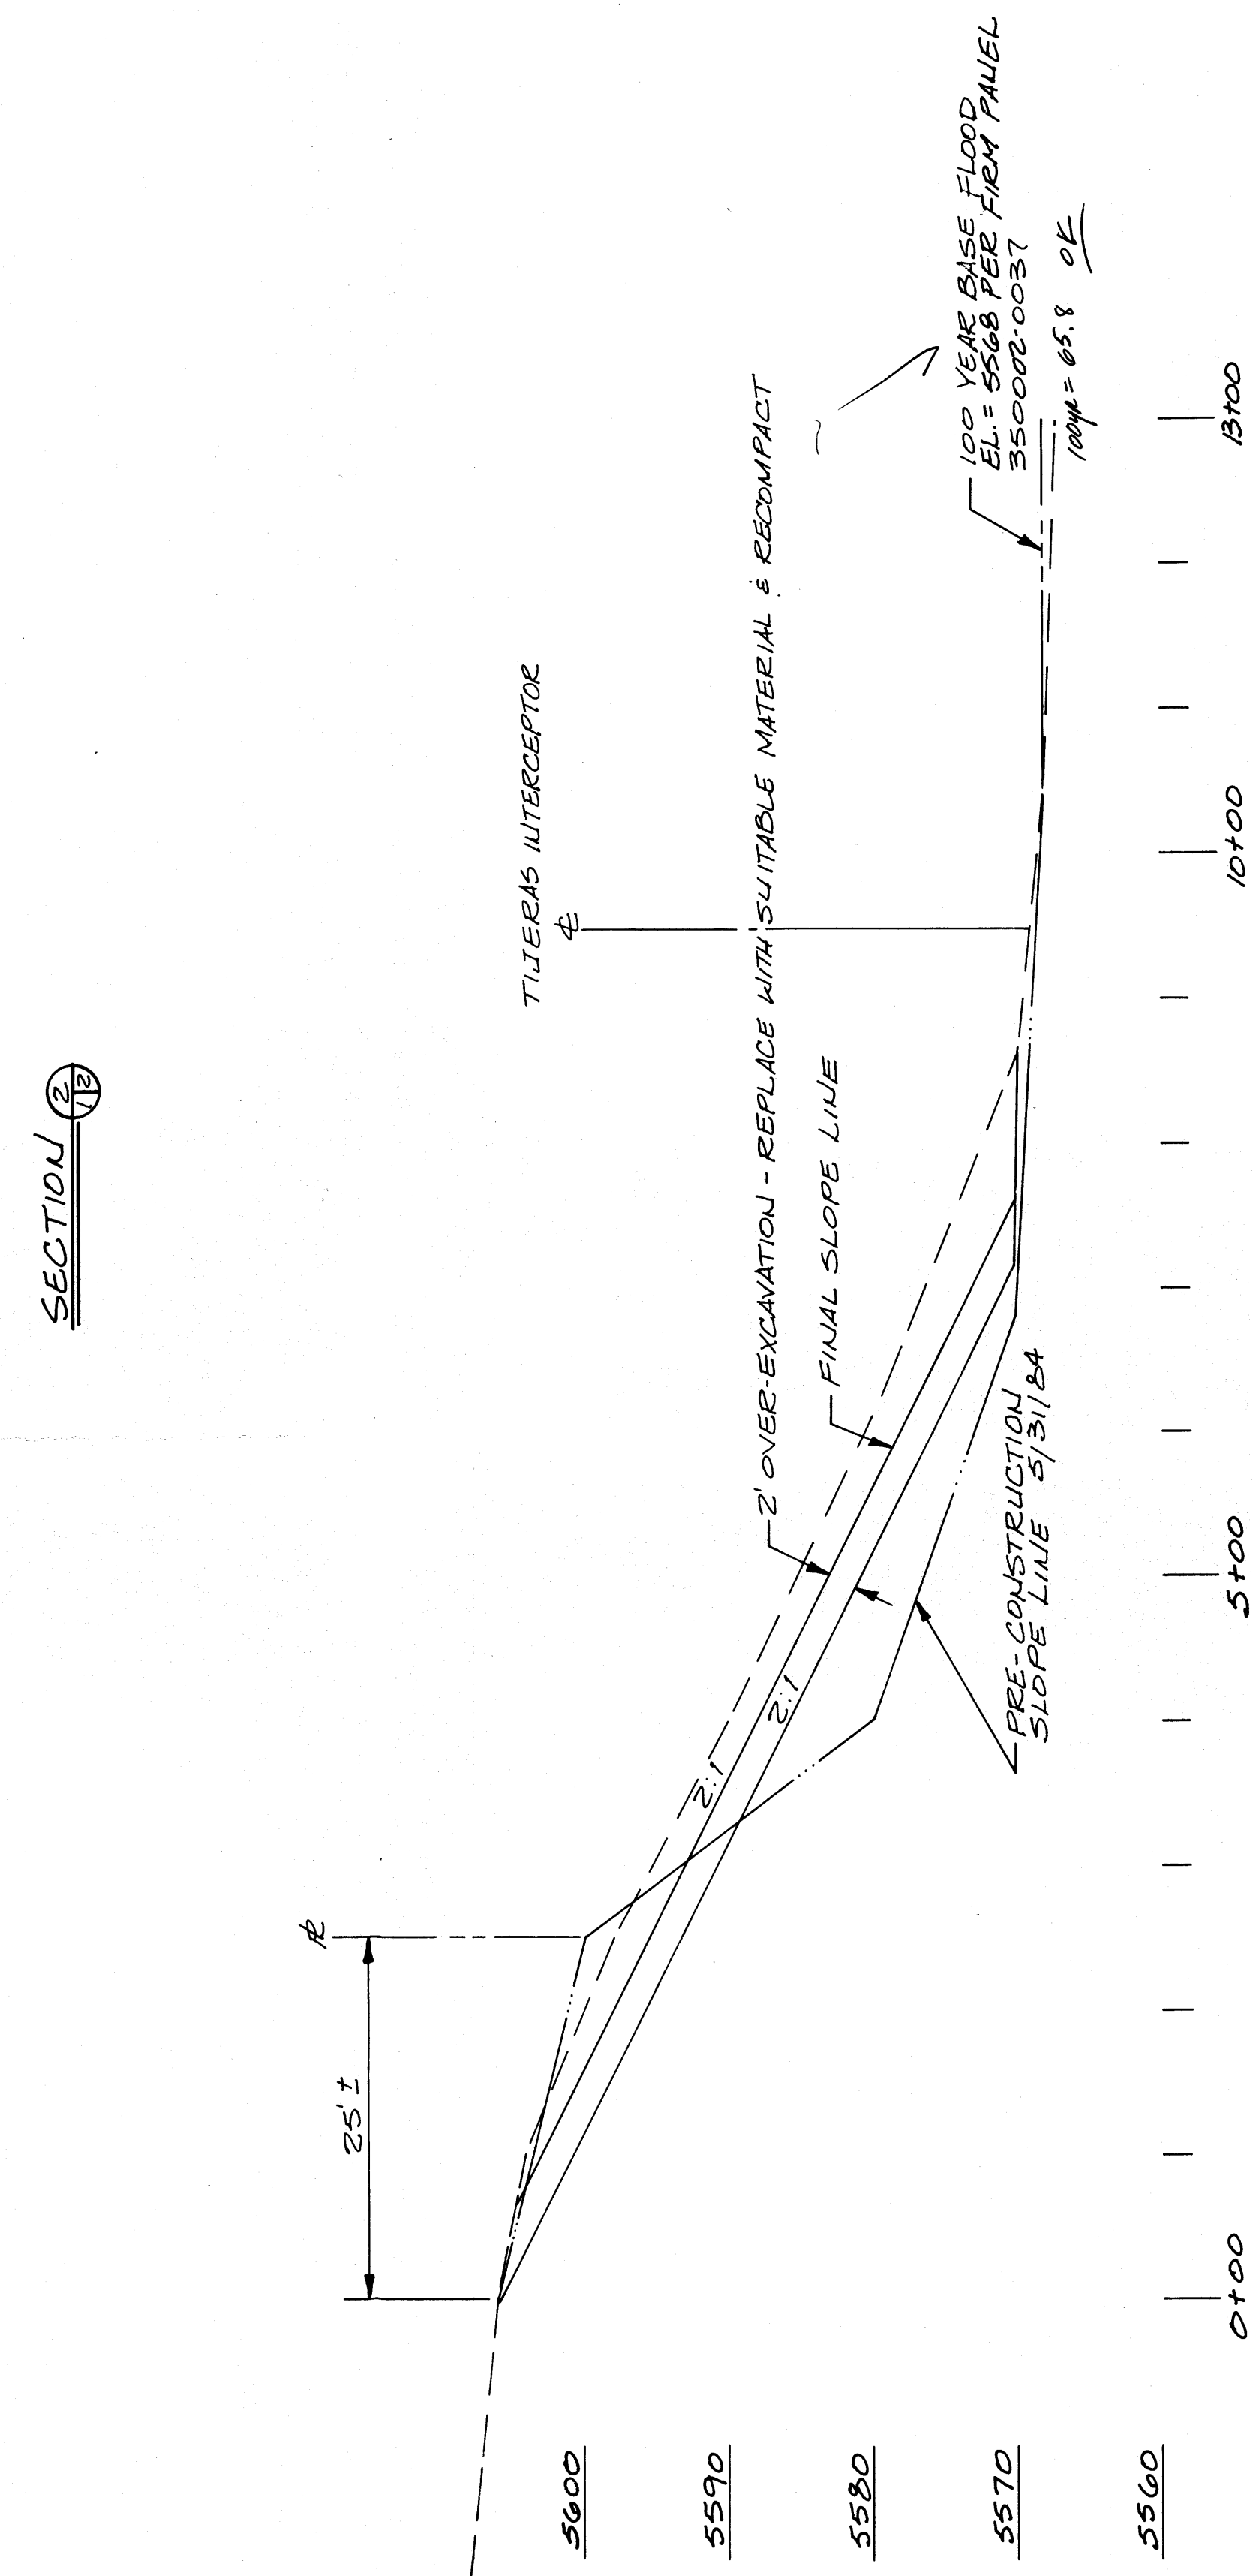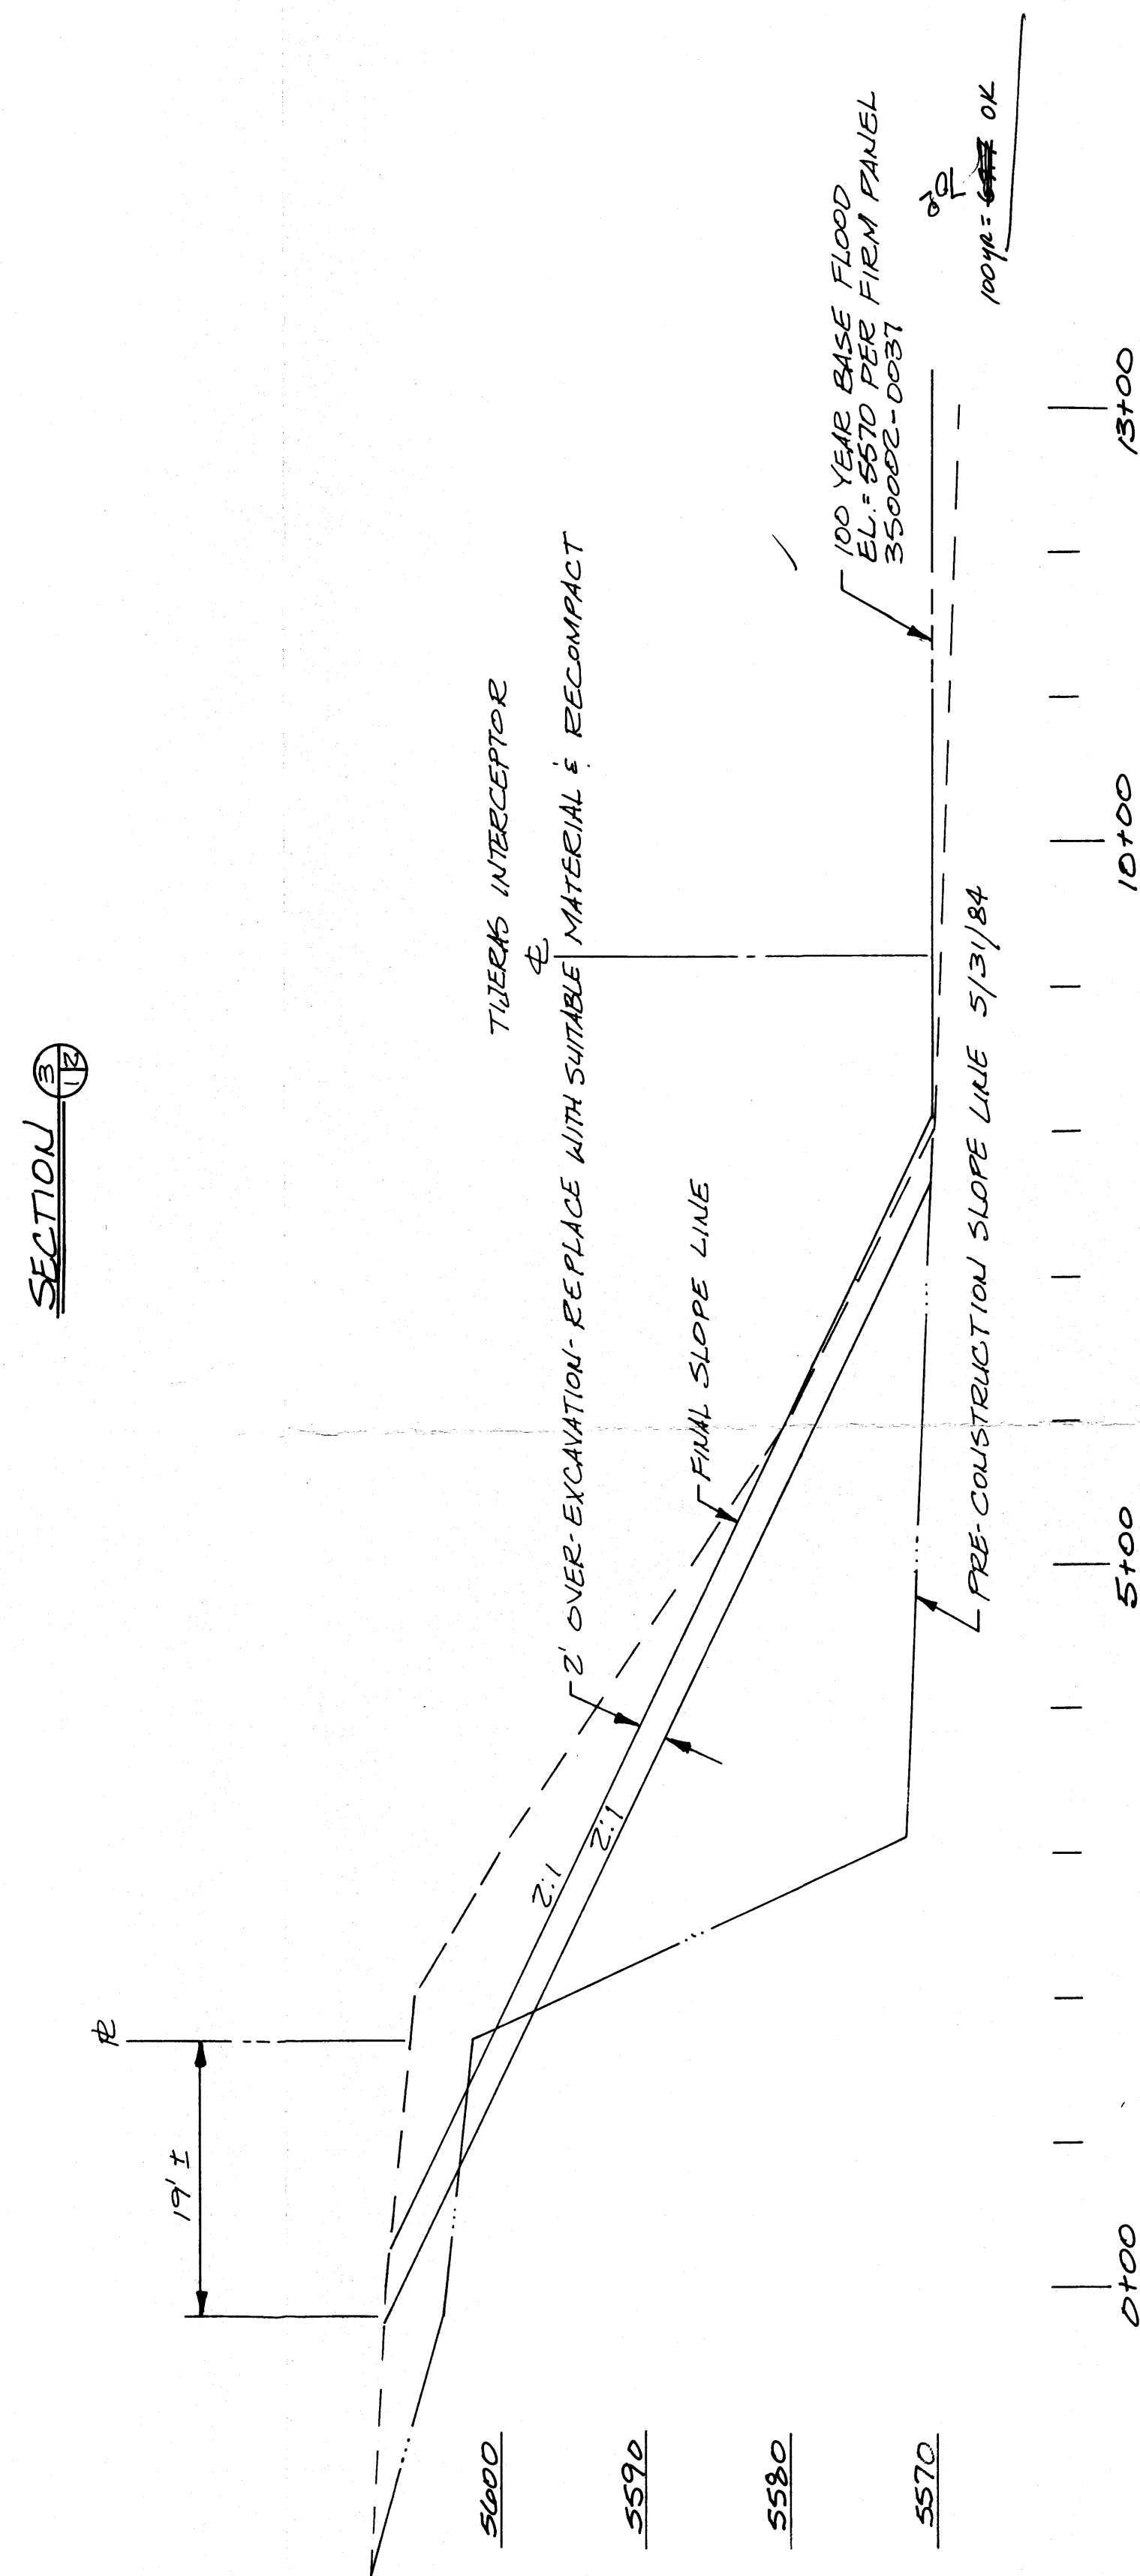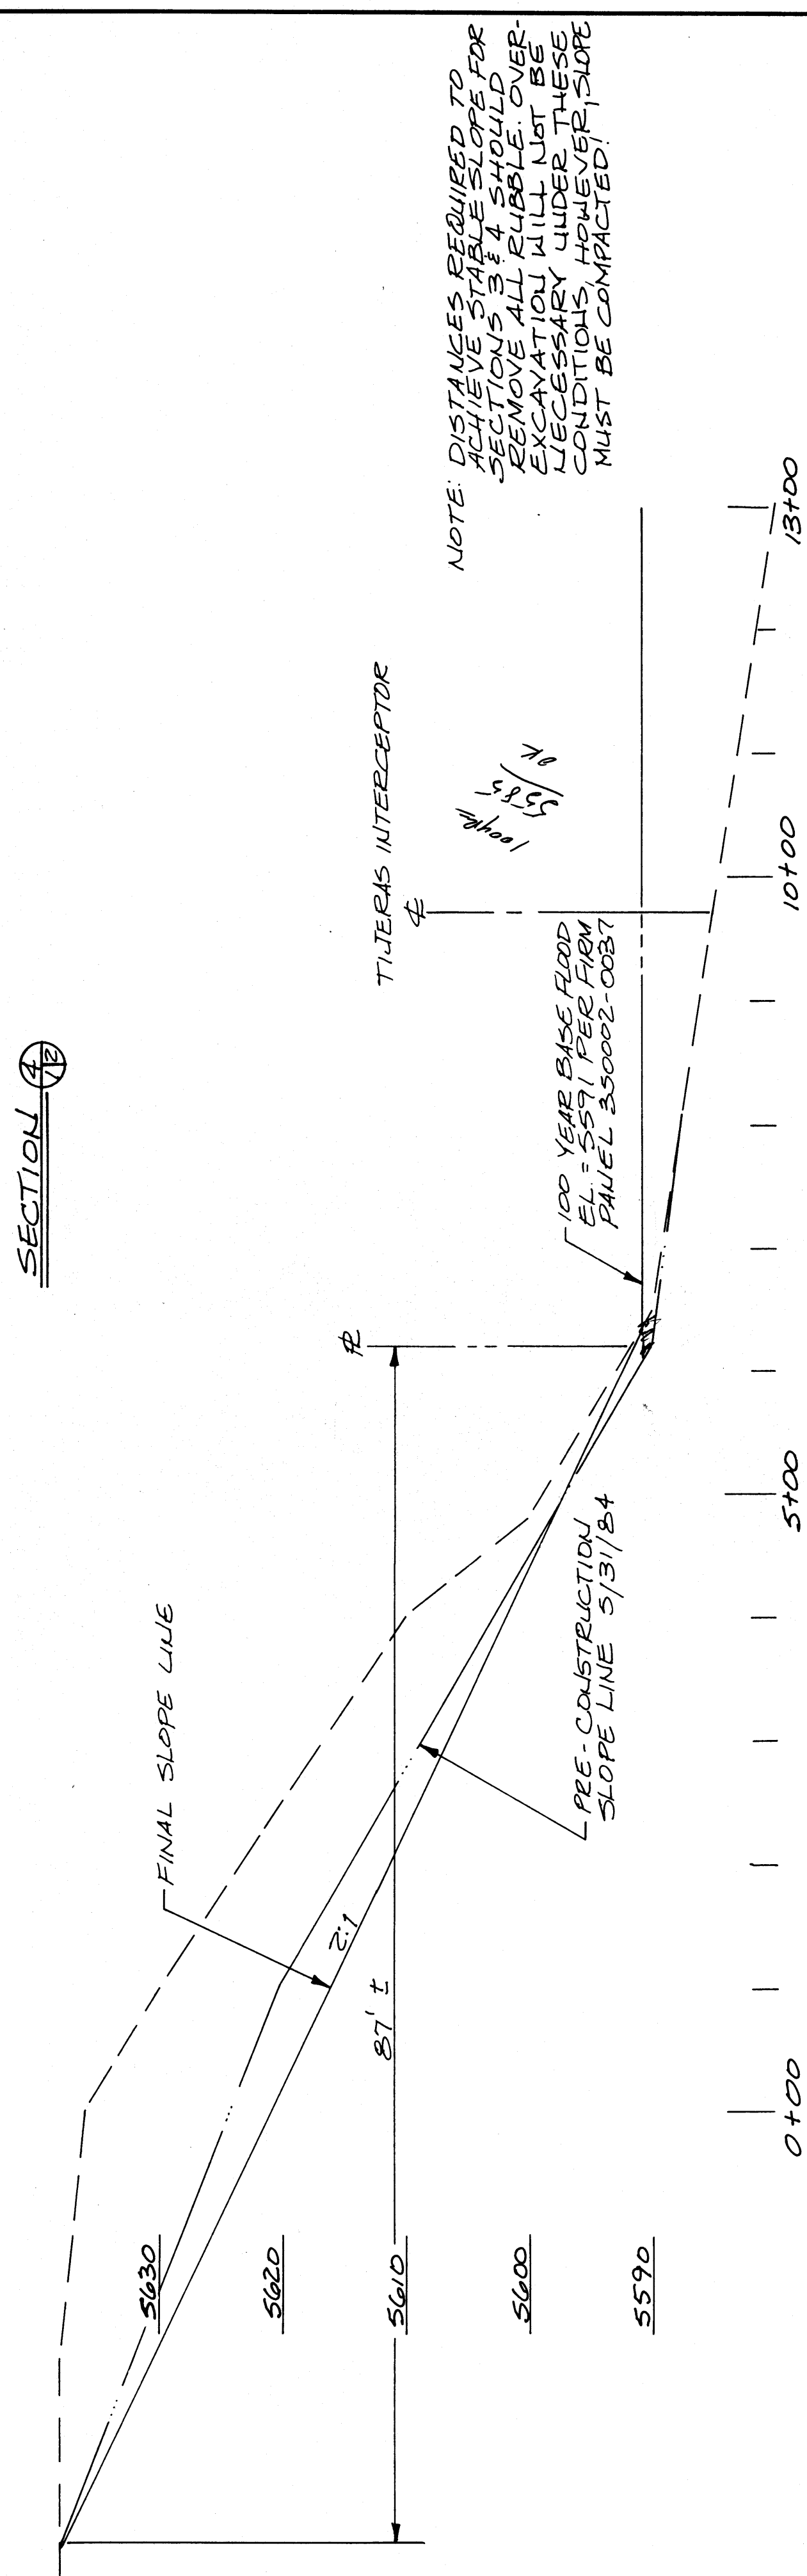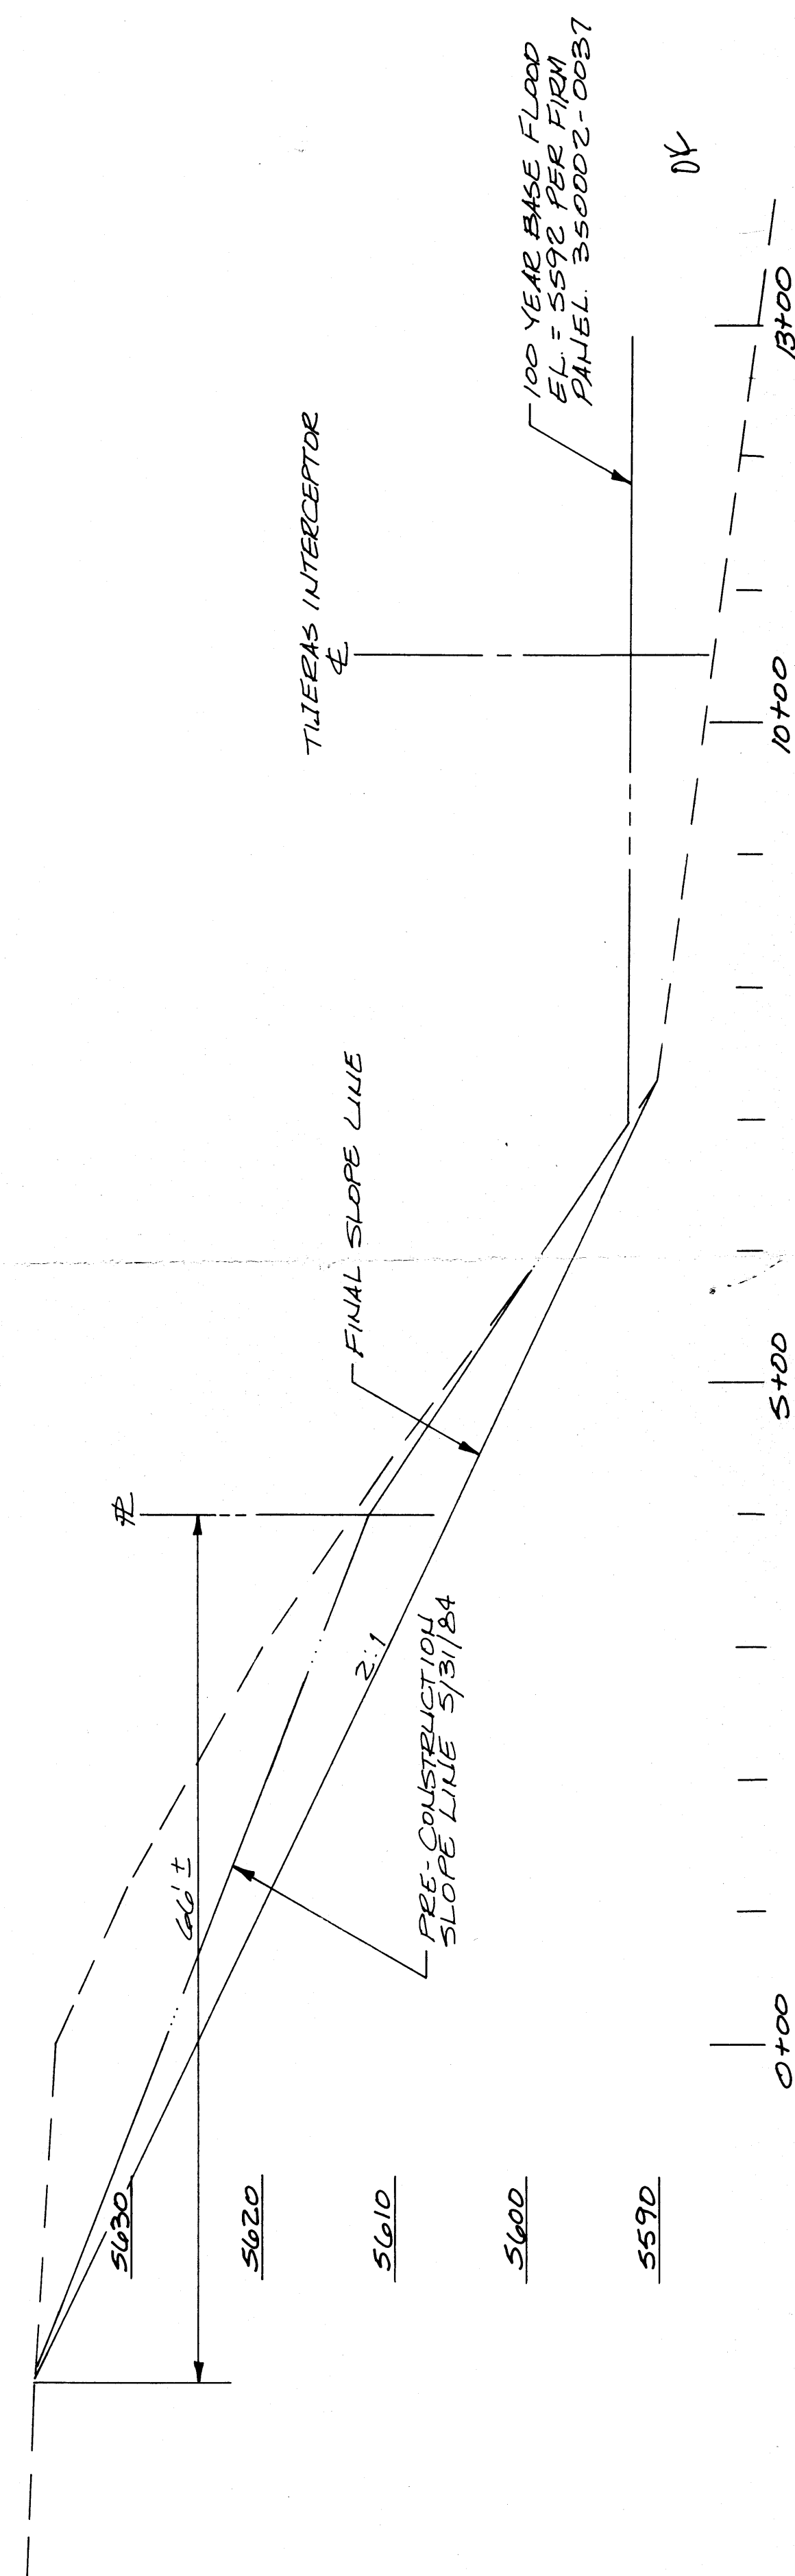

SCALES:
HORIZ. 1" = 10'
VERT. 1" = 10'



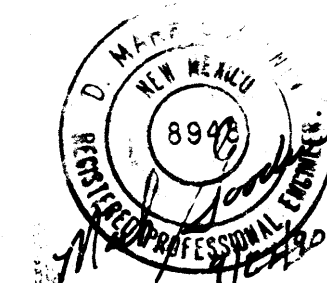
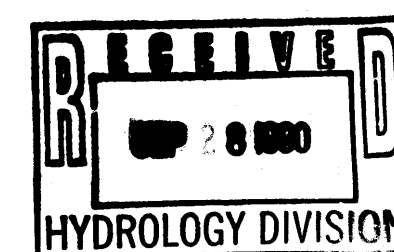


NORTH FOUR HILLS SUBDIVISION

FLOOD PLAIN RECLAMATION

dmg D. MARK GOODWIN & ASSOCIATES, P.A.
CONSULTING ENGINEERS & SURVEYORS
P.O. BOX 90606
ALBUQUERQUE, NEW MEXICO 87199
(505) 828-2200


Designed: <i>DMG</i>	Drawn: <i>RJA</i>	Checked: <i>DMG</i>	Sheet 2 of 2
Scale: <i>NONE</i>	Date: <i>9/90</i>	Job: <i>90-40</i>	

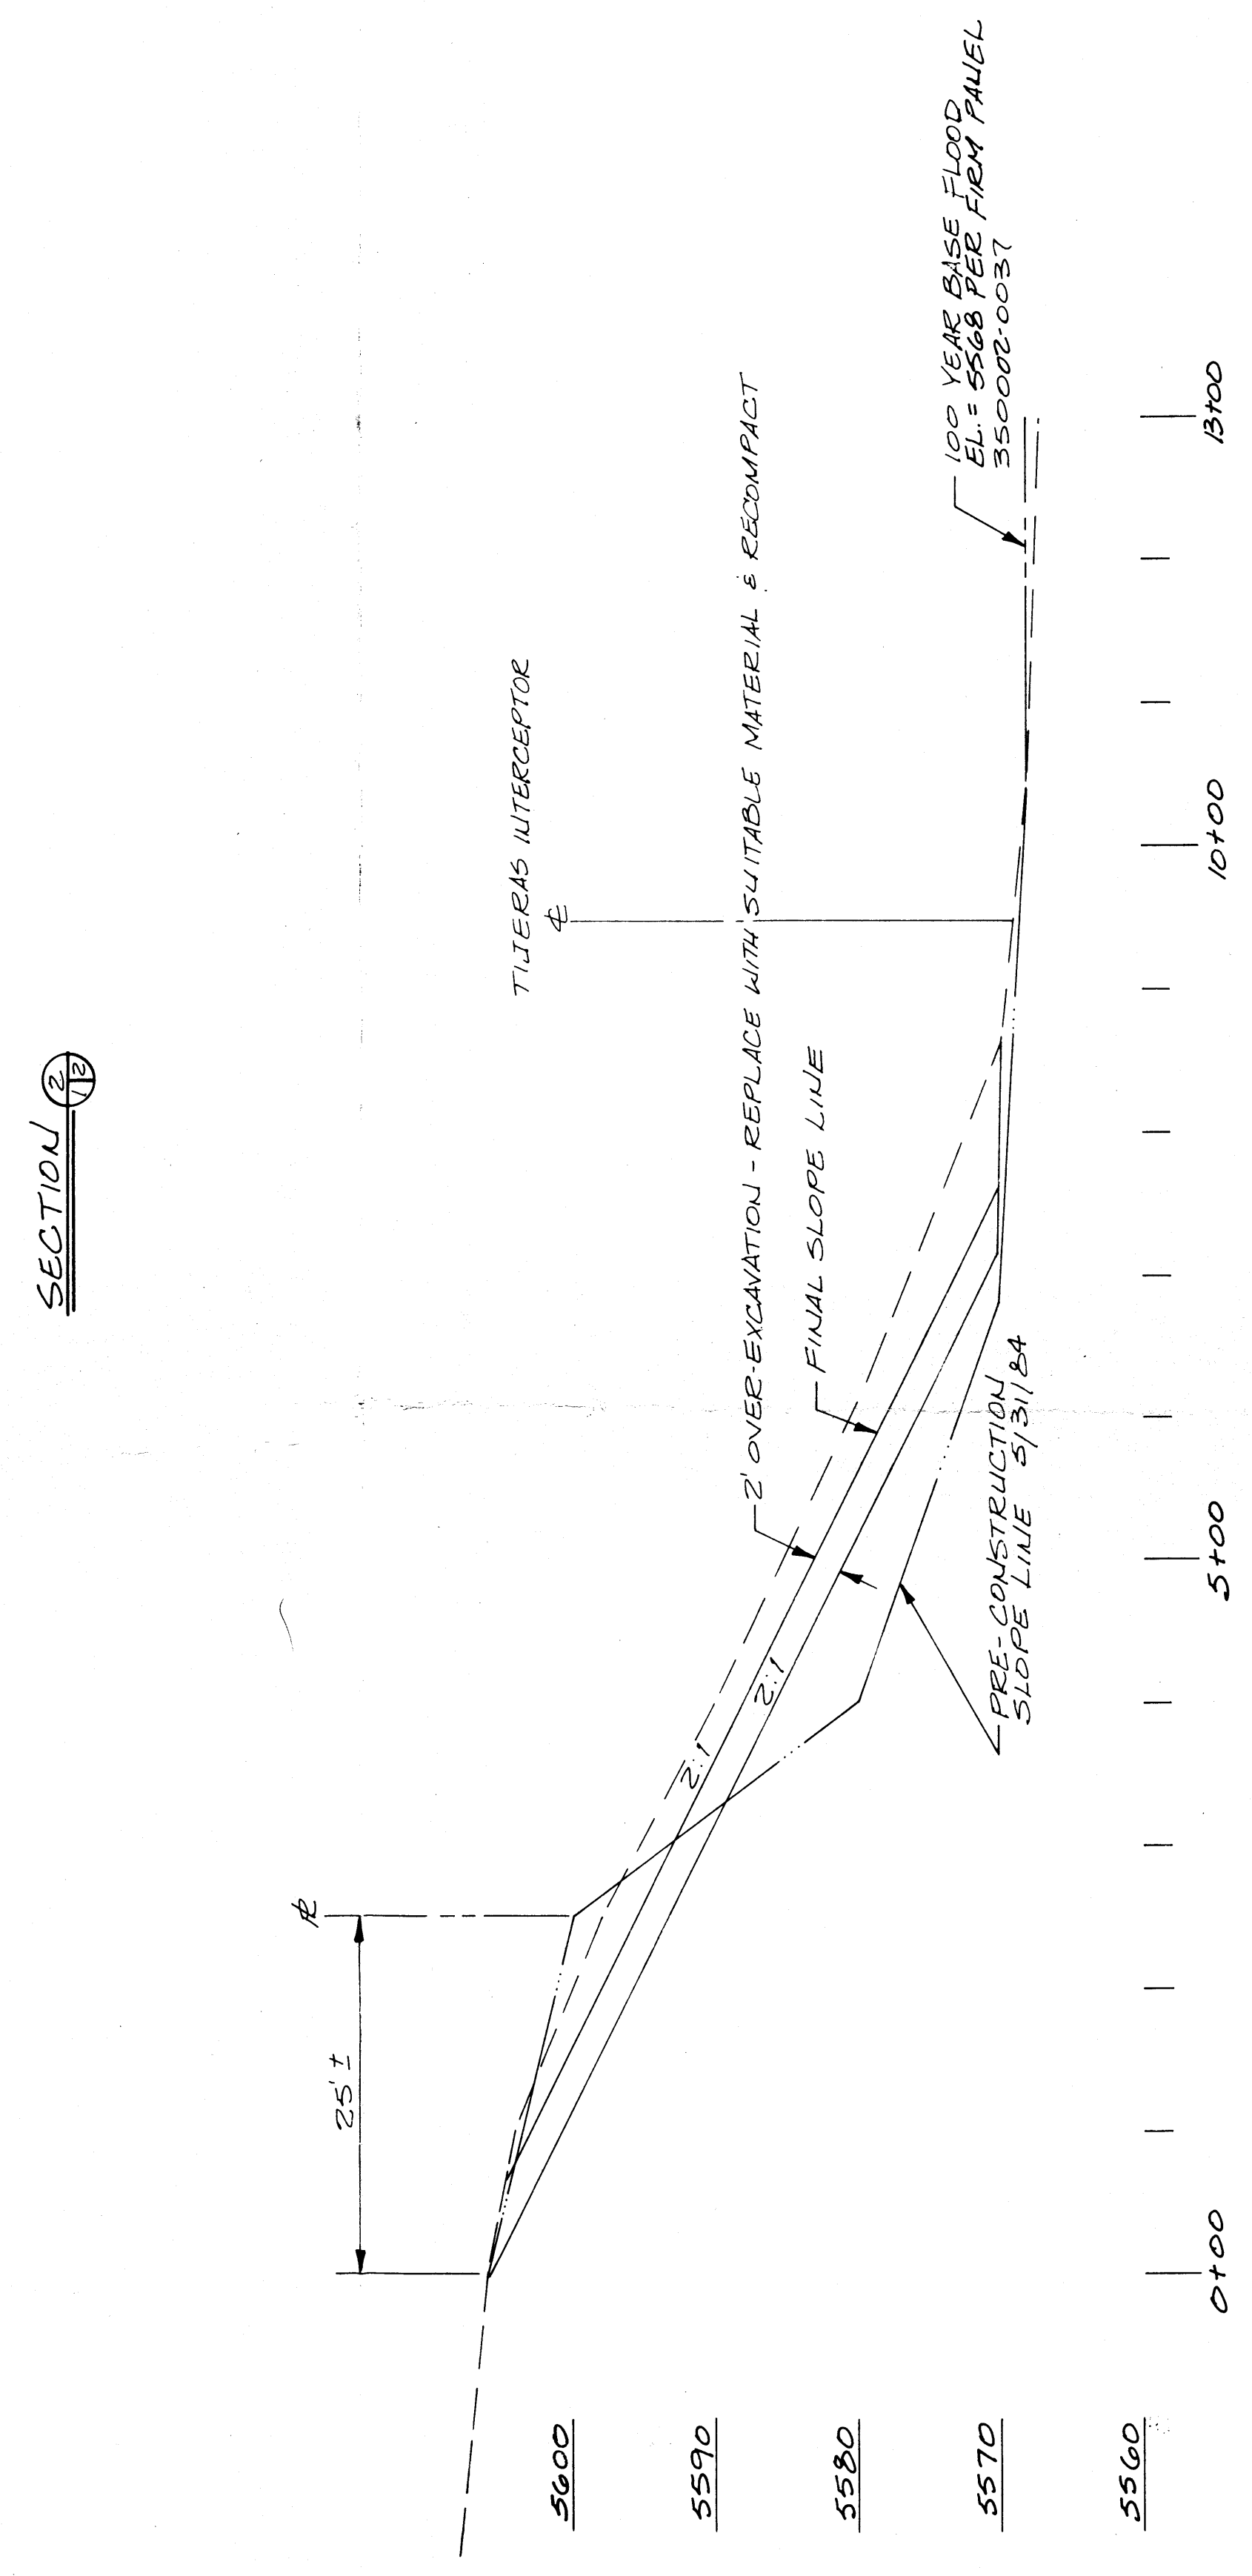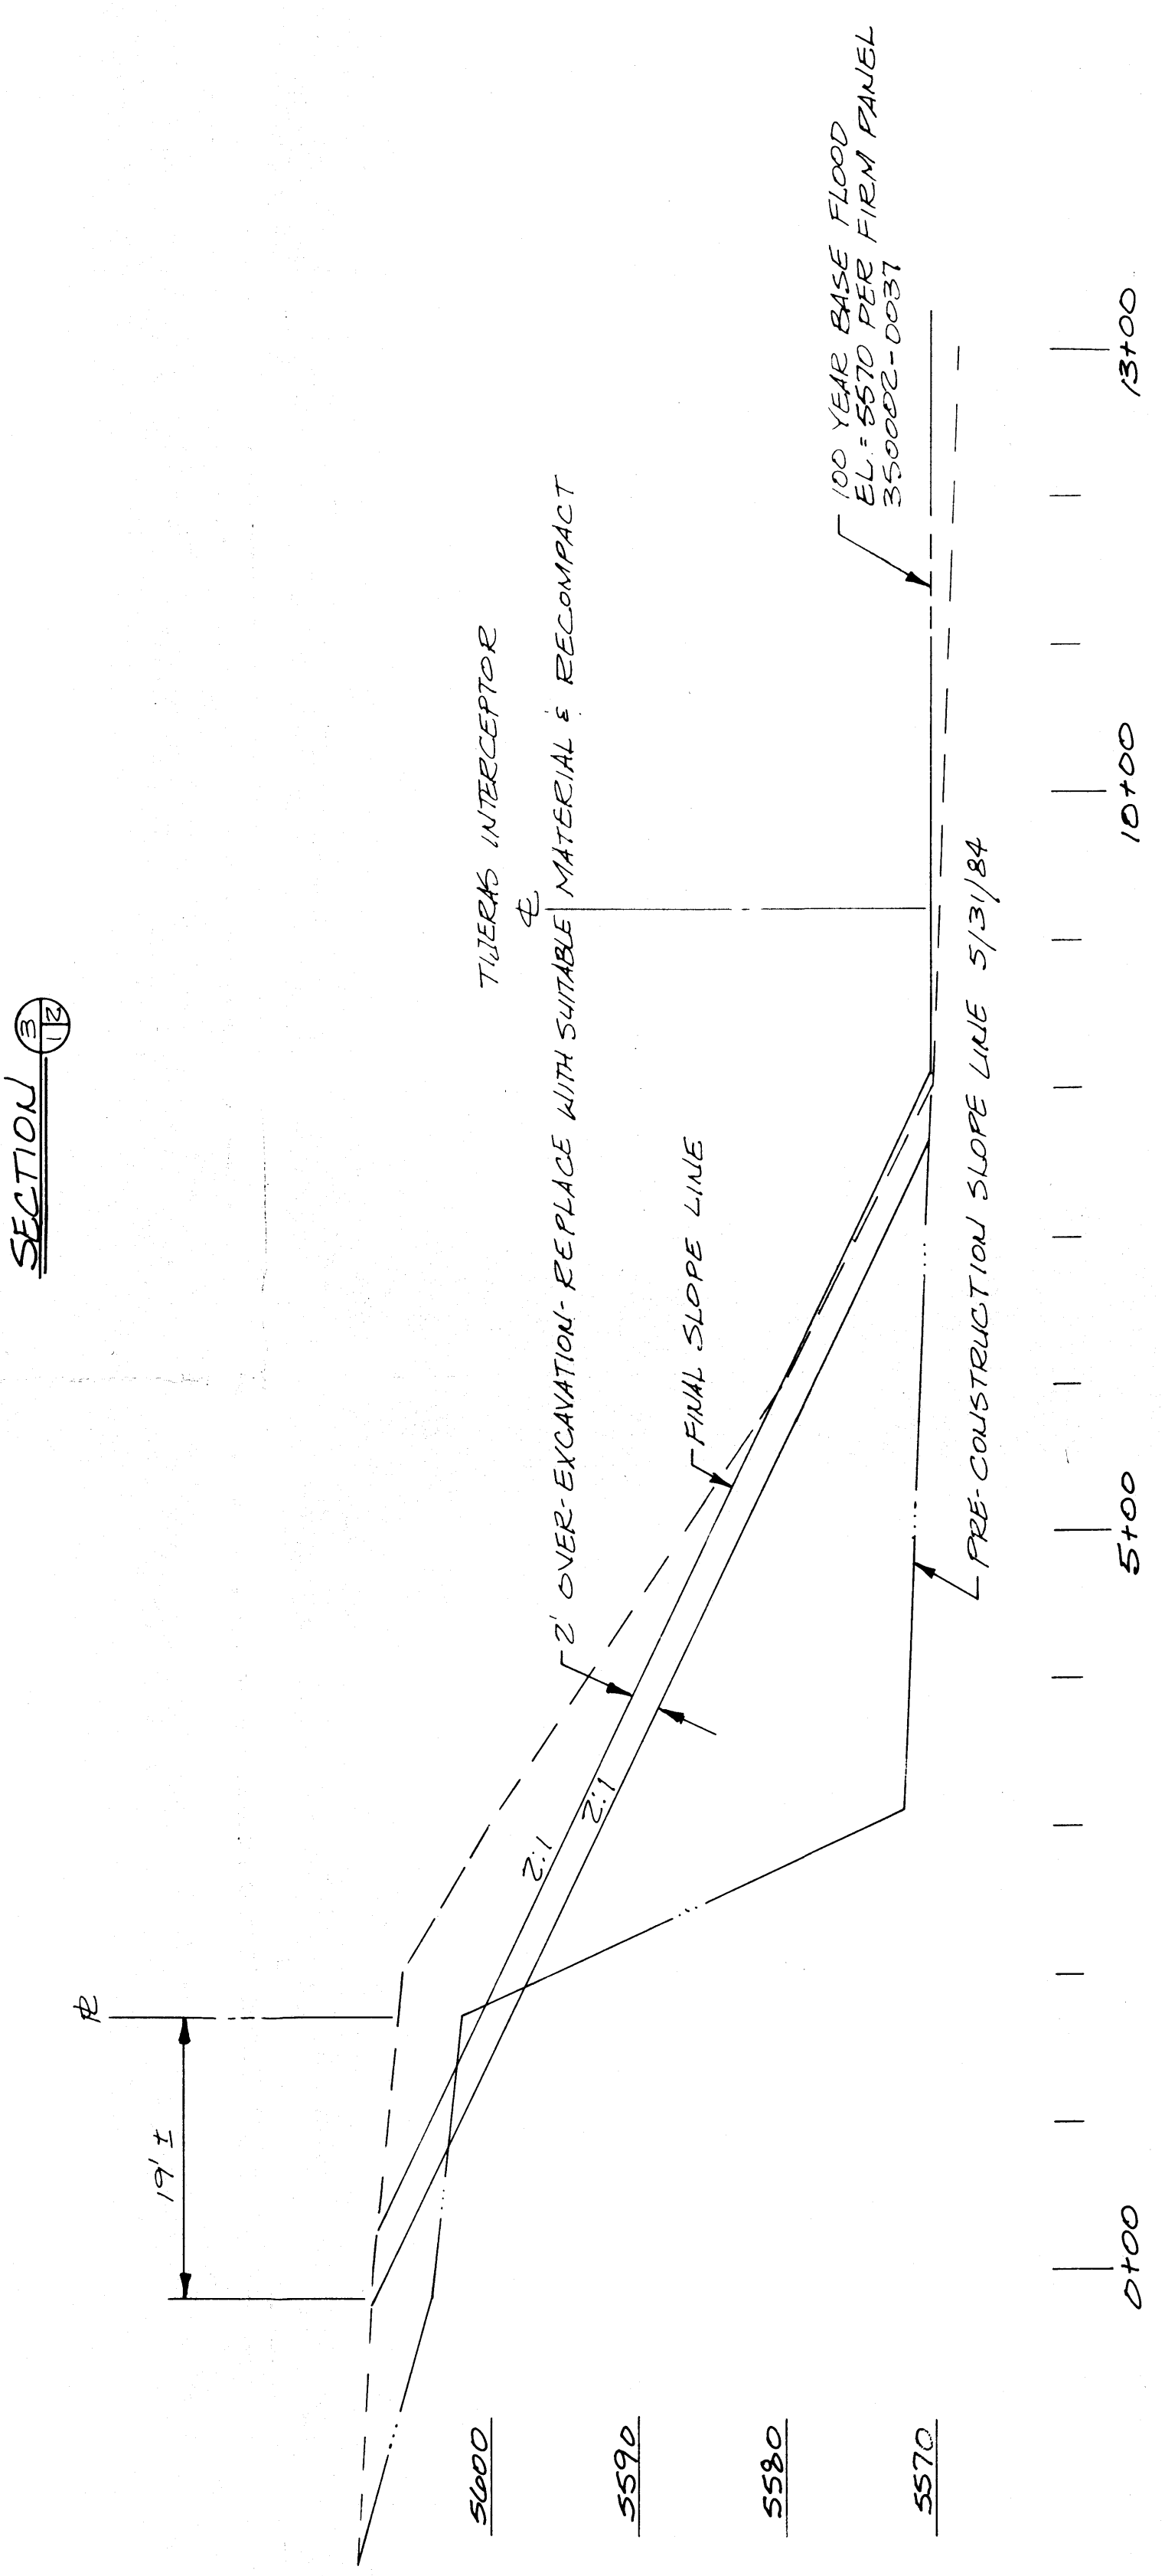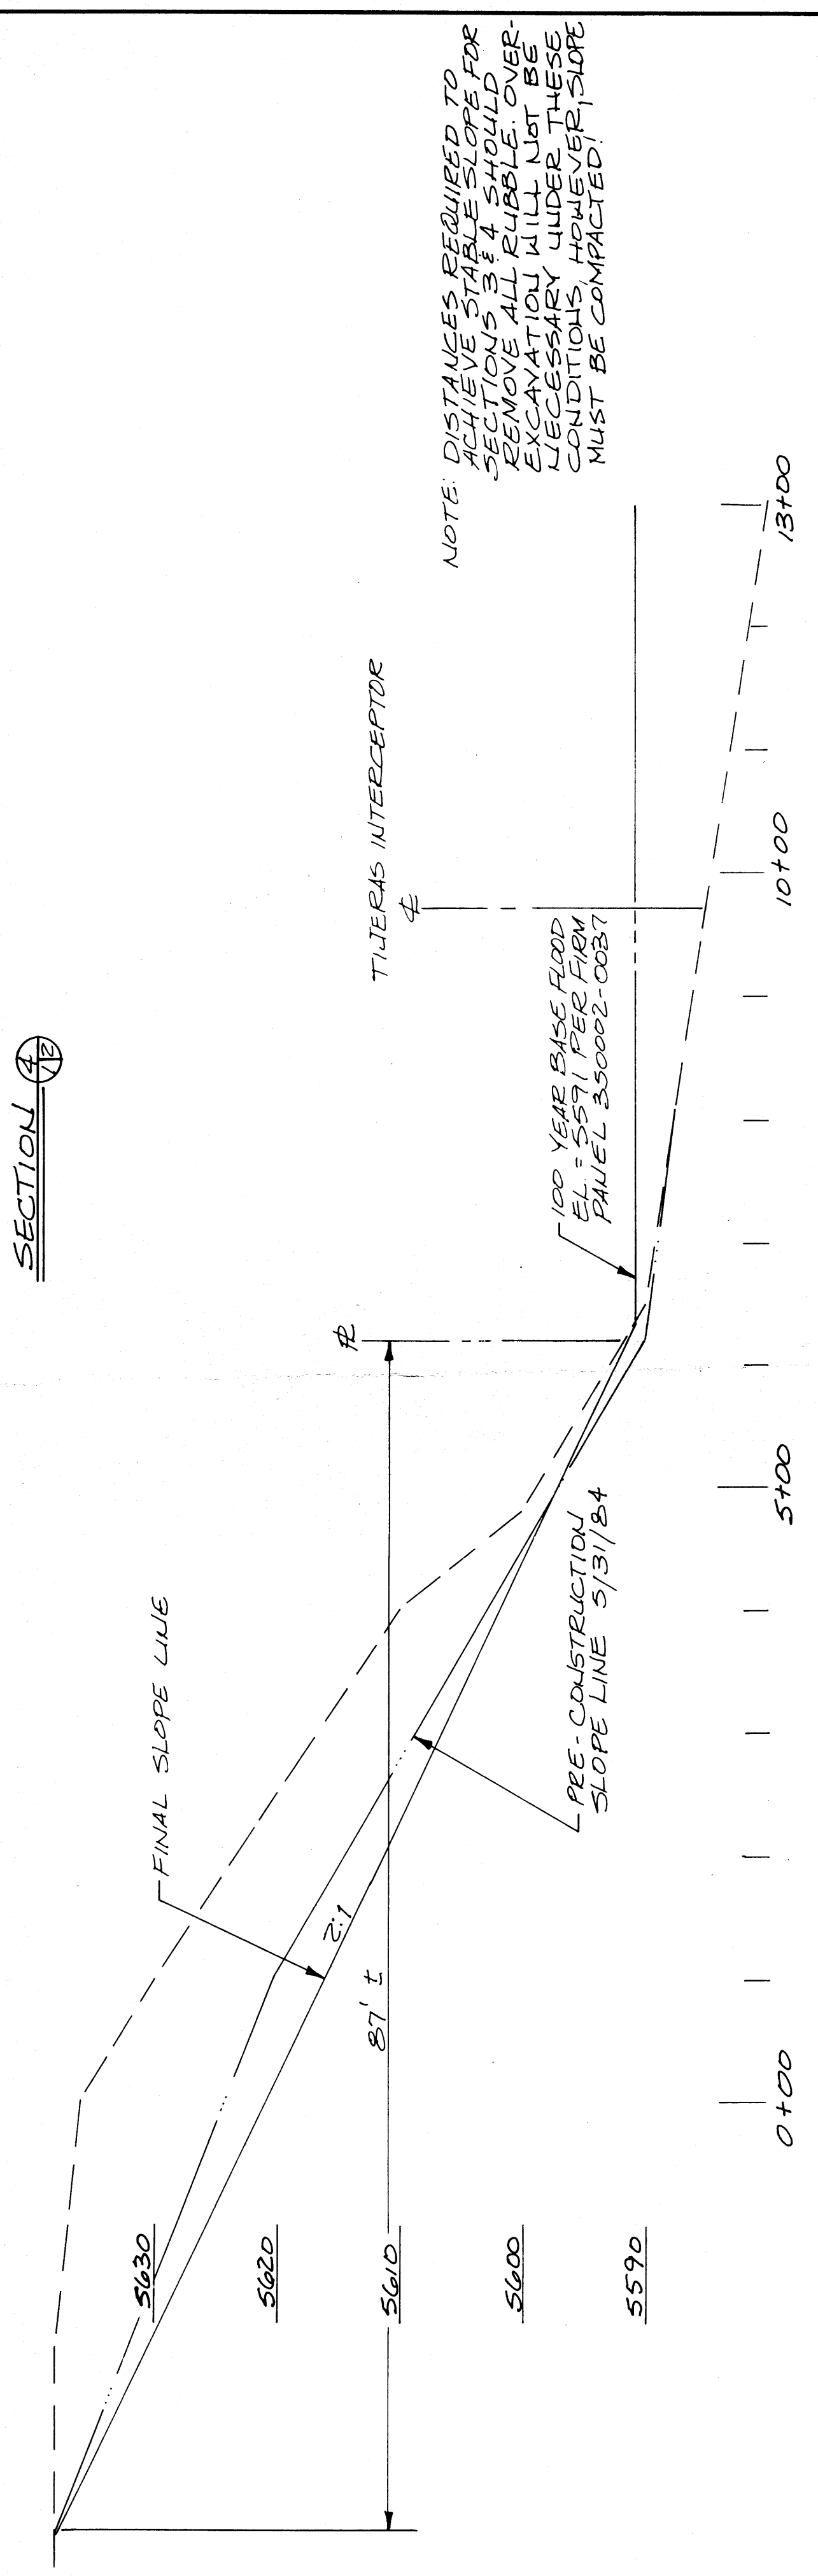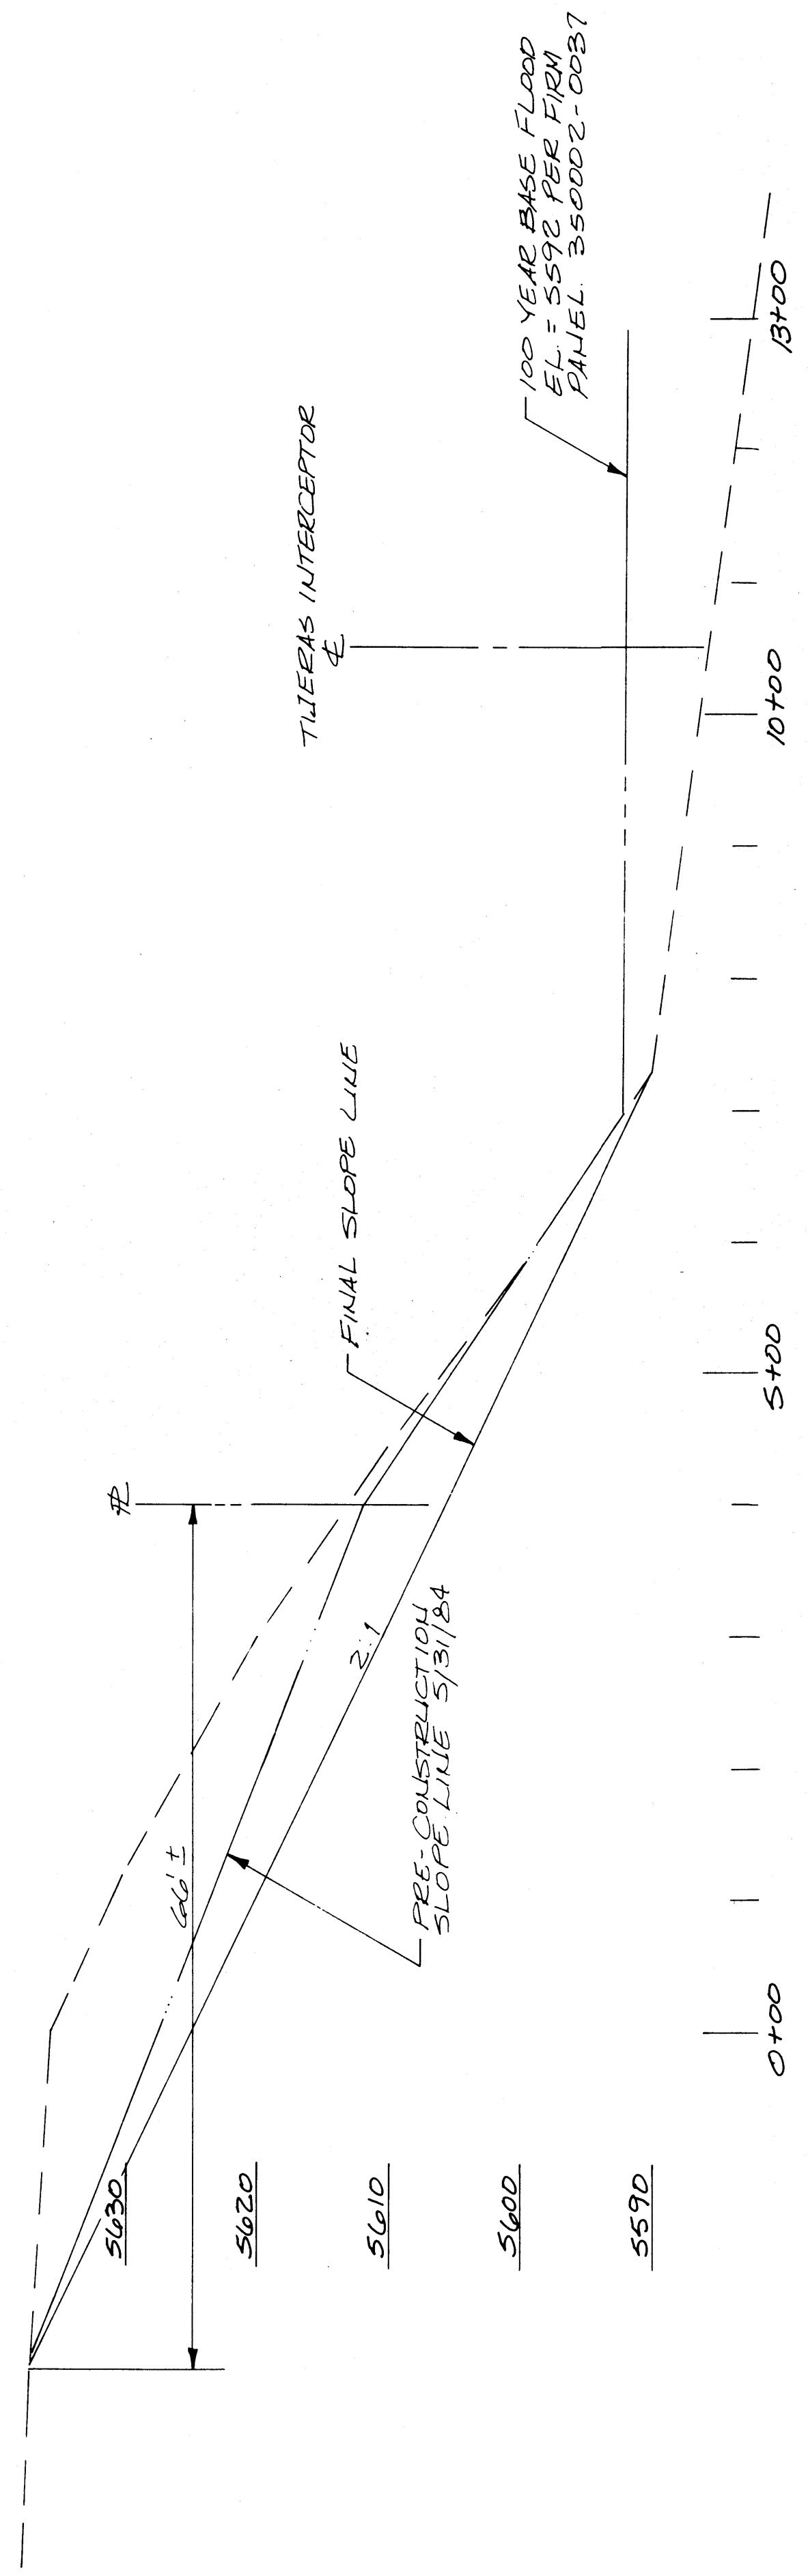

SCALES:
HORIZ 1" = 10'
VERT 1" = 10'



NORTH FOUR HILLS SUBDIVISION			
FLOOD PLAIN RECLAMATION			
dmg D. MARK GOODWIN & ASSOCIATES, P.A. CONSULTING ENGINEERS & SURVEYORS P.O. BOX 90606 ALBUQUERQUE, NEW MEXICO 87199 (505) 828-2200			
Designed: DMG	Drawn: RJA	Checked: DMG	Sheet 2 of 2
Scale: NONE	Date: 9/90	Job: 90-40	

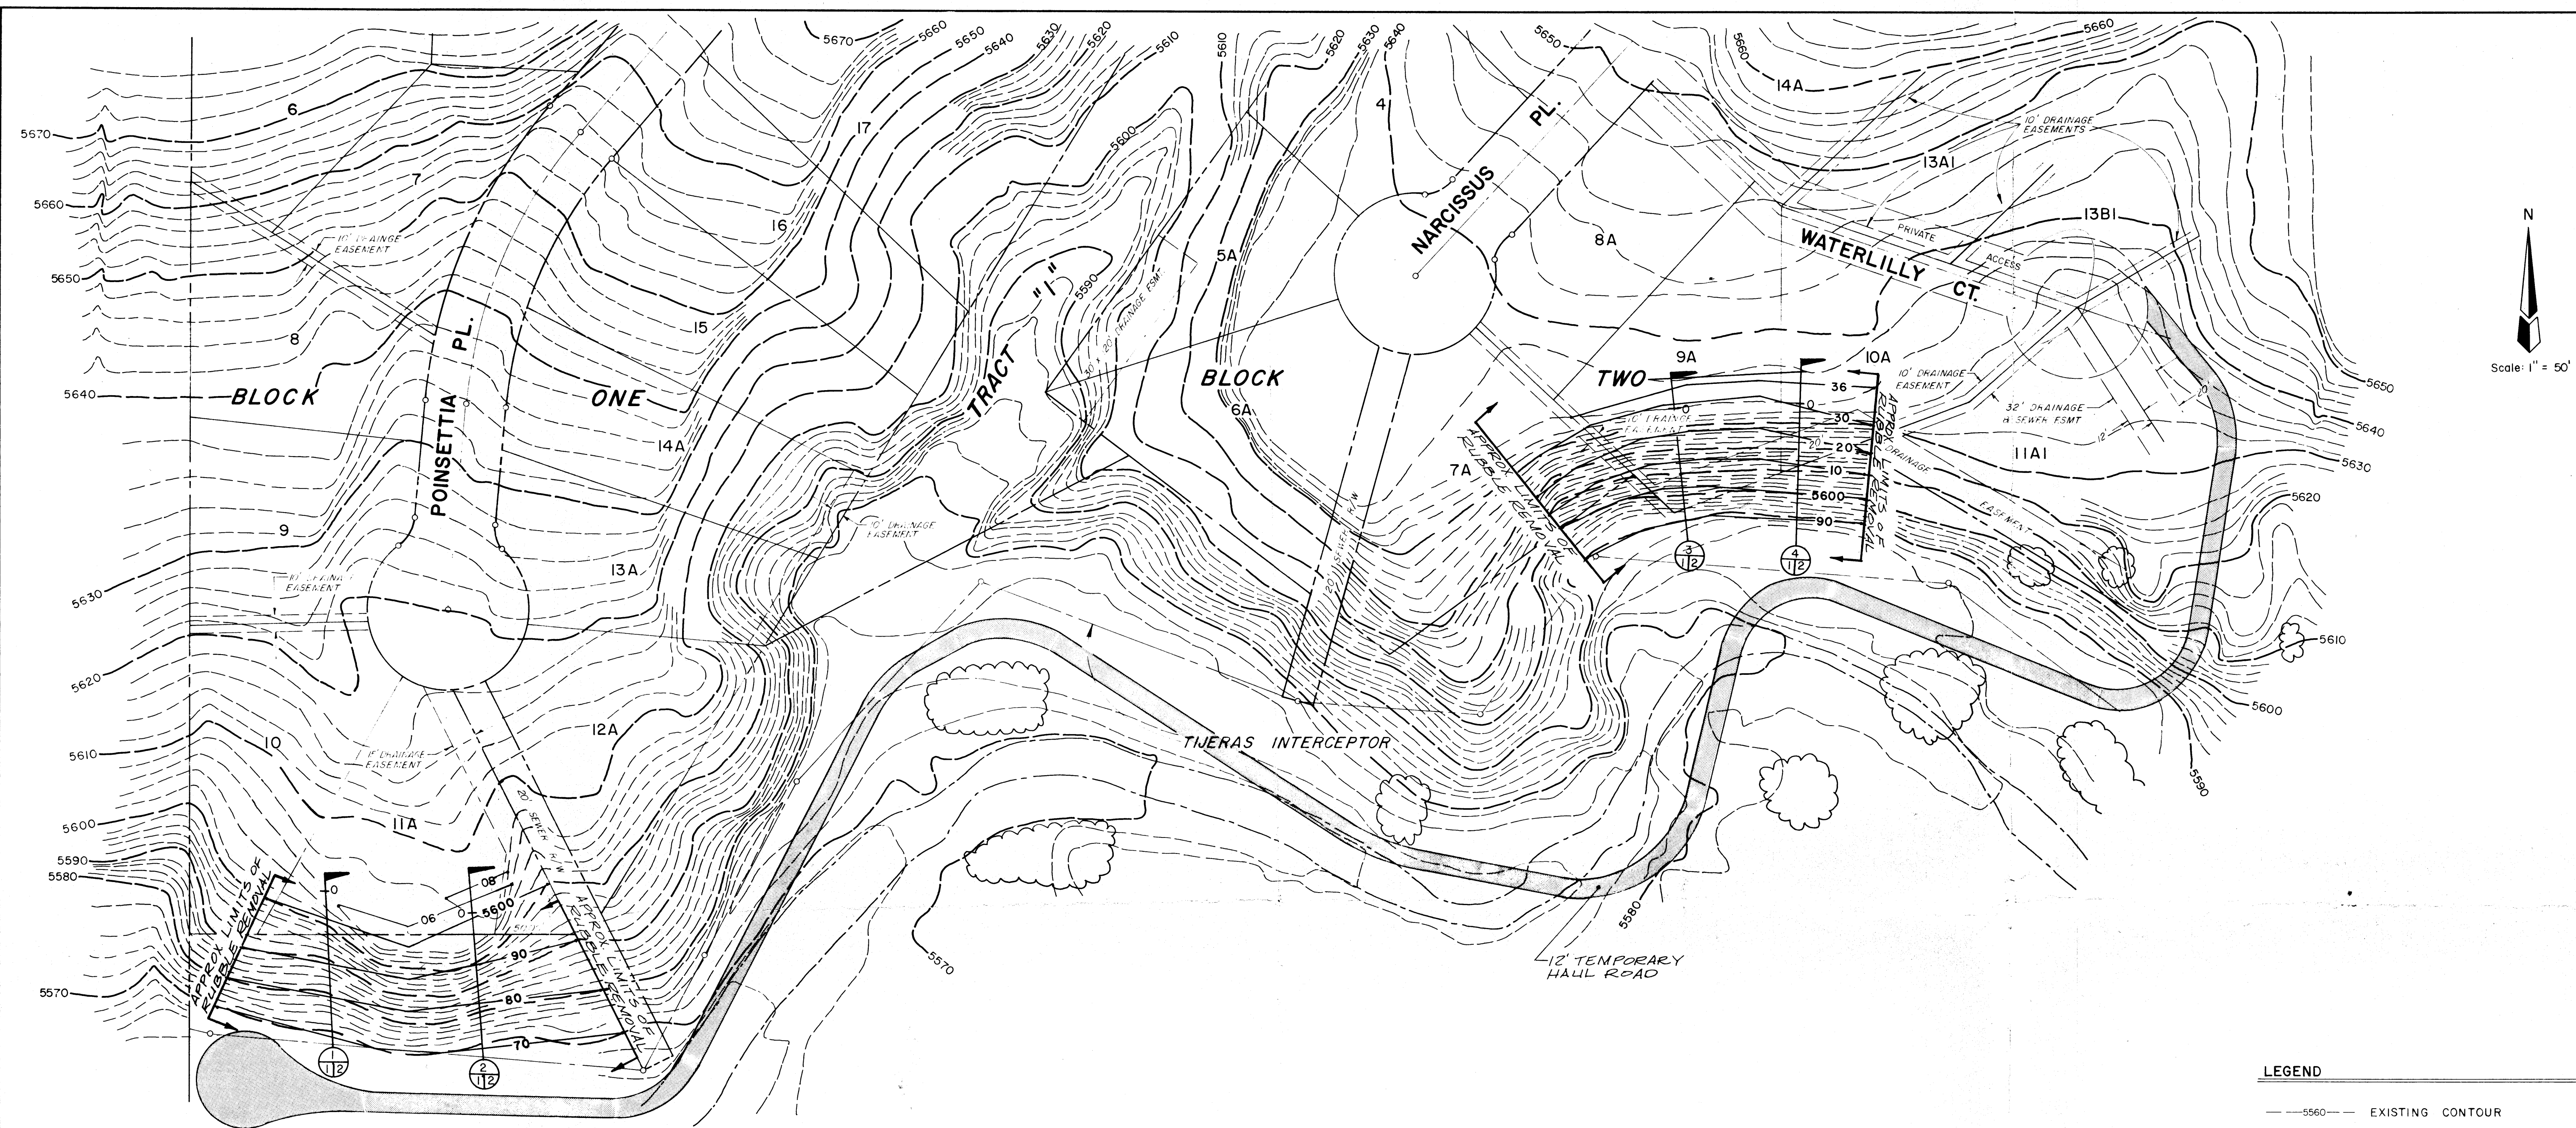

LEGEND	
— 5560 —	EXISTING CONTOUR
— 100 —	PROPOSED CONTOUR
---	SUBDIVISION BOUNDARY
---	EDGE OF ARROYO

LEGAL DESCRIPTION


Lot 11A, Block One, and Lots 7A, 9A and 10A, Block Two, North Four Hills Subdivision, Albuquerque, Bernalillo County, New Mexico.

ACS BENCHMARK

The station is a standard ACS brass tablet stamped "TOM - 1978", set in a concrete post projecting 2" above ground. To reach the station from the intersection of I-40 and Tramway Blvd. SE, go south on Tramway 0.1 miles to the frontage road. Turn left, go east to the intersection of the frontage road and Waterfall Dr. Turn right, go south on Waterfall Dr. for 0.14 miles. The station is located approximately 250 feet east of Waterfall Dr.

"TOM 1978" EL. = 5711.67'

- NOTES**
1. ALL DISTURBED AREAS ARE TO BE RECOMPACTED THEN SEEDED PER CITY OF ALBUQUERQUE STANDARD SPECIFICATIONS FOR PUBLIC WORKS CONSTRUCTION, SECTION 1011, AS MODIFIED.
 2. LOCATION OF TEMPORARY HAUL ROAD IS APPROXIMATE. CONTRACTOR IS TO PLACE ROAD SUCH THAT NO DAMAGE TO EXISTING VEGETATION OCCURS. UPON COMPLETION OF CONSTRUCTION, ROAD IS TO BE OBLITERATED. SEEDING WILL NOT BE NECESSARY.
 3. ALL RUBBLE REMOVED FROM SLOPES IS TO BE DISPOSED OF IN AN ACCEPTABLE MANNER. UNDER NO CIRCUMSTANCES IS RUBBLE TO BE DISPOSED OF ON-SITE OR IN ADJACENT ARROYOS OR STRUCTURES.
 4. WHEREVER CONTRACTOR CROSSES THE TIJERAS INTERCEPTOR, ADEQUATE PROTECTION IS TO BE PROVIDED.
 5. FOR FINISHED LINES AND GRADES, SHEET 2.
 6. LIMITS OF RUBBLE AND TOPOGRAPHY ACQUIRED BY FIELD SURVEY 9/90.
 7. SLOPE COMPACTION IS TO BE ACCOMPLISHED BY TRACKED VEHICLE EQUIVALENT TO A D-6 OR HEAVIER.

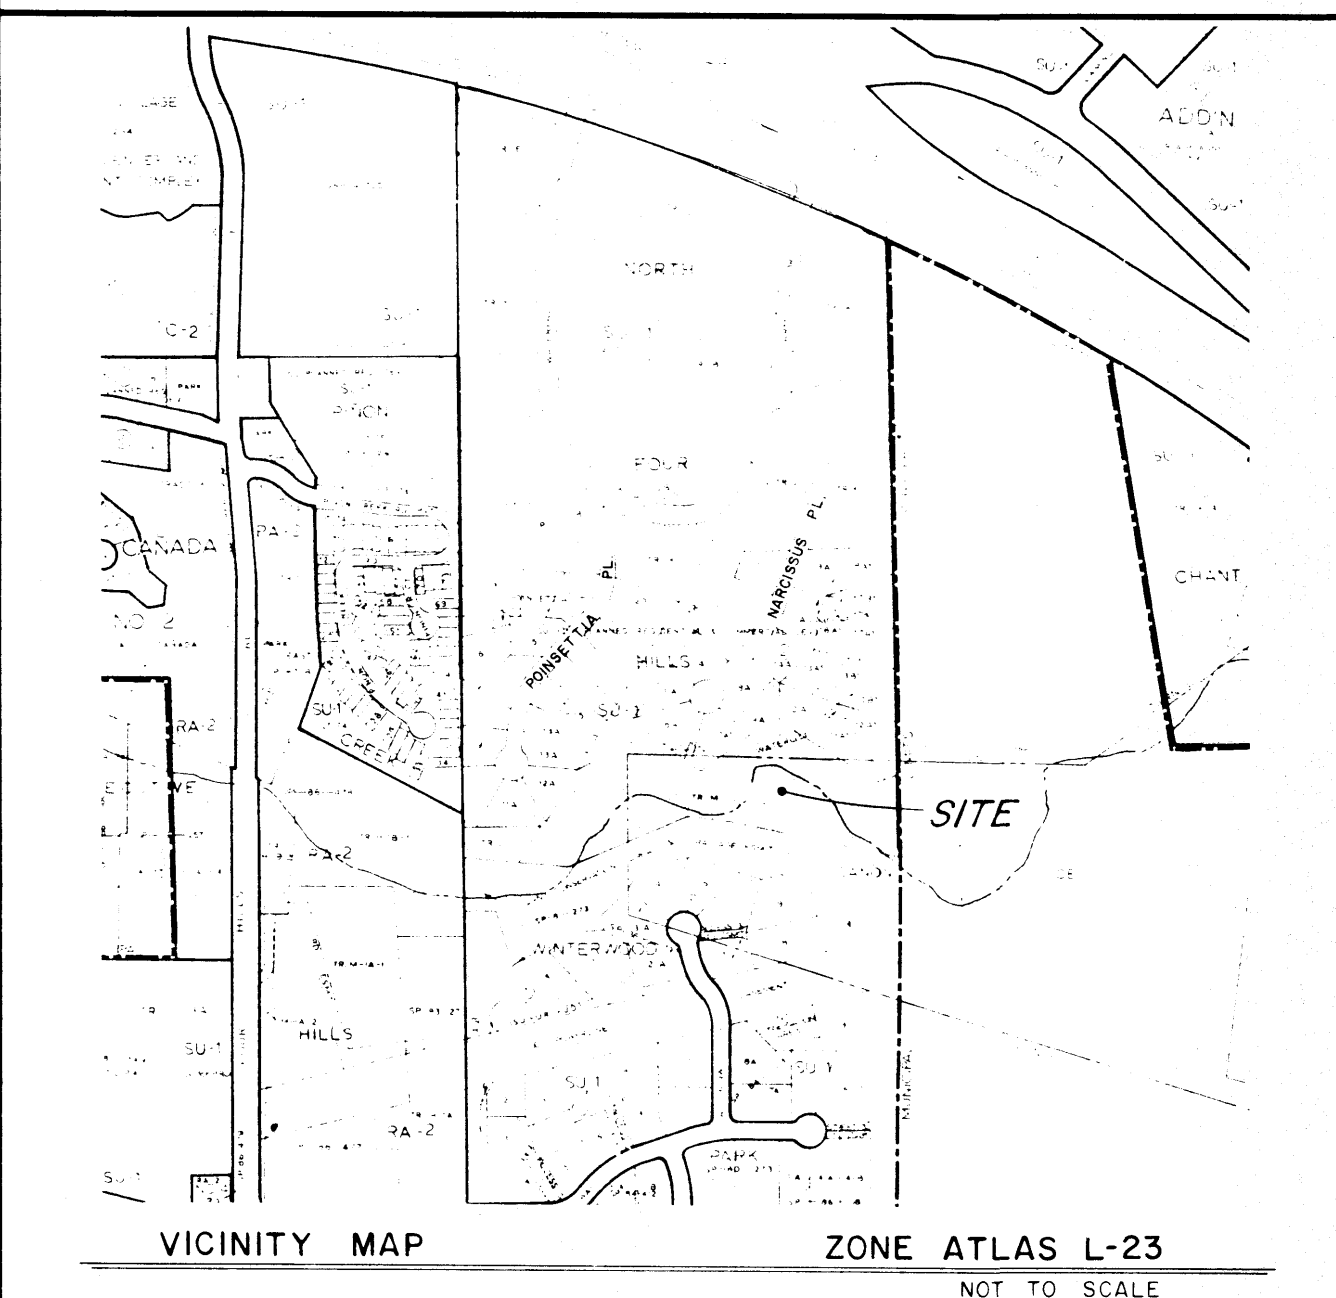


NORTH FOUR HILLS SUBDIVISION

FLOOD PLAIN RECLAMATION

dmg D. MARK GOODWIN & ASSOCIATES, P.A.
CONSULTING ENGINEERS & SURVEYORS
P.O. BOX 90606
ALBUQUERQUE, NEW MEXICO 87199
(505) 828-2200

Designed: DMG	Drawn: MLM	Checked: DMG	Sheet 1 of 2
Scale: 1" = 50'	Date: 9/90	Job: 90-40	

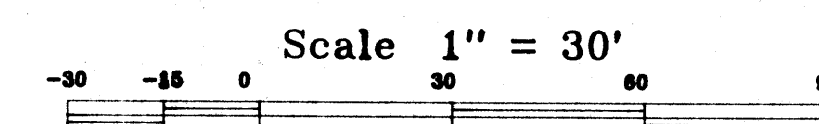

CONTOUR OVERLAY OF EXISTING AND PRE-EXISTING CONTOURS NORTH FOURHILLS SUBDIVISION.

88-217

88-217

80 43533

ENCHANTMENT ENGINEERING Inc.
1517 EUBANK BLVD. N.E.
ALBUQUERQUE, N.M. Ph. 294-8859

WINTERWOOD PARK

A PORTION OF
TOWN AND COUNTRY VILLAGE
AN ADDITION TO THE
CITY OF ALBUQUERQUE,
BERNALILLO CO., NEW MEXICO
WITHIN SECTION 26, T.10N., R.4E., N.M.P.M.
April 22, 1980

DESCRIPTION:
BEGINNING at the Southwest corner of the Tract herein described, which point is the Northwest corner of Lot 1, Block 2, FOUR HILLS VILLAGE FIRST INSTALLMENT, Plat of which was filed in the office of the County Clerk of Bernalillo County, New Mexico, on September 9, 1958, and from said Beginning point running thence, N. 0° 30' 00" W., along the Easterly boundary of Executive Hills, a distance of 1141.00 feet, thence, S. 85° 30' 00" E., 325.00 feet; thence, N. 66° 53' 27" E., 411.85 feet, thence, S. 83° 45' 00" E., 130.50 feet, thence, S. 79° 22' 39" E., 459.36 feet, thence, S. 0° 23' 00" E., 1164.29 feet, thence, S. 89° 22' 30" W., along the Northerly boundary of Four Hills Village First Installment, 1282.01 feet to the point of Beginning and containing 34.999 Acres more or less.

DEDICATION
Subdivision of the above described land is with the free consent and in accordance with the desires of the undersigned owners and the Public Ways shown hereon together with private Conservation Areas, all easements shown for drainage, access, and utilities are herewith dedicated to the public use forever. ANAFCA and other public agencies have the right of access, the right to remove obstructions, and the right to construct and maintain drainage facilities within drainage easements.

STATE OF NEW MEXICO } ss
COUNTY OF BERNALILLO }
On this 22nd day of April, 1980 the foregoing instrument was acknowledged before me by Bill Henderson, as General Partner of H & F Investments.

My commission expires Dec 2, 1982
Elizabeth D. Schuman
Notary Public

APPROVALS
5-22-80 Date
5-8-80 Date
7/31/80 Date
7/16/80 Date
7-15-80 Date
5-29-80 Date
5/1/80 Date
7/15/80 Date
7/31/80 Date
3/1/80 Date


Public Service Co. of New Mexico
Mountain Bell
Gas Company of New Mexico
Parks and Recreation Department
Water Resources Department
Traffic Engineer
Property Management
City Surveyor
City Engineer
Planning Department

SURVEYOR'S CERTIFICATE
I, J. W. Bettis, under the laws of the State of New Mexico, certify that I am a Registered Professional Engineer and Land Surveyor and that this Plat was prepared by me or under my supervision, shows all easements of record, meets the minimum requirements for monumentation and surveys of the Albuquerque Subdivision Ordinance, and is true and accurate to the best of my knowledge and belief.

J.W. Bettis, Reg. P.E. & L.S. N.M. # 3441

NOTE:
All "PERMANENT ACCESS & UTILITY EASEMENTS" shown hereon will be indivisible and will be privately and collectively owned by the individuals whose lots they serve.
The easements are:
Between Lots 6 and 7, Block ONE, Serving Lots 8 and 9, Block ONE
Between Lots 1 and 4 and west of Lot 5, Block TWO, Providing service to Lots 1, 2, 3 and 4, Block TWO
Between Lots 6 and 9, Block TWO, Serving Lots 7 and 8, Block TWO.

TIJERAS ARROYO

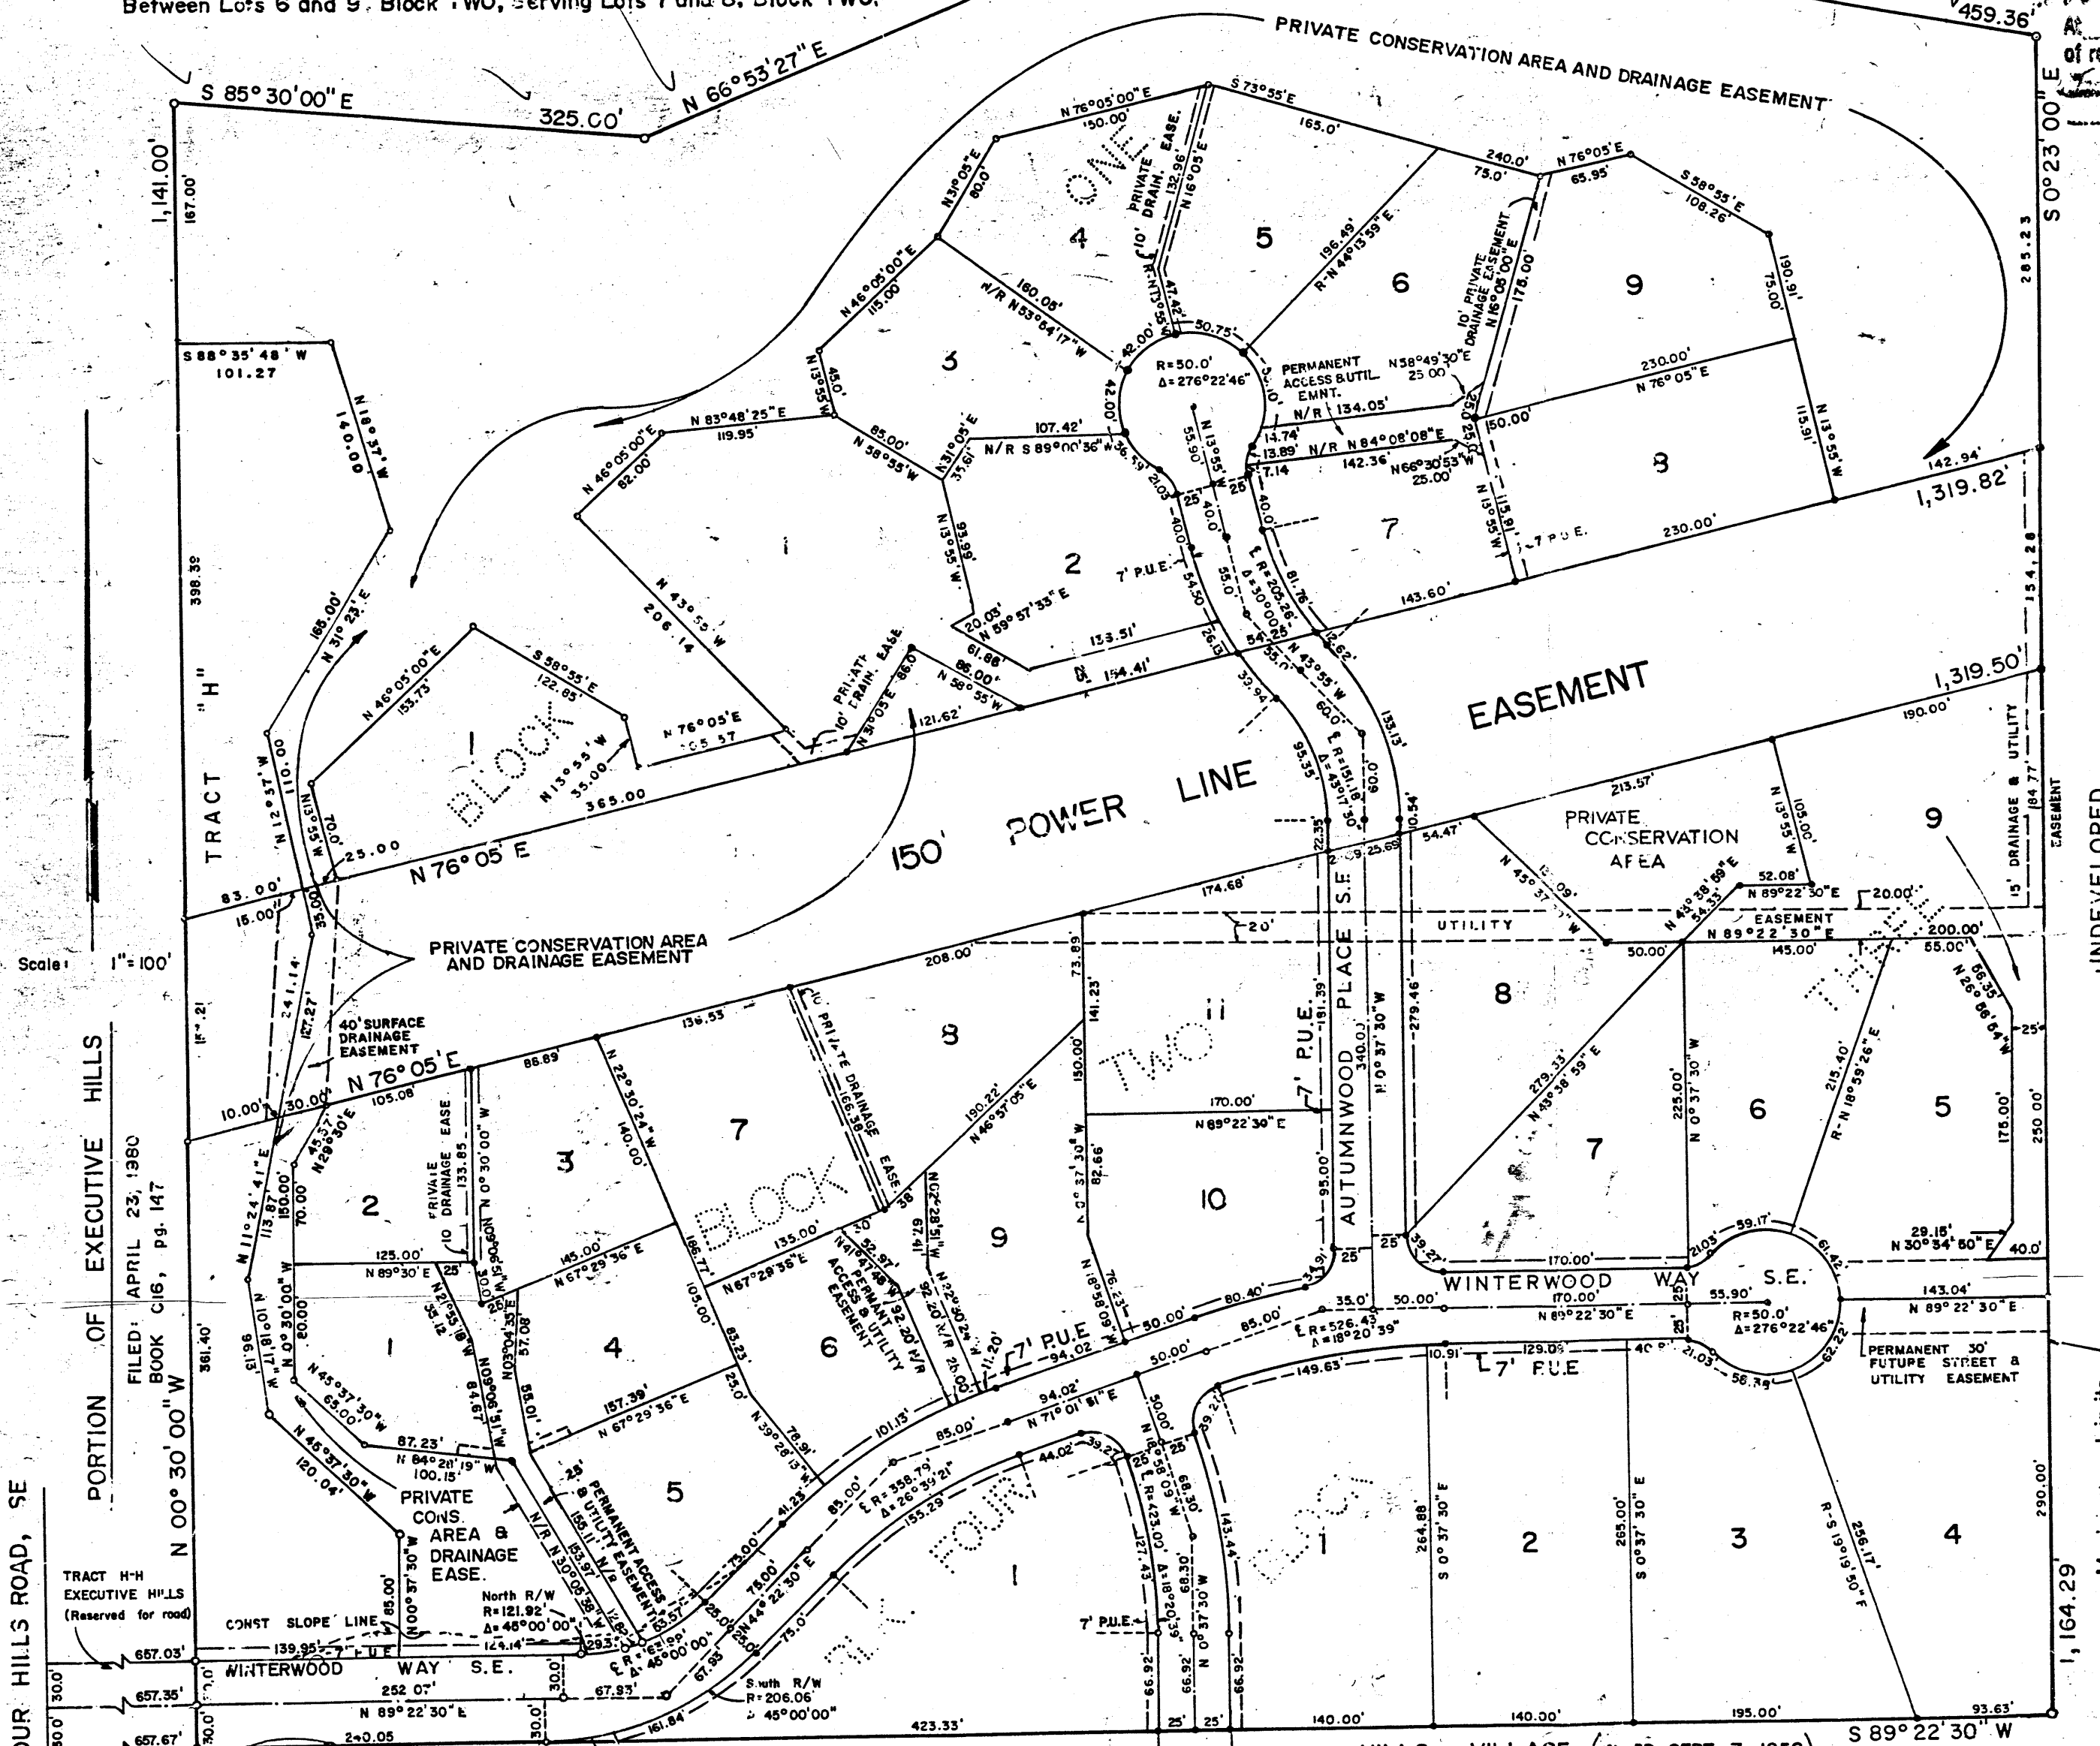


STATE COORDINATES
X = 427,400.21
Y = 1,475,163.00
Z = -0° 38' 21"

TIE TO ACS STA. "TOM"
GROUND DIST. = 2803.40
GRID DIST. = 2802.28
BEARING = 99° 53' 45"
FACTOR = 3675.27


BENCH MARK
16.423 A square on top of conc. curb
Located at int. of Warm Sands Dr. & Martingale Ln. S.E. in the S.W. quad. of N. 10° 46' 33" E. EV = 5755.01

NOTES:
1. All corner lot radii are 25' unless otherwise noted.
2. All dimensions along curved lines are measured along the arc.
3. Lot lines showing "R" are radial; those showing "N/R" are non-radial.
4. All distances shown are ground distances.
5. All easements shown are "WATER, SANITARY SEWER, & OTHER PUBLIC UTILITY EASEMENT."
6. No sewer to be constructed within the subdivision.
7. BEARINGS SHOWN WERE TAKEN FROM THE PLAT OF TOWN & COUNTRY VILLAGE, PREPARED BY J. W. BETTIS, L.S. & P.E. N.M. # 3441, FILED OCT. 10, 1979. For State Plane Grid System rotate all bearings clockwise 00° 20' 48".

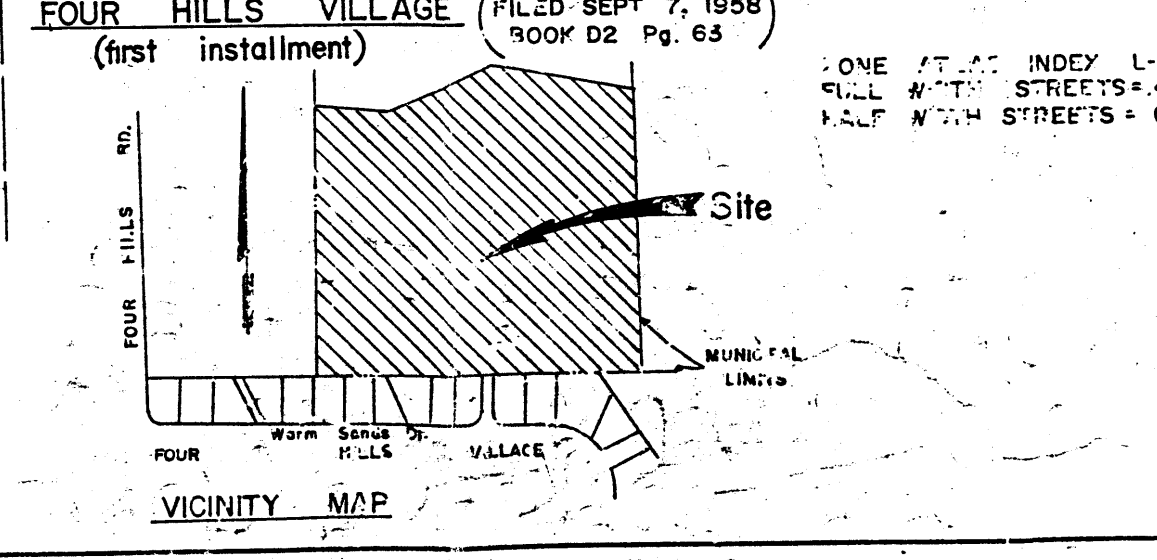


C17-33

C17-22

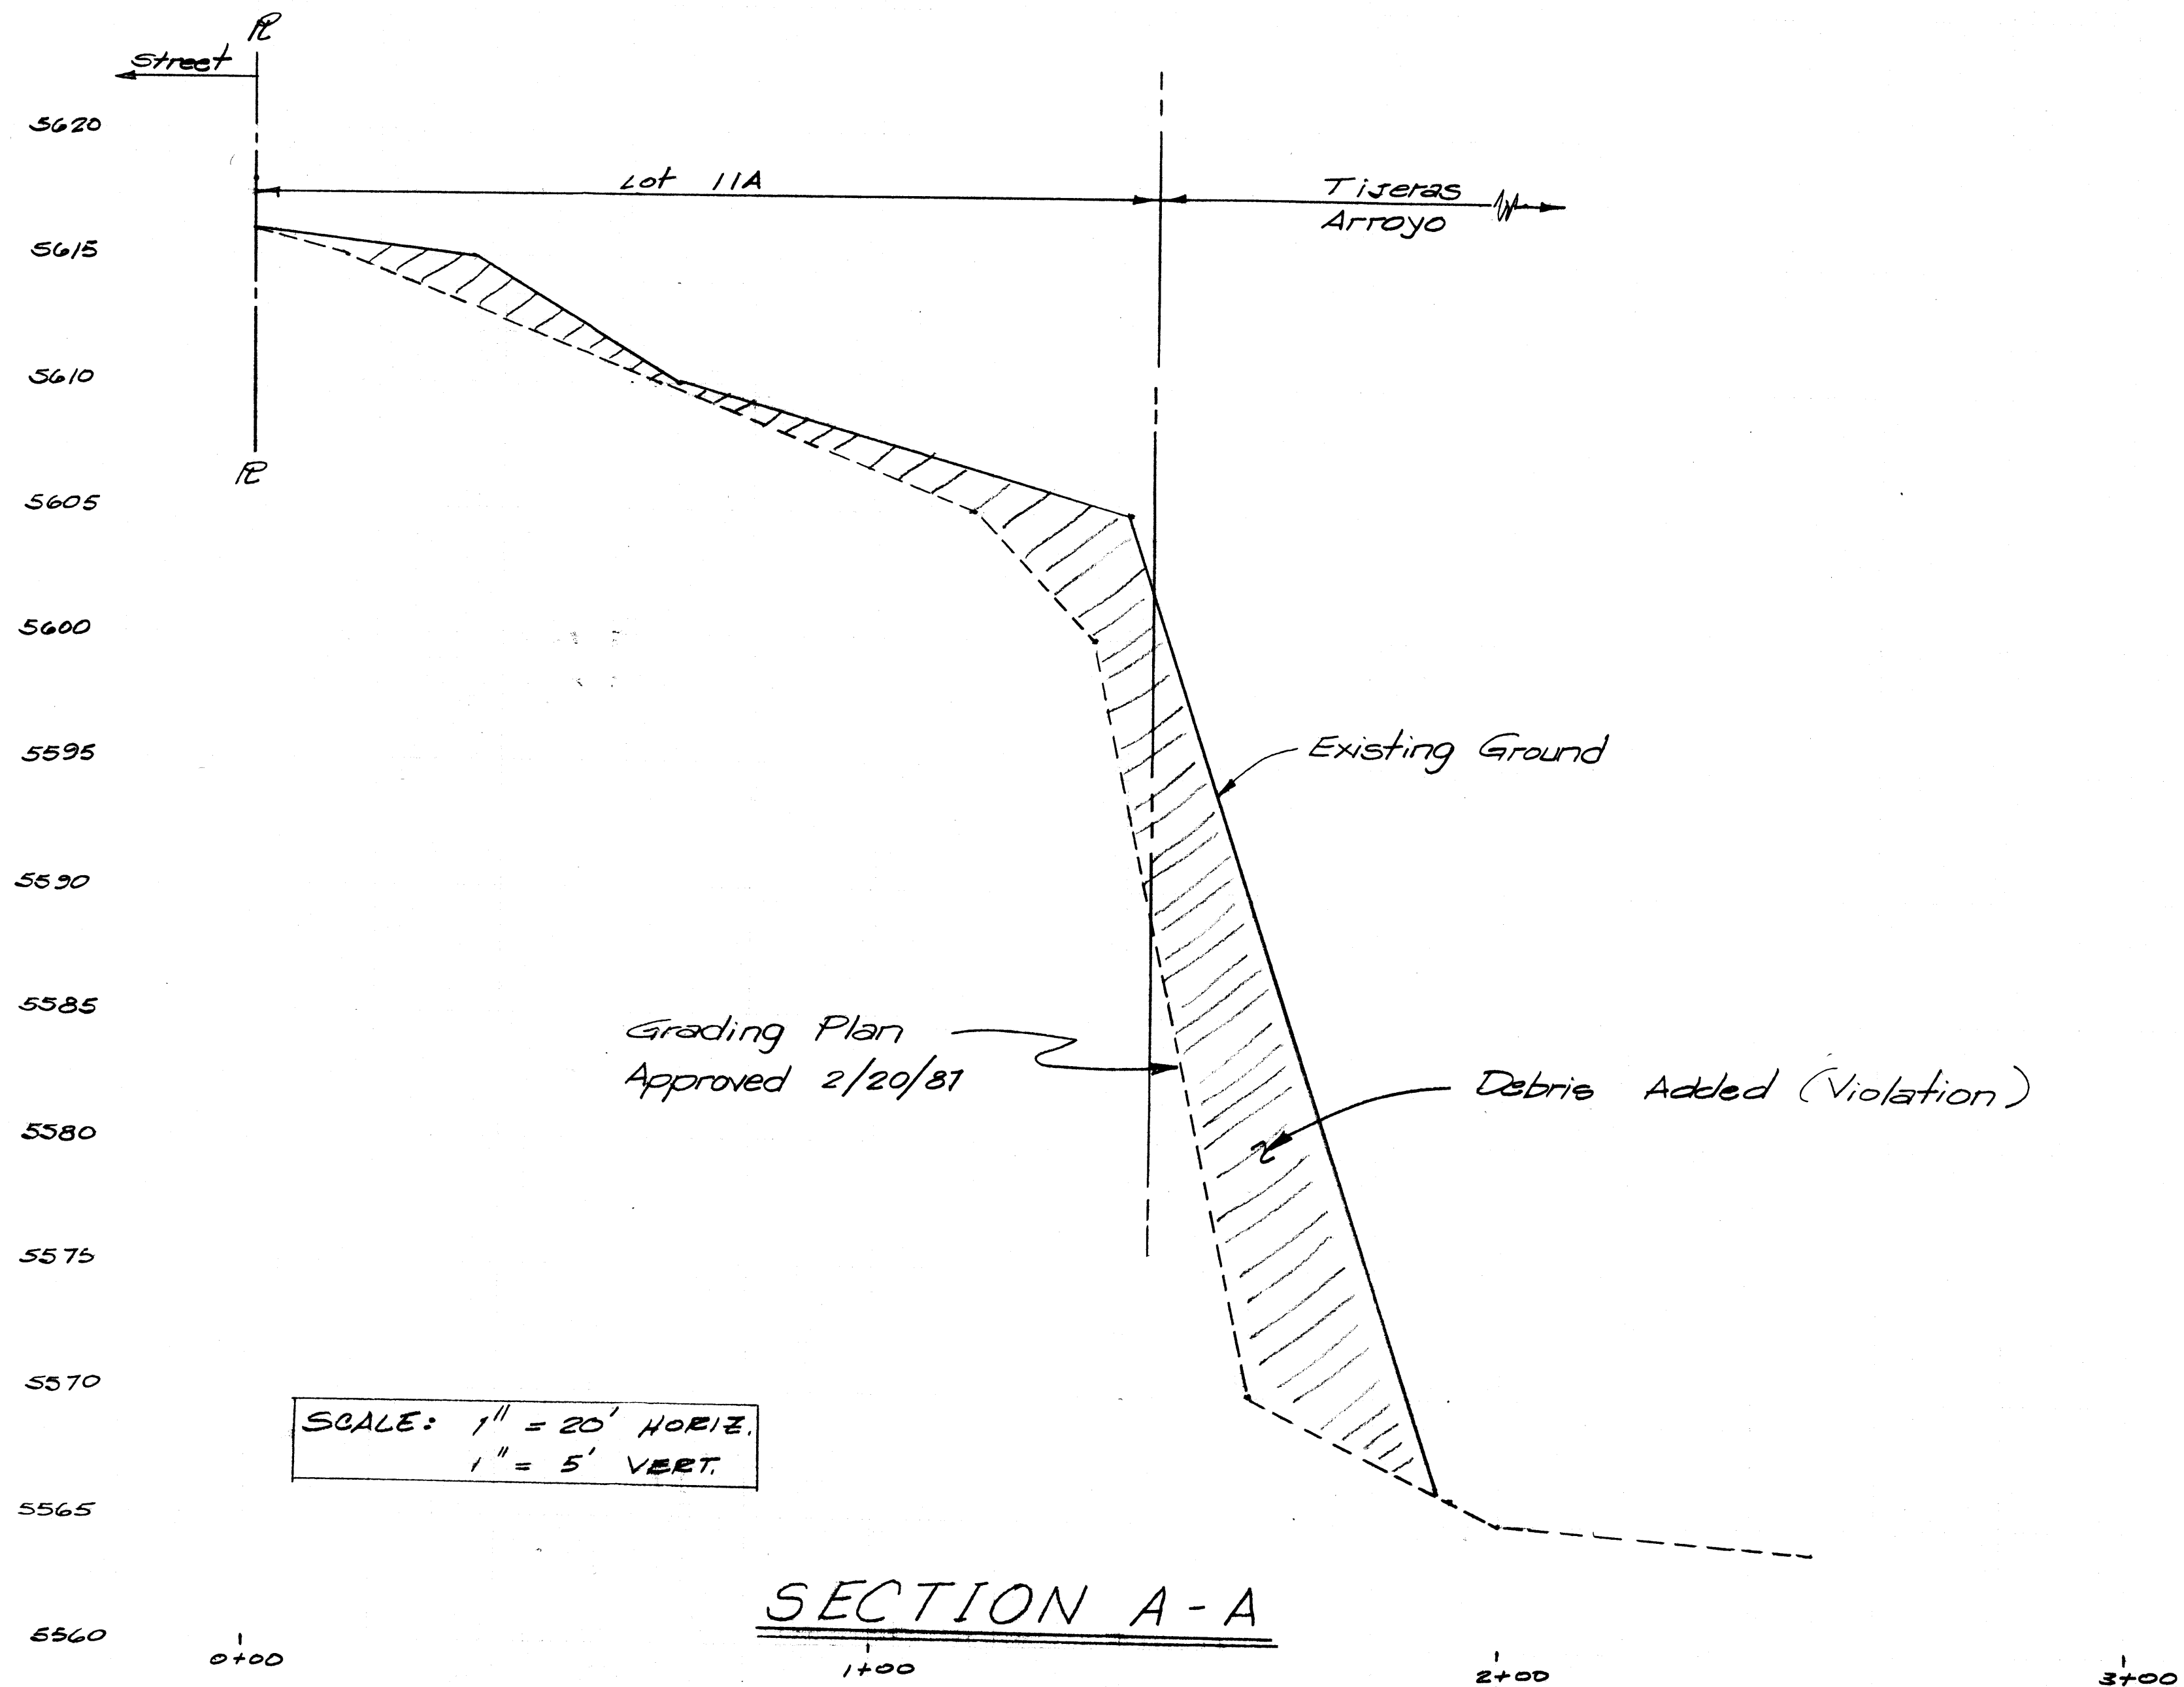

C 33-21 (2)

C 33-21 (2)

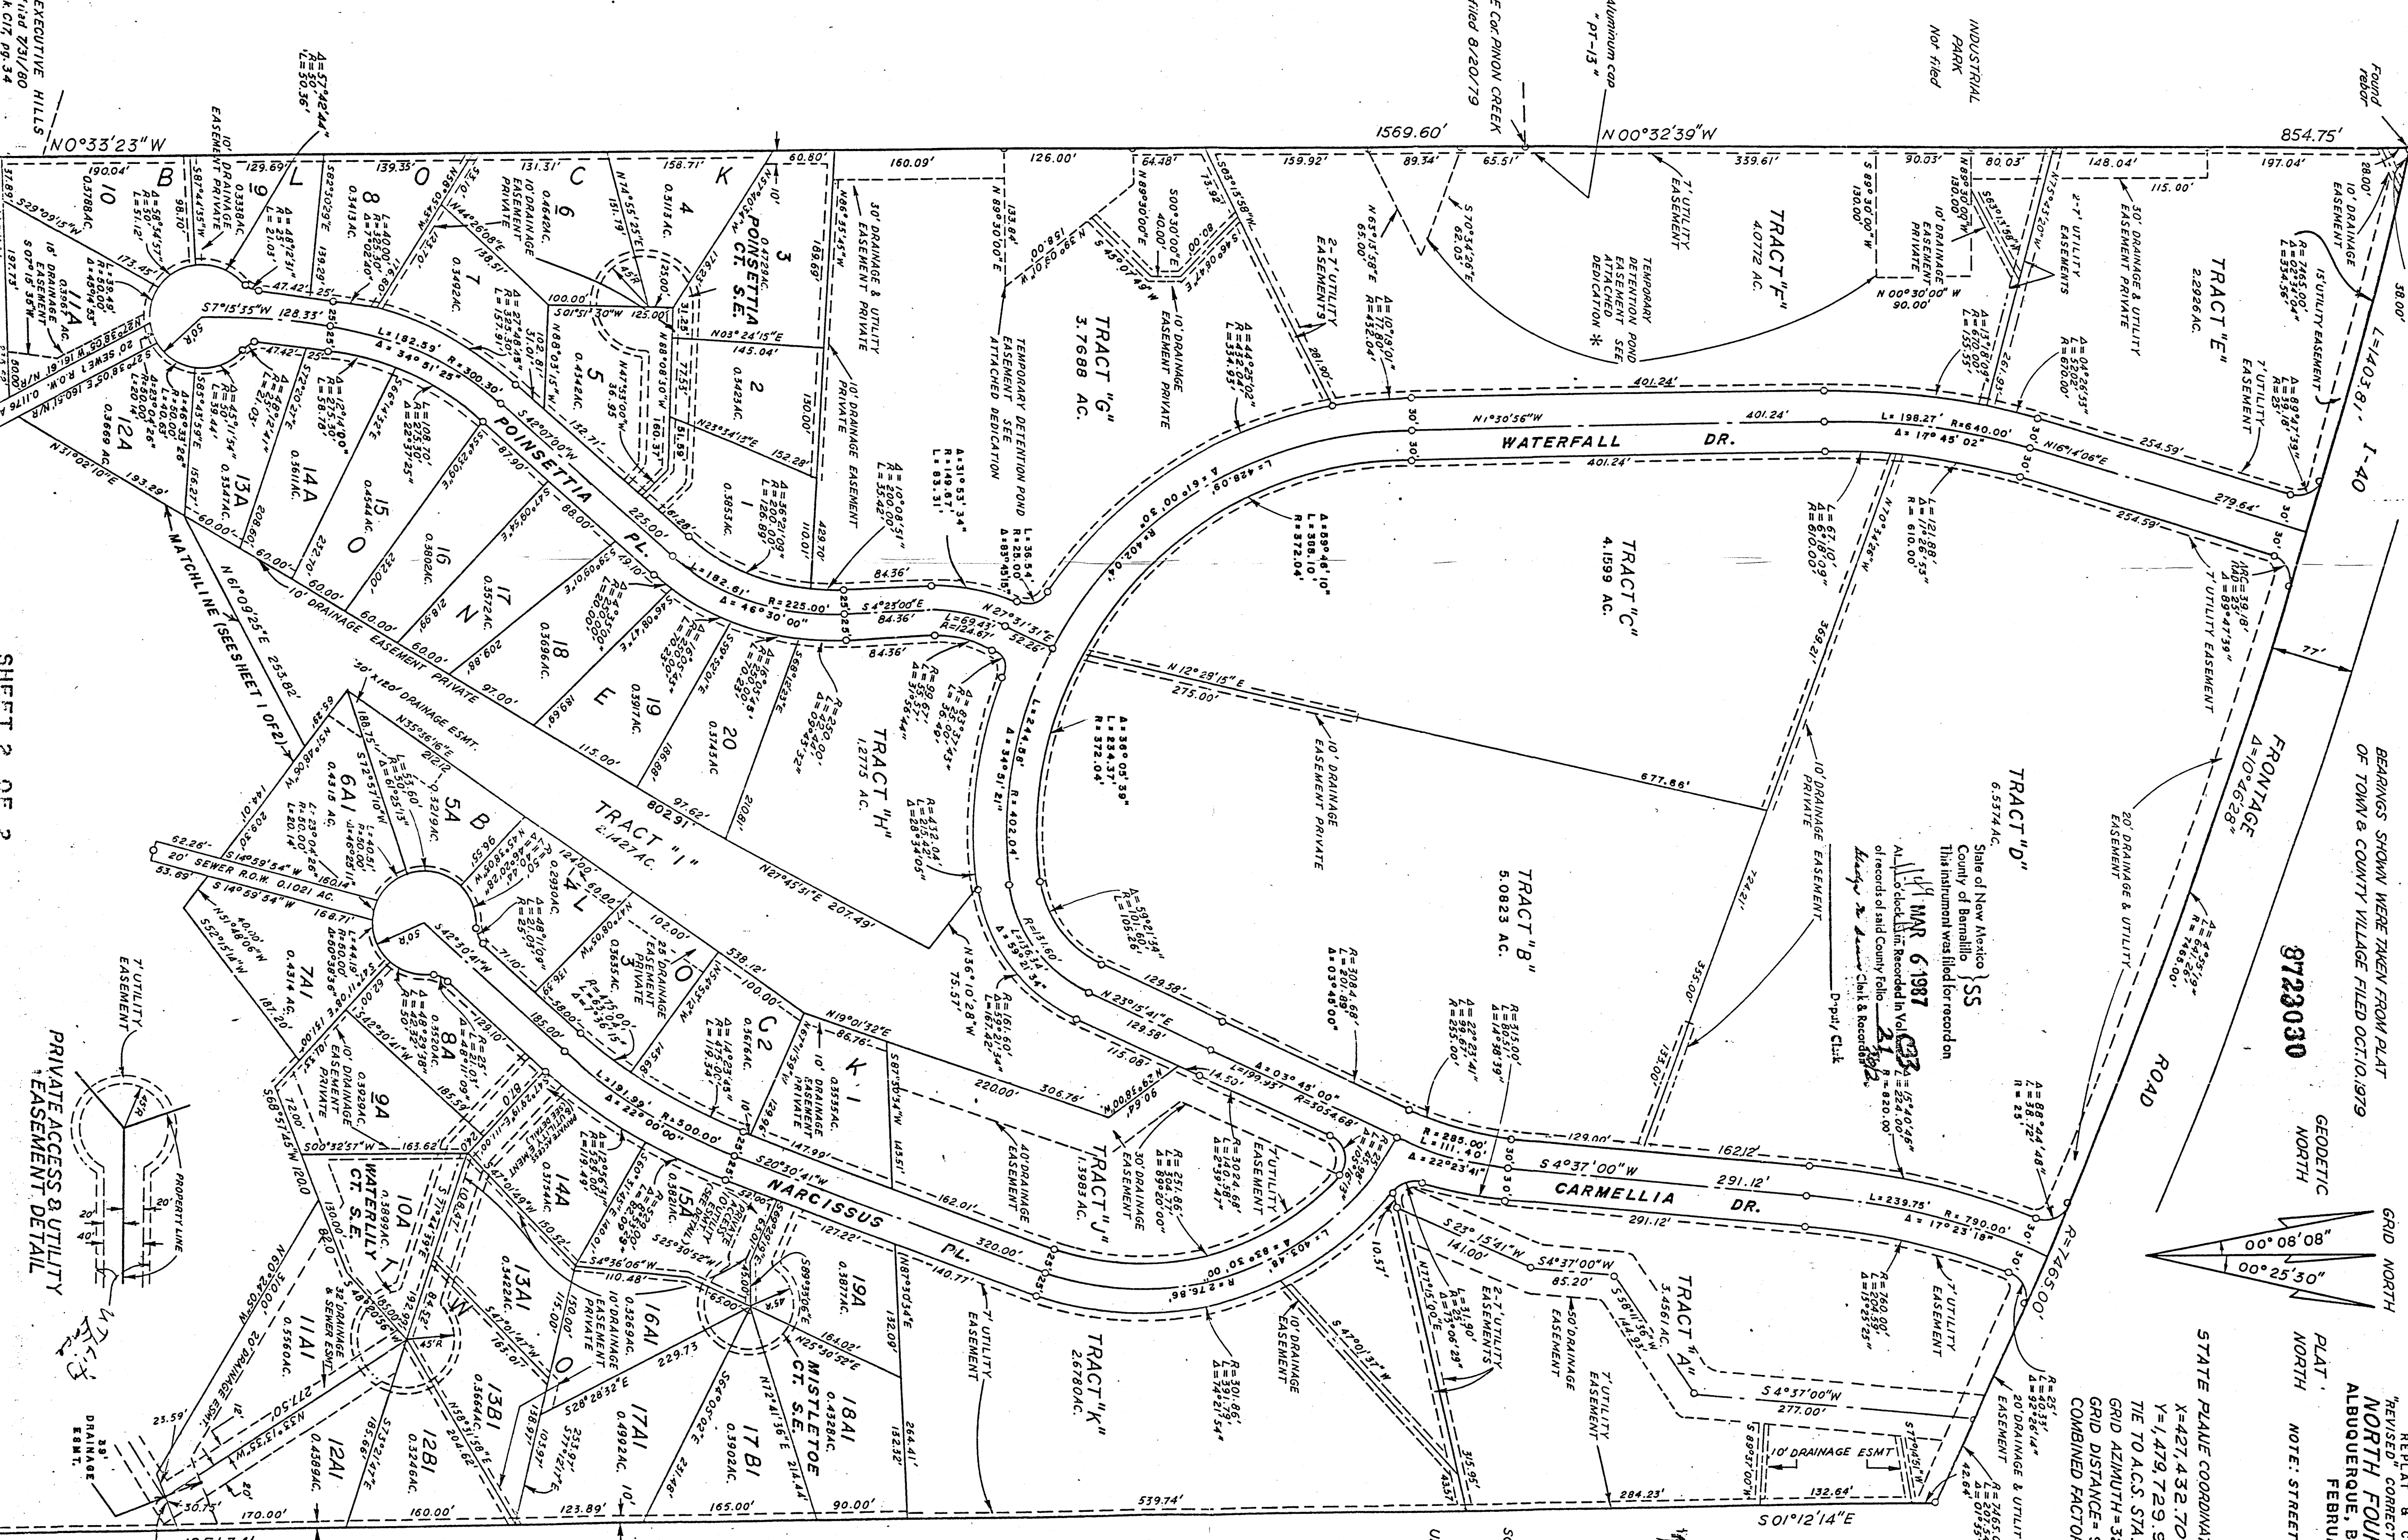

SHEET 2 OF 2


C 33-21 (2)

C 33-21 (2)


SURVEYOR'S CERTIFICATION
I, Dennis D. Lynn, a Registered Land Surveyor, licensed under the Laws of the State of New Mexico, do hereby certify that the plat shown hereon was prepared by me or under my supervision, shows all easements of record, and that the plat and survey meet the minimum requirements of the standards for the land surveys in New Mexico as adopted by the New Mexico State Board of Registration for Professional Engineers and Land Surveyors, and the Albuquerque Subdivision Ordinance, and is true and correct to the best of my knowledge and belief.
Dennis D. Lynn, S.B.S. #7430


State of New Mexico) County of Valencia)
The foregoing instrument was acknowledged before me on this 4TH day of MAR, 1986, by Dennis D. Lynn.
My comm expires 02/24/88
Richard J. Truesdale
Notary Public

REPLAT & CORRECTION PLAT OF NORTH FOUR HILLS SUBD ALBUQUERQUE, BERNALILLO CO., NM FEBRUARY, 1986
NOTE: STREET NAMES WERE CHANGED.
STATE PLANE COORDINATES OF NW COR. SUB
X=427,432.70 CENTRAL ZONE
Y=1,479,729.94
TIE TO A.C.S. STA. "TOM" - NW CORNER
GRID AZIMUTH=326°51'45"
GRID DISTANCE=972.19'
COMBINED FACTOR=0.99964602


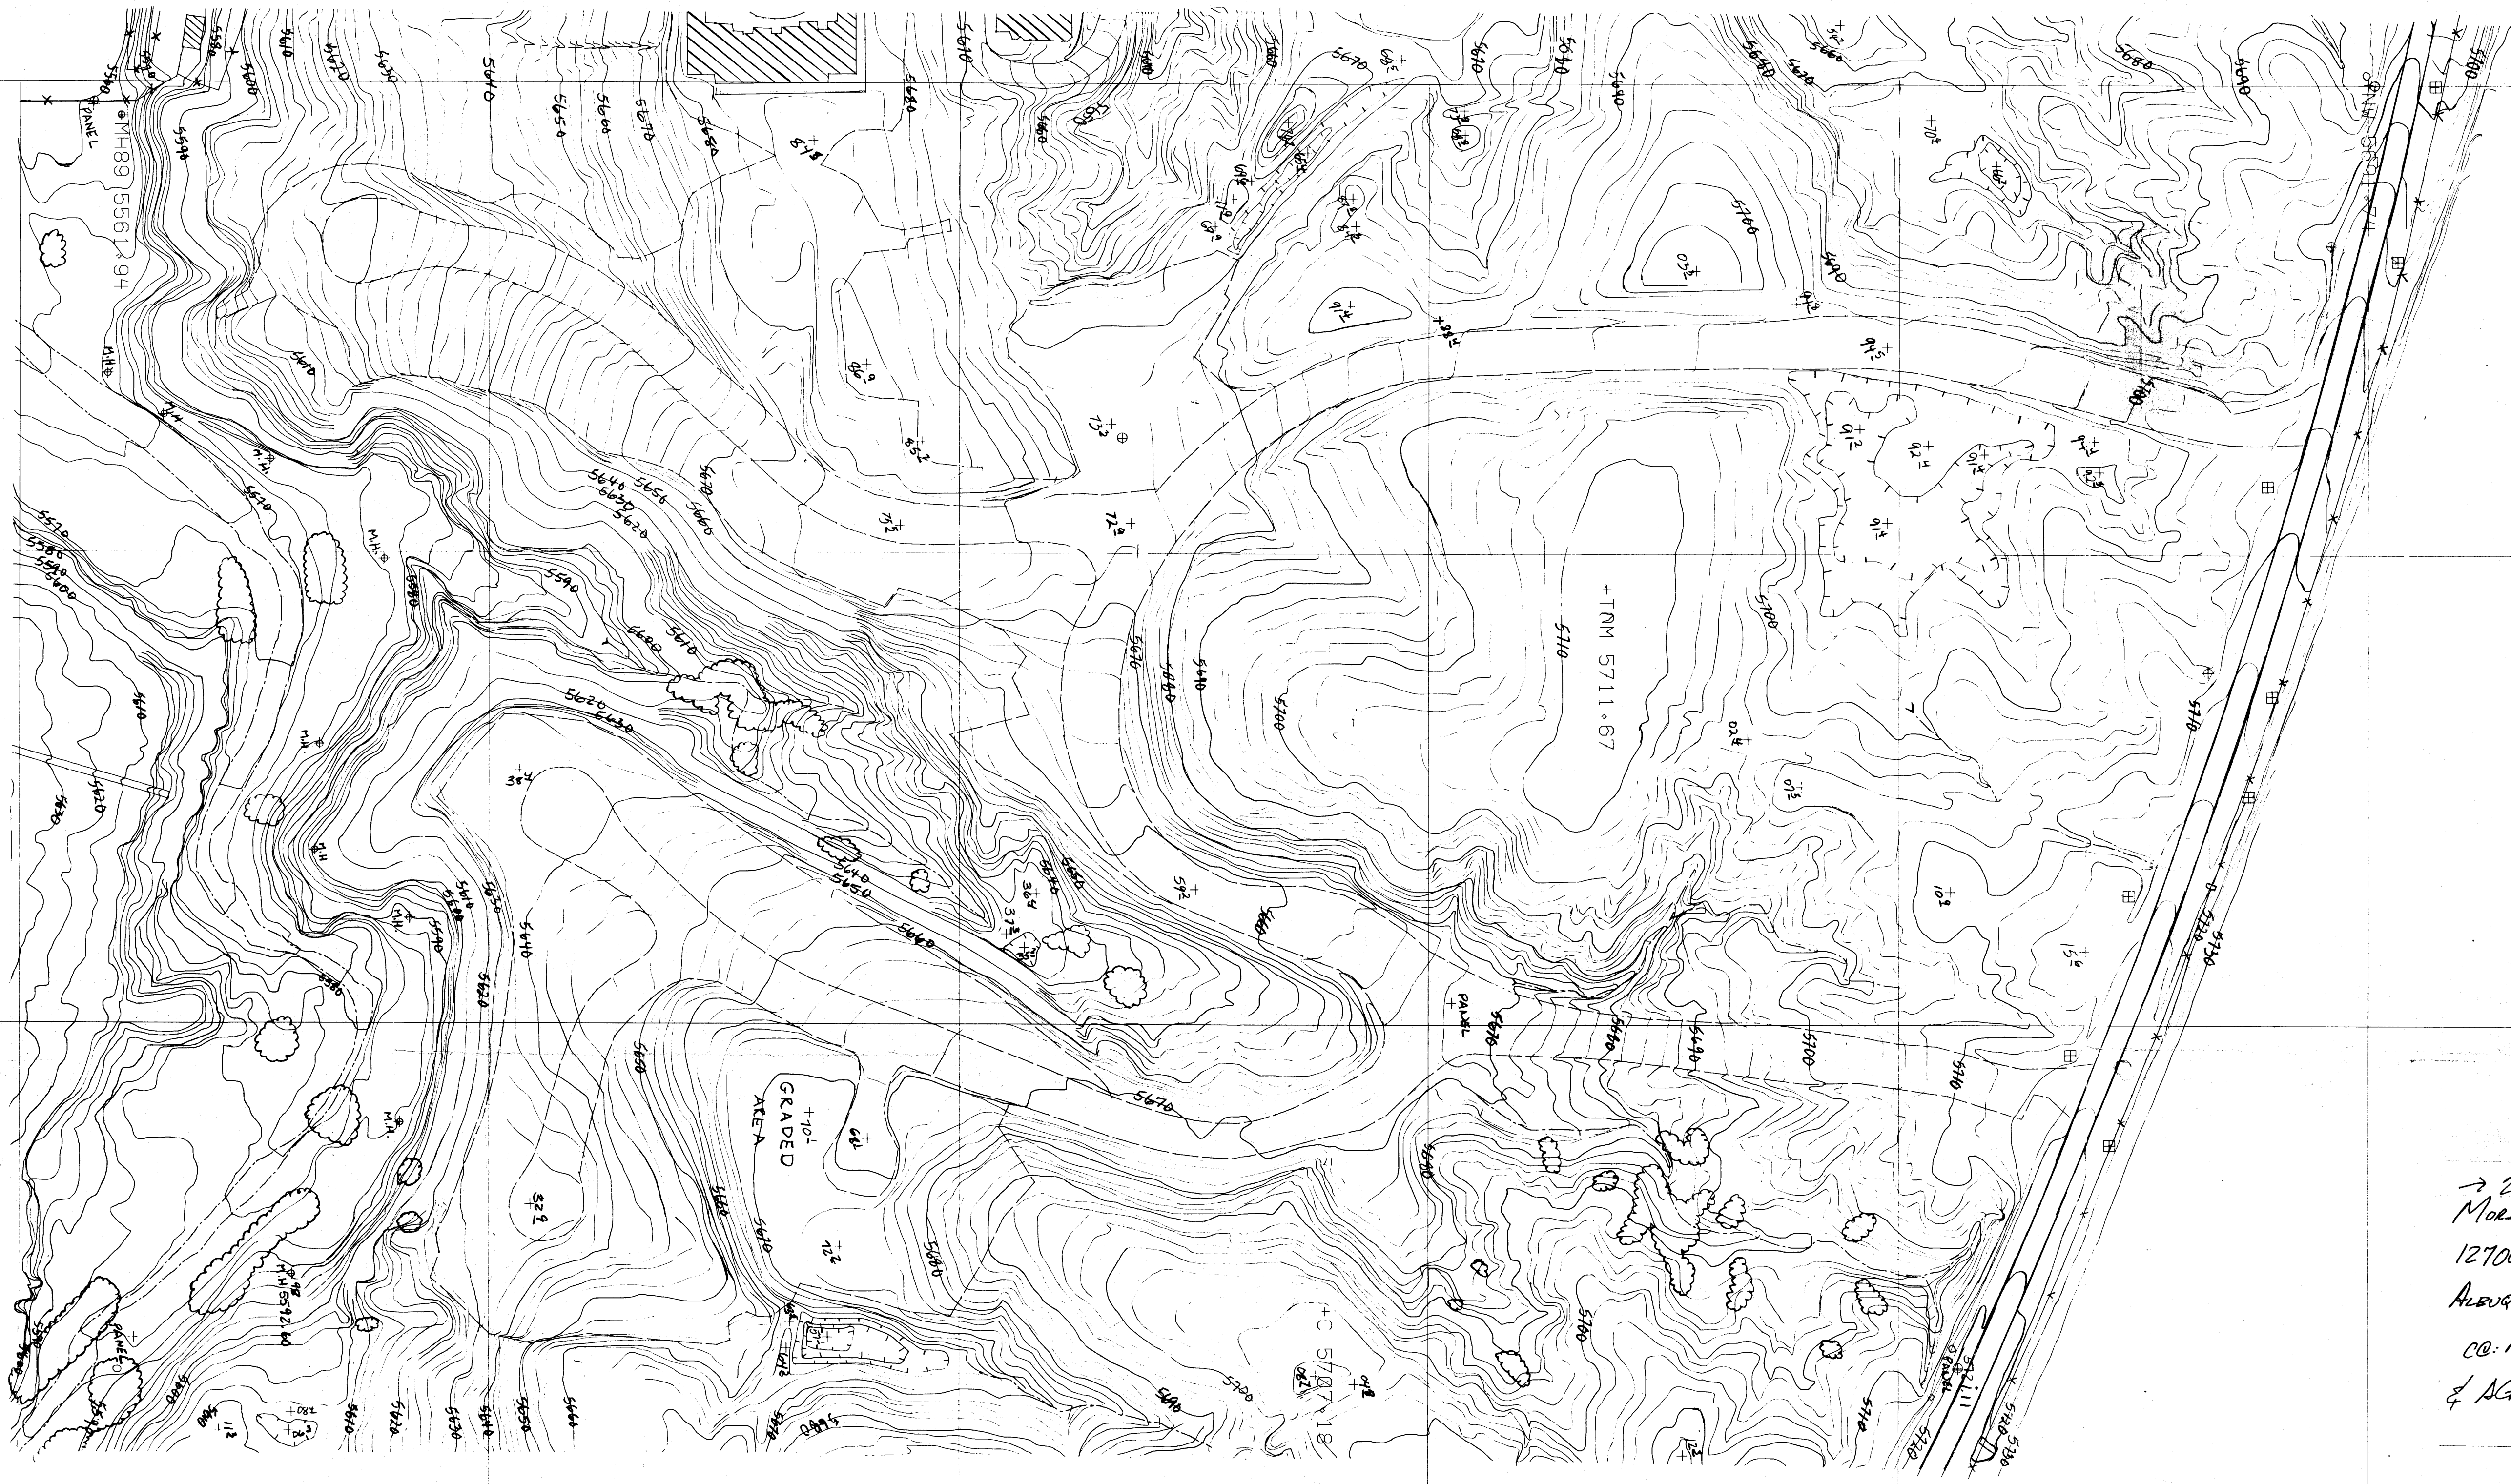


→ 294-204B
MORE SAFARI
12700 #SAN RAFAEL NE
ALBUQ. NM
CO: Mickey Pitschke
& AGP


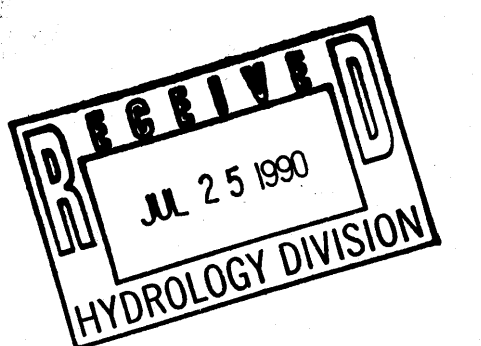


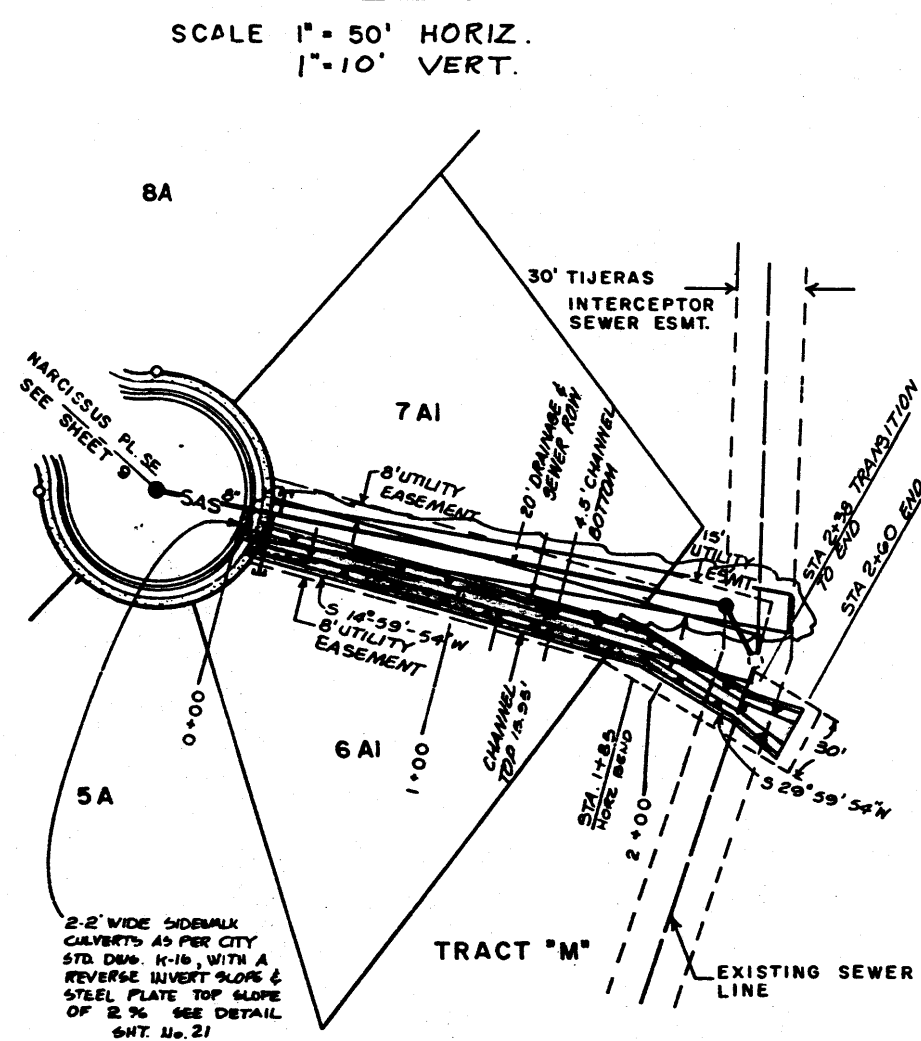


NARCISSUS PLACE S.E.

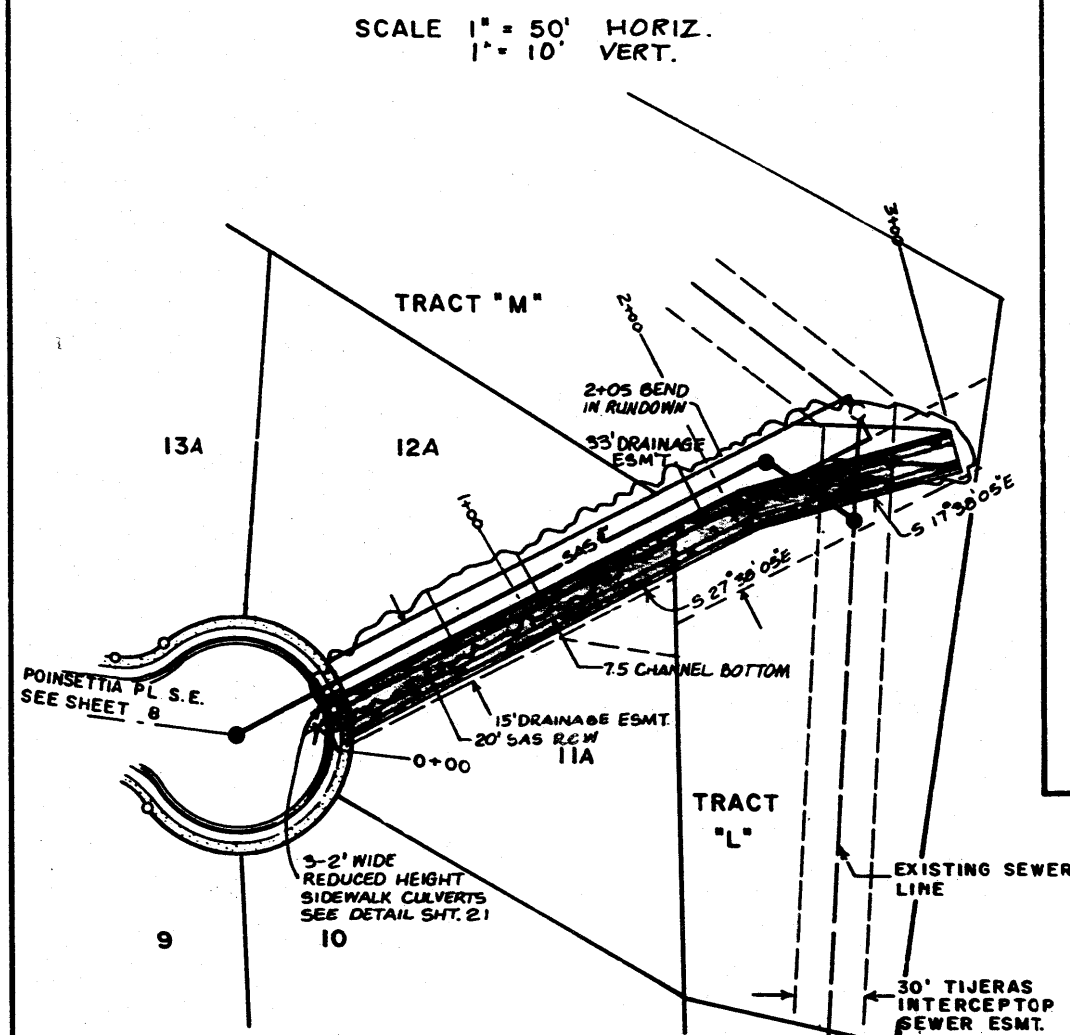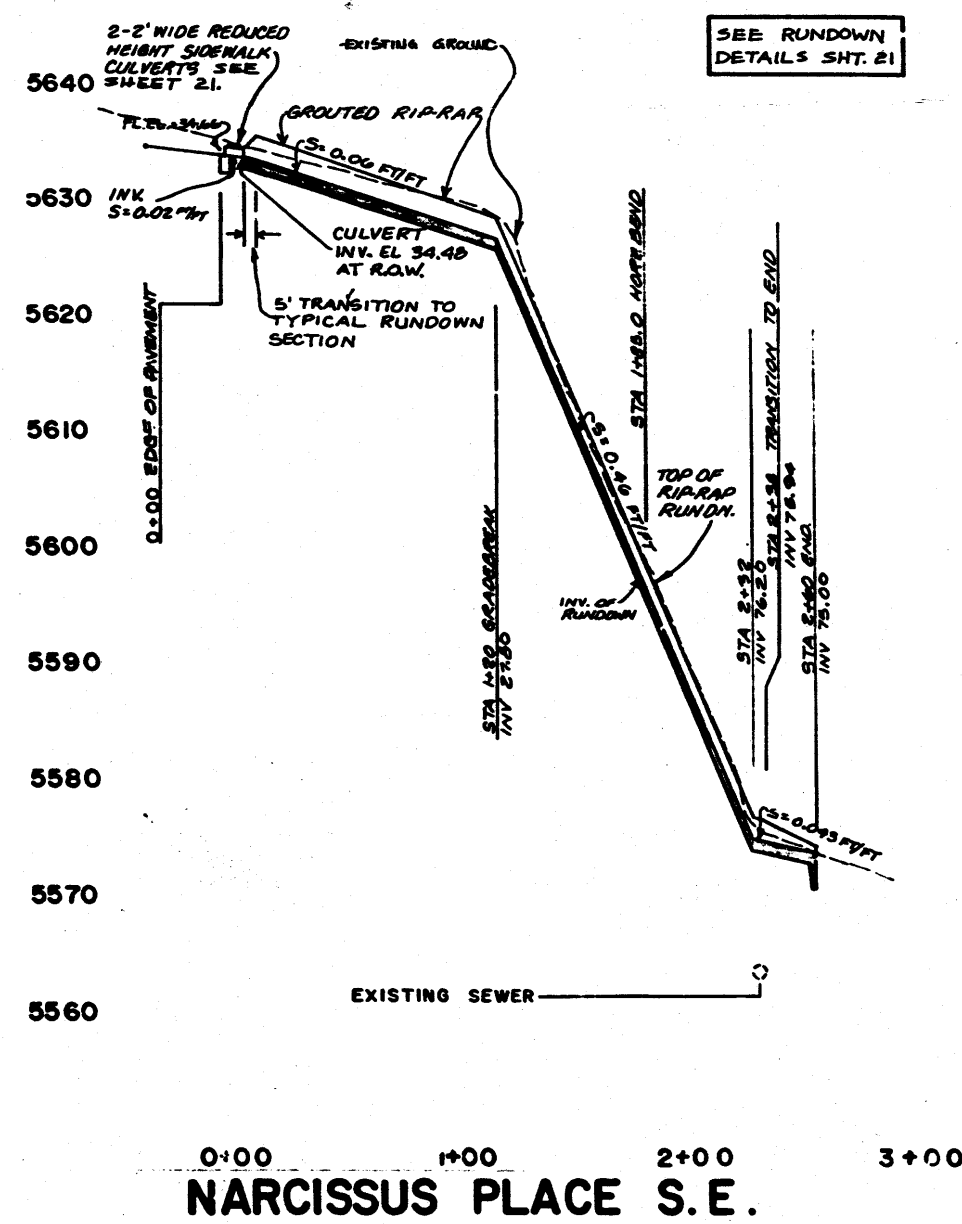

POINSETTIA PLACE S.E.

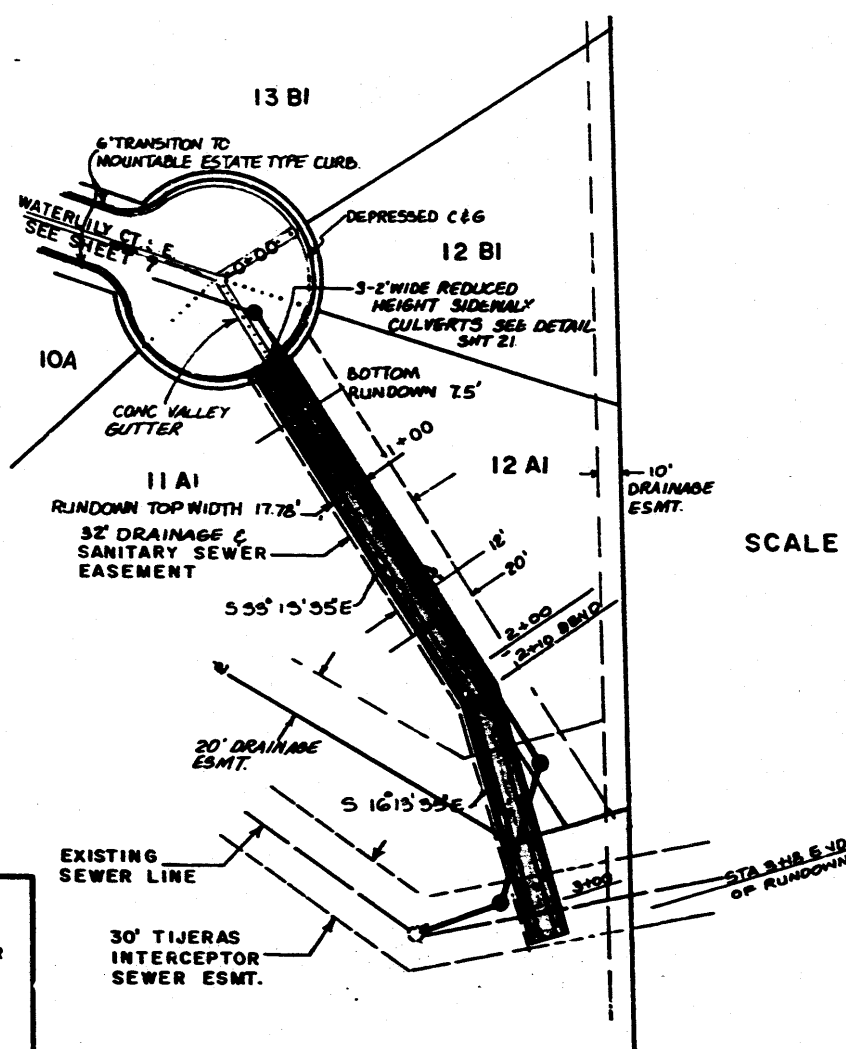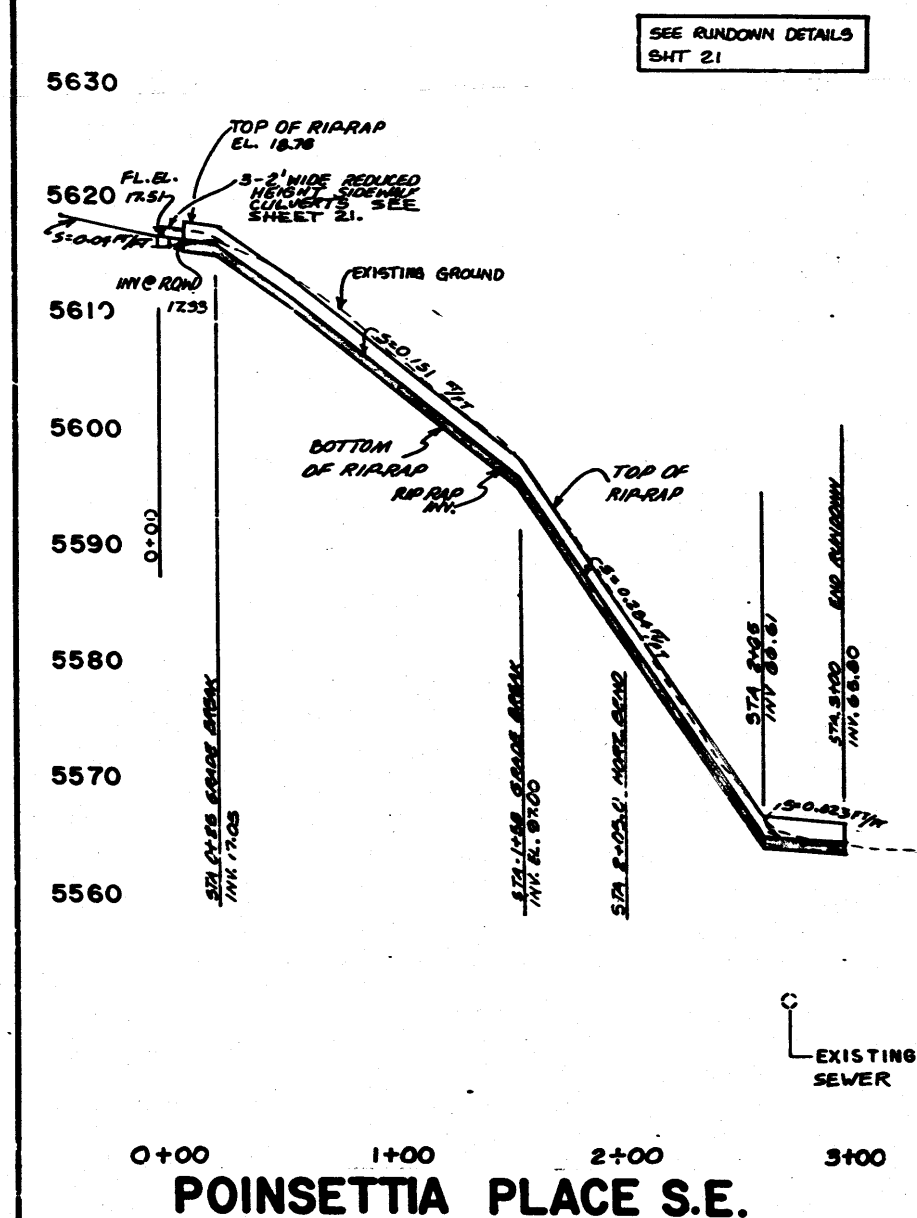

WATERLILY COURT S.E.

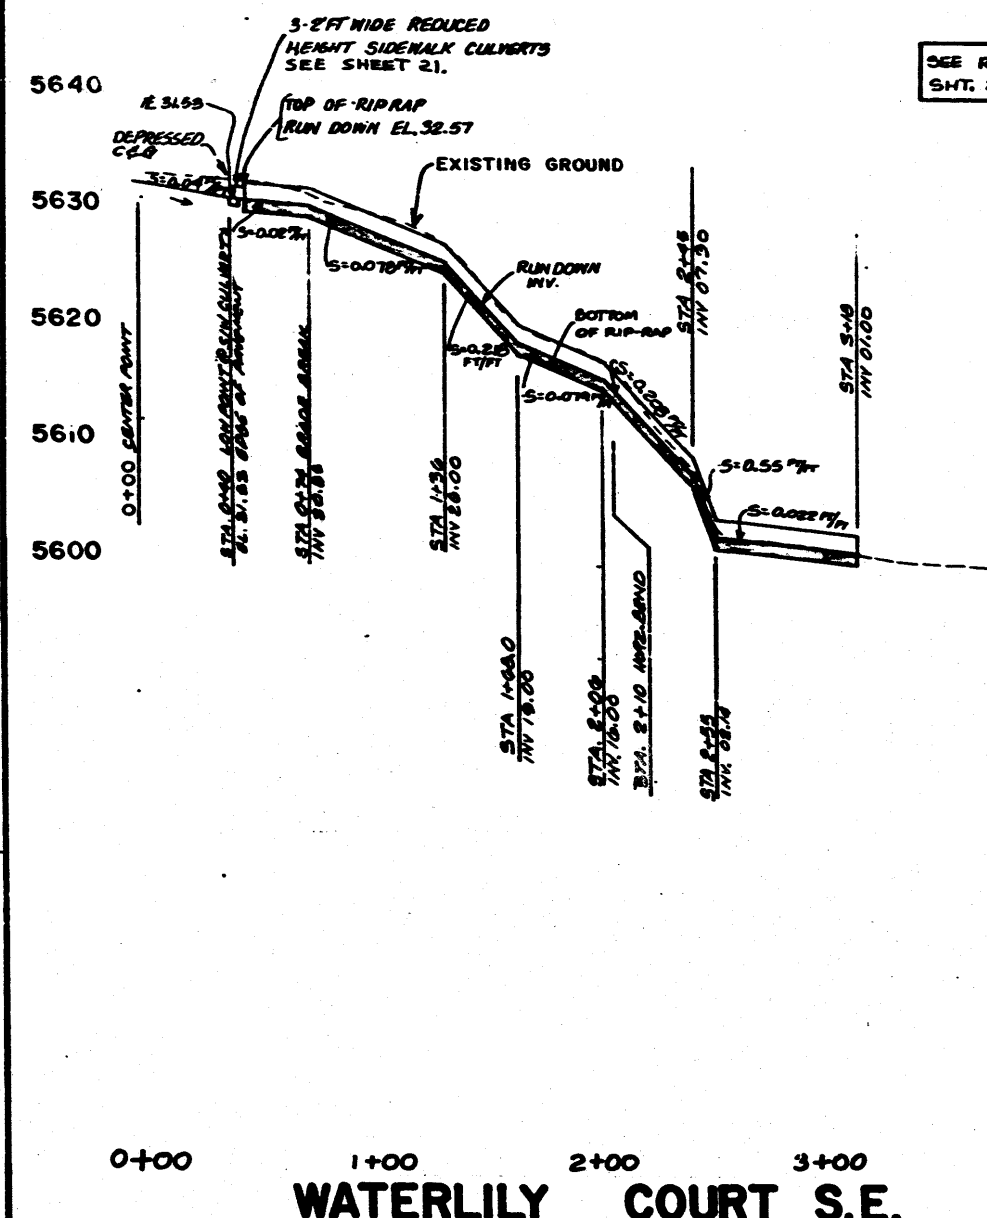

LEGEND	
[Symbol]	TRANSITION AREA
[Symbol]	CATCH BASIN
[Symbol]	STORM DRAIN LINE
[Symbol]	PROPOSED STORM DRAIN MANHOLE
[Symbol]	TOP OF CURB ELEVATION

NOTES:
1. SEE SHEET 17 FOR
SANITARY SEWER PLAN &
PROFILES

CONTROL: 10M, APPROX. 712' SOUTH
OF E. OF 1-10 HIGHWAY AND
AND APPROX. 230' EAST OF E. OF
ROSEWOOD PLACE, SE AT APPROX.
STA. 7+76 STANDARD A.C.S. BRASS
CAP STAMPED "10M".

EL. 5711.67

RECORD DRAWING
The improvements shown on this drawing have been
as-built in accordance with field information
provided by B. Mark Goodwin and Associates, P.A., and
by RMB Construction Company (Contractor) to reflect
construction actually accomplished to the best of
my knowledge and belief.
Mark Goodwin, P.E. 8548 Date 4/24/89



NORTH FOUR HILLS SUBDIVISION
NARCISSUS PL. POINSETTIA PL. & WATERLILY CT.
RUNDOWN PLAN & PROFILE

2565 L-23 10 22