CITY OF ALBUQUERQUE

Planning Department
Brennon Williams, Director



August 18, 2020

David Soule, P.E. Rio Grande Engineering P.O. Box 93924 Albuquerque, NM 87199

RE: 13727 Covered Wagon Ave. SE

Request for Permanent C.O. – Accepted Engineer's Certification Date: 07/26/20 Engineer's Stamp Date: 01/17/20 Hydrology File: L23D014E

Dear Mr. Soule:

PO Box 1293 Based on the Certification received 08/14/20, this certification is approved in support of

Permanent Release of Occupancy by Hydrology.

Albuquerque If you have any questions, please contact me at 924-3995 or rbrissette@cabq.gov.

NM 87103 Sincerely,
Ronée C. Brisselle

www.cabq.gov Renée C. Brissette, P.E. CFM

Senior Engineer, Hydrology

Planning Department



City of Albuquerque

Planning Department

Development & Building Services Division

DRAINAGE AND TRANSPORTATION INFORMATION SHEET (REV 6/2018)

Project Title: 13727 COVERED W	tle: 13727 COVERED WAGON Building Permit #:			logy File #:
DRB#:	EPC#·		Work	Order#:
Legal Description: LOT 2 COVE	RED WAGON SUBI	DIVISION	1	
City Address: 13727 COVERED	WAGON		10 - 10 - 10 - 10 - 10 - 10 - 10 - 10 -	
Applicant:			Contact:	
Address:				
Phone#:				
Other Contact: RIO GRANDE ENGINEERING				
Address: PO BOX 93924 ALB			Contact.	
Phone#: 505.321.9099	Fax#: 505.872.0999		E-mail:	david@riograndeengineering.com
TYPE OF DEVELOPMENT:P				
Check all that Apply:		-		
DEPARTMENT: X HYDROLOGY/ DRAINAGE TRAFFIC/ TRANSPORTATION TYPE OF SUBMITTAL: X ENGINEER/ARCHITECT CERTIFIC. PAD CERTIFICATION CONCEPTUAL G & D PLAN SRADING PLAN DRAINAGE REPORT DRAINAGE MASTER PLAN FLOODPLAIN DEVELOPMENT PER ELEVATION CERTIFICATE CLOMR/LOMR TRAFFIC CIRCULATION LAYOUT TRAFFIC IMPACT STUDY (TIS) STREET LIGHT LAYOUT OTHER (SPECIFY) PRE-DESIGN MEETING? IS THIS A RESUBMITTAL?: X Yes DATE SUBMITTED:	MIT APPLIC (TCL) No	BUIL X CERT PREL SITE SITE FINA SIA/ I FOUN GRAI SO-19 PAVE X GRAI WORI CLON FLOO OTHE	DING PERMIT APPITIFICATE OF OCCU IMINARY PLAT AF PLAN FOR SUB'D PLAN FOR BLDG. I L PLAT APPROVA RELEASE OF FINAN IDATION PERMIT APPITION PERMIT APPROVATION PAD CERTIFICATION PERMITION	PPROVAL APPROVAL PERMIT APPROVAL L NCIAL GUARANTEE APPROVAL ROVAL DVAL DICATION L MENT PERMIT
DATE SUBMITTED.	* ''		* *************************************	and and the second seco
COA STAFF:	ELECTRONIC SUE	BMITTAL RECI	EIVED:	-


FEE PAID:_____

THIS SITE IS PART OF THE COVERED WAGON MASTER DRAINAGE PLAN (L23D14). THIS SITE IS ALLOWED FREE DISCHARGE.

I, DAVID SOULE HAVE PERSONALLY INPECTED THE SITE. I HEREBY
CERTIFY THE PAD HAS BEEN CONSTRUCTED SUCH THAT IT IS IN
SUBSTANTIAL CONFORMANCE TO THE APPROVED GRADING PLAN DATED 1/17/20



I <u>David Soule</u>, NMPE 14522, of the firm <u>Rio Grande Engineering</u>, hereby certify that this project has been graded and will drain in substantial compliance with and in accordance with the design intend of the approved plan dated <u>1/17/20</u>. The record information edited on the original design document has performed by me or under my direct supervision and is true and correct to the best of my knowledge and belief. The asbuilt survey was provided by THOMAS PATRICK NMPS 12651. The certification is submitted in support of a request for <u>PERMANENT CERTIFICATE OF OCCUPANCY</u>. The record information presented heron is not necessarily complete and intended only to verify substantial compliance of the grading and drainage aspects of this project. Those relying on this record document are advised to obtain independent verification of its accuracy before using it for any other purpose

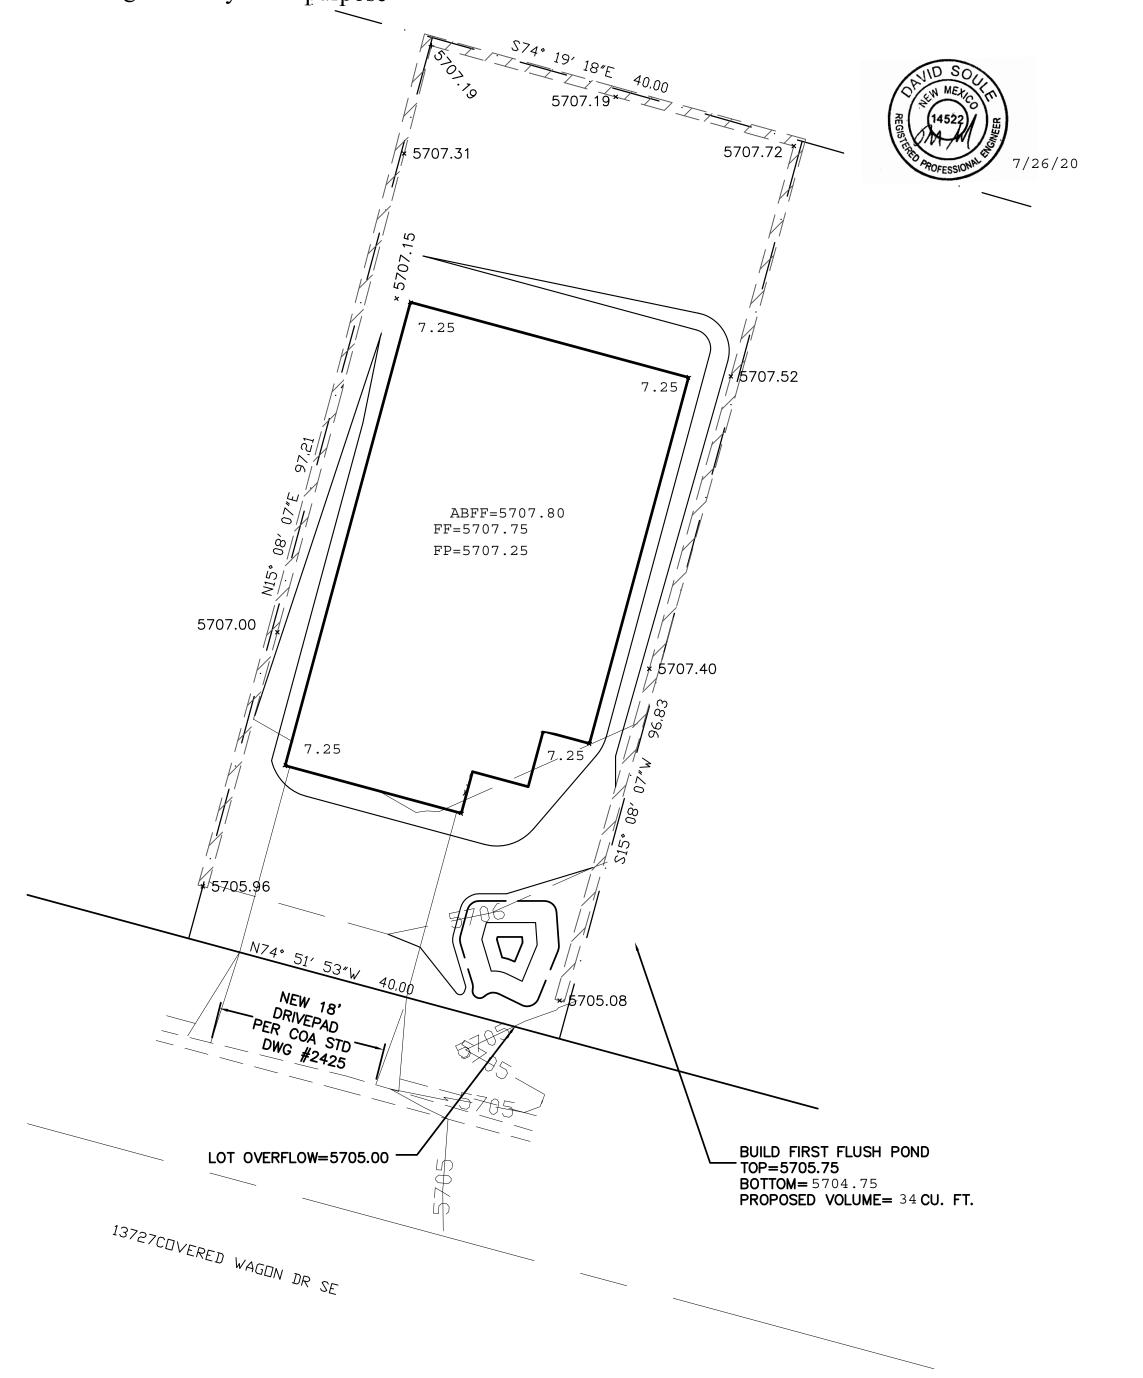

CAUTION:

EXISTING UTILITIES ARE NOT SHOWN.

IT SHALL BE THE SOLE RESPONSIBILITY

OF THE CONTRACTOR TO CONDUCT ALL

NECESSARY FIELD INVESTIGATIONS PRIOR


TO ANY EXCAVATION TO DETERMINE THE


ACTUAL LOCATION OF UTILITIES & OTHER

IMPROVEMENTS.

EROSION CONTROL NOTES:

- 1. CONTRACTOR IS RESPONSIBLE FOR OBTAINING A TOPSOIL DISTURBANCE PERMIT PRIOR TO BEGINNING WORK.
- 2. CONTRACTOR IS RESPONSIBLE FOR MAINTAINING RUN-OFF ON SITE DURING CONSTRUCTION.
- 3. CONTRACTOR IS RESPONSIBLE FOR CLEANING ALL SEDIMENT THAT GETS INTO EXISTING RIGHT-OF-WAY.
- 4. REPAIR OF DAMAGED FACILITIES AND CLEANUP OF SEDIMENT ACCUMULATIONS ON ADJACENT PROPERTIES AND IN PUBLIC FACILITIES IS THE RESPONSIBILITY OF THE CONTRACTOR.
- 5. ALL EXPOSED EARTH SURFACES MUST BE PROTECTED FROM WIND AND WATER EROSION PRIOR TO FINAL ACCEPTANCE OF ANY PROJECT.

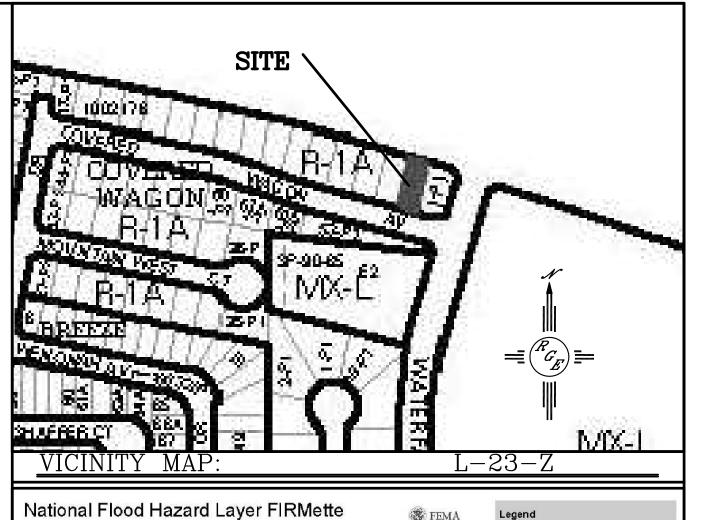

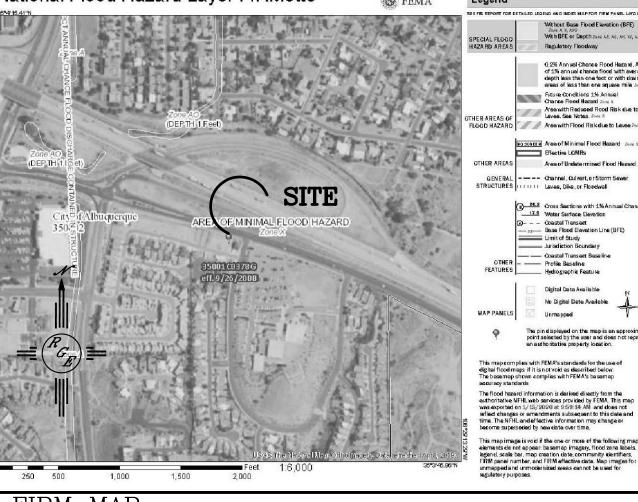

LEGAL DESCRIPTION:
LOT 2-P1, COVERED WAGON

NOTES:

1. ALL SPOT ELEVATIONS REPRESENT FLOWLINE ELEVATION UNLESS OTHERWISE NOTED.

2. ALL SLOPES SHALL BE 3:1 MAX. AND GRAVEL OR NATIVE SEEDING PRIOR TO CO.

LEGEND

EXISTING CONTOUR

EXISTING INDEX CONTOUR

PROPOSED CONTOUR

PROPOSED INDEX CONTOUR

SLOPE TIE

EXISTING SPOT ELEVATION

PROPOSED SPOT ELEVATION

PROPOSED SPOT ELEVATION

BOUNDARY


CENTERLINE

RIGHT-OF-WAY

EXISTING CURB AND GUTTER

EXISTING CMU SCREEN WALL



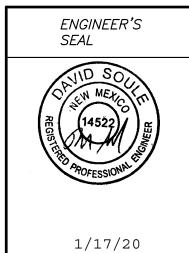

DAVID SOULE P.E. #14522 13727
COVERED WAGON
GRADING AND
DRAINAGE PLAN

Rio Congina 1606 CENTRAL SUITE SUITE

Rio Grande
Ingineering

1606 CENTRAL AVENUE SE
SUITE 201

ALBUQUERQUE, NM 87106
(505) 872-0999

DRAWN BY _{WCWJ}

> *DATE* 1–17–20

2102007-LAYOUT-1-17-20

SHEET #

JOB #

2102007