


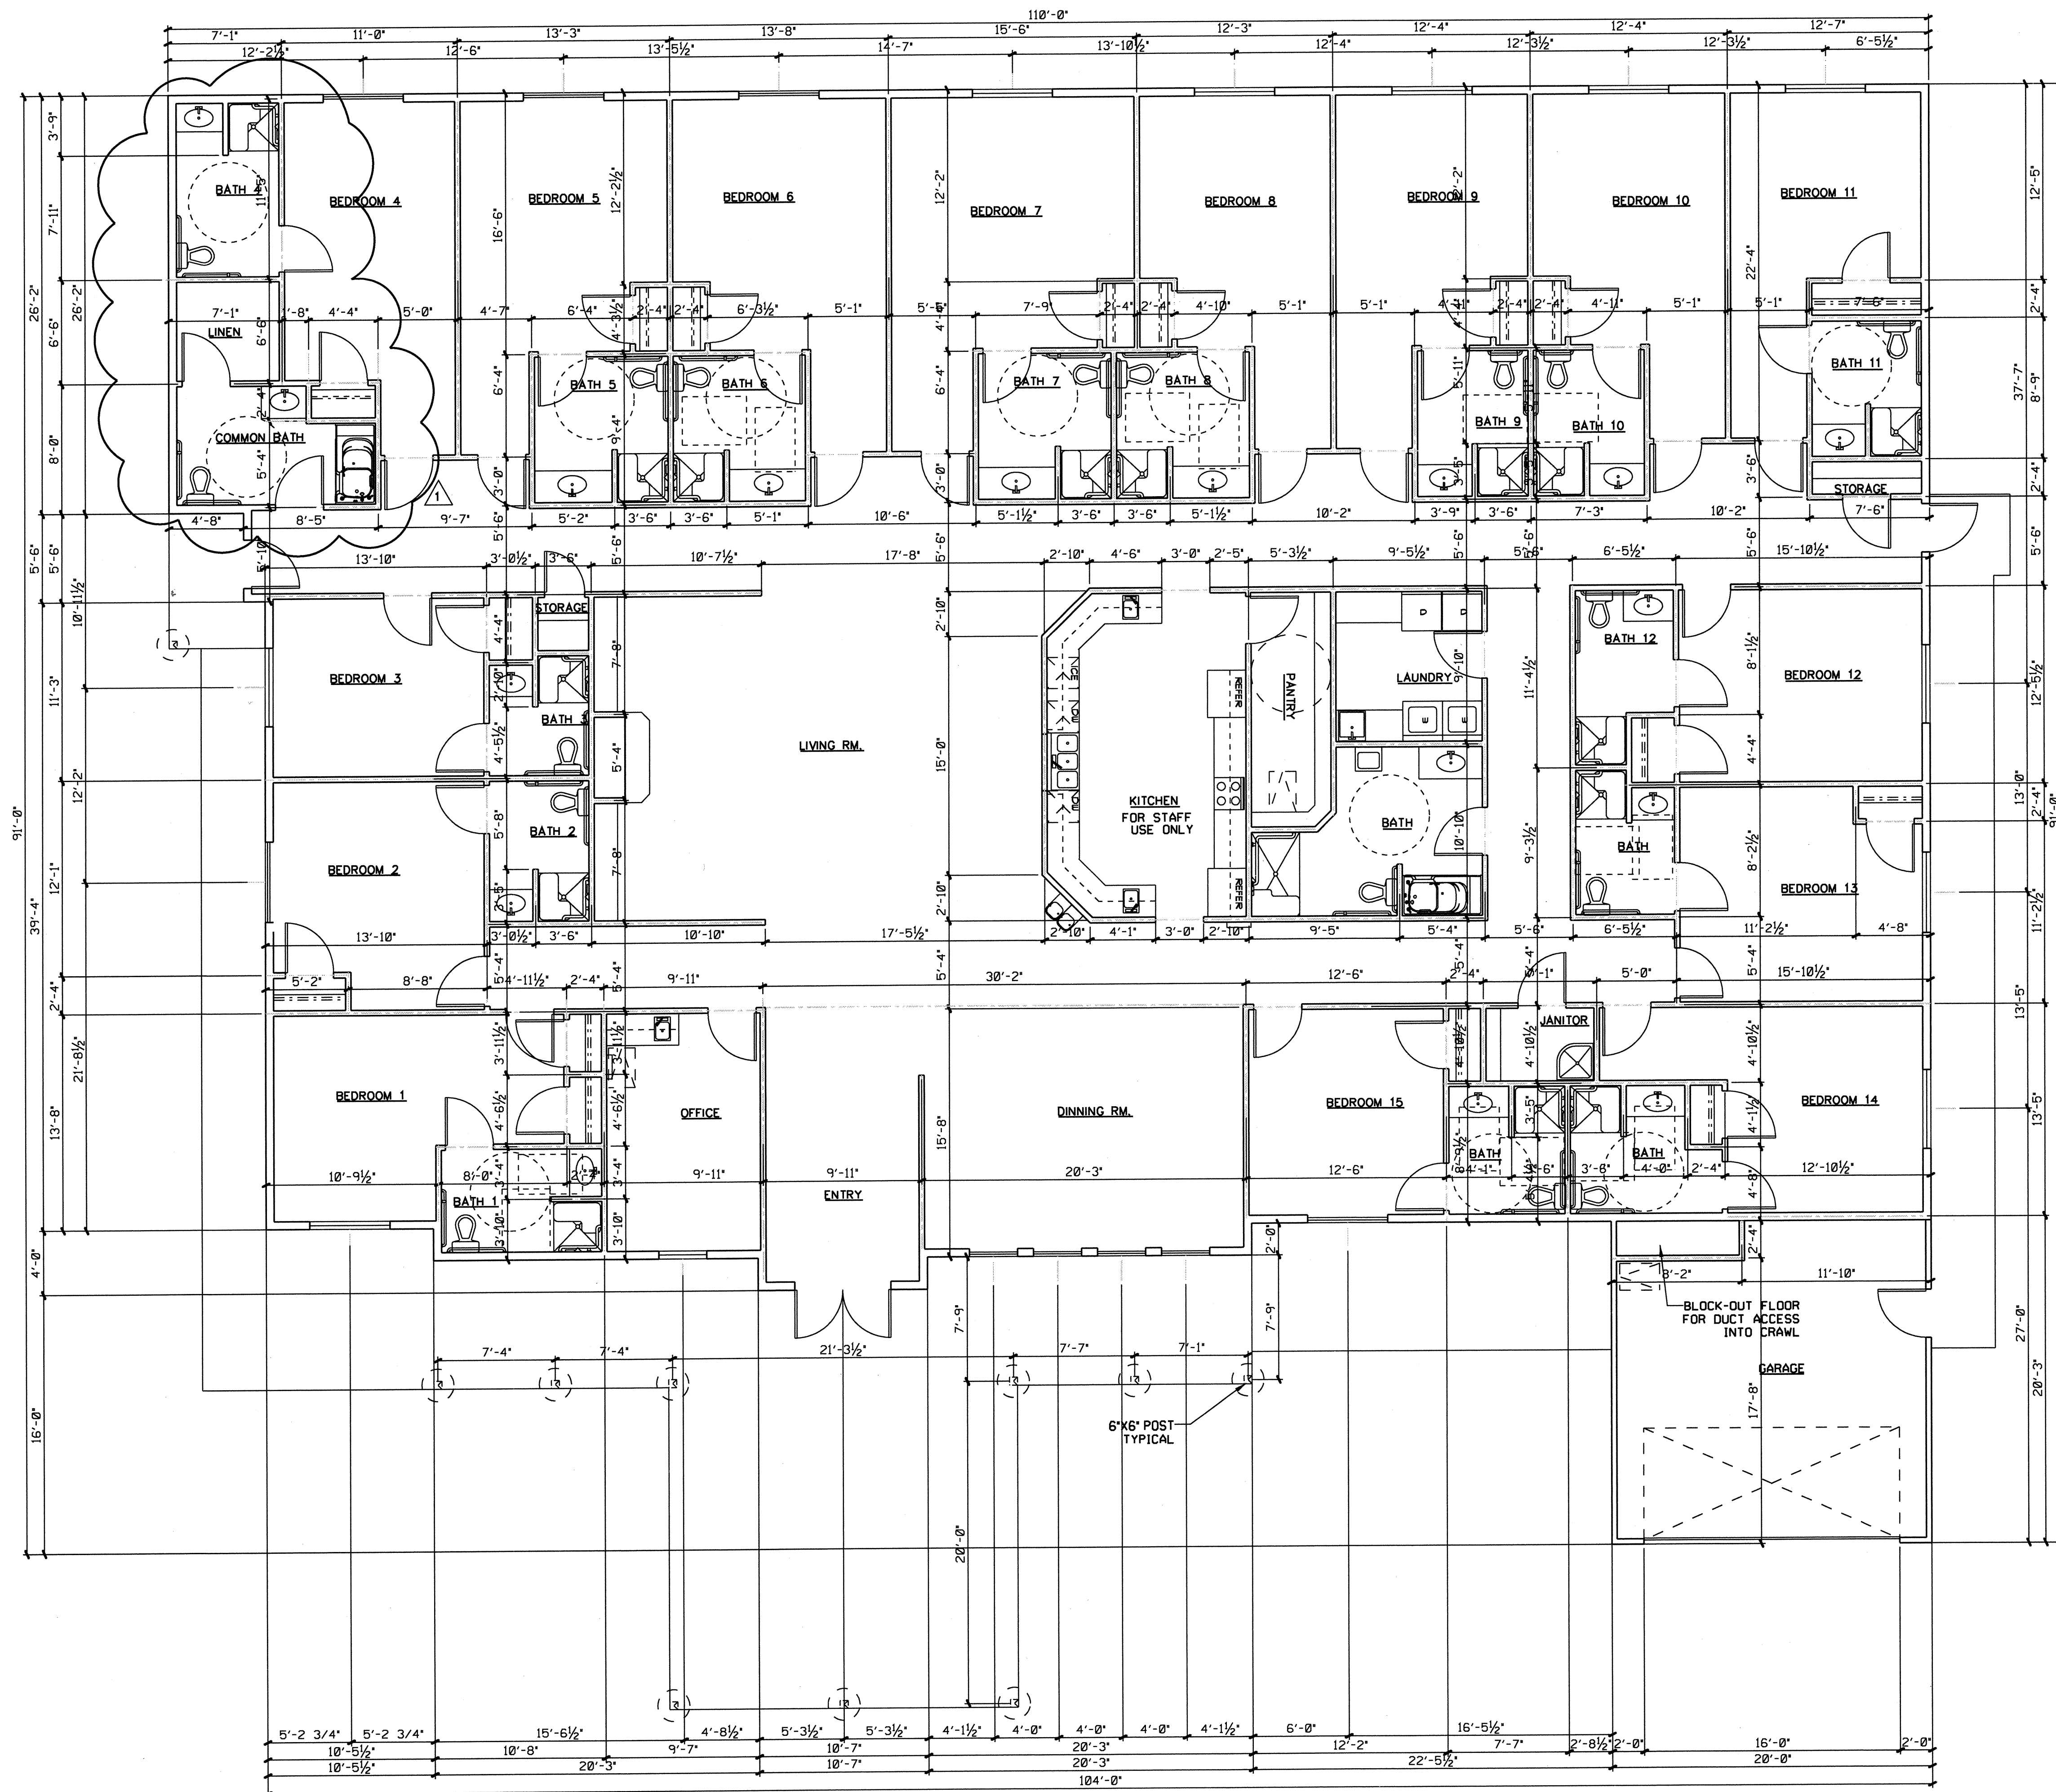

DIMENSION PLAN
SCALE: 3/8" = 1'-0"

7,777 SQ. FT.

A


GENERAL NOTES

B

1. ALL GYP. BD CORNERS TO BE BULLNOSED, TYP.
2. ALL WALL MOUNTED EQUIPMENT TO BE FLUSH MOUNTED W/1" MAX. PROJECTION AND NO SHARP CORNERS/EDGES TO PREVENT SKIN TEARS.
3. ONE KITCHEN CABINET TO BE LOCKABLE FOR KNIFE STORAGE.
4. DINING ROOM IS TO HAVE WAINSCOT @ 48" A.F.F., 3 WALLS.
5. ALL WINDOWS TO BE 3-WAY GYP. BD. WRAPPED W/WOOD TRIM (PAINTED) SILL AND APRON.

REVISIONS	BY
1 CITY REVIEW 3/5/13	AJ

DRa
DESIGN RESOURCES
ARCHITECTS PC
1014 S. LA POINTE STREET
BOISE, IDAHO 83706
208.343.5511
www.desresarch.com
administrator@desresarch.com

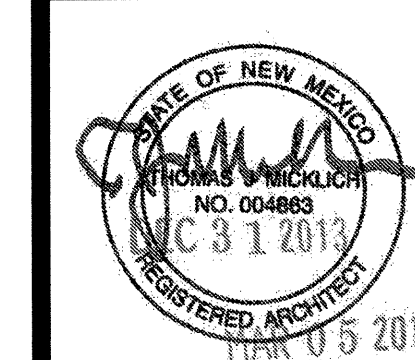

BEEHIVE HOMES
QUALITY SENIOR LIVING
ENGINEERED BY
1500 W. BARRETT DR. PH: (208) 888-7145
MERIDIAN, ID. 83642 FAX: (208) 888-7186
richard@karlchneengineering.com

**FOUR HILLS BEEHIVE
NEW MEXICO**
PAGE TITLE
DIMENSION PLAN

DRAWN
AJ/SM
CHECKED
RTK
DATE
JANUARY, 2013
SCALE
AS NOTED
JOB NO.
12-44
SHEET
A2.1
OF SHEETS

CITY OF ALBUQUERQUE
BUILDING & SAFETY

JUL 16 2013

I.S.C.
PLAN CHECK SECTION

Print Date: 07/15/2013 3:06 PM