


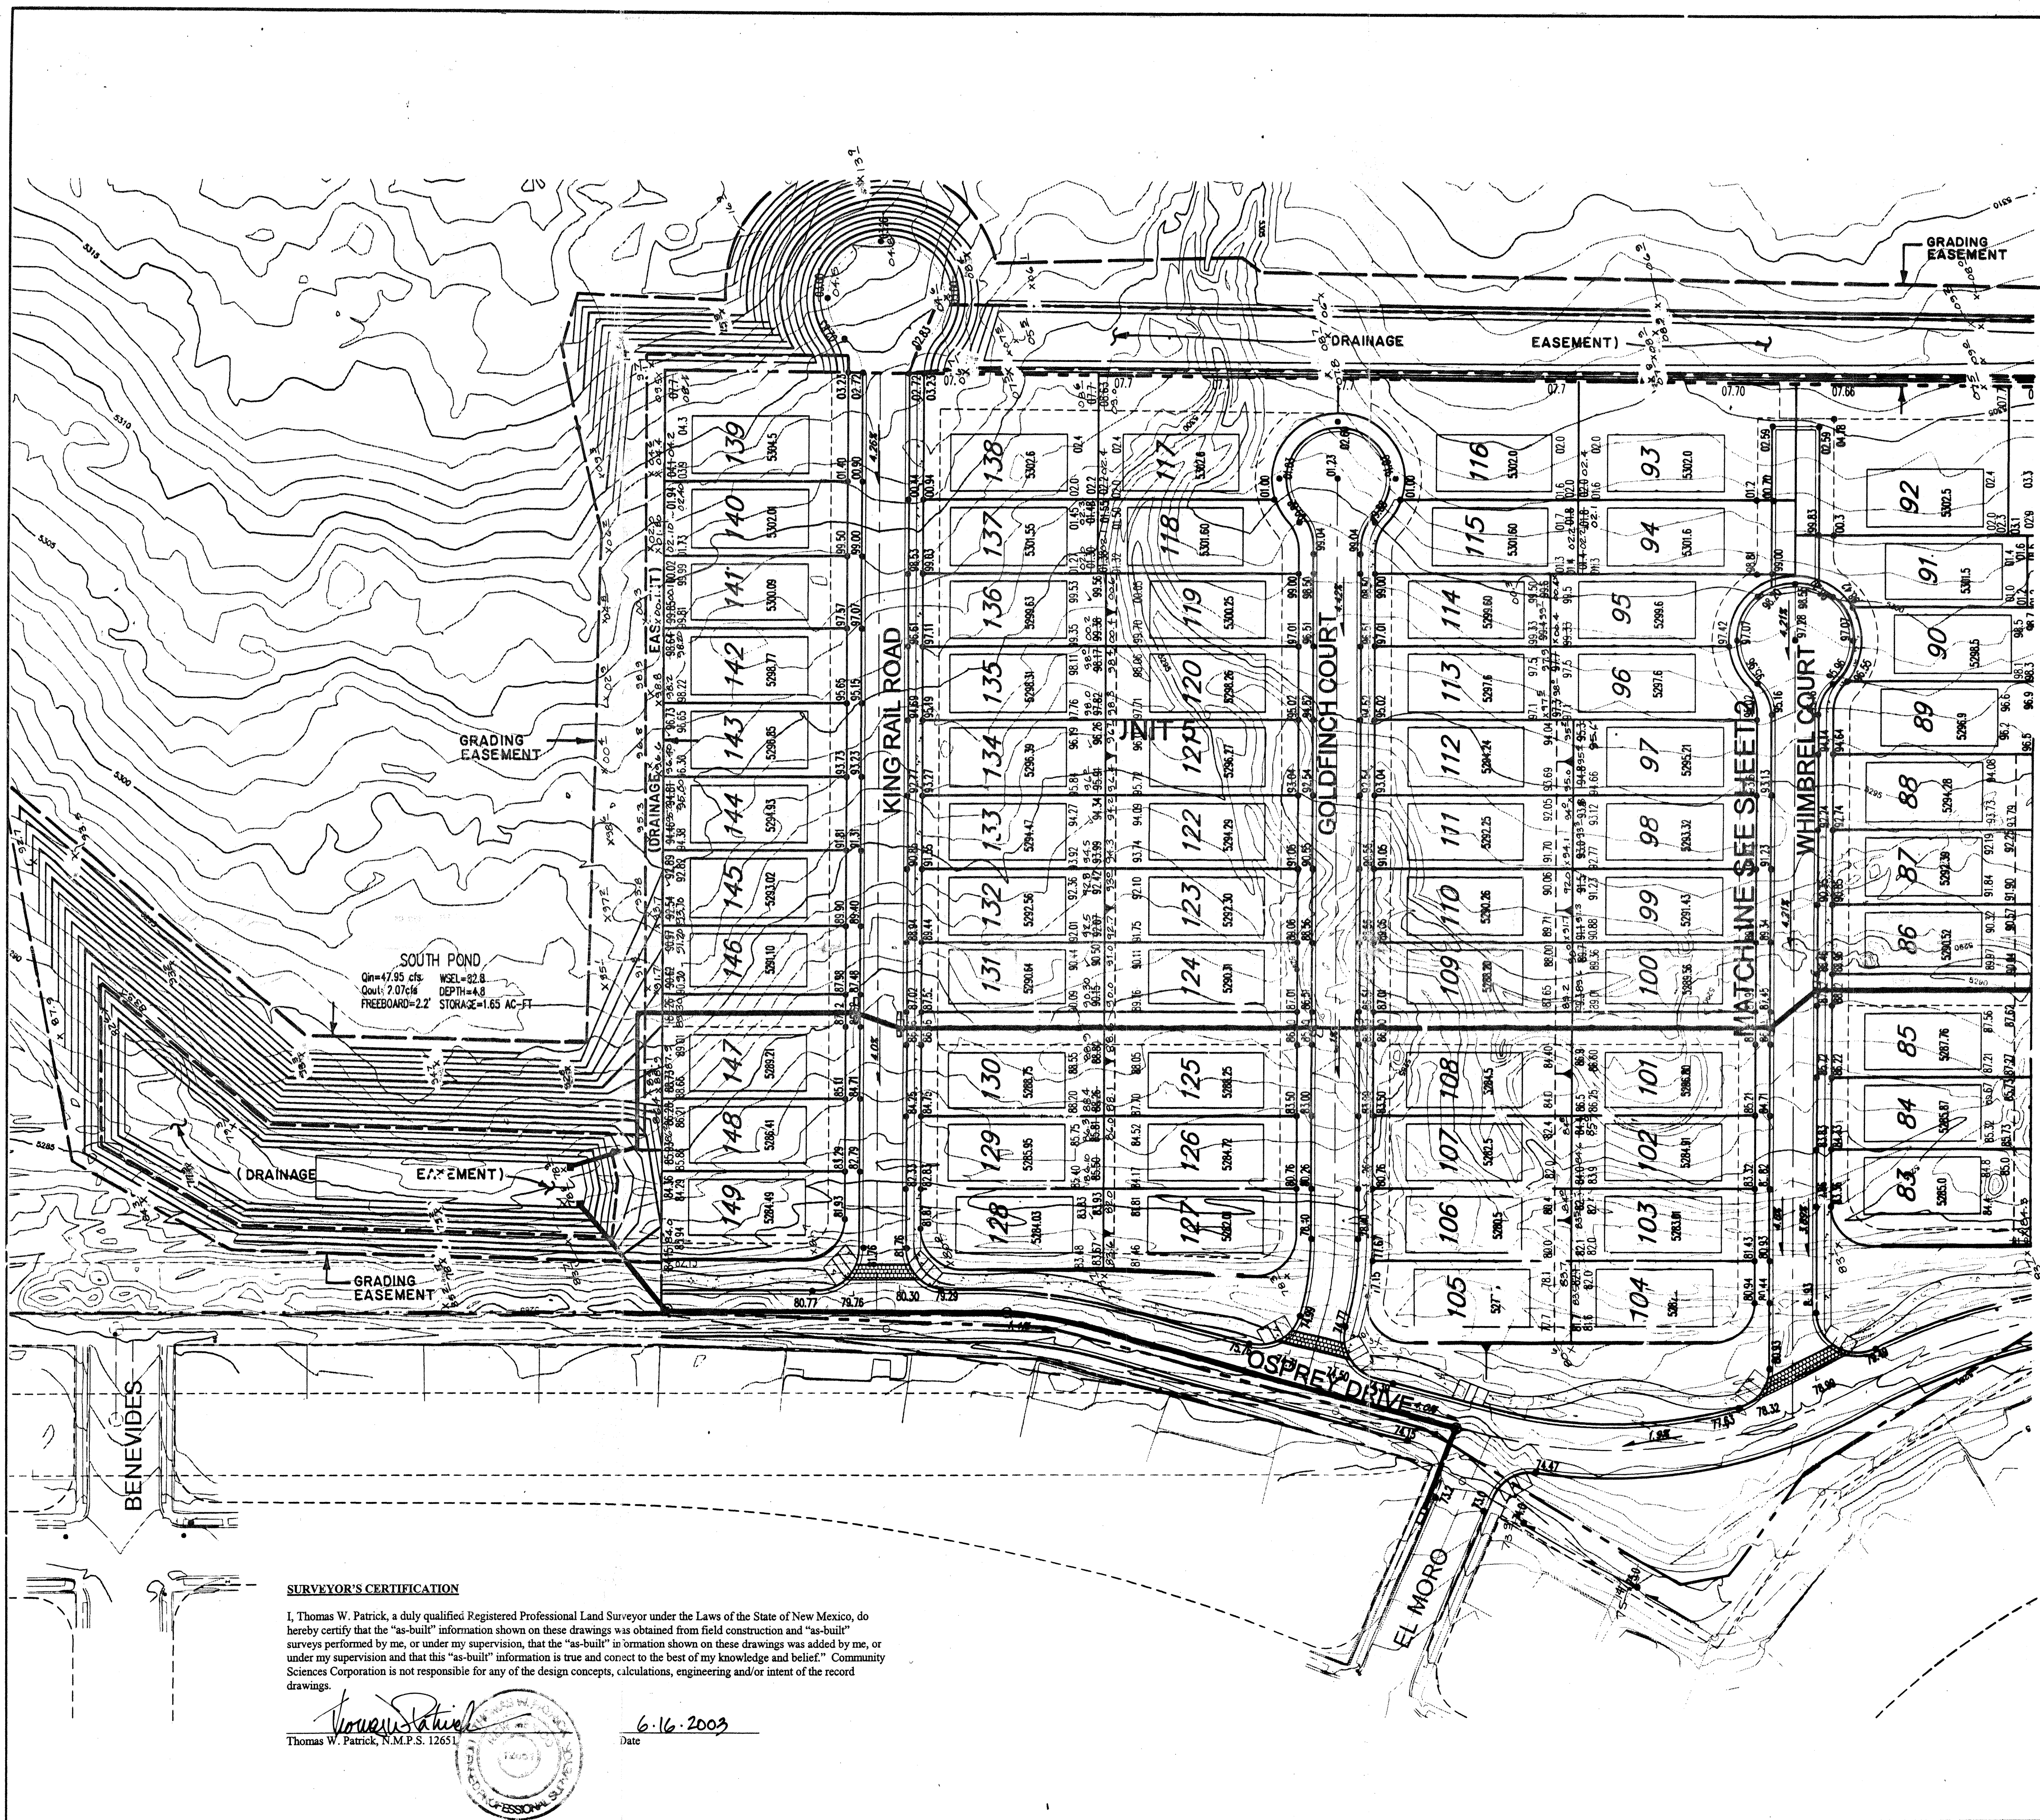

SURVEYOR'S CERTIFICATION

I, Thomas W. Patrick, a duly qualified Registered Professional Land Surveyor under the Laws of the State of New Mexico, do hereby certify that the "as-built" information shown on these drawings was obtained from field construction and "as-built" surveys performed by me, or under my supervision, that the "as-built" information shown on these drawings was added by me, or under my supervision and that this "as-built" information is true and correct to the best of my knowledge and belief. Community Sciences Corporation is not responsible for any of the design concepts, calculations, engineering and/or intent of the record drawings.

Thomas W. Patrick, N.M.P.S. 12651
Date: 6-16-2003

DETAILED CERTIFICATION

I, RICHARD LYNN BELTRAMO, NMPE #10596, OF THE FIRM BOHANNAN HUSTON INC., HEREBY CERTIFY THAT THIS PROJECT HAS BEEN GRADED AND WILL DRAIN IN SUBSTANTIAL COMPLIANCE WITH AND IN ACCORDANCE WITH THE DESIGN INTENT OF THE APPROVED PLAN DATED 08/21/01. THE RECORD INFORMATION EDITED ONTO THE ORIGINAL DESIGN DOCUMENT HAS BEEN OBTAINED BY THOMAS W. PATRICK, NMPS #12651, OF THE FIRM COMMUNITY SCIENCES CORPORATION. I FURTHER CERTIFY THAT I HAVE PERSONALLY VISITED THE PROJECT SITE ON 08/16/03 AND HAVE DETERMINED BY VISUAL INSPECTION THAT THE SURVEY DATA PROVIDED IS REPRESENTATIVE OF ACTUAL SITE CONDITIONS AND IS TRUE AND CORRECT TO THE BEST OF MY KNOWLEDGE AND BELIEF. THIS CERTIFICATION IS SUBMITTED IN SUPPORT OF A REQUEST FOR SIA/FINANCIAL GUARANTEE RELEASE.

(EX) DESCRIBE ANY EXCEPTIONS AND/OR QUALIFICATIONS HERE IN A SEPARATE PARAGRAPH.


(CR) DESCRIBE ANY DEFICIENCIES AND/OR REQUIRED CORRECTIONS HERE IN A SEPARATE PARAGRAPH.

THE RECORD INFORMATION PRESENTED HEREON IS NOT NECESSARILY COMPLETE AND INTENDED ONLY TO VERIFY SUBSTANTIAL COMPLIANCE OF THE GRADING AND DRAINAGE ASPECTS OF THIS PROJECT. THOSE RELYING ON THIS RECORD DOCUMENT ARE ADVISED TO OBTAIN INDEPENDENT VERIFICATION OF ITS ACCURACY BEFORE USING IT FOR ANY OTHER PURPOSE.

Richard Lynn Beltramo
RICHARD LYNN BELTRAMO, NMPE #10596

DATE: JUNE 19, 2003

DRB Approved
See Revised
10/16/00
9/21/01

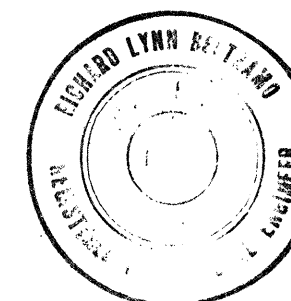

LEGEND

- PROPOSED TOP OF CURB ELEVATION
- PROPOSED SPOT ELEVATION
- EXISTING SPOT ELEVATION (GRID & TC)
- EXISTING CURB & GUTTER
- PROPOSED MOUNTABLE CURB & GUTTER
- PROPOSED STANDARD CURB & GUTTER
- EXISTING CONTOUR W/ INDEX ELEVATION
- EXISTING POWER POLE
- OVERHEAD ELECTRIC LINE
- EXISTING WATER MAIN
- SWALE
- FLOW ARROW
- PROPOSED RETAINING WALL
- PROPOSED GARDEN WALL
- PROPOSED SLOPE
- MANDATORY DRIVEWAY LOCATION
- EXISTING UNIT

NOTE: ALL ELEVATIONS ARE IN THE 5000 RANGE.

Bohannon Huston

County One 7500 JEFFERSON NE Albuquerque NEW MEXICO 87109

ENGINEERS PLANNERS PROGRAMMERS SURVEYORS SOFTWARE DEVELOPERS

CITY OF ALBUQUERQUE
PUBLIC WORKS DEPARTMENT
ENGINEERING DEVELOPMENT GROUP
TIMARRON WEST UNIT 5
GRADING & EROSION CONTROL PLAN


Design Review Committee: City Engineer: Approval: JUN 20 2003
HYDROLOGY SECTION

City Project No. Zone Map No. M-8 Sheet 1 Of 3

City of Albuquerque, New Mexico
Date: March 14, 2000

BHI JOB NO. 99470

MATCHLINE SEE SHEET 1

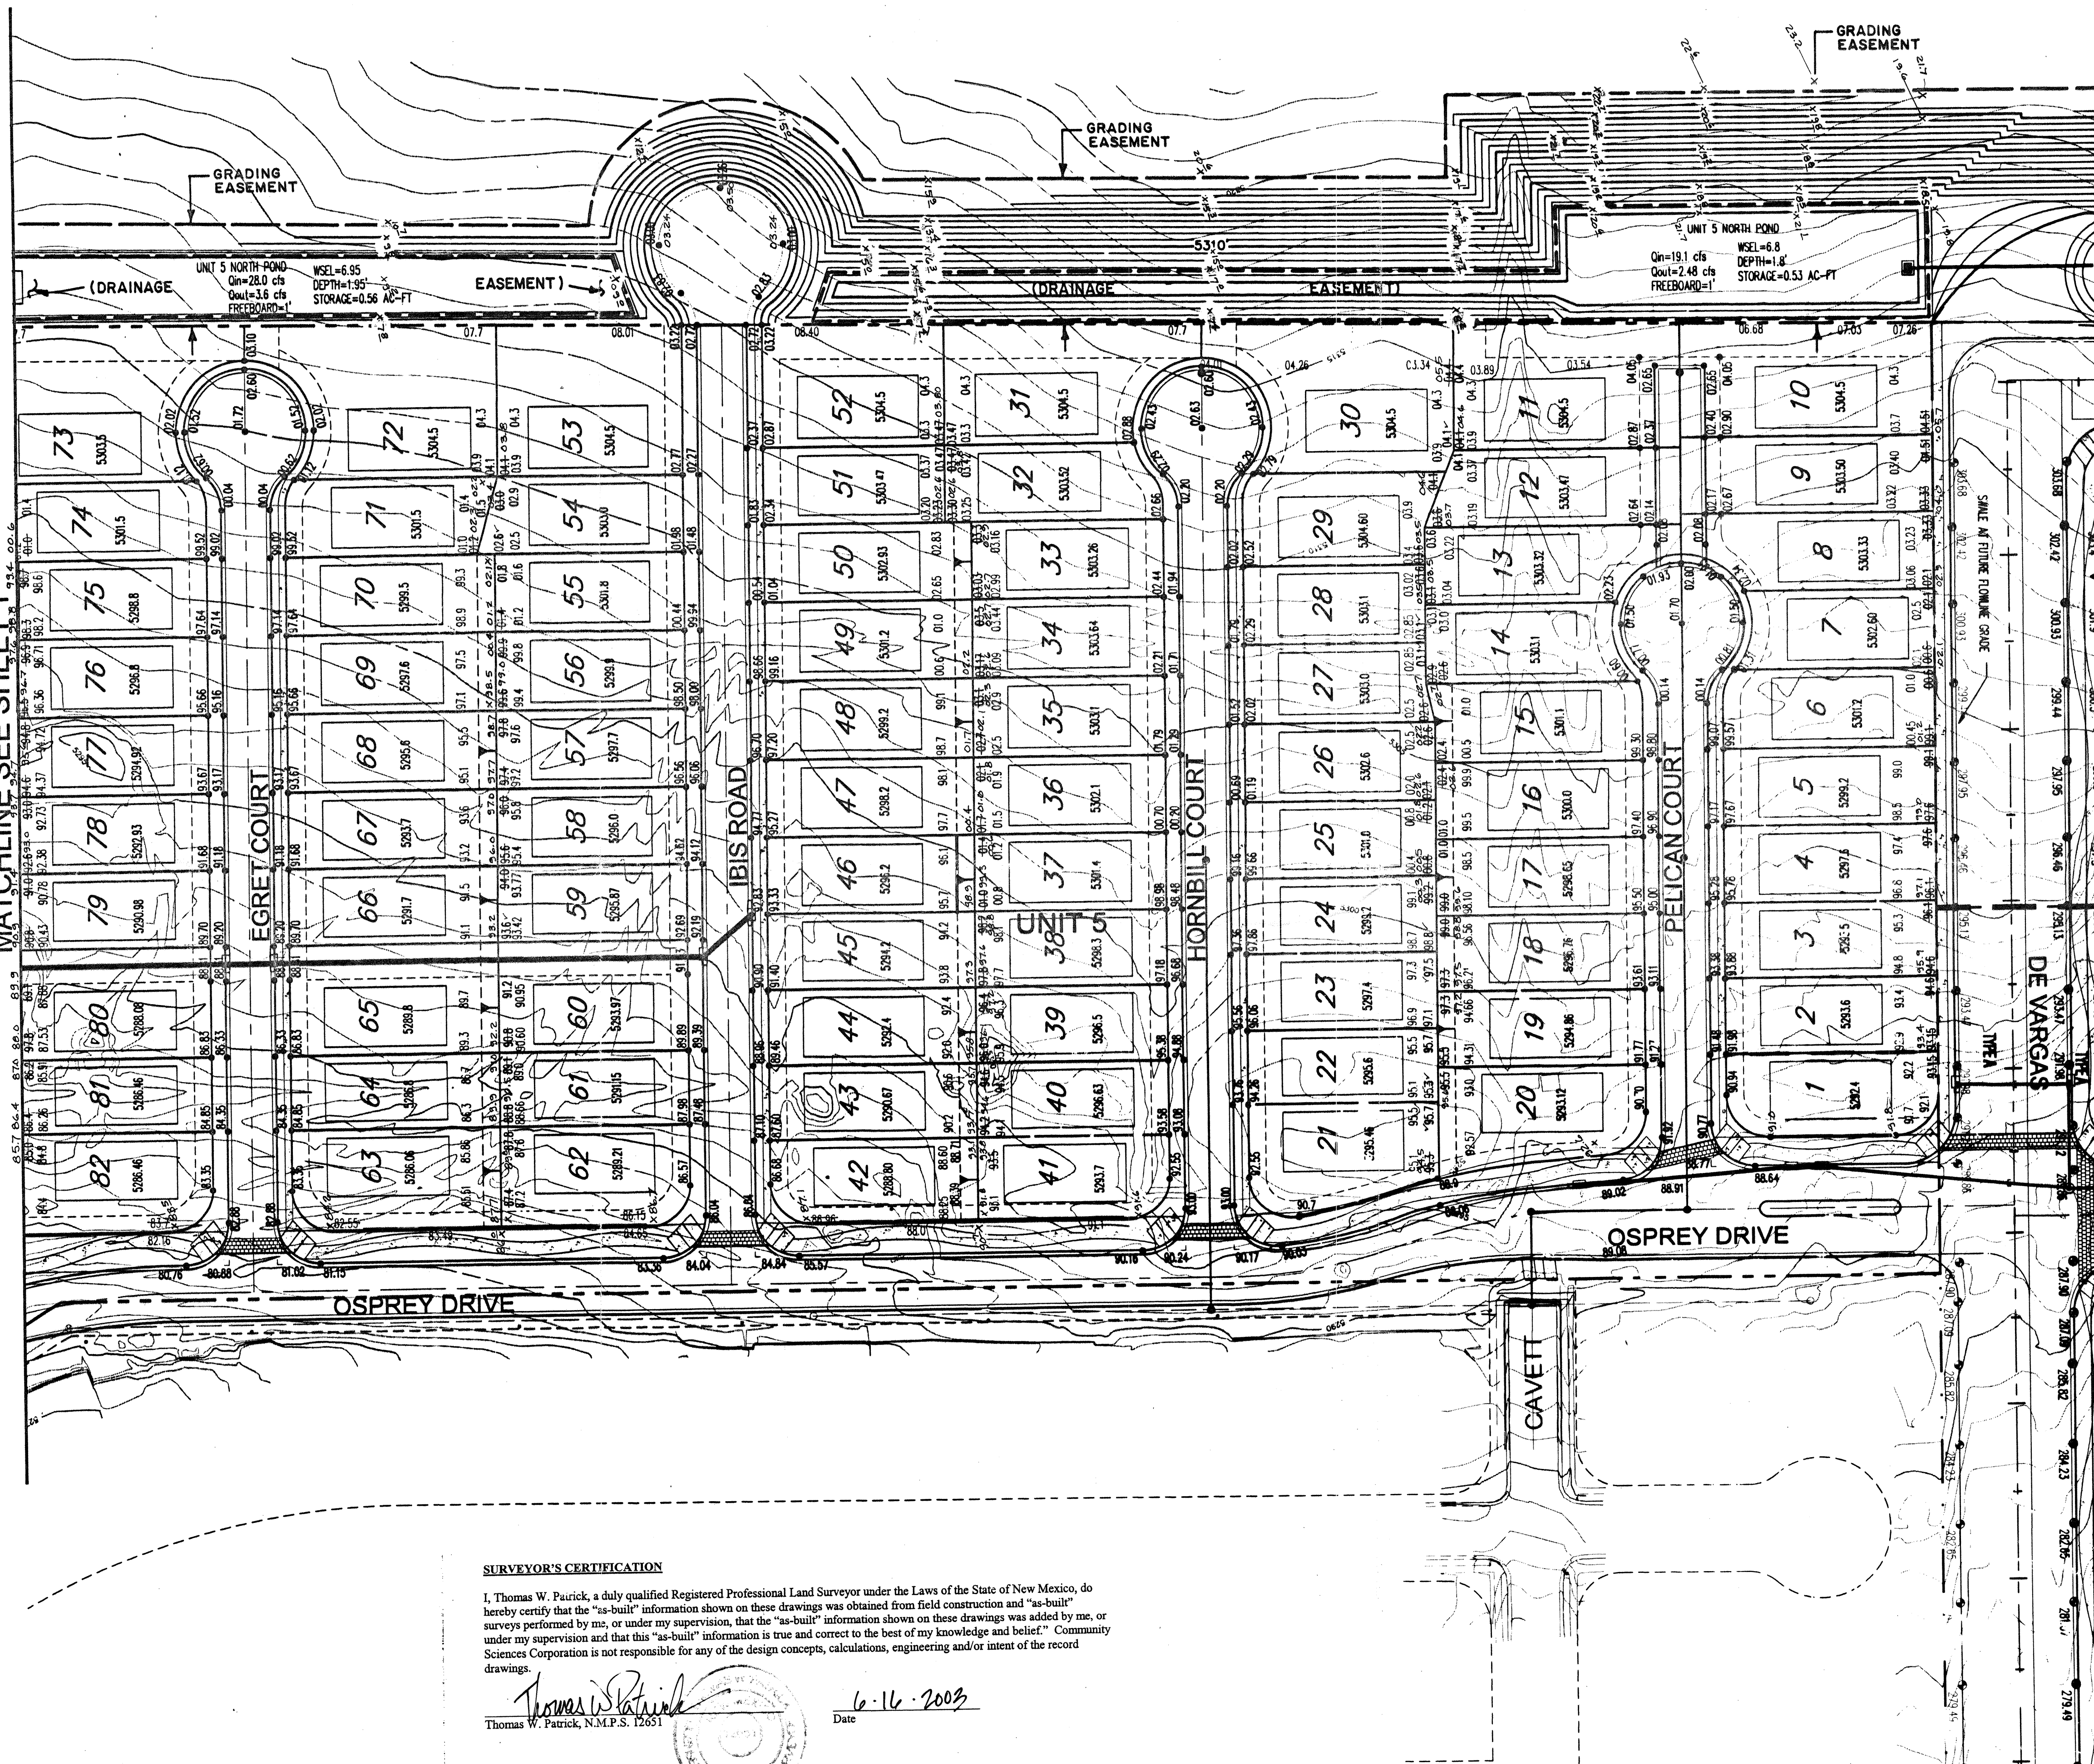

DRAINAGE CERTIFICATION

I, RICHARD LYNN BELTRAMO, NMPE #10596, OF THE FIRM BOHANNAN HUSTON INC., HEREBY CERTIFY THAT THIS PROJECT HAS BEEN GRADED AND WILL DRAIN IN SUBSTANTIAL COMPLIANCE WITH AND IN ACCORDANCE WITH THE DESIGN INTENT OF THE APPROVED PLAN DATED 08/21/01. THE RECORD INFORMATION EDITED ONTO THE ORIGINAL DESIGN DOCUMENT HAS BEEN OBTAINED BY THOMAS W. PATRICK, NMPS #12851, OF THE FIRM COMMUNITY SCIENCES CORPORATION. I FURTHER CERTIFY THAT I HAVE PERSONALLY VISITED THE PROJECT SITE ON 06/16/03 AND HAVE DETERMINED BY VISUAL INSPECTION THAT THE SURVEY DATA PROVIDED IS REPRESENTATIVE OF ACTUAL SITE CONDITIONS AND IS TRUE AND CORRECT TO THE BEST OF MY KNOWLEDGE AND BELIEF. THIS CERTIFICATION IS SUBMITTED IN SUPPORT OF A REQUEST FOR SURVIVAL FINANCIAL GUARANTEE RELEASE.

(DESCRIBE ANY EXCEPTIONS AND/OR QUALIFICATIONS HERE IN A SEPARATE PARAGRAPH)
(DESCRIBE ANY DEFICIENCIES AND/OR REQUIRED CORRECTIONS HERE IN A SEPARATE PARAGRAPH)

THE RECORD INFORMATION PRESENTED HEREON IS NOT NECESSARILY COMPLETE AND INTENDED ONLY TO VERIFY SUBSTANTIAL COMPLIANCE OF THE GRADING AND DRAINAGE ASPECTS OF THIS PROJECT. THOSE RELYING ON THIS RECORD DOCUMENT ARE ADVISED TO OBTAIN INDEPENDENT VERIFICATION OF ITS ACCURACY BEFORE USING IT FOR ANY OTHER PURPOSE.

RICHARD LYNN BELTRAMO, NMPE #10596
DATE: JUNE 19, 2003



DRB APPROVED
SEE REVISED
10/6/00

LEGEND


- PROPOSED TOP OF CURB ELEVATION
- PROPOSED SPOT ELEVATION
- EXISTING SPOT ELEVATION (GRID & 10)
- EXISTING CURB & GUTTER
- PROPOSED MOUNTABLE CURB & GUTTER
- PROPOSED STANDARD CURB & GUTTER
- EXISTING CONTOUR W/ INDEX ELEVATION
- EXISTING POWER POLE
- OVERHEAD ELECTRICAL LINE
- EXISTING WATER MAIN
- SWALE
- FLOW ARROW
- PROPOSED RETAINING WALL
- PROPOSED GARDEN WALL
- PROPOSED SLOPE
- MANDATORY DRIVEWAY LOCATION
- EXISTING UNIT

NOTE: ALL ELEVATIONS ARE IN THE 5000 RANGE.

SURVEYOR'S CERTIFICATION

I, Thomas W. Patrick, a duly qualified Registered Professional Land Surveyor under the Laws of the State of New Mexico, do hereby certify that the "as-built" information shown on these drawings was obtained from field construction and "as-built" surveys performed by me, or under my supervision, that the "as-built" information shown on these drawings was added by me, or under my supervision and that this "as-built" information is true and correct to the best of my knowledge and belief. Community Sciences Corporation is not responsible for any of the design concepts, calculations, engineering and/or intent of the record drawings.

Thomas W. Patrick, N.M.P.S. 12651
Date: 6-16-2003

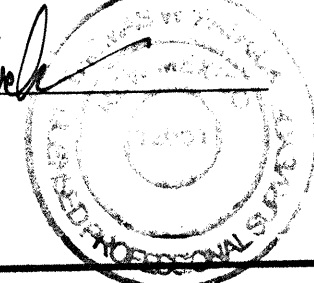

Bohannon - Huston
Copyright One 7500 JEFFERSON NE Albuquerque NEW MEXICO 87109
ENGINEERS PLANNERS PHOTOGRAMMETRICISTS SURVEYORS SOFTWARE DEVELOPERS

CITY OF ALBUQUERQUE PUBLIC WORKS DEPARTMENT ENGINEERING DEVELOPMENT GROUP			
TIMARRON WEST UNIT 5 GRADING & EROSION CONTROL PLAN			
Design Review Committee	City Engineer Approval	Mo./Day/Yr.	Mo./Day/Yr.
City Project No.	Zone Map No.	Sheet	Of
	M-8	2	3

BHI JOB NO. 99470

Copyright Bohannon Huston 2000
Date: March 14, 2000