**RADIUS INFORMATION:** 

(1) = 10'-0" (5) = 20'-0"(2) = 30'-0" (6) = 5'-0" (3) = 15'-0" (7) = 40'-0" (4) = 3'-0"

**GENERAL NOTES:** 

[A] THE PARKING LOT DIMENSIONS ARE FROM FACE OF CURB TO FACE OF CURB. [B] LANDSCAPING AND SIGNING WILL NOT INTERFERE WITH CLEAR SIGHT REQUIREMENTS. THEREFORE, SIGNS. WALLS, TREES, AND SHRUBBERY BETWEEN 3 AND 8 FEET TALL (AS

MEASURED FROM THE GUTTER PAN) WILL NOT BE ACCEPTABLE IN THIS AREA. [C] ANY ENCROACHMENT OR OVERHANG INTO THE ROW FROM

SIGNS, FENCES, CANOPY, ROOF LINES, ETC. WILL REQUIRE AN ANNUAL REVOCABLE ENCROACHMENT PERMIT. [D] ALL CURBS SURROUNDING LANDSCAPING, SHALL PROVIDE

WATER RUNOFF OPENINGS TO ALLOW SURFACE DRAINAGE INTO THE LANDSCAPED AREAS (WATER HARVESTING). [E] ALL SIGNAGE AND FENCES WILL BE DONE UNDER SEPARATE

[F] ALL IMPROVEMENTS LOCATED IN THE RIGHT OF WAY MUST BE INCLUDED ON A PUBLIC WORK ORDER.

[G] SIDEWALK AREAS TO BE SHADED ALONG THE PRIMARY FACADE OF BUILDING.

**KEYED NOTES:** 

[1] PROPERTY LINE EXISTING DIRT SHOULDER ALONG GIBSON

EXISITNG PNM EASEMENT 4] EXISTING 6' CMU WALL SEPARATING SOLARE COLLEGIATE SCHOOL FROM RESIDENTIAL PROPERTIES.

[5] 50' "NO BUILDING" SETBACK BETWEEN RESIDENTIAL AND COMMERCIAL PROPERTY PER INTEGRATED DEVELOPMENT ORDINANCE REQUIREMENTS.

[6] NEW DRIVE PAD TO TIE INTO EXISTING CURB AND GUTTER SYSTEM. REFER TO CIVIL AND COA STANDARD DETAIL 2426.

[7] ASPHALT PAVING, REFER TO GEOTECHNICAL INVESTIGATION FOR ASPHALT SECTION.

[8] CONCRETE CURB AND GUTTER WHERE STORM WATER FLOWS AGAINST THE CURB.

[9] CONCRETE CURB [10] CONCRETE SIDEWALK. REFER TO COA STANDARD DETAIL 2430. [11] ADA COMPLIANT SIDEWALK RAMP WITH TRUNCATED DOMES TO

MEET COA STANDARD DETAILS AT BOTH SIDES OF NEW DRIVEPAD. [12] EXISTING ADA COMPLIANT SIDEWALK INTERSECTION RAMP. 13 LIGHT POLE ON CONCRETE BASE, REFER TO DETAIL.

[14] PARKING SPACE PAVEMENT STRIPING [15] HANDICAPPED ACCESSIBLE PARKING SPACES, REFER TO DETAILS.

[16] CROSSWALK PAVEMENT STRIPING.

17 TRAFFIC CONTROL PAVEMENT MARKINGS [18] CONCRETE RETAINING WALL, REFER TO DETAIL. [19] CONCRETE HANDICAPPED ACCESSIBLE RAMP, REFER TO DETAILS.

[20] CONCRETE STAIR, REFER TO DETAILS. 21 LANDSCAPE AREA, REFER TO LANDSCAPE PLAN.

[22] FIRE HYDRANT, REFER TO CIVIL UTILITY PLAN [23] STORM WATER SWALE, REFER TO GRADING AND DRAINAGE PLAN. [24] POND, REFER TO GRADING AND DRAINAGE PLAN.


[25] TEMPORARY FENCE AND GATES AROUND DUMPSTER. [26] TRANSFORMER AND MDP PANEL WITH FENCE. [27] BIKE TRAIL. REFER TO CIVIL.

[28] BIKE RACK. PARKING


CALCULATIONS: PROPOSED 1-STORY SCHOOL:

EDUCATION AT 2 SPACES/CLASSROOM = 14 SPACES REQUIRED 40 STANDARD SPACES PROVIDED 2 ADA ACCESSIBLE SPACES PROVIDED

2 MOTORCYCLE SPACES REQUIRED, 2 MOTORCYCLE SPACES PROVIDED 16 BICYCLE SPACED REQUIRED, 18 BICYCLE SPACES PROVIDED

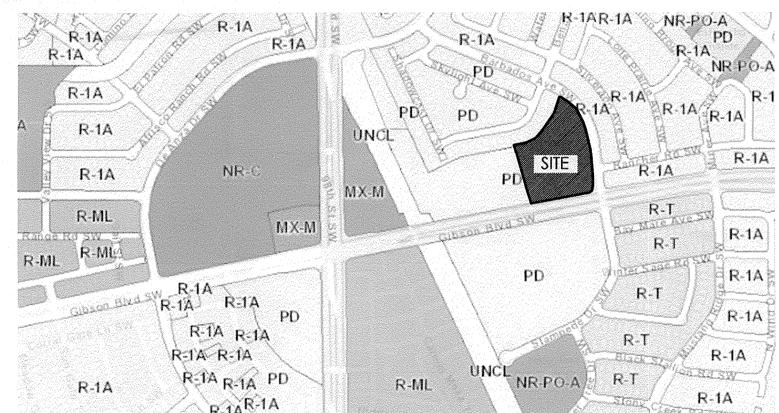

2 Vicinity Map Scale: Not To Scale

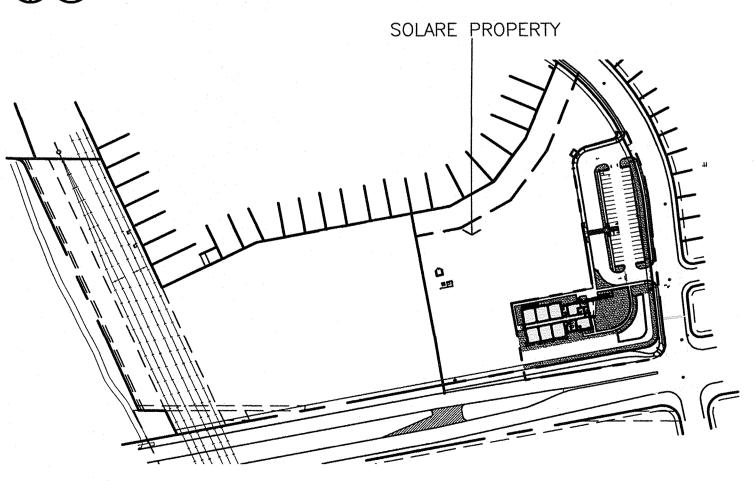

Overall Site Plan
Scale: 1"=200'-0"

JUL 1 8 2019 LAND DEVELOPMENT SECTION

JUL 1 6 2019

LAND DEVELOPMENT SECTION

D D D D D G G G




**MULLEN HELLER ARCHITECTURE** 1718 CENTRAL AVE SW | STE. D ALBUQUERQUE, NM | 87104 P | 505.268.4144 F | 505.268.4244 www.mullenheller.com

SCH00L

PROJECT
SOLARE CHARTER S
8801 Gibson Blvd. SW
Albuquerque, NM 87121

SHEET TCL

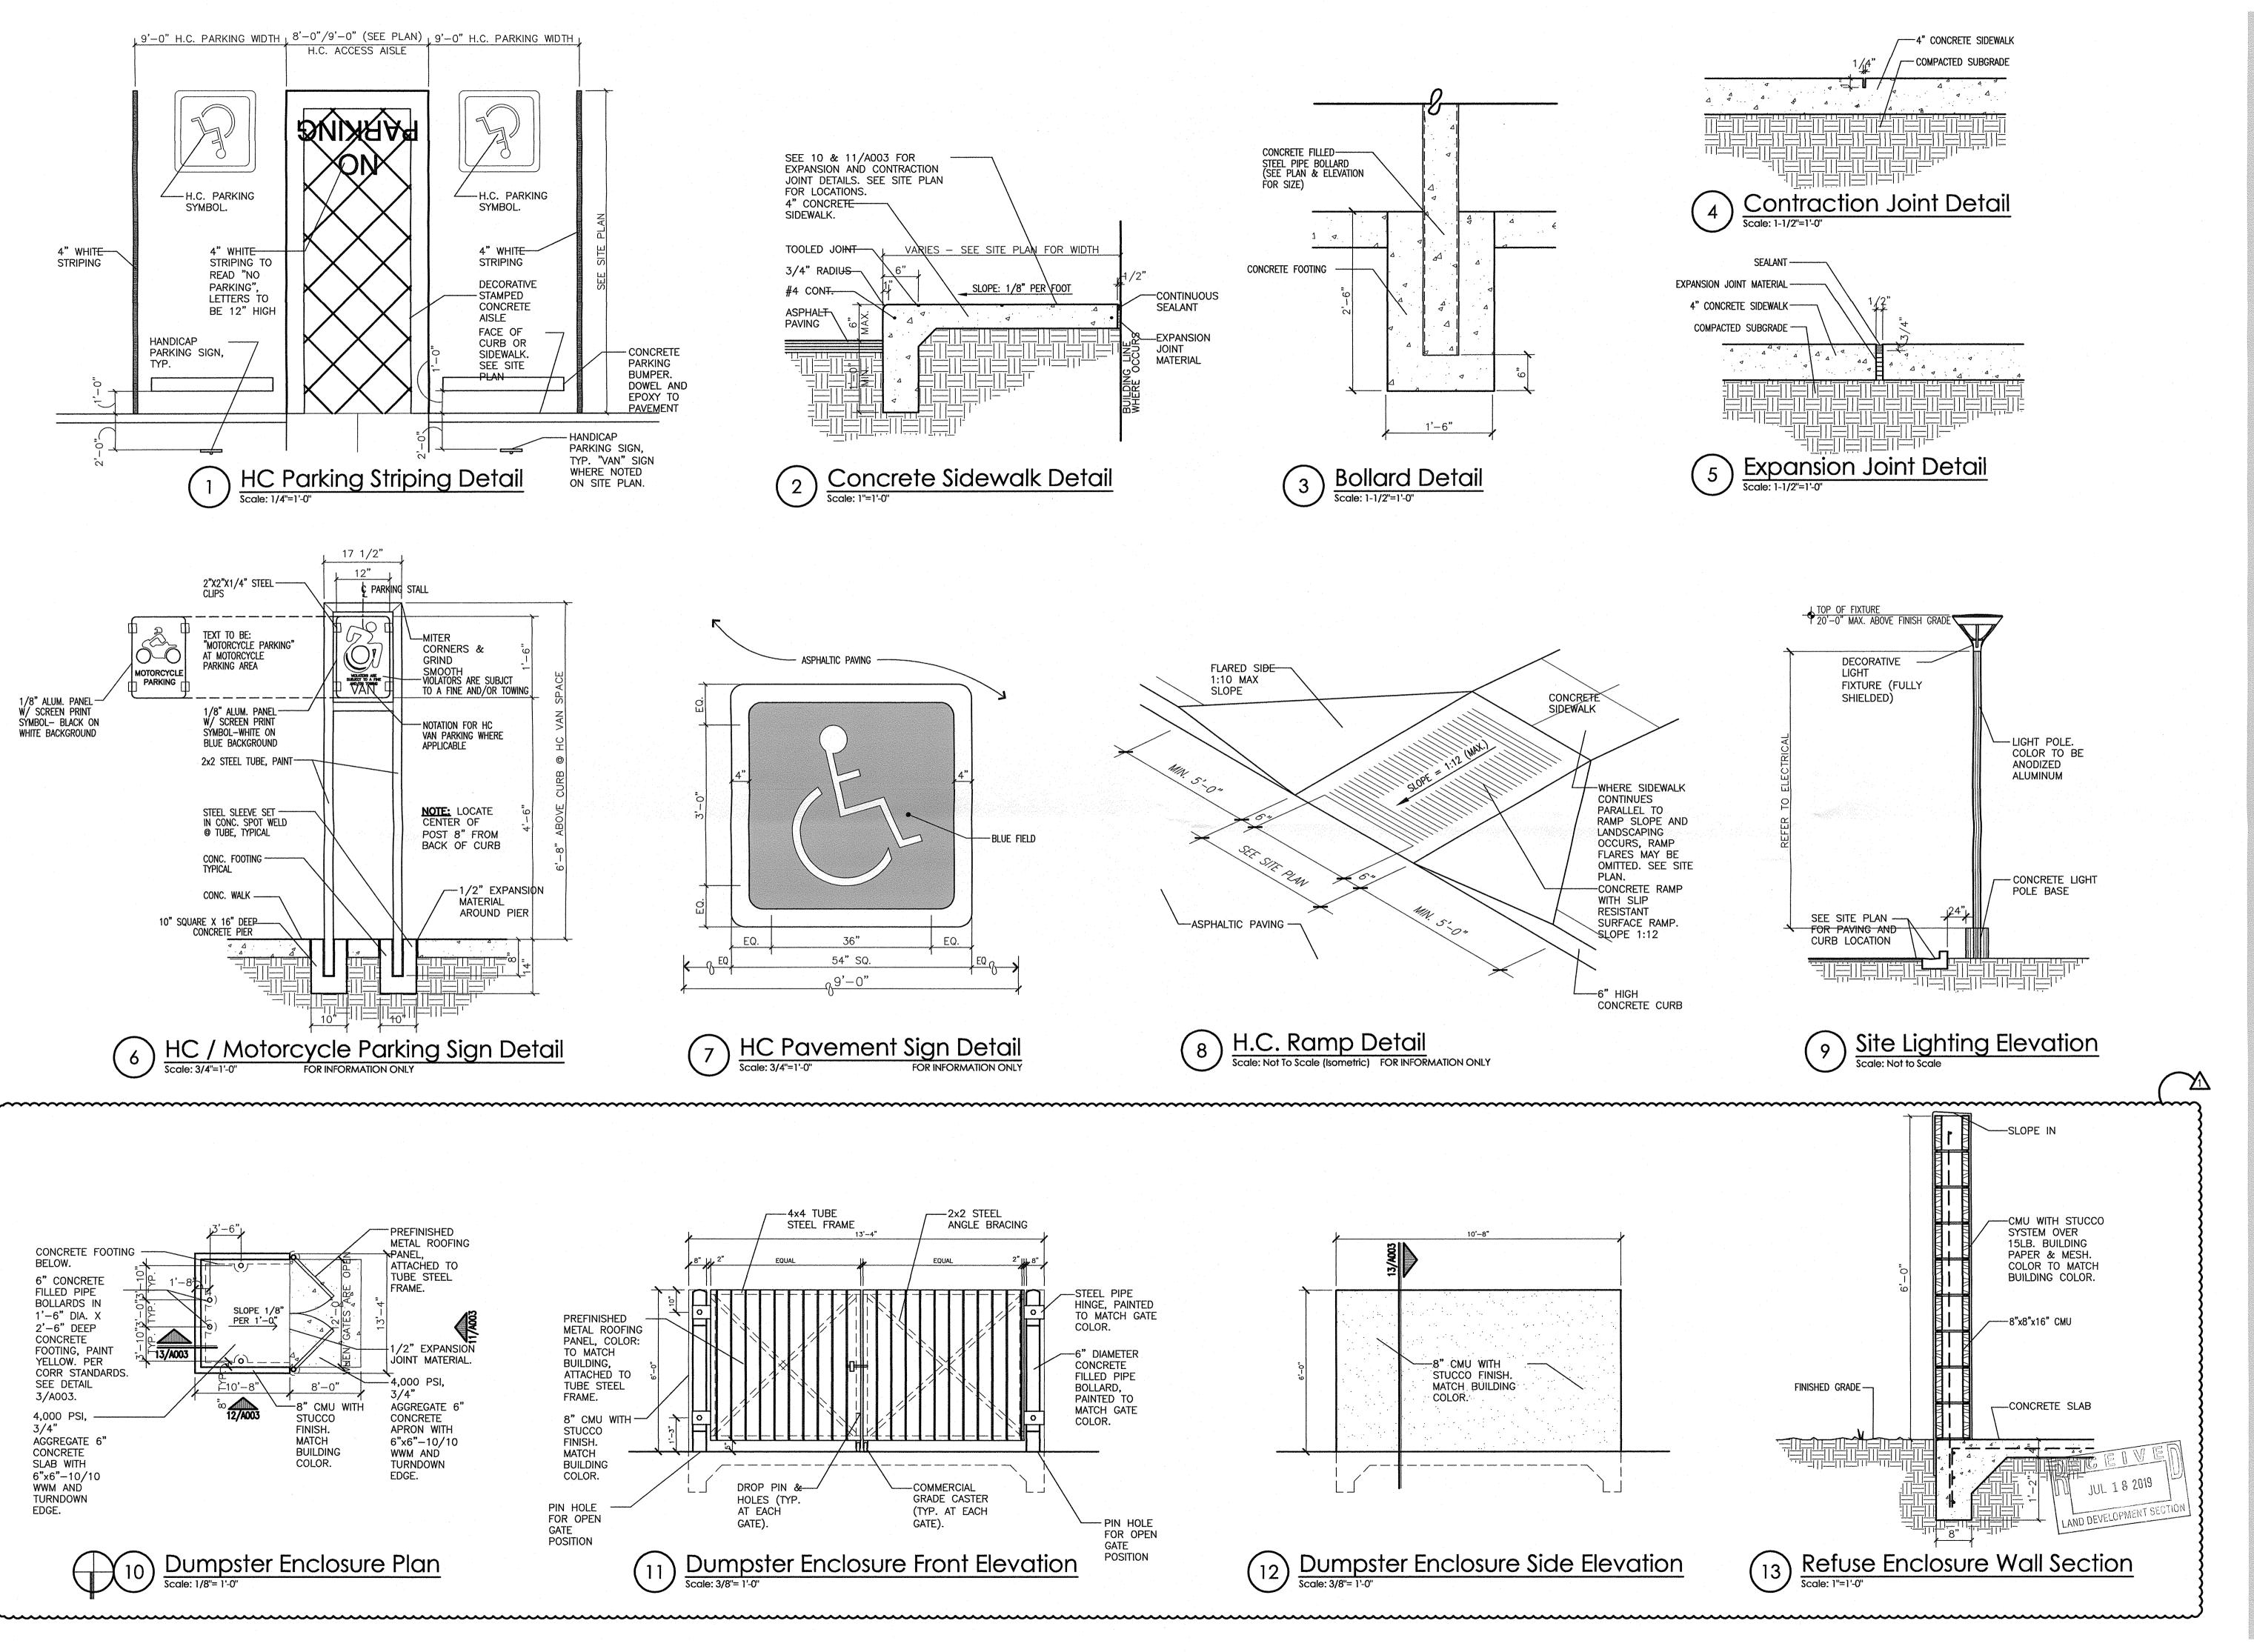


REV DATE BY DESCRIPTION

4

2

7-16-19 MW PERMIT REVIEW COMMENTS

ullen heller architecture

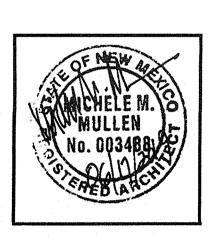

MULLEN HELLER ARCHITECTURE 1718 CENTRAL AVE SW | STE. D ALBUQUERQUE, NM | 87104 P | 505.268.4144 F | 505.268.4244 www.mullenheller.com

JOB NUMBER 19-01

DRAWN BY MW/SS/AG/AV

PROJECT MGR MMM

DATE 06-27-2019
PHASE CDs

Toohas

SOLARE CHARTER SCHC 8801 Gibson Blvd. SW Albuquerque, NM 87121

SHEET A003

[A] THE PARKING LOT DIMENSIONS ARE FROM FACE OF CURB TO FACE OF CURB.

[B] LANDSCAPING AND SIGNING WILL NOT INTERFERE WITH CLEAR SIGHT REQUIREMENTS. THEREFORE, SIGNS. WALLS, TREES, AND SHRUBBERY BETWEEN 3 AND 8 FEET TALL (AS MEASURED FROM THE GUTTER PAN) WILL NOT BE ACCEPTABLE IN THIS AREA.

[C] ANY ENCROACHMENT OR OVERHANG INTO THE ROW FROM SIGNS, FENCES, CANOPY, ROOF LINES, ETC. WILL REQUIRE AN ANNUAL REVOCABLE ENCROACHMENT PERMIT.

[D] ALL CURBS SURROUNDING LANDSCAPING, SHALL PROVIDE WATER RUNOFF OPENINGS TO ALLOW SURFACE DRAINAGE INTO THE LANDSCAPED AREAS (WATER HARVESTING). [E] ALL SIGNAGE AND FENCES WILL BE DONE UNDER SEPARATE

[F] ALL IMPROVEMENTS LOCATED IN THE RIGHT OF WAY MUST BE

INCLUDED ON A PUBLIC WORK ORDER. [G] SIDEWALK AREAS TO BE SHADED ALONG THE PRIMARY

FACADE OF BUILDING.

KEYED NOTES:

[1] PROPERTY LINE

2 EXISTING DIRT SHOULDER ALONG GIBSON

EXISITNG PNM EASEMENT 4] EXISTING 6' CMU WALL SEPARATING SOLARE COLLEGIATE SCHOOL

FROM RESIDENTIAL PROPERTIES. [5] 50' "NO BUILDING" SETBACK BETWEEN RESIDENTIAL AND

COMMERCIAL PROPERTY PER INTEGRATED DEVELOPMENT ORDINANCE REQUIREMENTS. [6] NEW DRIVE PAD TO TIE INTO EXISTING CURB AND GUTTER

SYSTEM. REFER TO CIVIL AND COA STANDARD DETAILS. [7] ASPHALT PAVING, REFER TO GEOTECHNICAL INVESTIGATION FOR

[8] CONCRETE CURB AND GUTTER WHERE STORM WATER FLOWS

AGAINST THE CURB.

[9] CONCRETE CURB

10] CONCRETE SIDEWALK

1] ADA COMPLIANT SIDEWALK RAMP WITH TRUNCATED DOMES TO MEET COA STANDARD DETAILS AT BOTH SIDES OF NEW DRIVEPAD.

12] EXISTING ADA COMPLIANT SIDEWALK INTERSECTION RAMP. 13] LIGHT POLE ON CONCRETE BASE, REFER TO DETAIL.

14] PARKING SPACE PAVEMENT STRIPING 5] HANDICAPPED ACCESSIBLE PARKING SPACES, REFER TO DETAILS.

6 CROSSWALK PAVEMENT STRIPING.

17 TRAFFIC CONTROL PAVEMENT MARKINGS 18] CONCRETE RETAINING WALL, REFER TO DETAIL.

9] CONCRETE HANDICAPPED ACCESSIBLE RAMP, REFER TO DETAILS. 20] CONCRETE STAIR, REFER TO DETAILS.

[1] LANDSCAPE AREA, REFER TO LANDSCAPE PLAN. 2] FIRE HYDRANT, REFER TO CIVIL UTILITY PLAN

23] STORM WATER SWALE, REFER TO GRADING AND DRAINAGE PLAN. [24] POND, REFER TO GRADING AND DRAINAGE PLAN.


[25] TEMPORARY FENCE AND GATES AROUND DUMPSTER. [26] TRANSFORMER AND MDP PANEL WITH FENCE.

SWMD enclosure placement DK Michael Annya.


PARKING CALCULATIONS: PROPOSED 1-STORY SCHOOL:

EDUCATION AT 2 SPACES/CLASSROOM = 14 SPACES REQUIRED 41 STANDARD SPACES PROVIDED 2 ADA ACCESSIBLE SPACES PROVIDED

RADIUS INFORMATION:

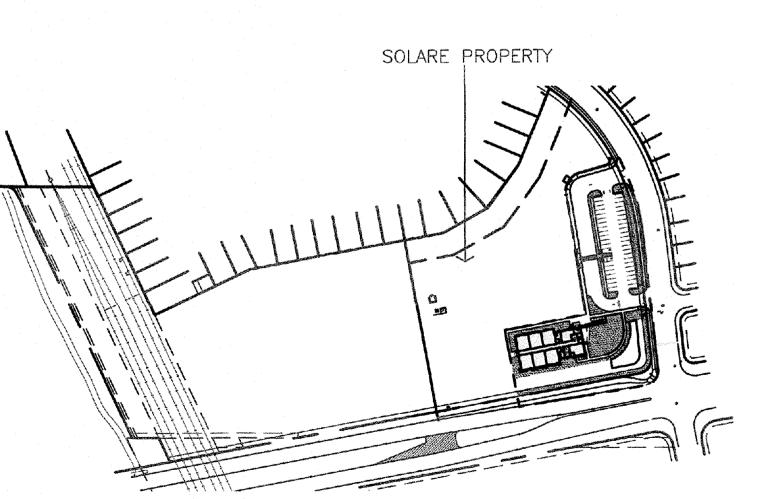

Overall Site Plan
Scale: 1"=200'-0"

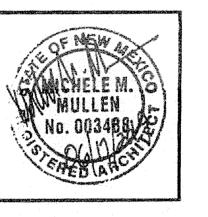

MULLEN HELLER ARCHITECTURE 1718 CENTRAL AVE SW | STE. D ALBUQUERQUE, NM | 87104 P | 505.268.4144 F | 505.268.4244 www.mullenheller.com

JOB NUMBER DRAWN BY MW/SS/AG/AV

PROJECT MGR

PHASE

**PHASE** Architectural Site

CHARTER on Blvd. SW ae, NM 87121

SCHOOL

SHEET A001