

CITY OF ALBUQUERQUE

Planning Department
Brennon Williams, Director



Mayor Timothy M. Keller

August 12, 2021

Scott McGee, P.E.
9700 Sand Verbena Trail NE
Albuquerque, NM 87122

**RE: Solare Charter School
8801 Gibson Blvd SW
Temporary C.O. - Accepted
Engineer's Certification Date: 08/03/21
Engineer's Stamp Date: 11/17/20
Hydrology File: M09D031A**

Dear Mr. McGee:

PO Box 1293

Based **solely** on the Certification received 08/08/2021, this certification is approved in support of Temporary Release of Occupancy by Hydrology. **The following comment needs to be addressed prior to acceptance for Permanent C.O.:**

Albuquerque

1. Please note that Hydrology will need a pdf copy of the recorded Drainage Covenant prior to Hydrology's approval of Permanent Release of Occupancy.

NM 87103

If you have any questions, please contact me at 924-3995 or rbrissette@cabq.gov.

Sincerely,

www.cabq.gov

Renée C. Brissette, P.E. CFM
Senior Engineer, Hydrology
Planning Department



City of Albuquerque

Planning Department

Development & Building Services Division

DRAINAGE AND TRANSPORTATION INFORMATION SHEET (REV 11/2018)

Project Title: _____ **Building Permit #:** _____ **Hydrology File #:** _____

DRB#: _____ **EPC#:** _____ **Work Order#:** _____

Legal Description: _____

City Address: _____

Applicant: _____ **Contact:** _____

Address: _____

Phone#: _____ **Fax#:** _____ **E-mail:** _____

Owner: _____ **Contact:** _____

Address: _____

Phone#: _____ **Fax#:** _____ **E-mail:** _____

TYPE OF SUBMITTAL: _____ PLAT (____# OF LOTS) _____ RESIDENCE _____ DRB SITE _____ ADMIN SITE

IS THIS A RESUBMITTAL?: _____ Yes _____ No

DEPARTMENT: _____ TRAFFIC/ TRANSPORTATION _____ HYDROLOGY/ DRAINAGE

Check all that Apply:

TYPE OF SUBMITTAL:

- _____ ENGINEER/ARCHITECT CERTIFICATION
- _____ PAD CERTIFICATION
- _____ CONCEPTUAL G & D PLAN
- _____ GRADING PLAN
- _____ DRAINAGE MASTER PLAN
- _____ DRAINAGE REPORT
- _____ FLOODPLAIN DEVELOPMENT PERMIT APPLIC
- _____ ELEVATION CERTIFICATE
- _____ CLOMR/LOMR
- _____ TRAFFIC CIRCULATION LAYOUT (TCL)
- _____ TRAFFIC IMPACT STUDY (TIS)
- _____ OTHER (SPECIFY) _____
- _____ PRE-DESIGN MEETING?

TYPE OF APPROVAL/ACCEPTANCE SOUGHT:


- _____ BUILDING PERMIT APPROVAL
- _____ CERTIFICATE OF OCCUPANCY
- _____ PRELIMINARY PLAT APPROVAL
- _____ SITE PLAN FOR SUB'D APPROVAL
- _____ SITE PLAN FOR BLDG. PERMIT APPROVAL
- _____ FINAL PLAT APPROVAL
- _____ SIA/ RELEASE OF FINANCIAL GUARANTEE
- _____ FOUNDATION PERMIT APPROVAL
- _____ GRADING PERMIT APPROVAL
- _____ SO-19 APPROVAL
- _____ PAVING PERMIT APPROVAL
- _____ GRADING/ PAD CERTIFICATION
- _____ WORK ORDER APPROVAL
- _____ CLOMR/LOMR
- _____ FLOODPLAIN DEVELOPMENT PERMIT
- _____ OTHER (SPECIFY) _____

DATE SUBMITTED: _____ **By:** _____

COA STAFF:

ELECTRONIC SUBMITTAL RECEIVED: _____

FEE PAID: _____

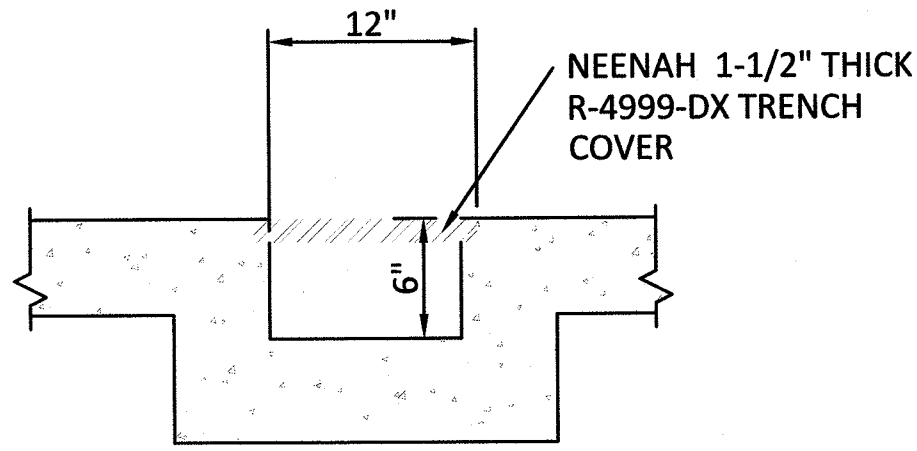

SIDEWALK CULVERT DETAIL

NTS

DRAINAGE CERTIFICATION

I, SCOTT M MCGEE, NMPE 10519, OF THE FIRM SCOTT M MCGEE PE, LLC, HEREBY CERTIFY THAT THIS SITE HAS BEEN GRADED AND WILL DRAIN IN SUBSTANTIAL COMPLIANCE WITH THE DESIGN INTENT OF THE APPROVED PLAN DATED 11/17/20. THE RECORD INFORMATION EDITED ONTO THE ORIGINAL PLAN WAS OBTAINED BY BRIAN J MARTINEZ, NMPLS # 18374, OF CARTESIAN SURVEYS. I ALSO CERTIFY THAT I VISITED THE SITE ON 8/01/21 AND HAVE DETERMINED BY VISUAL INSPECTION THAT THE SURVEY DATA PROVIDED IS REPRESENTATIVE OF ACTUAL SITE CONDITIONS AND IS TRUE AND CORRECT TO THE BEST OF MY KNOWLEDGE AND BELIEF. THIS CERTIFICATION IS SUBMITTED IN SUPPORT OF A REQUEST FOR A PERMANENT CERTIFICATE OF OCCUPANCY.

THE RECORD INFORMATION SHOWN HEREON IS NOT NECESSARILY COMPLETE AND IS ONLY INTENDED TO VERIFY SUBSTANTIAL COMPLIANCE OF THE GRADING/ DRAINAGE ASPECTS OF THIS PROJECT. THOSE RELYING ON THIS RECORD DOCUMENT ARE ADVISED TO OBTAIN INDEPENDENT ACCURACY VERIFICATION BEFORE USING IT FOR ANY PURPOSE.

Scott M McGee 8-3-21
SCOTT M MCGEE, NMPE 10519



City of Albuquerque
Planning Department
Development Review Services
HYDROLOGY SECTION
APPROVED
DATE: 12/04/20
BY: *Renee C. Brissette*
HydroTrans # M09D031A
THE APPROVAL OF THESE PLANS/REPORT SHALL NOT BE CONSTRUED TO PERMIT VIOLATIONS OF ANY CITY ORDINANCE OR STATE LAW, AND SHALL NOT PREVENT THE CITY OF ALBUQUERQUE FROM REQUIRING CORRECTION, OR ERROR OR DIMENSIONS IN PLANS, SPECIFICATIONS, OR CONSTRUCTIONS. SUCH APPROVED PLANS SHALL NOT BE CHANGED, MODIFIED OR ALTERED WITHOUT AUTHORIZATION.



VICINITY MAP

M-9

LEGEND

- EXISTING CONTOURS
- NEW CONTOUR
- FF=5090.71 PROPOSED BUILDING FINISH FLOOR ELEV
- FF=4973.00
- ◆ 36.5 NEW SPOT ELEVATION
- NEW CONSTRUCTION
- DS DOWNSPOUT
- TC TOP OF CURB
- × 89.6 AS-BUILT ELEVATION

KEYED NOTES

- A. INSTALL NEW 12" SIDEWALK CULVERT.

DRAINAGE ANALYSIS

LEGAL: Tract 12-B-1-B, El Rancho Grande I, Albuquerque, NM
ADDRESS: 8801 GIBSON BLVD SW
SITE AREA: 4.88 acres
PROJECT AREA = 180'x215' = 38,700 SF (0.89 AC)
BENCHMARK: City of Albuquerque Station '10_M9' being an aluminum disc
ELEV= 5082.551 (NAVD 1988)

SURVEYOR: CSI-Cartesian Surveys Inc. dated September 2020

PRECIPITATION ZONE: 1

FLOOD HAZARD: From FEMA Map 35001C0336H (dated 8/16/2012), this site is identified as being within Zone 'X' which is determined to be outside the 0.2% chance annual floodplain.

EXISTING CONDITIONS: The existing site is developed with a single classroom building, paved parking lot and drop-off drive aisle, and xeric landscaping. It slopes from the west down to the east at approximately 3%. There are 2 onsite detention ponding areas located east and west of the existing building.

PROPOSED IMPROVEMENTS: The proposed improvements include an 11,980 SF classroom building with several sports courts west of the building. The existing parking will be sufficient to support the new building.

DRAINAGE APPROACH: The drainage plan will equally split the roof flows to both the east and west sides of the building. A landscaped retention pond is proposed north of the building to store the east half of the roof. Developed roof and sports court runoff will discharge via surface flow to the southwest of the building where an existing pond will be enlarged to retain the needed SWQ volume.

Existing land treatment: 100% C (previously disturbed)
 $Q = (2.87)(0.89) = 2.55$ CFS

Proposed land treatment: 45% C and 55% D
 $Q = [(0.45)(2.87) + (0.55)(4.37)](0.89) = 3.3$ CFS

Storm water quality volume (SWQV) is based on 0.42" rain over the impervious area giving -- $V = (21,260)(0.42/12) = 744$ CF
The depressed landscape ponds provide a total of 1,190 CF onsite retention storage volume at 0.5-0.8' depth.

