

CITY OF ALBUQUERQUE

Planning Department
Brennon Williams, Director



Mayor Timothy M. Keller

July 13, 2020

Shawn Biazar
SBS Construction and Engineering
10209 Snowflake Ct. NW
Albuquerque, NM 87114

RE: DKG Roofing
7000 Huseman Pl SW
Permanent C.O. - Accepted
Engineer's Certification Date: 03/13/20
Engineer's Stamp Date: 05/09/19
Hydrology File: M10D016J

Dear Mr. Biazar:

PO Box 1293

Based on the Certification re-submitted 07/9/20 and site visit on 07/10/20, this certification is approved Permanent Release of Occupancy by Hydrology.

Albuquerque

If you have any questions, please contact me at 924-3986 or earmijo@cabq.gov.

Sincerely,

NM 87103

www.cabq.gov

Ernest Armijo, P.E.
Principal Engineer, Planning Dept.
Development Review Services



City of Albuquerque

Planning Department
Development & Building Services Division

DRAINAGE AND TRANSPORTATION INFORMATION SHEET (REV 6/2018)

Project Title: DKG ROOFING INC. **Building Permit #:** _____ **Hydrology File #:** M10D016J
DRB#: _____ **EPC#:** _____ **Work Order#:** _____
Legal Description: LOT 12 COORS-ARENAL INDUSTRIAL PARK
City Address: 7000 HUSEMAN PLACE, SW

Applicant: SBS CONSTRUCTION AND ENGINEERING, LLC **Contact:** SHAWN BIAZAR
Address: 10209 SNOWFLAKE CT., NW, ALBUQUERQUE, NM 87114
Phone#: (505) 804-5013 **Fax#:** (505) 897-4996 **E-mail:** AECLLC@AOL.COM

Other Contact: _____ **Contact:** _____
Address: _____
Phone#: _____ **Fax#:** _____ **E-mail:** _____

TYPE OF DEVELOPMENT: _____ PLAT (# of lots) _____ RESIDENCE _____ DRB SITE ☒ ADMIN SITE

IS THIS A RESUBMITTAL? _____ Yes ☒ No

DEPARTMENT _____ TRANSPORTATION ☒ HYDROLOGY/DRAINAGE

Check all that Apply:

TYPE OF SUBMITTAL:

- ☒ ENGINEER/ARCHITECT CERTIFICATION
☐ PAD CERTIFICATION
☐ CONCEPTUAL G & D PLAN
☒ GRADING PLAN
☐ DRAINAGE REPORT
☐ DRAINAGE MASTER PLAN
☐ FLOODPLAIN DEVELOPMENT PERMIT APPLIC
☐ ELEVATION CERTIFICATE
☐ CLOMR/LOMR
☐ TRAFFIC CIRCULATION LAYOUT (TCL)
☐ TRAFFIC IMPACT STUDY (TIS)
☐ STREET LIGHT LAYOUT
☐ OTHER (SPECIFY) _____
☐ PRE-DESIGN MEETING?

TYPE OF APPROVAL/ACCEPTANCE SOUGHT:

- ☐ BUILDING PERMIT APPROVAL
☒ CERTIFICATE OF OCCUPANCY
☐ PRELIMINARY PLAT APPROVAL
☐ SITE PLAN FOR SUB'D APPROVAL
☐ SITE PLAN FOR BLDG. PERMIT APPROVAL
☐ FINAL PLAT APPROVAL
☐ SIA/ RELEASE OF FINANCIAL GUARANTEE
☐ FOUNDATION PERMIT APPROVAL
☐ GRADING PERMIT APPROVAL
☐ SO-19 APPROVAL
☐ PAVING PERMIT APPROVAL
☐ GRADING/ PAD CERTIFICATION
☐ WORK ORDER APPROVAL
☐ CLOMR/LOMR
☐ FLOODPLAIN DEVELOPMENT PERMIT
☐ OTHER (SPECIFY) _____

DATE SUBMITTED: 03-18-2020 **By:** SHAWN BIAZAR

COA STAFF:

ELECTRONIC SUBMITTAL RECEIVED: _____

FEE PAID: _____

Location
LOT 12, COOR-ARENAL INDUSTRIAL PARK SUBDIVISION, is located at 7000 Huseman Place, SW containing 0.9856 acre. See attached portion of Vicinity Map M-10-Z for exact location.

Purpose
The purpose of this drainage report is to present a grading and drainage solution for new buildings and improvement for LOT 12, COOR-ARENAL INDUSTRIAL PARK SUBDIVISION.

Existing Drainage Conditions
This lot is very flat and drains north into Huseman Place, SW and no other offsite flows enters this site. There are existing gravel on site and some grading has been done.

Proposed Conditions and On-Site Drainage Management Plan
We are proposing to retain all the developed flow. The total volume requirement under this condition is 10,178.64 CF. We are proposing a total of five ponds (A-E) with total volume provided of 11,832.68 CF which includes the first flush volume requirement of 912.32 CF.

VOLUME CALCULATIONS FOR 10 DAY STORM
(UNDER PROPOSED CONDITIONS)

BASIN	AREA (SF)	AREA (AC)	AREA (MI ²)
ON-SITE	42,932.74	0.9856	0.001540

$$E = \frac{EA(AA) + EB(AB) + EC(AC) + ED(AD)}{AA + AB + AC + AD}$$

$$V-360 = E(AA + AB + AC + AD)$$

EA = 0.44
EB = 0.67
EC = 0.99
ED = 1.97

AA = 0.00%
AB = 25.00%
AC = 0.00%
AD = 75.00%

P-60 = 2.01
P-360 = 2.35
P-1440 = 2.75
P-10 Day = 3.95

E = 1.6450 IN
V-360 = 0.1351 AC-FT
AD = 0.7392 AC
V-10 DAY = 0.2337 AC-FT
V-10 DAY = 10,178.64 CF

V (REQUIRED) = 10,178.64 CF

PONDING VOLUME REQUIREMENTS (90TH PERCENTILE/FIRST FLUSH)

VOLUME REQUIRED = 0.34 INCHES x IMPERVIOUS AREA =
(0.34/12 x 32,199.55) = 912.32 CF

PONDING VOLUME CALCULATION

TOTAL POND AREA PROVIDED =
PONDING CALCULATIONS:

POND A:
AREA @ ELEV. 84.00 = 3196.00 SF
AREA @ ELEV. 83.50 = 7.07 SF
POND VOLUME=(3196.00+7.07)/2*0.50=800.77 CF


POND B:
AREA @ ELEV. 84.00 = 5310.09 SF
AREA @ ELEV. 83.50 = 7.07 SF
POND VOLUME=(5310.09+7.07)/2*0.50=1329.29 CF

POND C:
AREA @ ELEV. 84.00 = 3243.32 SF
AREA @ ELEV. 83.50 = 510.70 SF
AREA @ ELEV. 83.00 = 297.72 SF
AREA @ ELEV. 81.00 = 120.24 SF
POND VOLUME=(938.51+202.11+417.96)= 1558.57 CF

POND D:
AREA @ ELEV. 84.00 = 3417.78 SF
AREA @ ELEV. 83.50 = 7.07 SF
POND VOLUME=(3417.78+7.07)/2*0.50= 856.21 CF

POND E:
AREA @ ELEV. 84.00 = 4344.91 SF
AREA @ ELEV. 83.50 = 1945.92 SF
AREA @ ELEV. 83.00 = 1784.68 SF
AREA @ ELEV. 79.00 = 1229.25 SF
POND VOLUME=(1572.71+932.65+4782.48)= 7287.84 CF


TOTAL PONDING VOLUME PROVIDED =
800.77 +1329.29 + 1558.57 + 856.21 + 7287.84 = 11,832.68 CF

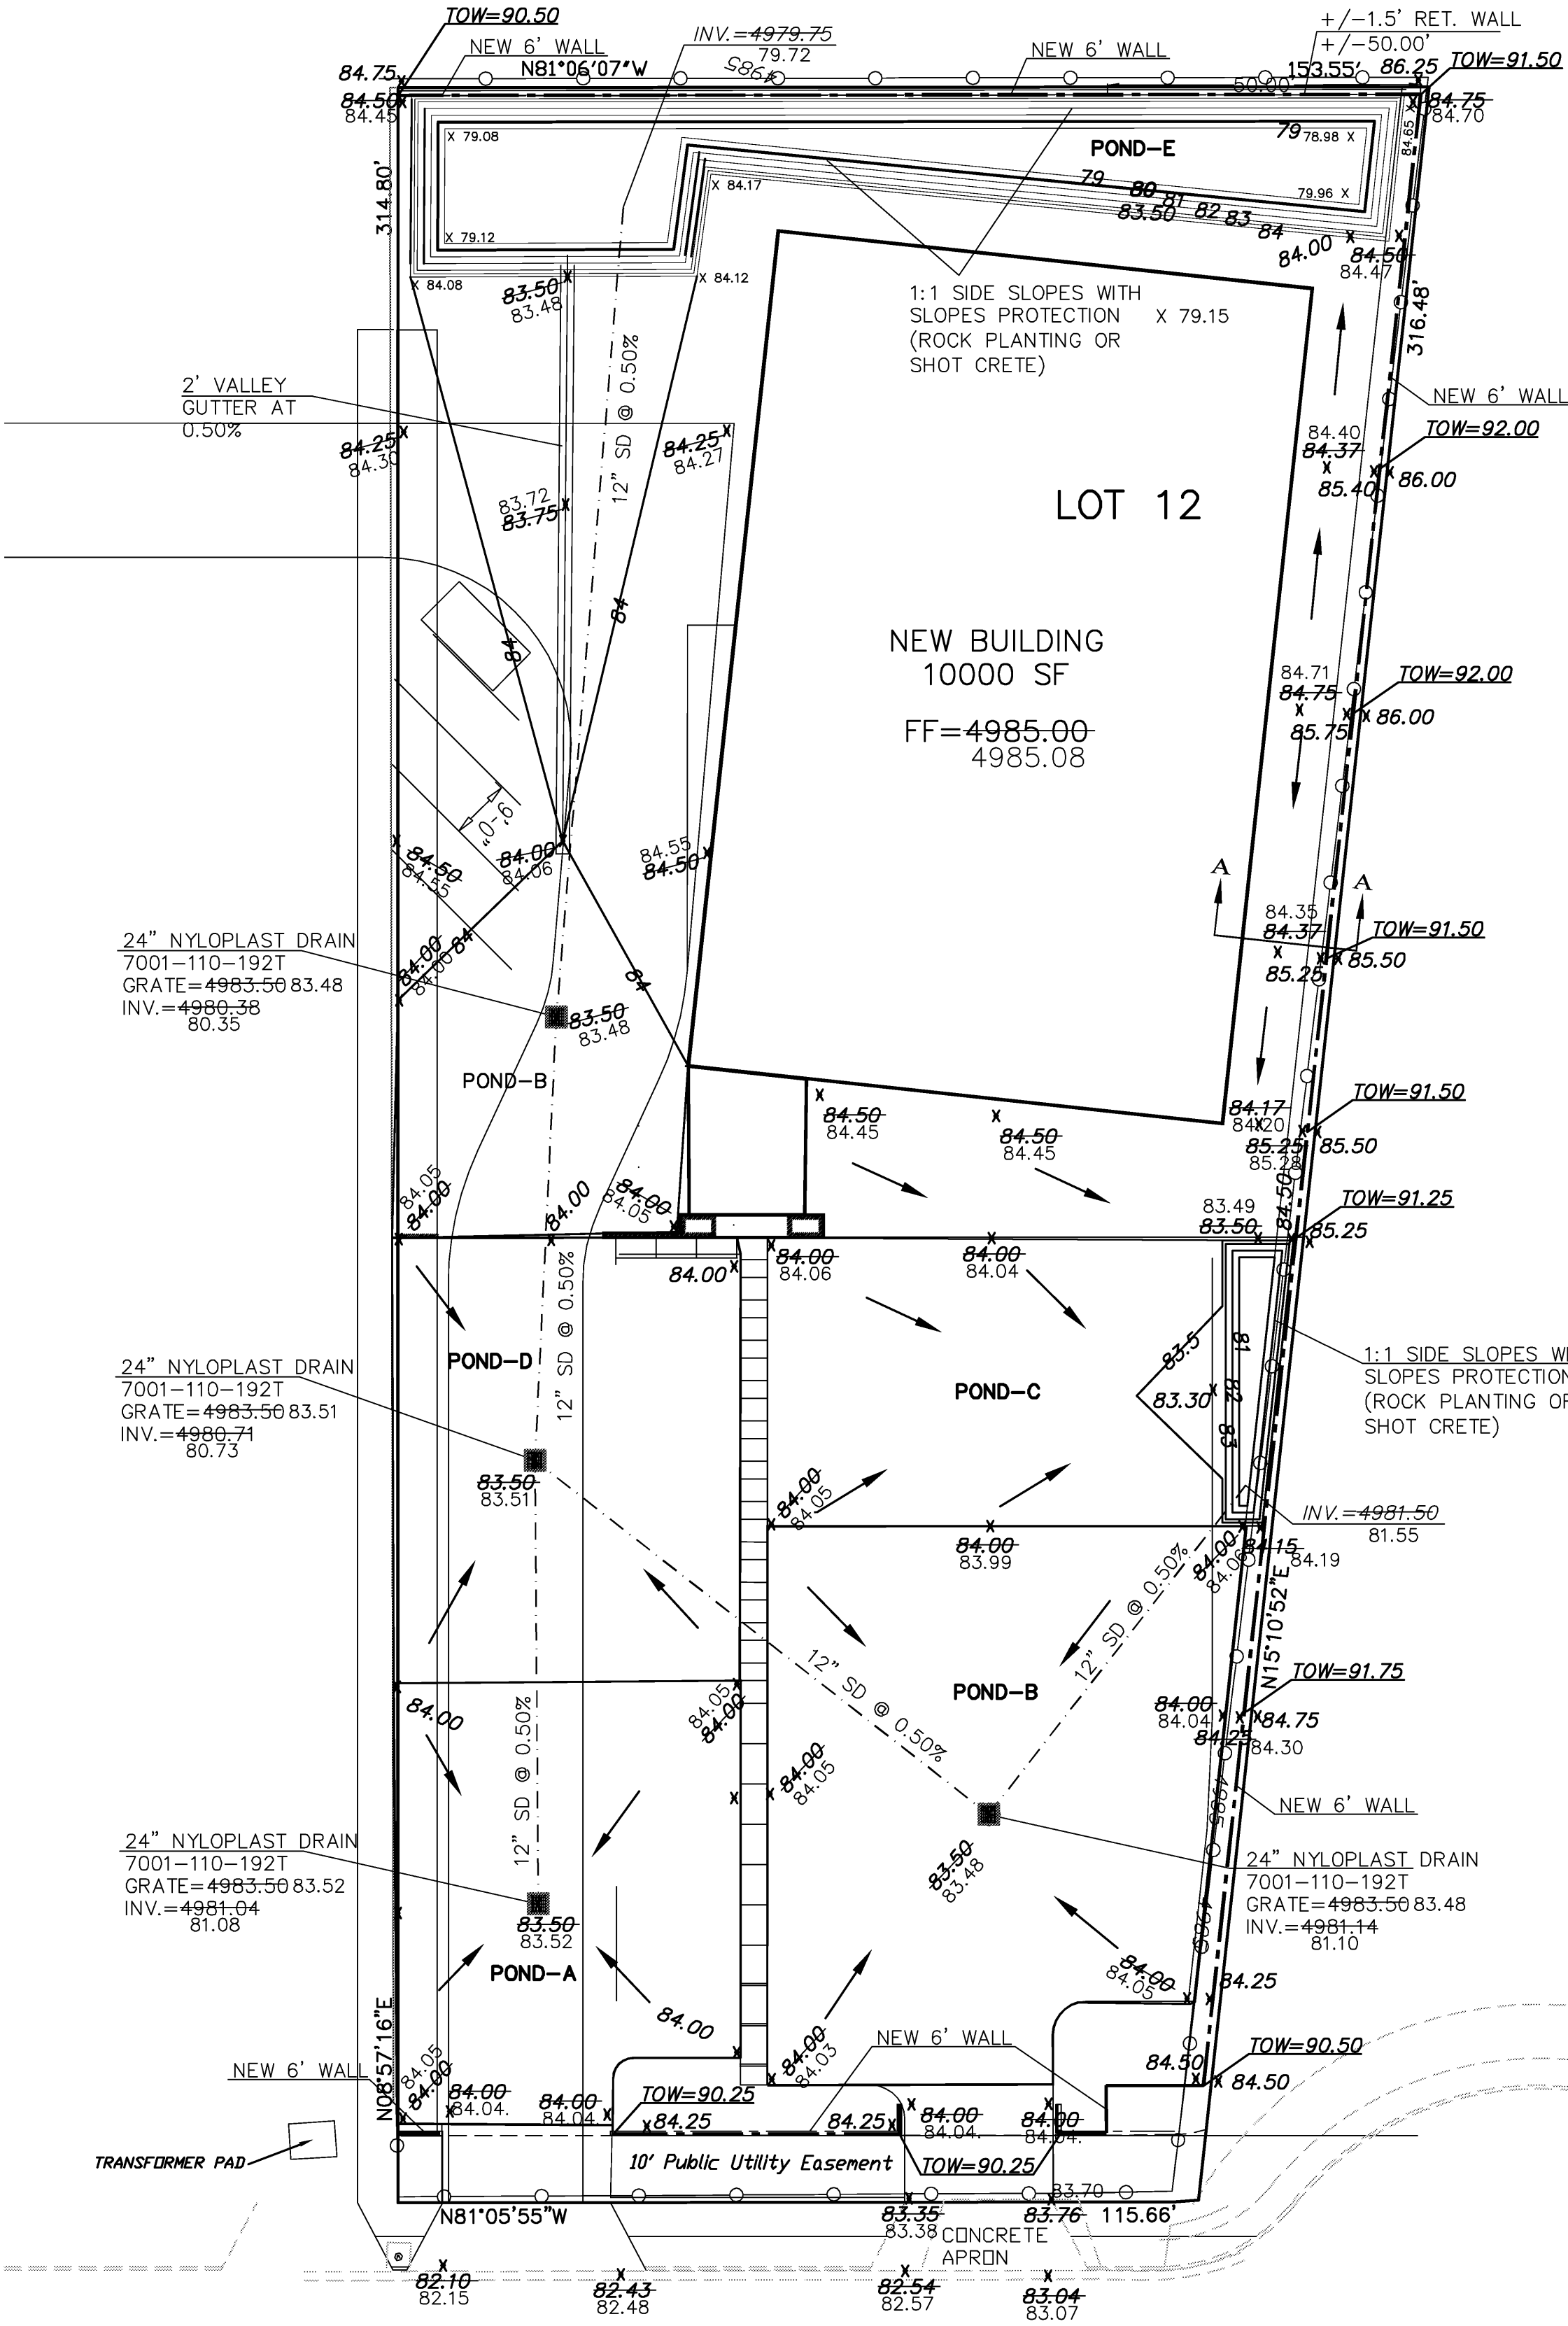

HUSEMAN PLACE, SW

GENERAL NOTES:

- 1: CONTOUR INTERVAL IS HALF (1.00) FOOT.
- 2: UTILITIES SHOWN HEREON ARE IN THEIR APPROXIMATE LOCATION BASED ONLY ON ABOVE GROUND EVIDENCE FOUND IN THE FIELD AND AS-BUILT INFORMATION PROVIDED BY THE CLIENT. UTILITIES SHOWN HEREON, WHETHER INDICATED AS ABANDONED OR NOT, SHALL BE VERIFIED BY OTHERS FOR EXACT LOCATION AND/ OR DEPTH PRIOR TO EXCAVATION OR DESIGN CONSIDERATIONS.
- 3: THIS IS NOT A BOUNDARY SURVEY, BEARINGS ARE ASSUMED, DISTANCES AND FOUND PROPERTY CORNERS ARE FOR INFORMATIONAL PURPOSES ONLY.
- 4: SLOPES ARE AT 3:1 MAXIMUM UNLESS NOTED.
- 5: ELEVATIONS ARE BASED ON CITY OF ALBUQUERQUE CONTROL STATION 9_M11, HAVING AN ELEVATION OF 4957.54 FEET ABOVE SEA LEVEL.
- 6: ADD 4900 TO ALL PROPOSED SPOT ELEVATIONS.

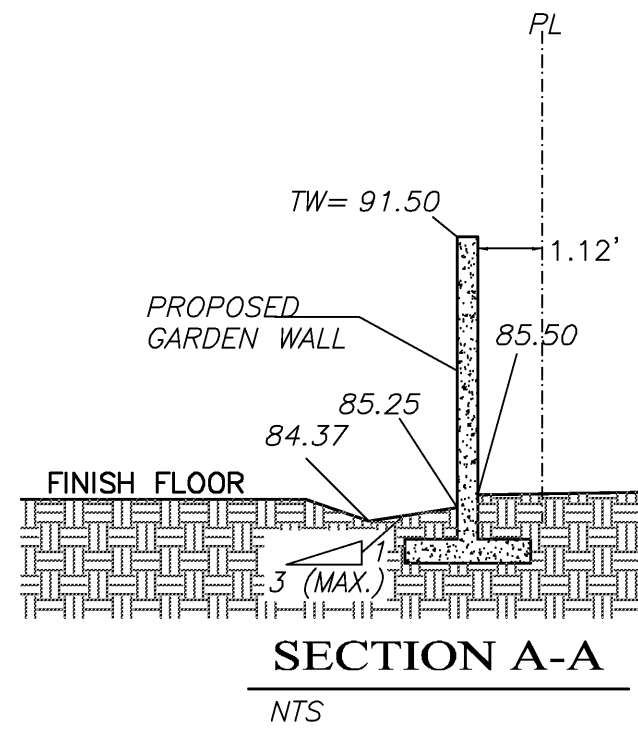


DRAINAGE CERTIFICATION

I, REZA AFAGHPUR, NMPE 11814, OF SBS CONSTRUCTION AND ENGINEERING, LLC, HEREBY CERTIFY THAT THIS PROJECT HAS BEEN GRADED AND WILL DRAIN IN SUBSTANTIAL COMPLIANCE WITH AND IN ACCORDANCE WITH THE DESIGN INTENT OF THE APPROVED PLAN DATED 05-19-2019. THE RECORD INFORMATION EDITED ONTO THE ORIGINAL DESIGN DOCUMENT HAS BEEN OBTAINED BY NMPS 9801 LEONARD MARTINEZ, OF SBS CONSTRUCTION AND ENGINEERING. I FURTHER CERTIFY THAT I HAVE PERSONALLY VISITED THE PROJECT SITE ON AND HAVE DETERMINED BY VISUAL INSPECTION THAT THE SURVEY DATA PROVIDED IS REPRESENTATIVE OF ACTUAL SITE CONDITIONS AND IS TRUE AND CORRECT TO THE BEST OF MY KNOWLEDGE AND BELIEF. THIS CERTIFICATION IS SUBMITTED IN SUPPORT OF A REQUEST FOR FINAL CERTIFICATE OF OCCUPANCY.


THE RECORD INFORMATION PRESENTED HEREON IS NOT NECESSARILY COMPLETE AND INTENDED ONLY TO VERIFY SUBSTANTIAL COMPLIANCE OF THE GRADING AND DRAINAGE ASPECTS OF THIS PROJECT. THOSE RELYING ON THIS RECORD DOCUMENT ARE ADVISED TO OBTAIN INDEPENDENT VERIFICATION OF ITS ACCURACY BEFORE USING IT FOR ANY OTHER PURPOSE.

REZA AFAGHPUR, NMPE 11814
03/13/2020
DATE

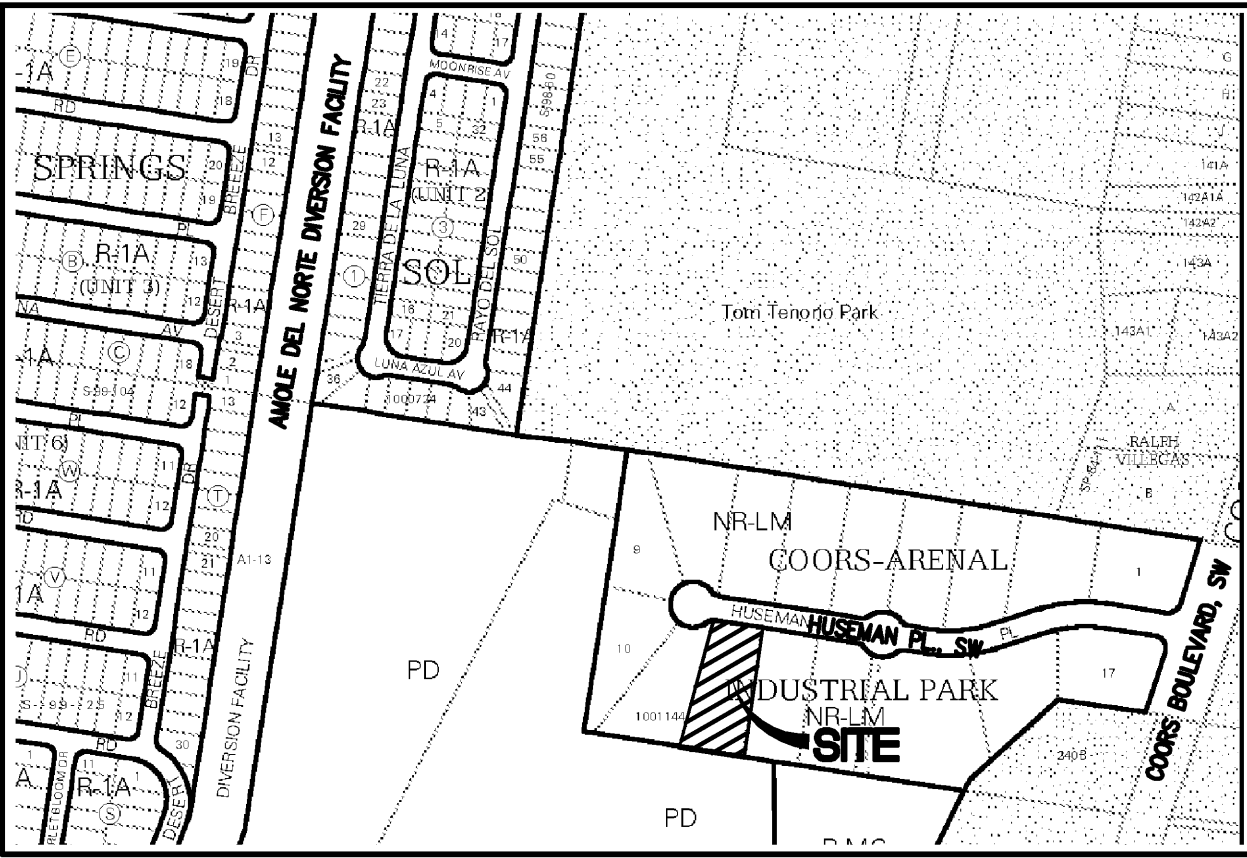

VICINITY MAP:

M-10-Z

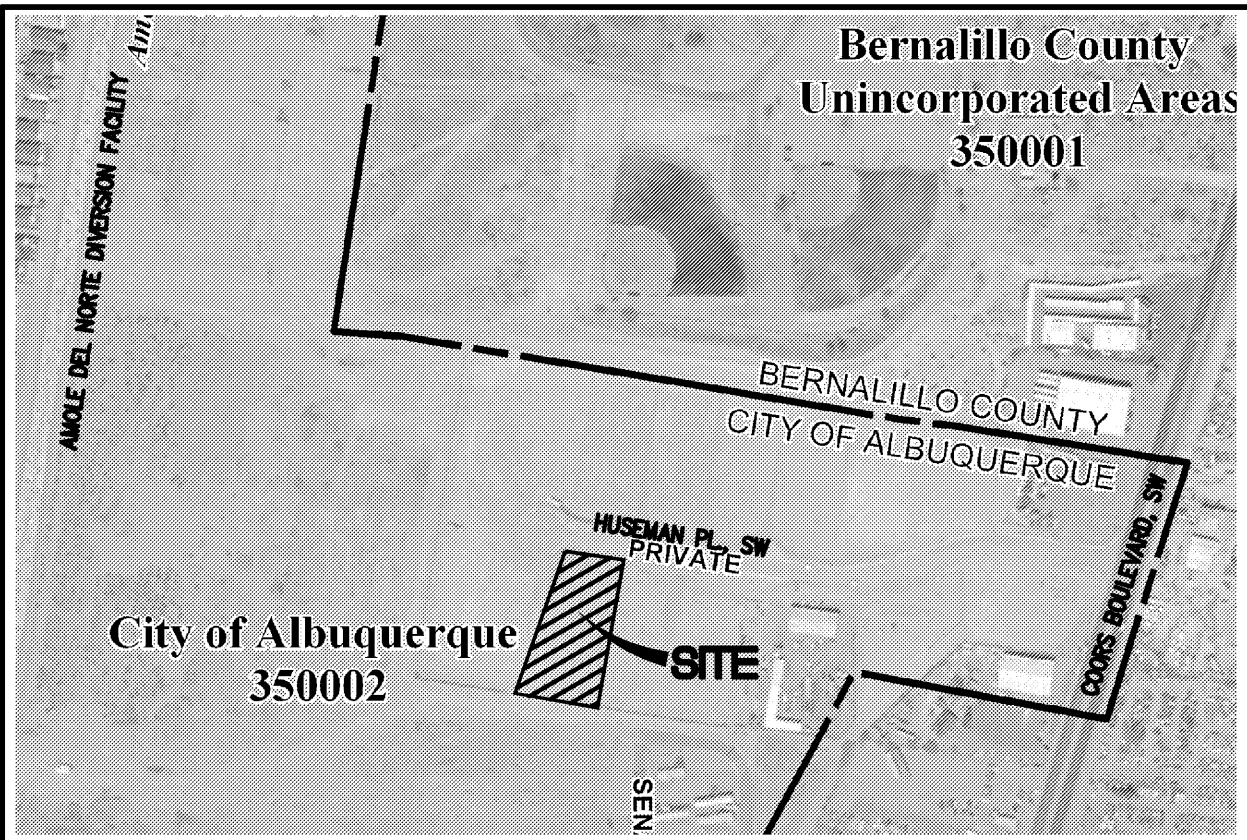

FIRM MAP:
EFFECTIVE DATE:

35001C0337G
09-26-2008


LEGAL DESCRIPTION:

LOT 12, COOR-ARENAL INDUSTRIAL PARK SUBDIVISION
CONTAINING 0.9856 ACRE
ADDRESS: 7000 HUSEMAN PLACE, SW

LEGEND

- BOUNDARY LINE
- EASEMENT LINE
- EXISTING SEWER
- EXISTING STORM DRAIN
- EXISTING CURB & GUTTER
- PROPOSED WALL
- EXISTING SIDEWALK
- EXISTING FIRE HYDRANT
- EXISTING WATER SERVICE
- EXISTING DROP INLET

GRAPHIC SCALE

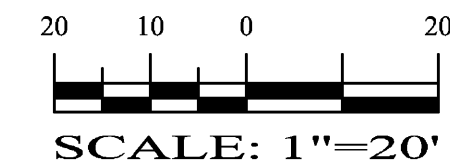

DKG ROOFING, INC
7000 HUSEMAN PLACE, SW
GRADING PLAN

DRAWING:	DRAWN BY:	DATE:	SHEET #
201827-GD.DWG	SDR	10/29/2017	1