


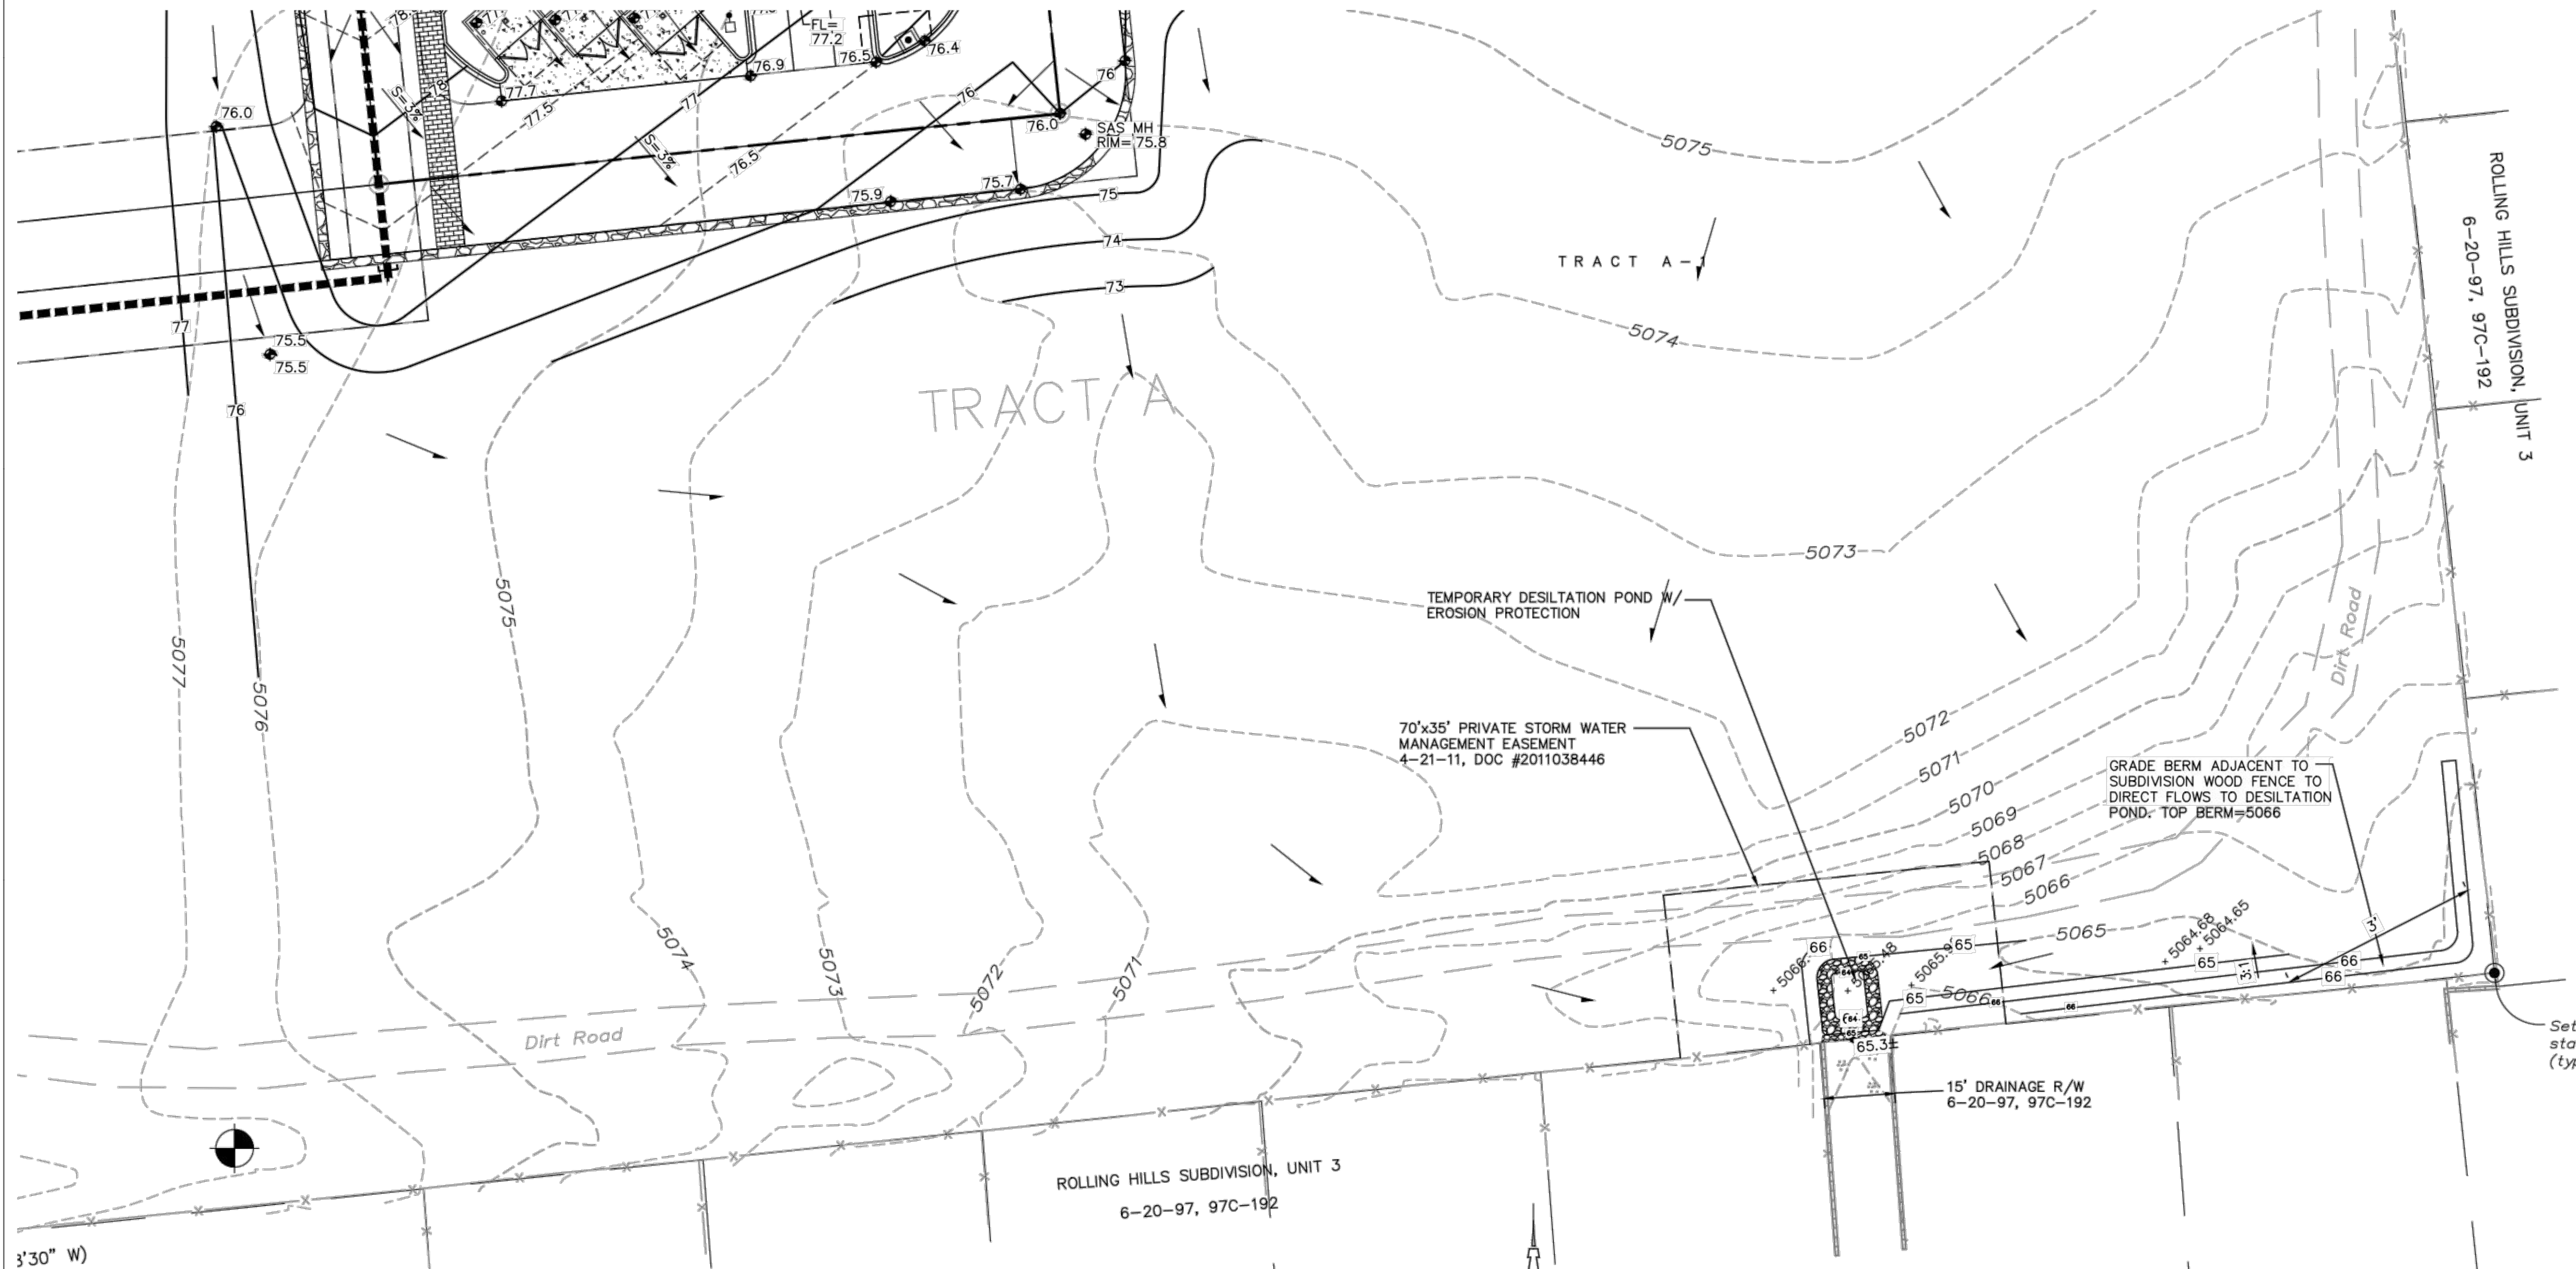


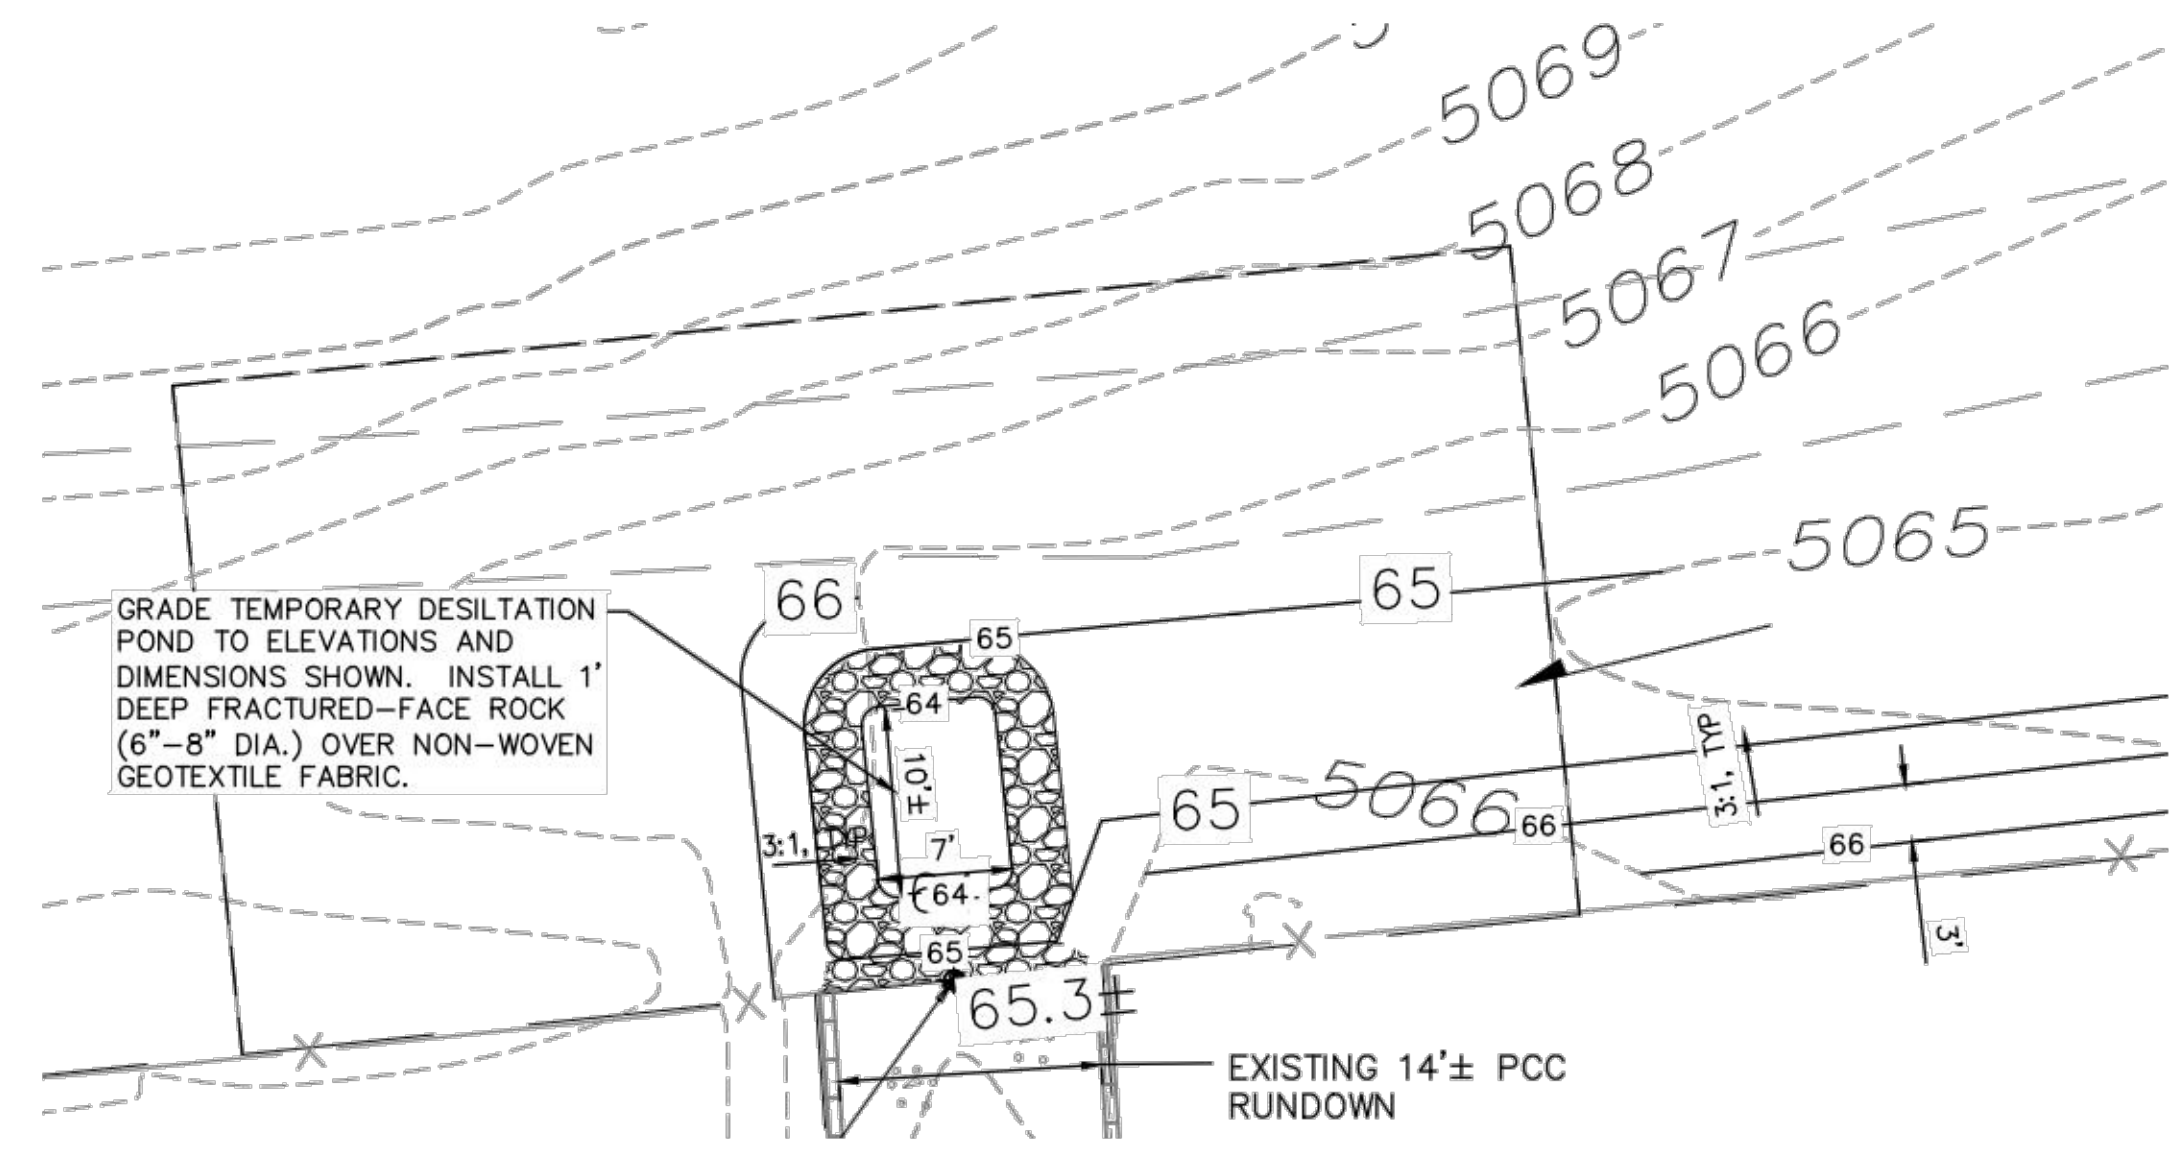

OFFSITE DRAINAGE PLAN

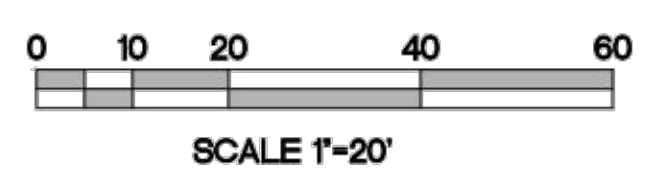


DESILTATION POND DETAIL

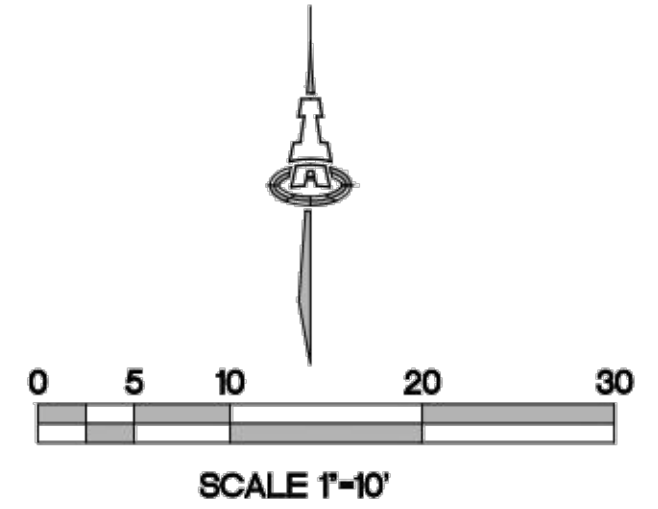

LEGEND

- 5065--- EXISTING CONTOUR - 1' INTERVAL
- 67--- PROPOSED CONTOUR - 1' INTERVAL
- 78.3 PROPOSED SPOT ELEVATION
- FLOW ARROW

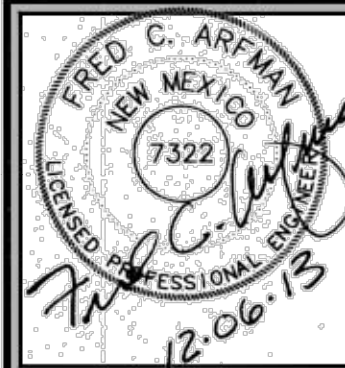

ISAACSON & ARFMAN, P.A.
Consulting Engineering Associates
128 Monroe Street N.E.
Albuquerque, New Mexico 87108
Ph. 505-268-8828 www.isaacson.com

This design, calculations, and concepts are owned by and remain the property of Isaacson & Arfman, P.A. and no part thereof shall be utilized by any person, firm or corporation for any purpose whatsoever except with the written permission of Isaacson & Arfman, P.A. ©

FAMILY DOLLAR STORE
SAGE RD AND UNSER BLVD
THE HUTTON COMPANY

OFFSITE DESILTATION POND

Date:	No.	Revised:	Date:	Job No.
11-02-2012				1886
Drawn By:				PAGE
ANW				
Chd By:				CG-201
FCA				