CITY OF ALBUQUERQUE



Planning Department Transportation Development Services

September 2, 2015

Troy Kelts Merrick & Company 5970 Greenwood Plaza Blvd., Greenwood Village, CO 80015

Re:

Chick-fil-A Gibson, 1600 Gibson Blvd. SE Traffic Circulation Layout - Revised

Engineer's Stamp Dated 7-29-15 (M15-D012C)

Dear Mr. Kelts,

The TCL submittal received 8-31-15 is approved for Building Permit. A copy of the stamped and signed plan will be needed for each of the building permit plans. Please keep the original to be used for certification of the site for final C.O. for Transportation.

PO Box 1293

Additionally, a Certificate of Occupancy will not be issued until the work order is completed for the required work on University Boulevard as shown as part of the Traffic Impact Study dated May 12, 2015. Work Order drawings shall include striping work and median work necessary for extension of the northbound left-turn lane onto University Boulevard and the center dual left-turn lane north of Driveway "A" as shown on Page A-48 (Attached).

Albuquerque

New Mexico 87103

When the site construction is completed and a Certificate of Occupancy (C.O.) is requested, use the original City stamped approved TCL for certification. Redline any minor changes and adjustments that were made in the field. A NM registered architect or engineer must stamp, sign, and date the certification TCL along with indicating that the development was built in "substantial compliance" with the TCL. Submit this certification TCL with a completed <u>Drainage and Transportation Information Sheet</u> to front counter personnel for log in and evaluation by Transportation.

www.cabq.gov

Once verification of certification is completed and approved, notification will be made to Building Safety to issue Final C.O. To confirm that a final C.O. has been issued, call Building Safety at 924-3690.

Sincerely,

Racquel M. Michel, P.E.

Traffic Engineer, Planning Dept. Development Review Services

\gs

via: email

Č:

CO Clerk, File



City of Albuquerque

Planning Department

Development & Building Services Division DRAINAGE AND TRANSPORTATION INFORMATION SHEET

(REV 02/2013)

Project Title: Chick-fil-A at Gibson	Building Permit #: 201493225 City Drainage #: 4/500/
	Work Order#:
Legal Description: See Attached	
City Address: 1600 Gibson Blvd SE	
Engineering Firm: Merrick & Company	Contact: Troy Kelts
Address: 5970 Greenwood Plaza Blvd, Greenwo	ood Village, CO 80015
Phone#: 303-751-0741 Fax#: 303-	
Owner: Chick-fil-A	Contact: Don Ikler
Address: 15635 Alton Parkway, Irvine, CA 303-	
Phone#: 404-305-4407 Fax#:	E-mail: don.ikeler@chick-fil-a.com
Architect: CRHO	Contact: Kimanh Nguyen
Address: 195 South "C" Street 200, Turstin, CA	92780
Phone#: 714-832-1834 Fax#:	E-mail: kimanh@CRHO.com
Surveyor: Surv-Tek Inc	Contact: Russ Hugg
Address: 9384 Valley View Drive	
Phone#: 505-897-3366 Fax#:	E-mail: russhugg@survtek.com
Contractor:	Contact:
Address:	
Phone#: Fax#:	E-mail:
TYPE OF SUBMITTAL:	CHECK TYPE OF APPROVAL/ACCEPTANCE SOUGHT:
DRAINAGE REPORT	SIA/FINANCIAL GUARANTEE RELEASE
DRAINAGE PLAN 1st SUBMITTAL	PRELIMINARY PLAT APPROVAL
DRAINAGE PLAN RESUBMITTAL	S. DEV. PLAN FOR SUB'D APPROVAL S. DEV. FOR BLDG. PERMIT APPROVAL
CONCEPTUAL G & D PLAN	
GRADING PLAN	SECTOR PLAN APPROVAL
EROSION & SEDIMENT CONTROL PLAN (ESC)	FINAL PLAT APPROVAL
ENGINEER'S CERT (HYDROLOGY)	CERTIFICATE OF OCCUPANCY (PERM)
X TRAFFIC CIRCULATION LAYOUT (TCL)	CERTIFICATE OF OCCUPANCY (TCL TEMP)
X TRAFFIC CIRCULATION LAYOUT (TCL) ENGINEER'S CERT (TCL) Revision	FOUNDATION PERMIT APPROVAL
ENGINEER'S CERT (TCL) ENGINEER'S CERT (DRB SITE PLAN)	BUILDING PERMIT APPROVAL
ENGINEER'S CERT (ESC)	GRADING PERMIT APPROVAL SO-19 APPROVAL
SO-19	PAVING PERMIT APPROVAL ESC PERMIT APPROVAL
OTHER (SPECIFY)	WORK ORDER APPROVAL GRADING CERTIFICATION ESC CERT. ACCEPTANCE OTHER (SPECIFY)
OTHER (SIECIFT)	GRADING CERTIFICATION OTHER (SPECIFY)
-	X Yes No Copy Provided
DATE SUBMITTED: 8/31/15	By: Ryan Robinson

Requests for approvals of Site Development Plans and/or Subdivision Plats shall be accompanied by a drainage submittal. The particular nature, location, and scope to the proposed development defines the degree of drainage detail. One or more of the following levels of submittal may be required based on the following

- 1. Conceptual Grading and Drainage Plan: Required for approval of Site Development Plans greater than five (5) acres and Sector Plans
- 2. Drainage Plans: Required for building permits, grading permits, paving permits and site plans less than five (5) acres
- 3. Drainage Report: Required for subdivision containing more than ten (10) lots or constituting five (5) acres or more
- 4. Erosion and Sediment Control Plan: Required for any new development and redevelopment site with 1-acre or more of land disturbing area, including project less than 1-acre than are part of a larger common plan of development



City of Albuquerque

Planning Department

Development & Building Services Division


DRAINAGE AND TRANSPORTATION INFORMATION SHEET


(REV 02/2013)

Project Title: Chick-fil-A at Gibson	Building Permit #: 201493225 City Drainage #:	
DRB#: 1010060 EPC#:		
Legal Description: See Attached		
City Address: 1600 Gibson Blvd SE		
E	Contract Tray Valta	
Engineering Firm: Merrick & Company Address: 5970 Greenwood Plaza Blvd, Gree	Contact: Troy Kelts	
Phone#: 303-751-0741 Fax#: 3		
1 Holicii. 303-131-0141 1 1 dani. 2	D-man. droy.kerts@memex.com	
Owner: Chick-fil-A	Contact: Don Ikler	
Address: 15635 Alton Parkway, Irvine, CA		
Phone#: 404-305-4407 Fax#:	E-mail: don.ikeler@chick-fil-a.com	
Architect: CRHO	Contact: Kimanh Nguyen	
Address: 195 South "C" Street 200, Turstin,		
	E-mail: kimanh@CRHO.com	
		
Surveyor: Surv-Tek Inc	Contact: Russ Hugg	
Address: <u>9384 Valley View Drive</u> Phone#: <u>505-897-3366</u> Fax#:	E-mail: russhugg@survtek.com	
Phone#: 303-897-3300 Fax#:	E-maii: russnugg@survtek.com	
Contractor:	Contact:	
Address:		
Phone#: Fax#:	E-mail:	
TYPE OF SUBMITTAL:	CHECK TYPE OF APPROVAL/ACCEPTANCE SOUGHT:	
DRAINAGE REPORT	SIA/FINANCIAL GUARANTEE RELEASE	
DRAINAGE PLAN 1st SUBMITTAL	PRELIMINARY PLAT APPROVAL	
DRAINAGE PLAN RESUBMITTAL	S. DEV. PLAN FOR SUB'D APPROVAL	
CONCEPTUAL G & D PLAN	S. DEV. FOR BLDG. PERMIT APPROVAL	
GRADING PLAN	SECTOR PLAN APPROVAL	
EROSION & SEDIMENT CONTROL PLAN (ESC	FINAL PLAT APPROVAL	
ENGINEER'S CERT (HYDROLOGY)	CERTIFICATE OF OCCUPANCY (PERM)	
CLOMR/LOMR	CERTIFICATE OF OCCUPANCY (TCL TEMP)	
\overline{X} TRAFFIC CIRCULATION LAYOUT (TCL)	FOUNDATION PERMIT APPROVAL	
ENGINEER'S CERT (TCL) Revision	BUILDING PERMIT APPROVAL	
ENGINEER'S CERT (DRB SITE PLAN)	GRADING PERMIT APPROVAL SO-19 APPROVAL	
ENGINEER'S CERT (ESC)	PAVING PERMIT APPROVAL ESC PERMIT APPROVAL	
SO-19	WORK ORDER APPROVAL ESC CERT. ACCEPTANCE	
OTHER (SPECIFY)	GRADING CERTIFICATION OTHER (SPECIFY)	
WAS A PRE-DESIGN CONFERENCE ATTENDED:	X Yes No Copy Provided	
DATE SUBMITTED: 8/31/15		

Requests for approvals of Site Development Plans and/or Subdivision Plats shall be accompanied by a drainage submittal. The particular nature, location, and scope to the proposed development defines the degree of drainage detail. One or more of the following levels of submittal may be required based on the followin

- Conceptual Grading and Drainage Plan: Required for approval of Site Development Plans greater than five (5) acres and Sector Plans
- Drainage Plans: Required for building permits, grading permits, paving permits and site plans less than five (5) acres Drainage Report: Required for subdivision containing more than ten (10) lots or constituting five (5) acres or more
- Erosion and Sediment Control Plan: Required for any new development and redevelopment site with 1-acre or more of land disturbing area, including project less than 1-acre than are part of a larger common plan of development

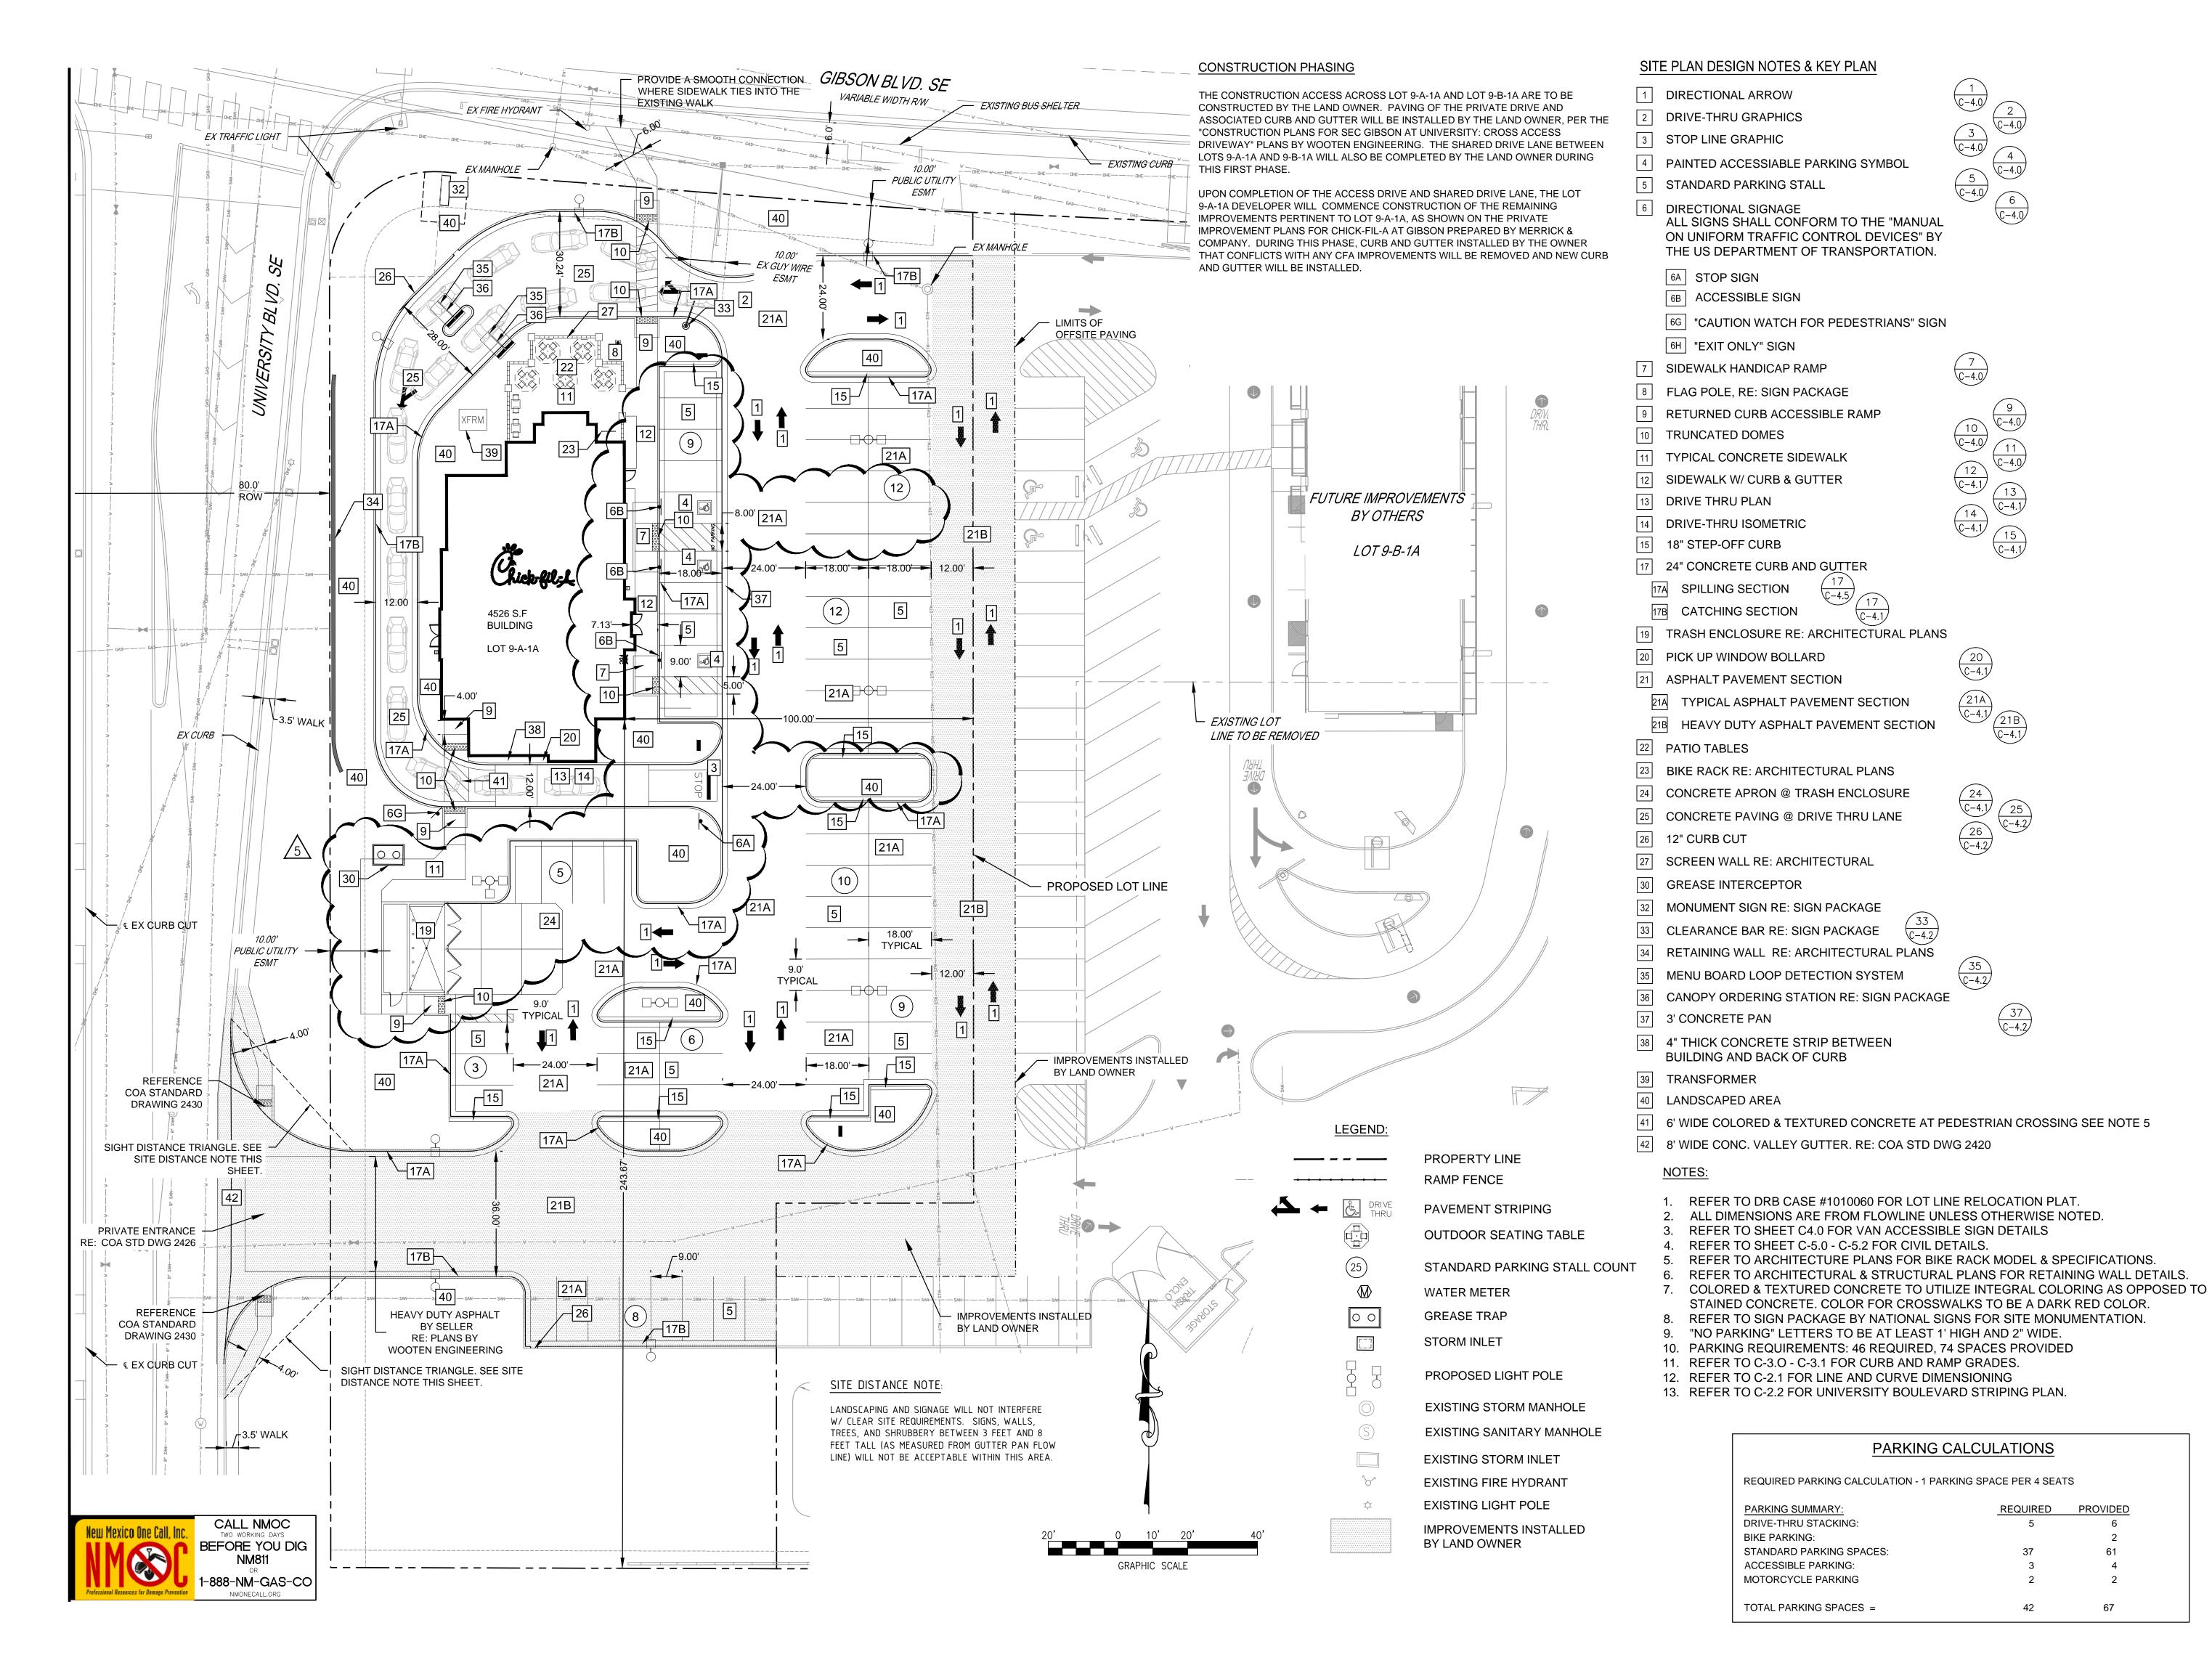

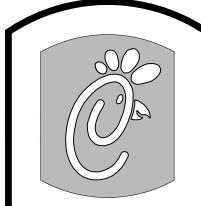


Chick-fil; L

5200 Buffington Rd. Atlanta, Georgia 30349-2998


Revisi	ions:	
Mark	Date	Ву
\bigwedge	REV. 5 ENCLOS	TRASH
233	ENCLOS	URE &
ADA P	PARKING	STALLS

Mark Date By

Mark Date By

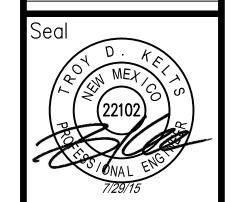

STO GREENWOOD PLAZA BLVD
GREENWOOD VILLAGE, CO 80111
303-751-0741

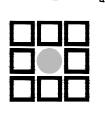

STORE FSU SO8H-A-WC

1600 GIBSON BLVD. SE ALBUQUERQUE, NM

SHEET TITLE

Traffic
Circulation
Layout

DWG EDITION ---

Job No. :65118373
Store : 03486
Date :07/01/15

Date : 03488 Date :07/01/15 Drawn By : TW Checked By: TDK

C-20

Sheet