
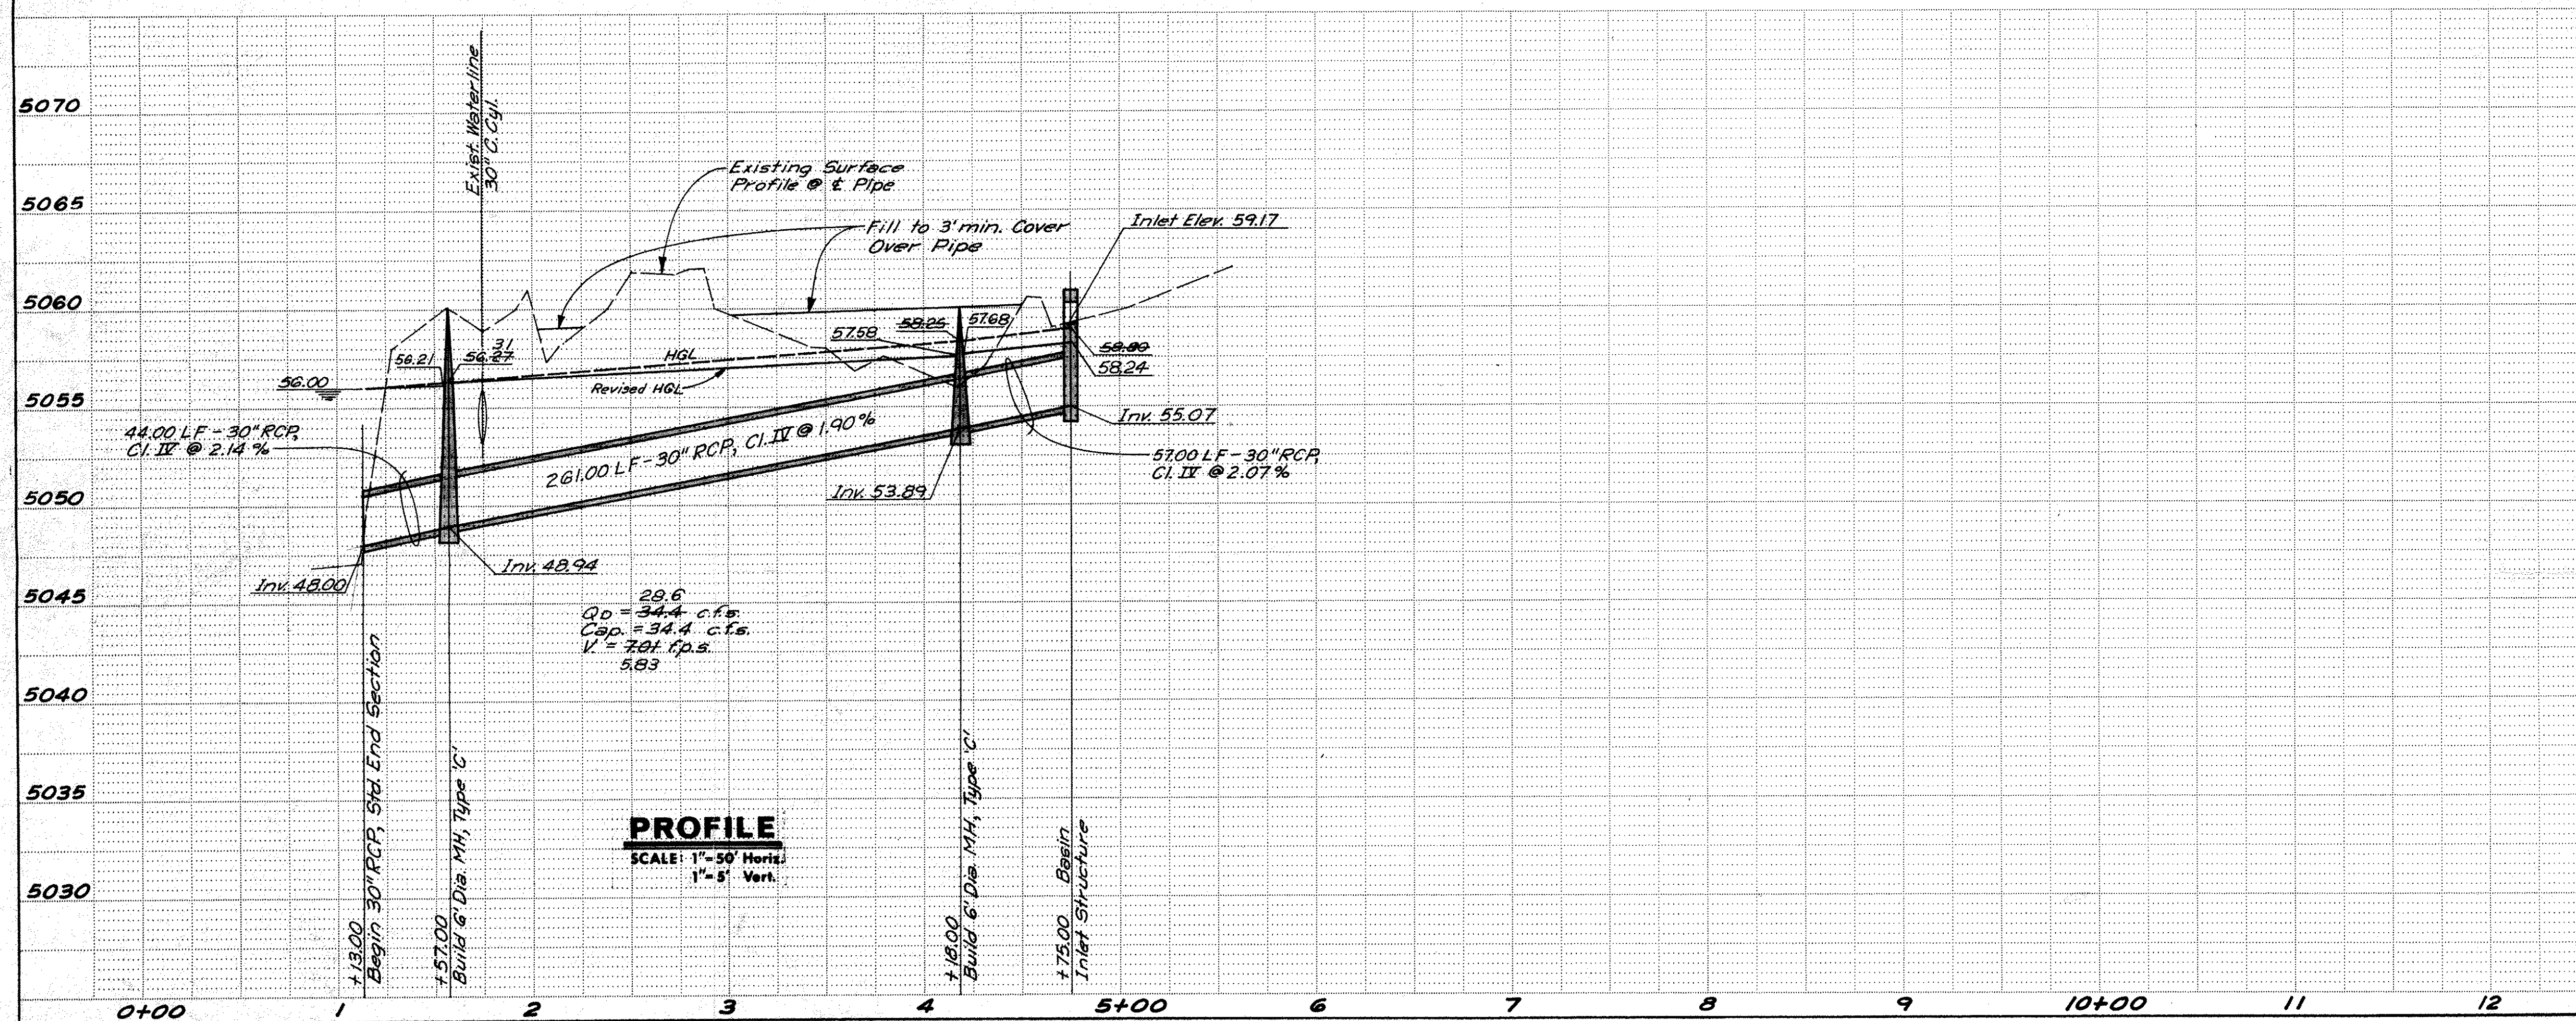


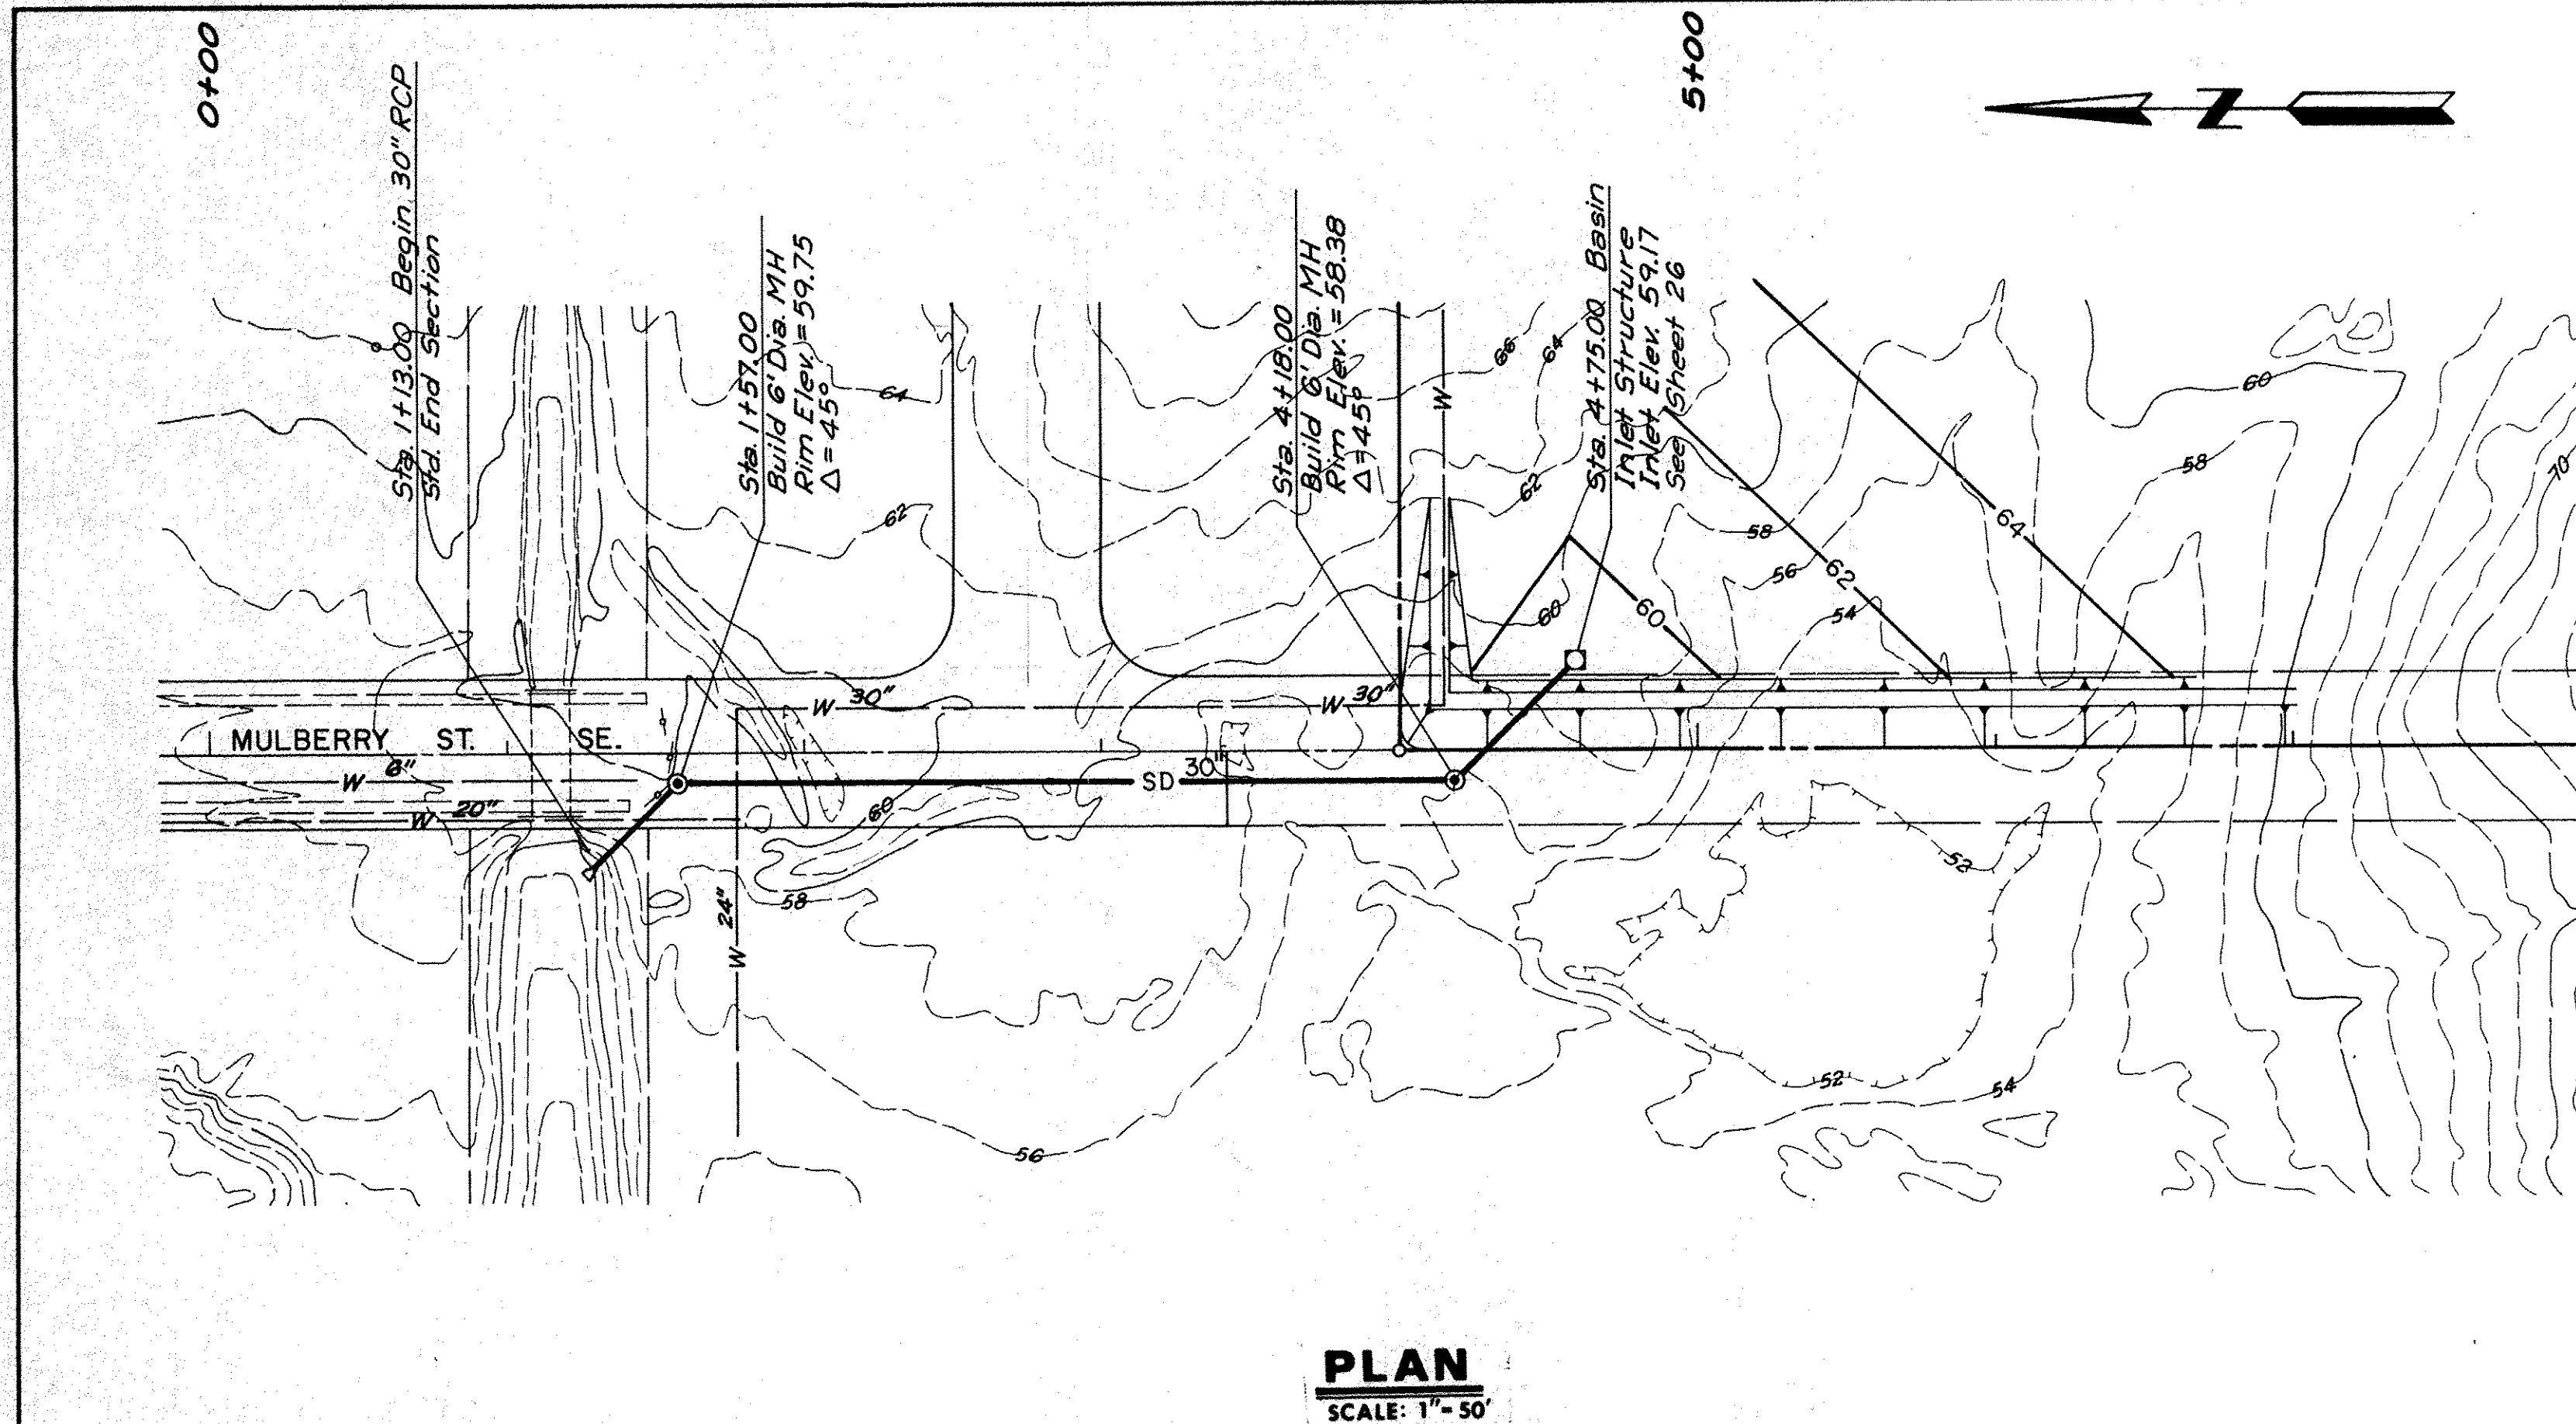

John A. Anderson
RECORD DRAWING
2-8-89

APPROVALS			ENGINEER			DATE			APPROVALS			ENGINEER			DATE		
City Engineer			<i>Anderson</i>			4/23/87			Liquid Waste			TMA			5-22-87		
A.C.E. - Design			" "			" "			Traffic			NADWH			5-22-87		
A.C.E. - Hydrology			<i>Anderson</i>			5-22-87			Water			TMA			5-22-87		
DRAWING NO.			2950			MAP NO.			M-15			SHEET			25 OF 26		

ENGINEER'S SEAL		REVISIONS		REMARKS		BY		DATE		DESIGNED BY		CHECKED BY		DATE	
Professional Engineer		1		Revise HGL		JMA		7-10-80		JMA		JMA		7-10-80	
Professional Engineer		2		Revise HGL		JMA		8-23-80		JMA		JMA		8-23-80	

SURVEY INFORMATION		FIELD NOTES		DATE		BY		NO.		BENCH MARKS		AS BUILT INFORMATION	
STA. 1+25-31"		ELEVATION 5062.528		1-89		CONTRACTOR New Concepts Inc.		WORK STARTED BY		STANDARD INSURANCE BRASS TABLE SET IN CONCRETE		DATE 1-89	
POST LOCATED AT THE NORTHEAST CORNER OF		THE HIGHWAY 1-25 BRIDGE CROSSING OVER AN		DATE 2-89		ABANDONED RAILROAD SPUR LINE APPROXIMATELY		CORRECTED BY		1.15 MILES NORTH OF RIO BRAVO BOULEVARD		DATE 1-89	
RECORDED BY		NO.		DATE		MICRO-FILM INFORMATION		CORRECTED BY		AA#R		DATE 1-89	

ANDREWS, ASBURY & ROBERT, INC.
ALBUQUERQUE, NEW MEXICO